

# MAP SYMBOLLOGY

Aerial Cableway	---	Pipeline	---
Boundary	---	Railroad	---
International	---	Single Track	---
Interprovincial	---	Double Track	---
State, Township	---	Abandoned	---
Approximate	---	Terrestrial	---
Let, Concession	---	Road	---
Approximate	---	Highway, County	---
Park Boundary	---	Trail, Back Road	---
Bridge	---	Trail, Back Road	---
Rock, Railroad	---	Trail, Back Road	---
Building	---	Road	---
Chimney	---	Road	---
Cliff, Pit, Pile	---	Road	---
Contours	---	Road	---
Interpolated	---	Road	---
Approximate	---	Road	---
Depression	---	Road	---
Control Points	---	Road	---
Horizontal	---	Road	---
Vertical	---	Road	---
Culvert	---	Road	---
Falls	---	Road	---
Double line river	---	Road	---
Fence, Hedge, Wall	---	Road	---
Feature Outline	---	Road	---
(Construction features, etc.)	---	Road	---
Flooded Land	---	Road	---
Lock	---	Road	---
Marsh or Swamp	---	Road	---
Mast	---	Road	---
Mine Head Frame	---	Road	---
Outcrop	---	Road	---


## AREAS WITHDRAWN FROM DISPOSITION


M.R.O. - MINING RIGHTS ONLY

S.R.O. - SURFACE RIGHTS ONLY

M. + S. - MINING AND SURFACE RIGHTS

Description	Order No.	Date	Disposition	File
SEC. 36/82	W. 4/82	14/8/82	S.R.O.	137685

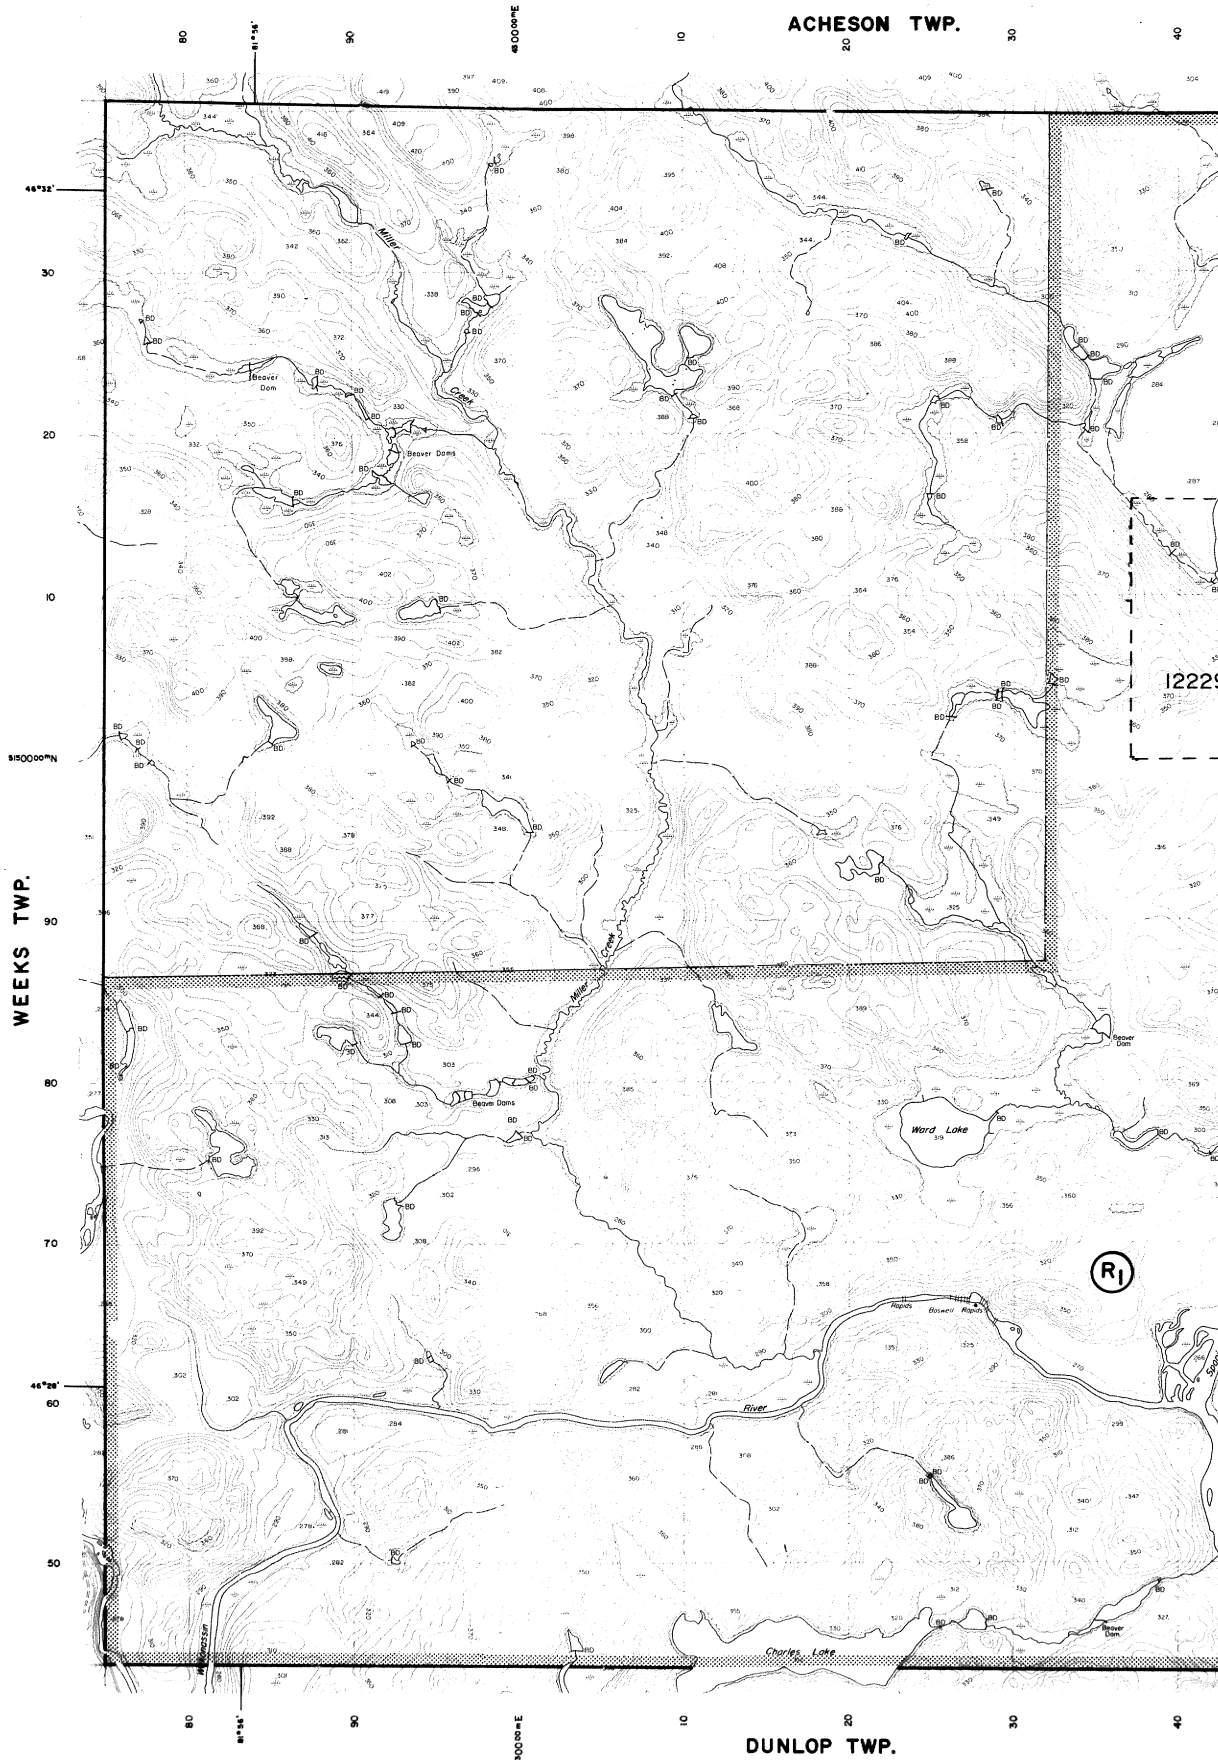

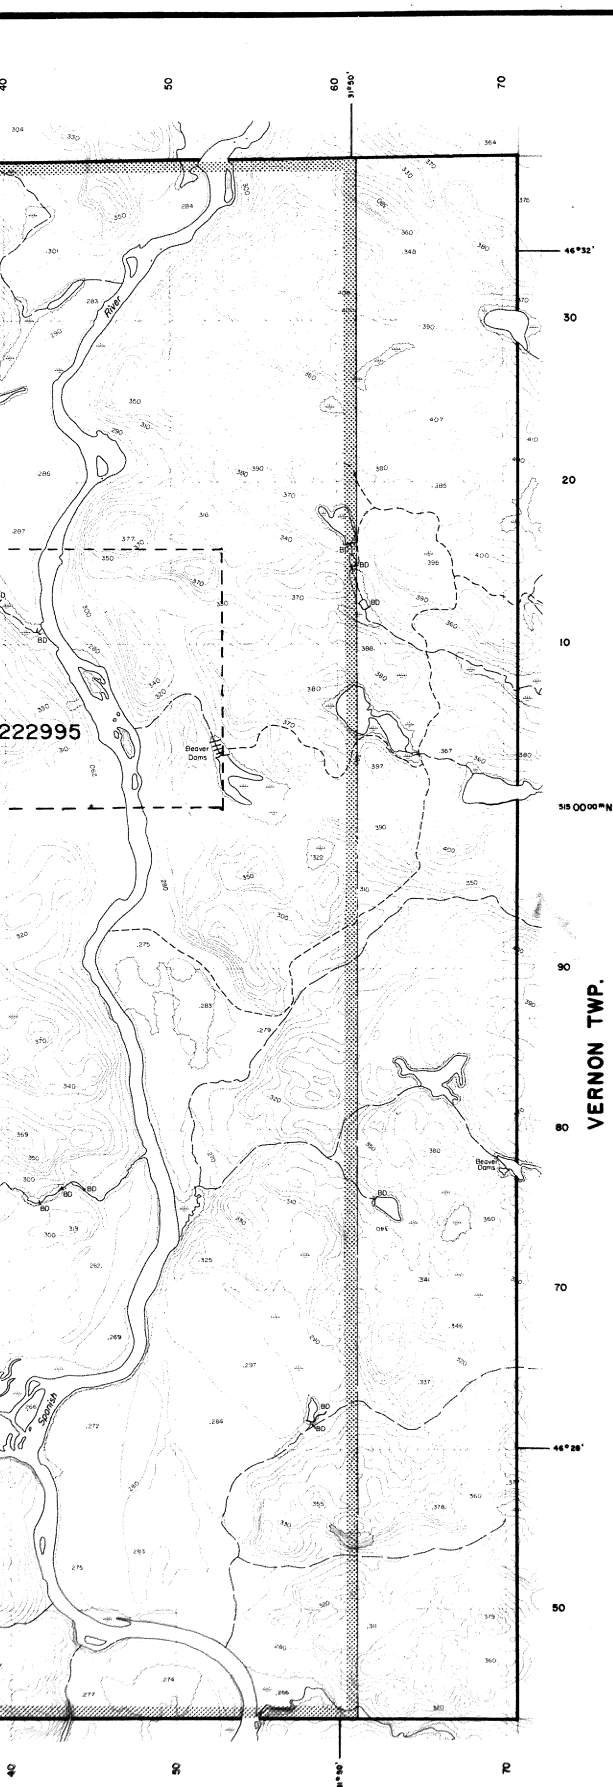


# LEGEND

HIGHWAY AND ROUTE No.	
OTHER ROADS	
TRAILS	
SURVEYED LINES:	
TOWNSHIPS, BASE LINES, ETC.	
LOTS, MINING CLAIMS, PARCELS, ETC.	
UNSURVEYED LINES:	
LOT LINES	
PARCEL BOUNDARY	
MINING CLAIMS ETC.	
RAILWAY AND RIGHT OF WAY	
UTILITY LINES	
NON-PERENNIAL STREAM	
FLOODING OR FLOODING RIGHTS	
SUBDIVISION OR COMPOSITE PLAN	
RESERVATIONS	
ORIGINAL SHORELINE	
MARSH OR MUSKEG	
MINES	
TRAVERSE MONUMENT	

## DISPOSITION OF CROWN LANDS

TYPE OF DOCUMENT	SYMBOL
PATENT, SURFACE & MINING RIGHTS	
" SURFACE RIGHTS ONLY	
" MINING RIGHTS ONLY	
LEASE, SURFACE & MINING RIGHTS	
" SURFACE RIGHTS ONLY	
" MINING RIGHTS ONLY	
LICENCE OF OCCUPATION	
ORDER-IN-COUNCIL	
RESERVATION	
CANCELLED	
SAND & GRAVEL	

NOTE: MINING RIGHTS IN PARCELS PATENTED PRIOR TO MAY 6, 1913, VESTED IN ORIGINAL PATENTEE BY THE PUBLIC LANDS ACT, R.S.O. 1970, CHAP. 300, SEC. 63, SUBSEC. 1.

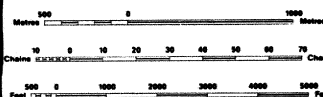

SCALE 1:20 000

THE INFORMATION THAT APPEARS ON THIS MAP HAS BEEN COMPILED FROM VARIOUS SOURCES, AND ACCURACY IS NOT GUARANTEED. THOSE WISHING TO STAKE MINING CLAIMS SHOULD CONSULT WITH THE MINING RECORDER, MINISTRY OF NORTHERN DEVELOPMENT AND MINES, FOR ADDITIONAL INFORMATION ON THE STATUS OF THE LANDS SHOWN HEREON.

### TOWNSHIP

**BIGELOW**

M.N.R. ADMINISTRATIVE DISTRICT

**ESPANOLA**

MINING DIVISION

**SUDBURY**

LAND TITLES / REGISTRY DIVISION

**SUDBURY**



Ministry of  
Natural  
Resources

Land  
Management  
Branch

Date NOVEMBER, 1984

Number

**G-2864**

G-5884

BIGELOW TWP.

G-5884

# NOTES


surface rights reservation along the shores  
all lakes and rivers.

division of this township into lots and  
cessions was annulled June 10, 1953.

ACHESON, TP. M.618



WEEKS TP. M.1203

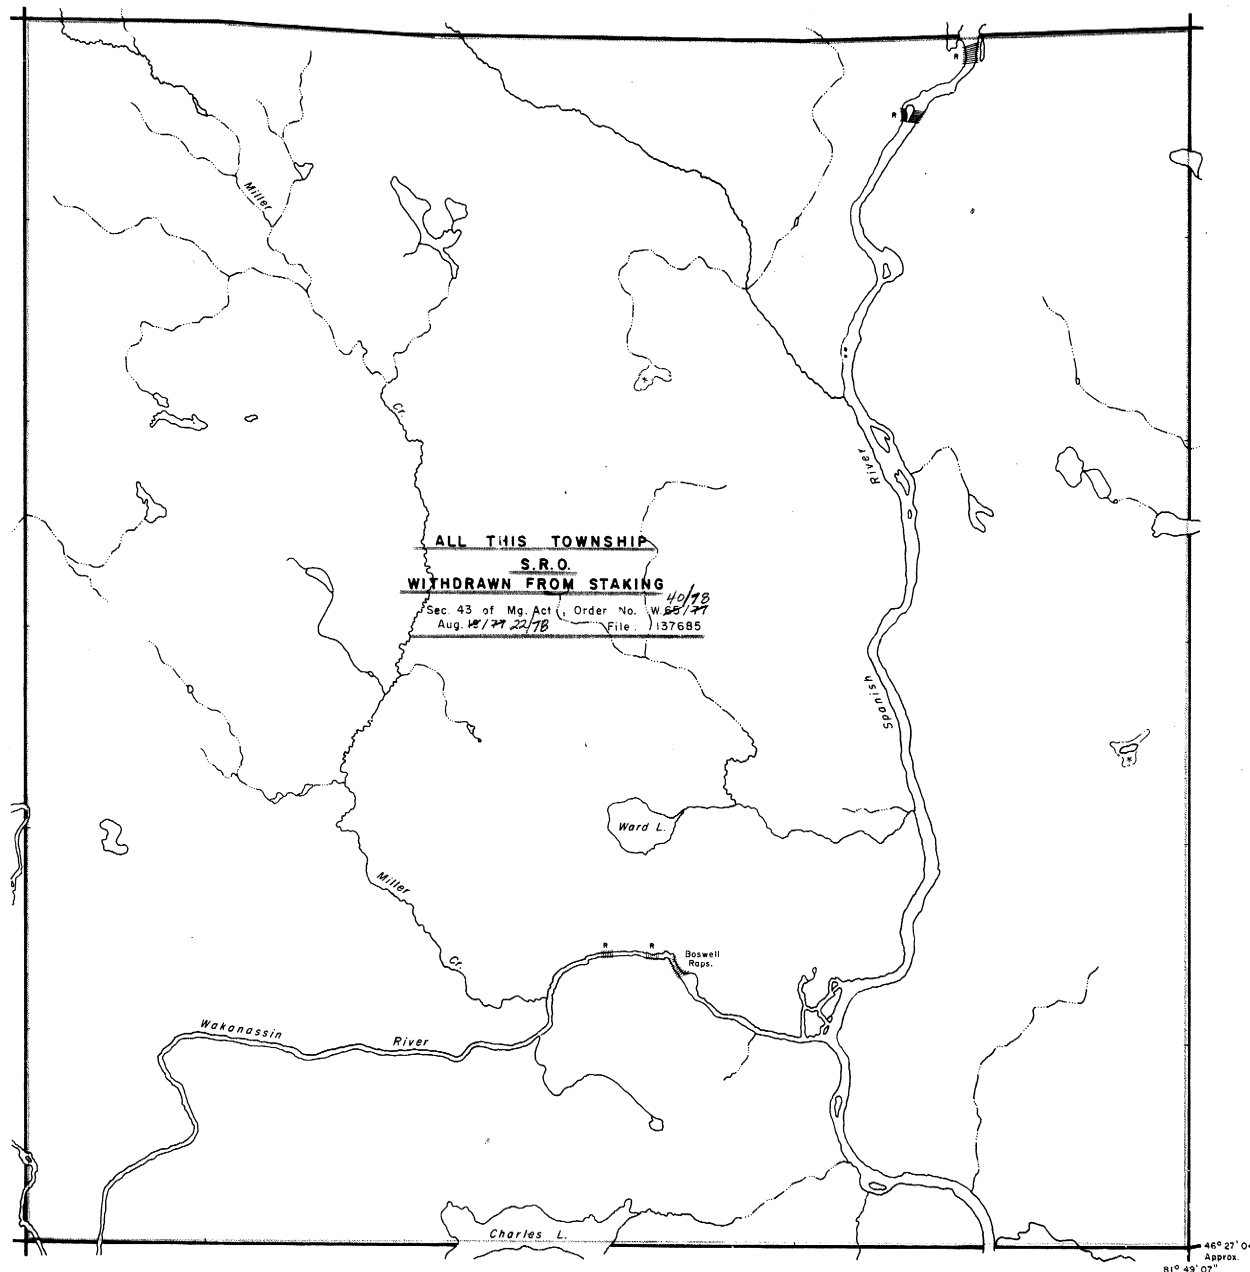

DUNLOP TP. M.771


VERNON TP. M.1171

## LEGEND

HIGHWAY AND ROUTE No.	
OTHER ROADS	
TRAILS	
SURVEYED LINES:	
TOWNSHIPS, BASE LINES, ETC.	
LOTS, MINING CLAIMS, PARCELS, ETC.	
UNSURVEYED LINES:	
LOT LINES	
PARCEL BOUNDARY	
MINING CLAIMS ETC.	
RAILWAY AND RIGHT OF WAY	
UTILITY LINES	
NON-PERENNIAL STREAM	
FLOODING OR FLOODING RIGHTS	
SUBDIVISION	
ORIGINAL SHORELINE	
MARSH OR MUSKEG	
MINES	

## DISPOSITION OF CROWN LANDS

TYPE OF DOCUMENT	SYMBOL
PATENT, SURFACE & MINING RIGHTS	
SURFACE RIGHTS ONLY	
MINING RIGHTS ONLY	
LEASE, SURFACE & MINING RIGHTS	
SURFACE RIGHTS ONLY	
MINING RIGHTS ONLY	
LICENCE OF OCCUPATION	
CROWN LAND SALE	C.S.
ORDER-IN-COUNCIL	O.C.
RESERVATION	
CANCELLED	
SAND & GRAVEL	

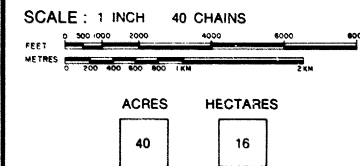

## TOWNSHIP

**BIGELOW**

## DISTRICT

**SUDBURY**

## MINING DIVISION

**SUDBURY**



Ministry of Natural  
Resources

Ontario Surveys and Mapping Branch

Date AUG. 1975

Plan No.


Whitney Block  
Queen's Park, Toronto

**M.664**

# NOTES


400' surface rights reservation along the shores of all lakes and rivers.

Subdivision of this township into lots and concessions was annulled June 10, 1953.

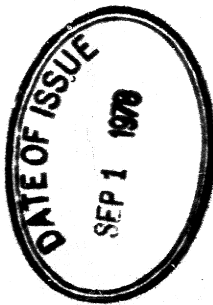


# OFFICE USE ONLY

WEEKS TP. M.1203

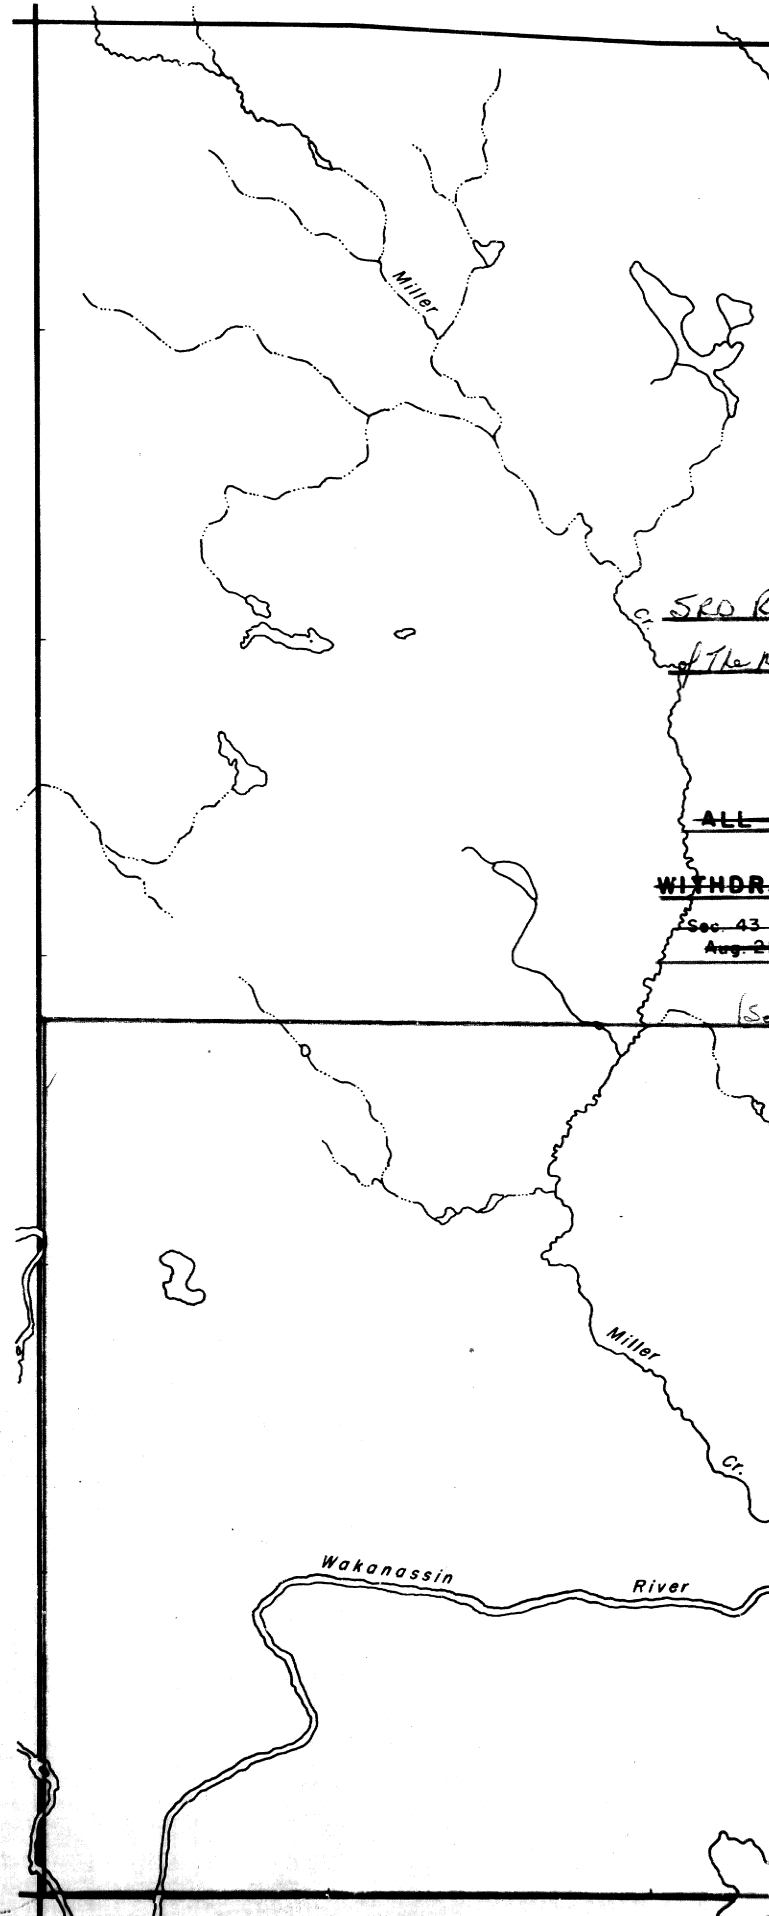



ACHESON TP. M.618

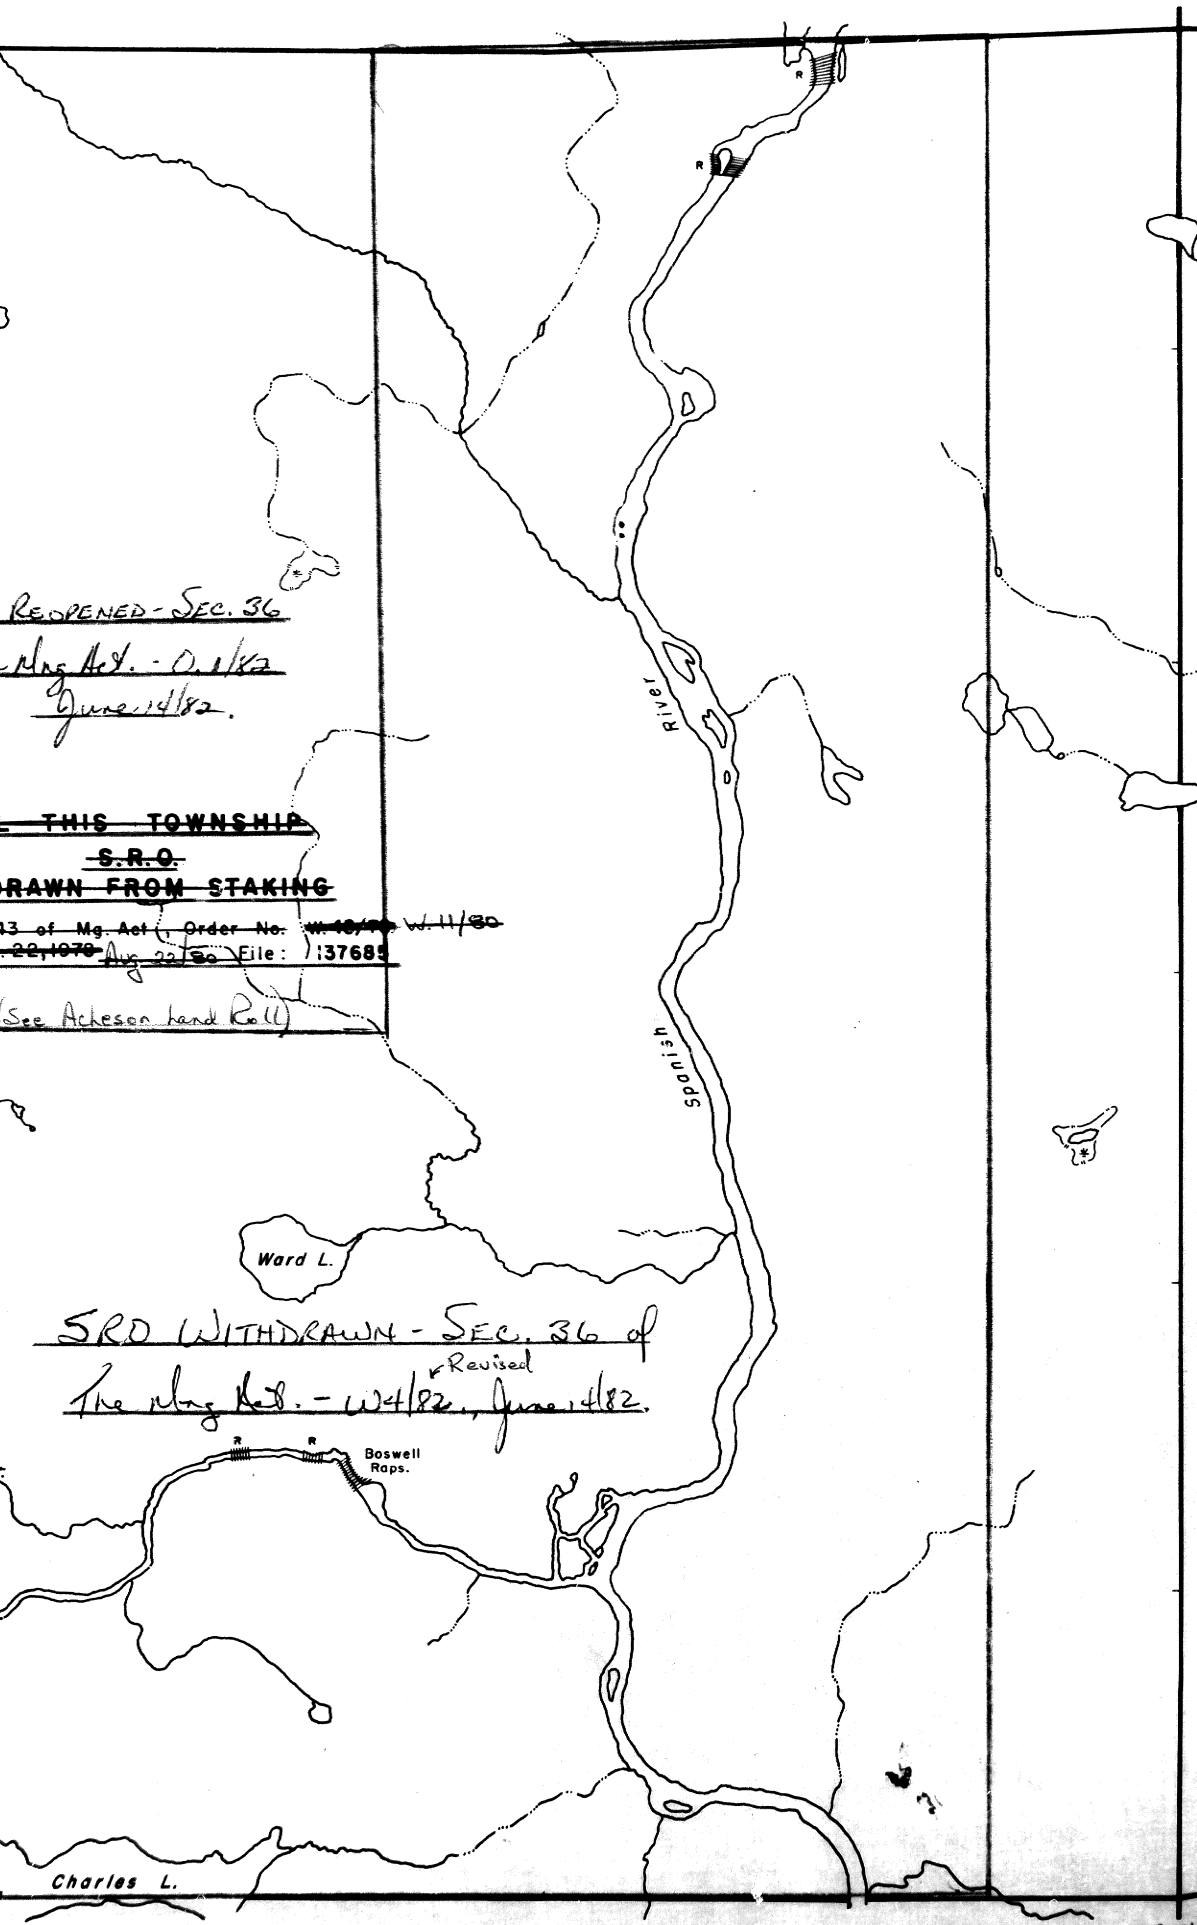

VERNON TP. M.1171

DUNLOP TP. M.771

HIGHWAY AND ROUTE No.

OTHER ROADS

TRAILS

SURVEYED LINES:

TOWNSHIPS, BASE LINES, ETC.

LOTS, MINING CLAIMS, PARCELS, ETC.

UNSURVEYED LINES:

LOT LINES

PARCEL BOUNDARY

MINING CLAIMS ETC.

RAILWAY AND RIGHT OF WAY

UTILITY LINES

NON-PERENNIAL STREAM


FLOODING OR FLOODING RIGHTS

SUBDIVISION

ORIGINAL SHORELINE

MARSH OR MUSKEG

MINES

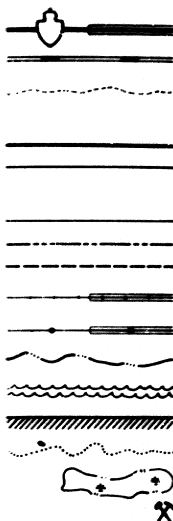


## DISPOSITION OF CROWN LANDS

### TYPE OF DOCUMENT

### SYMBOL

PATENT, SURFACE & MINING RIGHTS	●
" SURFACE RIGHTS ONLY	◐
" MINING RIGHTS ONLY	◑
LEASE, SURFACE & MINING RIGHTS	■
" SURFACE RIGHTS ONLY	◼
" MINING RIGHTS ONLY	◻
LICENCE OF OCCUPATION	▼
CROWN LAND SALE	C.S.
ORDER-IN-COUNCIL	OC
RESERVATION	Ⓜ
CANCELLED	ⓧ
SAND & GRAVEL	Ⓢ

SCALE : 1 INCH 40 CHAINS

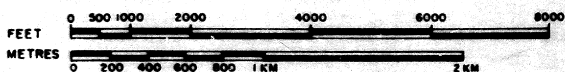

ACRES

HECTARES

40

16

TOWNSHIP

# BIGELOW

DISTRICT

## SUDBURY

MINING DIVISION

## SUDBURY



Ontario

## Ministry of Natural Resources

Surveys and Mapping Branch

Date AUG. 1975

Plan No.

# NOTES

surface rights reservation along the shores of all lakes and rivers.


division of this township into lots and sections was annulled June 10, 1953.

## AREAS WITHDRAWN FROM DISPOSITION

FACE RIGHTS DISPOSITION	ORDER No.	DATE	M.R. - MINING RIGHTS DISPOSITION	FILE
/82	W.4/82	14/6/82	S.R.	137685

## ACHESON TP. M.618

WEEKS TP. M.1203

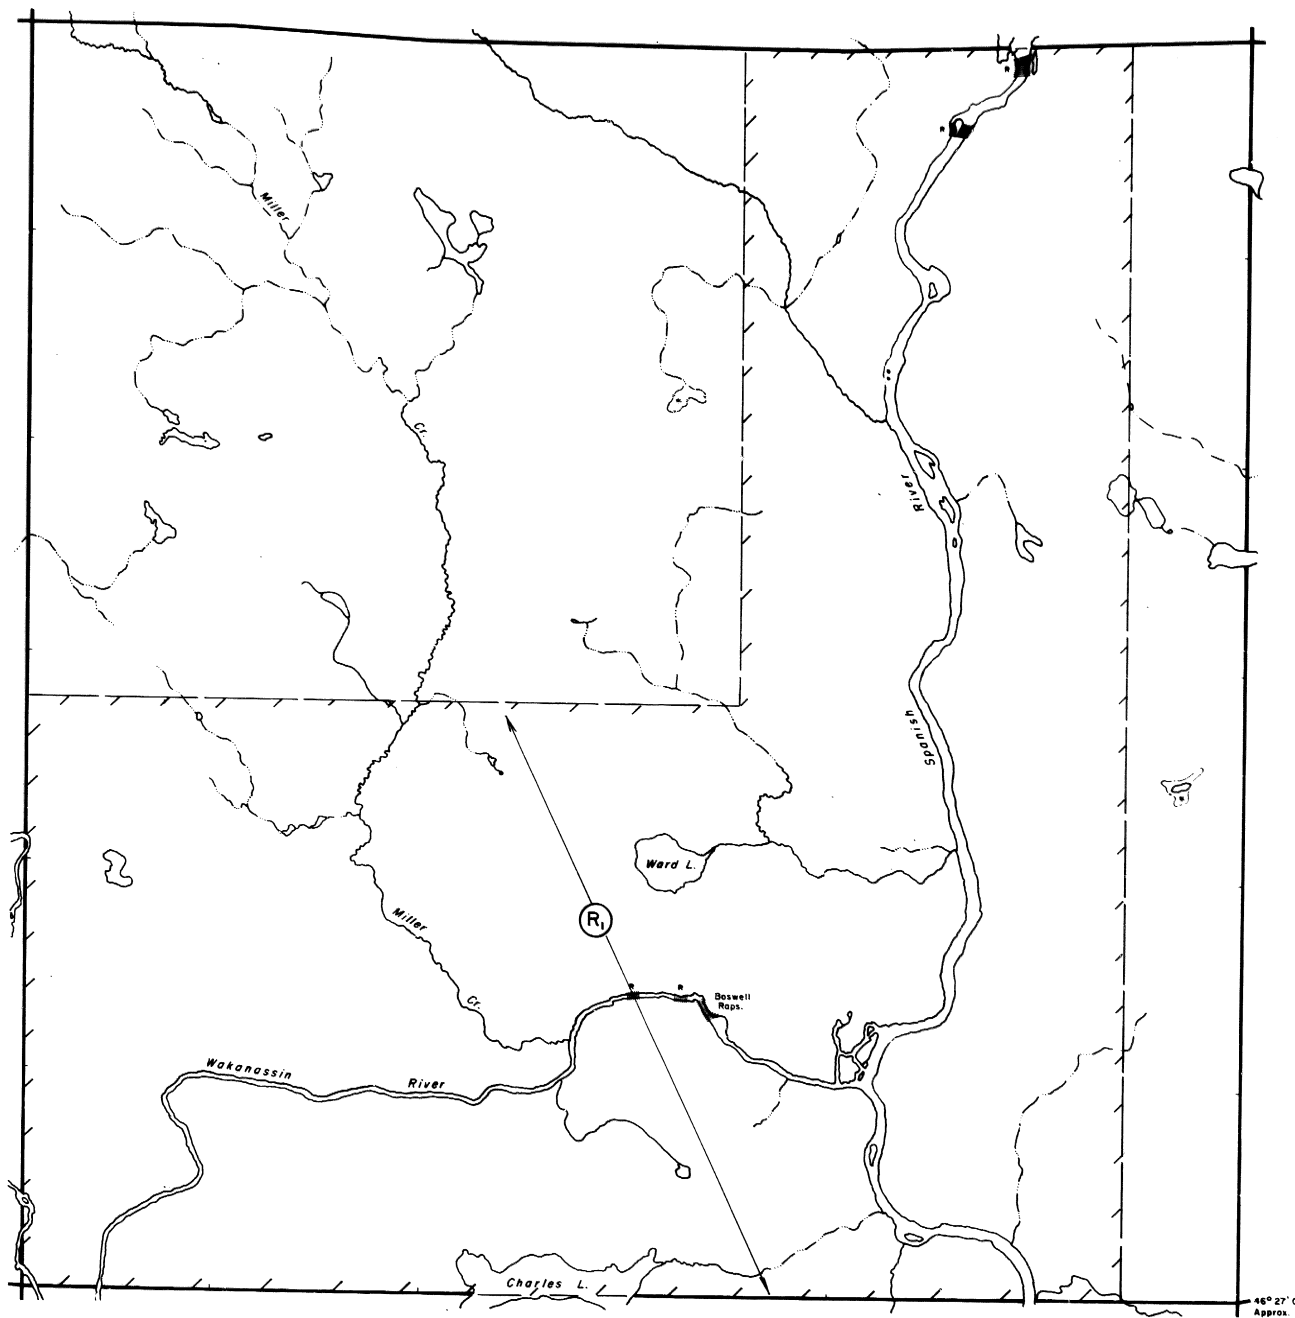


DUNLOP TP. M.771

## LEGEND

- HIGHWAY AND ROUTE No.
- OTHER ROADS
- TRAILS
- SURVEYED LINES:
  - TOWNSHIPS, BASE LINES, ETC.
  - LOTS, MINING CLAIMS, PARCELS, ETC.
- UNSURVEYED LINES:
  - LOT LINES
  - PARCEL BOUNDARY
  - MINING CLAIMS ETC.
- RAILWAY AND RIGHT OF WAY
- UTILITY LINES
- NON-PERENNIAL STREAM
- FLOODING OR FLOODING RIGHTS
- SUBDIVISION
- ORIGINAL SHORELINE
- MARSH OR MUSKEG
- MINES

## DISPOSITION OF CROWN LANDS

TYPE OF DOCUMENT	SYM
PATENT, SURFACE & MINING RIGHTS	
SURFACE RIGHTS ONLY	
MINING RIGHTS ONLY	
LEASE, SURFACE & MINING RIGHTS	
SURFACE RIGHTS ONLY	
MINING RIGHTS ONLY	
LICENCE OF OCCUPATION	
CROWN LAND SALE	
ORDER-IN-COUNCIL	
RESERVATION	
CANCELLED	
SAND & GRAVEL	

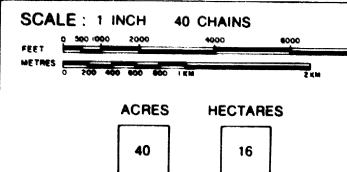


TOWNSHIP  
**BIGELOW**  
DISTRICT  
SUDBURY  
MINING DIVISION  
SUDBURY

Ministry of Natural Resources  
Ontario Surveys and Mapping Branch  
Date AUG. 1975  
Whitney Block  
Queen's Park, Toronto  
Plan No. **M.664**

# NOTES

400' surface rights reservation along the shores  
of all lakes and rivers.


Subdivision of this township into lots and  
concessions was annulled June 10, 1953.

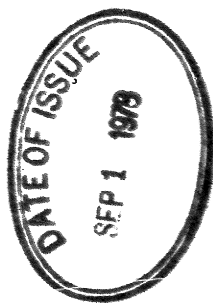

WEEKS TP. M.1203


OFFICE USE ONLY

AC

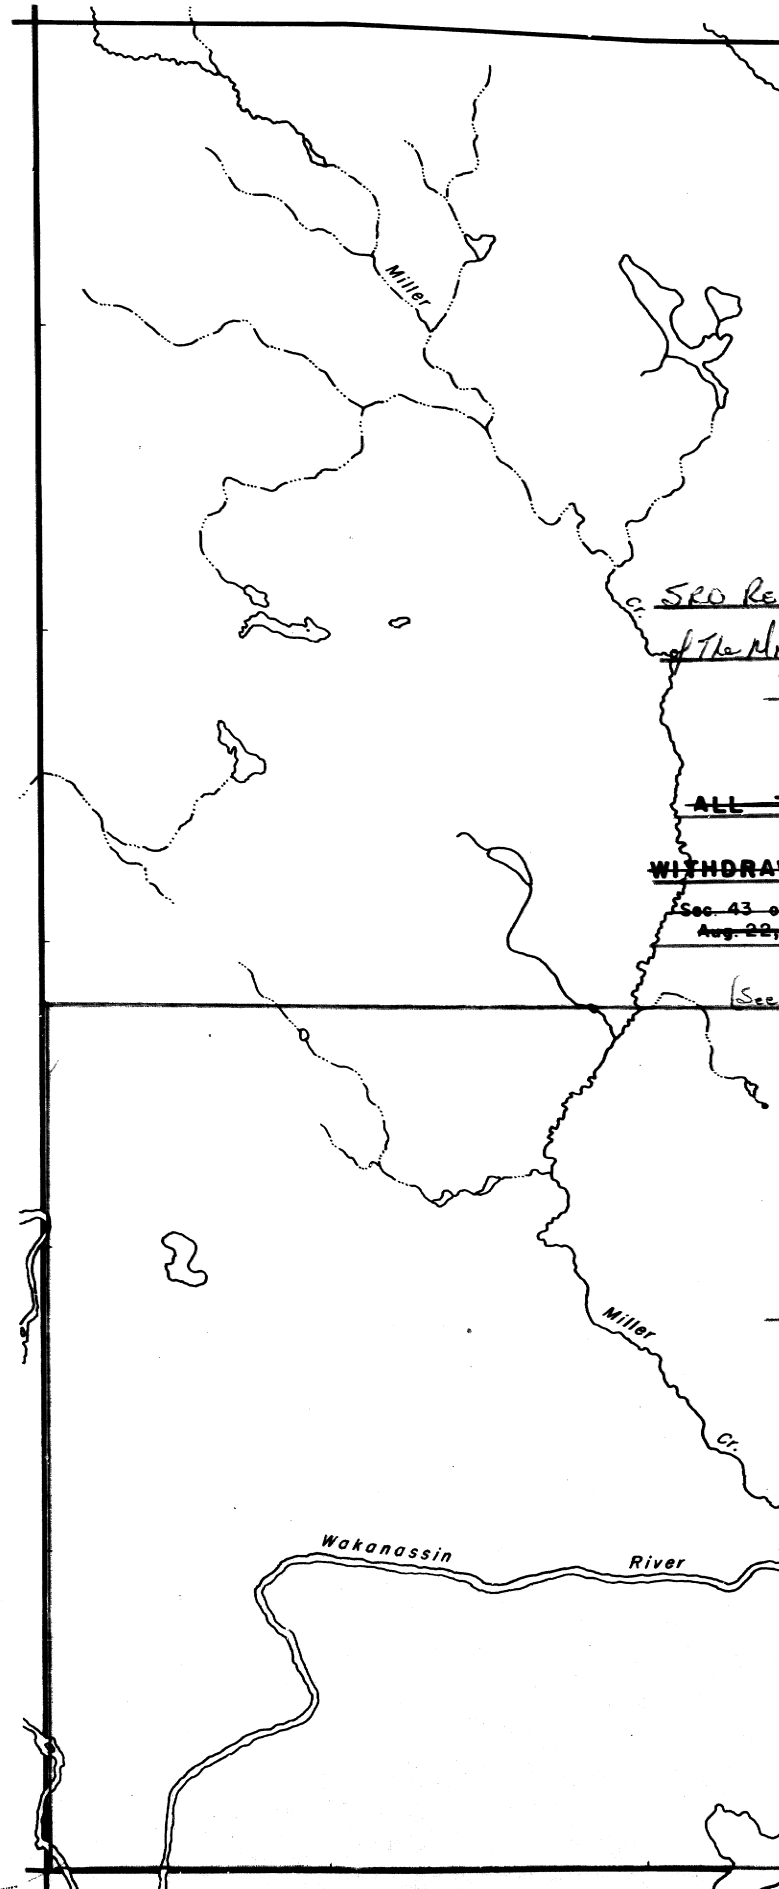

D

ACHESON TP. M.618

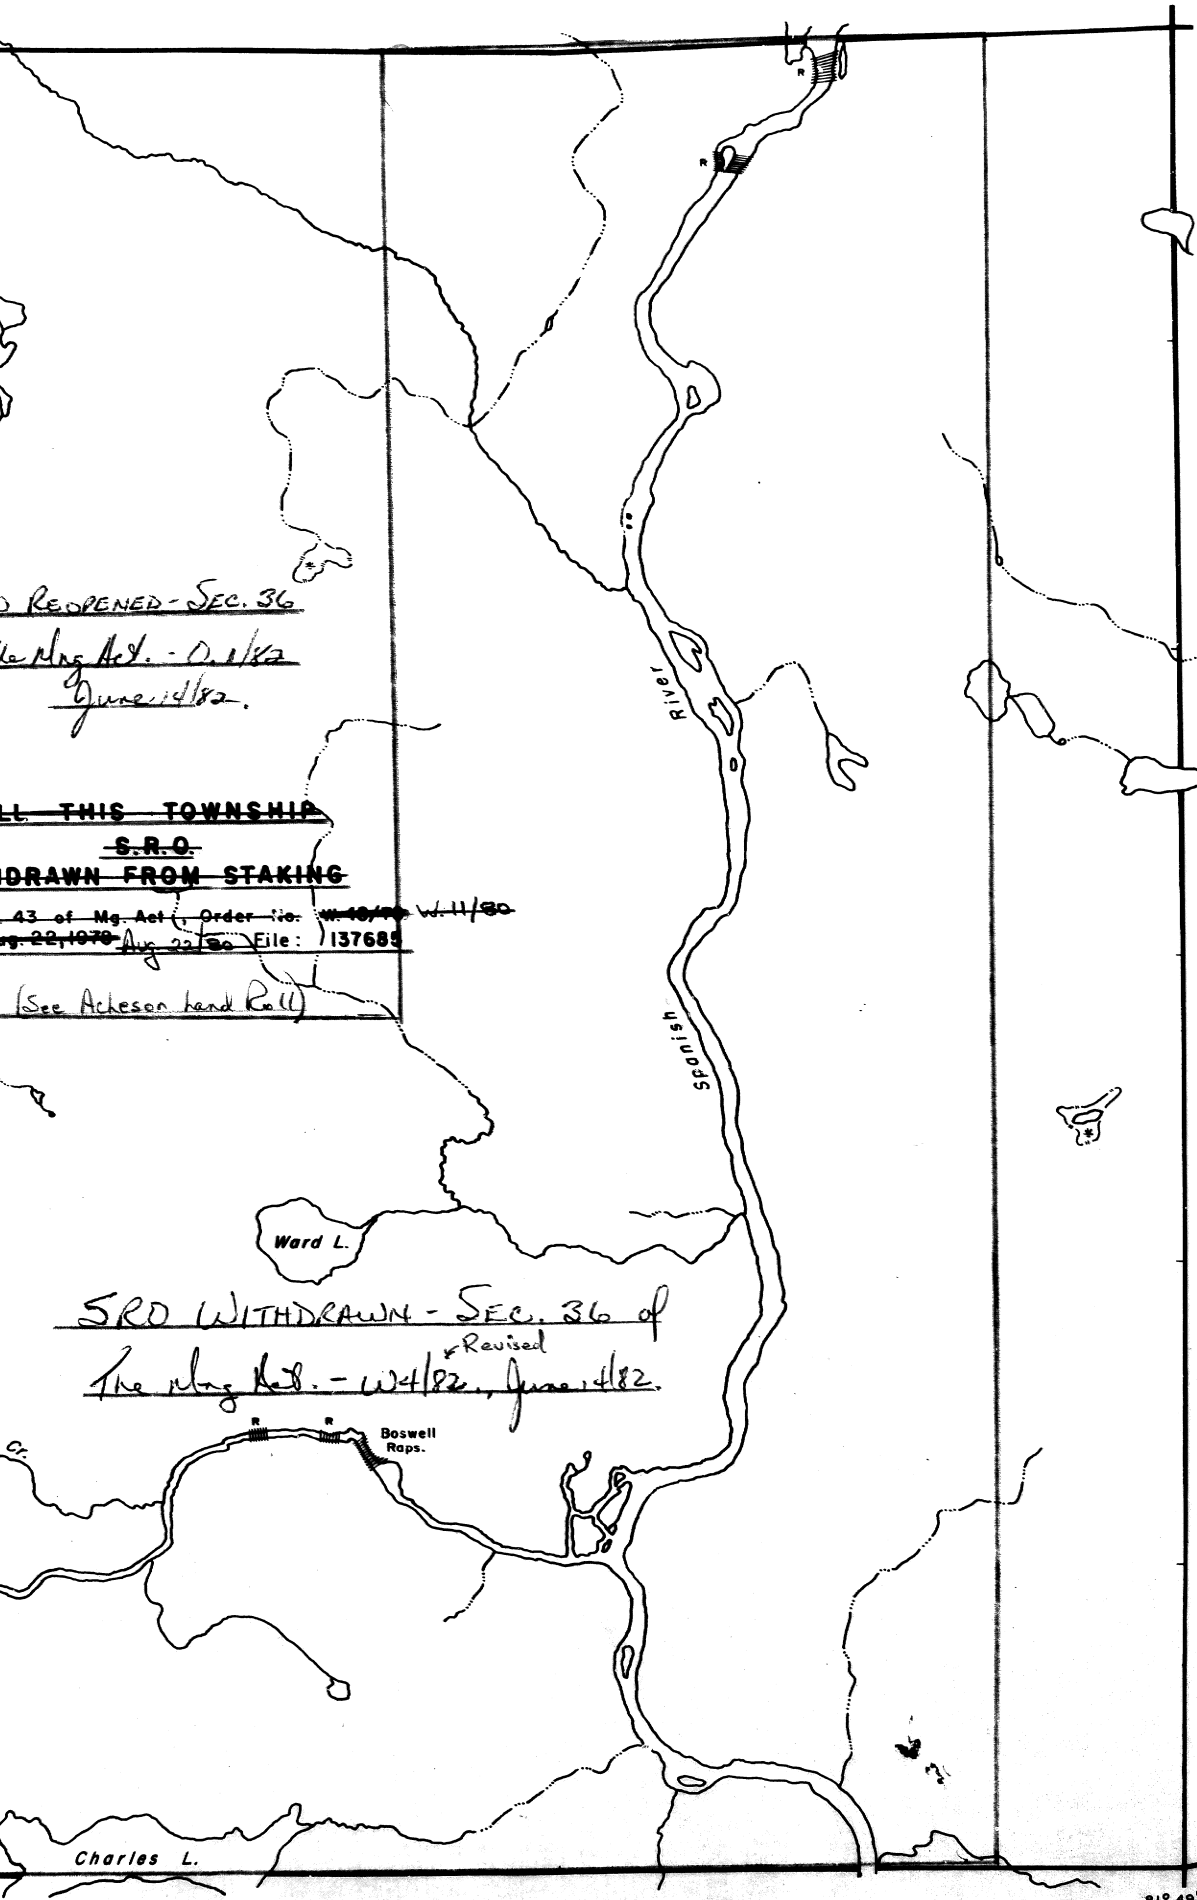

REOPENED - SEC. 36  
Mg Act. - W 4/82  
June 14/82.

~~ALL THIS TOWNSHIP~~  
~~S.R.O.~~  
~~DRAWN FROM STAKING~~

43 of Mg Act. Order No. W 4/82 W 11/82  
Aug 22, 1978 Aug 22, 80 File: 137685  
(See Acheson Land Roll)

SRO WITHDRAWN - SEC. 36 of  
The Mg Act. - W 4/82, June 14/82.  
Revised

VERNON TP. M.1171

DUNLOP TP. M.771

46° 27' 04"  
Approx.  
81° 49' 07"


# LEGEND

HIGHWAY AND ROUTE No.	
OTHER ROADS	
TRAILS	
SURVEYED LINES:	
TOWNSHIPS, BASE LINES, ETC.	
LOTS, MINING CLAIMS, PARCELS, ETC.	
UNSURVEYED LINES:	
LOT LINES	
PARCEL BOUNDARY	
MINING CLAIMS ETC.	
RAILWAY AND RIGHT OF WAY	
UTILITY LINES	
NON-PERENNIAL STREAM	
FLOODING OR FLOODING RIGHTS	
SUBDIVISION	
ORIGINAL SHORELINE	
MARSH OR MUSKEG	
MINES	

## DISPOSITION OF CROWN LANDS

TYPE OF DOCUMENT	SYMBOL
PATENT, SURFACE & MINING RIGHTS	
" SURFACE RIGHTS ONLY	
" MINING RIGHTS ONLY	
LEASE, SURFACE & MINING RIGHTS	
" SURFACE RIGHTS ONLY	
" MINING RIGHTS ONLY	
LICENCE OF OCCUPATION	
CROWN LAND SALE	C.S.
ORDER-IN-COUNCIL	OC
RESERVATION	
CANCELLED	
SAND & GRAVEL	

SCALE : 1 INCH 40 CHAINS

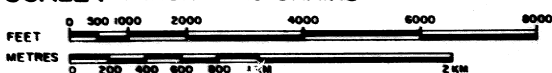

ACRES

HECTARES

40

16

TOWNSHIP

# BIGELOW

DISTRICT

## SUDBURY

MINING DIVISION

## SUDBURY



## Ministry of Natural Resources

Ontario

Surveys and Mapping Branch

Date

AUG. 1975

Plan No.

Whitney Block

# M 664