

287

GOWAN TWP. (M.285)

THE TOWNSHIP
OF

HOYLE

DISTRICT OF
COCHRANEPORCUPINE
MINING DIVISION

SCALE: 1-INCH = 40 CHAINS

LEGEND


PATENTED LAND
CROWN LAND SALE
LEASES
LOCATED LAND
LICENSE OF OCCUPATION
MINING RIGHTS ONLY
SURFACE RIGHTS ONLY
ROADS
IMPROVED ROADS
KING'S HIGHWAYS
RAILWAYS
POWER LINES
MARSH OR MUSKEG
MINES
CANCELLED

P
C.S.
L
Loc.
L.O.
M.R.O.
S.R.O.
C.

NOTES

400' Surface Rights Reservation around all
lakes and rivers.

Ont. Northland Rwy. spur line R/W for S.R.O.
see file 177607.

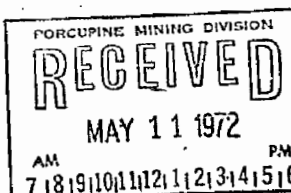

PLAN. NO.

M.287

ONTARIO
DEPARTMENT OF MINES
AND NORTHERN AFFAIRS

MURPHY TWP. (M.303)

MATHESON TWP. (M.297)

WHITNEY TWP. (M.319)

GOWAN TWP. (M.285)

THE TOWNSHIP
OF

HOYLE

DISTRICT OF
COCHRANE

PORCUPINE
MINING DIVISION

SCALE: 1-INCH = 40 CHAINS

LEGEND

PATENTED LAND	(P)
CROWN LAND SALE	C.S.
LEASES	(L)
LOCATED LAND	Loc.
LICENSE OF OCCUPATION	L.O.
MINING RIGHTS ONLY	M.R.O.
SURFACE RIGHTS ONLY	S.R.O.
ROADS	—
IMPROVED ROADS	—
KING'S HIGHWAYS	—
RAILWAYS	—
POWER LINES	—
MARSH OR MUSKEG	—
MINES	—
CANCELLED	C.



NOTES

400' Surface Rights Reservation along the shores of all lakes and rivers.

This township lies within the Municipality of CITY of TIMMINS.

Ont. Northland Rwy. spur line R/W patented for S.R.O. File: 177607.

See also C.M.V. Records Survey

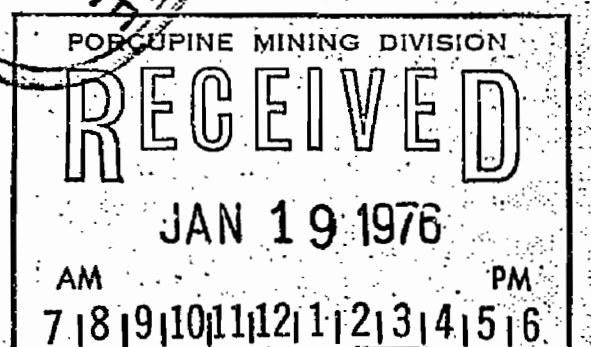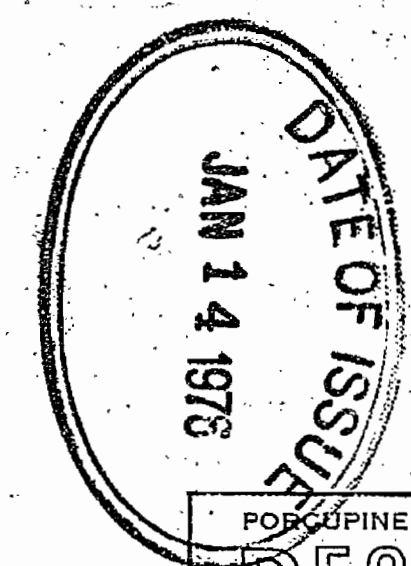

PLAN NO. **M.287**

ONTARIO
MINISTRY OF NATURAL RESOURCES
SURVEYS AND MAPPING BRANCH

MURPHY TWP. (M.303)

MATHESON TWP. (M.297)

WHITNEY TWP. (M.319)

48° 32' 11"

81° 04' 28"

GOWAN TWP. (M.285)

THE TOWNSHIP
OF

HOYLE

DISTRICT OF
COCHRANE

PORCUPINE
MINING DIVISION

SCALE: 1-INCH = 40 CHAINS

LEGEND

PATENTED LAND	P
CROWN LAND SALE	C.S.
LEASES	L
LOCATED LAND	Loc.
LICENSE OF OCCUPATION	L.O.
MINING RIGHTS ONLY	M.R.O.
SURFACE RIGHTS ONLY	S.R.O.
ROADS	==
IMPROVED ROADS	==
KING'S HIGHWAYS	==
RAILWAYS	==
POWER LINES	==
MARSH OR MUSKEG	==
MINES	*
CANCELLED	C.

NOTES

400' Surface Rights Reservation along the
shores of all lakes and rivers.

This township lies within the Municipality
of CITY of TIMMINS.

Ont. Northland Rwy. spur line R/W patented for S.R.O.
File: 177607.

N.R.W. 183 - Mining
Right Only

PLAN NO. M.287

ONTARIO
MINISTRY OF NATURAL RESOURCES
SURVEYS AND MAPPING BRANCH

Removed & filed March 15/84

MURPHY TWP. (M.303)

MATHESON TWP. (M.297)

WHITNEY TWP. (M.319)

MAP SYMBOLOLOGY

Aerial Cableway	Pipeline
Boundary	Railroad
International	Single Track
Provincial	Double Track
Statistical, Township	Abandoned
Index Reserve	Terrace
Appurtenances	Road
Lot, Concession	Highway, County
Appurtenances	Township
Pan Boundary	Access (lead of doubtful
Bridge	significance at
Road, Railroad	significant driveway)
Building	Trail, Bush Road
Chimney	(carriage, alley)
Chiff, Pit, Pile	Rapids
Contours	Double line river
Interpreted	with multiple rapids
Approximate	Double line river
Dissection	with multiple rapids
Control Points	Reservoir
Horizontal	River, Stream, Canal
Vertical	Approximate
Culvert	Direction of flow
Falls	Rock
Double line river	Significant
Fence, Hedge, Wall	Spot Elevation
Feature Outline	(spot elevations) -300.0
(contouring features, etc.)	Tower
Flooded Land	Transmission Line
Lock	Poles
Marsh or Swamp	Poles
Mast	Tunnel
Mine Head Frame	Utility Poles
Outcrop	Wharf, Dock, Pier
	Wooded Area

AREAS WITHDRAWN FROM DISPOSITION

M.R.O. - MINING RIGHTS ONLY
S.R.O. - SURFACE RIGHTS ONLY
M.S. - MINING AND SURFACE RIGHTS

Description	Order No.	Date	Disposition	File
NRW	3/63	MRO		

THIS TWP. SUBJECT TO FOREST ACTIVITY IN 1992/93

FURTHER INFORMATION AVAILABLE ON FILE.

THIS TWP. IS SUBJECT TO FOREST ACTIVITY IN 1994/95

FURTHER INFORMATION AVAILABLE ON FILE.

THE INFORMATION THAT APPEARS ON THIS MAP HAS BEEN COMPILED FROM VARIOUS SOURCES, AND ACCURACY IS NOT GUARANTEED. THOSE WISHING TO STAKE MINING CLAIMS SHOULD CONSULT WITH THE MINING RECORDER, MINISTRY OF NORTHERN DEVELOPMENT AND MINES, FOR ADDITIONAL INFORMATION ON THE STATUS OF THE LANDS SHOWN HEREON.

GOWAN TWP

MURPHY TWP

WHITNEY TWP


LEGEND

HIGHWAY AND ROUTE No.	
OTHER ROADS	
TRAILS	
SURVEYED LINES:	
TOWNSHIPS, BASE LINES, ETC.	
LOTS, MINING CLAIMS, PARCELS, ETC.	
UNSURVEYED LINES:	
LOT LINES	
PARCEL BOUNDARY	
MINING CLAIMS ETC.	
RAILWAY AND RIGHT OF WAY	
UTILITY LINES	
NON-PERENNIAL STREAM	
FLOODING OR FLOODING RIGHTS	
SUBDIVISION OR COMPOSITE PLAN	
RESERVATIONS	
ORIGINAL SHORELINE	
MARSH OR MUSKEG	
MINES	
TRAVERSE MONUMENT	

DISPOSITION OF CROWN LANDS

TYPE OF DOCUMENT	SYMBOL
PATENT, SURFACE & MINING RIGHTS	●
" SURFACE RIGHTS ONLY	○
" MINING RIGHTS ONLY	○
LEASE, SURFACE & MINING RIGHTS	■
" SURFACE RIGHTS ONLY	■
" MINING RIGHTS ONLY	■
LICENCE OF OCCUPATION	○
ORDER-IN-COUNCIL	○
RESERVATION	○
CANCELLED	○
SAND & GRAVEL	○

NOTE: MINING RIGHTS IN PARCELS PATENTED PRIOR TO MAY 6, 1913, VESTED IN ORIGINAL PATENTEE BY THE PUBLIC LANDS ACT, R.S.O. 1970, CHAP. 380, SEC. 63, SUBSEC. 1.

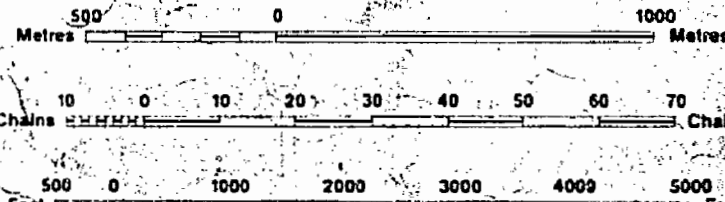

SCALE 1:20 000

GRID ZONE 17

NOTES

DATE OF ISSUE

JUN 02 1998

PROVINCIAL RECORDING OFFICE - SUDBURY

TOWNSHIP
HOYLE
M.N.R. ADMINISTRATIVE DISTRICT
TIMMINS
MINING DIVISION
PORCUPINE
LAND TITLES / REGISTRY DIVISION
COCHRANE

Ministry of Natural Resources
Land Management Branch

ORIGINAL COMPILATION JULY 1984
REVISED
G-3987

GOWAN TWP

AREAS WITHDRAWN FROM DISPOSITION


SEC. 35/90. W-P-50/98 NER 98/11/23 M&S 195150
SEC. 35/90 W-P-50/98 NER 98/11/23 M&S 195150

WHITNEY TWP



DISPOSITION OF CROWN LANDS

NOTE: MINING RIGHTS IN PARCELS PATENTED PRIOR TO MAY 6 1913, VESTED IN ORIGINAL PATENTEE BY THE PUBLIC LANDS ACT, R.S.O. 1970, CHAP. 380, SEC. 63, SUBSEC 1

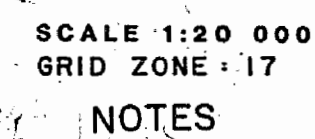

NOTES

 Ministry of Land
Natural Management
Resources Branch

ORIGINAL COMPILATION: JULY 1984	Number
REVISED	G-3987

MAP SYMBOLOLOGY

Aerial Cableway	Pipeline (above ground)
Boundary	Railroad
International	Single Track
Interprovincial	Double Track
District, Township	Accession
Indian Reserve	Turbine
Appurtenance	Road
Lot, Concession	Highway, County
Appurtenance	Township
Park Boundary	Access (road of doubtful maintenance or significant driveway)
Bridge	Trail, Bush Road (portage, atlay)
Road, Railroad	Rapids
Building	Double line river with multiple rapids
Chimney	Double line river with multiple rapids
Cliff, Pit, Pile	Reservoir
Contours	River, Stream, Canal
Interpreted	Approximate
Approximate	Approximate
Depression	Approximate
Control Points	Approximate
Horizontal	Horizontal
Vertical	Vertical
Culvert	Culvert
Falls	Falls
Double line river	Double line river
Fence, Hedge, Wall	Fence, Hedge, Wall
Feature Outline (Constructive features, etc.)	Feature Outline (Constructive features, etc.)
Flooded Land	Flooded Land
Lock	Lock
Marsh or Swamp	Marsh or Swamp
Mast	Mast
Mine Head Frame	Mine Head Frame
Outcrop	Outcrop

AREAS WITHDRAWN FROM DISPOSITION

M.R.O. - MINING RIGHTS ONLY


S.R.O. - SURFACE RIGHTS ONLY

M.+S. - MINING AND SURFACE RIGHTS

Description	Order No.	Date	Disposition	File
NRW	3/83	MRO		

THE INFORMATION THAT APPEARS ON THIS MAP HAS BEEN COMPILED FROM VARIOUS SOURCES, AND ACCURACY IS NOT GUARANTEED. THOSE WISHING TO STAKE MINING CLAIMS SHOULD CONSULT WITH THE MINING RECORDER, MINISTRY OF NORTHERN DEVELOPMENT AND MINES, FOR ADDITIONAL INFORMATION ON THE STATUS OF THE LANDS SHOWN HEREON.

GOWAN TWP

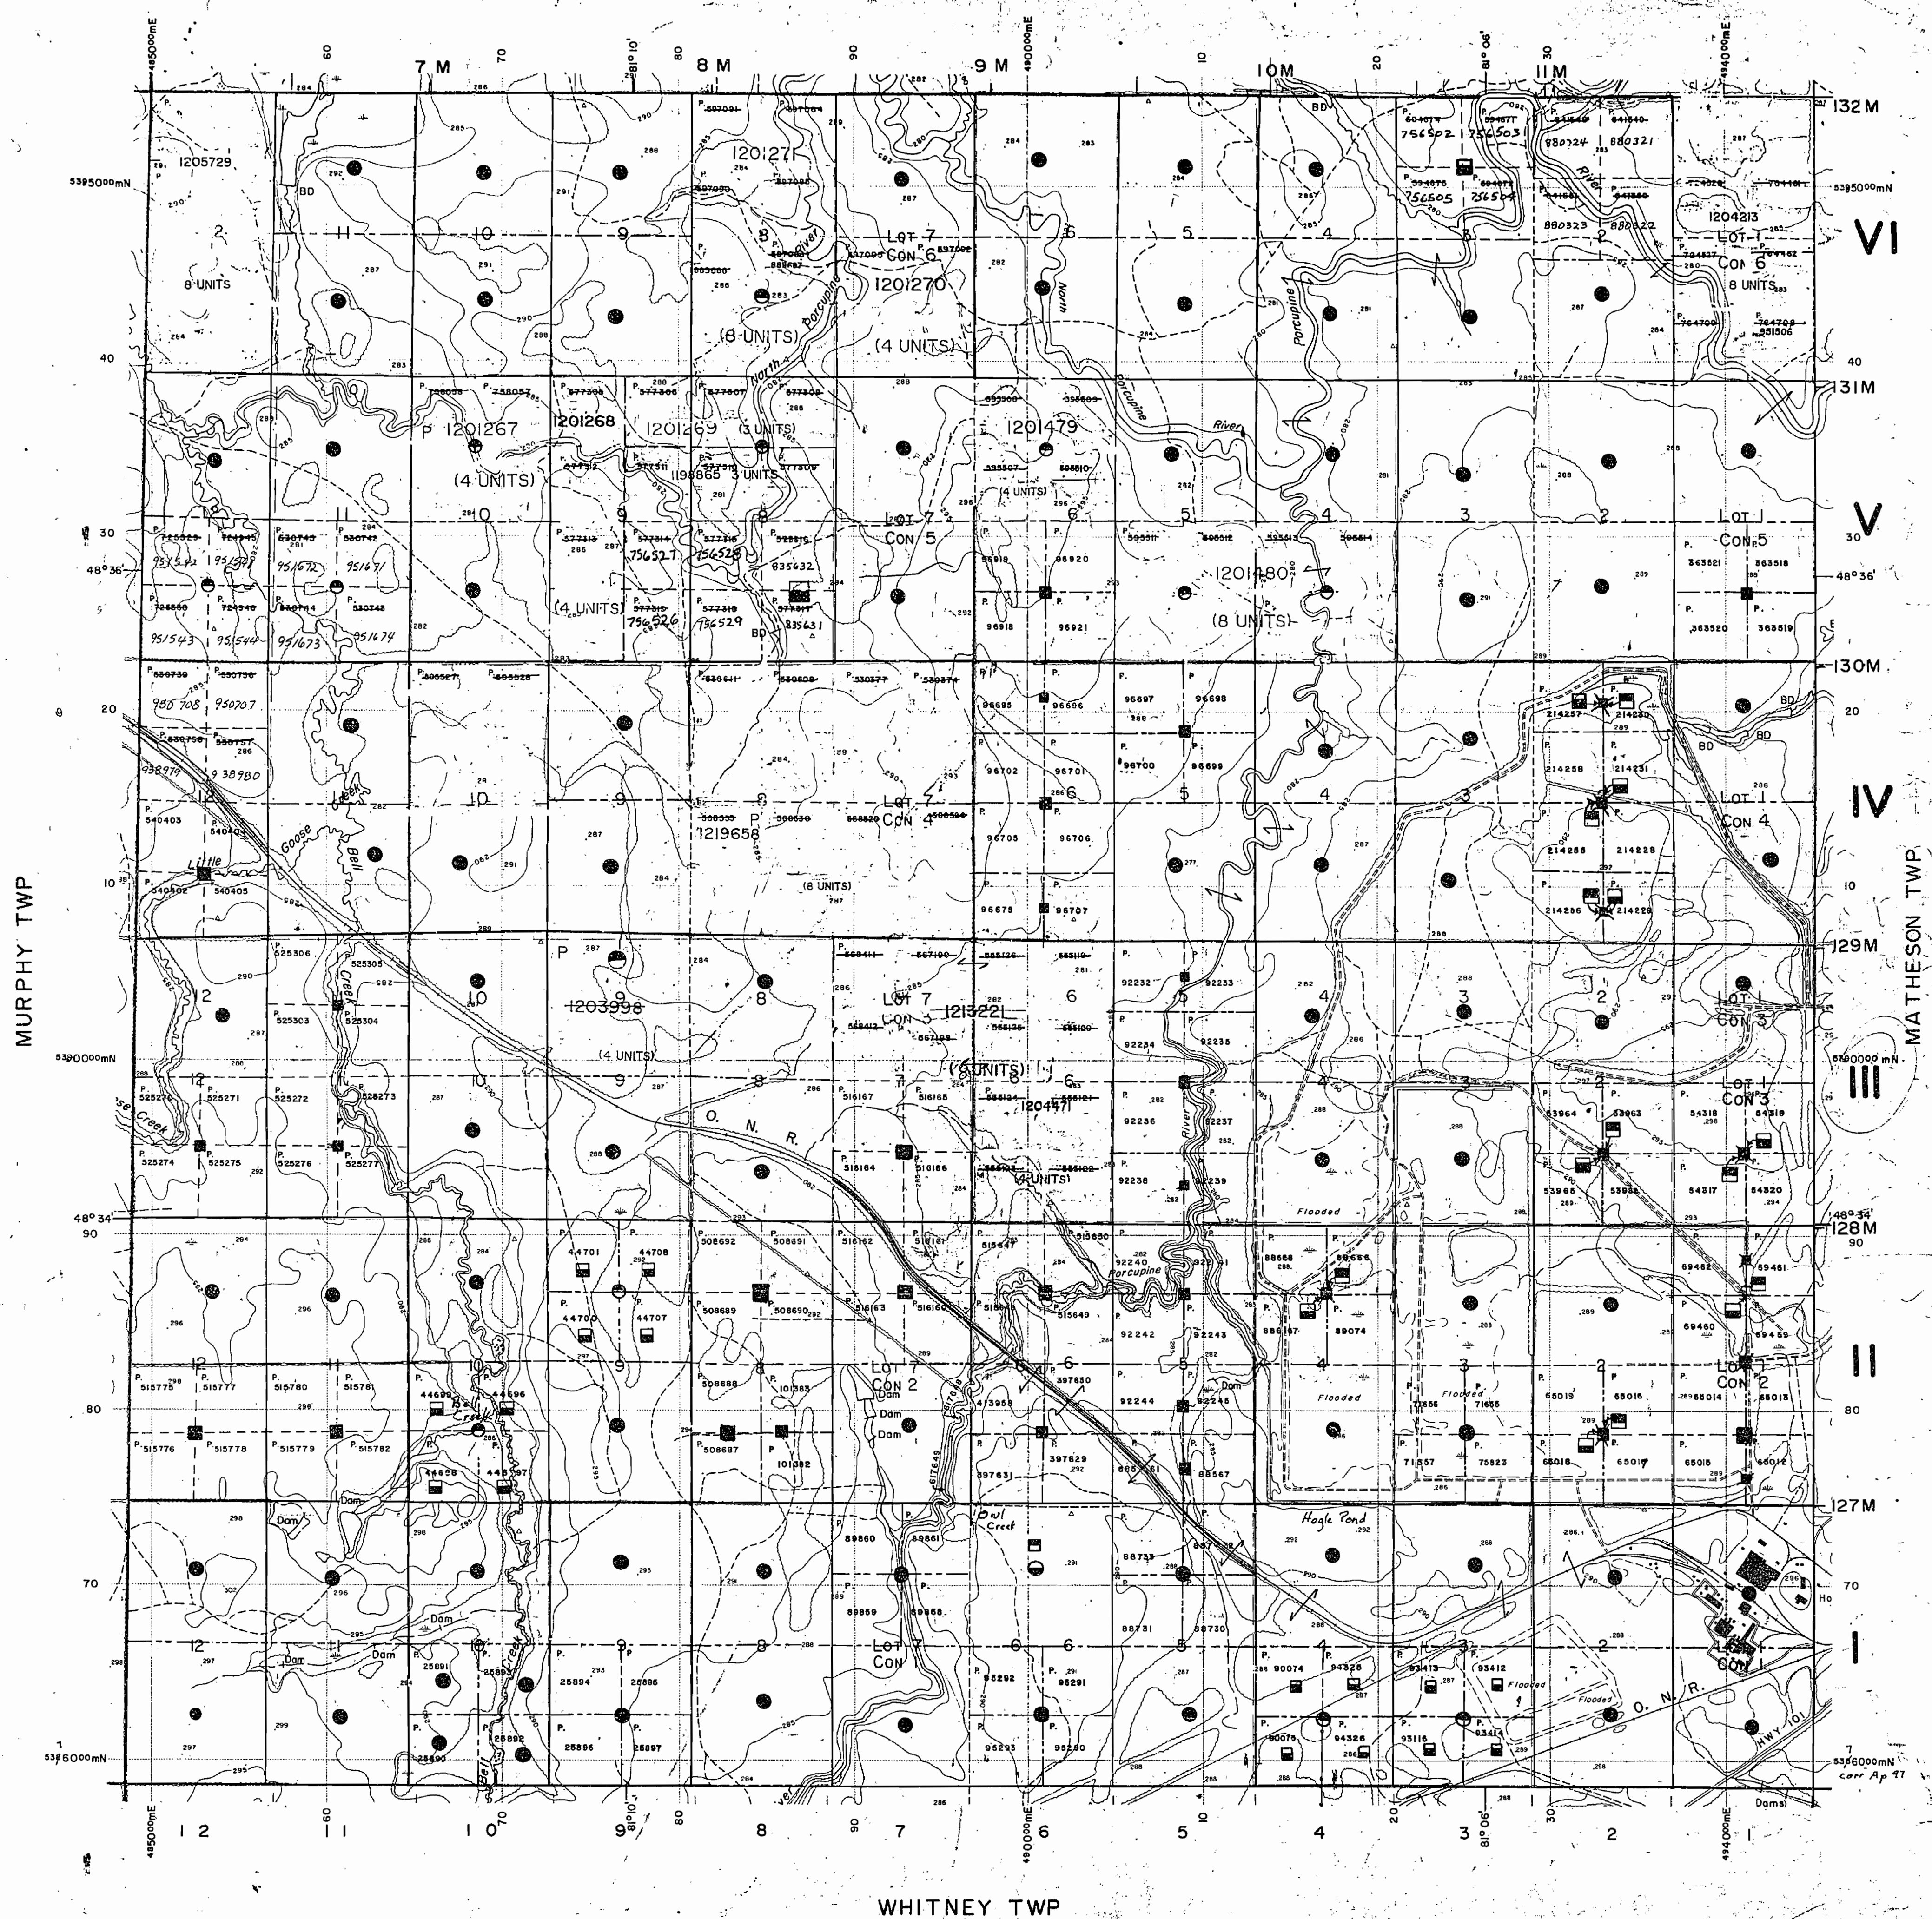


LEGEND

HIGHWAY AND ROUTE NO.	
OTHER ROADS	
TRAILS	
SURVEYED LINES:	
TOWNSHIPS, BASE LINES, ETC.	
LOTS, MINING CLAIMS, PARCELS, ETC.	
UNSURVEYED LINES:	
LOT LINES	
PARCEL BOUNDARY	
MINING CLAIMS ETC.	
RAILWAY AND RIGHT OF WAY	
UTILITY LINES	
NON-PERENNIAL STREAM	
FLOODING OR FLOODING RIGHTS	
SUBDIVISION OR COMPOSITE PLAN	
RESERVATIONS	
ORIGINAL SHORELINE	
MARSH OR MUSKEG	
MINES	
TRAVERSE MONUMENT	

DISPOSITION OF CROWN LANDS

TYPE OF DOCUMENT	SYMBOL
PATENT, SURFACE & MINING RIGHTS	
" SURFACE RIGHTS ONLY	
" MINING RIGHTS ONLY	
LEASE, SURFACE & MINING RIGHTS	
" SURFACE RIGHTS ONLY	
" MINING RIGHTS ONLY	
LICENCE OF OCCUPATION	
ORDER-IN-COUNCIL	
RESERVATION	
CANCELLED	
SAND & GRAVEL	

NOTE: MINING RIGHTS IN PARCELS PATENTED PRIOR TO MAY 6, 1912, VESTED IN ORIGINAL PATENTEE BY THE PUBLIC LANDS ACT, R.S.O. 1970, CHAP. 360, SEC. 62, SUBSEC. 1.

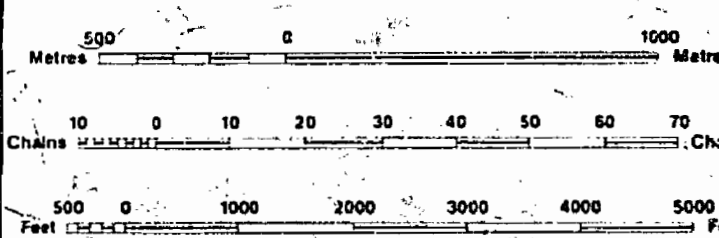

SCALE 1:20 000

GRID ZONE 17

NOTES

DATE OF ISSUE

AUG 14 1983

PROVINCIAL RECORDING OFFICE - SUDBURY

TOWNSHIP
HOYLE
M.N.R. ADMINISTRATIVE DISTRICT
TIMMINS
MINING DIVISION
PORCUPINE
LAND TITLES / REGISTRY DIVISION
COCHRANE

Ministry of Natural Resources
Land Management Branch
Ontario

ORIGINAL COMPILATION JULY 1984
REVISOR
Number
G-3987

MAP SYMBOLOLOGY


Aerial Cableway	Pipeline (above ground)
Boundary	Railroad
International	Single Track
Interprovincial	Double Track
Distress, Township	Abandoned
Indian Reserve	Turbidity
Approximate	Road
Lot, Concession	Highway, County
Approximate	Township
Port Boundary	Access (road of doubtful maintenance or navigational driveway)
Bridge	Trail, Bush Road (outage, alley)
Road, Railroad	Rapids
Building	Double line river with multiple rapids
Chimney	Double line river with multiple rapids
Cliff, Pit, Pile	Reservoir
Contours	River, Stream, Canal
Interpretation	Approximate (dashed)
Approximate	Direction of flow
Depression	Rock
Control Points	Spot Elevation (true elevations) -300.0
Horizontal	Tower
Vertical	Transmission Line
Culvert	Pole
Falls	Pylon
Double line river	Tunnel
Fence, Hedge, Wall	Utility Poles
Feature Outline (Construction features, etc.)	Wharf, Dock, Pier
Flooded Land	Wooded Area
Lock	
Marsh or Swamp	
Mast	
Mine Head Frame	
Outcrop	


AREAS WITHDRAWN FROM DISPOSITION

M.R.O. - MINING RIGHTS ONLY				
S.R.O. - SURFACE RIGHTS ONLY				
M.+ S. - MINING AND SURFACE RIGHTS				
Description	Order No.	Date	Disposition	File
NRW		3/83	MRO	

THE INFORMATION THAT APPEARS ON THIS MAP HAS BEEN COMPILED FROM VARIOUS SOURCES AND ACCURACY IS NOT GUARANTEED. THOSE WISHING TO STAKE MINING CLAIMS SHOULD CONSULT WITH THE MINING RECORDER, MINISTRY OF NORTHERN DEVELOPMENT AND MINES, FOR ADDITIONAL INFORMATION ON THE STATUS OF THE LANDS SHOWN HEREON.

GOWAN TWP

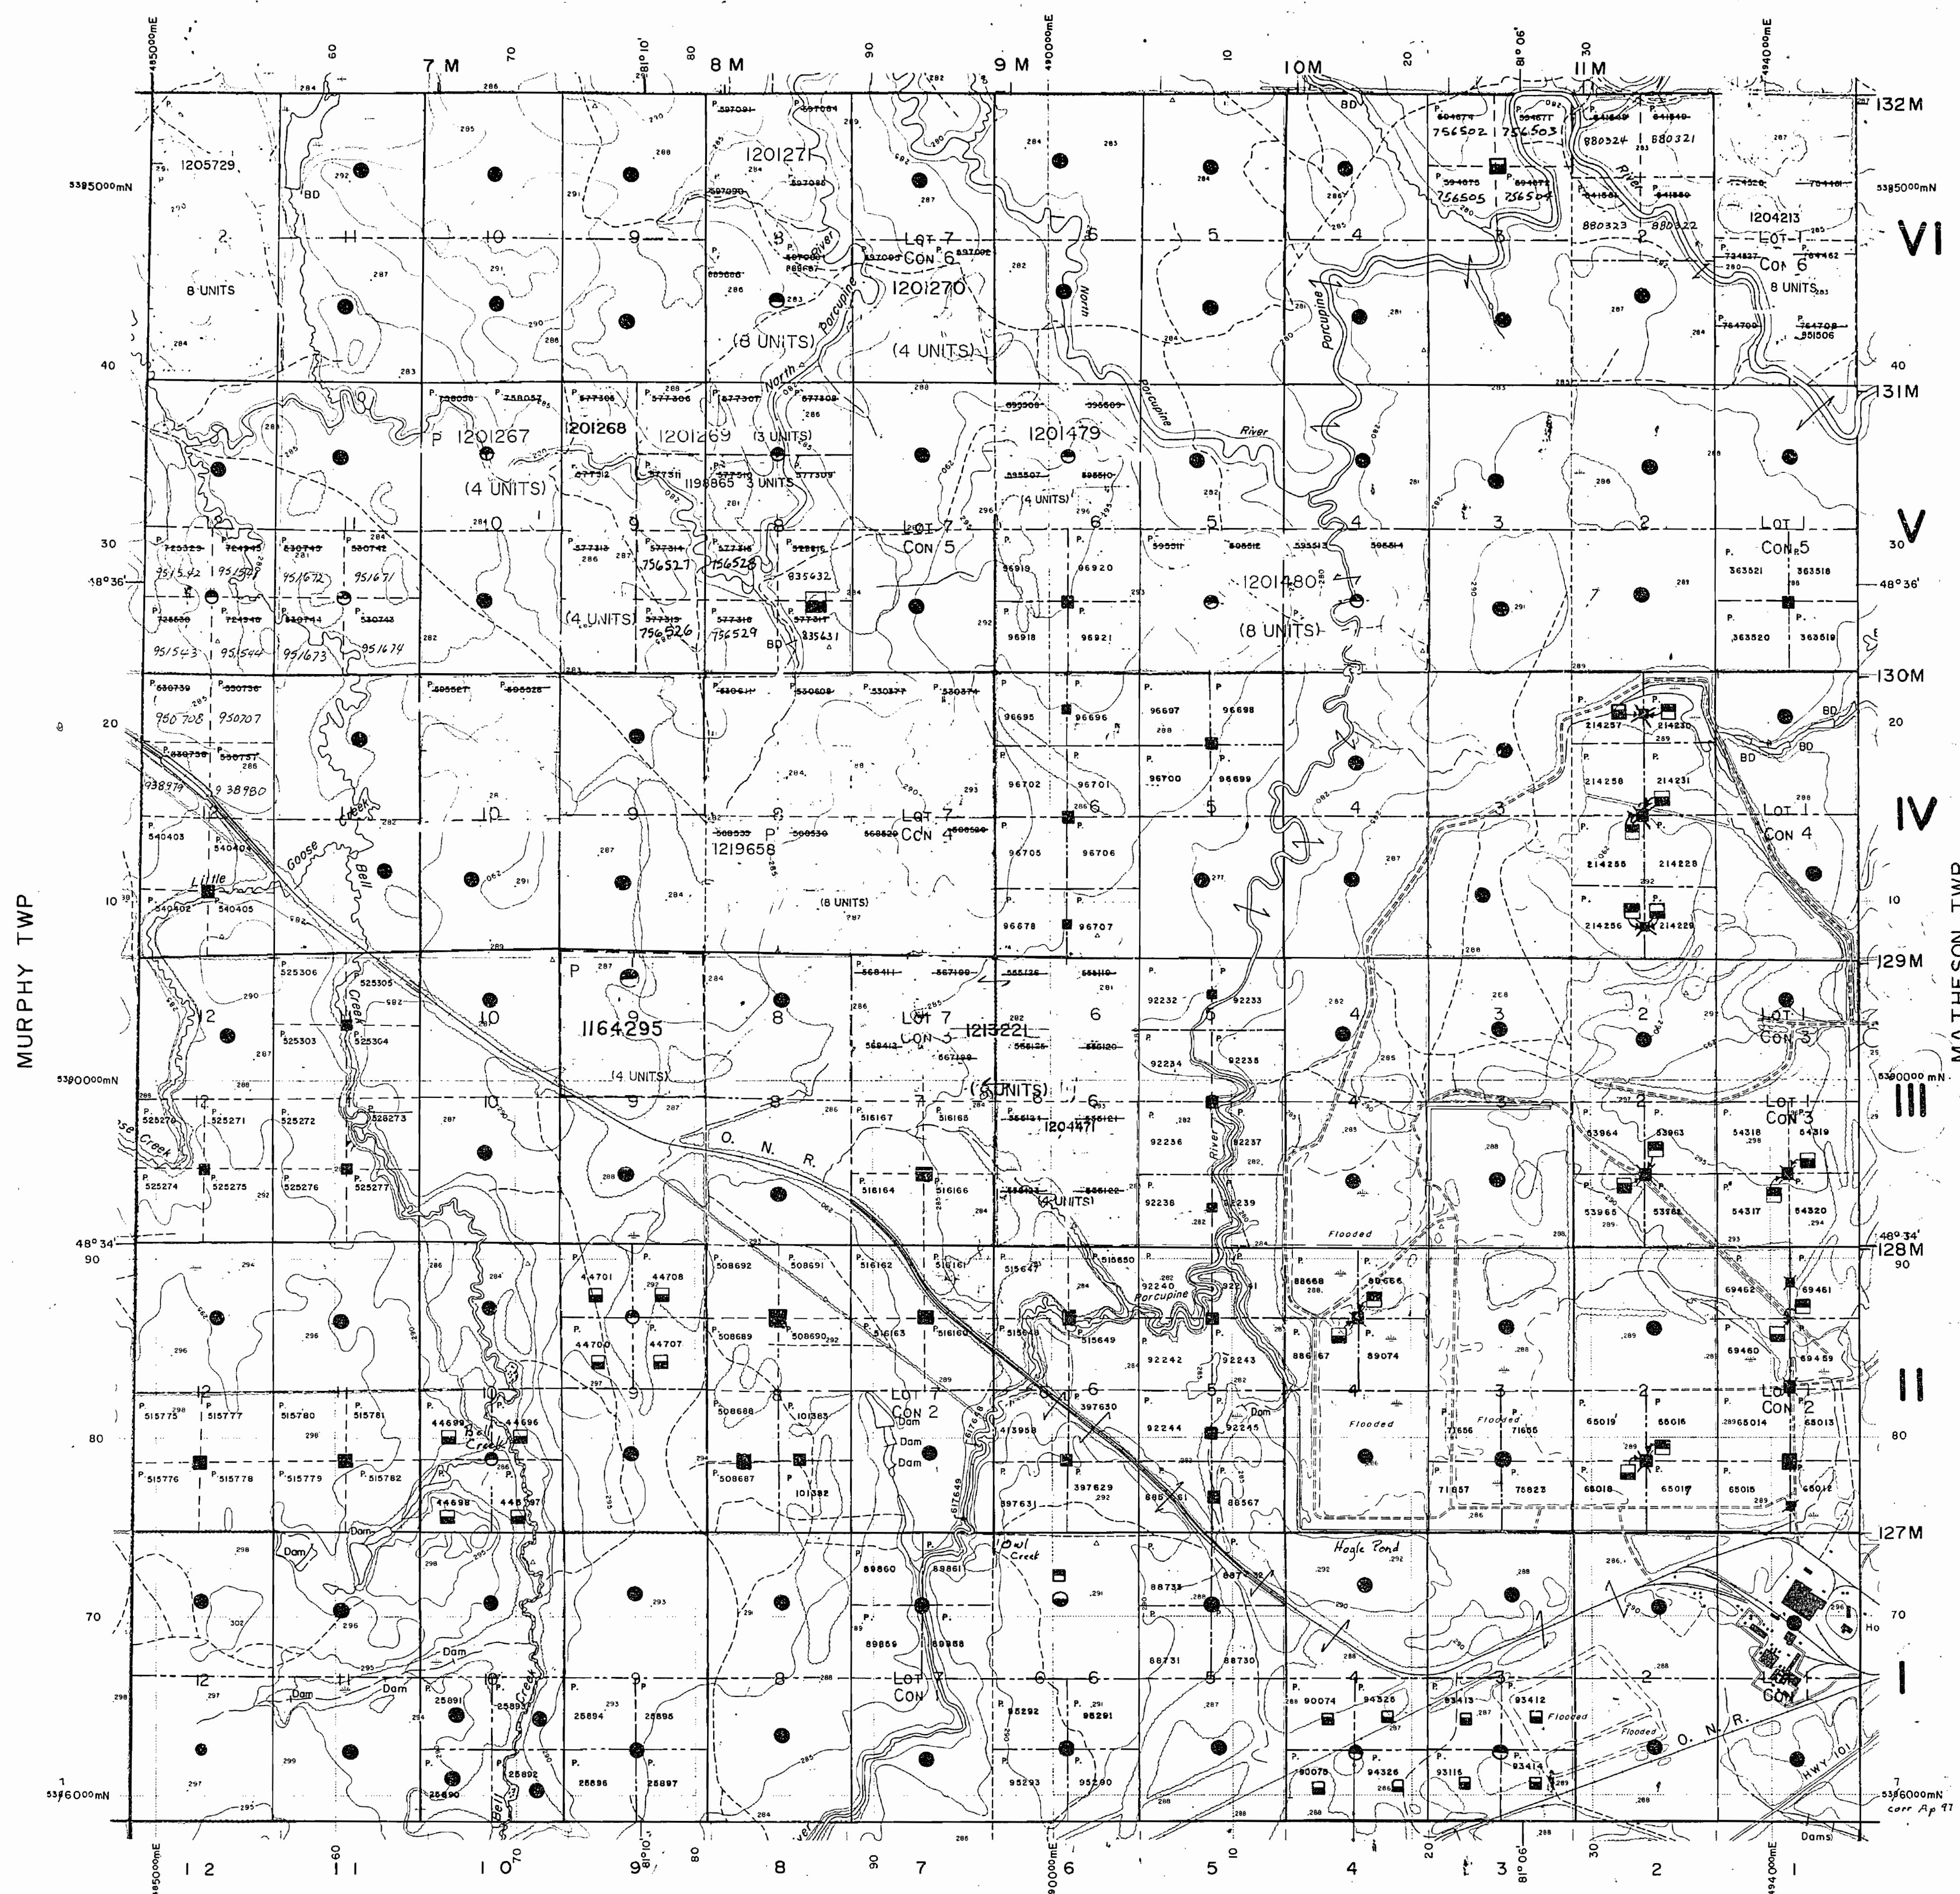

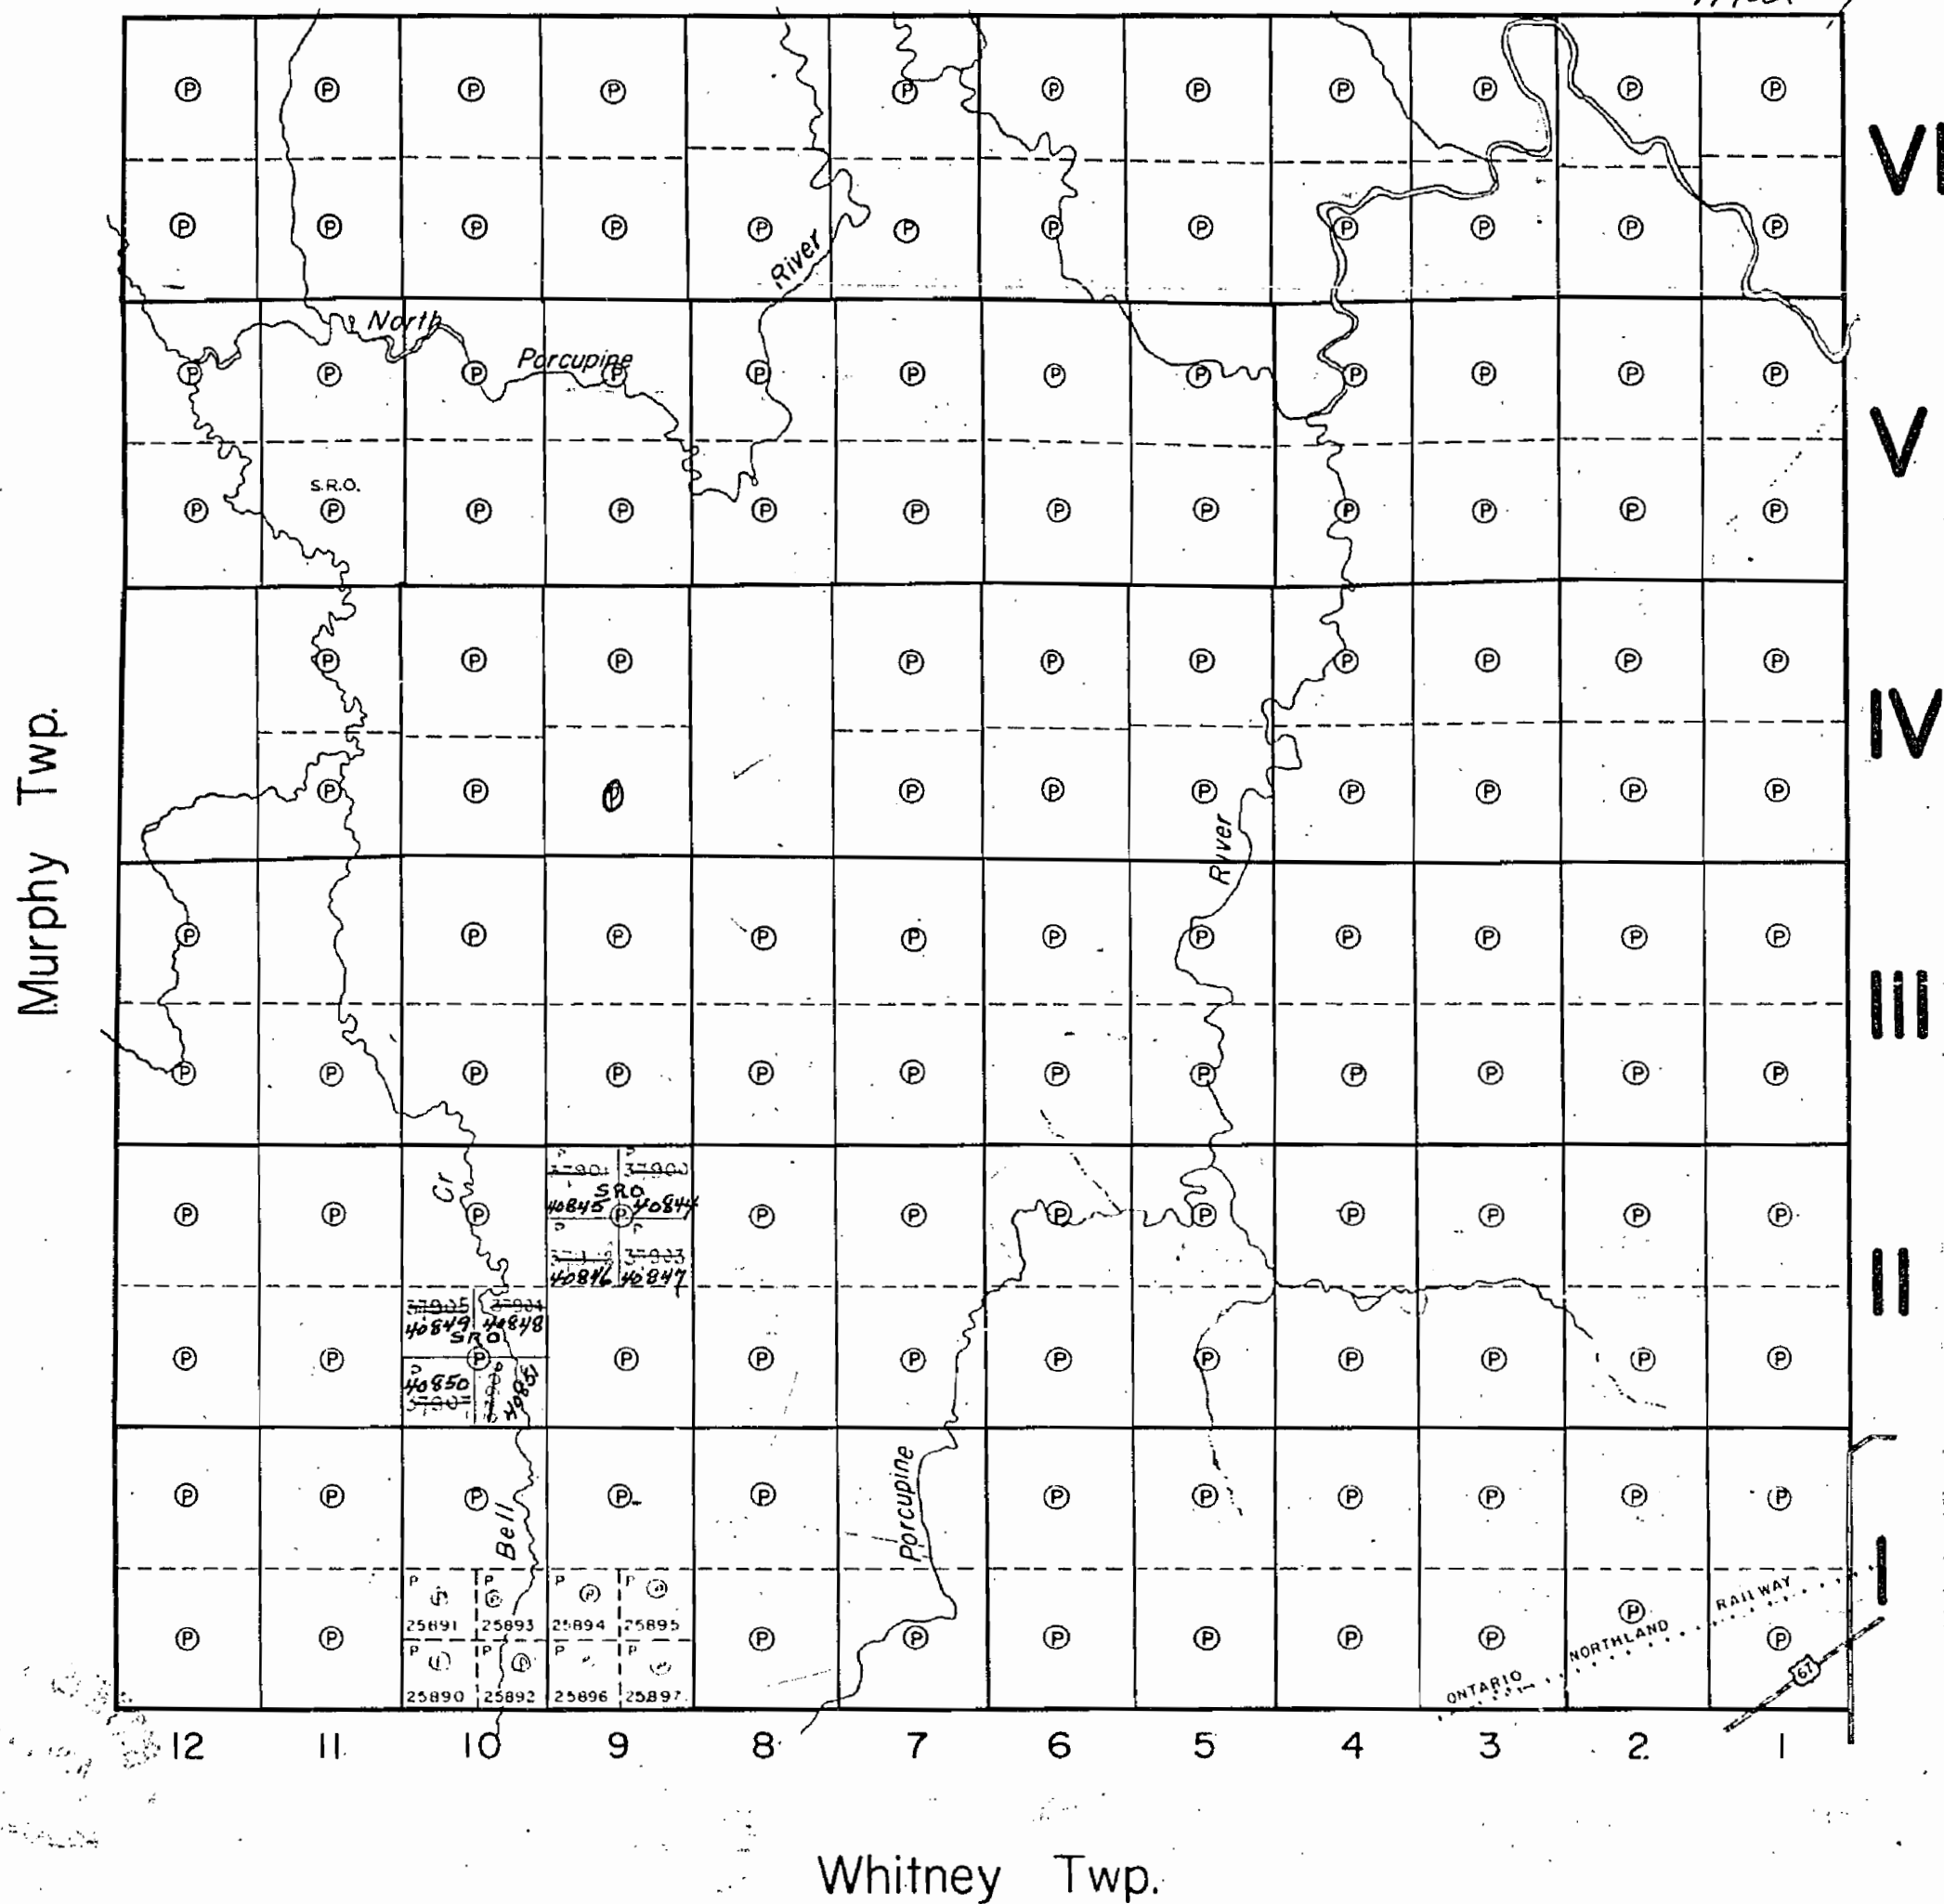

287

HOYLE


PORCUPINE MINING DIVISION

SCALE 40 CHAINS = 1 INCH.

M-287

GOWAN

MURPHY

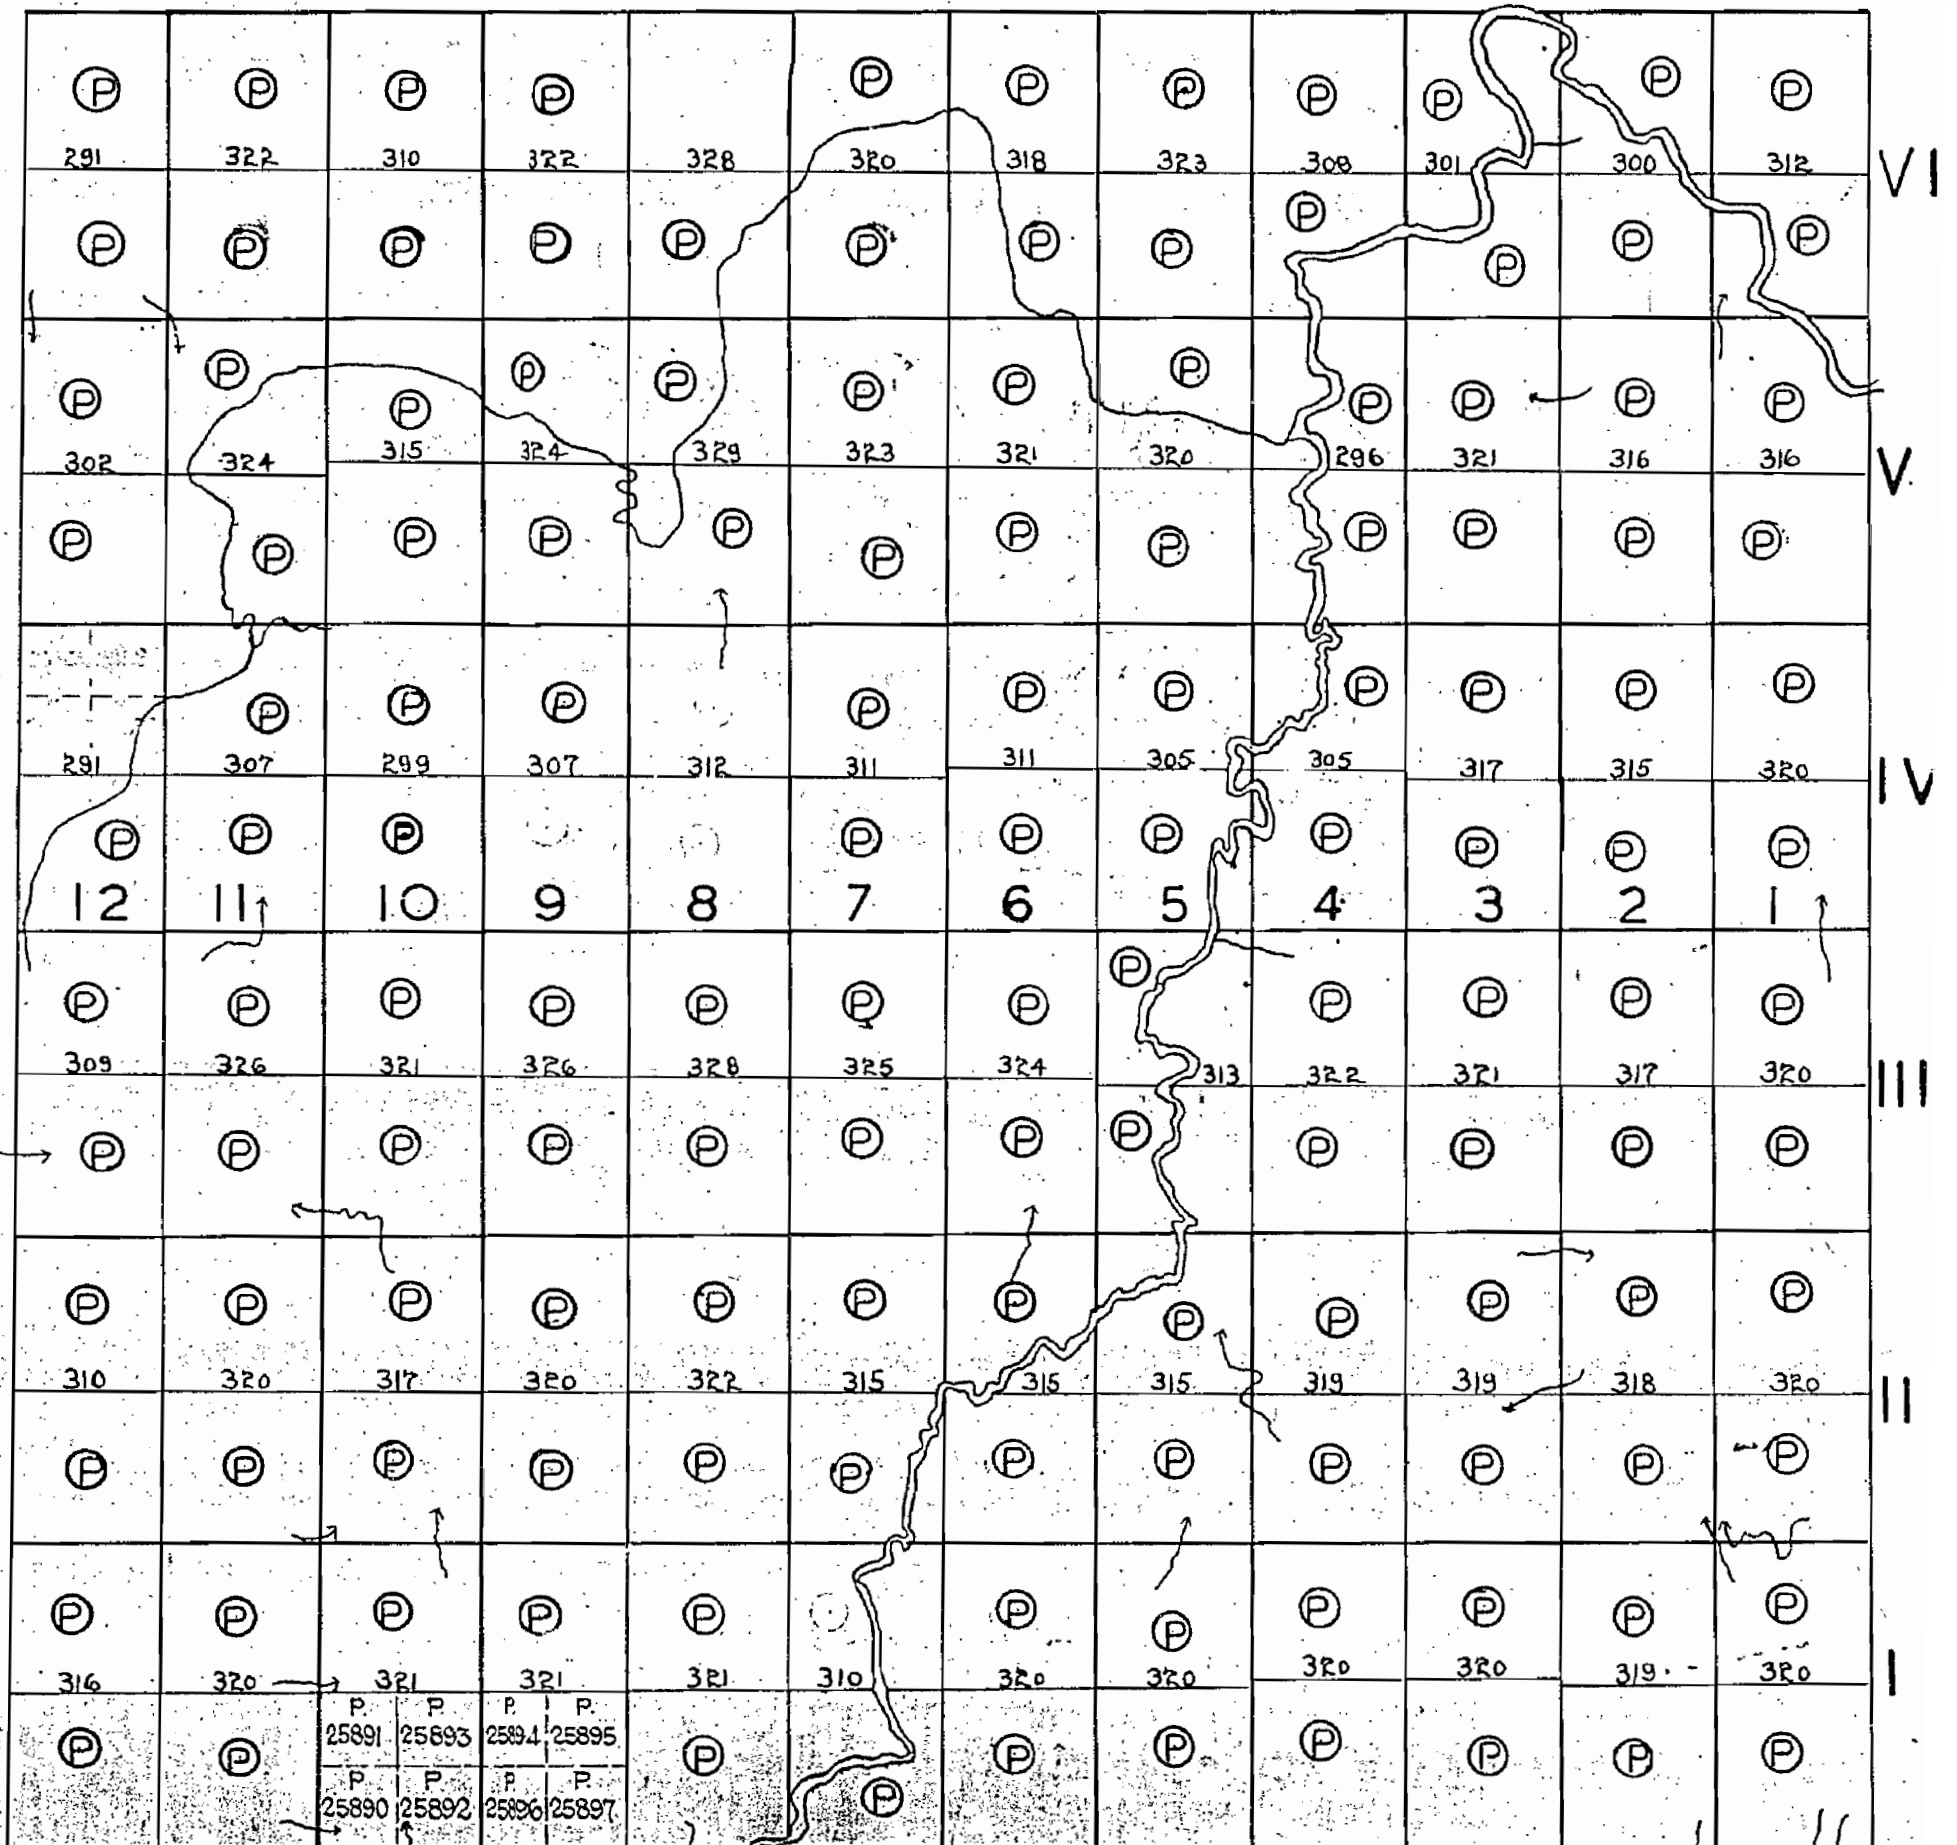

WHITNEY

287

Gowan Twp.

THE TOWNSHIP
OF**HOYLE**DISTRICT OF
COCHRANEPORCUPINE
MINING DIVISION

SCALE: 1-INCH = 40 CHAINS


LEGEND

PATENTED LAND	Ⓟ
CROWN LAND SALE	Ⓢ or Ⓞ
LEASES	Ⓞ
LOCATED LAND	Loc.
LICENSE OF OCCUPATION	L.O.
MINING RIGHTS ONLY	M.R.O.
SURFACE RIGHTS ONLY	S.R.O.
ROADS	—
IMPROVED ROADS	—
KING'S HIGHWAYS	—
RAILWAYS	—
POWER LINES	—
MARSH OR MUSKEG	—
MINES	✱

NOTESM.R.
ON N¹/₂ - Lot 8 - Con. 5. Open.

Murphy Twp.

Matheson Twp.

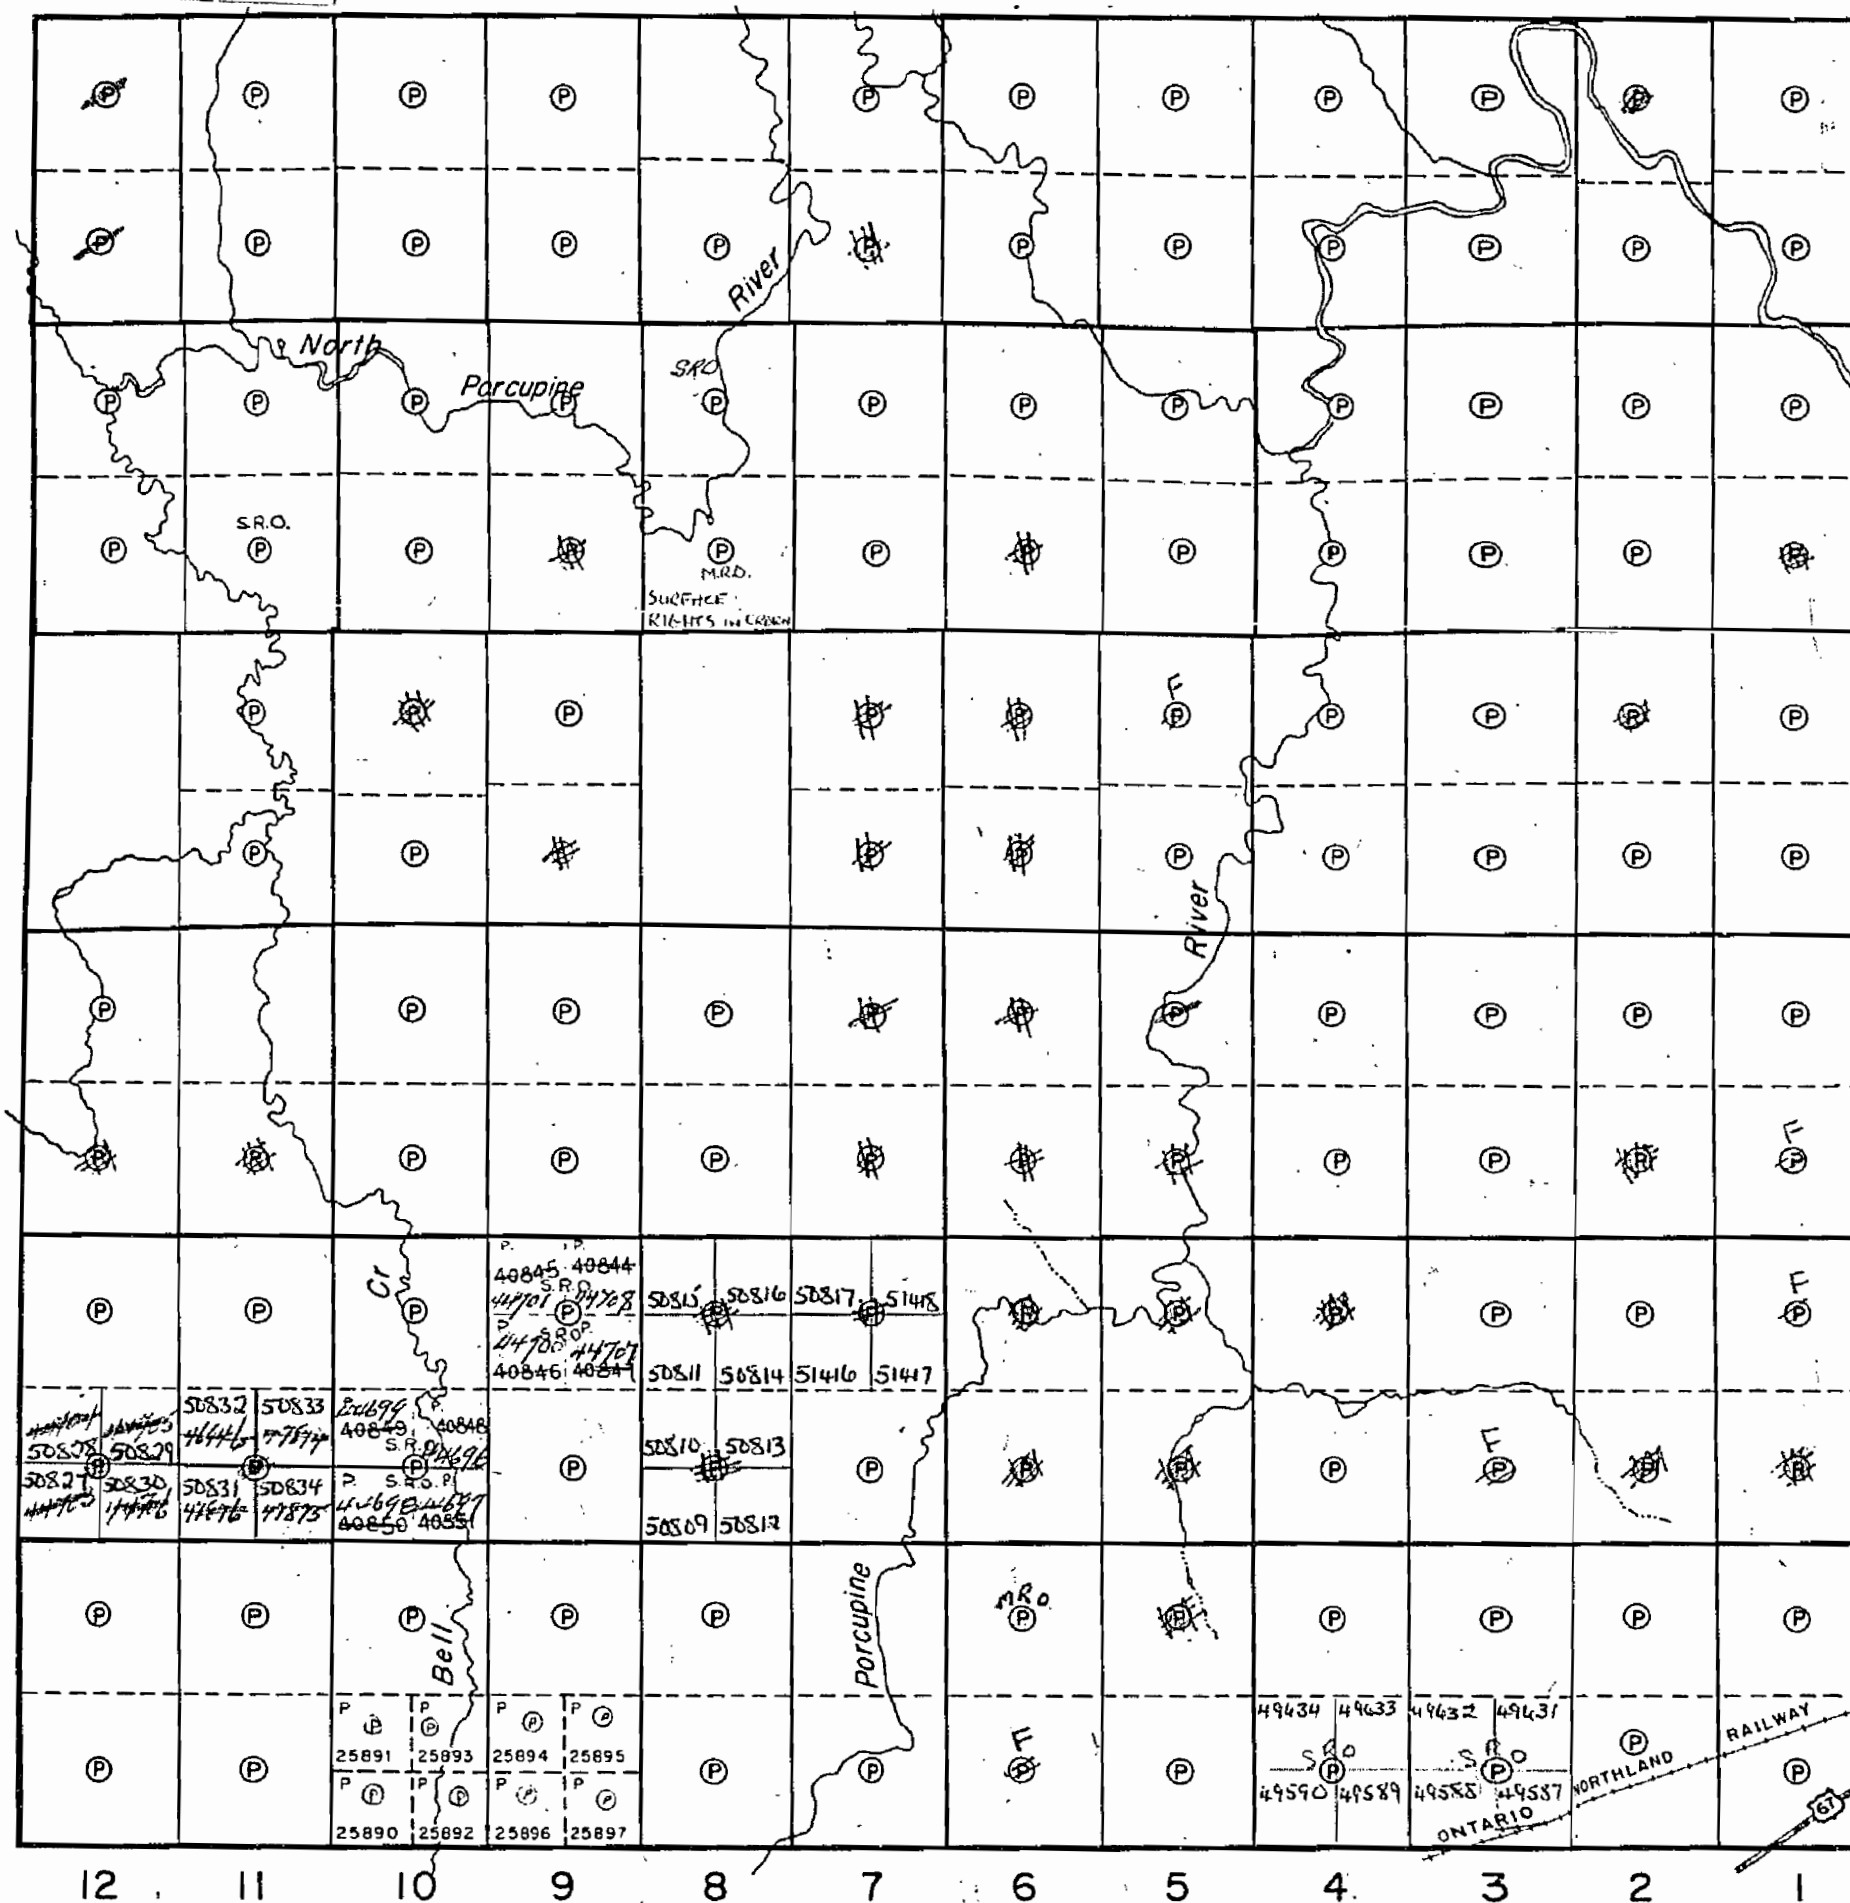

Whitney Twp.

PLAN NO.- M. 287

DEPARTMENT OF MINES
—ONTARIO—

287

Gowan Twp.

THE TOWNSHIP
OF

HOYLE

DISTRICT OF
COCHRANEPORCUPINE
MINING DIVISION

SCALE: 1-INCH = 40 CHAINS

LEGEND

PATENTED LAND	Ⓟ
CROWN LAND SALE	Ⓢ or Ⓞ
LEASES	Ⓞ
LOCATED LAND	Loc.
LICENSE OF OCCUPATION	L.O.
MINING RIGHTS ONLY	M.R.O.
SURFACE RIGHTS ONLY	S.R.O.
ROADS	—
IMPROVED ROADS	—
KING'S HIGHWAYS	—
RAILWAYS	—
POWER LINES	—
MARSH OR MUSKEG	—
MINES	✕

NOTES

MINING RECORDER
RECEIVED
FEB 15 1962PORCUPINE
MINING DIVISION


PLAN NO.- M. 287

DEPARTMENT OF MINES
—ONTARIO—

Murphy Twp.

Matheson Twp.

Whitney Twp.

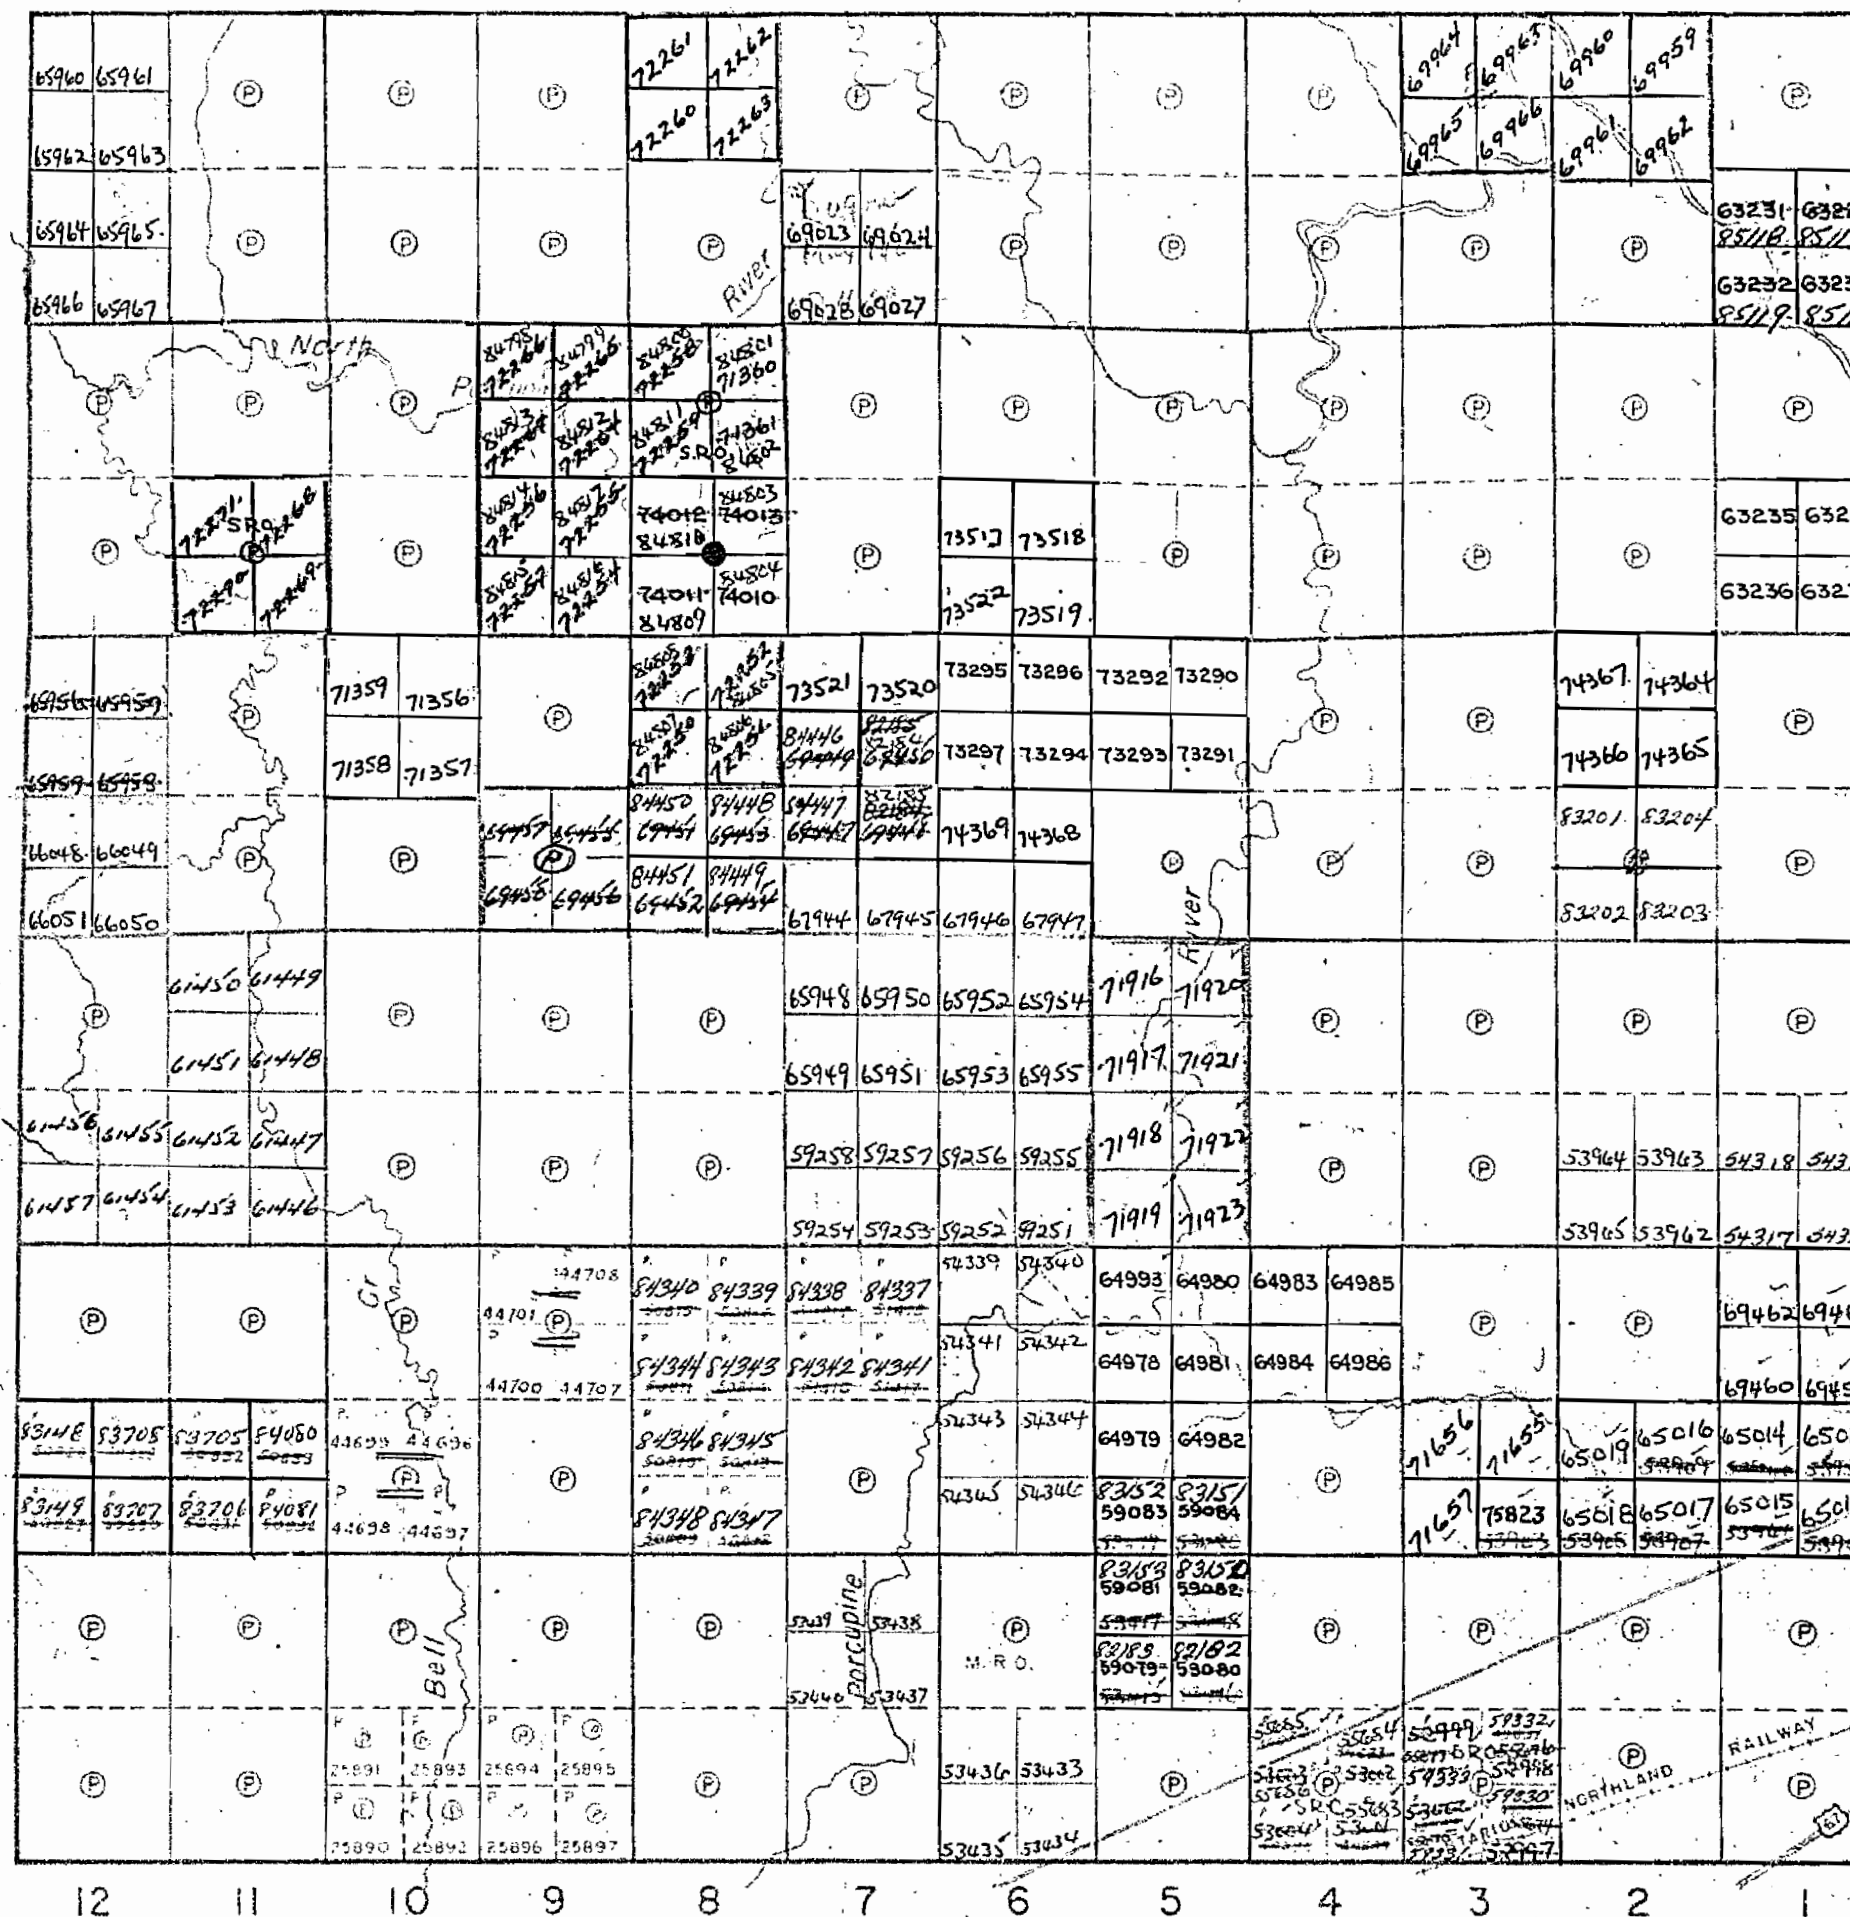

VI

V

IV

III

II

I

287

Gowan Twp.

THE TOWNSHIP
OF

HOYLE

DISTRICT OF
GOCHANEPORCUPINE
MINING DIVISION

SCALE: 1-INCH=40 CHAINS


LEGEND

PATENTED LAND	Ⓟ
CROWN LAND SALE	Ⓢ or Ⓞ
LEASES	Ⓢ or Ⓞ
LOCATED LAND	Loc.
LICENSE OF OCCUPATION	L.O.
MINING RIGHTS ONLY	M.R.O.
SURFACE RIGHTS ONLY	S.R.O.
ROADS	—
IMPROVED ROADS	—
KING'S HIGHWAYS	—
RAILWAYS	—
POWER LINES	—
MARSH OR MUSKEG	—
MINES	—

NOTES

400' Surface rights reservation around all lakes and rivers.

No disposition of sand & gravel from May 8th, 1964 until further notice

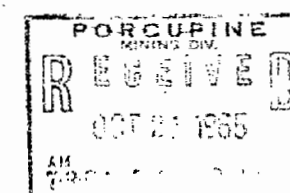


PLAN NO.- M.287

DEPARTMENT OF MINES
—ONTARIO—


Murphy Twp.

Matheson Twp.

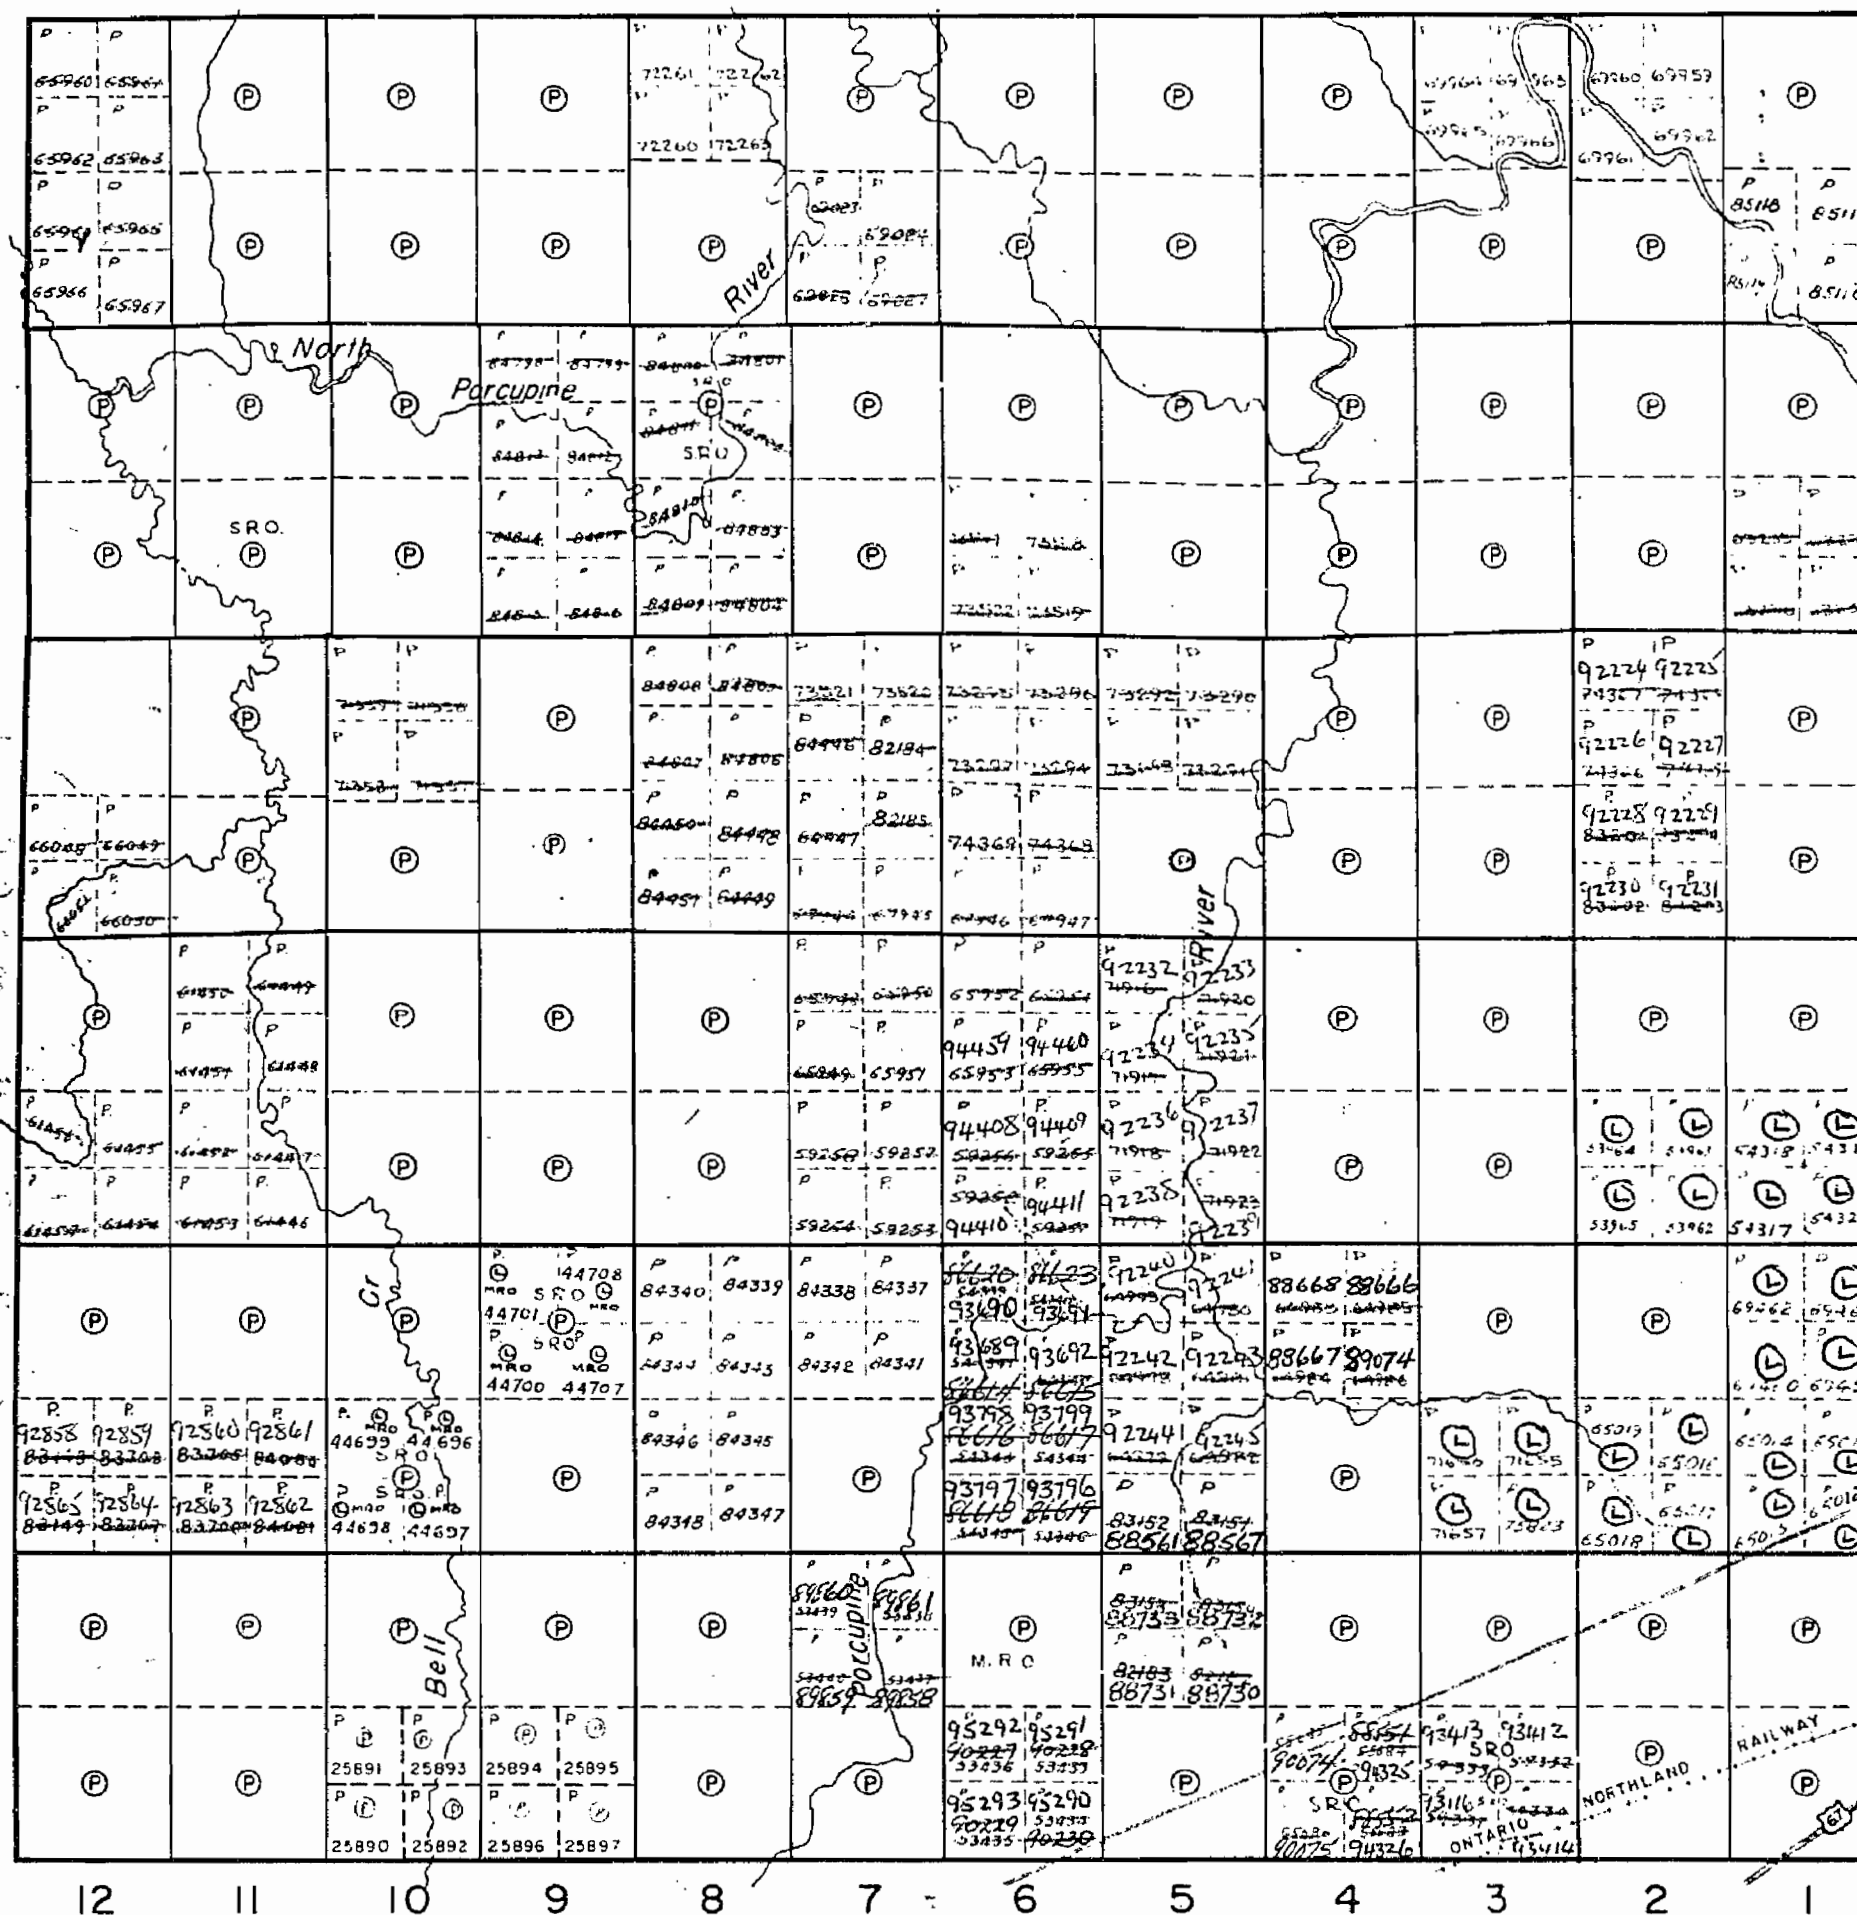

Whitney Twp.

Gowan Twp.

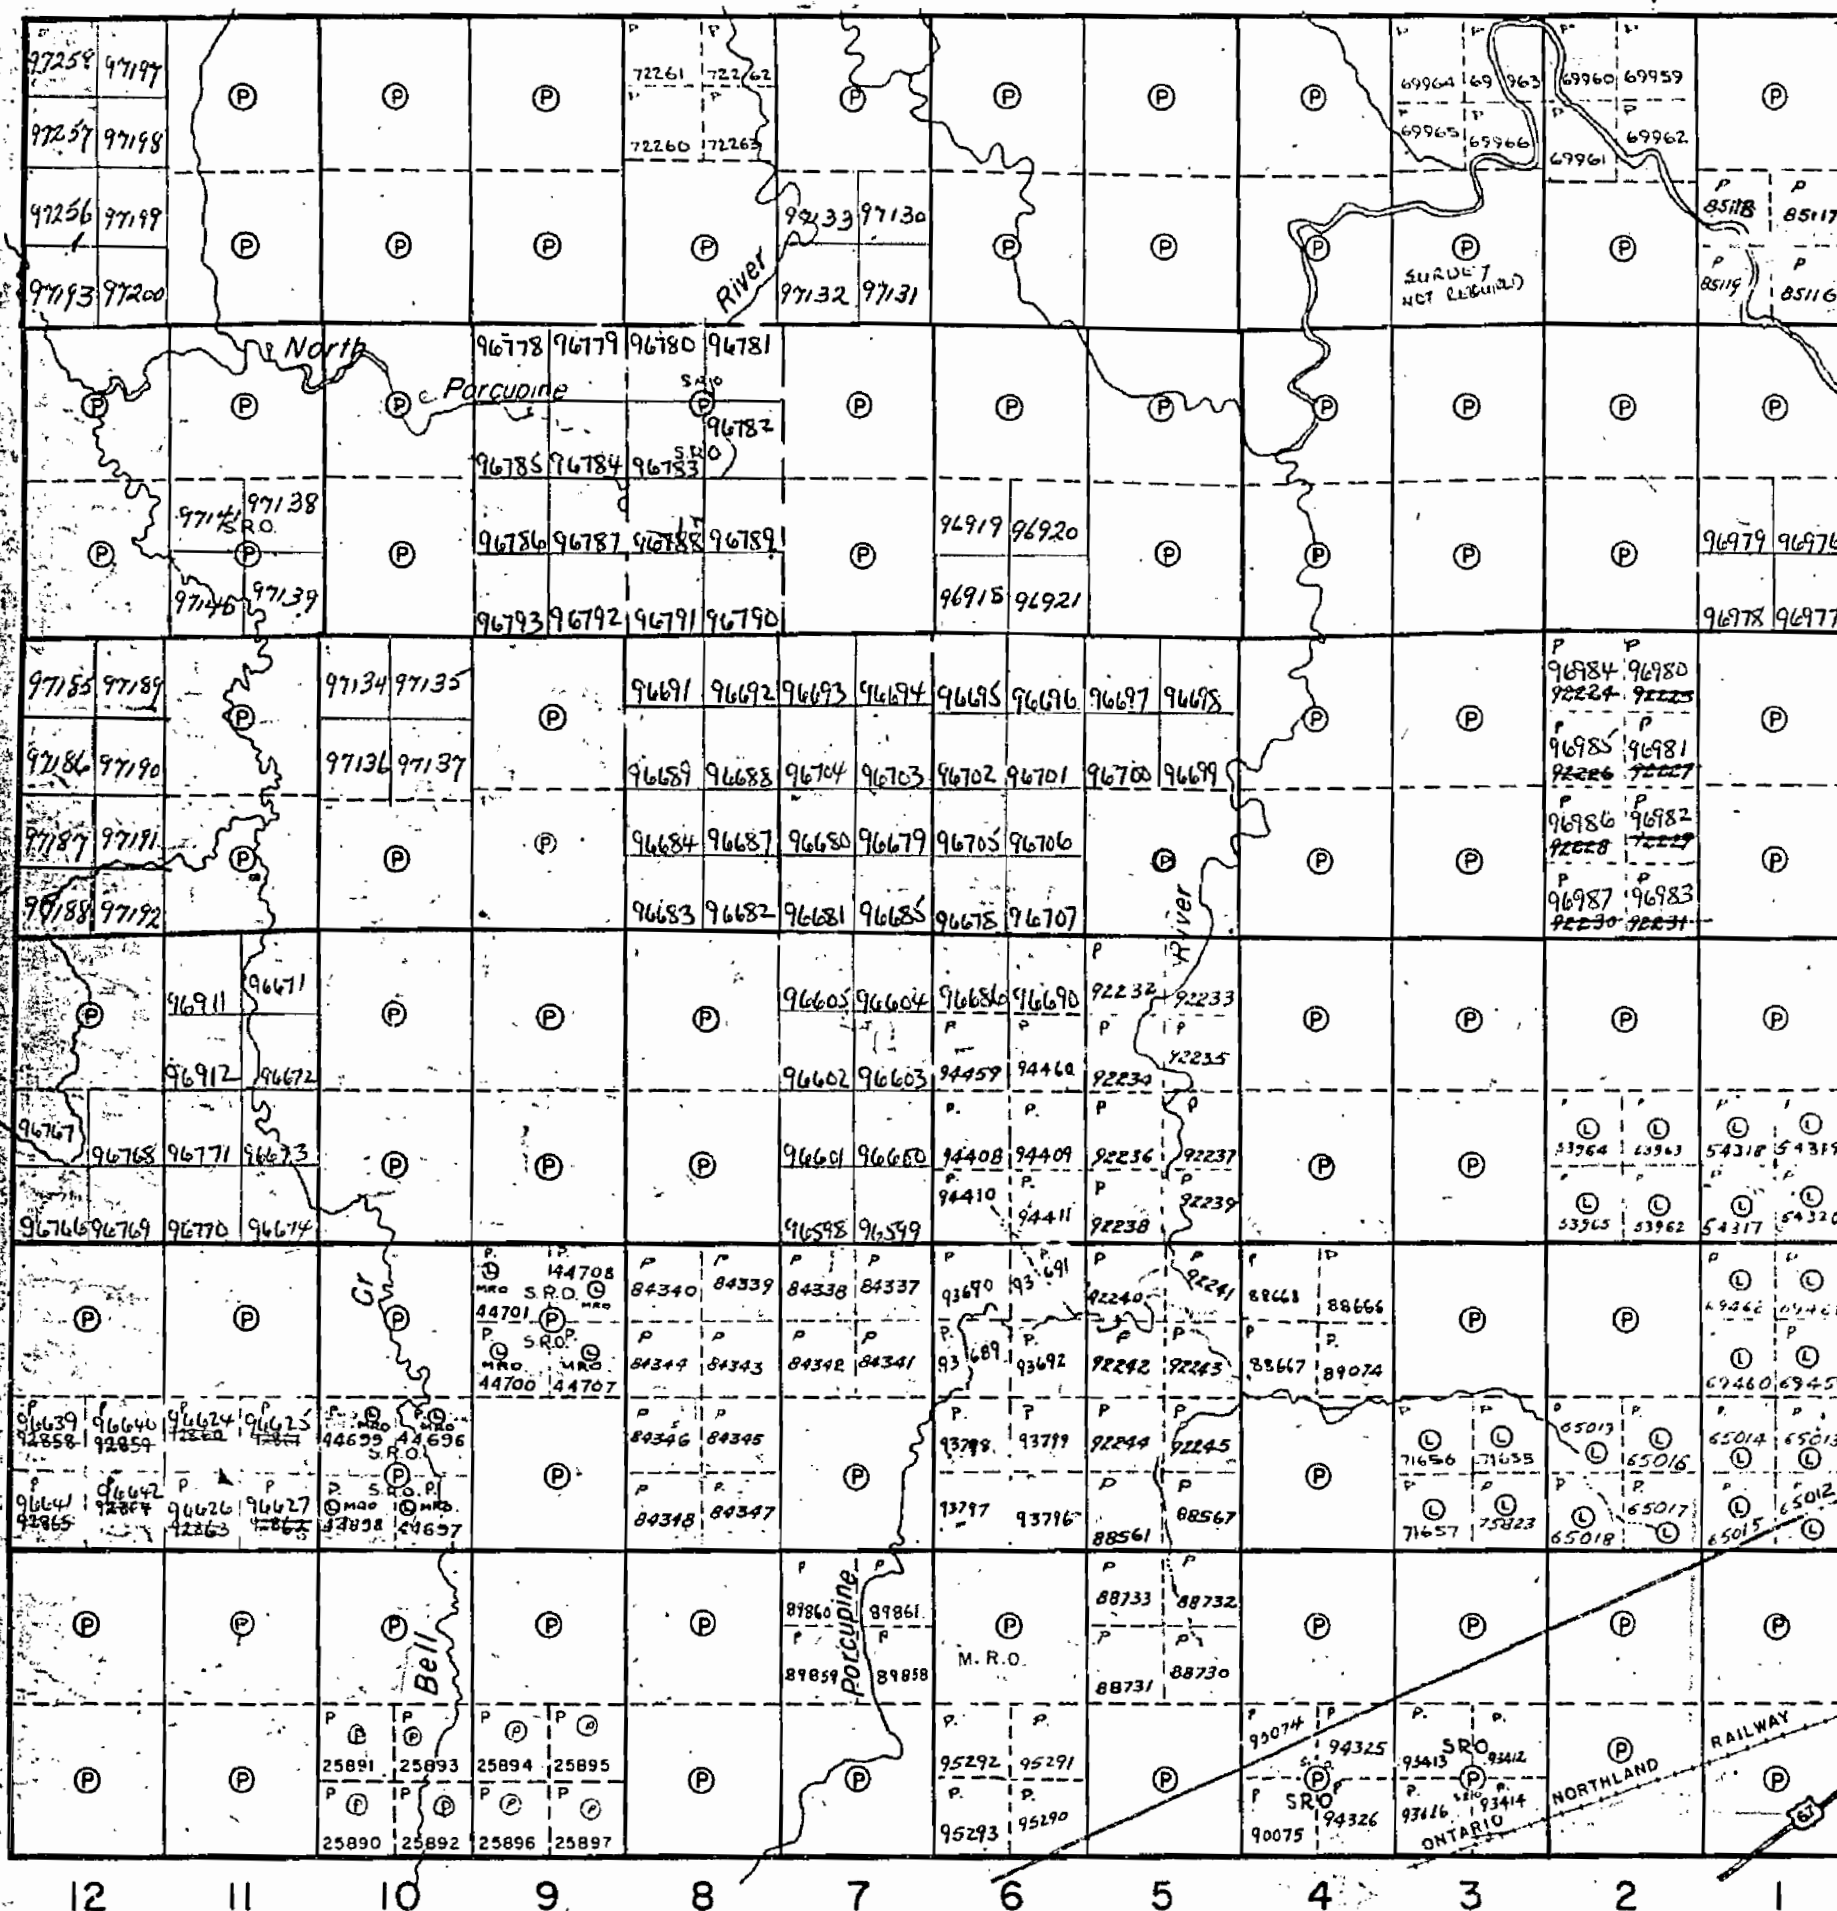

Whitney Twp.

THE TOWNSHIP
OF

HOYLE

DISTRICT OF
COCHRANE

PORCUPINE
MINING DIVISION

SCALE: 1-INCH = 40 CHAINS

LEGEND


PATENTED LAND (P)
CROWN LAND SALE (S) or C.S.
LEASES (L)
LOCATED LAND Loc.
LICENSE OF OCCUPATION L.O.
MINING RIGHTS ONLY M.R.O.
SURFACE RIGHTS ONLY S.R.O.
ROADS
IMPROVED ROADS
KING'S HIGHWAYS
RAILWAYS
POWER LINES
MARSH OR MUSKEG
MINES

NOTES

400' Surface rights reservation around all lakes and rivers

No disposition of sand & gravel from May 8th, 1964
until further notice

CLAIMS IN YELLOW REQUIRE SURVEY.

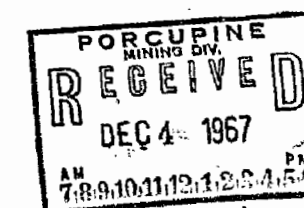


PLÂN NO.- M. 287

DEPARTMENT OF MINES
—ONTARIO—

287

GOWAN TWP. (M.285)

MURPHY TWP. (M.303)

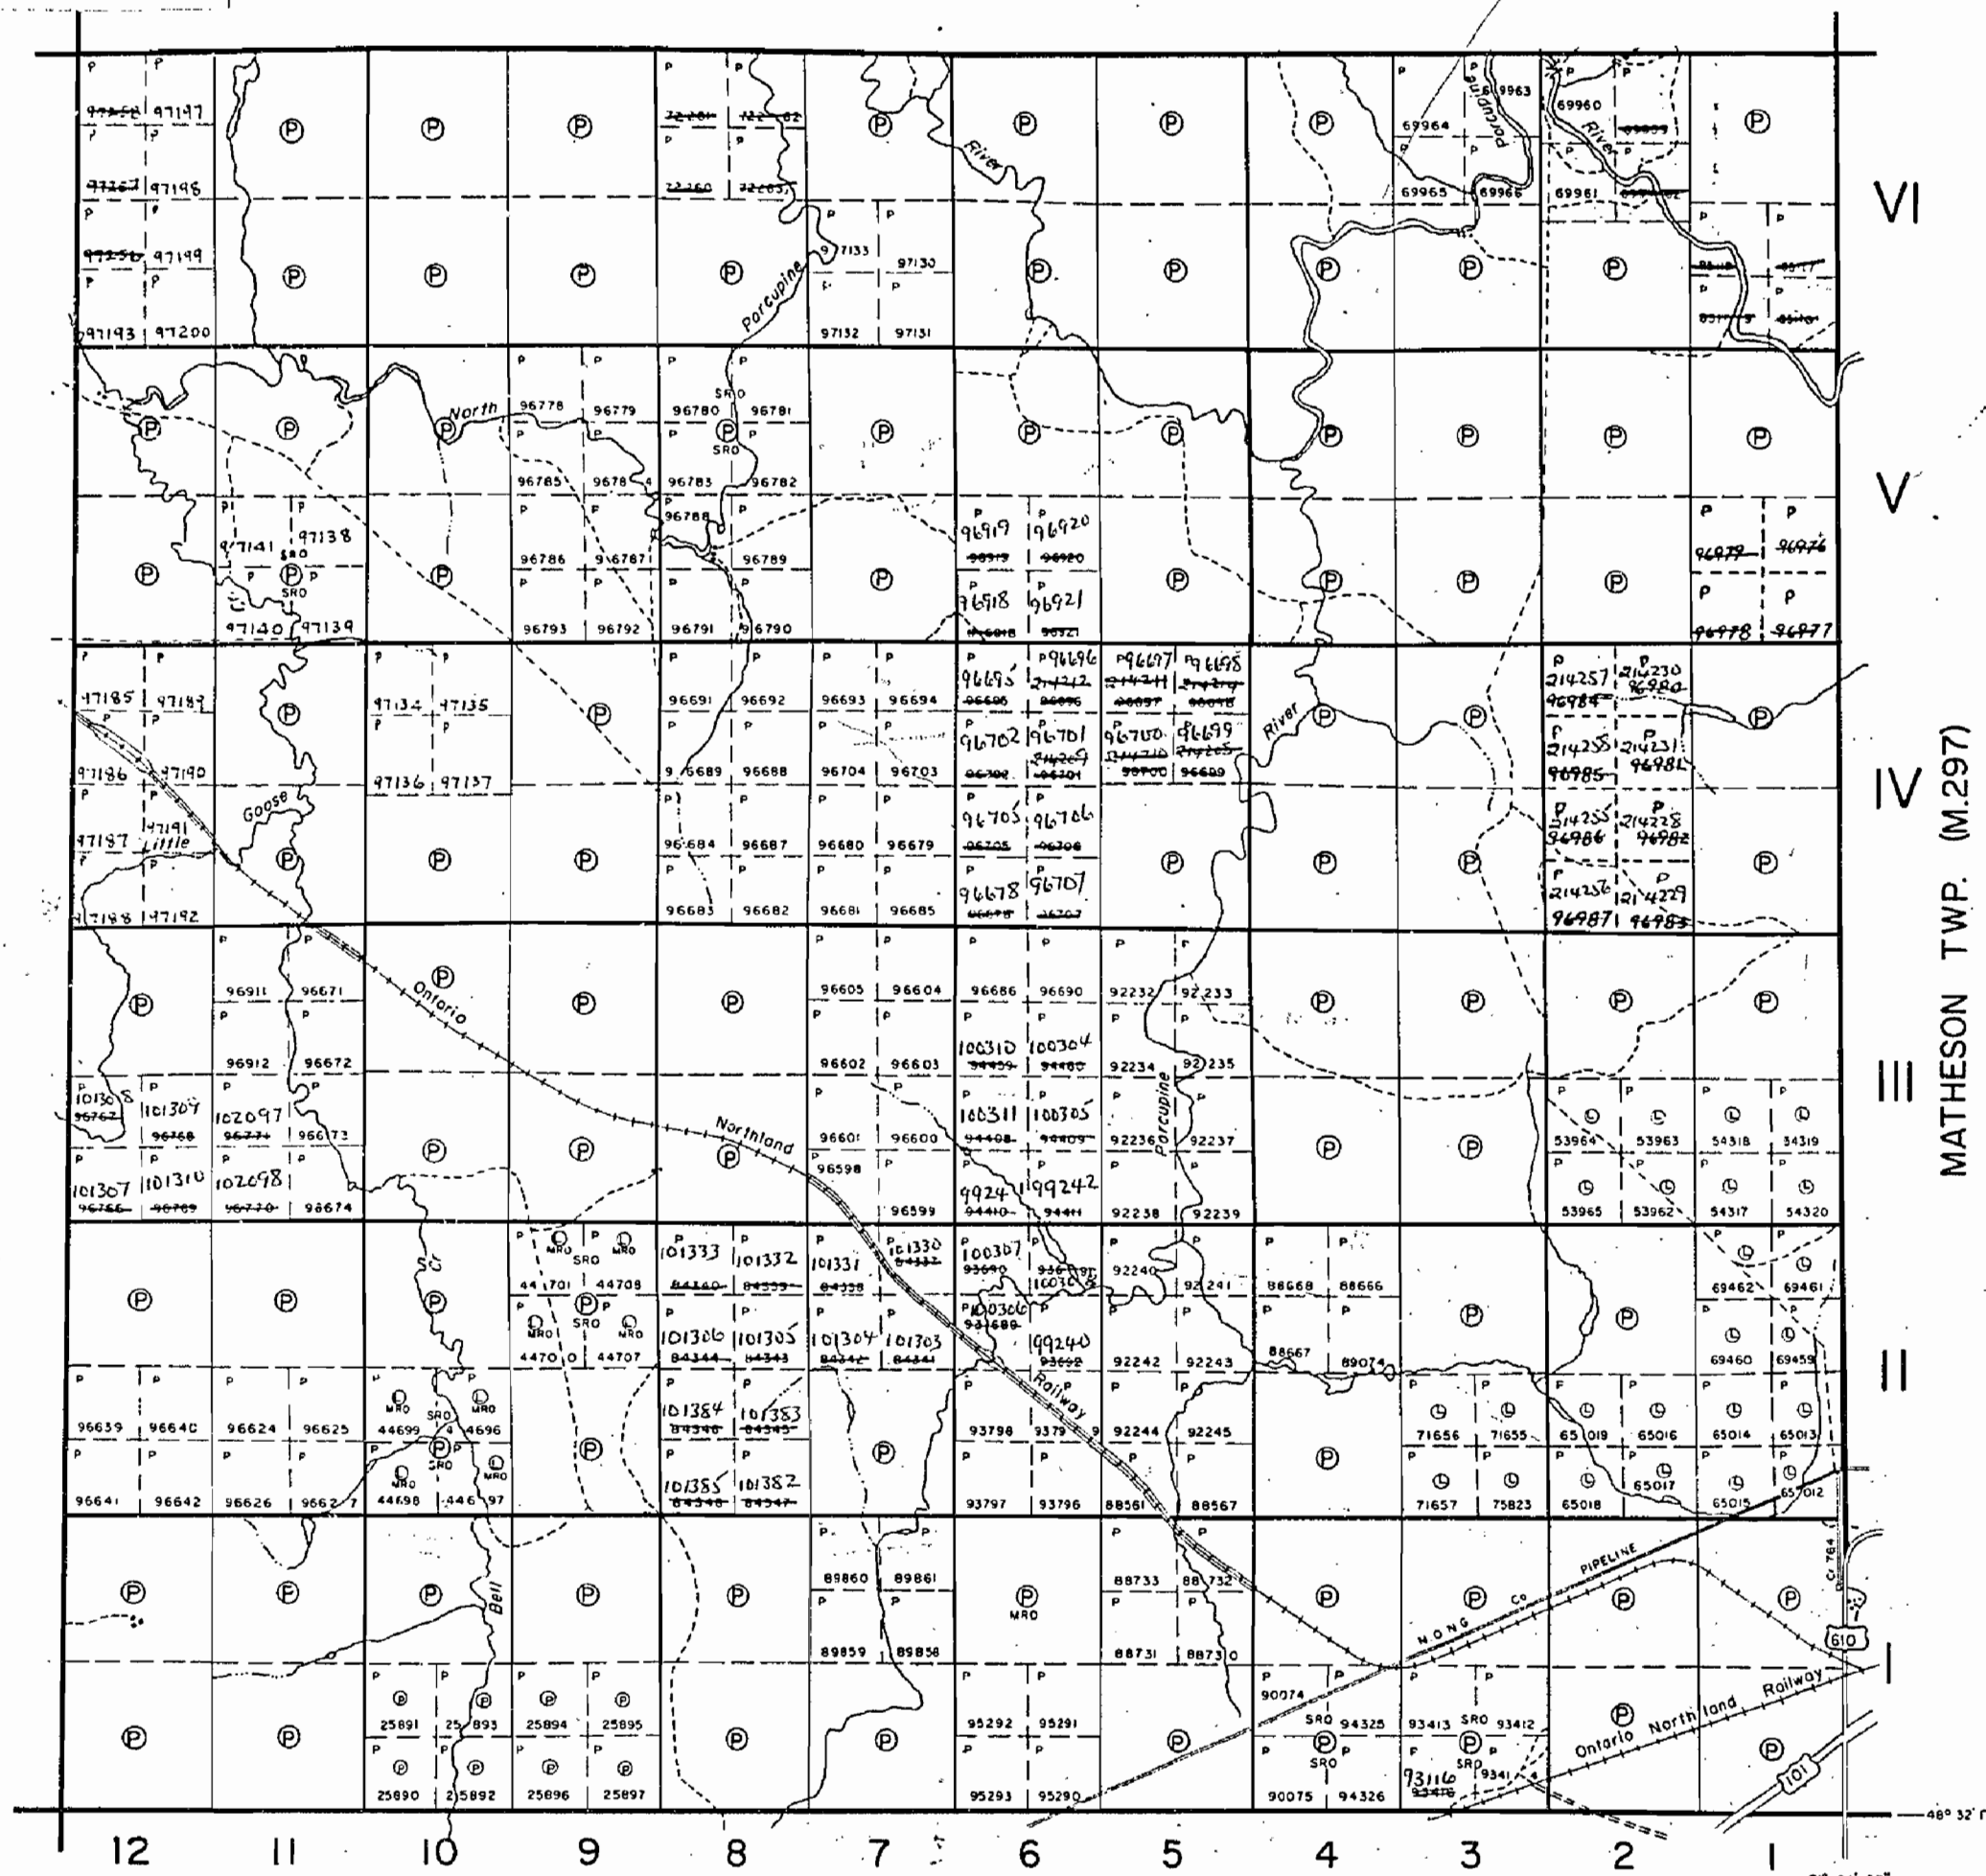

WHITNEY TWP. (M.319)

THE TOWNSHIP
OF

HOYLE

DISTRICT OF
COCHRANEPORCUPINE
MINING DIVISION

SCALE: 1-INCH 40 CHAINS


LEGEND

PATENTED LAND	(P)
CROWN LAND SALE	C.S.
LEASES	(L)
LOCATED LAND	Loc.
LICENSE OF OCCUPATION	L.O.
MINING RIGHTS ONLY	M.R.O.
SURFACE RIGHTS ONLY	S.R.O.
ROADS	—
IMPROVED ROADS	—
KING'S HIGHWAYS	—
RAILWAYS	—
POWER LINES	—
MARSH OR MUSKEG	—
MINES	—
CANCELLED	—

NOTES

400' Surface Rights Reservation around all
lakes and rivers.No disposition of sand and gravel from
May 8, 1964 until further notice.

CLAIMS IN YELLOW REQUIRE SURVEY

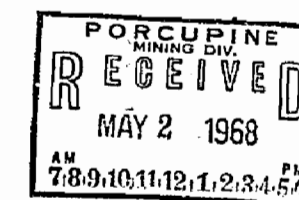

PLAN NO. M.287

DEPARTMENT OF MINES

— ONTARIO —

GOWAN TWP. (M.285)

THE TOWNSHIP
OF

HOYLE

DISTRICT OF
COCHRANE

PORCUPINE
MINING DIVISION

SCALE: 1-INCH = 40 CHAINS

LEGEND

PATENTED LAND
CROWN LAND SALE
LEASES
LOCATED LAND
LICENSE OF OCCUPATION
MINING RIGHTS ONLY
SURFACE RIGHTS ONLY
ROADS
IMPROVED ROADS
KING'S HIGHWAYS
RAILWAYS
POWER LINES
MARSH OR MUSKEG
MINES
CANCELLED

(P)
C.S.
(L)
Lo
L.C.
M.R.O.
S.R.O.

U.S. DEPT. OF JUSTICE

RECEIVED

JUN 10 1964

FBI - NEW YORK

NOTES

400' Surface Rights Reservation around all lakes and rivers.


Ont. Northland Rwy. spur line R/W for S.R.O.
see file 177607

FORCUPINE MINING DIVISION
RECEIVED
MAY 11 1972
AM PM
7 18 19 10 11 12 1 12 3 14 15 16

PLAÑ. NO.

M. 287

ONTARIO
DEPARTMENT OF MINES
AND NORTHERN AFFAIRS

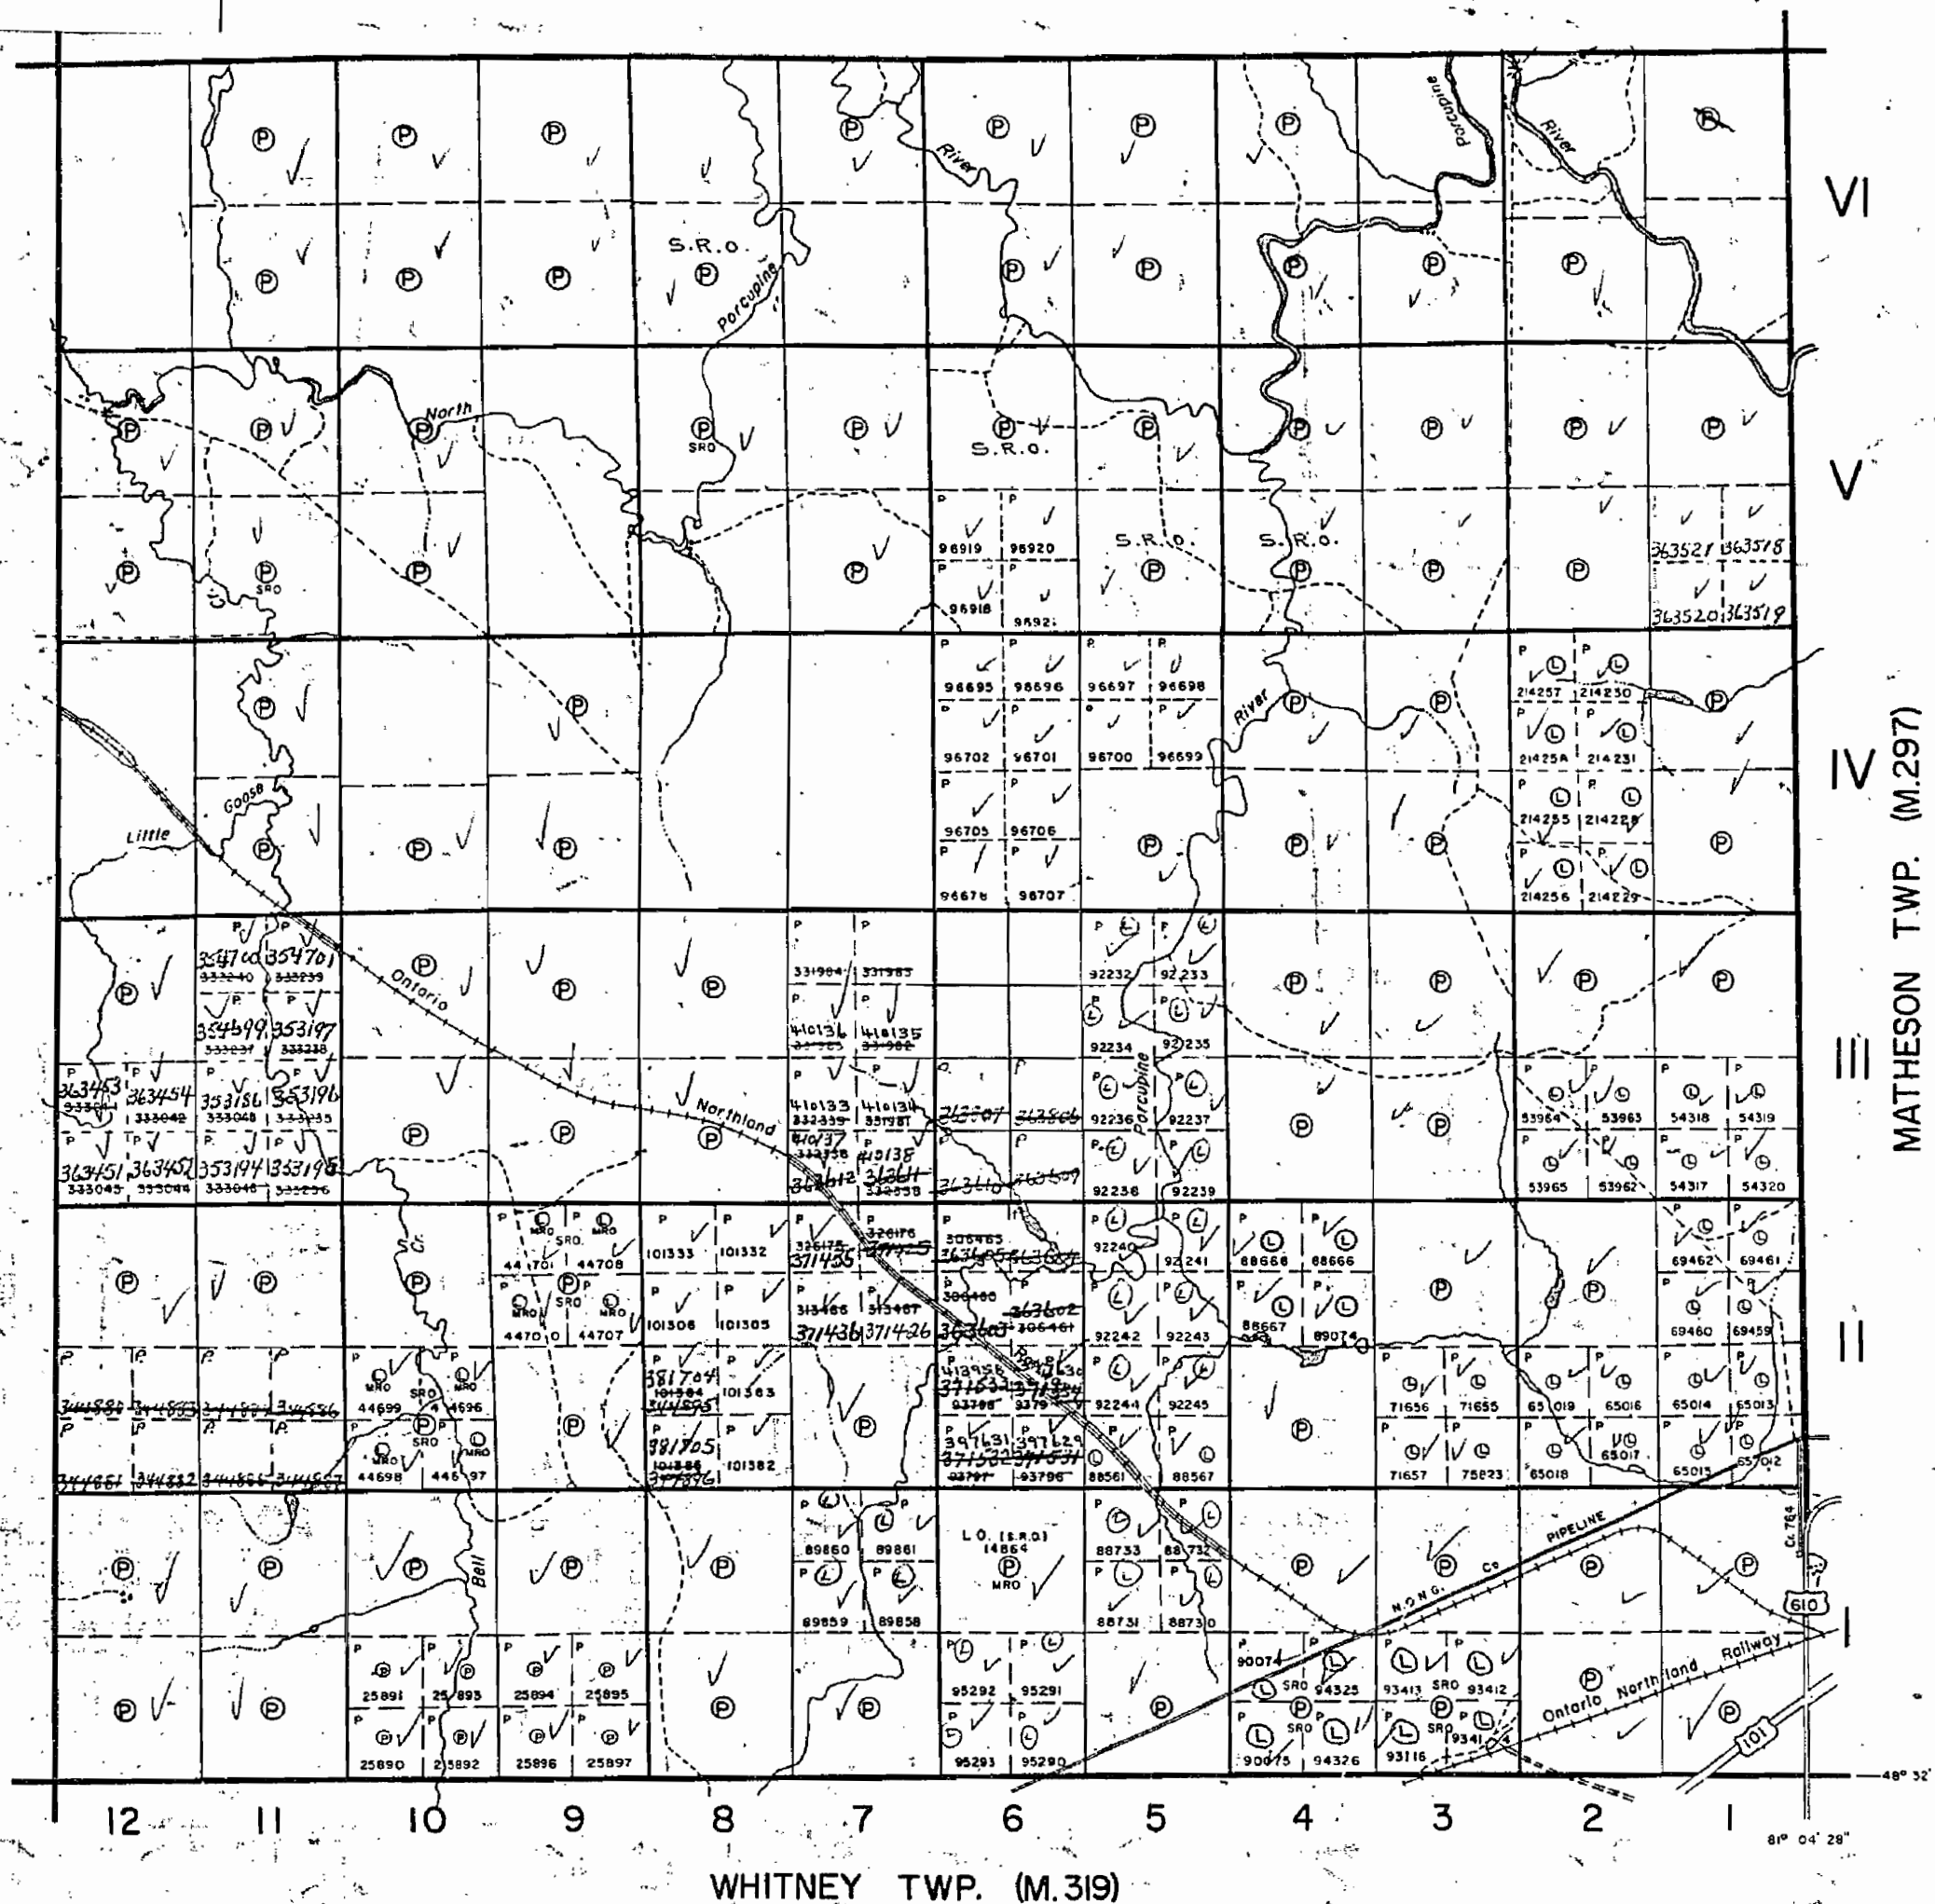

287

GOWAN TWP. (M.285)

THE TOWNSHIP
OF

HOYLE

DISTRICT OF
COCHRANEPORCUPINE
MINING DIVISION

SCALE: 1-INCH 40 CHAINS

LEGEND


PATENTED LAND	Ⓟ
CROWN LAND SALE	C.S.
LEASES	Ⓛ
LOCATED LAND	Loc.
LICENSE OF OCCUPATION	L.O.
MINING RIGHTS ONLY	M.R.O.
SURFACE RIGHTS ONLY	S.R.O.
ROADS	—
IMPROVED ROADS	—
KING'S HIGHWAYS	—
RAILWAYS	—
POWER LINES	—
MARSH OR MUSKEG	—
MINES	ⓧ
CANCELLED	C.

NOTES

400' Surface-Rights Reservation around all lakes and rivers.

~~No disposition of sand and gravel from May 8, 1964 until further notice.~~

See L.H.O. 1604

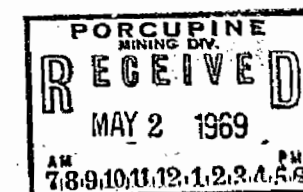

PLAN NO. M.287

DEPARTMENT OF MINES

— ONTARIO —

MURPHY TWP. (M.303)

MATHESON TWP. (M.297)

WHITNEY TWP. (M.319)

287

HOYLE


PORCUPINE MINING DIVISION

SCALE 40 CHAINS = 1 INCH.

M-287


GOWAN

MURPHY

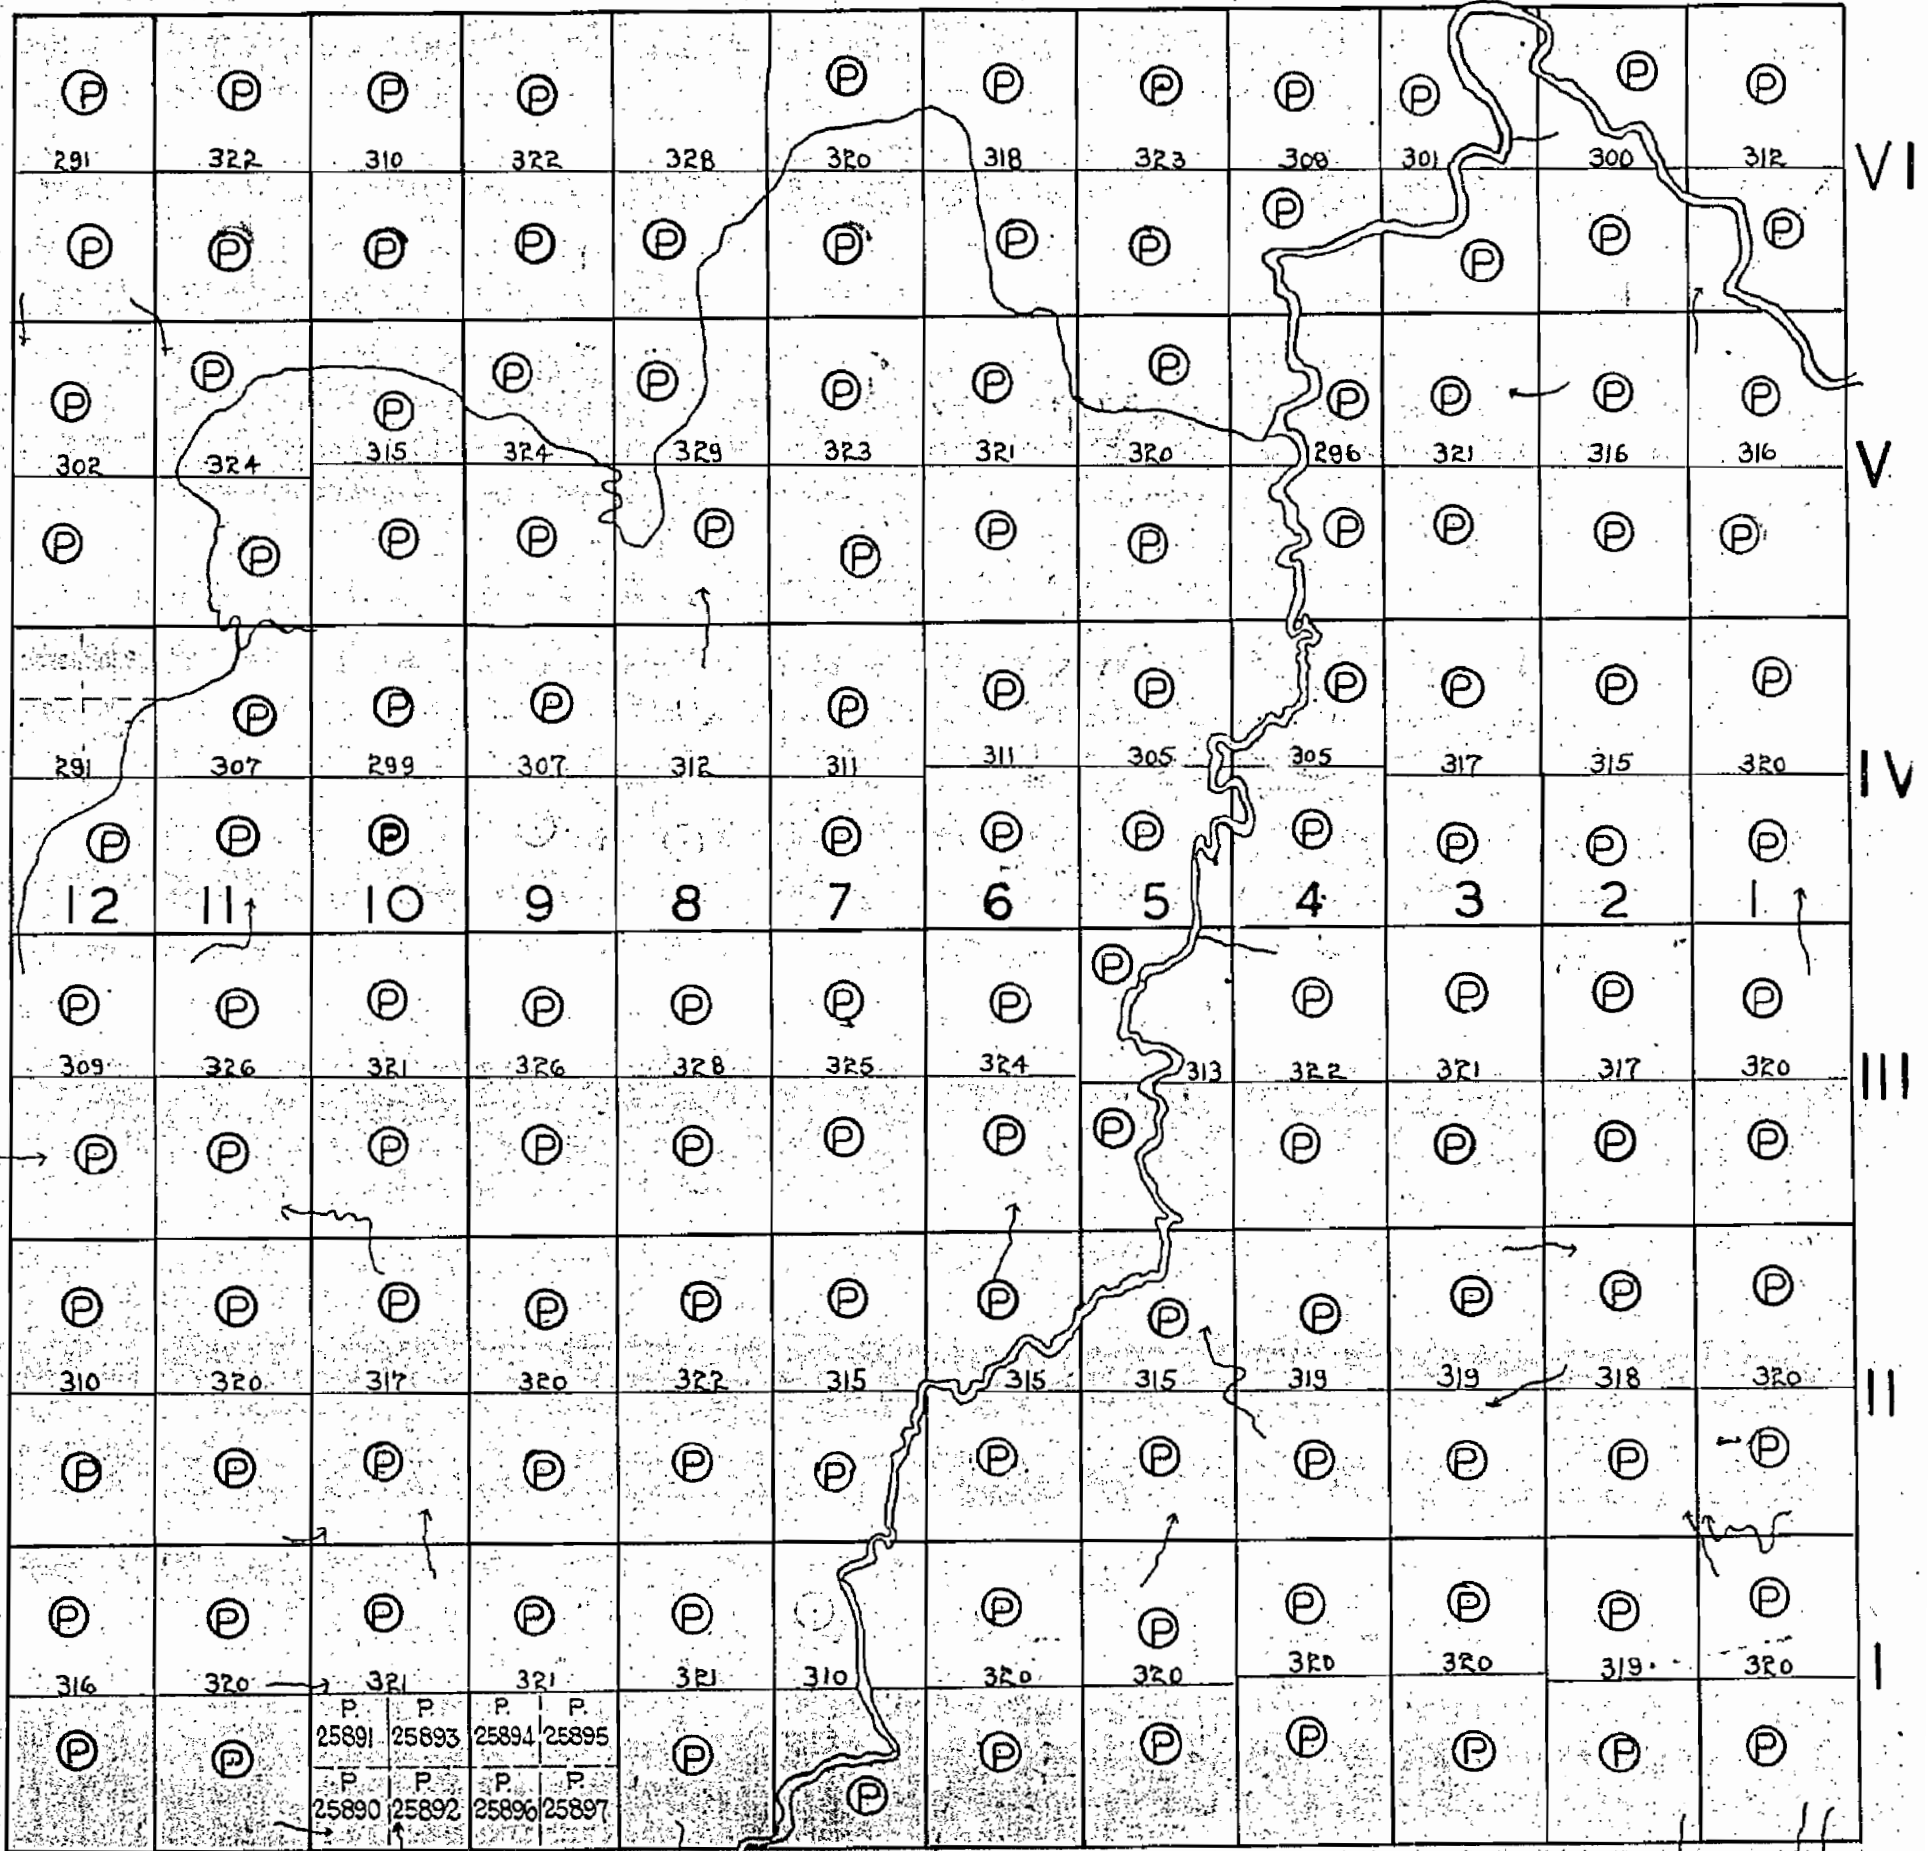

WHITNEY


m-287

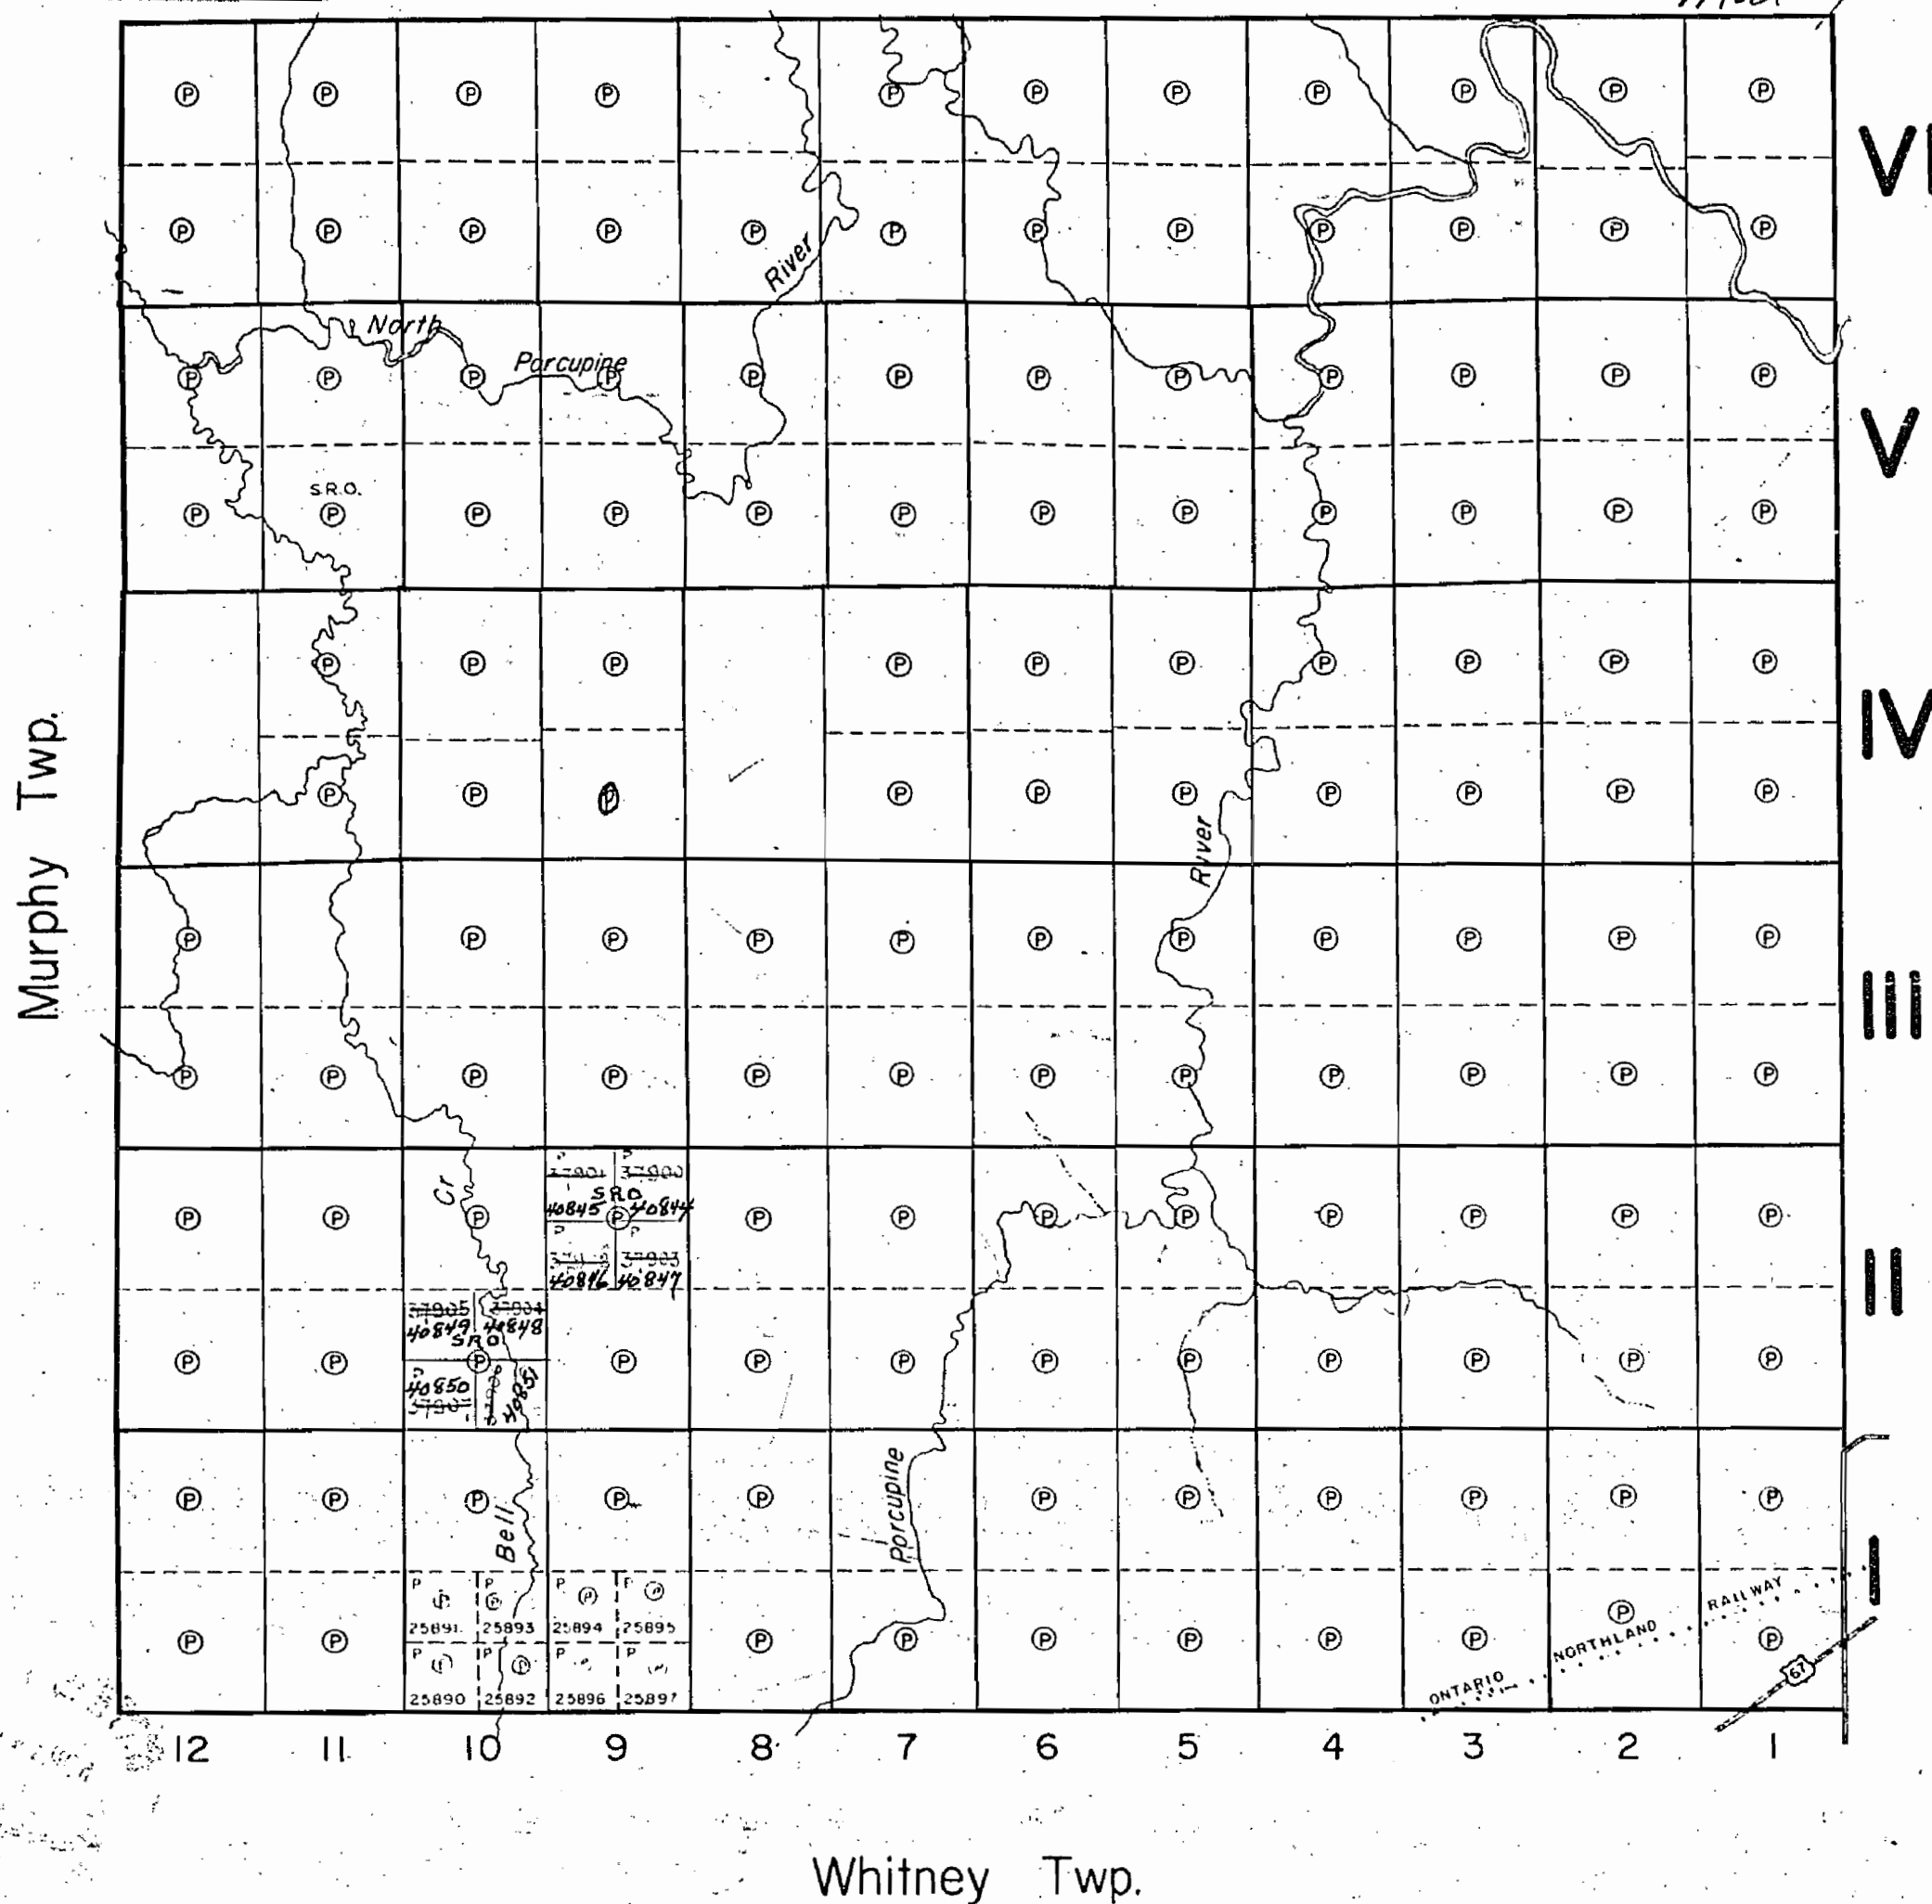

287

Gowan Twp.

Murphy Twp.

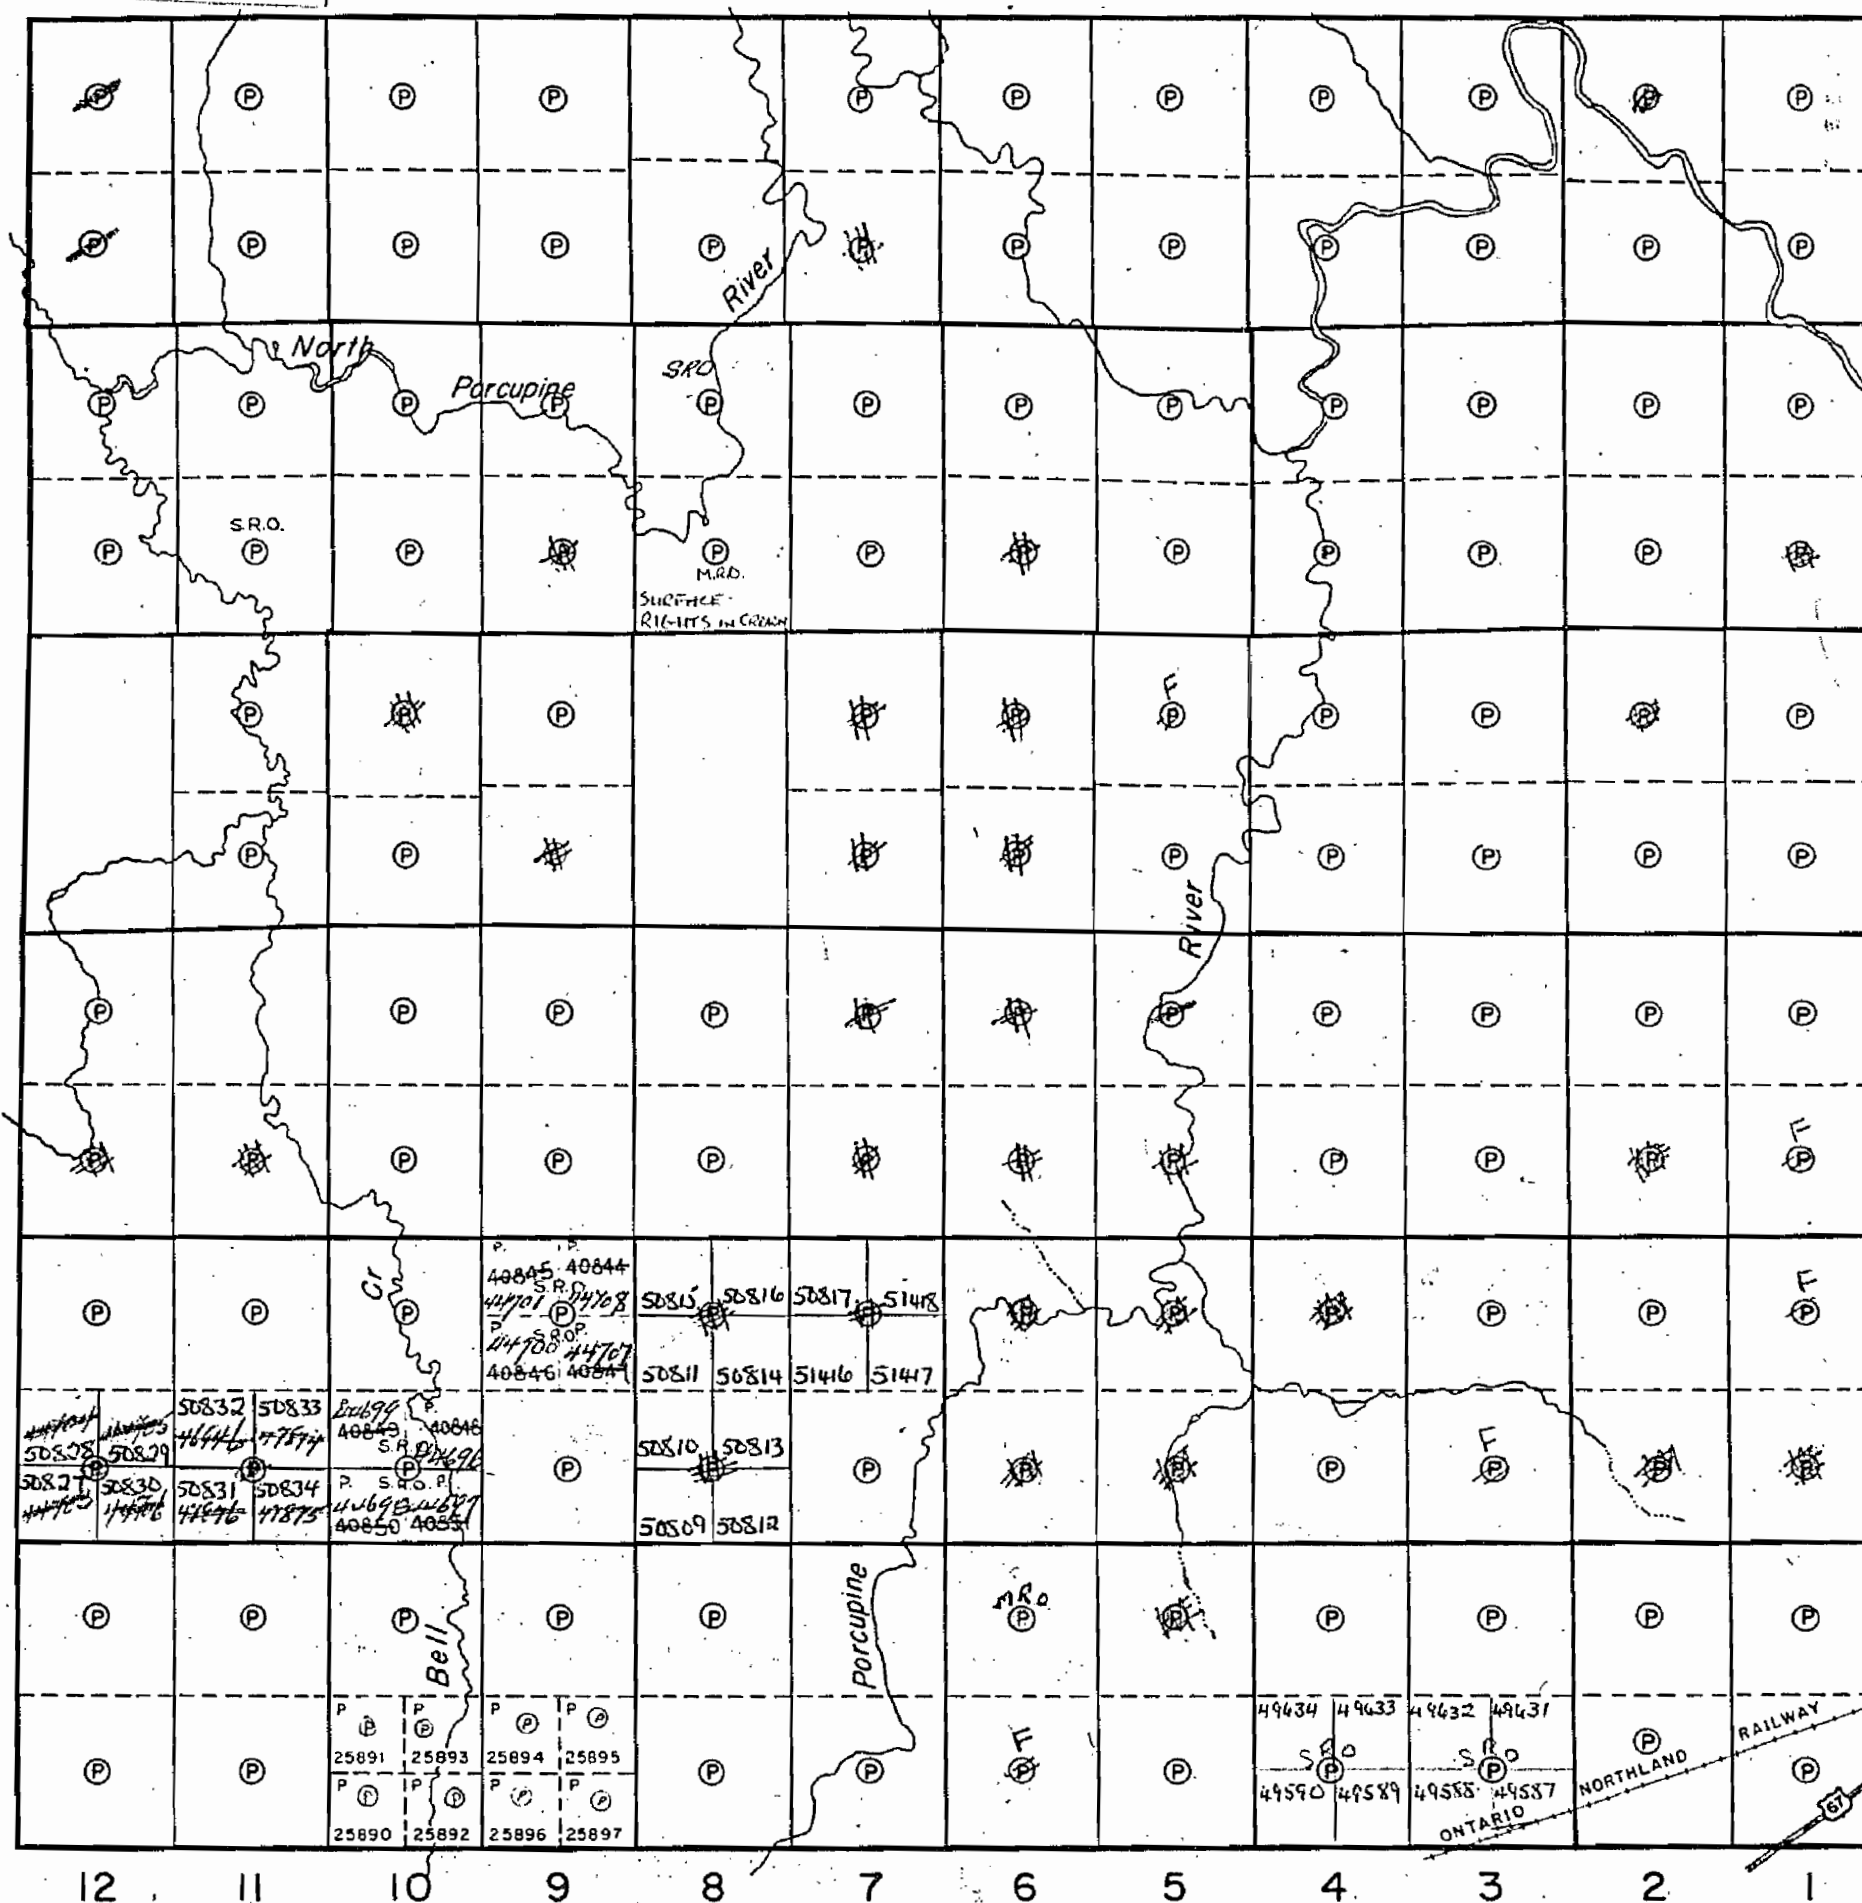THE TOWNSHIP
OF**HOYLE**DISTRICT OF
COCHRANEPORCUPINE
MINING DIVISION

SCALE: 1-INCH=40 CHAINS

LEGEND

PATENTED LAND	Ⓟ
CROWN LAND SALE	Ⓢ or C.S.
LEASES	Ⓛ
LOCATED LAND	Loc.
LICENSE OF OCCUPATION	L.O.
MINING RIGHTS ONLY	M.R.O.
SURFACE RIGHTS ONLY	S.R.O.
ROADS	—
IMPROVED ROADS	—
KING'S HIGHWAYS	—
RAILWAYS	—
POWER LINES	—
MARSH OR MUSKEG	—
MINES	—

NOTESM.R.
on N¹/₂ - Lot 8 - Sec. 5. Open.

PLAN NO.- M. 287

DEPARTMENT OF MINES
—ONTARIO—

Whitney Twp.

MAP SYMBOLS

Aerial Cableway	Pipeline
Boundary	(see ground)
International	Railroad
District, Township	Single Track
Indian Reserve	Double Track
Abandoned	Abandoned
Approximate	Turbine
Lot, Concession	Road
Approximate	Highway, County
Park Boundary	Township
Bridge	Access Road at Gravel Pit
Road, Railroad	(see ground)
Building	Trail, Back Road
Chimney	(see ground)
Cliff, Pit, Pile	Rapids
Contours	Double line river with multiple rapids
Intermittent	Double line river with multiple rapids
Approximate	Reservoir
Depression	River, Stream, Canal
Control Points	Approximate
Horizontal	Direction of flow
Vertical	Rock
Culvert	Significant
Falls	Spot Elevation
Double line river	(see ground)
Fence, Hedge, Wall	Tower
Feature Outline	Transmission Line
(see ground)	Pole
Flooded Land	Pylon
Lock	Tunnel
Marsh or Swamp	Utility Poles
Mast	Wharf, Dock, Pier
Mine Head Frame	Wooded Area
Outcrop	

AREAS WITHDRAWN FROM DISPOSITION

M.R.O. — MINING RIGHTS ONLY


S.R.O. — SURFACE RIGHTS ONLY

M.+ S. — MINING AND SURFACE RIGHTS

Description	Order No.	Date	Disposition	File
 N.R.W.		3/83	M.R.O.	

MURPHY TWP G - 3980

GOWAN TWP

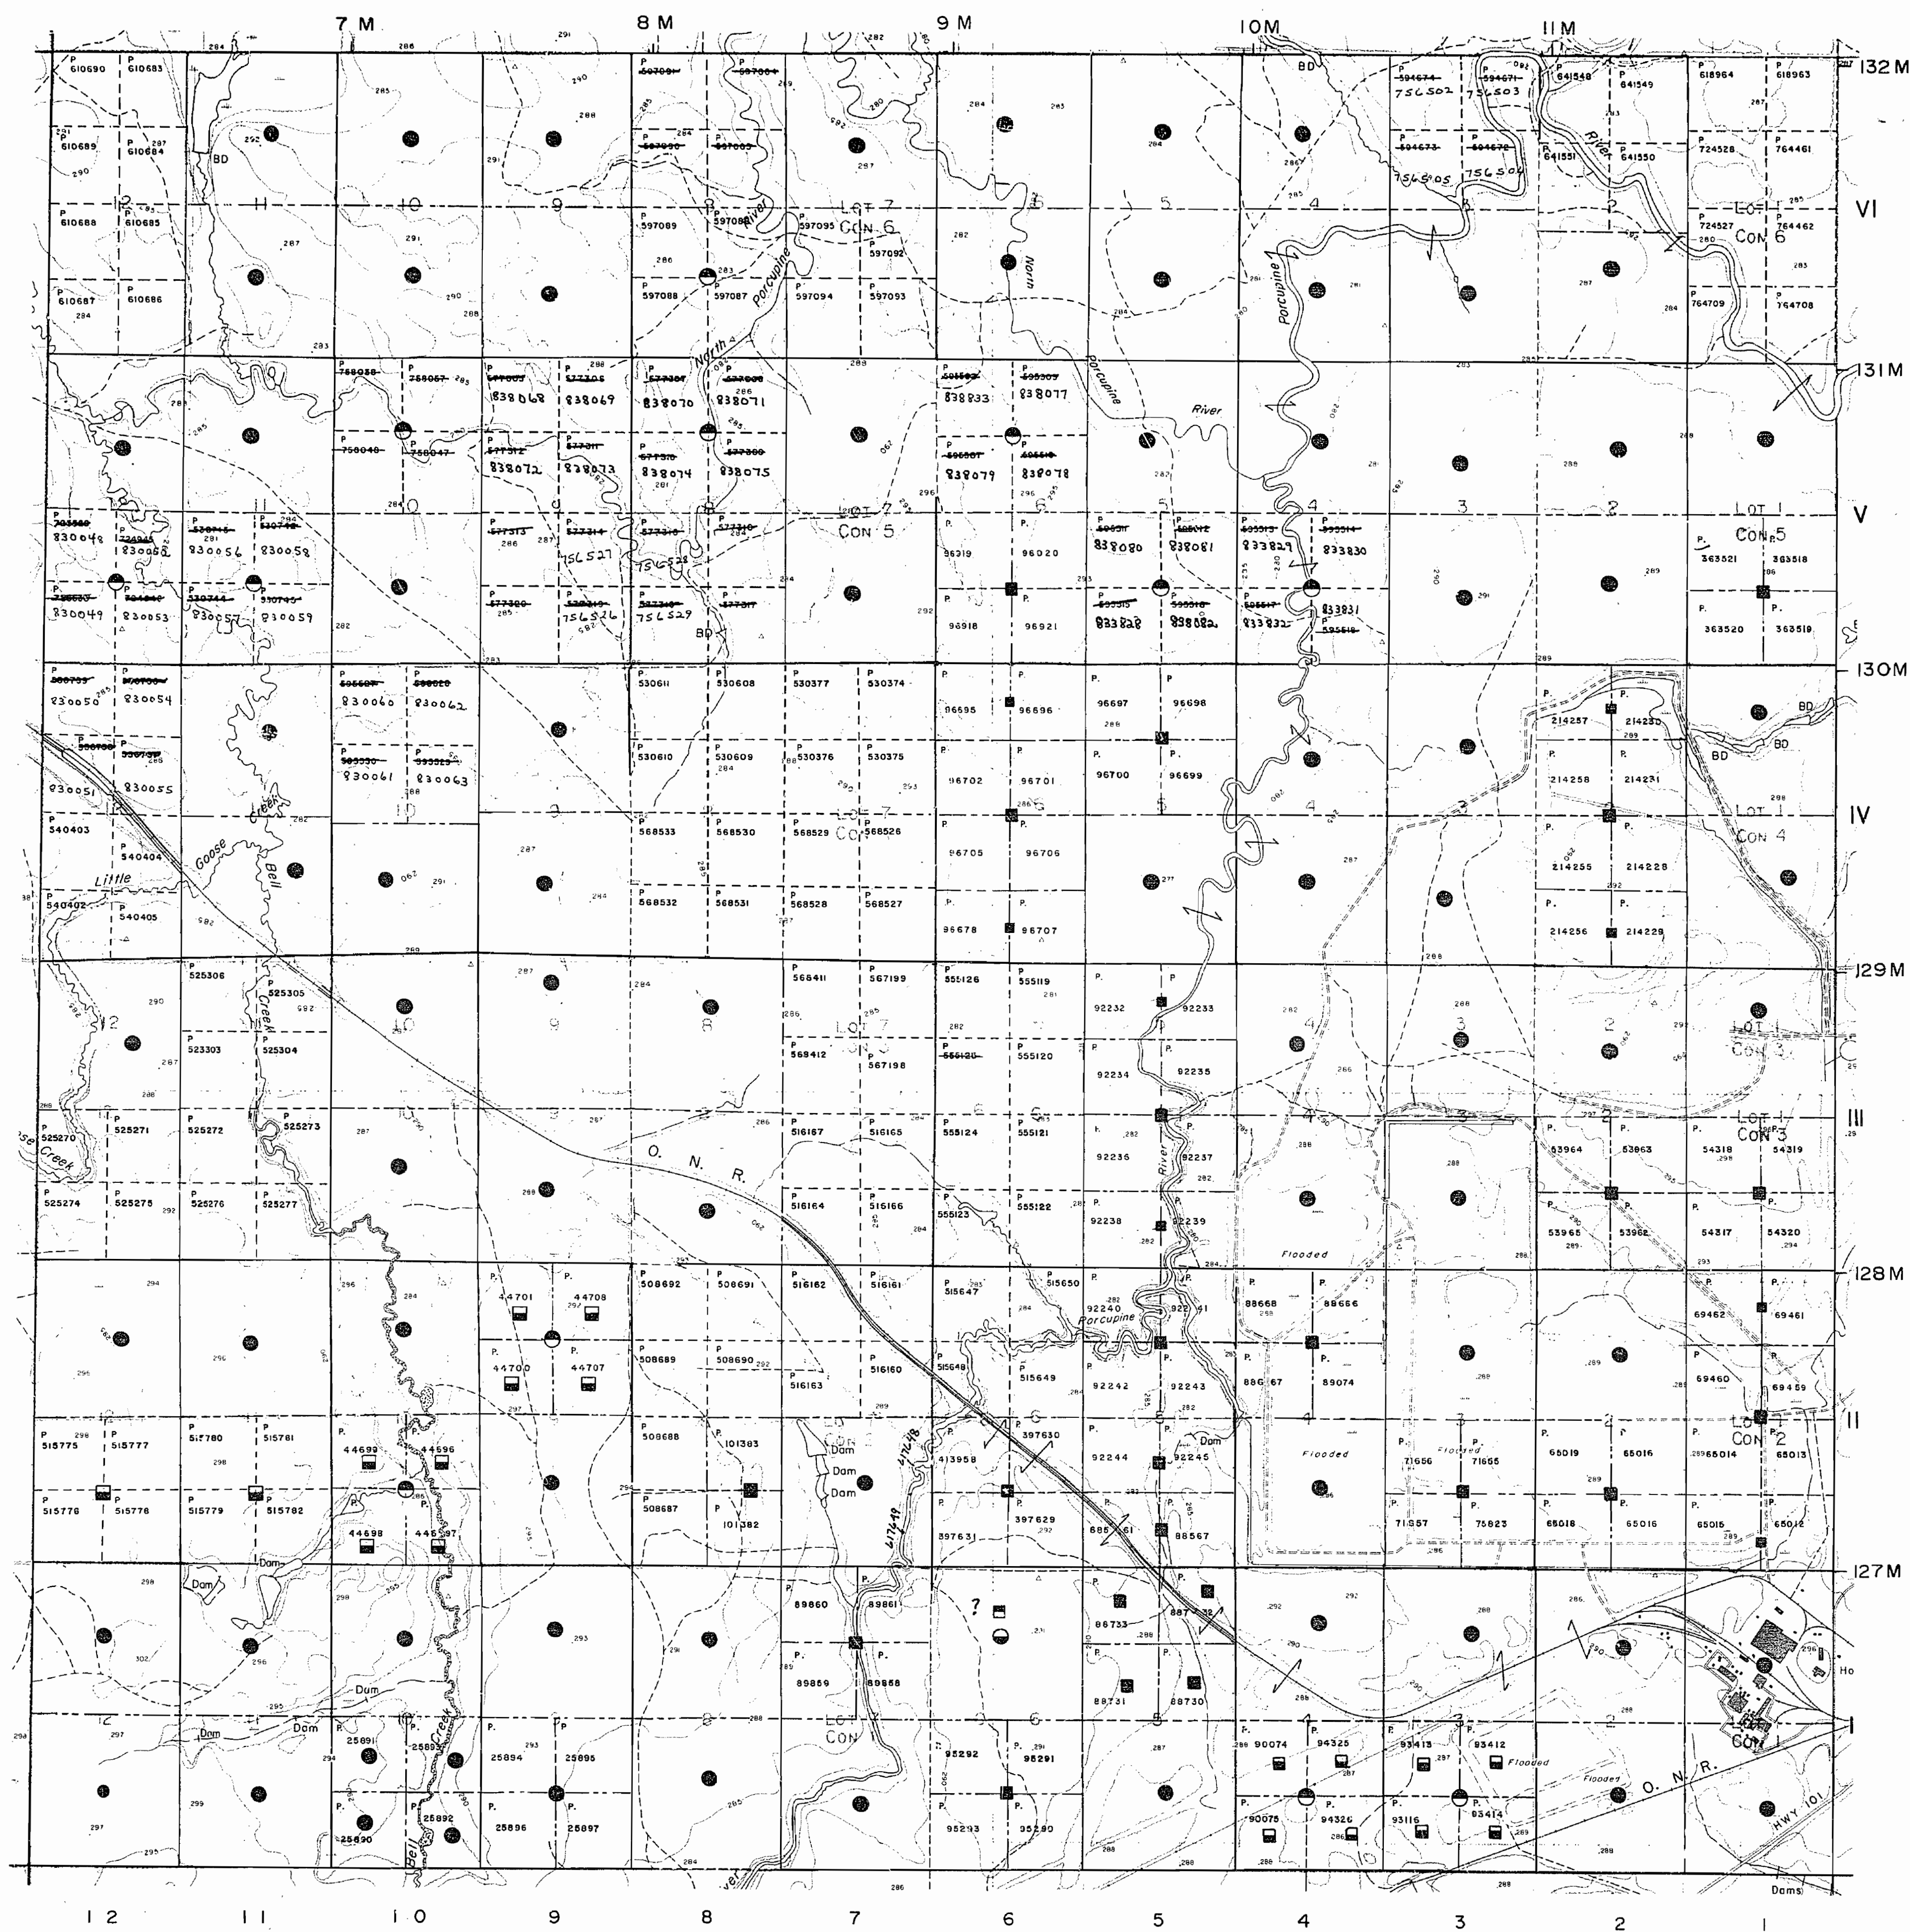

WHITNEY TWP G - 3975


LEGEND

HIGHWAY AND ROUTE No.	
OTHER ROADS	
TRAILS	
SURVEYED LINES:	
TOWNSHIPS, BASE LINES, ETC.	
LOTS, MINING CLAIMS, PARCELS, ETC.	
UNSURVEYED LINES:	
LOT LINES	
PARCEL BOUNDARY	
MINING CLAIMS ETC.	
RAILWAY AND RIGHT OF WAY	
UTILITY LINES	
NON-PERMANENT STREAM	
FLOODING OR FLOODING RIGHTS	
SUBDIVISION OR COMPOSITE PLAN	
RESERVATIONS	
ORIGINAL SHORELINE	
MARSH OR MUSKEG	
MINES	
TRAVERSE MONUMENT	

DISPOSITION OF CROWN LANDS

TYPE OF DOCUMENT	SYMBOL
PATENT, SURFACE & MINING RIGHTS	
" SURFACE RIGHTS ONLY	
" MINING RIGHTS ONLY	
LEASE, SURFACE & MINING RIGHTS	
" SURFACE RIGHTS ONLY	
" MINING RIGHTS ONLY	
LICENCE OF OCCUPATION	
ORDER-IN-COUNCIL	
RESERVATION	
CANCELLED	
SAND & GRAVEL	

NOTE: MINING RIGHTS IN PARCELS PATENTED PRIOR TO MAY 6, 1913, VESTED IN ORIGINAL PATENTEE BY THE PUBLIC LANDS ACT, R.S.O. 1913, CHAP. 300, SEC. 63, SUBSEC. 1.

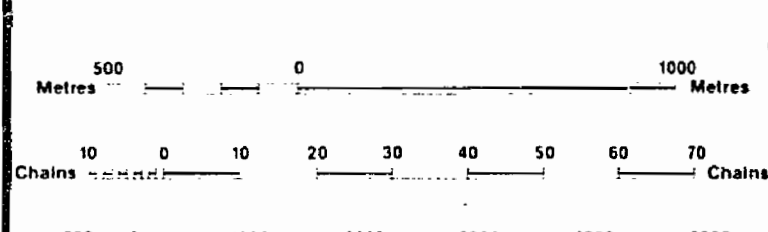

SCALE 1:20 000

NOTES

TOWNSHIP
HOYLE
M.N.R. ADMINISTRATIVE DISTRICT
TIMMINS
MINING DIVISION
PORCUPINE
LAND TITLES / REGISTRY DIVISION
COCHRANE

Ministry of Natural Resources
Land Management Branch
Ontario

Date FEBRUARY 2, 1984
Received March 19/84
Number
G-3987

Gowan Twp.

THE TOWNSHIP
OF

HOYLE

DISTRICT OF
COCHRANE

PORCUPINE
MINING- DIVISION

SCALE: 1-INCH = 40 CHAINS

LEGEND

PATENTED LAND	(P)
CROWN LAND SALE	(S) or C.S.
LEASES	(L)
LOCATED LAND	Loc.
LICENSE OF OCCUPATION	L.O.
MINING RIGHTS ONLY	M.R.O.
SURFACE RIGHTS ONLY	S.R.O.
ROADS	
IMPROVED ROADS	
KINGS HIGHWAYS	
RAILWAYS	
POWER LINES	
NIARSH OR MUSKEG	
MINES	

NOTES

MINING RECORDER
RECEIVED
FEB 15 1962
PORCUPINE
MINING DIVISION

PLAN NO.- M. 287

DEPARTMENT OF MINES
—ONTARIO—

Murphy Twp.

Matheson Two

Whitney Twp.

287

Gowan Twp.

THE TOWNSHIP
OF**HOYLE**DISTRICT OF
GOCHRANEPORCUPINE
MINING DIVISION

SCALE: 1-INCH=40 CHAINS


LEGEND

PATENTED LAND	Ⓟ
CROWN LAND SALE	Ⓢ or Ⓞ
LEASES	Ⓛ
LOCATED LAND	Loc.
LICENSE OF OCCUPATION	L.O.
MINING RIGHTS ONLY	M.R.O.
SURFACE RIGHTS ONLY	S.R.O.
ROADS	—
IMPROVED ROADS	—
KING'S HIGHWAYS	—
RAILWAYS	—
POWER LINES	—
MARSH OR MUSKEG	—
MINES	—

NOTES

400' Surface rights reservation around all lakes and rivers.

No disposition of sand & gravel from May 8th, 1964 until further notice

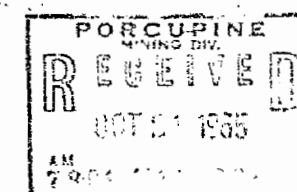


PLAN NO.- M. 287

DEPARTMENT OF MINES
—ONTARIO—

Murphy Twp.

Matheson Twp.

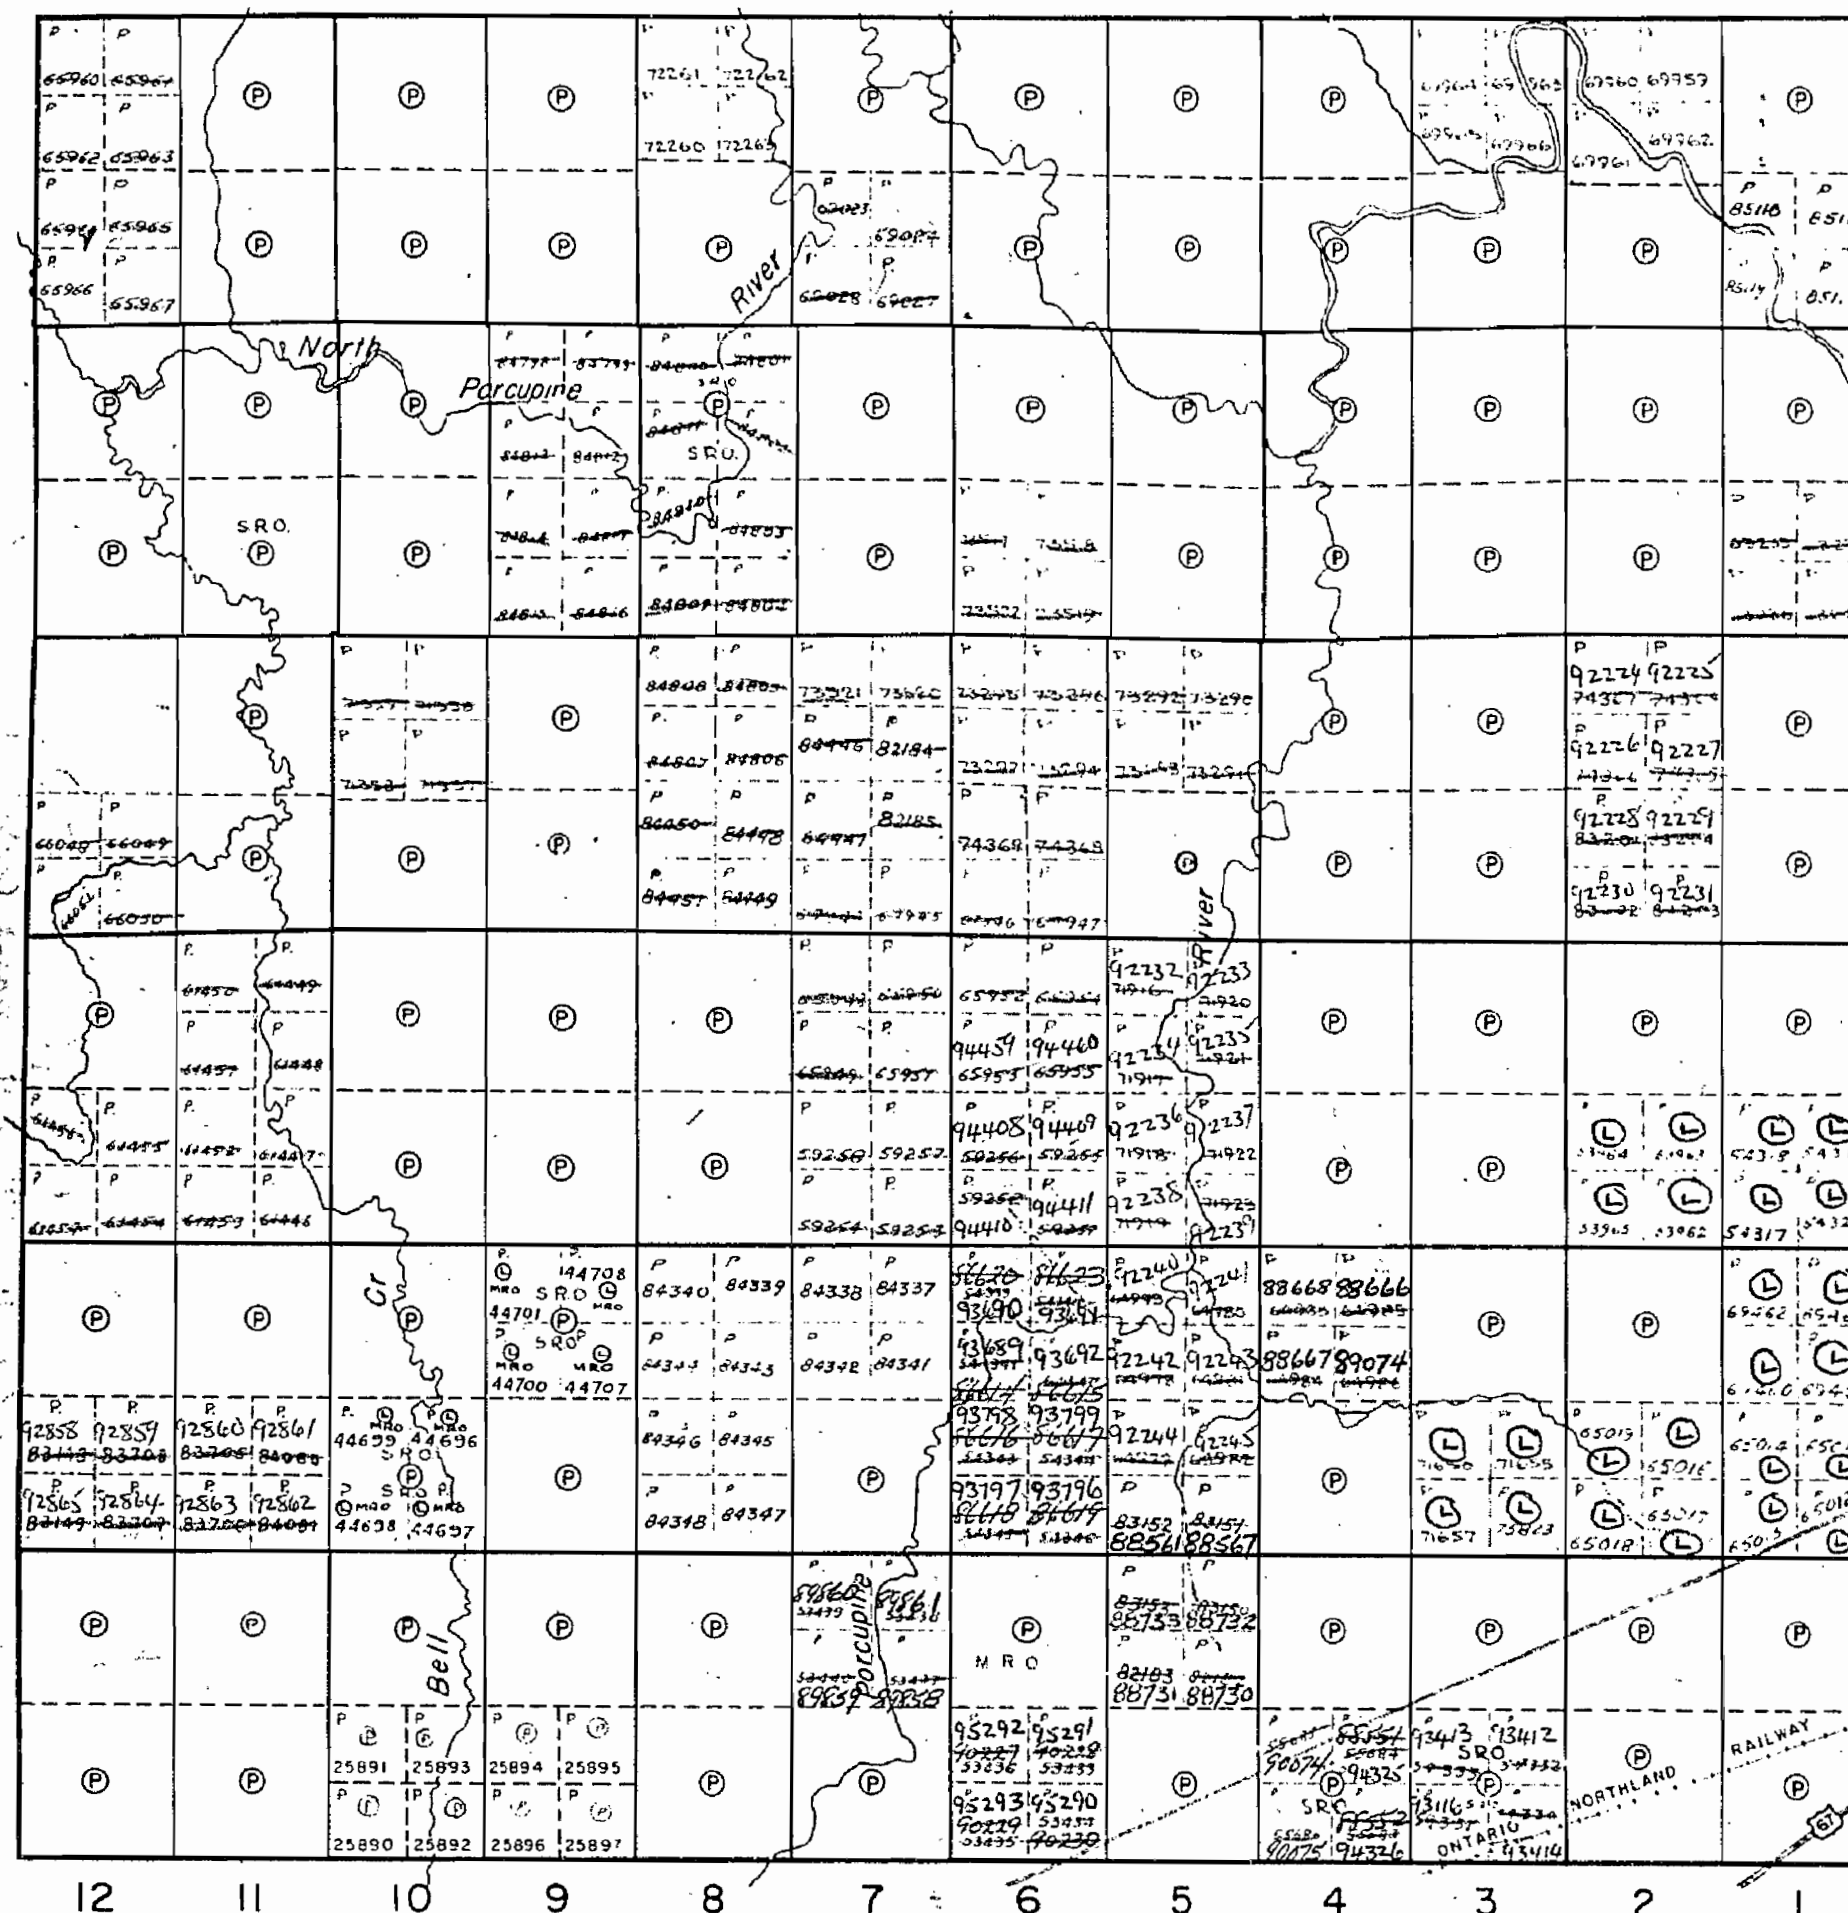

Whitney Twp.

287

Gowan Twp.

THE TOWNSHIP
OF**HOYLE**DISTRICT OF
COCHRANEPORCUPINE
MINING DIVISION

SCALE: 1-INCH = 40 CHAINS

LEGEND


PATENTED LAND	Ⓟ
CROWN LAND SALE	Ⓢ or C.S.
LEASES	Ⓞ
LOCATED LAND	Loc.
LICENSE OF OCCUPATION	L.O.
MINING RIGHTS ONLY	M.R.O.
SURFACE RIGHTS ONLY	S.R.O.
ROADS	—
IMPROVED ROADS	—
KING'S HIGHWAYS	—
RAILWAYS	—
POWER LINES	—
MARSH OR MUSKEG	—
MINES	—

NOTES


400' Surface rights reservation around all lakes and rivers.

No disposition of sand & gravel from May 8th, 1964 until further notice

CLAIMS IN YELLOW REQUIRE SURVEY

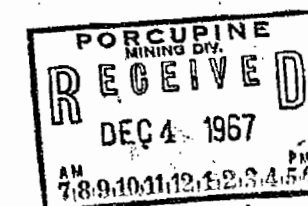

PLAN NO.- M. 287

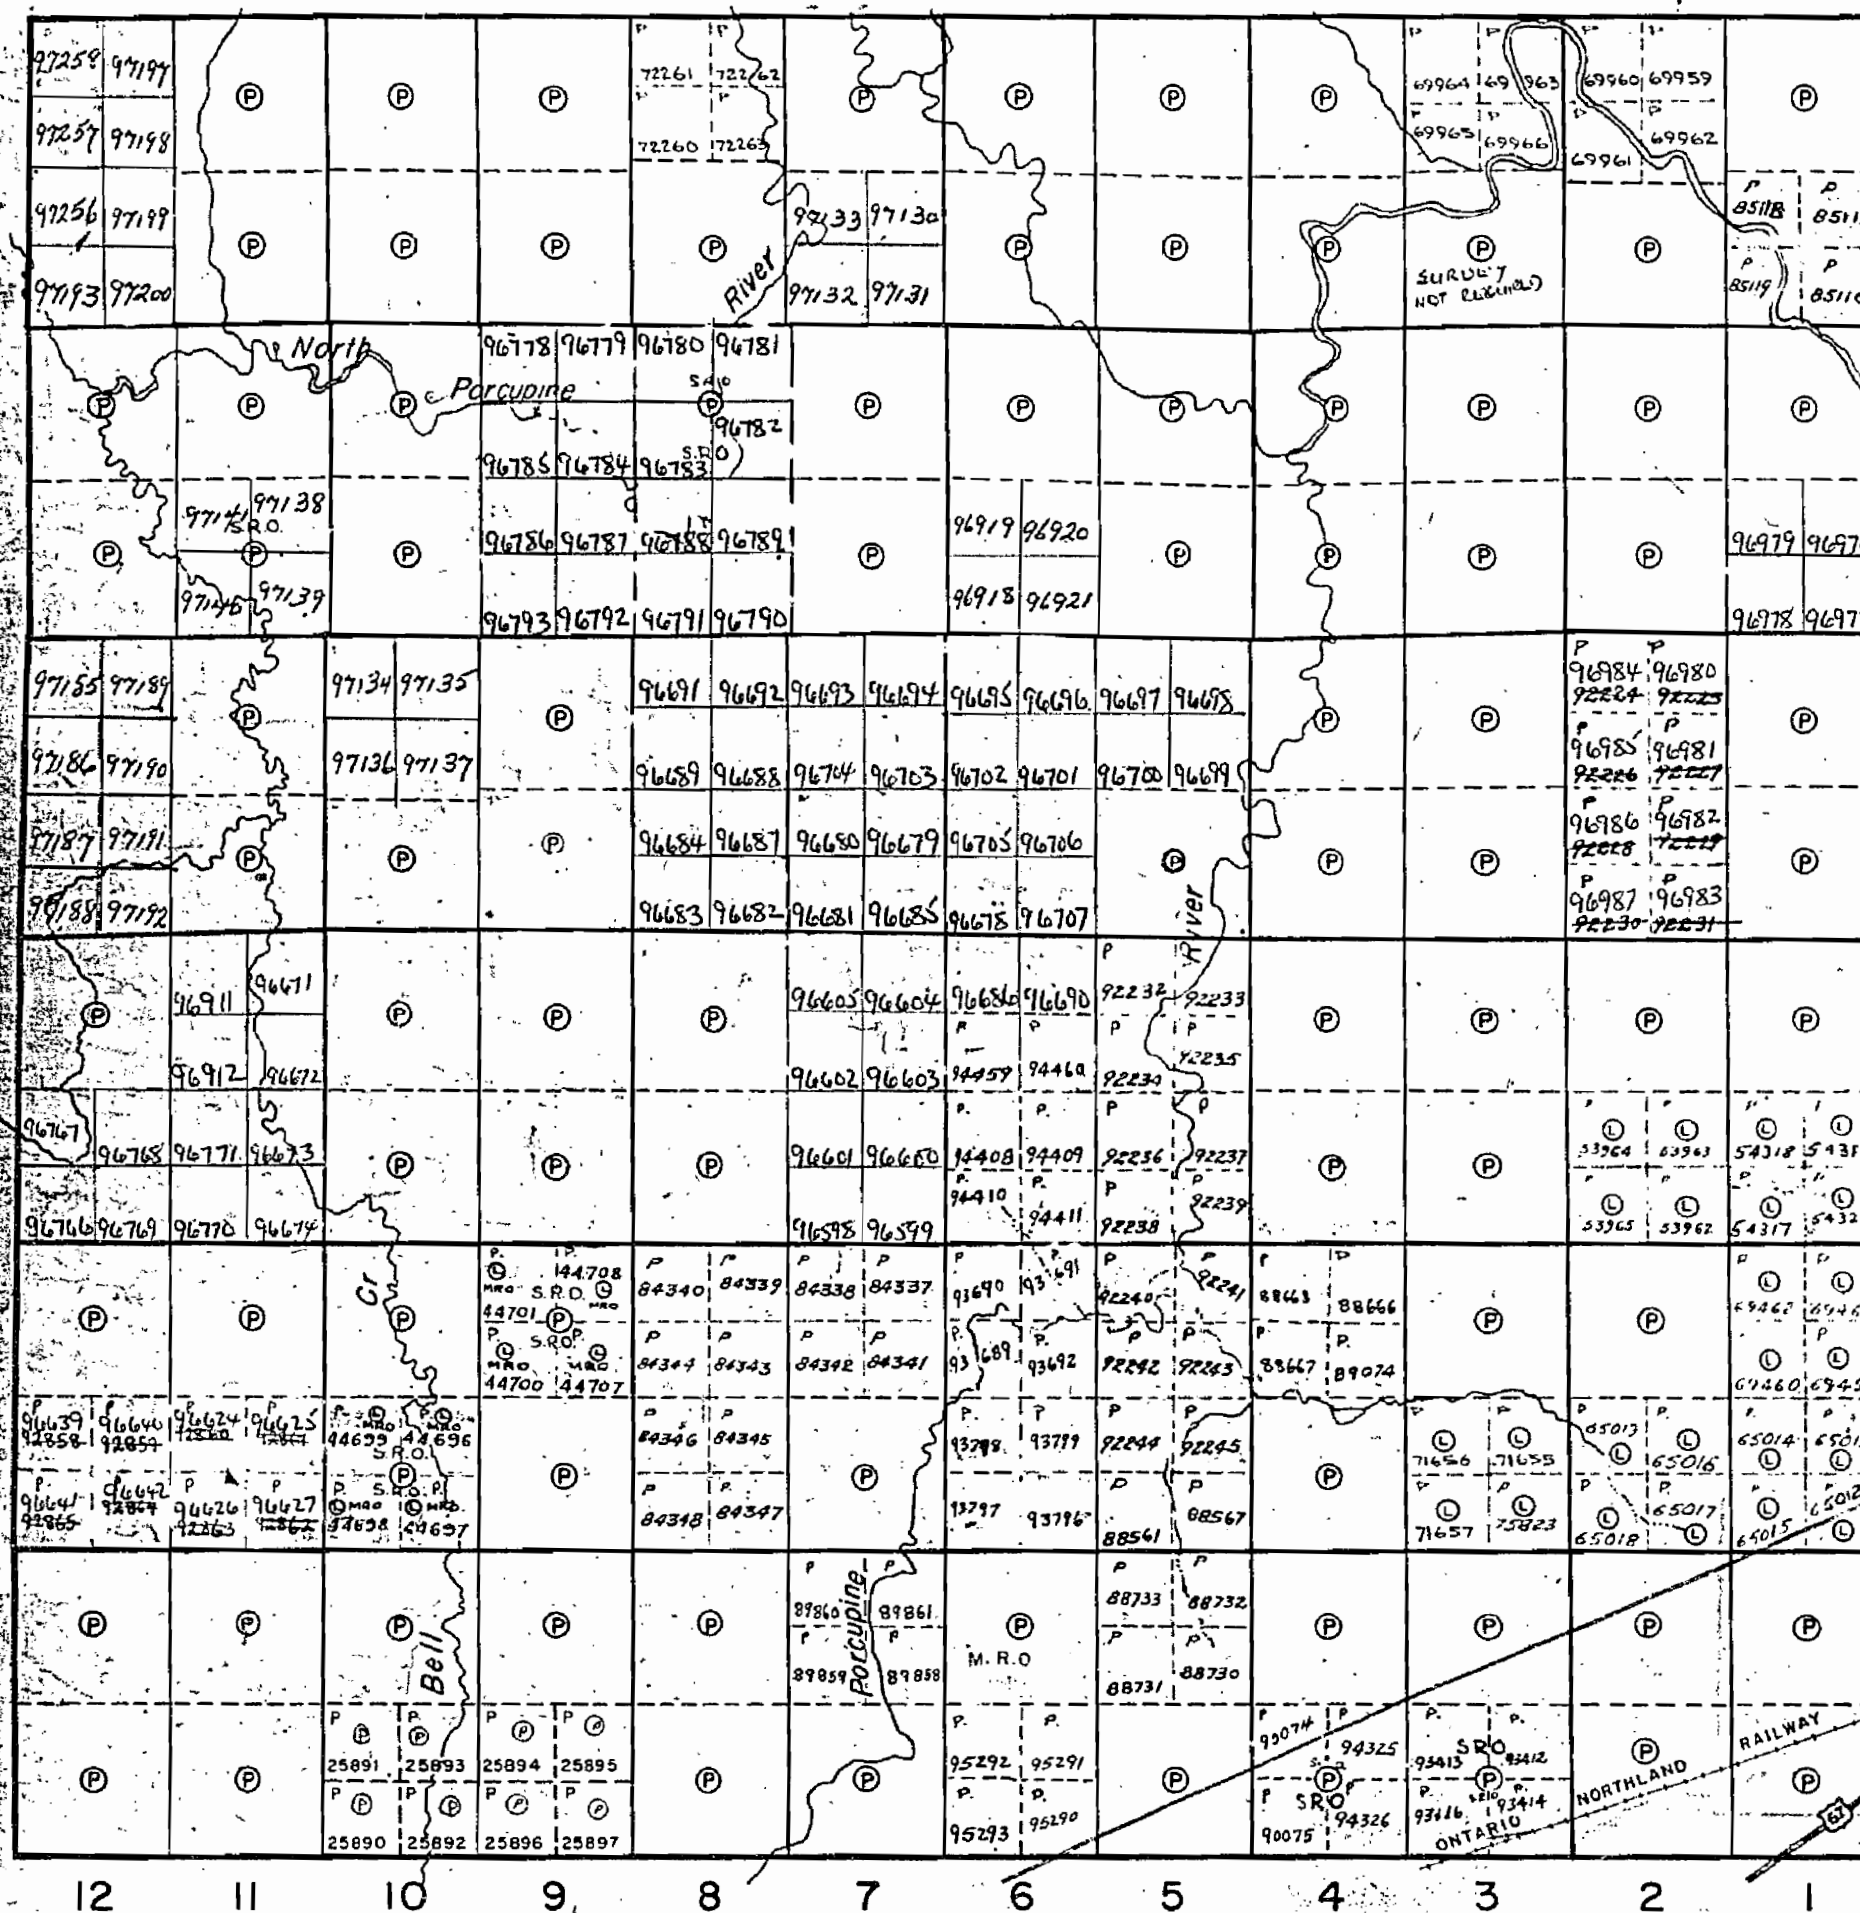DEPARTMENT OF MINES
—ONTARIO—

VI

V

IV

III

II

Matheson Twp.

Whitney Twp.

287

GOWAN TWP. (M.285)

THE TOWNSHIP
OF

HOYLE

DISTRICT OF
COCHRANEPORCUPINE
MINING DIVISION

SCALE: 1-INCH 40 CHAINS


LEGEND

PATENTED LAND	Ⓟ
CROWN LAND SALE	C.S.
LEASES	Ⓛ
LOCATED LAND	Loc.
LICENSE OF OCCUPATION	L.O.
MINING RIGHTS ONLY	M.R.O.
SURFACE RIGHTS ONLY	S.R.O.
ROADS	—
IMPROVED ROADS	—
KING'S HIGHWAYS	—
RAILWAYS	—
POWER LINES	—
MARSH OR MUSKEG	—
MINES	✕
CANCELLED	C.

NOTES

400' Surface Rights Reservation around all
lakes and rivers.No disposition of sand and gravel from
May 8, 1964 until further notice.

CLAIMS IN YELLOW REDUCE SURVEY

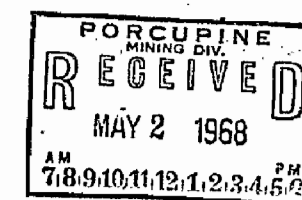

PLAN NO. M.287

DEPARTMENT OF MINES

— ONTARIO —

MURPHY TWP. (M.303)

WHITNEY TWP. (M.319)

287

GOWAN TWP. (M.285)

THE TOWNSHIP
OF

HOYLE

DISTRICT OF
COCHRANEPORCUPINE
MINING DIVISION

SCALE: 1-INCH 40 CHAINS


LEGEND

PATENTED LAND	Ⓟ
CROWN LAND SALE	C.S.
LEASES	Ⓛ
LOCATED LAND	Loc.
LICENSE OF OCCUPATION	L.O.
MINING RIGHTS ONLY	M.R.O.
SURFACE RIGHTS ONLY	S.R.O.
ROADS	—
IMPROVED ROADS	—
KING'S HIGHWAYS	—
RAILWAYS	—
POWER LINES	—
MARSH OR MUSKEG	—
MINES	ⓧ
CANCELLED	C.

NOTES

400' Surface Rights Reservation around all lakes and rivers.

~~No disposition of sand and gravel from May 8, 1964 until further notice.~~
S.E. LAND ROBE

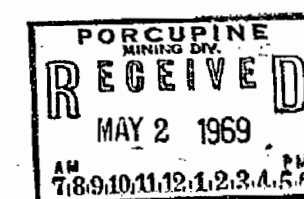

PLAN NO.

M.287

DEPARTMENT OF MINES

— ONTARIO —

MURPHY TWP. (M.303)

MATHESON TWP. (M.297)

WHITNEY TWP. (M.319)