





# PLAN OF LARKIN TWP.

M.1293


ONTARIO

MINISTRY OF NATURAL RESOURCES  
SURVEYS AND MAPPING BRANCH

PORCUPINE MINING DIVISION  
DISTRICT OF ALGOMA.

—Scale, 40 chains to an inch.—

DATE OF ISSUE  
APR 4 1977  
1050

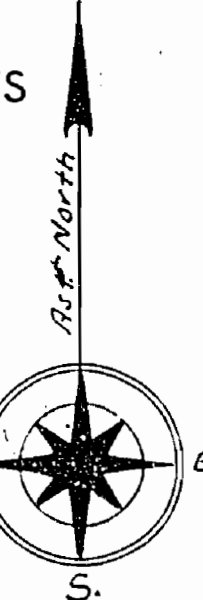


WICKSTEED TWP.

HAIG TWP.

CHELSEA TWP.

LASCALLE TWP.


BEATON TWP.

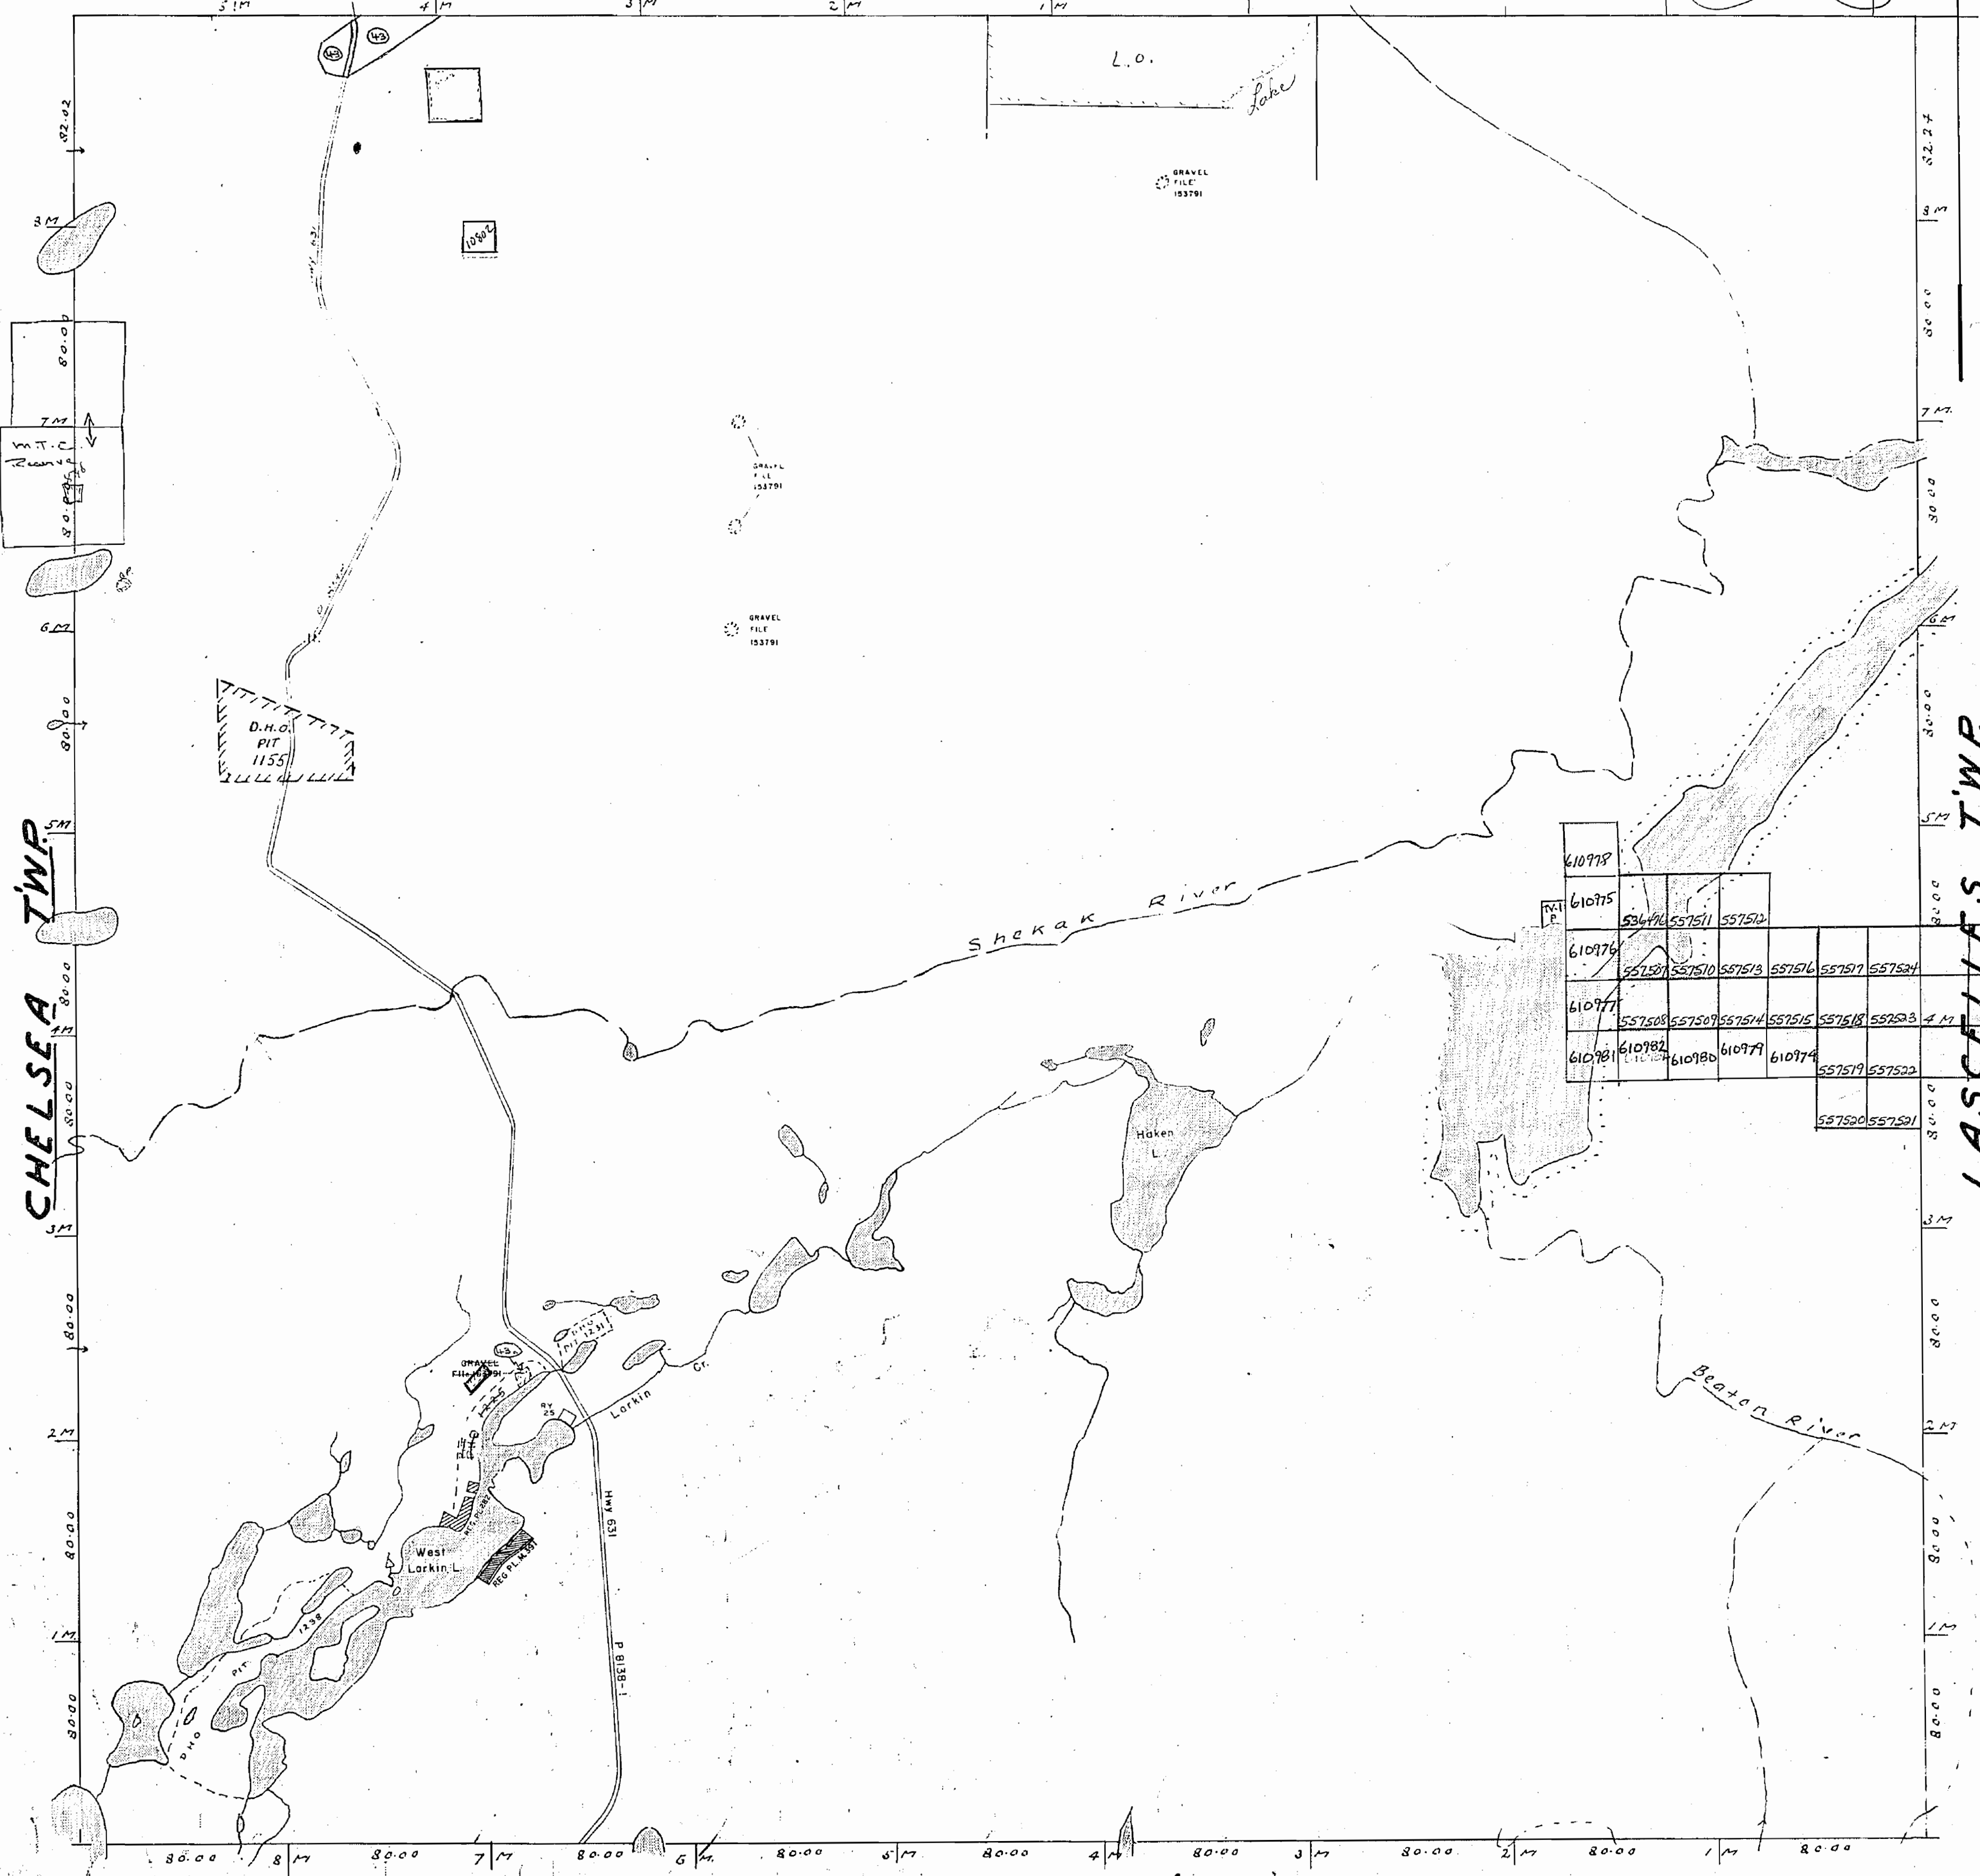

610978						
610975	53474	557511	557512			
610976	557507	557510	557513	557516	557517	557524
610977	557508	557509	557514	557515	557518	557523
610981	610982	610983	610986	610979	610974	557519
						557522
						557520
						557531

**Notes**

Railways shown thus  
Paved Highways  
Gravel  
Highway Route No.  
Other Roads  
Telegraph Lines  
Power Lines  
400' surface rights reservation around all lakes & rivers.

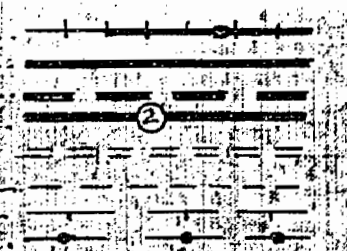

Non-perennial streams  
Bridges  
Buildings  
Swamps  
Areas marked  
Lands under  
Occupation

438 withdrawn - Public Access  
H.O.P. 1225 cancelled March 1977  
R.O. withdrawn Oct 27/76

RECEIVED  
APR 5 1977  
AM 7:18 PM 1:16




WICKSTEEPS TOWNSHIP

HAIG TOWNSHIP

CHELSEA TOWNSHIP

LASCELLES TOWNSHIP

BEATON TOWNSHIP

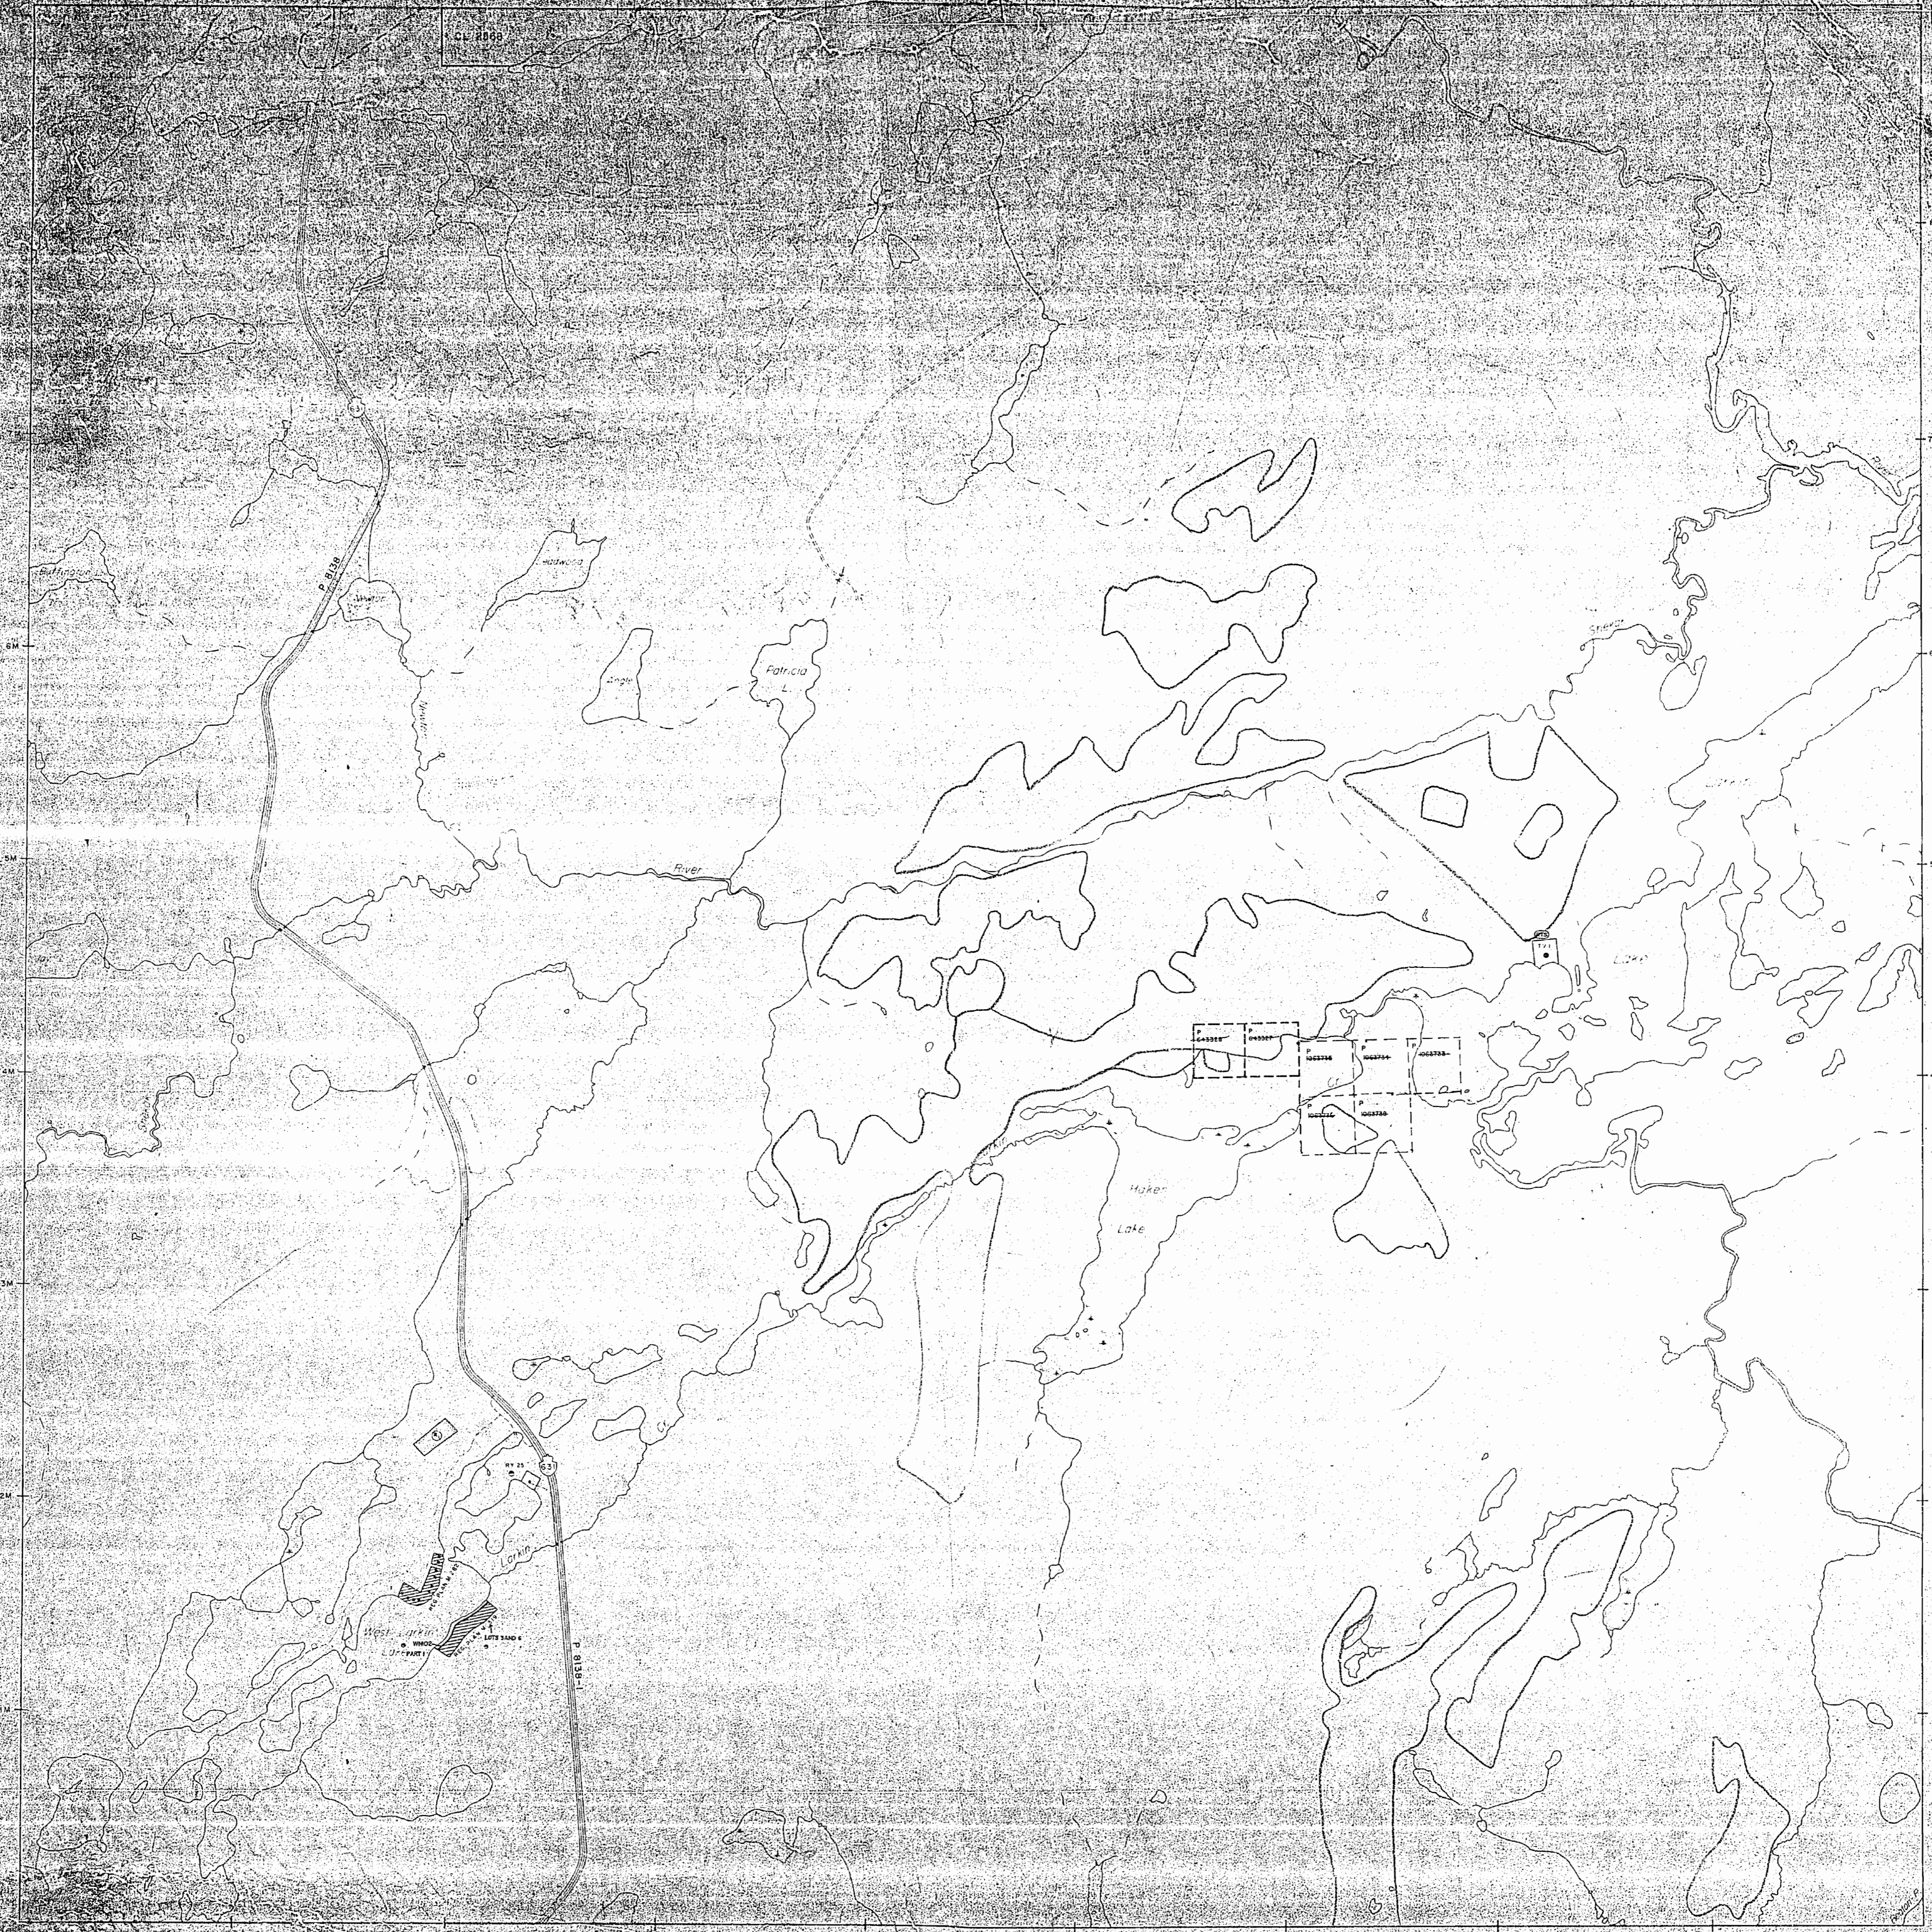

THE INFORMATION THAT APPEARS ON THIS MAP HAS BEEN COMPILED FROM VARIOUS SOURCES AND ACCURACY IS NOT GUARANTEED. THOSE WISHING TO STAKE MINING CLAIMS SHOULD CONSULT WITH THE MINING RECORDS, MINISTRY OF NORTHERN DEVELOPMENT AND REFINANCE, FOR ADDITIONAL INFORMATION ON THE STATUS OF THE LANDS SHOWN HEREON.

DATE OF ISSUE  
MAY 15 1980  
PROVINCIAL RECORDS  
OFFICE SUDBURY

**LEGEND**

**DISPOSITION OF CROWN LANDS**

UNCLASSIFIED

CLASSIFIED

LEASE

SURFACE RIGHTS ONLY

MINIMUM RIGHTS ONLY

EXERCISE OF SUPERVISORY JURISDICTION

EMERGENCY COUNCIL

RESTRICTION

CANCELLED

SAND & GRAVEL

WHITE TOMB SET


NOTE: MINING RIGHTS IN PARTIAL PATENTED LANDS ARE SUBJECT TO THE STATUS OF THE LANDS ACT R.S.O. 1980, CHAPTER 280.

SCALE 1:20 000

THIS MAP IS SUBJECT TO FOREST ACTIVITIES IN LAW AND OTHER FURTHER INFORMATION AVAILABLE ON FILE.

THE INFORMATION THAT APPEARS ON THIS MAP HAS BEEN COMPILED FROM VARIOUS SOURCES AND ACCURACY IS NOT GUARANTEED. THOSE WISHING TO STAKE MINING CLAIMS SHOULD CONSULT WITH THE MINING RECORDS, MINISTRY OF NORTHERN DEVELOPMENT AND REFINANCE, FOR ADDITIONAL INFORMATION ON THE STATUS OF THE LANDS SHOWN HEREON.

TOWNSHIP  
**LARKIN**  
M.N.R. ADMINISTRATIVE DISTRICT  
**HEARST**  
MINING DIVISION  
**PORCUPINE**  
LAND TITLES / REGISTRY DIVISION  
**SAULT STE. MARIE**

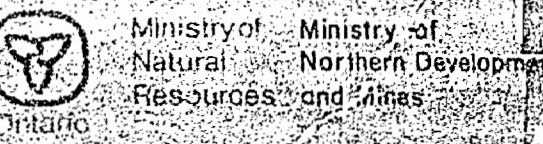

SEPTEMBER 1988  
G-2324








# PLAN OF LARKIN TWP. M-1293


*Pop Culture*  
SAULT STE MARIE MINING DIVISION  
DISTRICT OF ALGOMA.

—Scale 40 chains to an inch.—

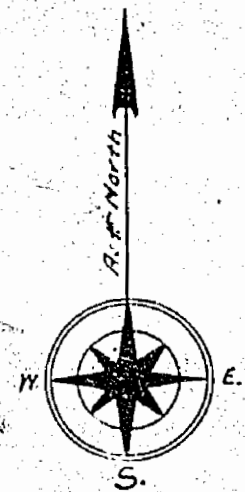

WICKSTEED TWP.

HAIG TWP.

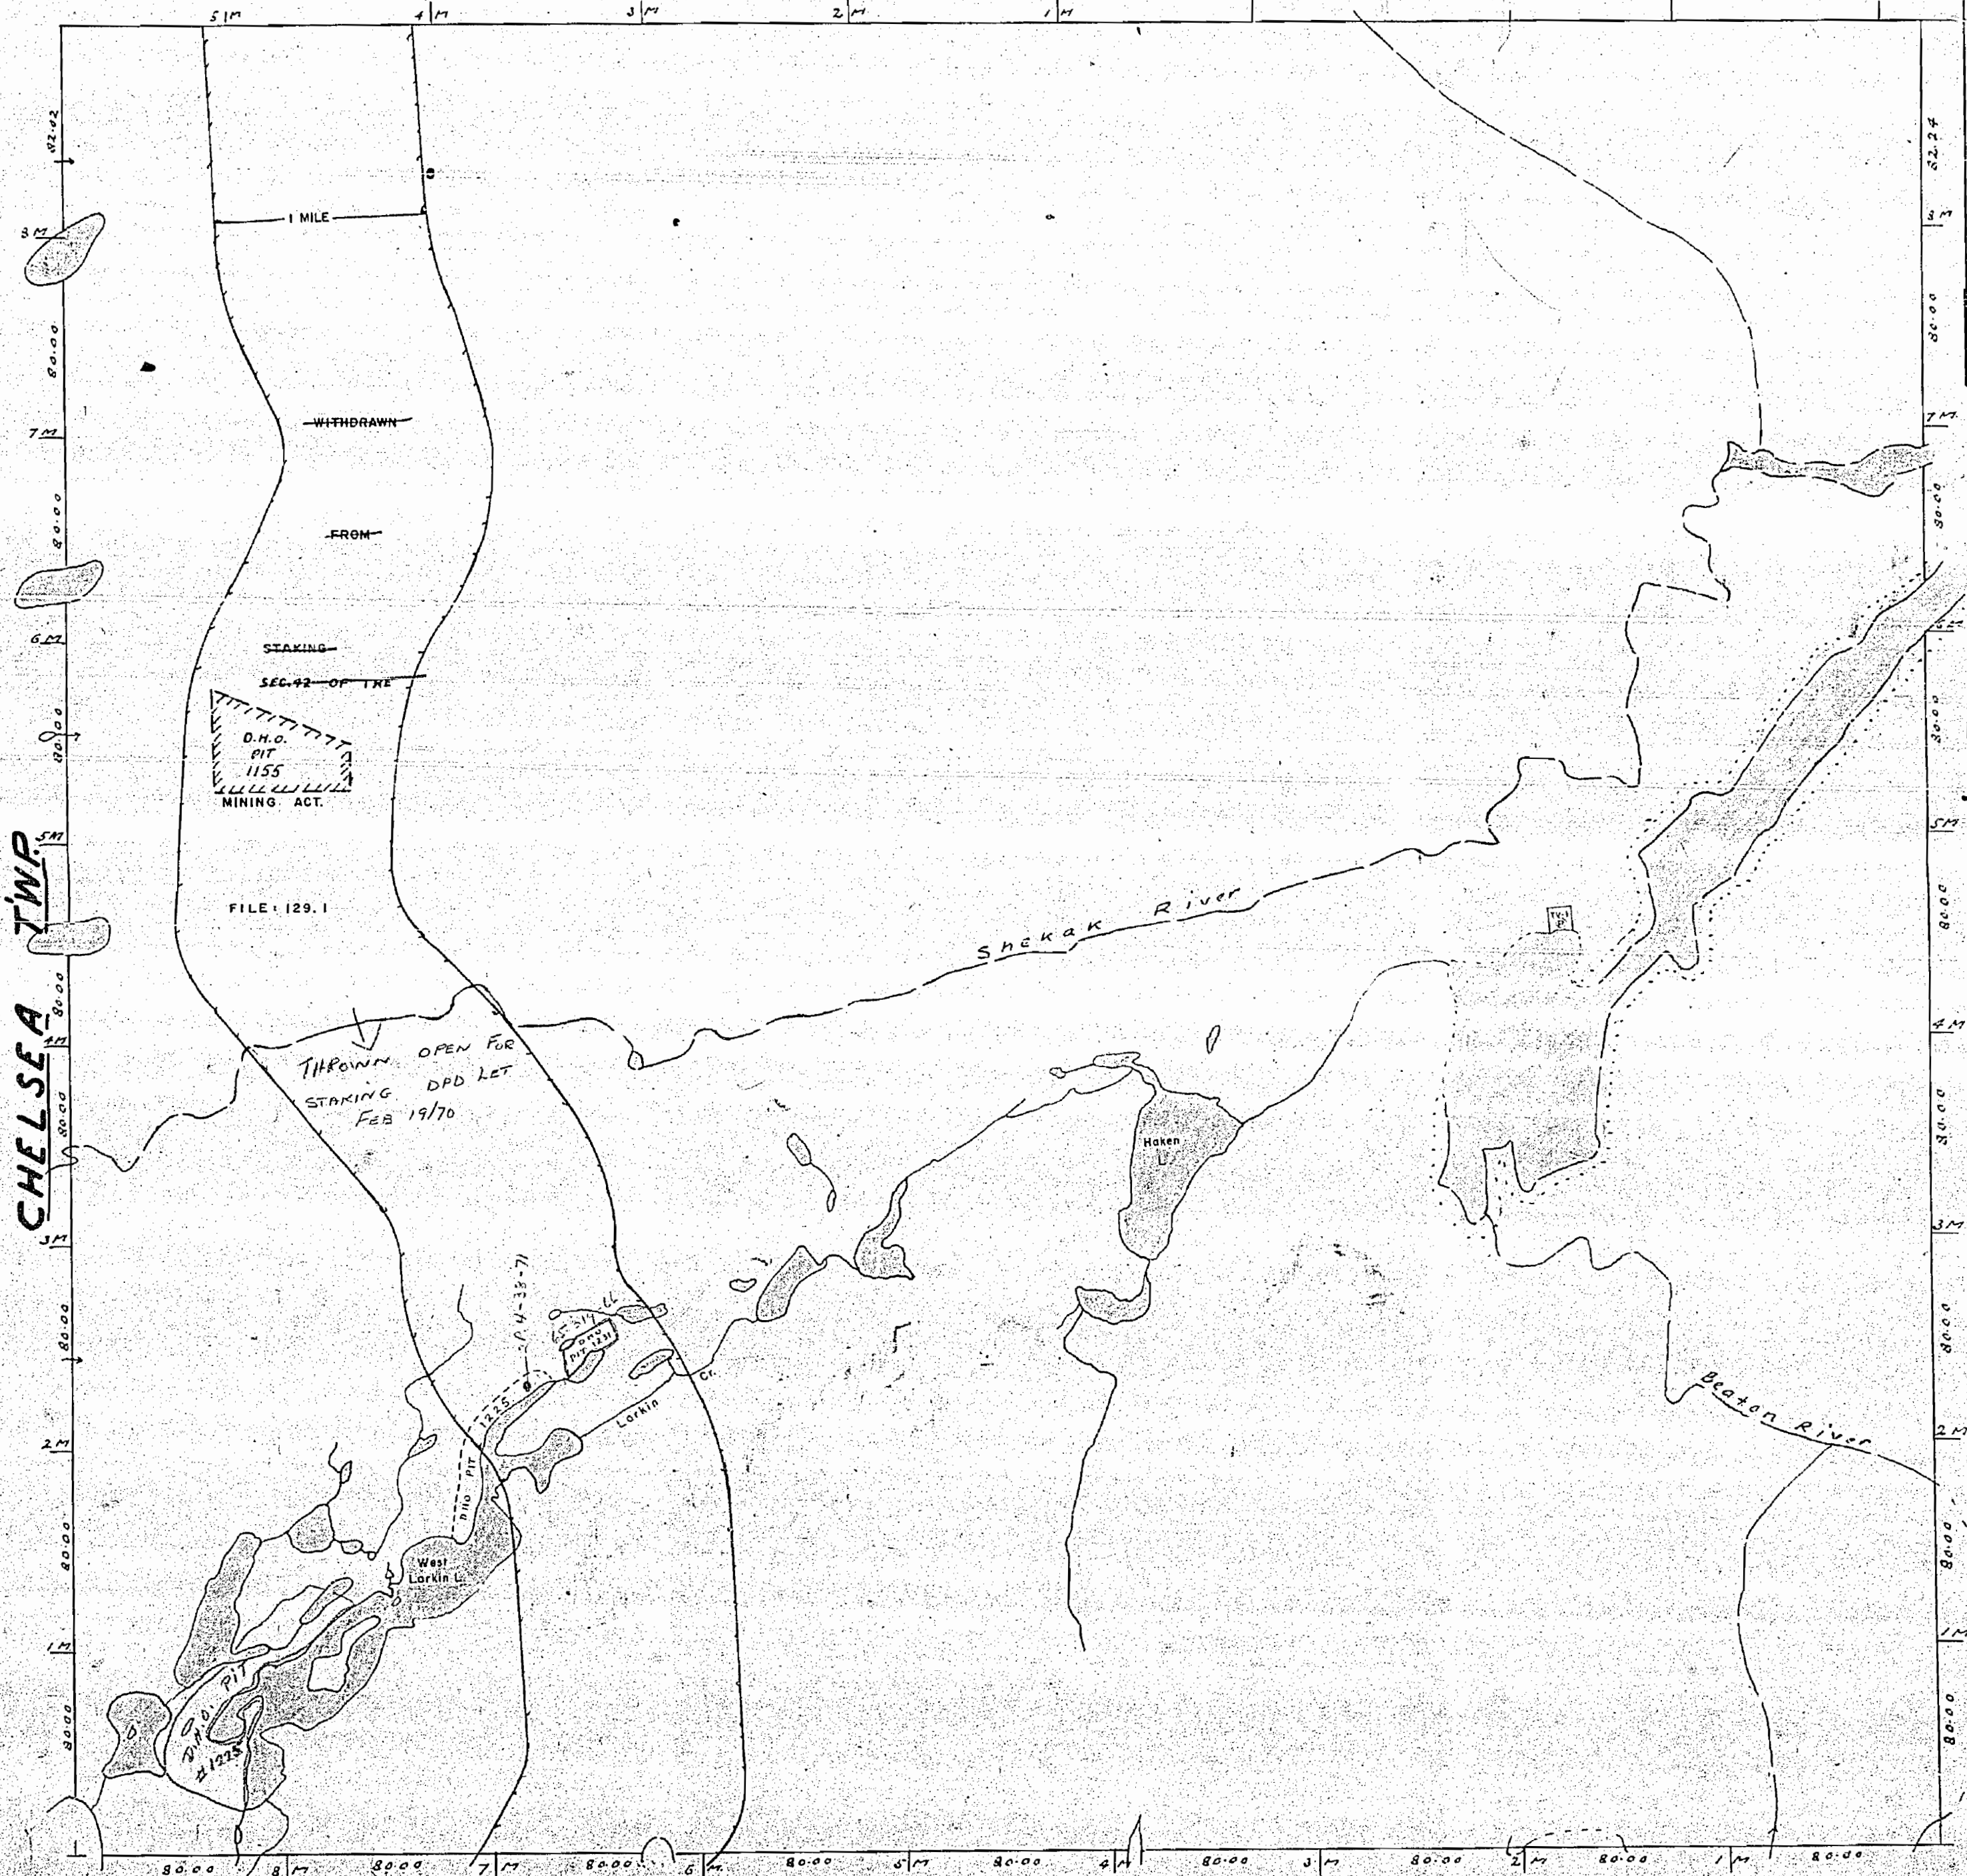

CHELSEA TWP.

LASCELLES TWP.

BEATON TWP.

**NOTES**

Railways shown thus  
Paved Highways  
Gravel  
Highway Route No.  
Other Roads



Non-perennial streams  
Bridges  
Swamps  
Dredging  
Other




1293

# PLAN OF LARKIN TWP. M-1293


*Porcupine*  
~~SAULT STE. MARIE~~ MINING DIVISION  
DISTRICT OF ALGOMA.

—Scale 40 chains to an inch.—

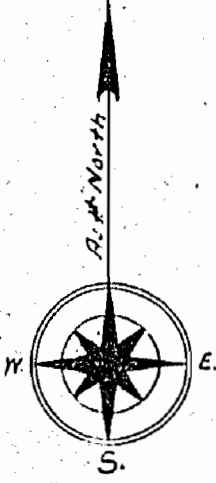

WICKSTEED TWP.

HAIG TWP.

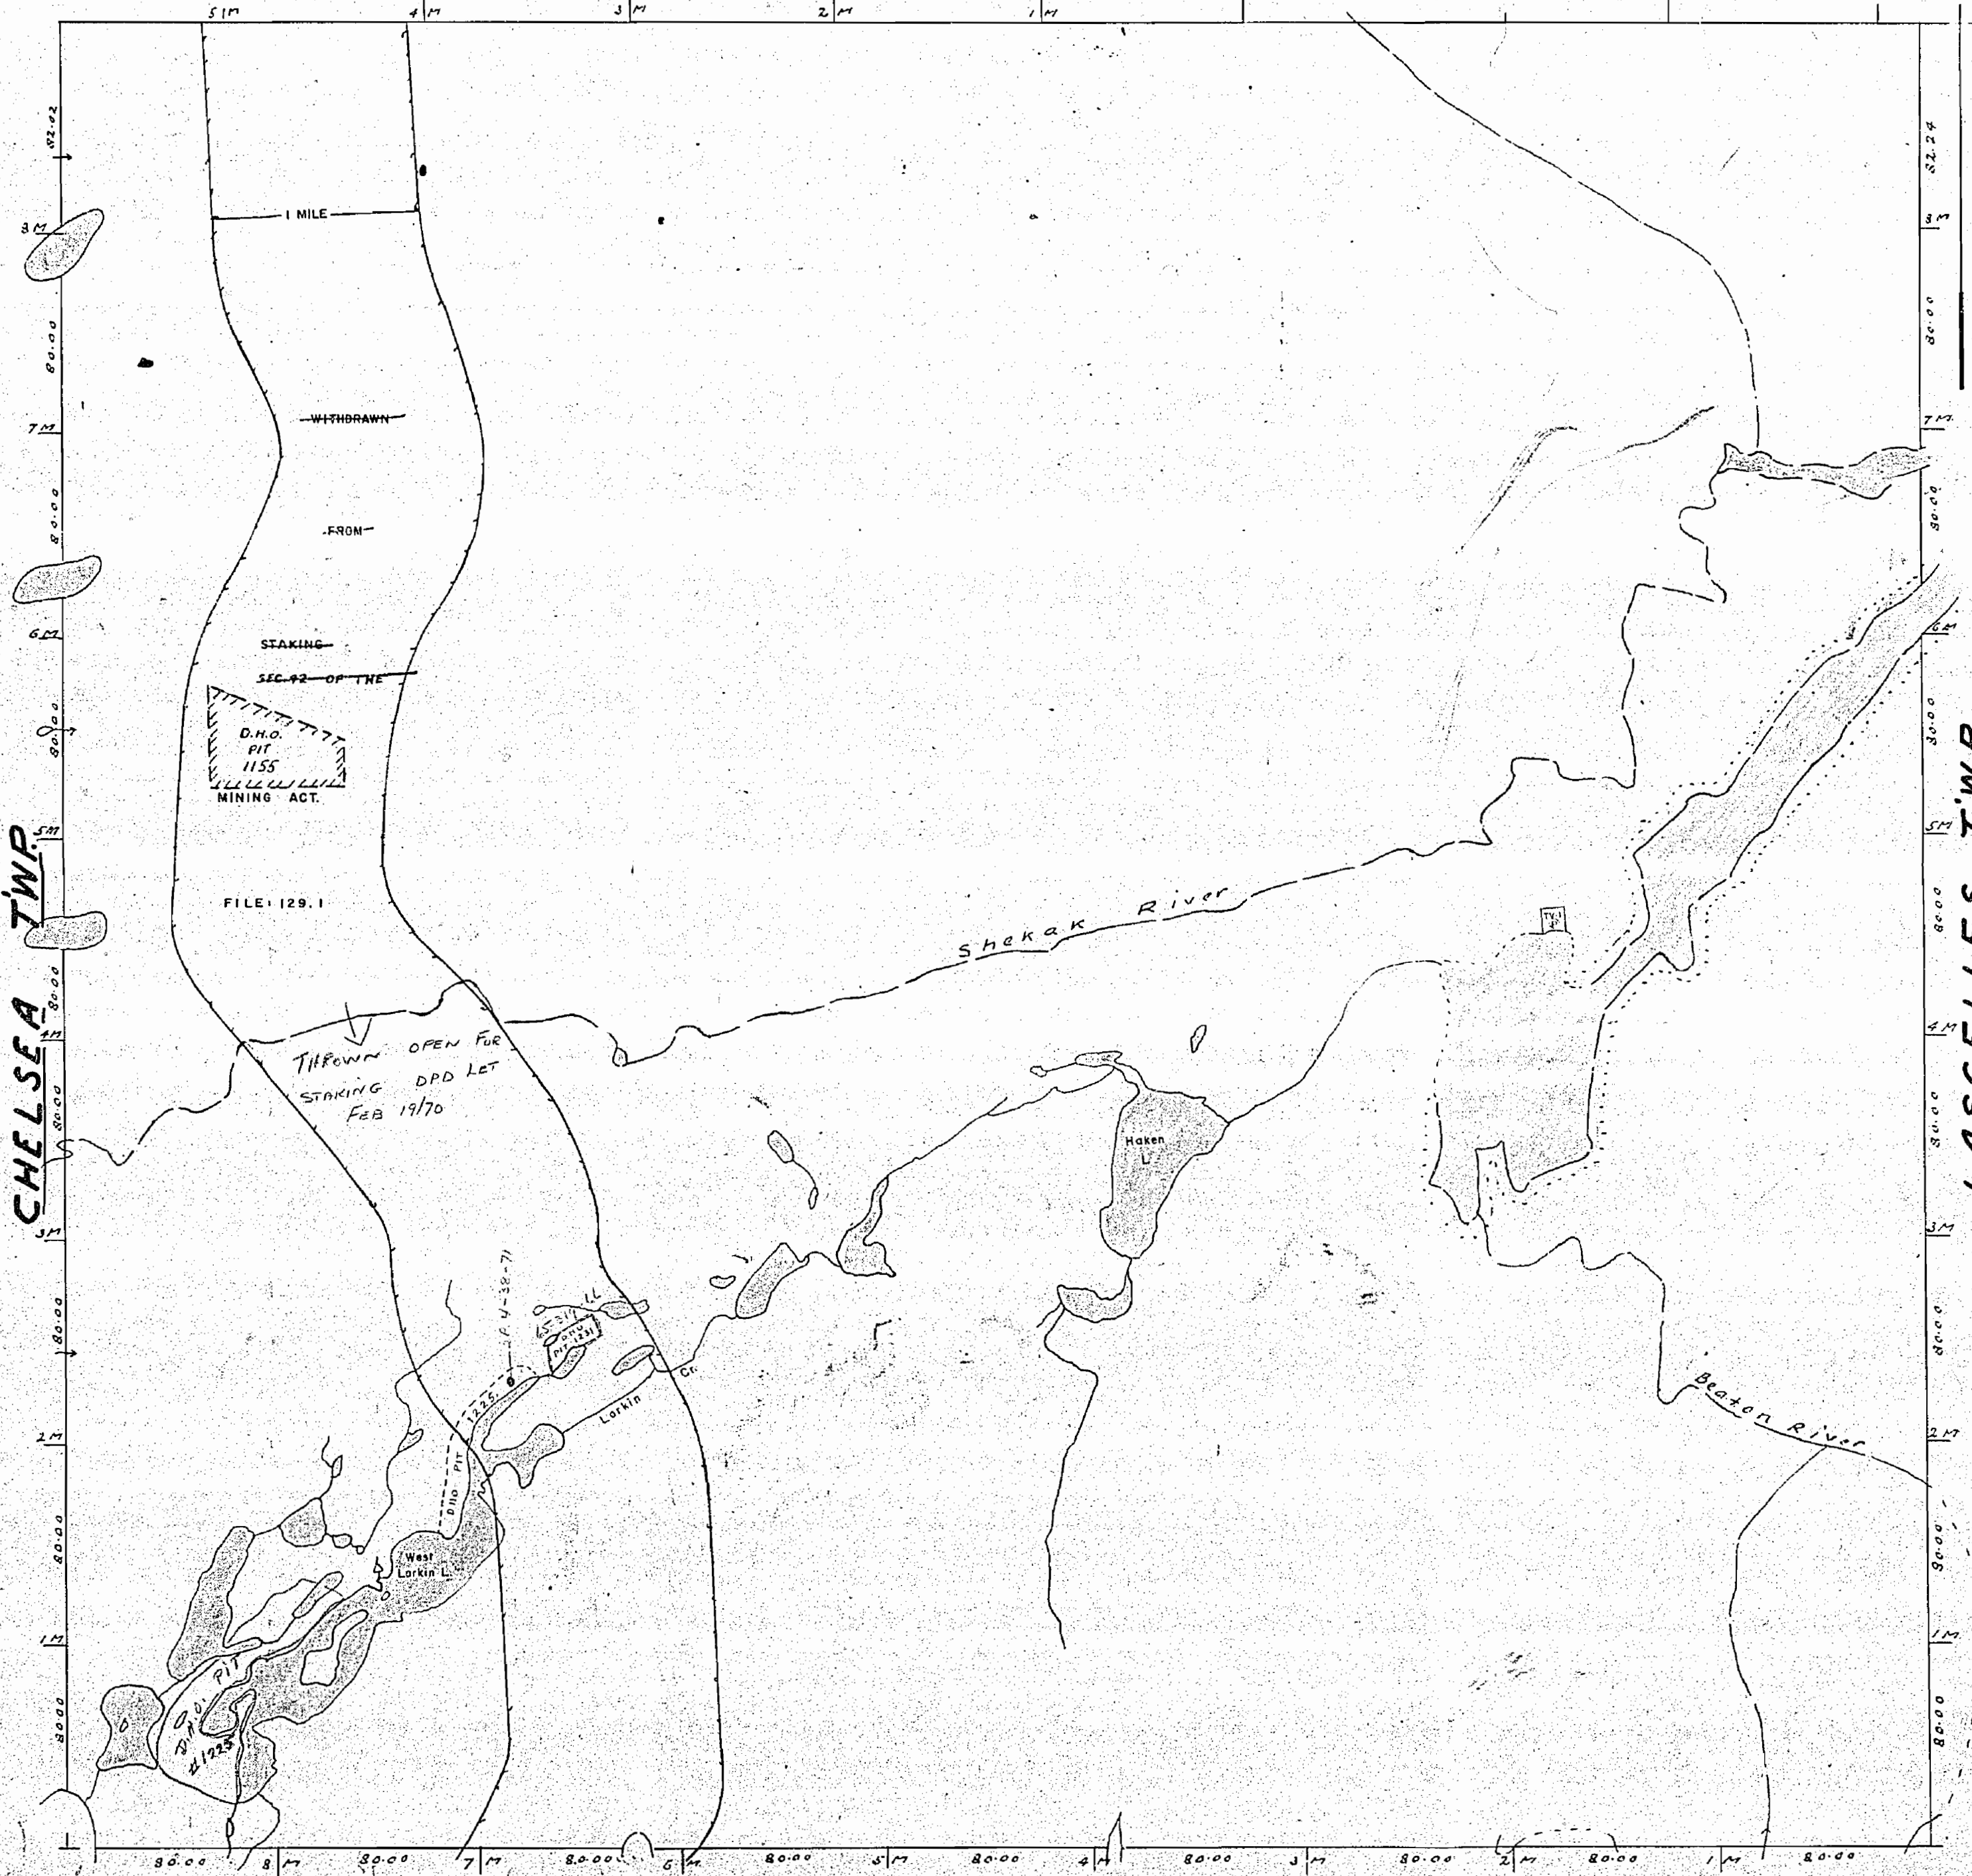

**Notes**

Railways shown thus	Non-perennial streams
Paved Highways	Bridges
Gravel	Buildings
Highway Route No.	Swamps
Other Roads	Areas marked
Trails Paths	are
Telephone & Telegraph Lines	Reserved
Electric Power Lines	Under
	Lease
	Occupation

400' surface rights reservation around all lakes & rivers.

BEATON TWP.




1293

# PLAN OF LARKIN TWP. M-1293


*Porcupine*  
~~SAULT STE MARIE~~ MINING DIVISION.  
DISTRICT OF ALGOMA.

—Scale 40 chains to an inch.—

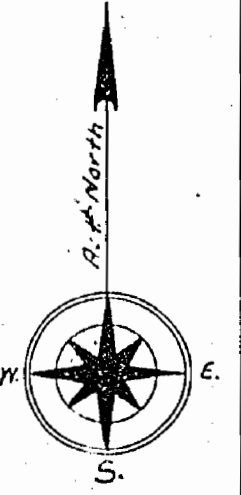

WICKSTEED TWP.

HAIG TWP.

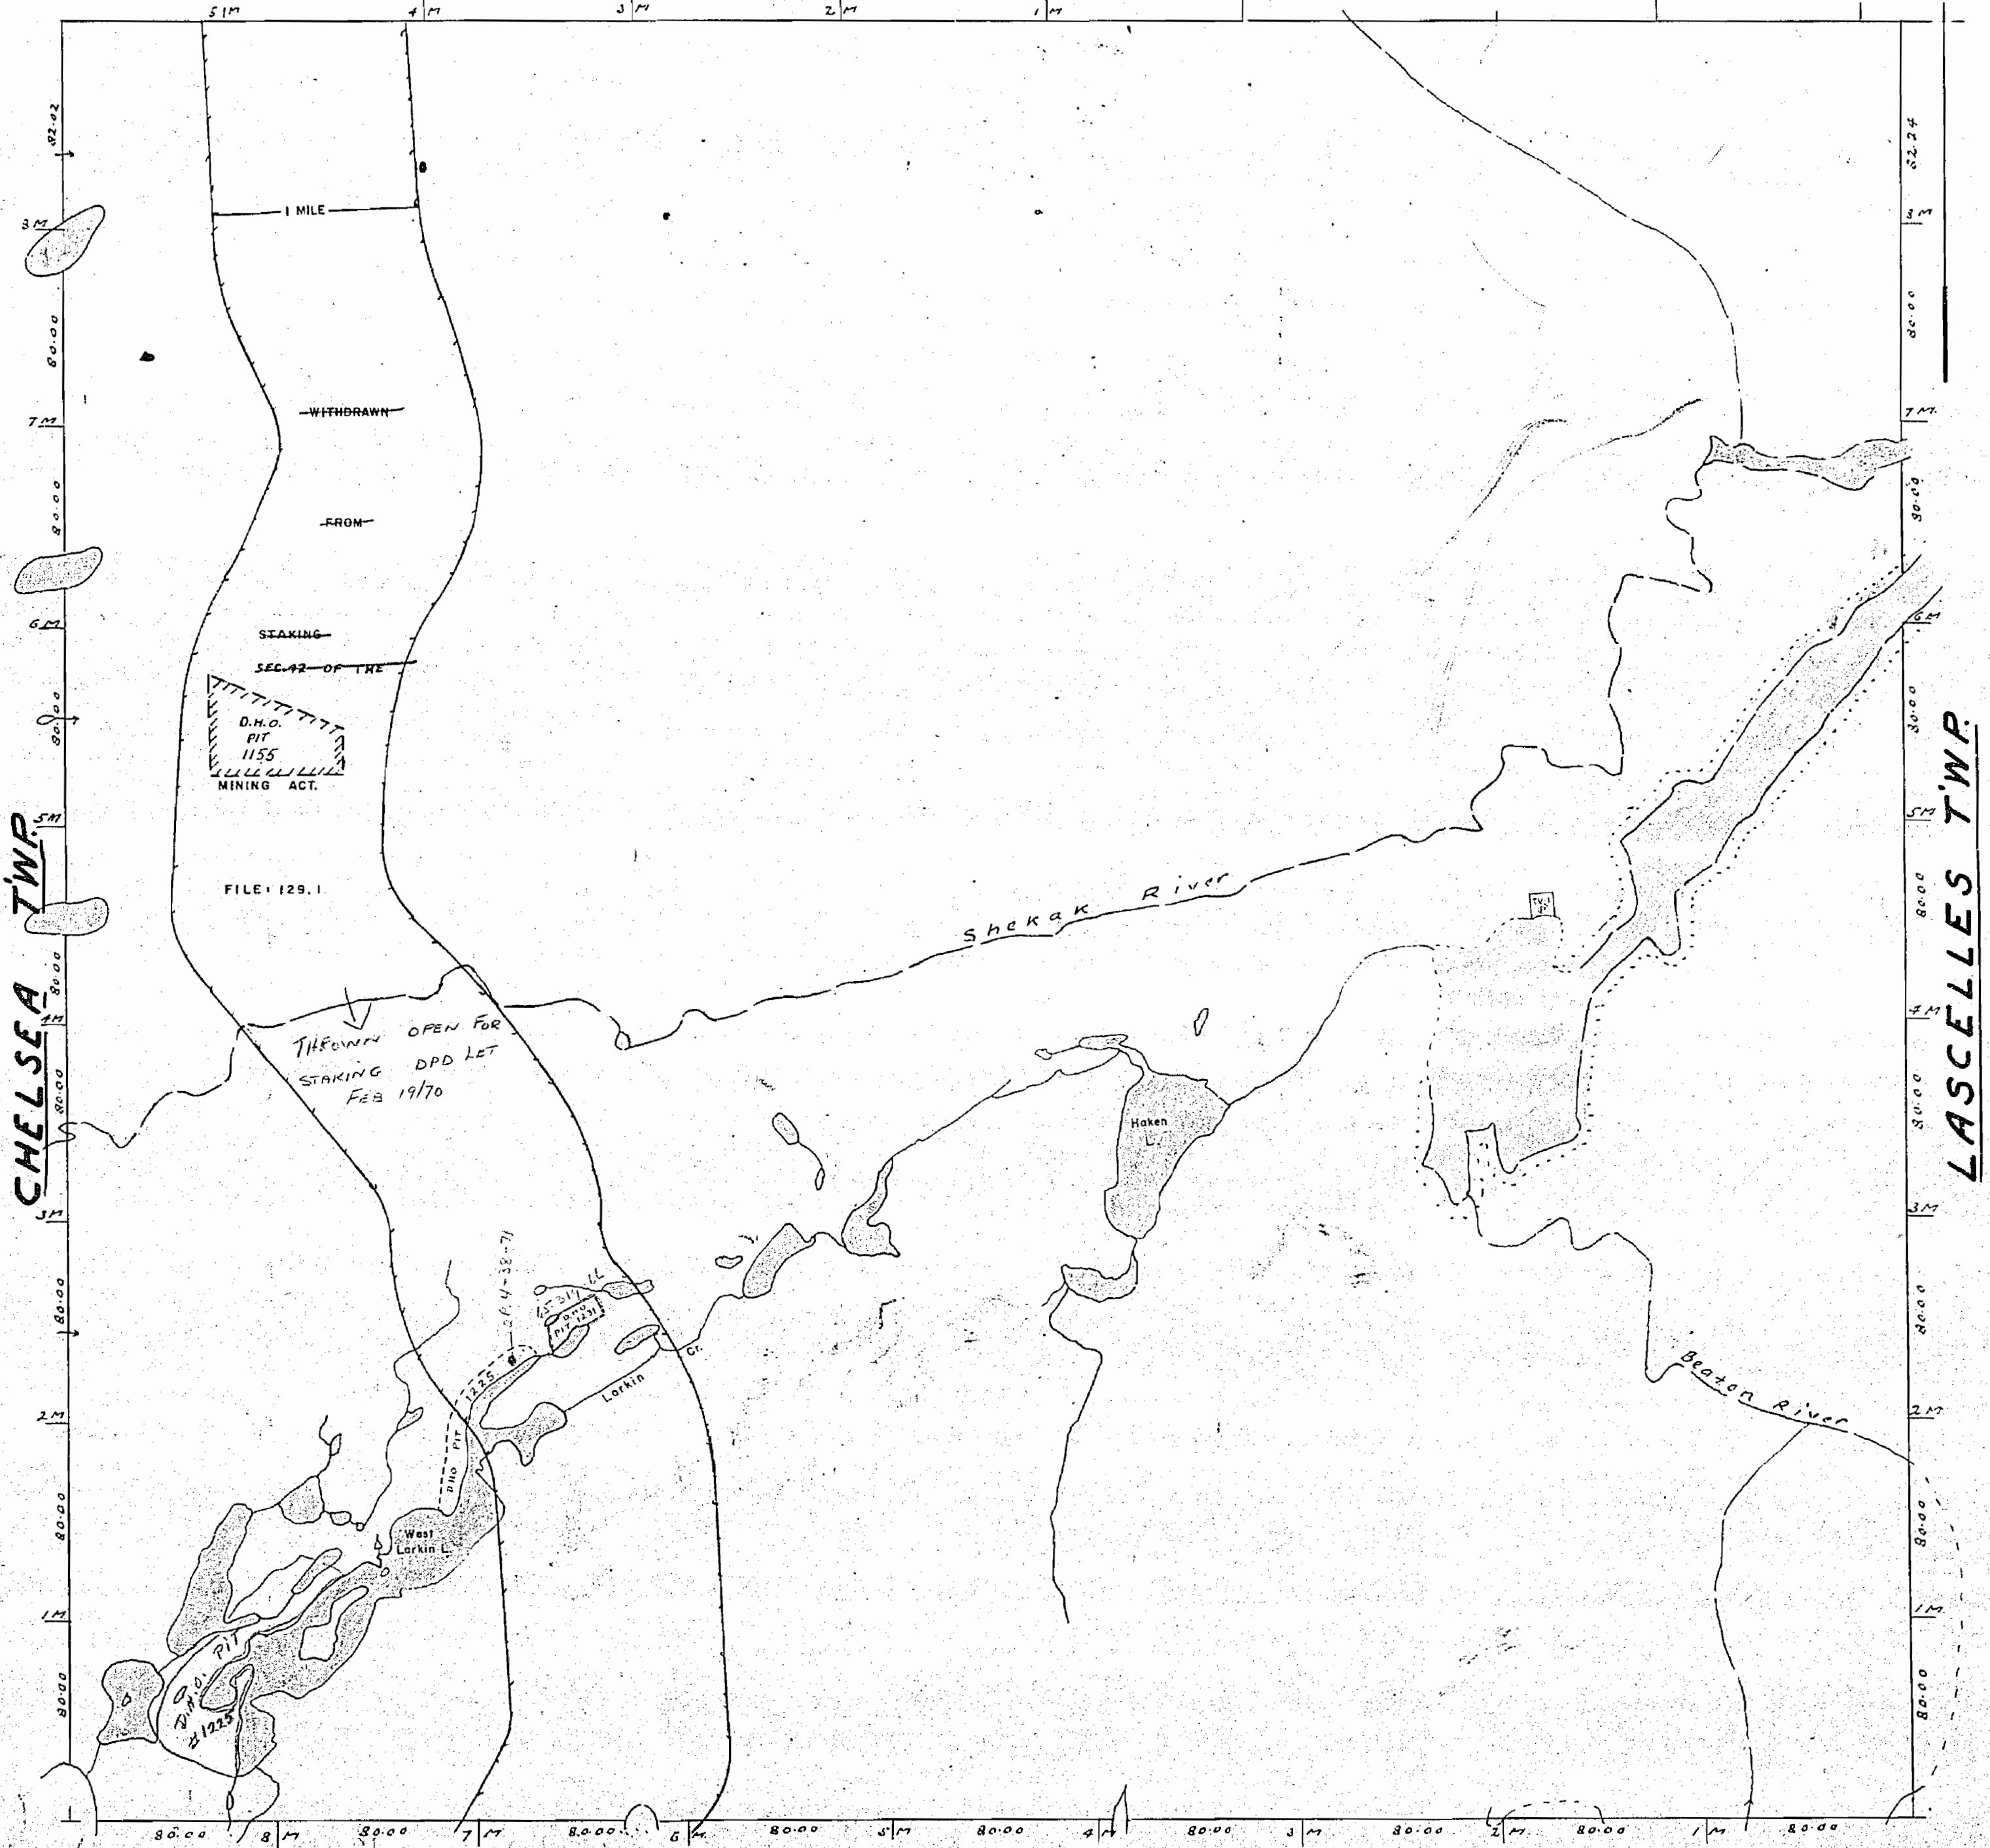

FILE 129.1

THE TOWN OPEN FOR  
STAKING DPD LET  
FEB 1970

WITHDRAWN  
FROM  
STAKING  
SEC. 42 OF THE  
D.H.O.  
PIT  
1155  
MINING ACT.

BEATON TWP.

**Notes**

- Railways shown thus
- Paved Highways
- Gravel Highway Route No.
- Other Roads
- Trails Paths
- Telephone Telegraph Lines
- Electric Power Lines
- K.U.P.

- Non-perennial streams
- Bridges
- Buildings
- Swamps
- Great marsh
- ② or ③ Potential
- ④ or ⑤ Held under
- ⑥ or ⑦ License or Occupation

400 surface rights reservation around all lakes & rivers.





# PLAN OF LARKIN TWP. M-1293

<sup>Porcupine</sup> SAULT STE MARIE MINING DIVISION  
DISTRICT OF ALGOMA.

—Scale 40 chains to an inch.—

WICKSTEED TWP

HAIG TWP

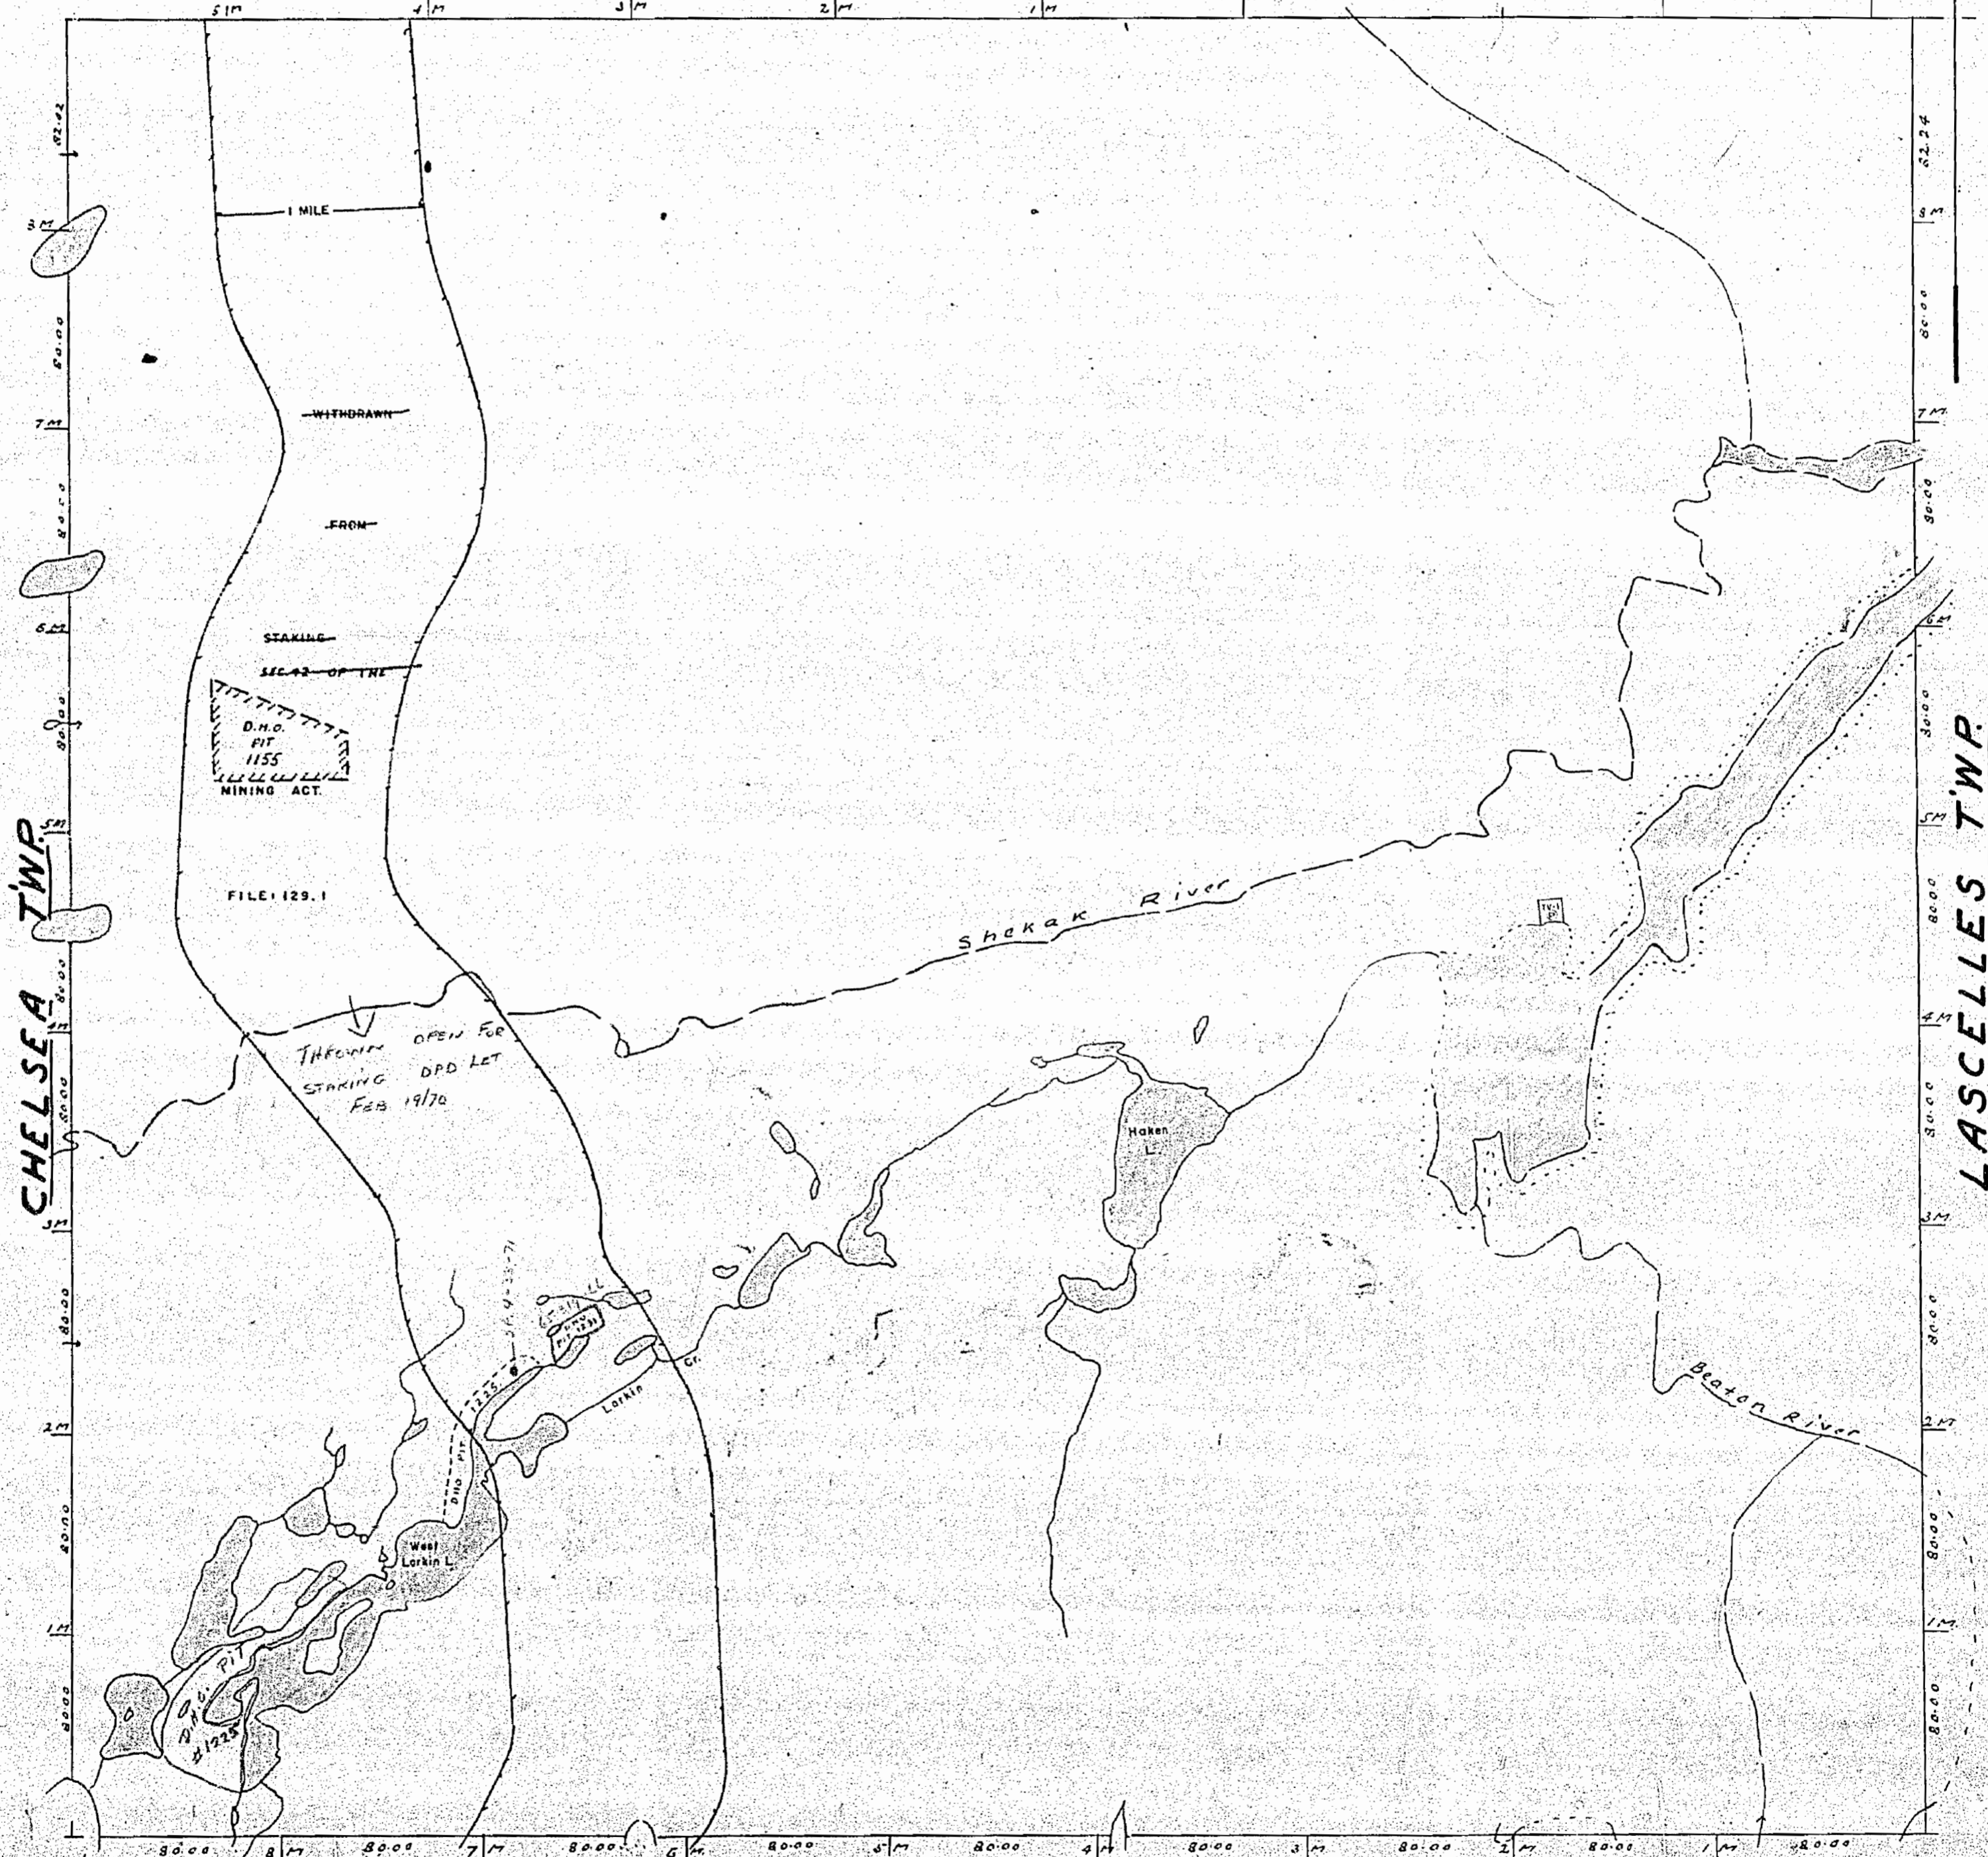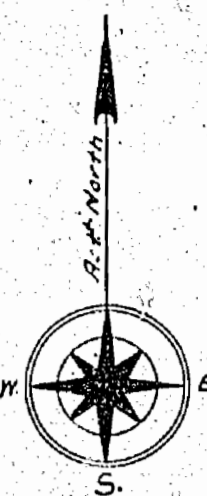

CHELSEA TWP

LASCELLES TWP

BEATON TWP

**Notes**

Railways shown thus	Non-perennial stream
Canals	Bridges
Highways	Buildings
Gravel	Streams
Highway Route No.	Clearing
Other Roads	Reservoir
Trails & Paths	Fields
Telephone & Power Lines	Fields under
Electric Power Lines	License of Occupation


400' surface rights reservation around all lakes & rivers.



PLAN OF  
**LARKIN TWP.**  
SAULT STE. MARIE MINING DIVISION.  
DISTRICT OF ALGOMA.


m-1293

—Scale 40 chains to an inch.—

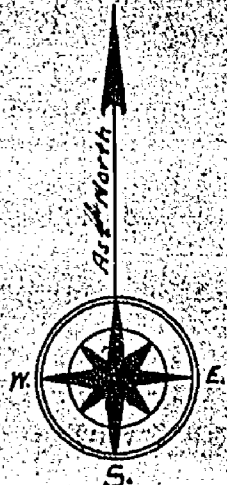

WICKSTEED TWP.

HAIG TWP.

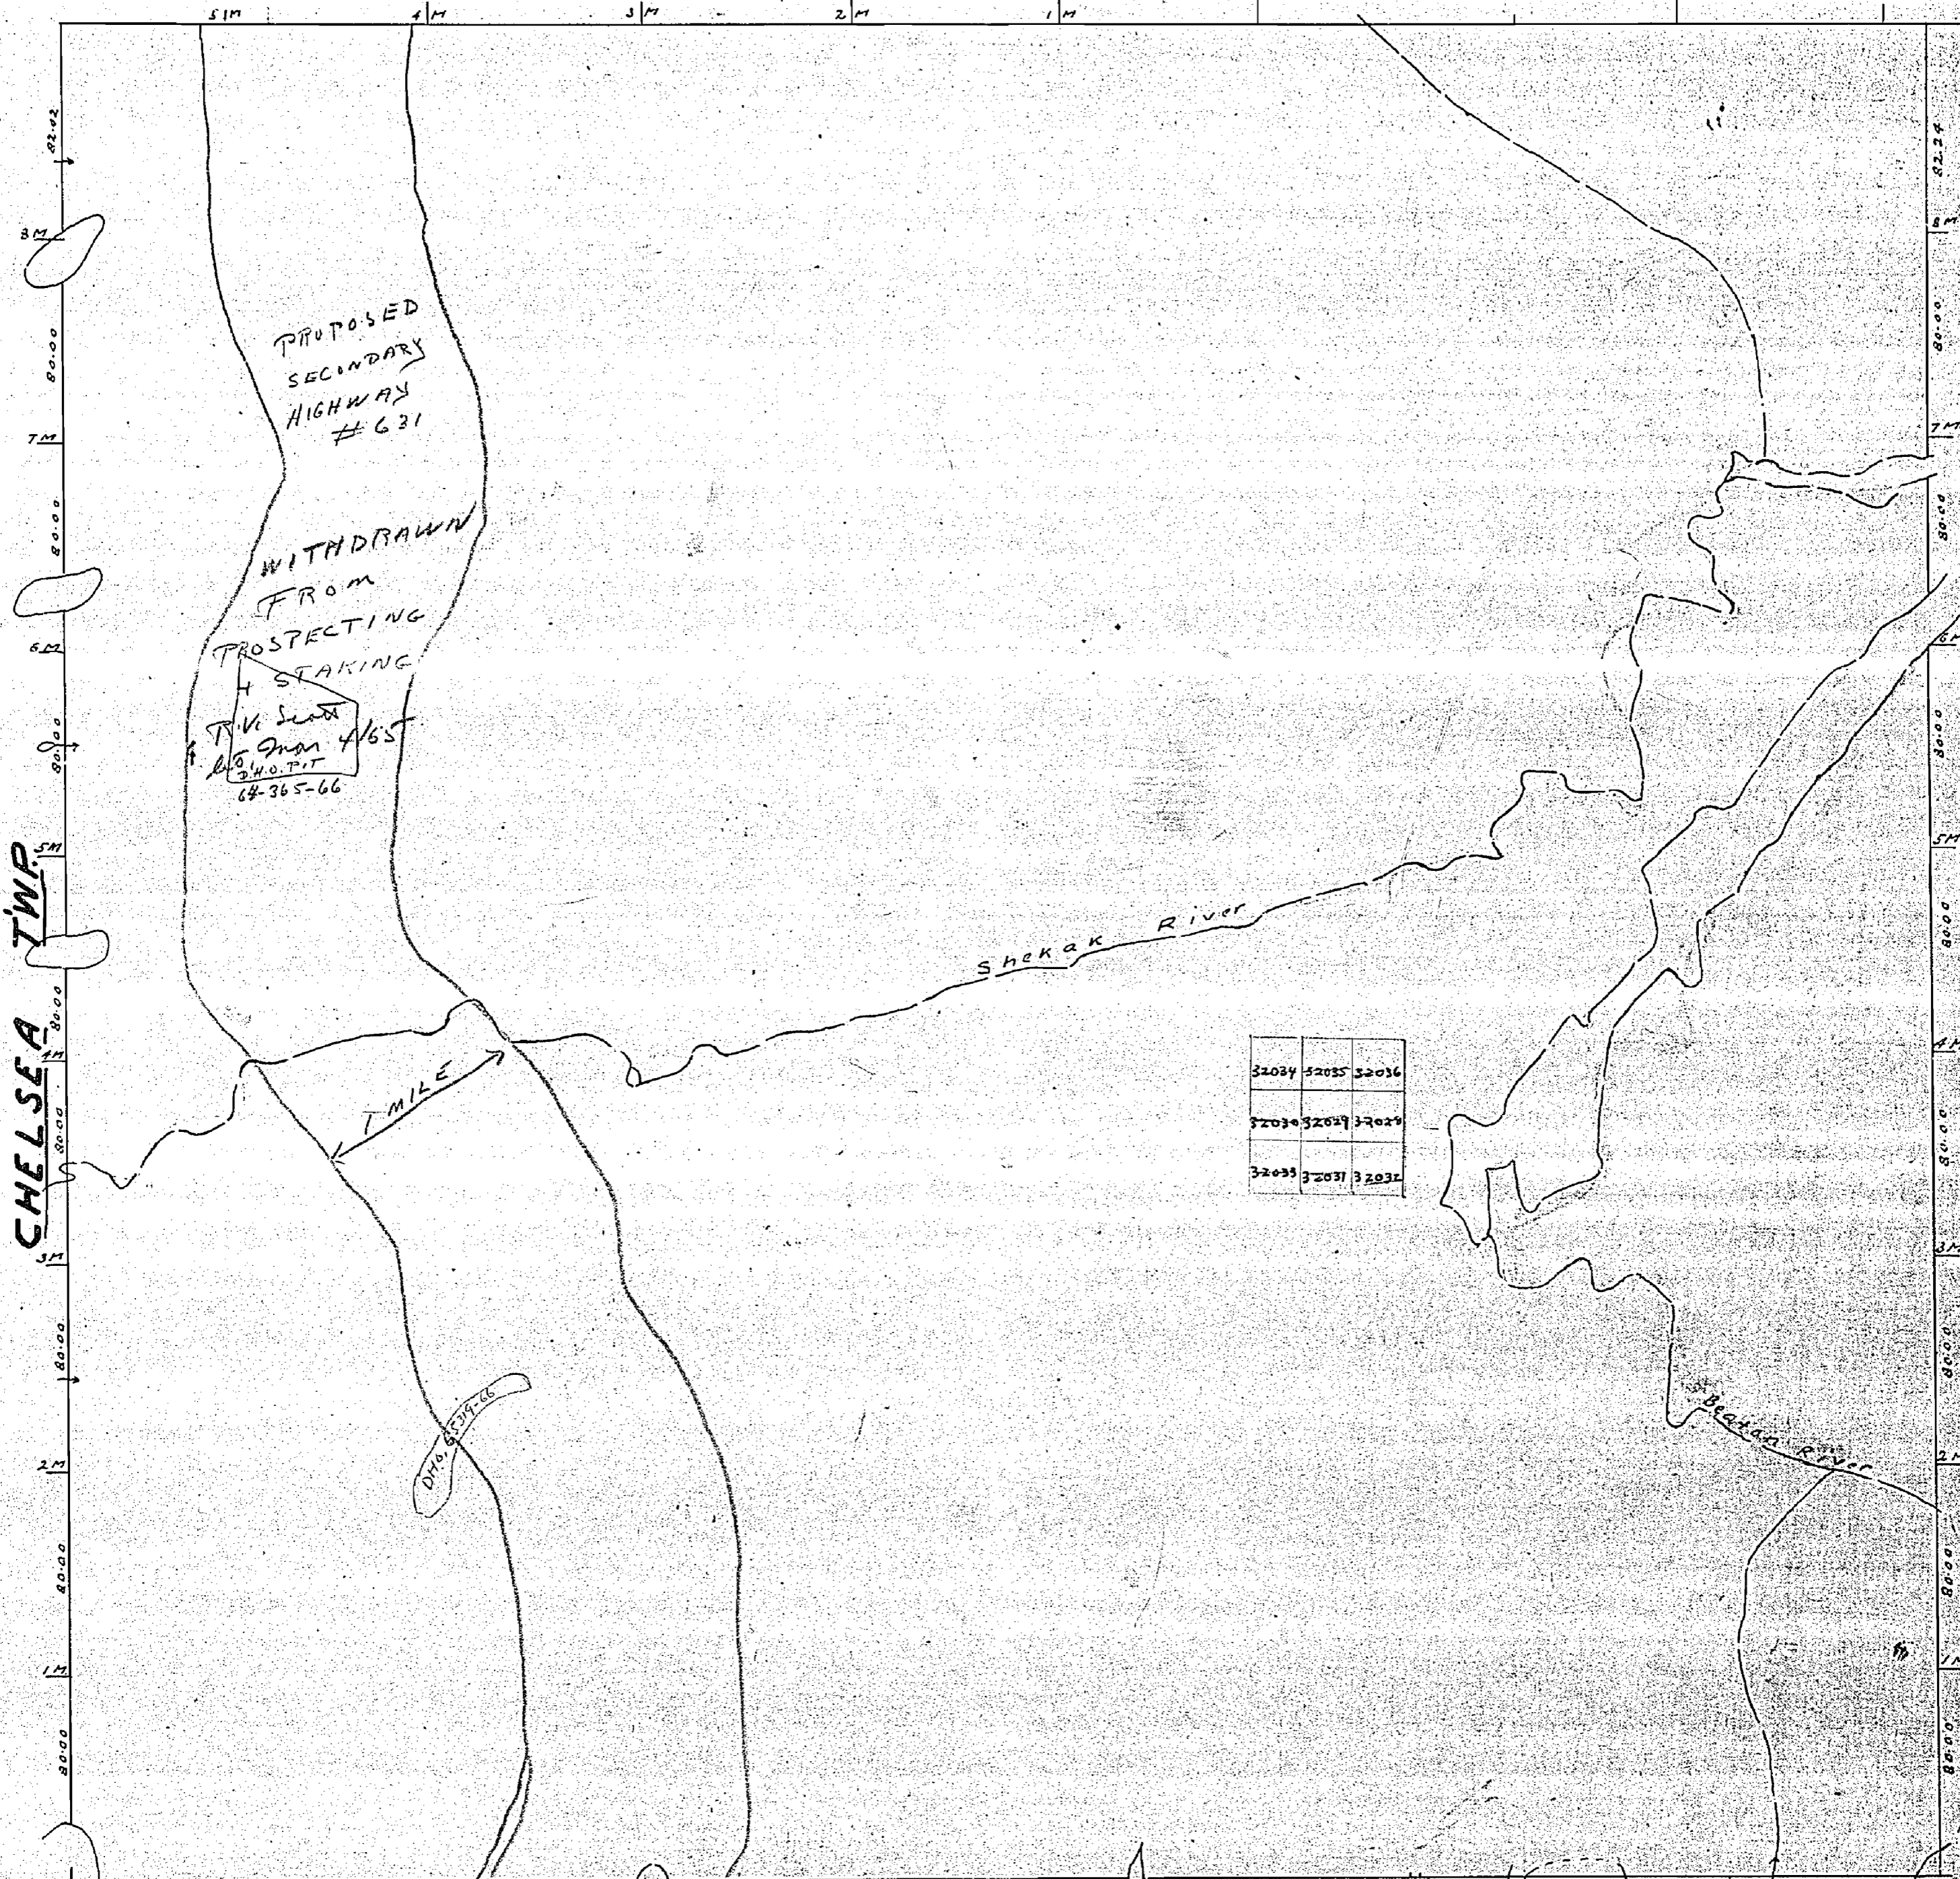

32034	32035	32036
32037	32038	32039
32040	32041	32042

BEATON TWP.

- Notes**
- Railways shown thus
  - Paved Highway
  - Gravel Highway Route No.
  - Other Roads
  - Trails & Paths
  - Telephone & Telegraph Lines
  - Electric Power Lines
  - Non-perennial streams
  - Bridges
  - Buildings
  - Swamps
  - Areas marked or Patented
  - Leased
  - held under License of Occupation



