

Bleazard Twp.

~~large fall~~

THE TOWNSHIP OF

MCKIM

DISTRICT OF SUDBURY

SUDBURY

MINING DIVISION


SCALE: 1-INCH = 40 CHAINS

LEGEND

- | | |
|-----------------------|-------------|
| PATENTED LAND | (P) |
| CROWN LAND SALE | (S) or C.S. |
| LEASES | (L) |
| LOCATED LAND | LOC. |
| LICENSE OF OCCUPATION | L.O. |
| MINING RIGHTS ONLY | M.R.O. |
| SURFACE RIGHTS ONLY | S.R.O. |
| ROADS | |
| IMPROVED ROADS | |
| KING'S HIGHWAYS | |
| RAILWAYS | |
| POWER LINES | |
| MARSH OR MUSKEG | |
| MINES | |

NOTES

MINING RECORDERS OFFICE LOCATED
AT WAISBERG BLOCK 5 YOUNG ST.
NORTH SUDBURY.

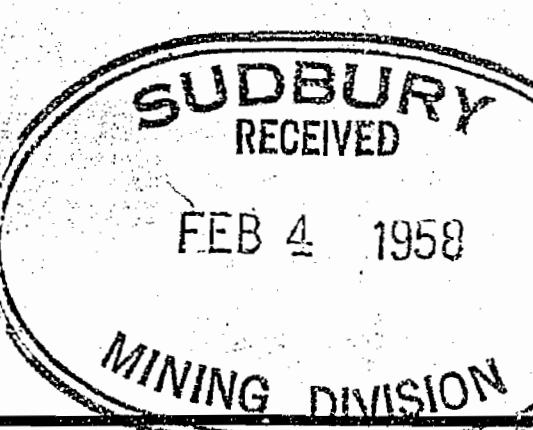

PLAN NO.- M- 1013

**DEPARTMENT OF MINES
— ONTARIO —**

OFFICE USE ONLY

Blezar Twp.

THE TOWNSHIP
OF

McKIM

DISTRICT OF
SUDBURY

SUDBURY
MINING DIVISION

SCALE: 1-INCH=40 CHAINS

LEGEND

- PATENTED LAND
- CROWN LAND SALE
- LEASES
- LOCATED LAND
- LICENSE OF OCCUPATION
- MINING RIGHTS ONLY
- SURFACE RIGHTS ONLY
- ROADS
- IMPROVED ROADS
- KING'S HIGHWAYS
- RAILWAYS
- POWER LINES
- MARSH OR MUSKEG
- MINES


NOTES

MINING RECORDERS OFFICE LOCATED
AT WAISBERG BLOCK 5 YOUNG ST.
NORTH SUDBURY.

400' surface rights reservation around all
lakes and river.

subj to see 37

* IN SERVICE 1971 04 13th. - VCM

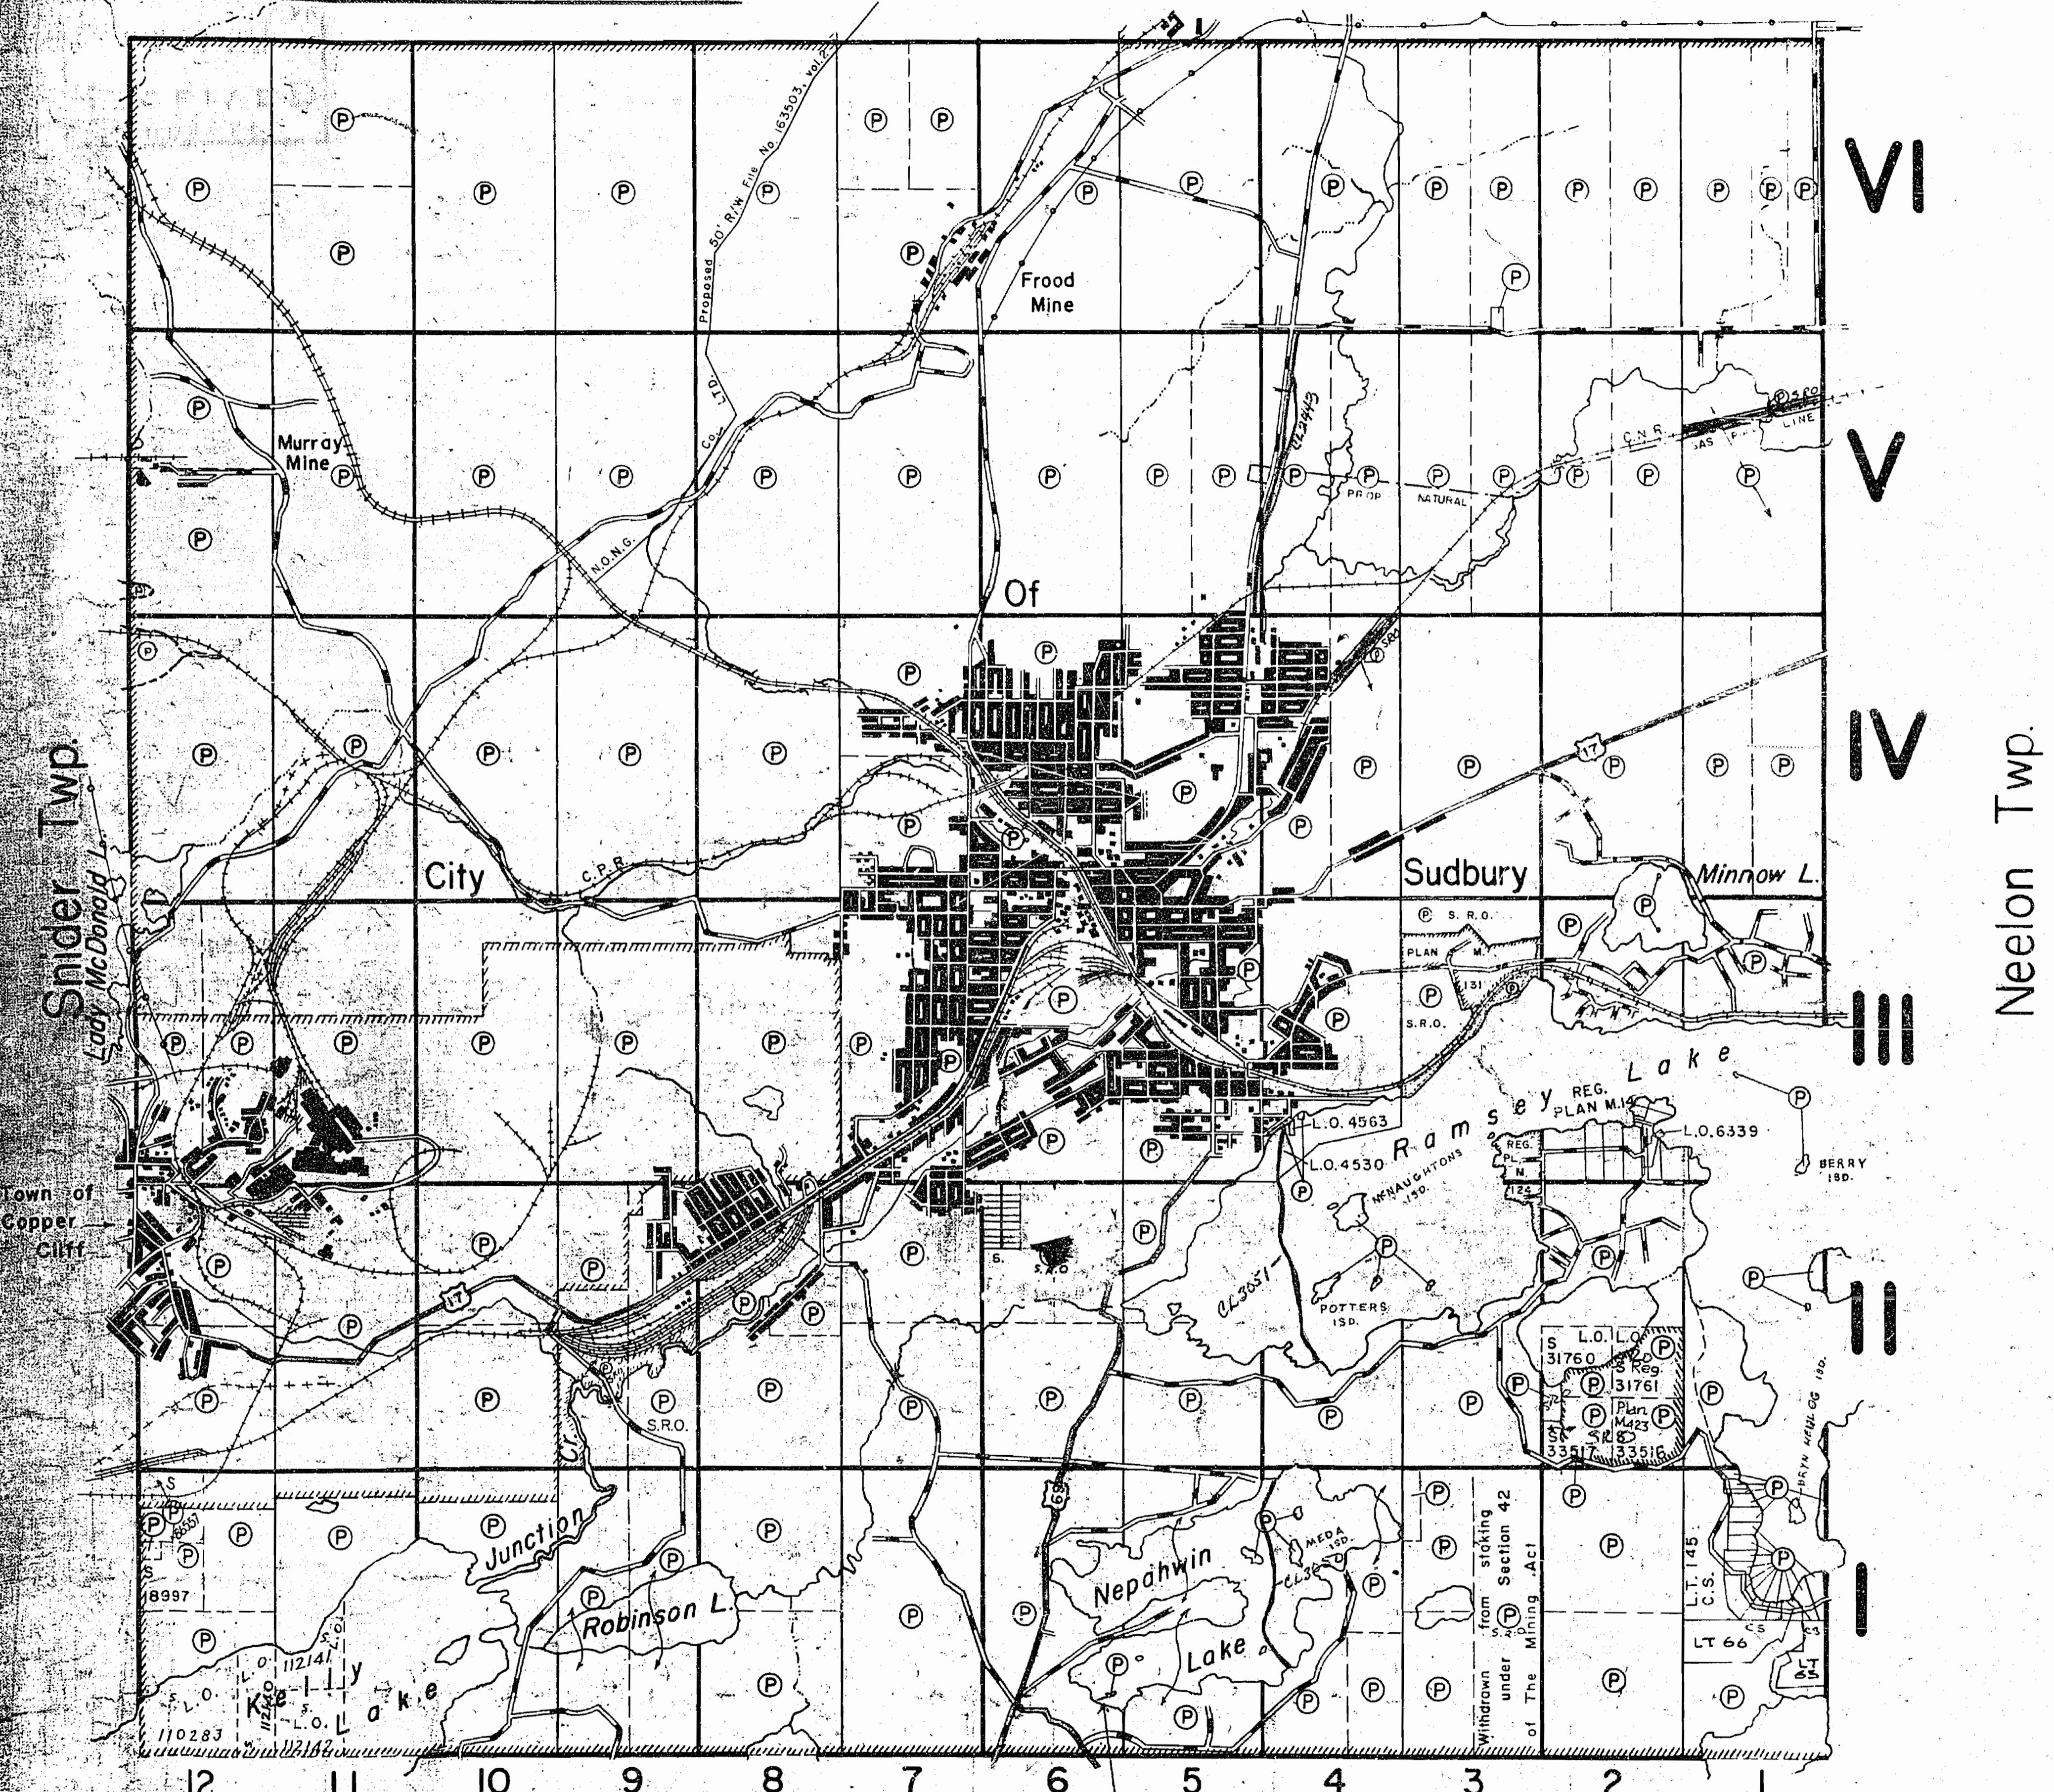

Broder Twp.

MCKIM

PLAN NO.- M-1013

ONTARIO
DEPARTMENT OF MINES
AND NORTHERN AFFAIRS

Aug. 22 1984

THE TOWNSHIP
OF

McKIM


DISTRICT OF
SUDBURY
SUDBURY
MINING DIVISION

SCALE: 1-INCH= 40 CHAINS

LEGEND

(P)	CROWN LAND SALE
(S) or C.S.	LEASES
(L)	LOCATED LAND
L.O.	LICENSE OF OCCUPATION
M.R.O.	MINING RIGHTS ONLY
S.R.O.	SURFACE RIGHTS ONLY
ROADS	ROADS
IMPROVED ROADS	KING'S HIGHWAYS
RAILWAYS	RAILWAYS
POWER LINES	POWER LINES
MARSH OR MUSKEG	MARSH OR MUSKEG
MINES	MINES
PATENTED for S.R.O.	PATENTED for S.R.O.

MCKIM TWP

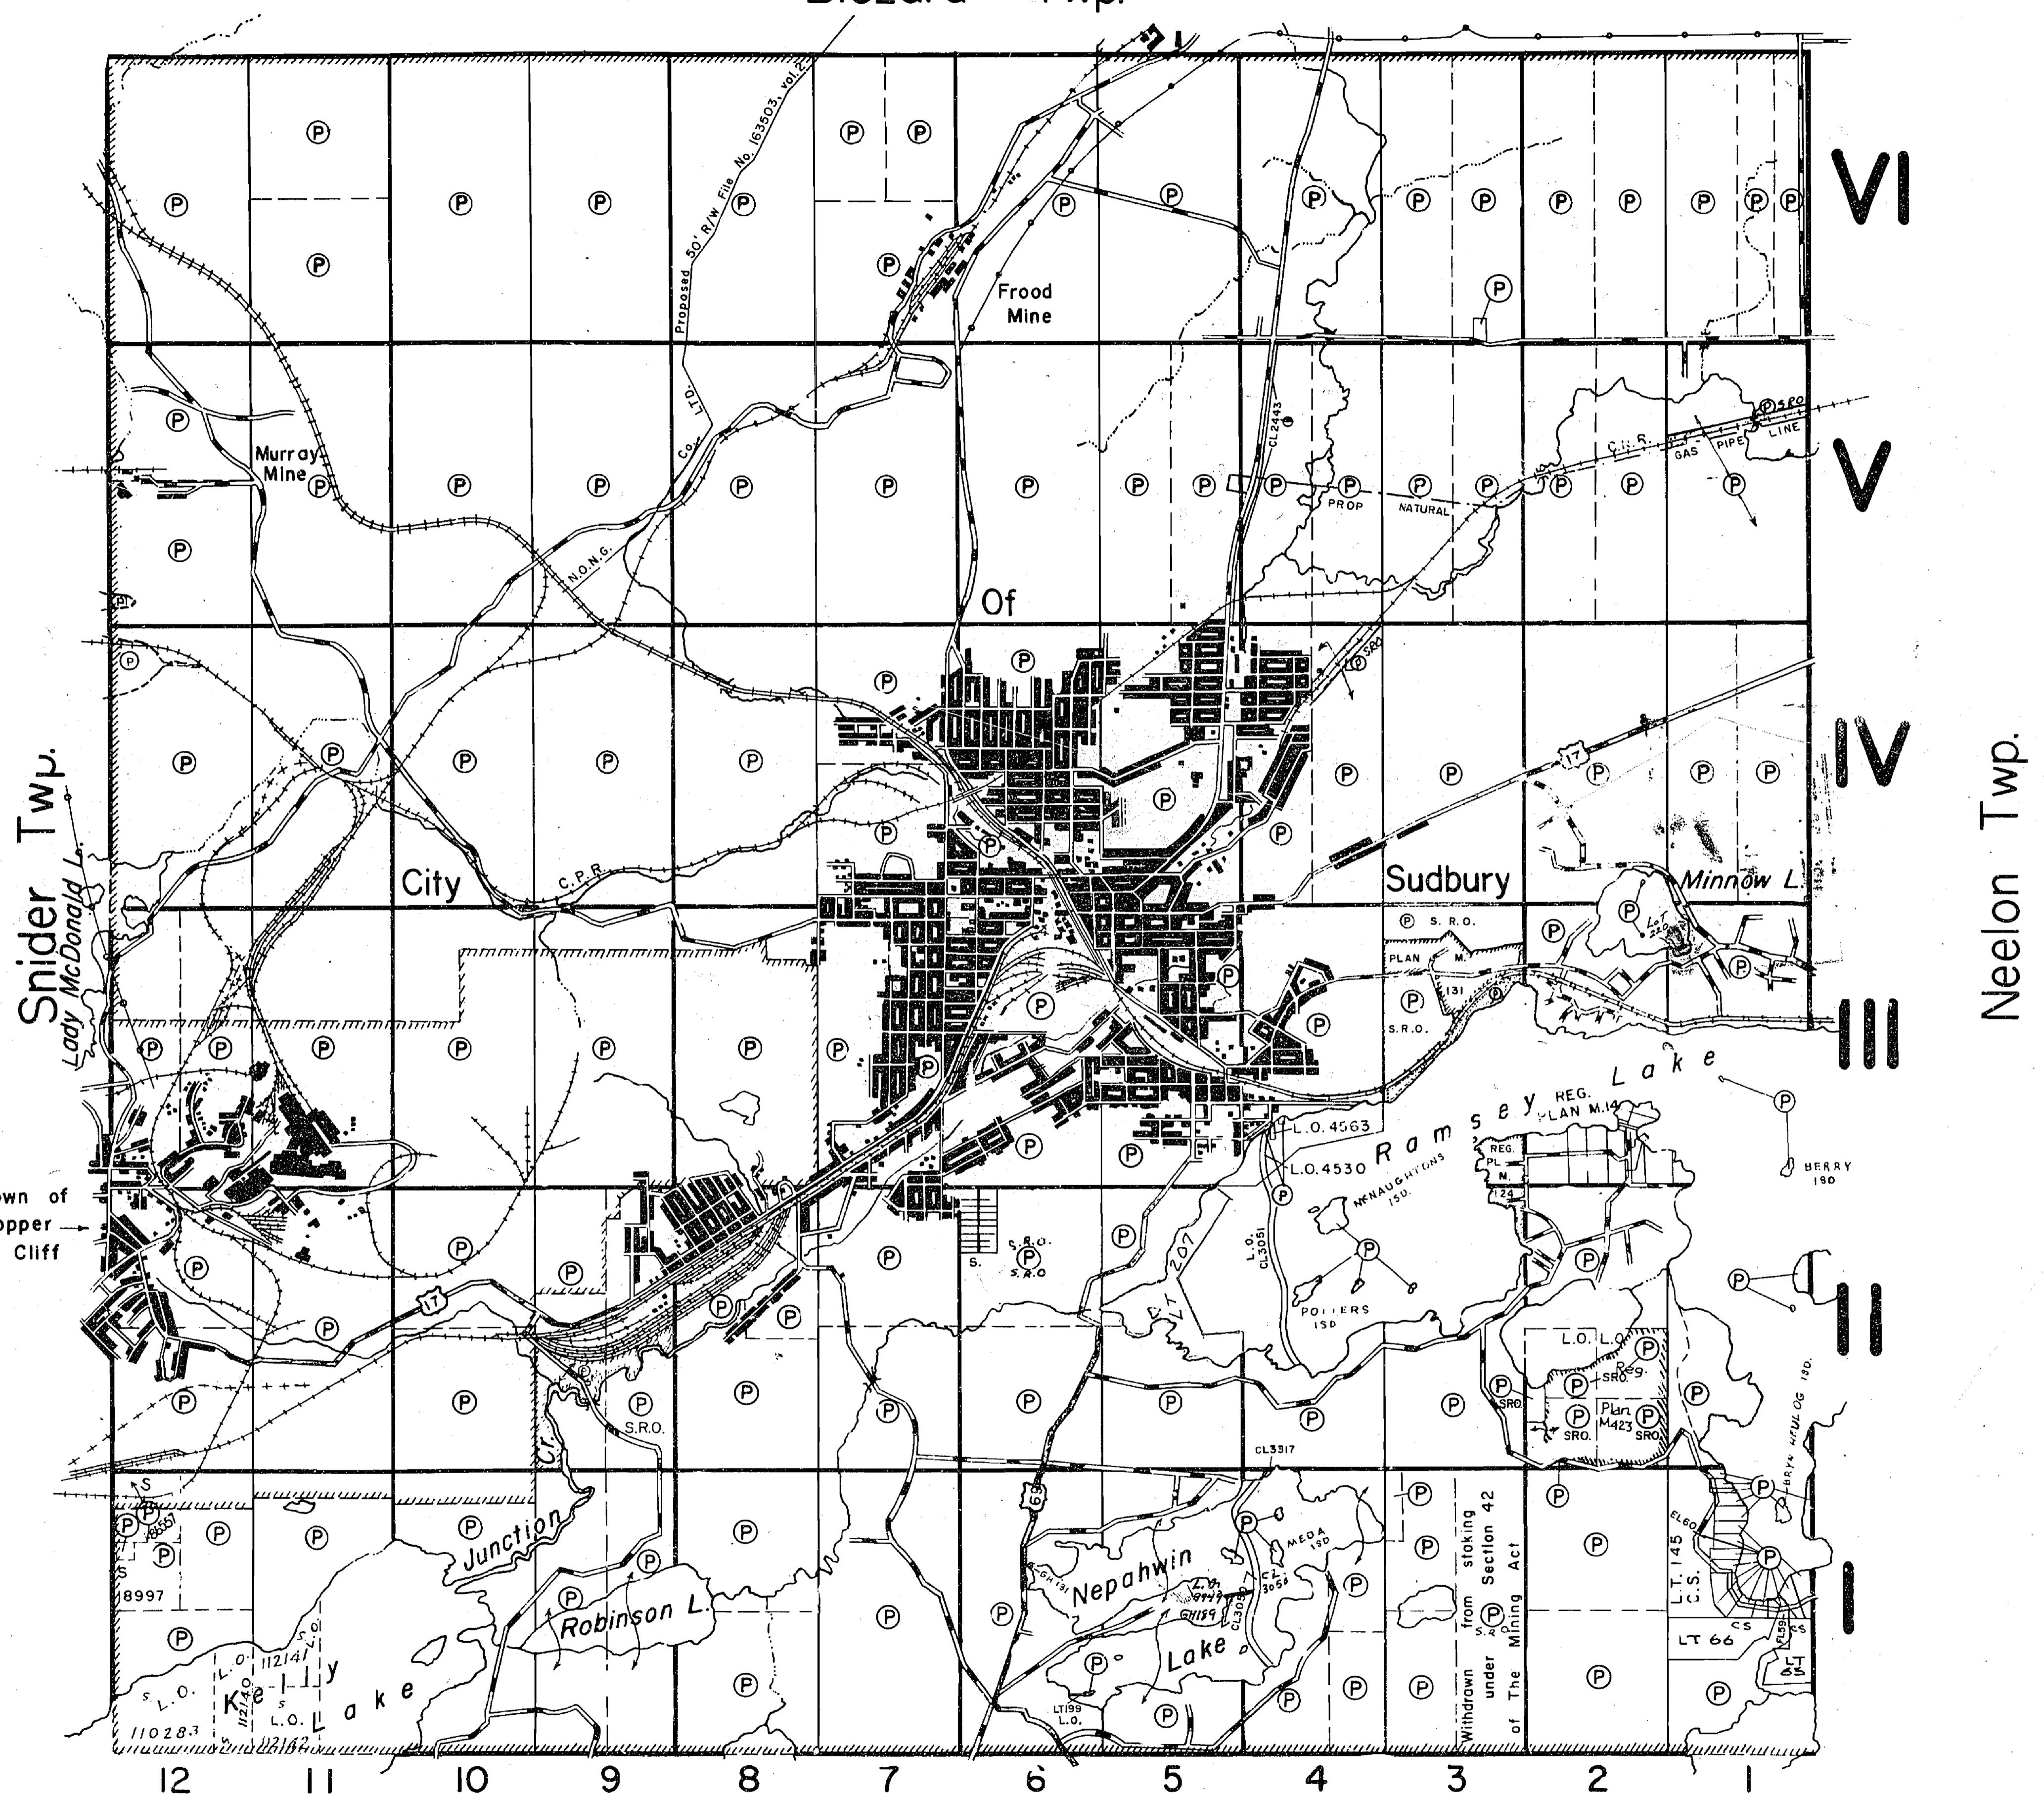

NOTES

400' surface rights reservation around all lakes and river.

McKIM

PLAN NO.- M-1013

ONTARIO

MINISTRY OF NATURAL RESOURCES

SURVEYS AND MAPPING BRANCH



Ministry of
Natural
Resources
Ontario

Ministry of
Northern Development
and Mines

© HERMIE BURGESS

INDEX TO LAND DISPOSITION

PLAN

4084

TOWNSHIP

McKIM

MNR ADMINISTRATIVE DISTRICT

SUDBURY

MINING DIVISION

SUDBURY

LAND TITLES/REGISTRY DIVISION

SUDBURY

Scale 1:25 000

Contour Interval 10 Metres

AREAS WITHDRAWN FROM DISPOSITION

M.R.O. - MINING RIGHTS ONLY
S.R.O. - SURFACE RIGHTS ONLY
M.S. - MINING AND SURFACE RIGHTS

Disposition Order No. Date Disposition Plan
① Sec. 35 W-S-1200 16/03/2000 MR & SR 195150

SYMBOLS

Boundary

Township, Section, Baseline.....

Road allowance, surveyed..... Shoreline.....

Lot/Concession, surveyed..... Unsurveyed.....

Parcel, surveyed..... Unsurveyed.....

Right-of-way; road..... Railway..... Utility.....

Reservation.....

Cliff, Pit, Pile.....

Contour.....

Interpolated..... Approximate.....

Depression.....

Control point (horizontal).....

Flooded land.....

Mine head frame.....

Pipeline (above ground).....

Railway; single track.....

double track.....

abandoned.....

Road, highway, county, township.....

access..... trail, bush.....

Shoreline (original).....

Transmission line.....

Wooded area.....

MAP 120000
1:250000
1:1000000
1:2000000
1:5000000

16/03/2000

DISPOSITION OF CROWN LANDS

Patent

Surface & Mining Rights.....

Surface Rights Only.....

Mining Rights Only.....

Lease

Surface & Mining Rights.....

Surface Rights Only.....

Mining Rights Only.....

Licence of Occupation

Order-in-Council.....


Cancelled.....

Reservation.....

Sand & Gravel.....


LAND USE PERMIT

THE INFORMATION THAT
APPEARS ON THIS MAP
HAS BEEN COMPILED
FROM VARIOUS SOURCES,
AND ACCURACY IS NOT
GUARANTEED. THOSE
WISHING TO START MINING
OR GRADING SHOULD CONSULT
WITH THE MINING RECORDER
MINISTRY OF NORTHERN
DEVELOPMENT AND MINES.
FOR ADDITIONAL INFORMATION
ON THE STATUS OF THE
LANDS SHOWN HEREON.

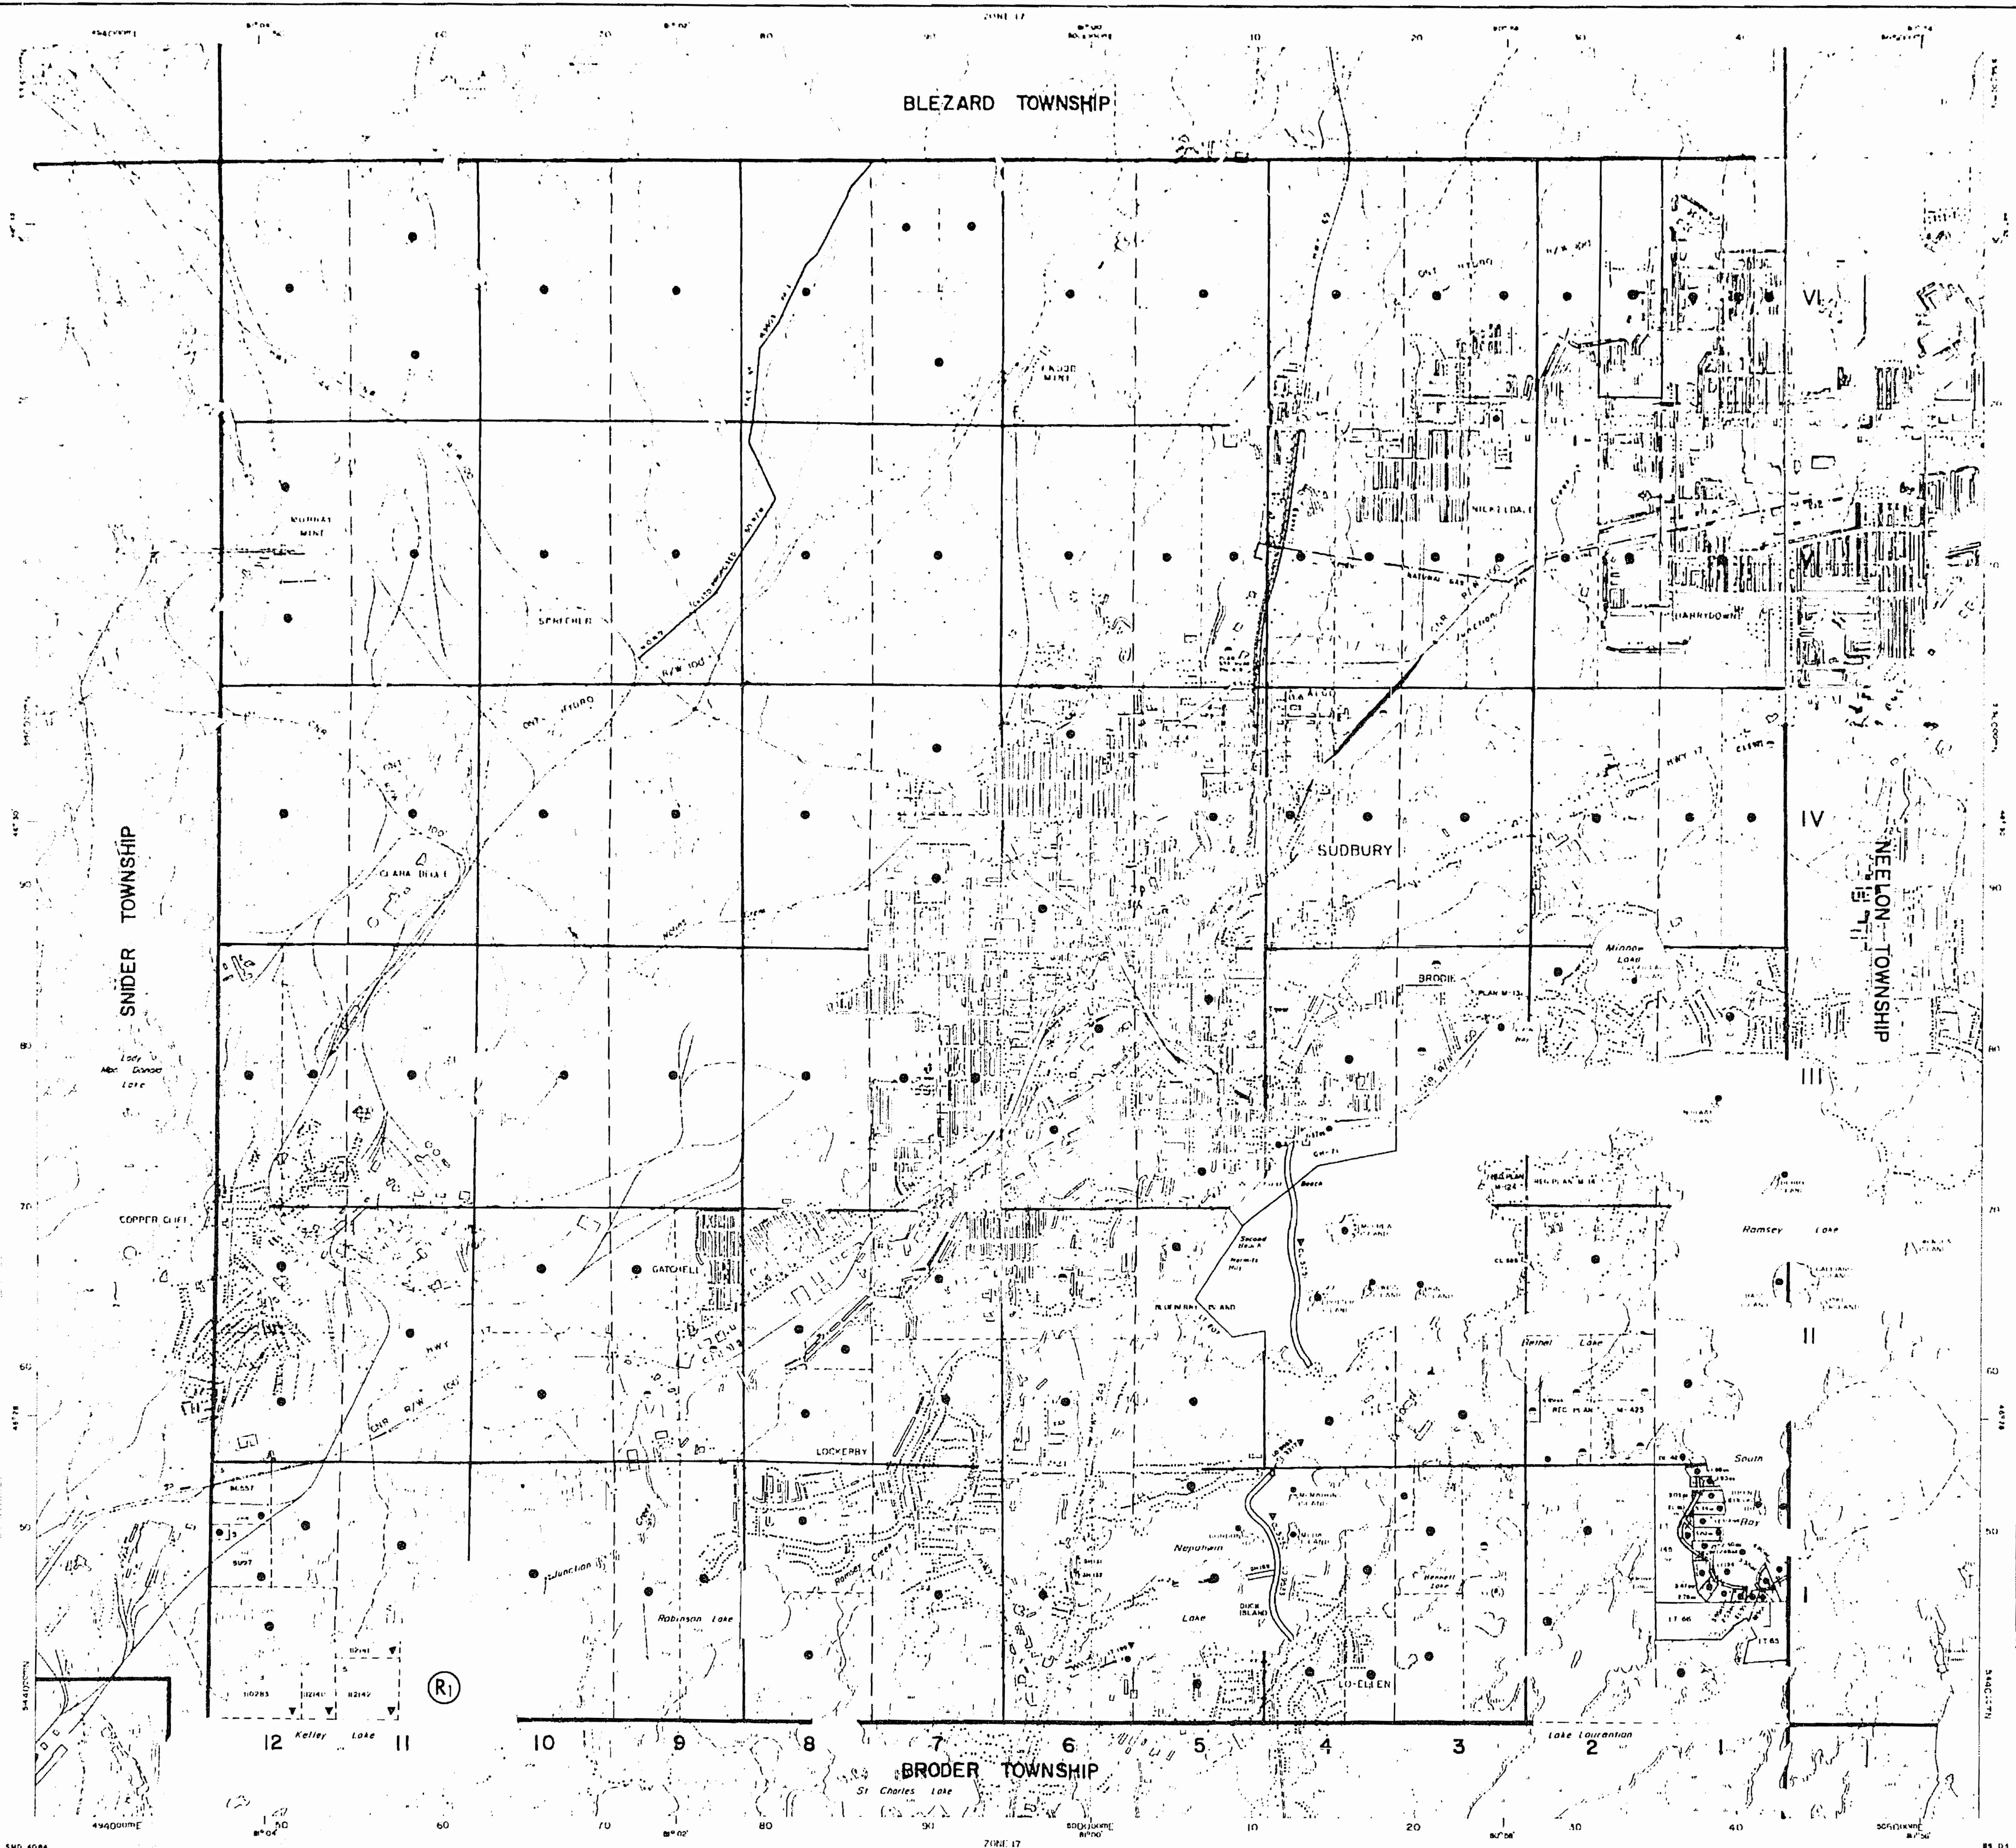

1013

Bleizard Twp.

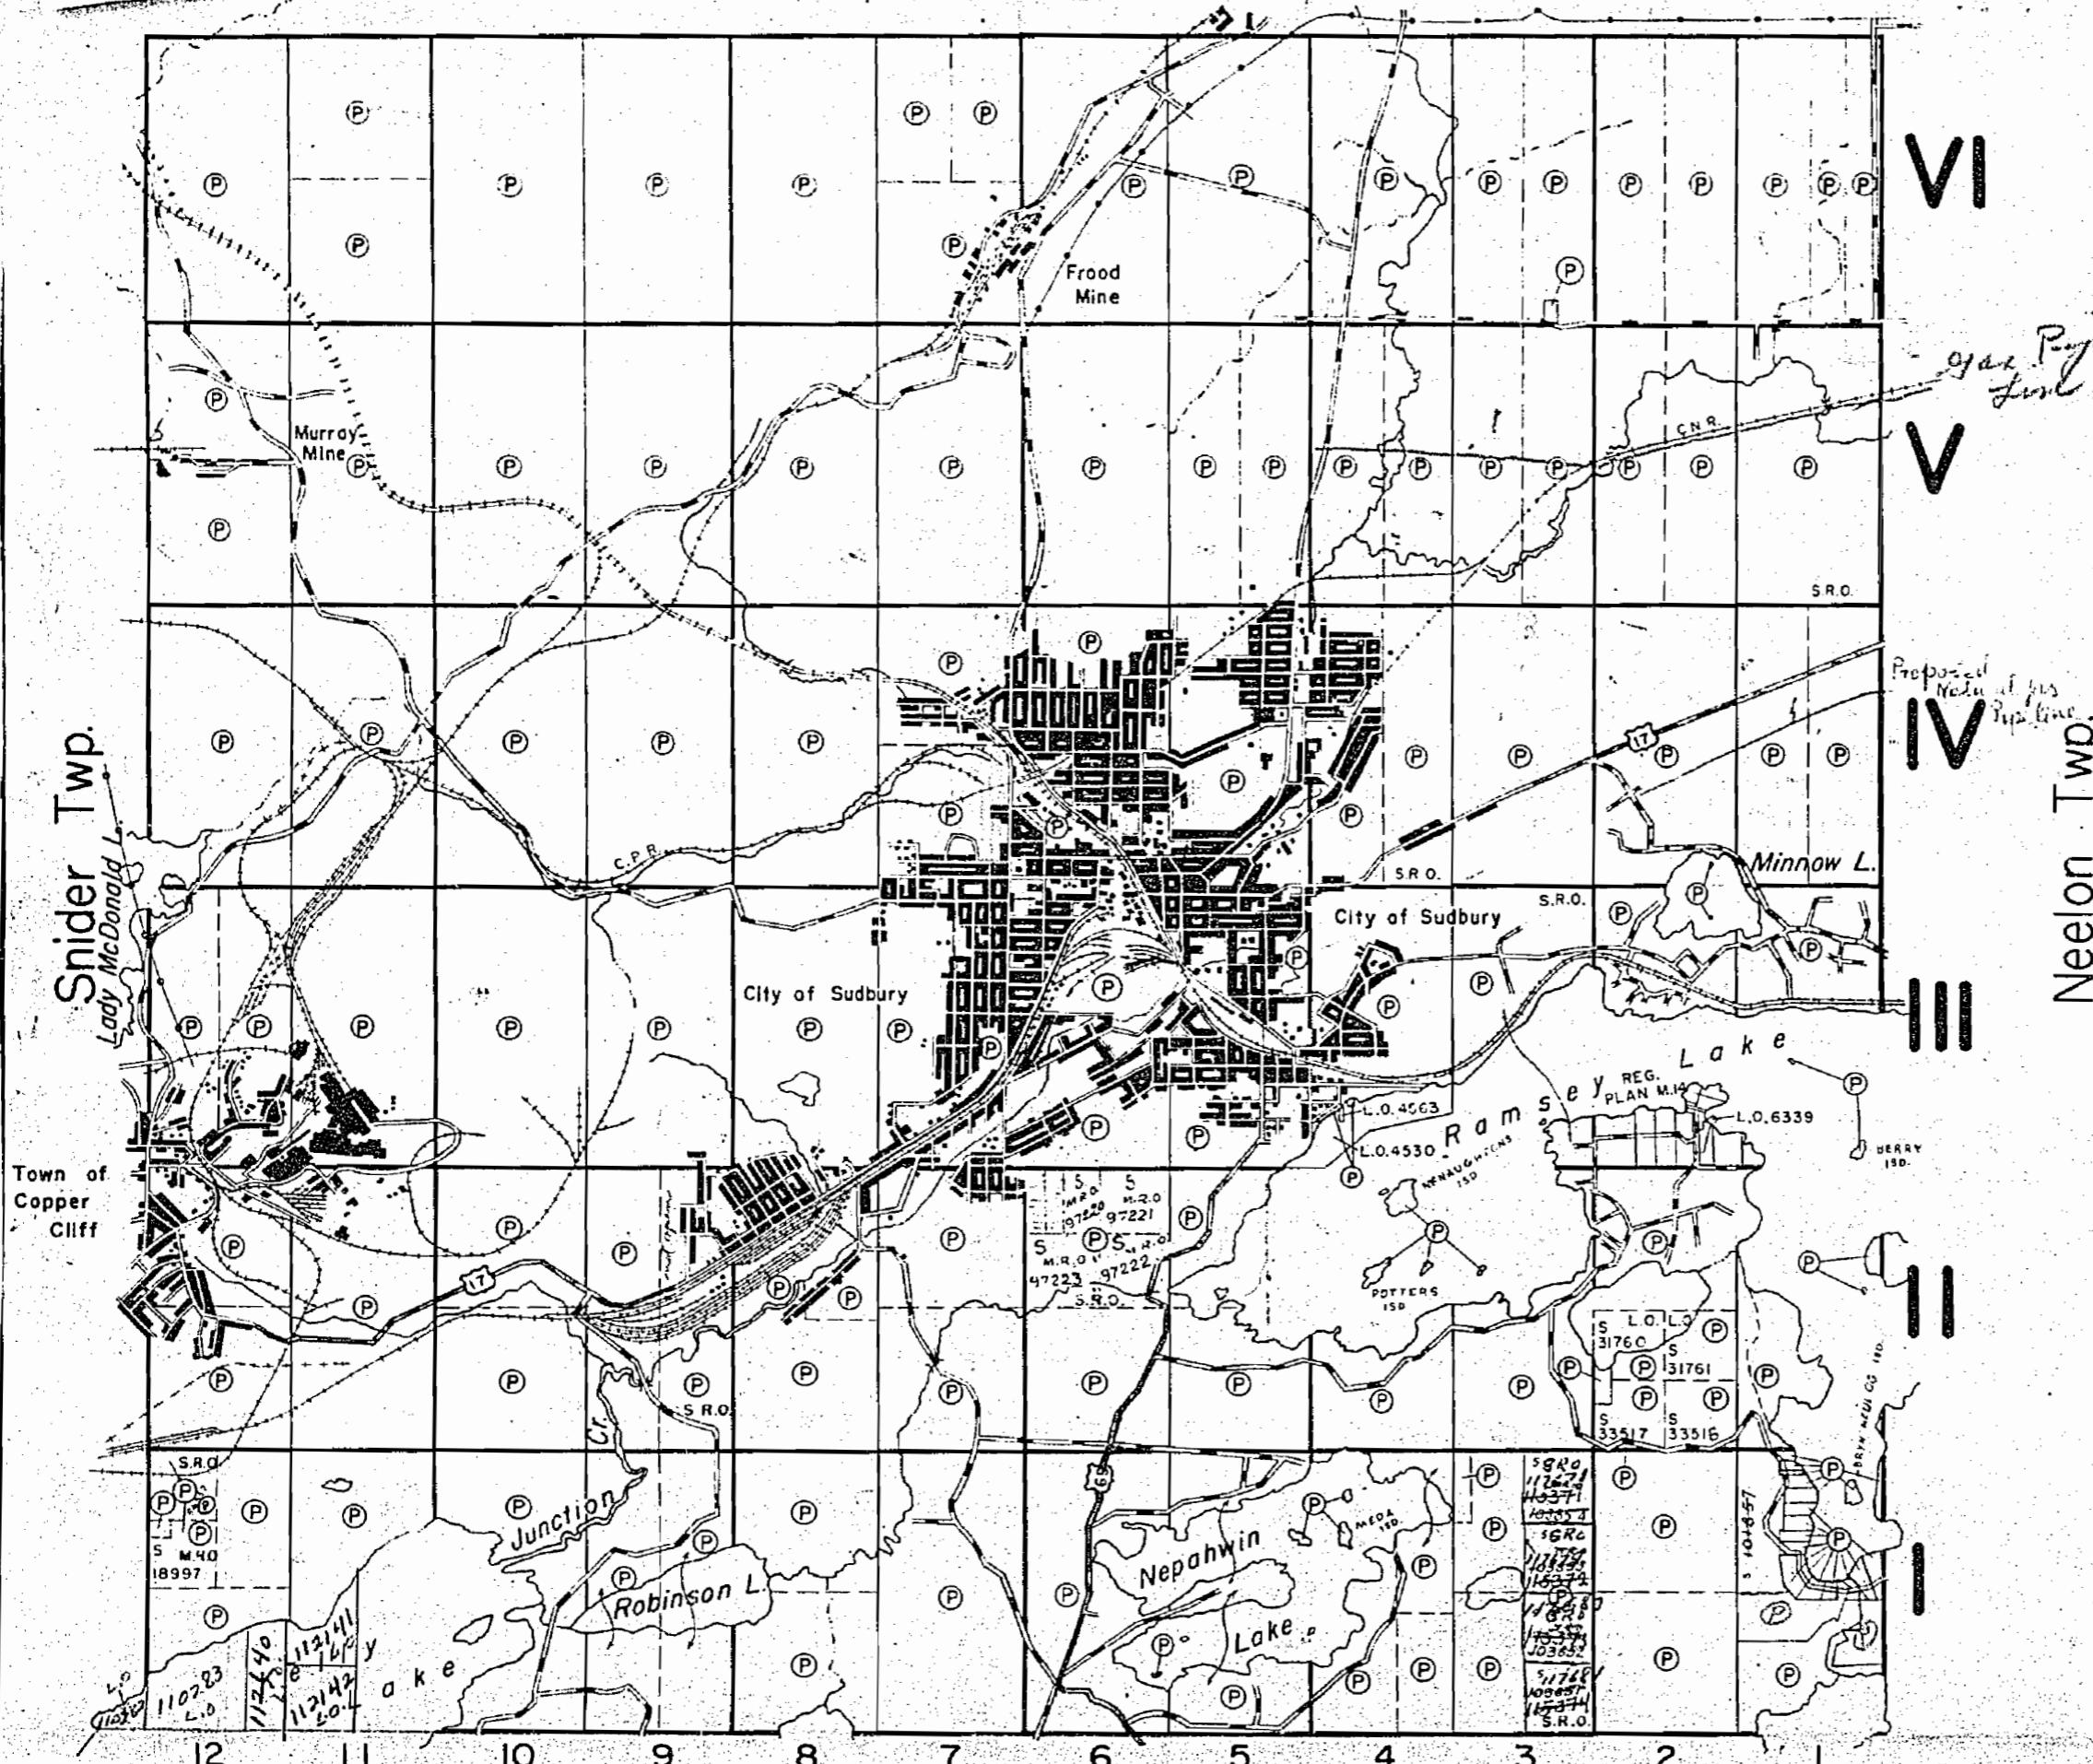

THE TOWNSHIP
OF
McKIM

DISTRICT OF
SUDBURY
SUDBURY
MINING DIVISION

SCALE: 1-INCH=40 CHAINS

LEGEND

(P)	PATENTED LAND
(S) or CS.	CROWN LAND SALE
(L)	LEASES
Loc.	LOCATED LAND
L.O.	LICENSE OF OCCUPATION
M.R.O.	MINING RIGHTS ONLY
S.R.O.	SURFACE RIGHTS ONLY
ROADS	ROADS
IMPROVED ROADS	IMPROVED ROADS
KING'S HIGHWAYS	KING'S HIGHWAYS
RAILWAYS	RAILWAYS
POWER LINES	POWER LINES
MARSH OR MUSKEG	MARSH OR MUSKEG
MINES	MINES

NOTES

MINING RECORDERS OFFICE LOCATED
AT WAISBERG BLOCK 5 YOUNG ST.
NORTH SUDBURY

SUDBURY RECEIVED
FEB 4 1958
MINING DIVISION

PLAN NO.- M- 1013

DEPARTMENT OF MINES
ONTARIO

1013

Bleizard Twp.

old

Twp file

THE TOWNSHIP
OF
McKIM

DISTRICT OF
SUDBURY
SUDBURY
MINING DIVISION


SCALE: 1-INCH= 40 CHAINS

LEGEND

- (P) PATENTED LAND
- (S or C.S.) CROWN LAND SALE
- (L) LEASES
- (Loc.) LOCATED LAND
- (L.O.) LICENSE OF OCCUPATION
- (M.R.O.) MINING RIGHTS ONLY
- (S.R.O.) SURFACE RIGHTS ONLY
- (ROADS) ROADS
- (IMPROVED ROADS) IMPROVED ROADS
- (KING'S HIGHWAYS) KING'S HIGHWAYS
- (RAILWAYS) RAILWAYS
- (POWER LINES) POWER LINES
- (MARSH OR MUSKEG MINES) MARSH OR MUSKEG MINES

NOTES

MINING RECORDERS OFFICE LOCATED
AT WAISBERG BLOCK 5 YOUNG ST.
NORTH SUDBURY.

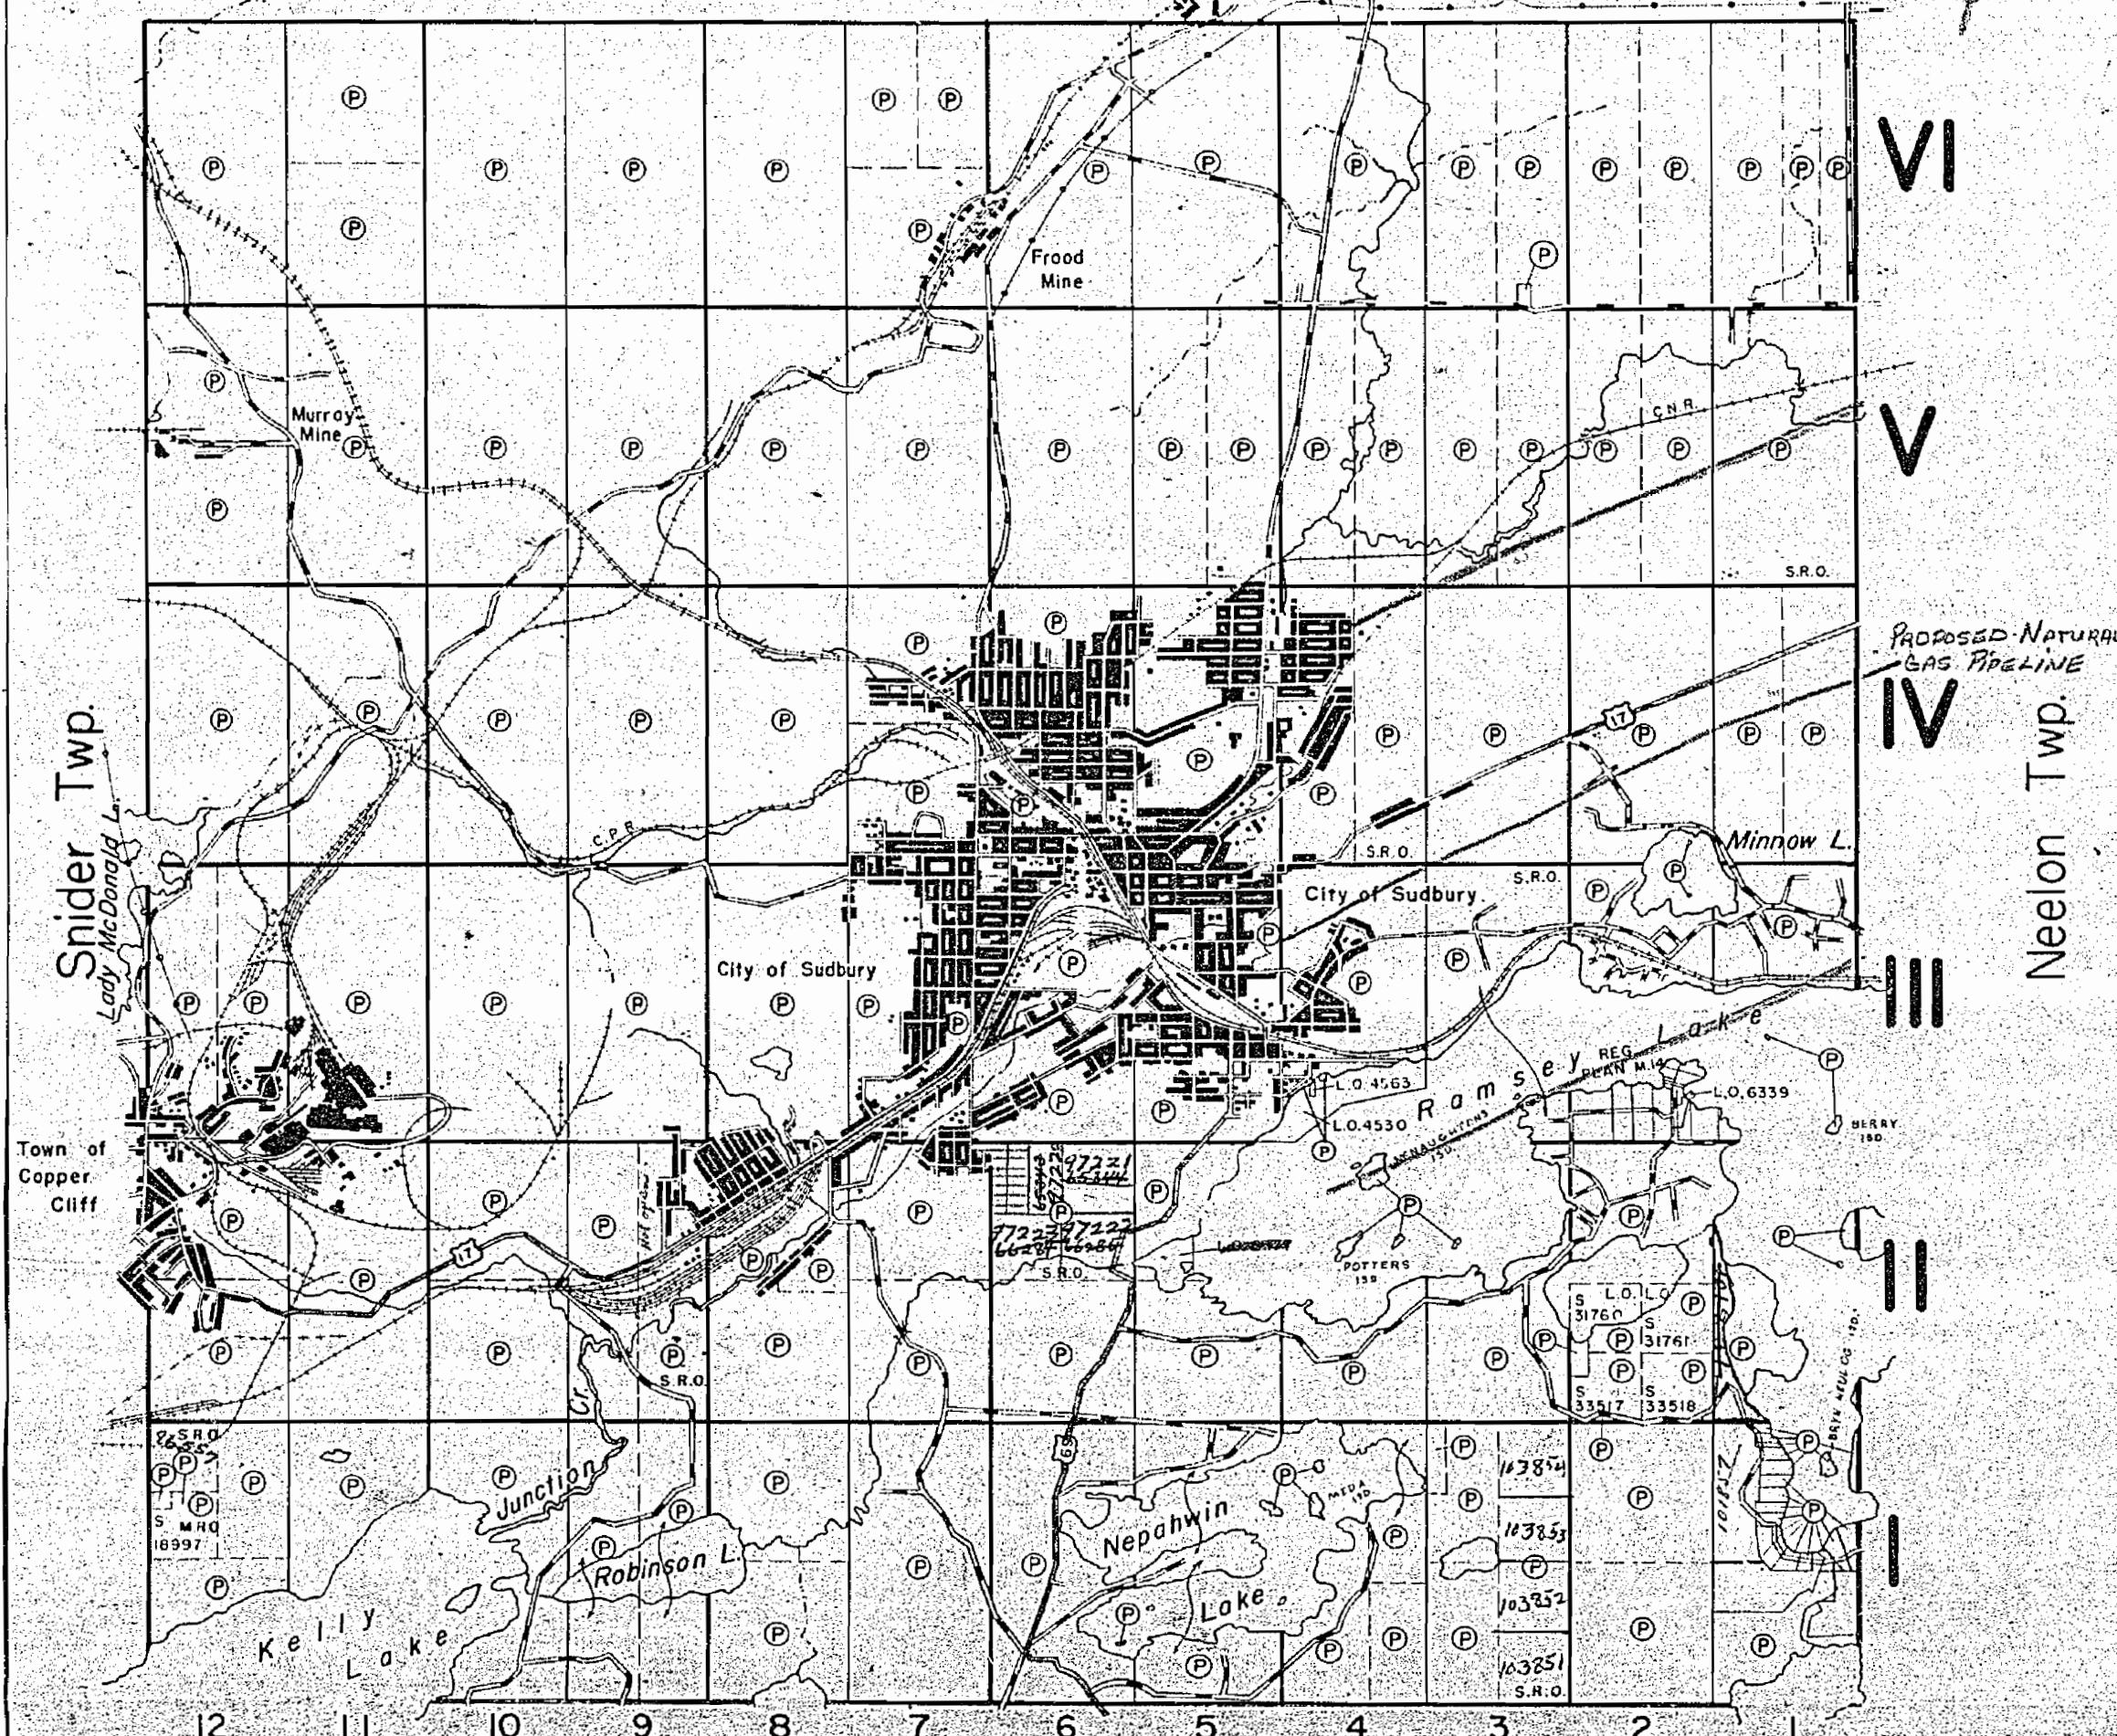

Broder Twp.

M-1013

PLAN NO - S.327


DEPARTMENT OF MINES
—ONTARIO—

1013

surface rights along
transmission line preserved
July 23/30 - destructions


Norite
Sudbury Townsite

BLEZARD

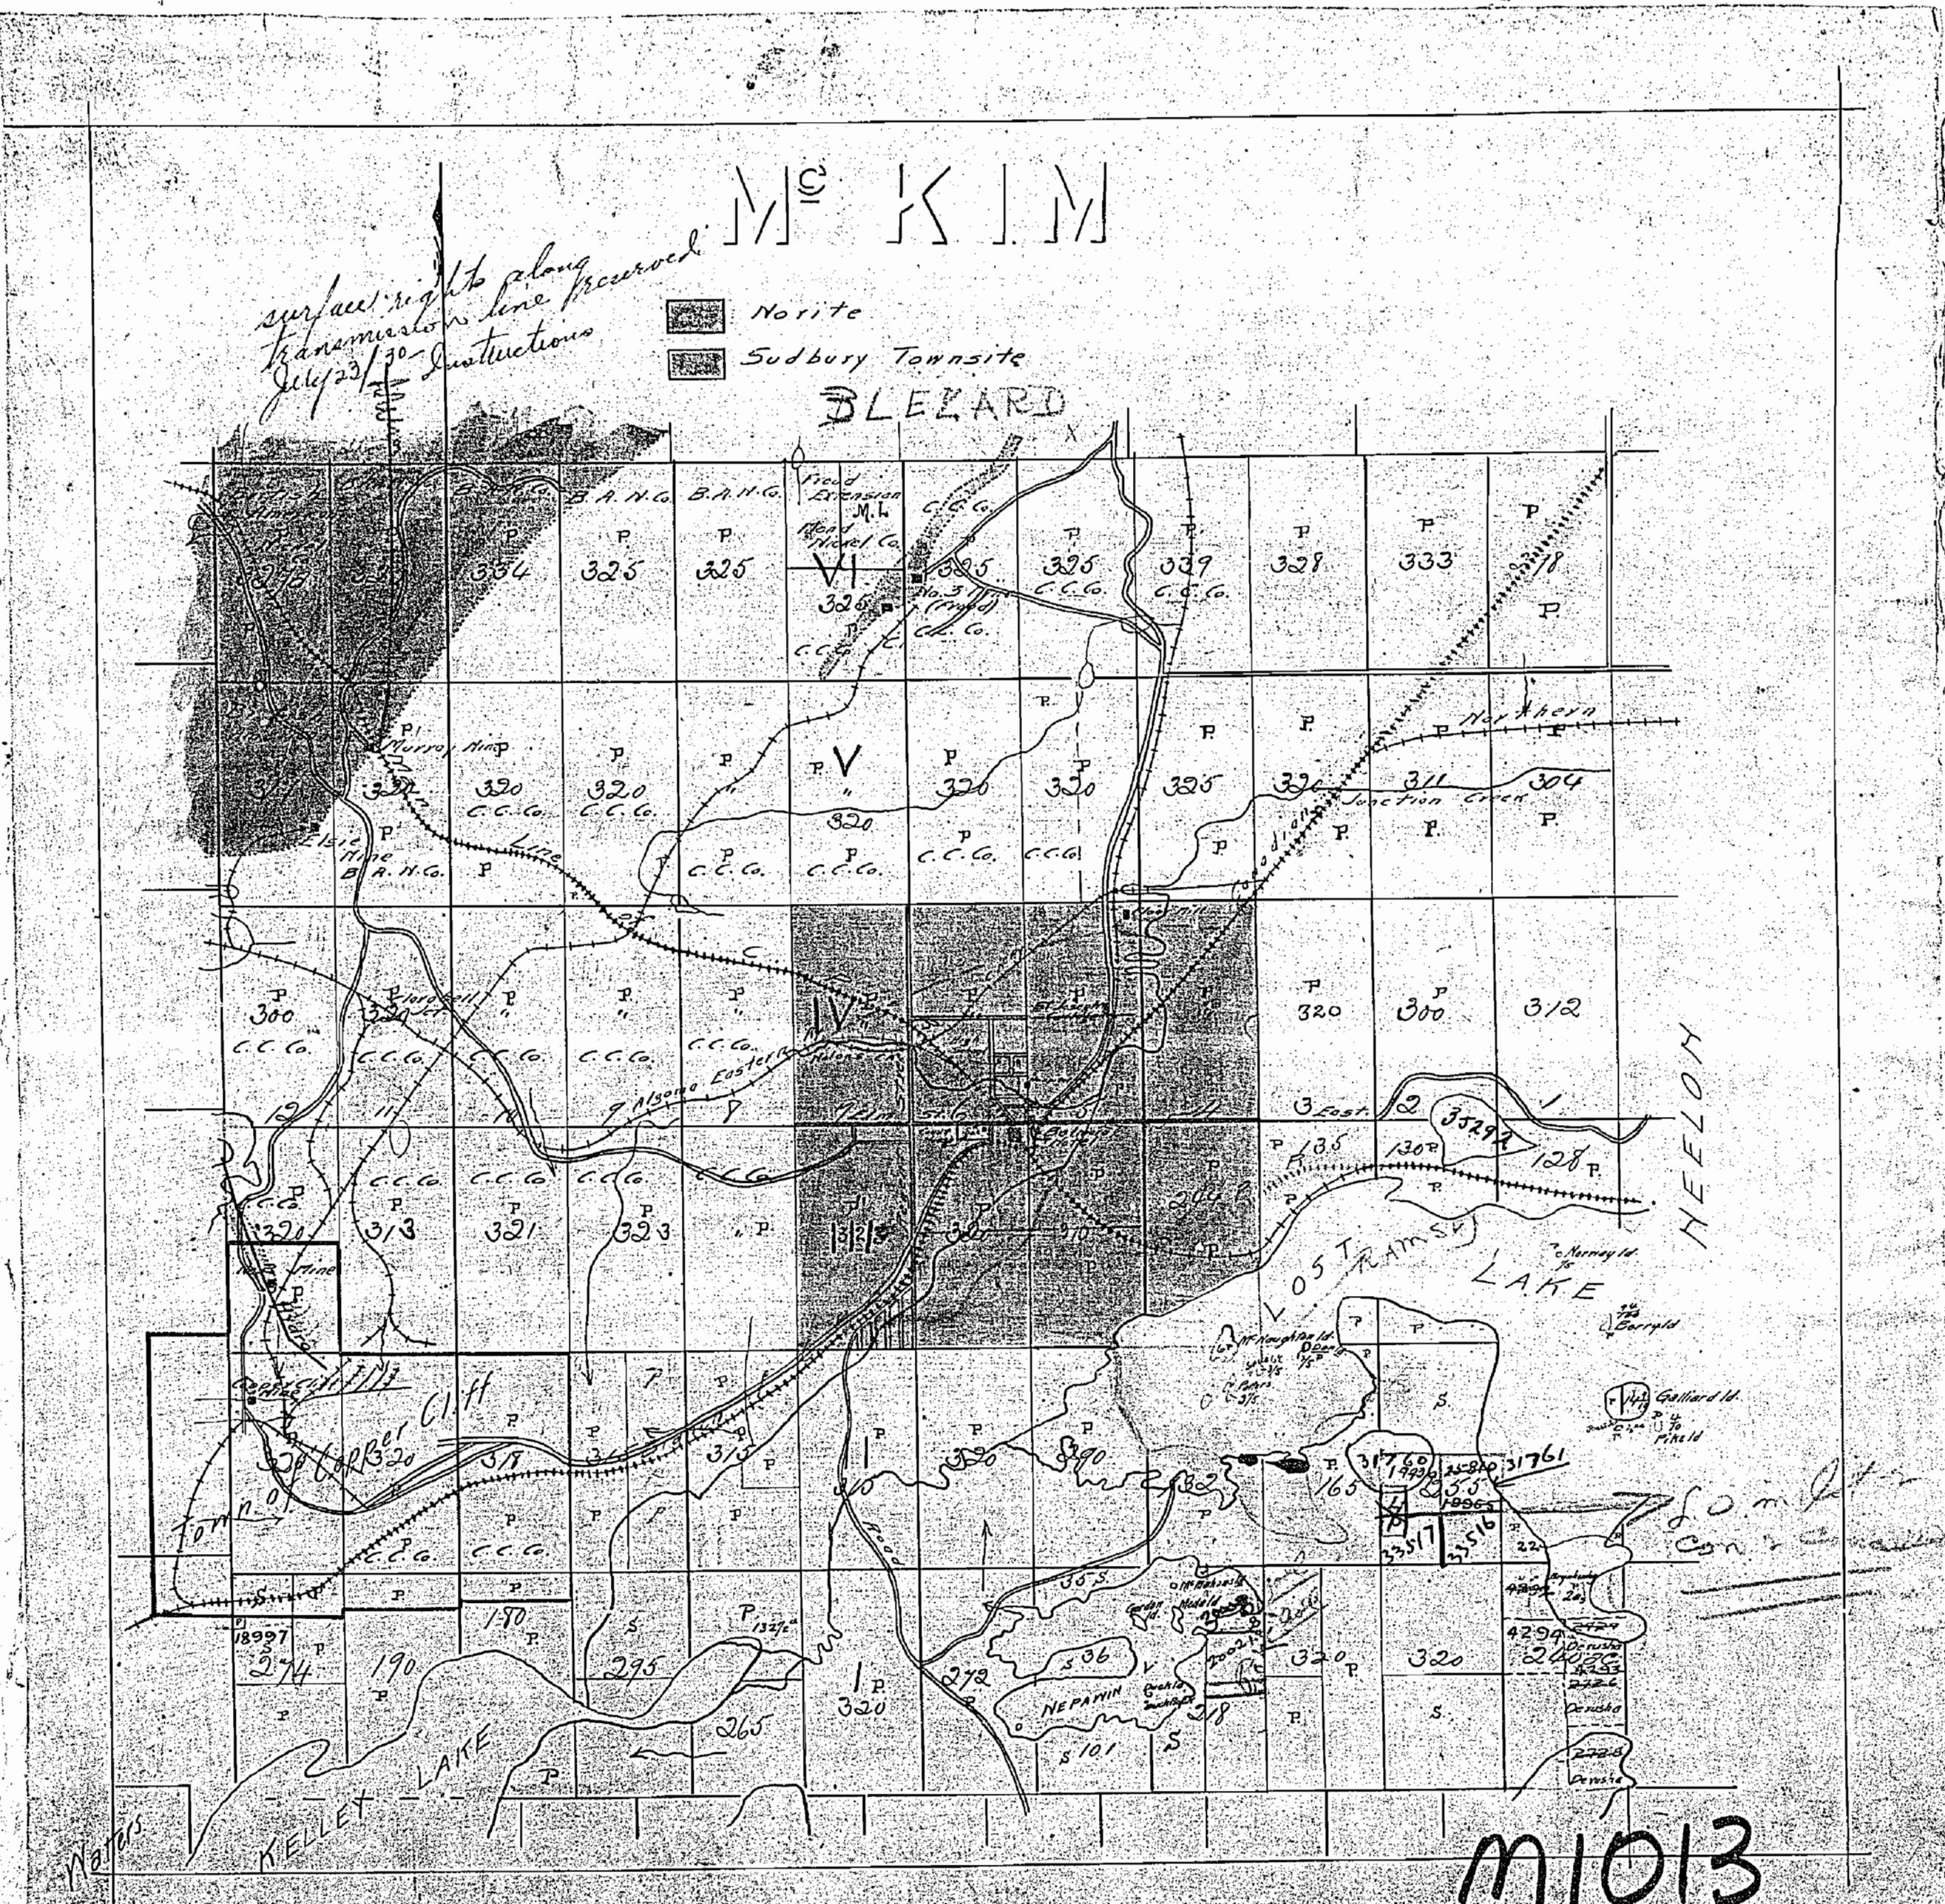

1013

Blezzard Twp.

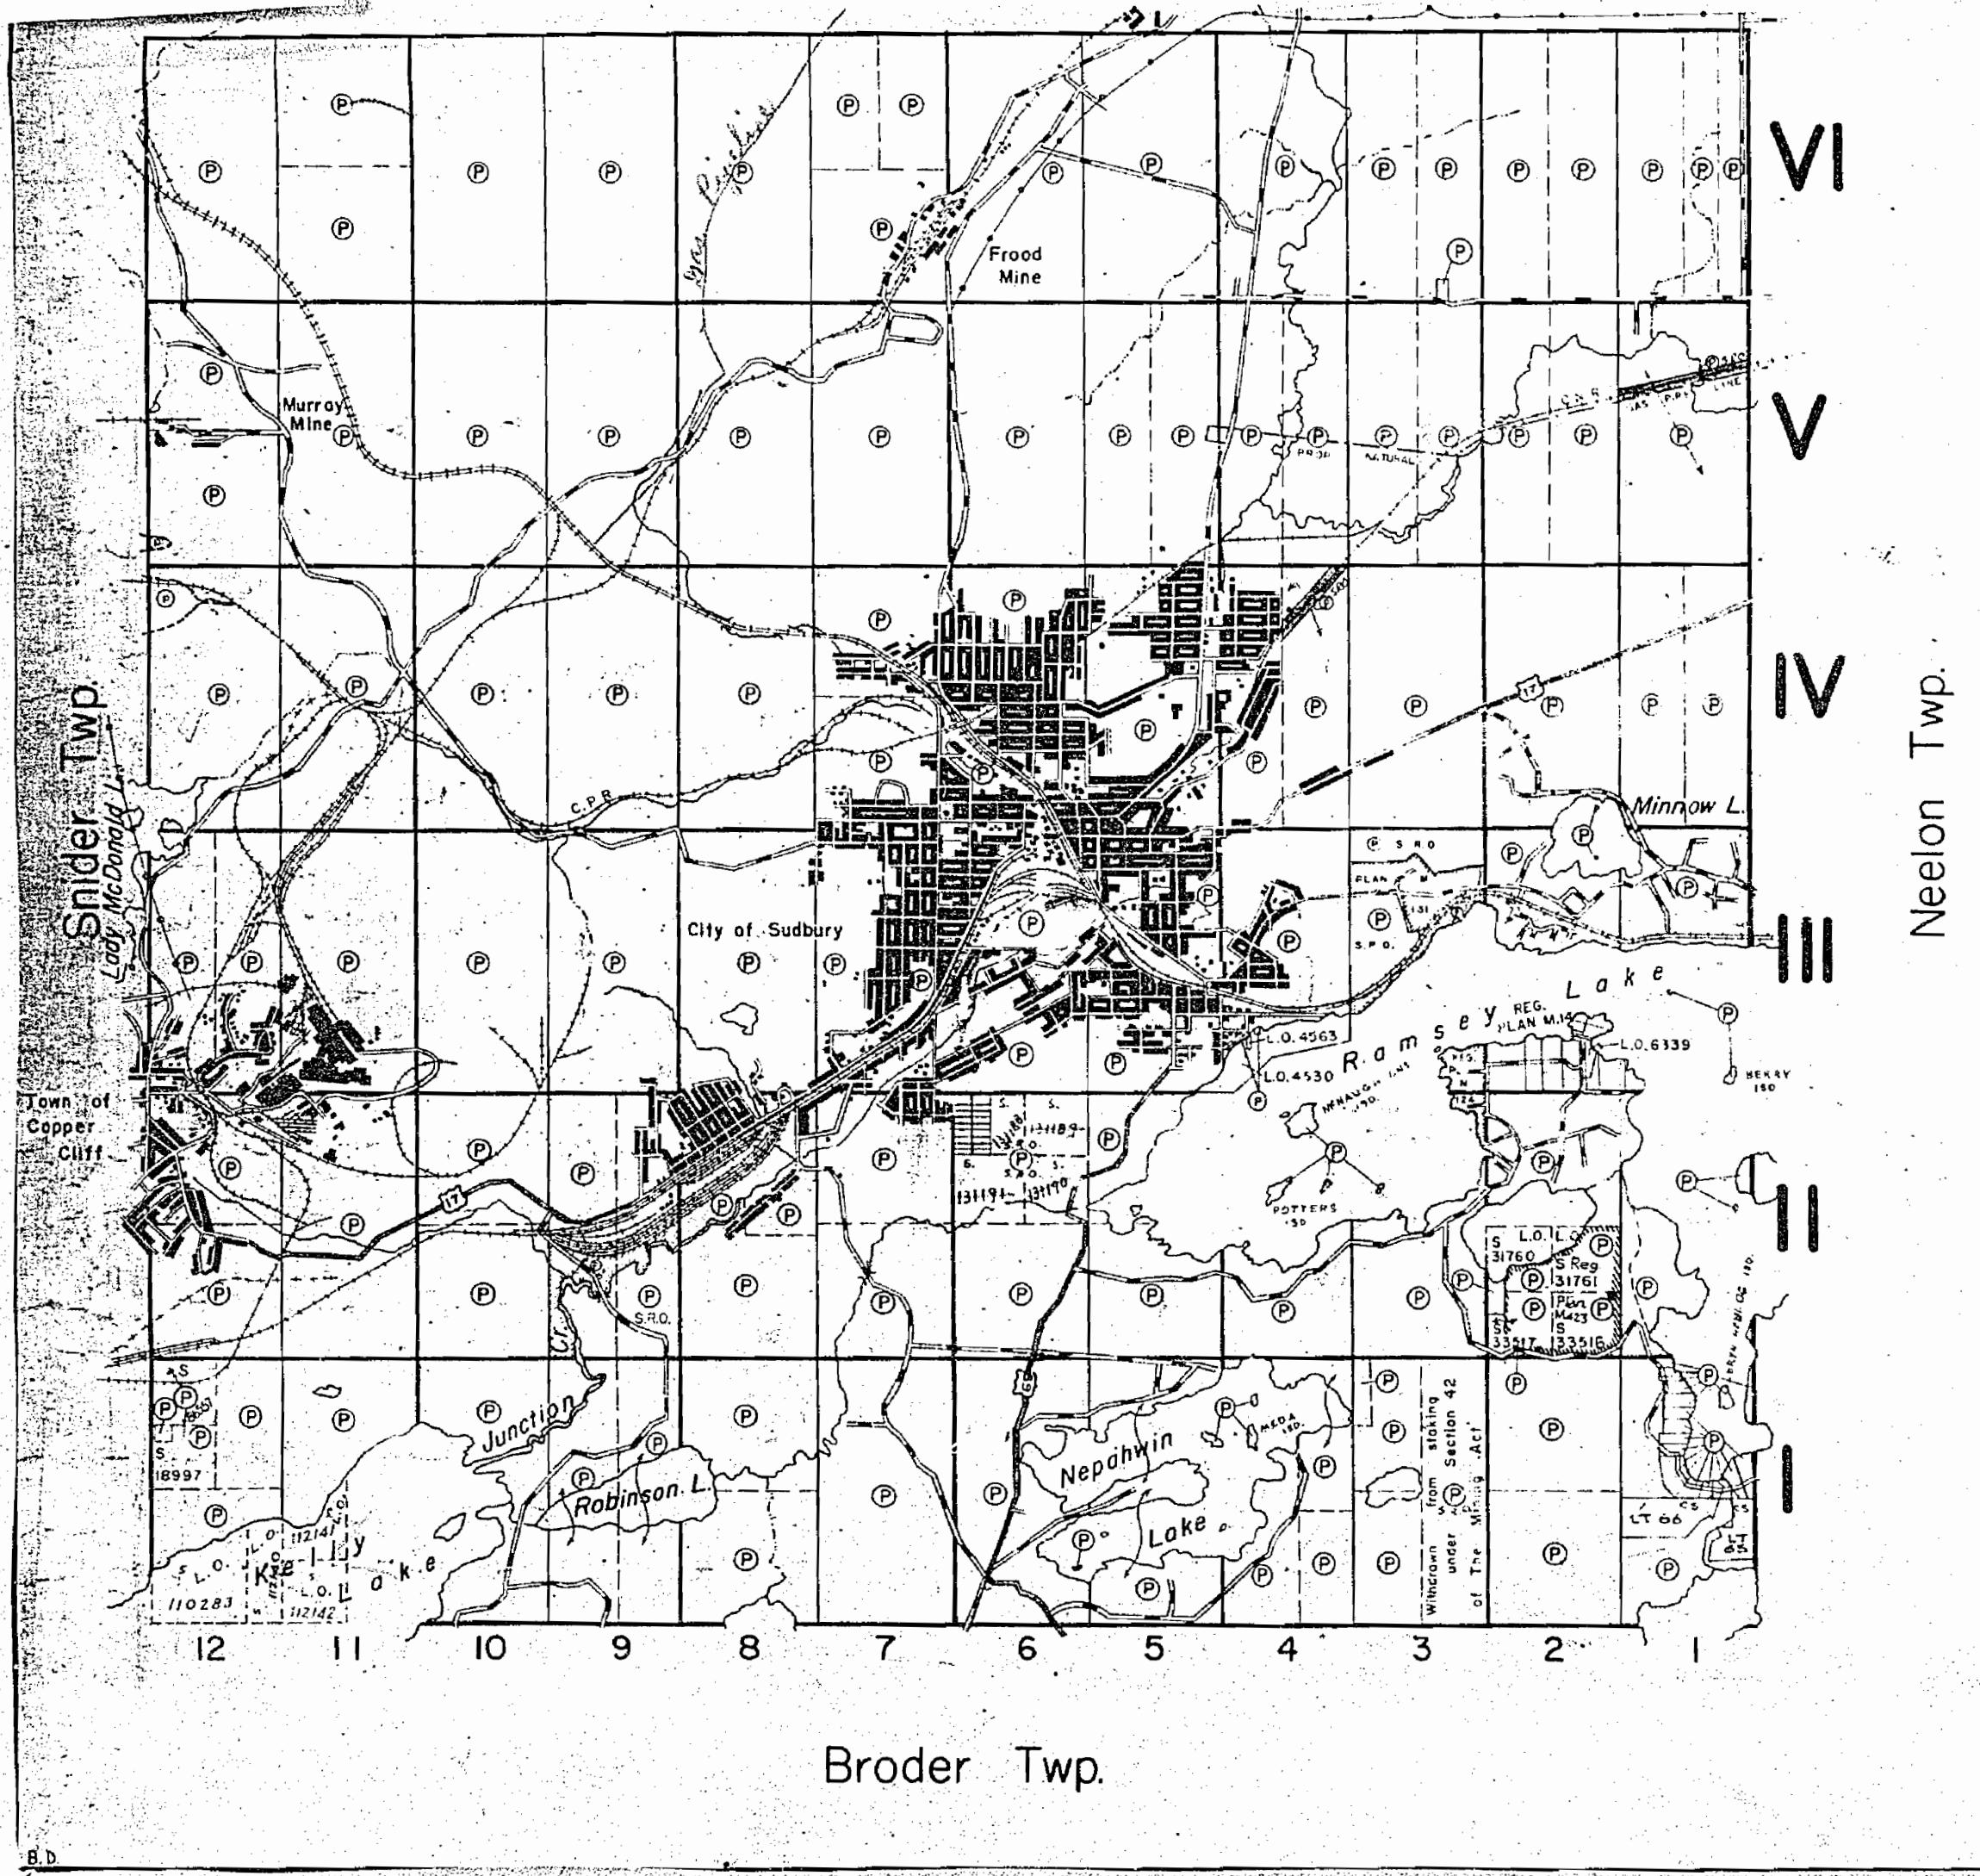THE TOWNSHIP
OF**McKIM**DISTRICT OF
SUDBURYSUDBURY
MINING DIVISION

SCALE: 1-INCH= 40 CHAINS

LEGEND

(P)	PATENTED LAND
(S) or C.S.	CROWN LAND SALE LEASES
Loc.	LOCATED LAND
L.O.	LICENSE OF OCCUPATION
M.R.O.	MINING RIGHTS ONLY
S.R.O.	SURFACE RIGHTS ONLY
ROADS	ROADS
IMPROVED ROADS	IMPROVED ROADS
KING'S HIGHWAYS	KING'S HIGHWAYS
RAILWAYS	RAILWAYS
POWER LINES	POWER LINES
MARSH OR MUSKEG	MARSH OR MUSKEG
MINES	MINES


NOTES

MINING RECORDERS OFFICE LOCATED
AT WAISBERG, BLOCK 5 YOUNG ST.
NORTH SUDBURY.

400' surface rights reservation around oil
lakes and river.

PLAN NO.- M-1013

DEPARTMENT OF MINES
—ONTARIO—

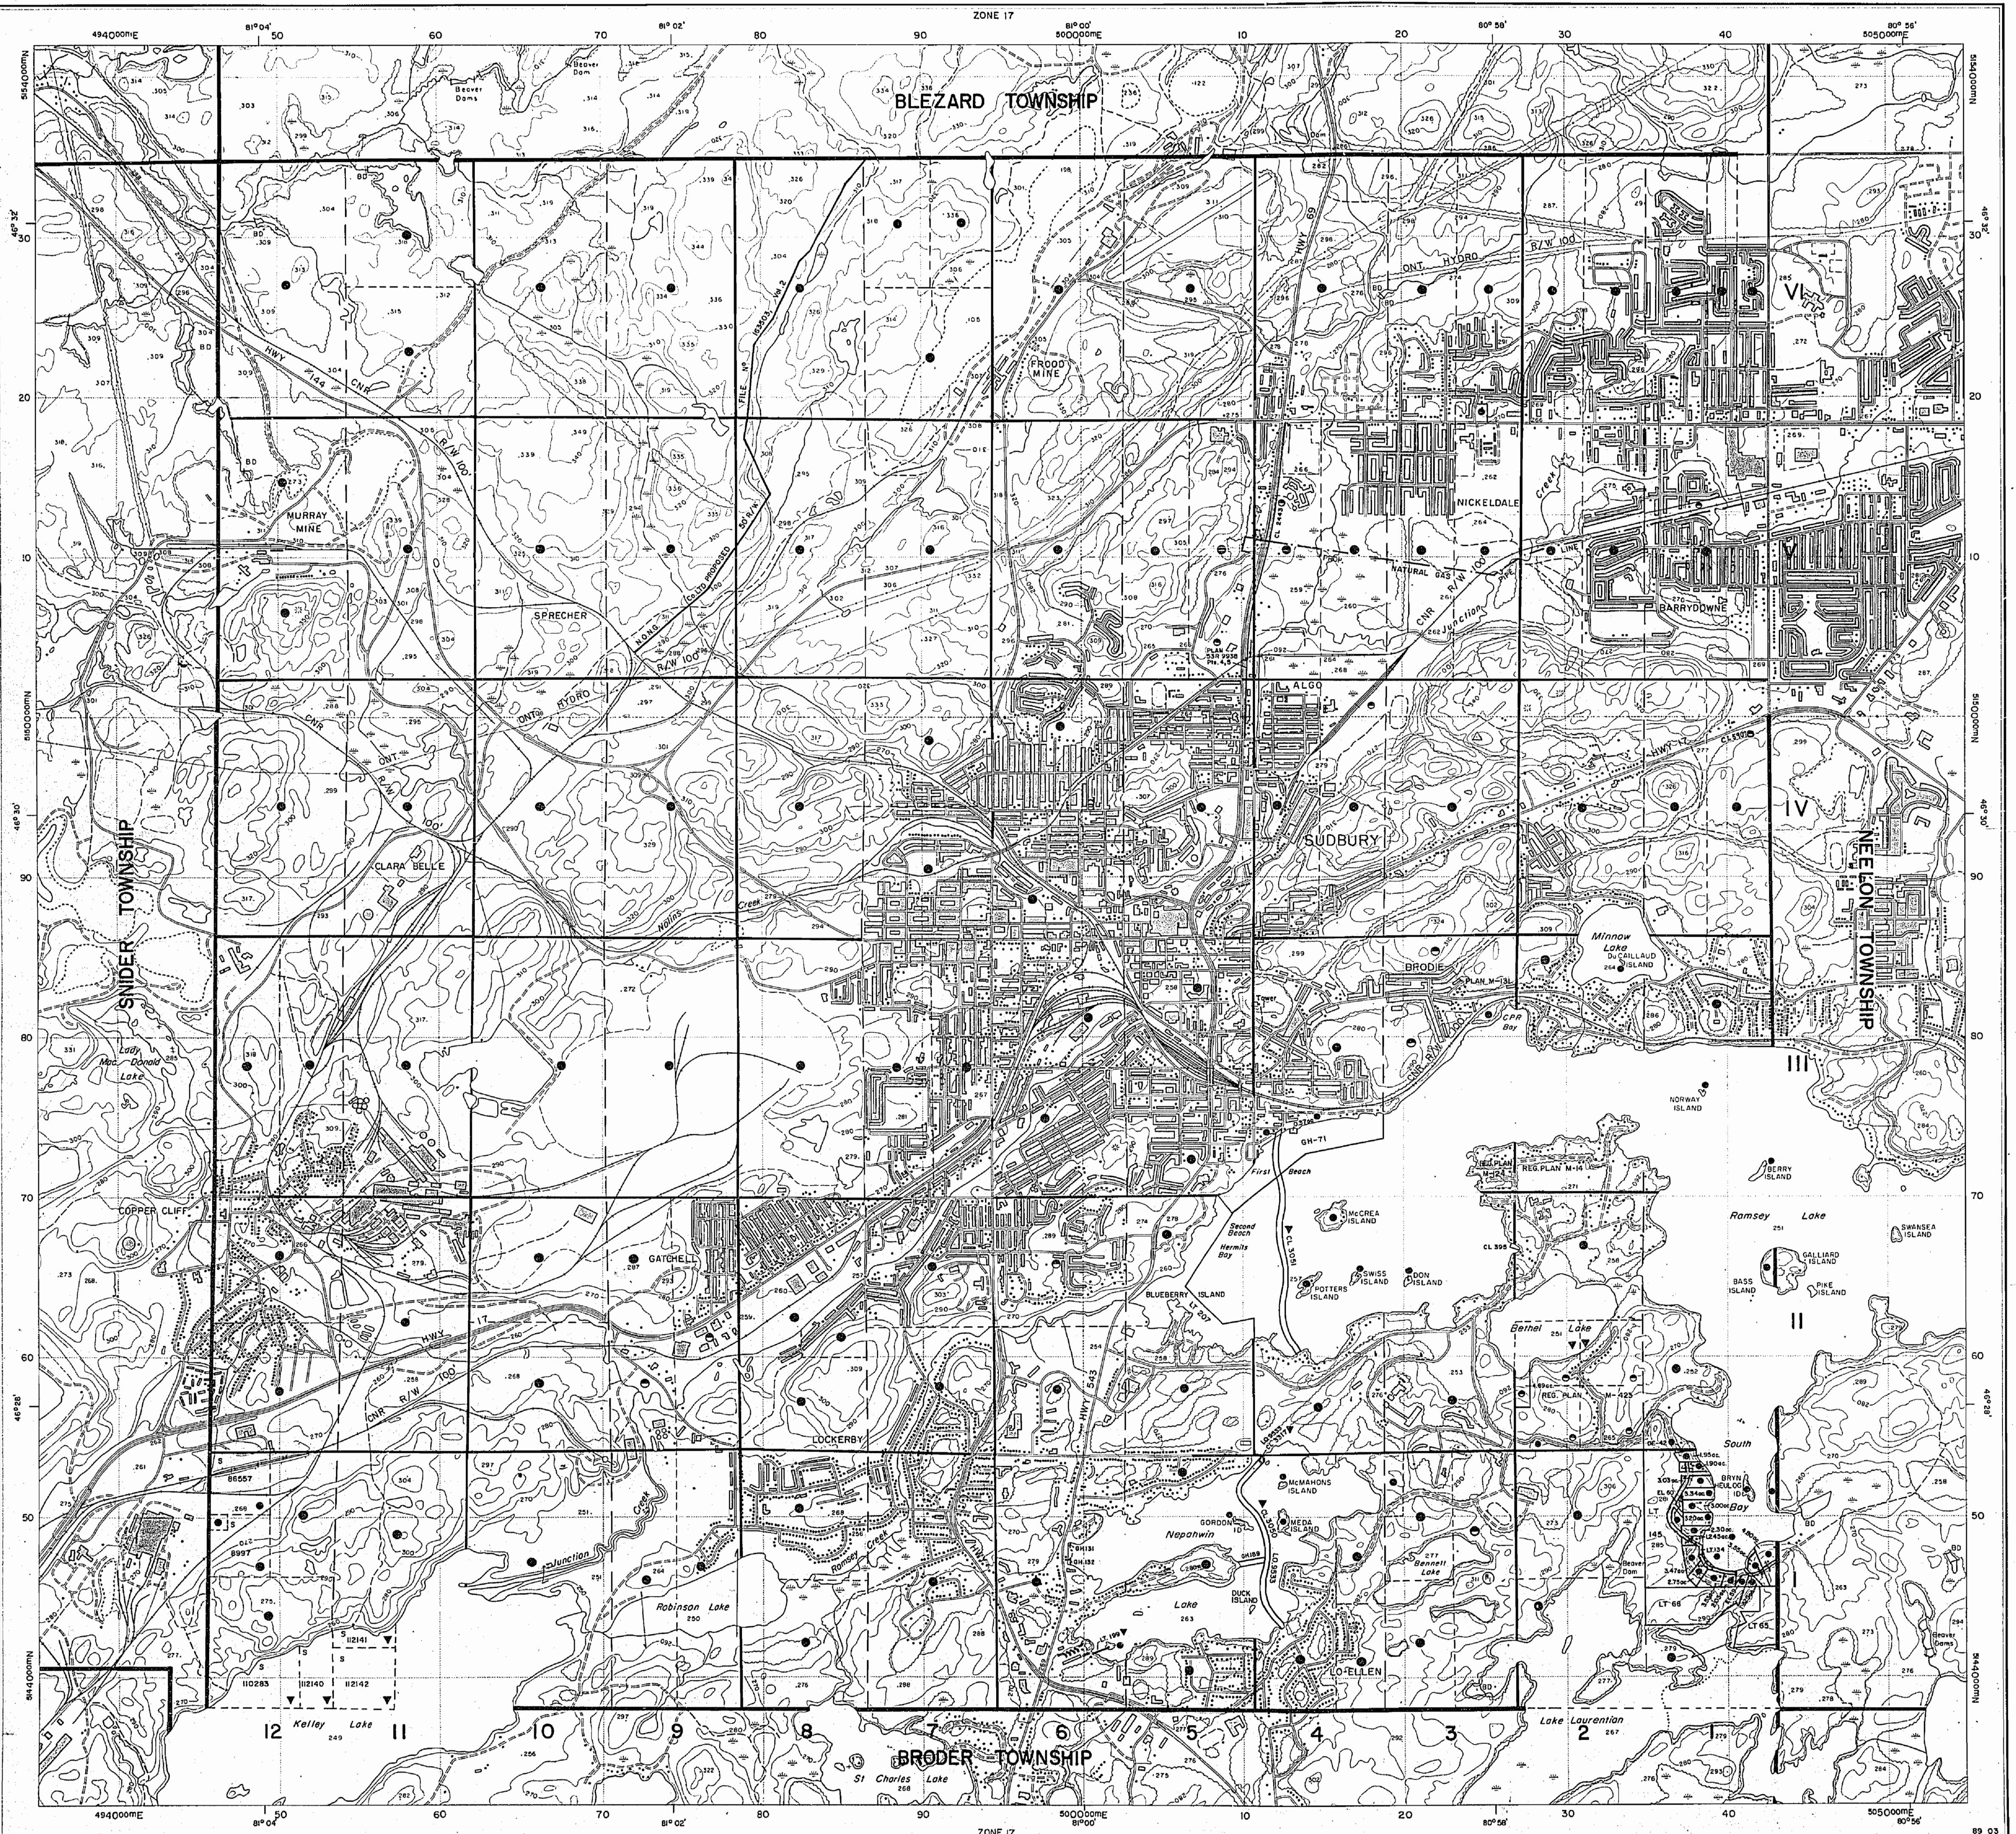

Ministry of
Natural
Resources
Ontario

Ministry of
Northern Development
and Mines

IN SERVICE 26/03/90

INDEX TO LAND DISPOSITION

PLAN

4084

TOWNSHIP

McKIM

M.N.R. ADMINISTRATIVE DISTRICT
SUDBURY
MINING DIVISION
SUDBURY
LAND TITLES/REGISTRY DIVISION
SUDBURY

Scale 1:20 000
Metres
1000 0 1000 2000 Metres
Feet
1000 0 1000 2000 3000 4000 5000 6000 7000 8000 9000 10000 Feet

Contour Interval 10 Metres

AREAS WITHDRAWN FROM DISPOSITION

MRO - Mining Rights Only
SRO - Surface Rights Only
M + S - Mining and Surface Rights

Description	Order No.	Date	Disposition	File
SEC. 42			M + S	

SYMBOLS


Boundary	— Township, Meridian, Baseline.....
Road allowance; surveyed	— shoreline.....
Lot/Concession; surveyed	— unsurveyed
Parcel; surveyed	— unsurveyed
Right-of-way; road	— railway
	— utility
Reservation	[dotted pattern]
Cliff, Pit, Pile	[diagonal hatching]
Contour	— 20
Interpolated	—
Approximate	—
Depression	△
Control point (horizontal)	△
Flooded land	—
Mine head frame	□
Pipeline (above ground)	—
Railway; single track	—
double track	—
abandoned	—
Road; highway, county, township	—
access	—
trail, bush	—
Shoreline (original)	—
Transmission line	—
Wooded area	—

DISPOSITION OF CROWN LANDS

Patent	Surface & Mining Rights
	Surface Rights Only
	Mining Rights Only
Lease	Surface & Mining Rights
	Surface Rights Only
	Mining Rights Only
Licence of Occupation	▼
Order-in-Council	OC
Cancelled	○
Reservation	○
Sand & Gravel	○

THE INFORMATION THAT APPEARS ON THIS MAP HAS BEEN COMPILED FROM VARIOUS SOURCES AND ACCURACY IS NOT GUARANTEED. THOSE WISHING TO STAKE MINING CLAIMS SHOULD CONSULT THE SURVEY RECORDER, MINISTRY OF NORTHERN DEVELOPMENT AND MINES FOR ADDITIONAL INFORMATION ON THE STATUS OF THE LANDS SHOWN HEREON.

Blezzard Twp.

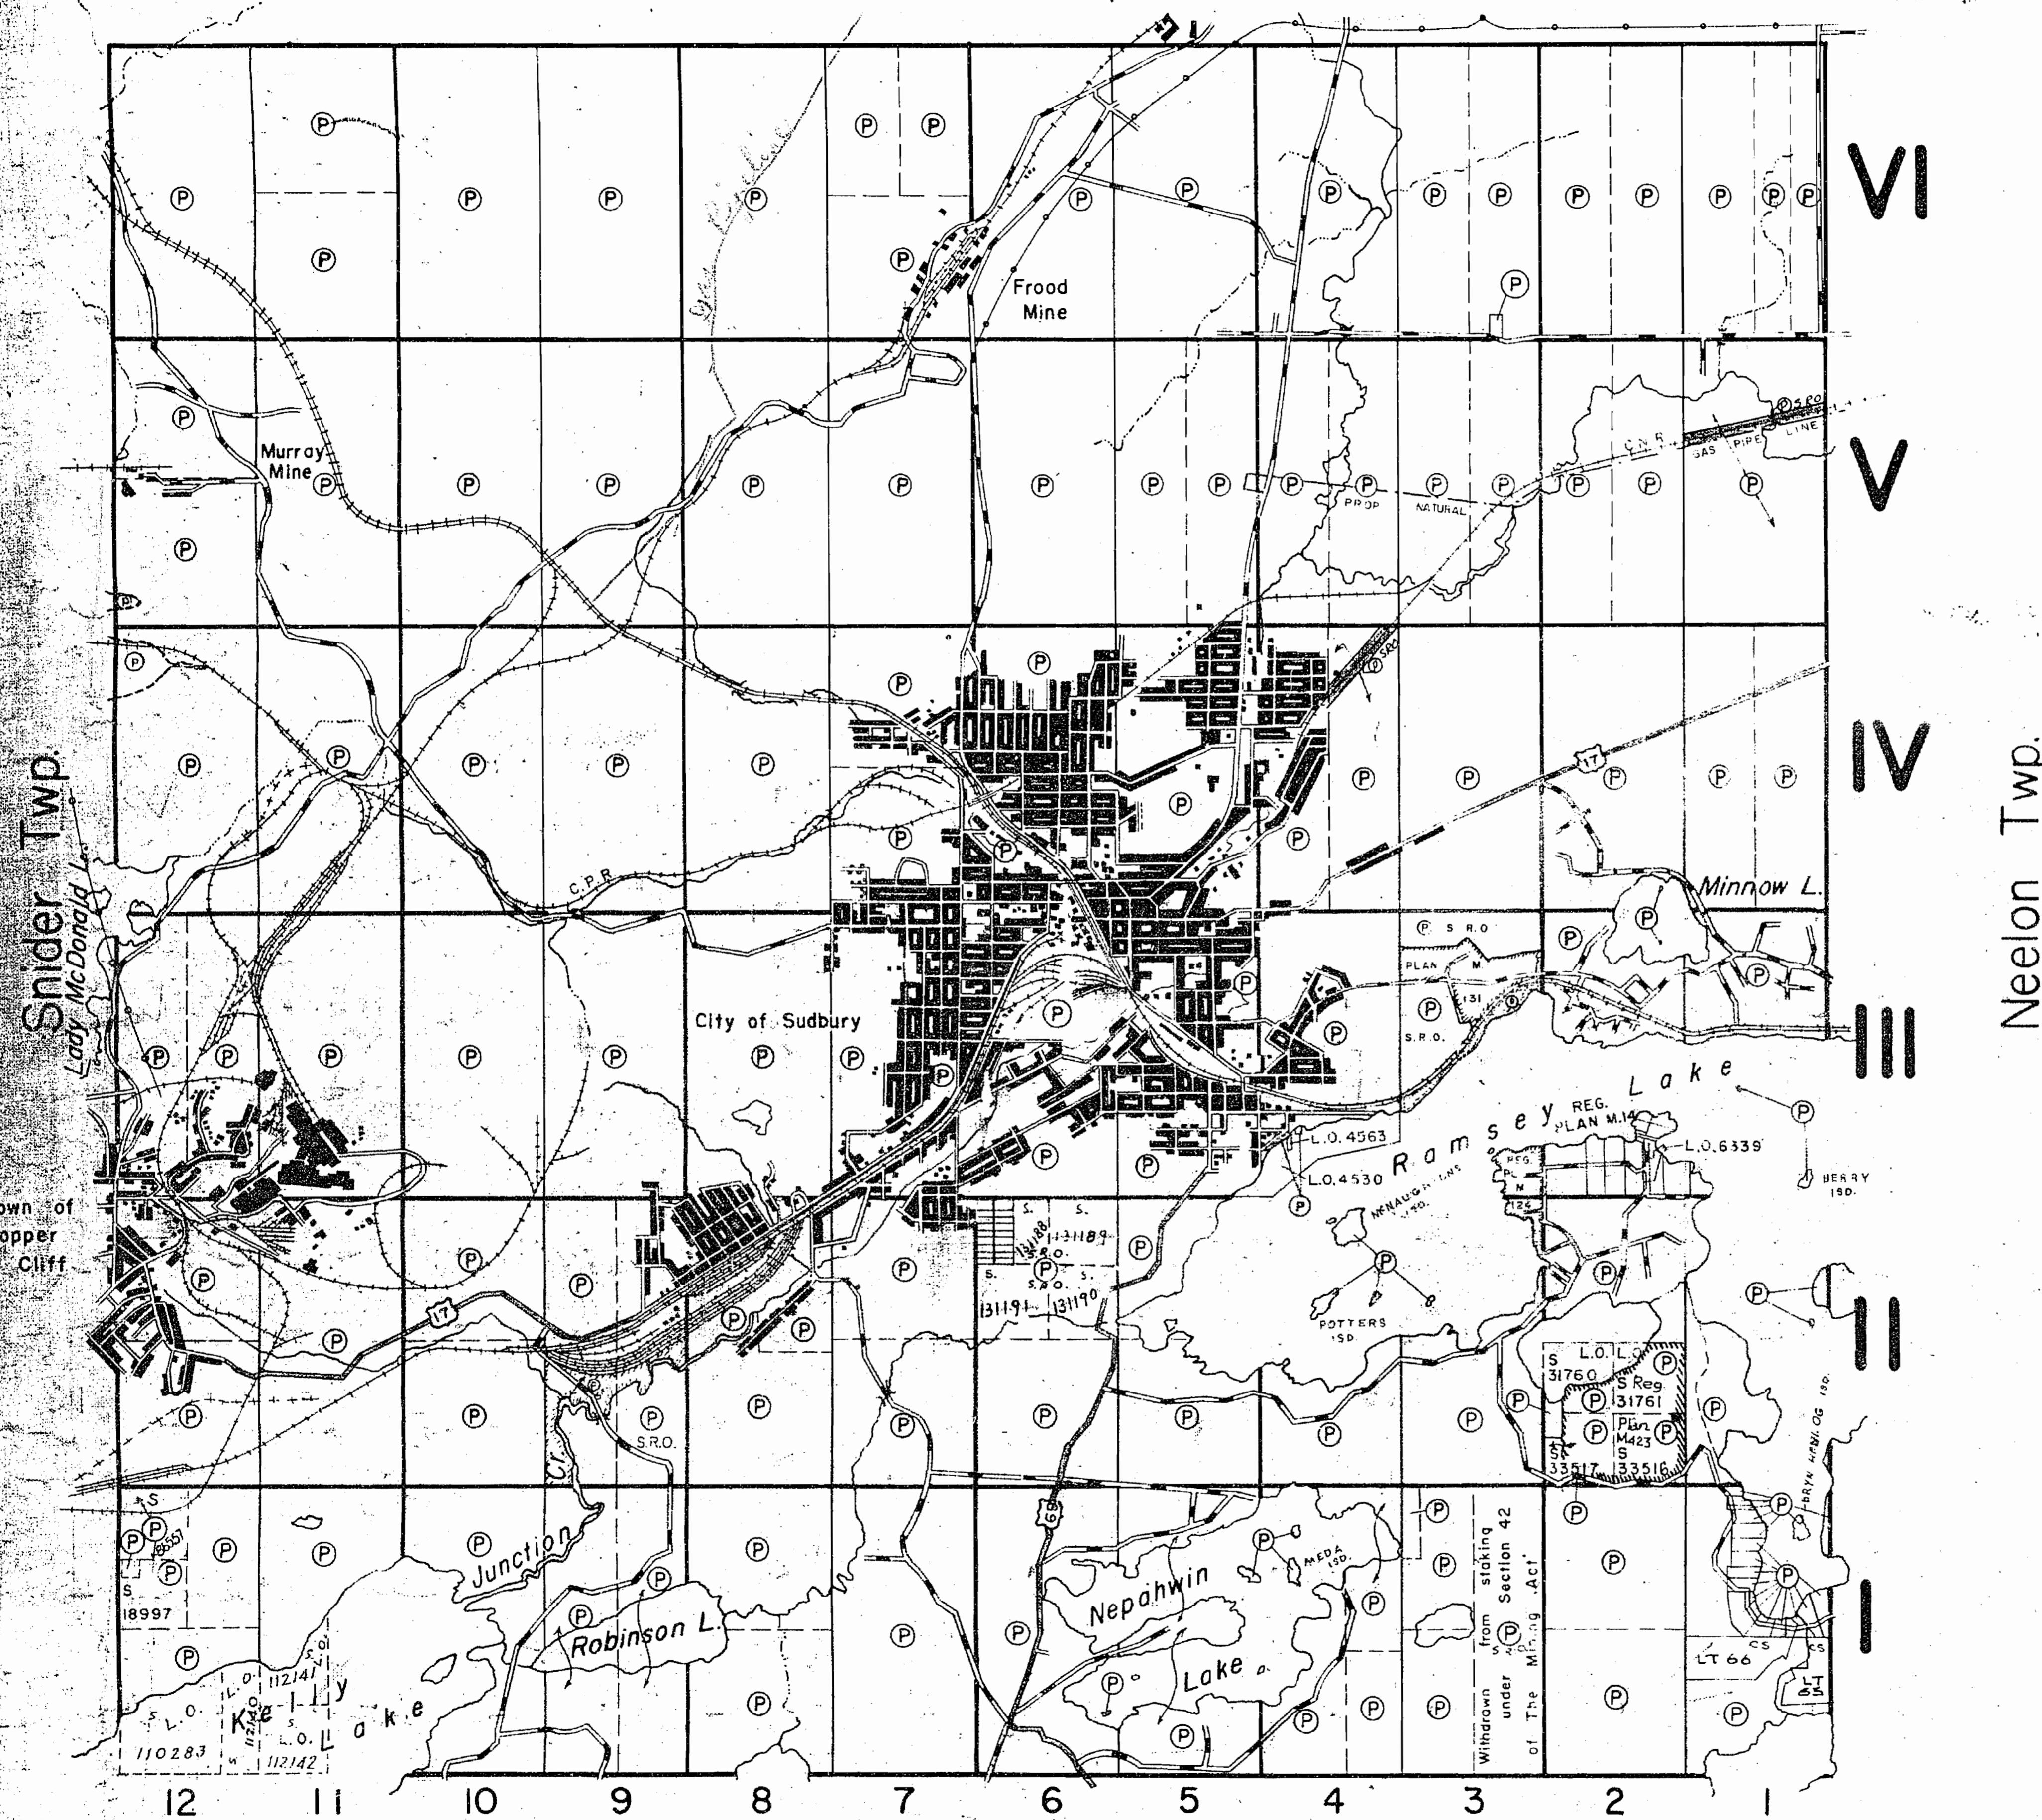

Broder Twp.

THE TOWNSHIP
OF
McKIM

DISTRICT OF
SUDBURY

SUDBURY
MINING DIVISION

SCALE: 1-INCH= 40 CHAINS

LEGEND

P	CROWN LAND SALE
(S) or C.S.	LEASES
L.	LOCATED LAND
L.O.	LICENSE OF OCCUPATION
M.R.O.	MINING RIGHTS ONLY
S.R.O.	SURFACE RIGHTS ONLY
—	ROADS
—	IMPROVED ROADS
—	KING'S HIGHWAYS
—	RAILWAYS
—	POWER LINES
—	MARSH OR MUSKEG
—	MINES

NOTES

MINING RECORDERS OFFICE LOCATED
AT WAISBERG, BLOCK 5 YOUNG ST.
NORTH SUDBURY.

400' surface rights reservation around all
lakes and river.

PLAN NO.- M- 1013

DEPARTMENT OF MINES
—ONTARIO—

Bleizard Twp.

old
Tufle

THE TOWNSHIP
OF

McKIM


DISTRICT OF
SUDBURY

SUDBURY
MINING DIVISION

SCALE: 1-INCH=40 CHAINS

LEGEND

(P)	PATENTED LAND
(S) or C.S.	CROWN LAND SALE
(L)	LEASES
Loc.	LOCATED LAND
L.O.	LICENSE OF OCCUPATION
M.R.O.	MINING RIGHTS ONLY
S.R.O.	SURFACE RIGHTS ONLY
—	ROADS
—	IMPROVED ROADS
—	KING'S HIGHWAYS
—	RAILWAYS
—	POWER LINES
—	MARSH OR MUSKEG
—	MINES

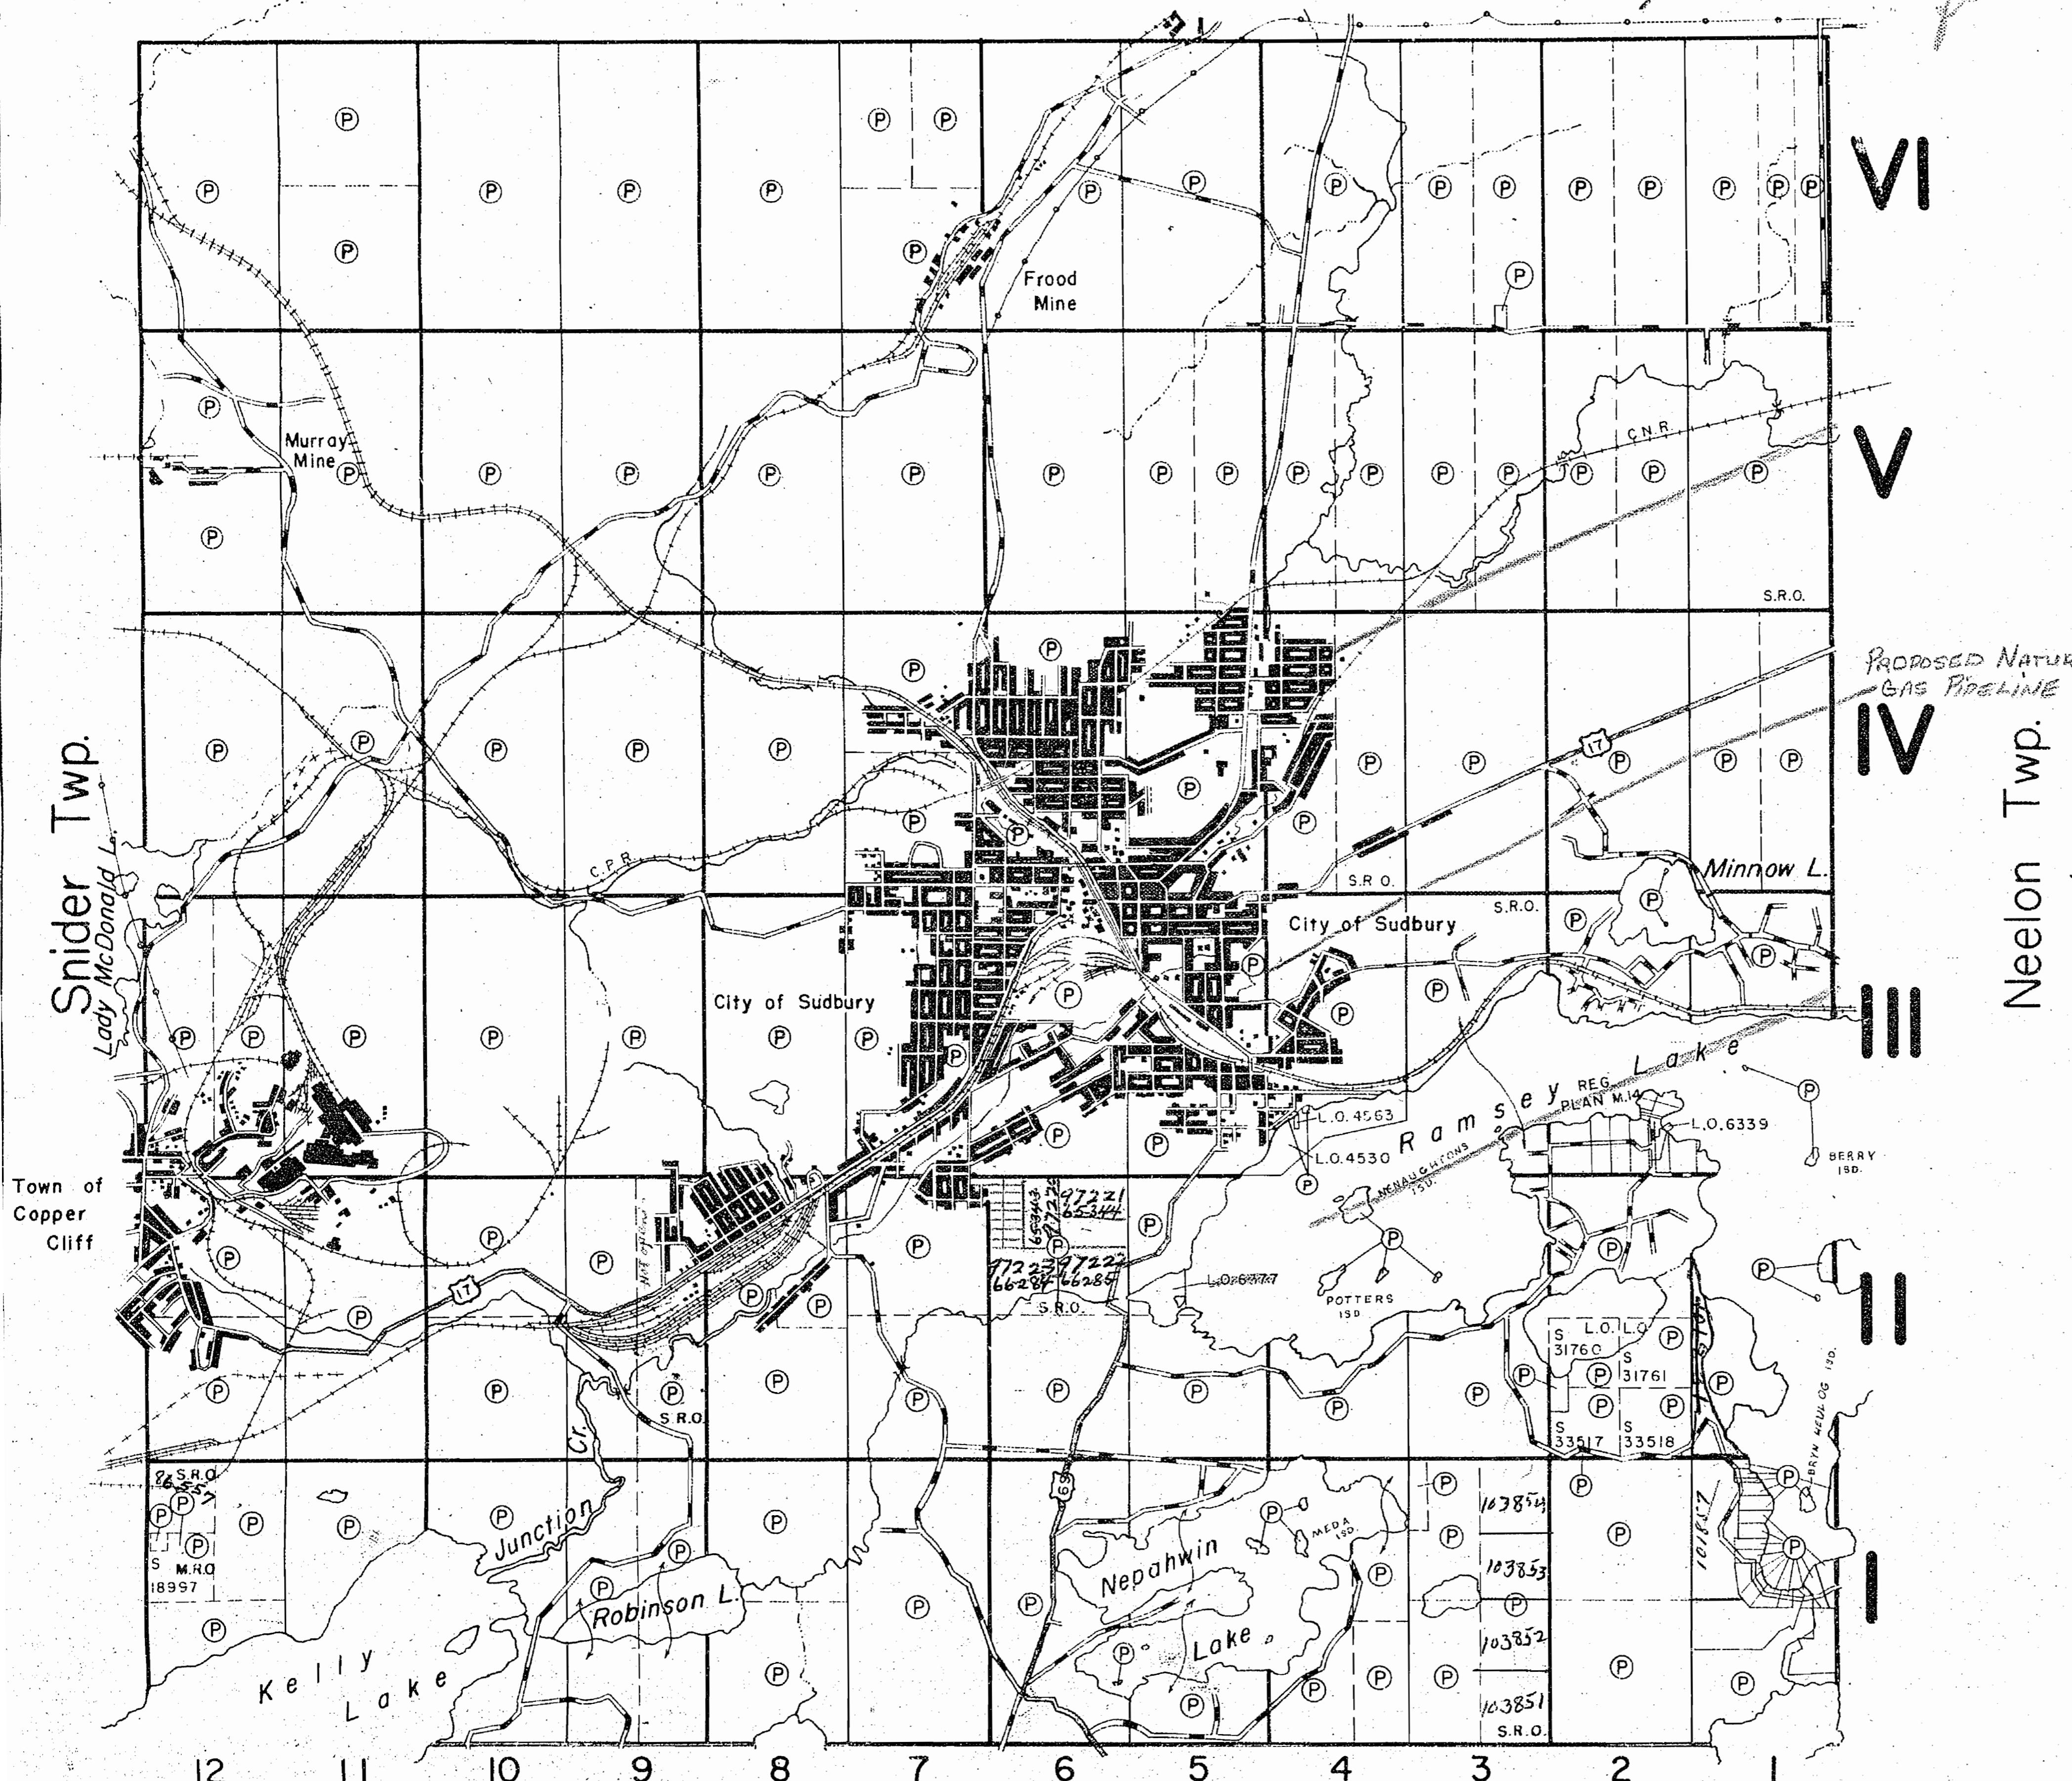

NOTES

MINING RECORDERS OFFICE LOCATED
AT WAISBERG BLOCK 5 YOUNG ST.
NORTH SUDBURY.

M-1013


PLAN NO.- S.327

DEPARTMENT OF MINES
—ONTARIO—

Brode 1013

1013

Bleizard Twp.

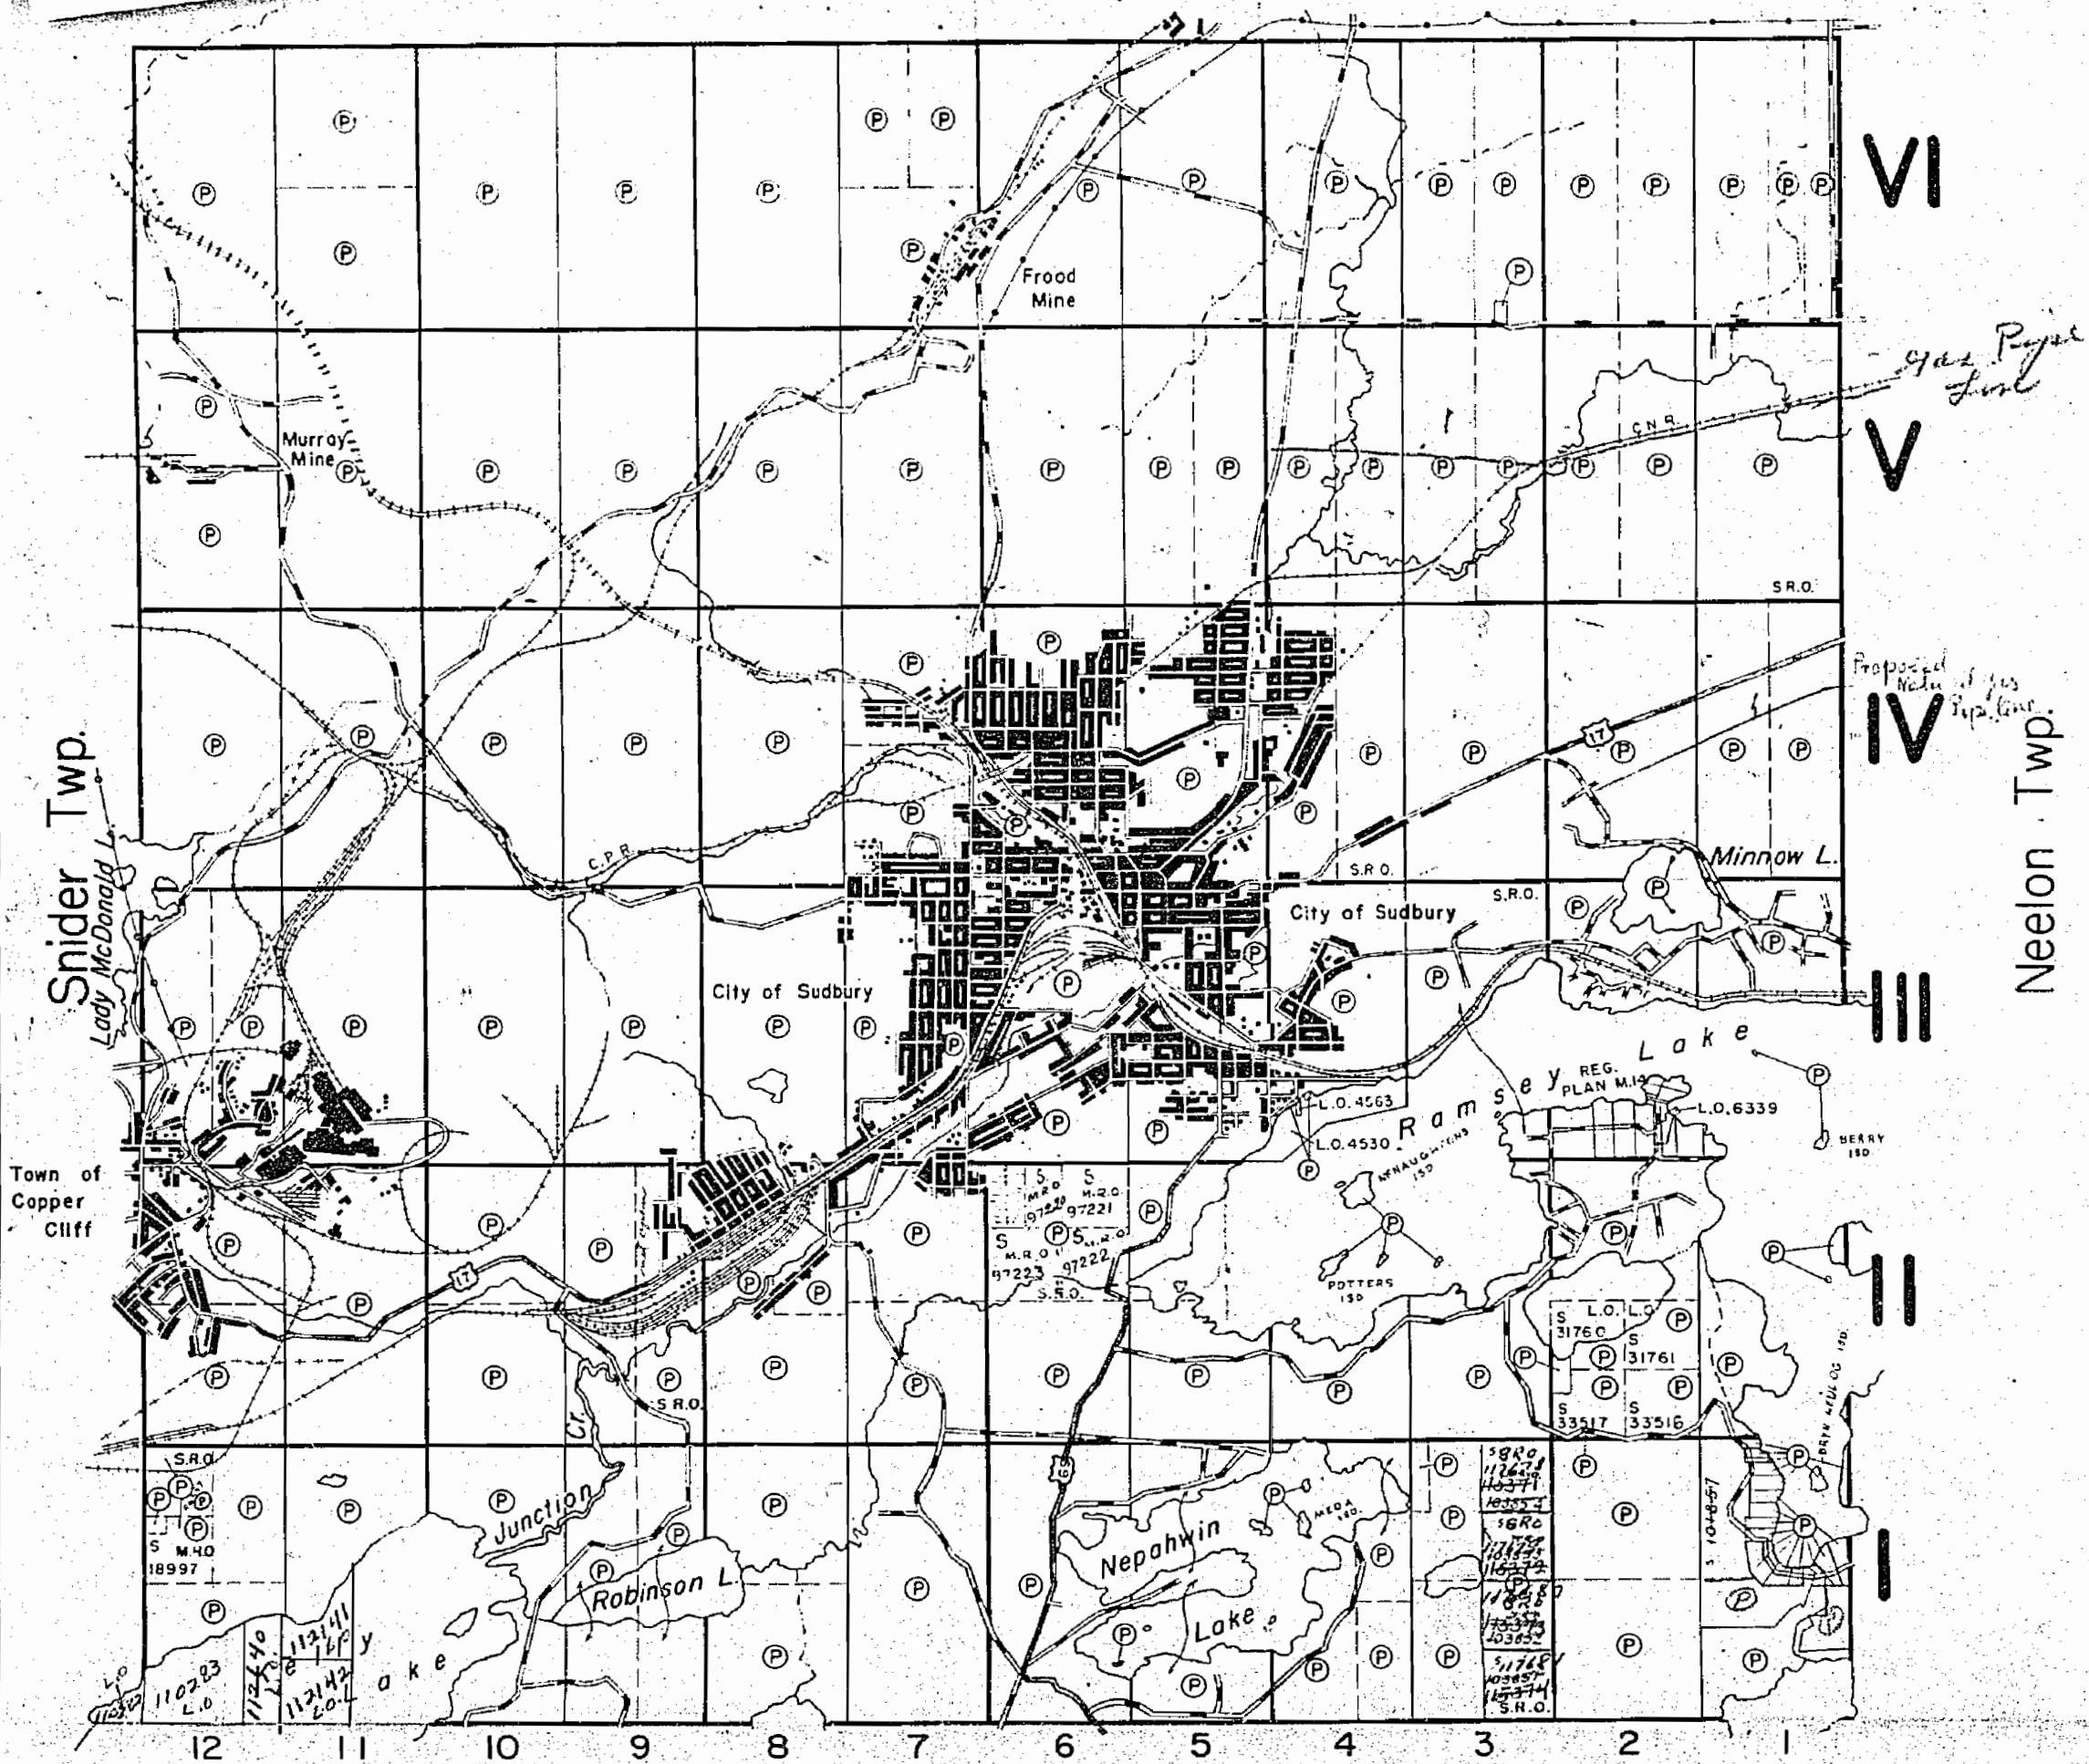map fileTHE TOWNSHIP
OF**McKIM**DISTRICT OF
SUDSBURYSUDSBURY
MINING DIVISION


SCALE: 1-INCH= 40 CHAINS.

LEGEND

PATENTED LAND	(P)
CROWN LAND SALE	(S) or C.S.
LEASES	(L)
LOCATED LAND	Loc.
LICENSE OF OCCUPATION	L.O.
MINING RIGHTS ONLY	M.R.O.
SURFACE RIGHTS ONLY	S.R.O.
ROADS	—
IMPROVED ROADS	—
KING'S HIGHWAYS	—
RAILWAYS	—
POWER LINES	—
MARSH OR MUSKEG	X
MINES	X

NOTES

MINING RECORDERS OFFICE LOCATED
AT WAISBERG BLOCK 5 YOUNG ST.
NORTH SUDSBURY

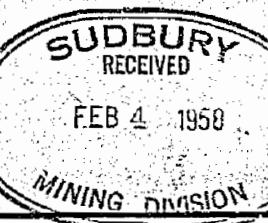

PLAN NO.- M- 1013

DEPARTMENT OF MINES
ONTARIO

1013

Blezard Twp.

~~old~~ Twinkie

THE TOWNSHIP
OF

McKIM

DISTRICT OF
SUDBURY

SUDBURY MINING DIVISION

SCALE: 1-INCH = 40 CHAINS

LEGEND

- | | |
|-----------------------|-------------|
| PATENTED LAND | |
| CROWN LAND SALE | (S) or C.S. |
| LEASES | (L) |
| LOCATED LAND | Loc. |
| LICENSE OF OCCUPATION | L.O. |
| MINING RIGHTS ONLY | M.R.O. |
| SURFACE RIGHTS ONLY | S.R.O. |
| ROADS | - - - - - |
| IMPROVED ROADS | ----- |
| KING'S HIGHWAYS | ----- |
| RAILWAYS | ----- |
| POWER LINES | ----- |
| MARSH OR MUSKEG | ----- |
| MINES | X |

NOTES

MINING RECORDERS OFFICE LOCATED
AT WAISBERG BLOCK 5 YOUNG ST.
NORTH SUDBURY.


M-1013

PLAN NO.- S.327

DEPARTMENT OF MINES
—ONTARIO—

1013

Blezar Twp.

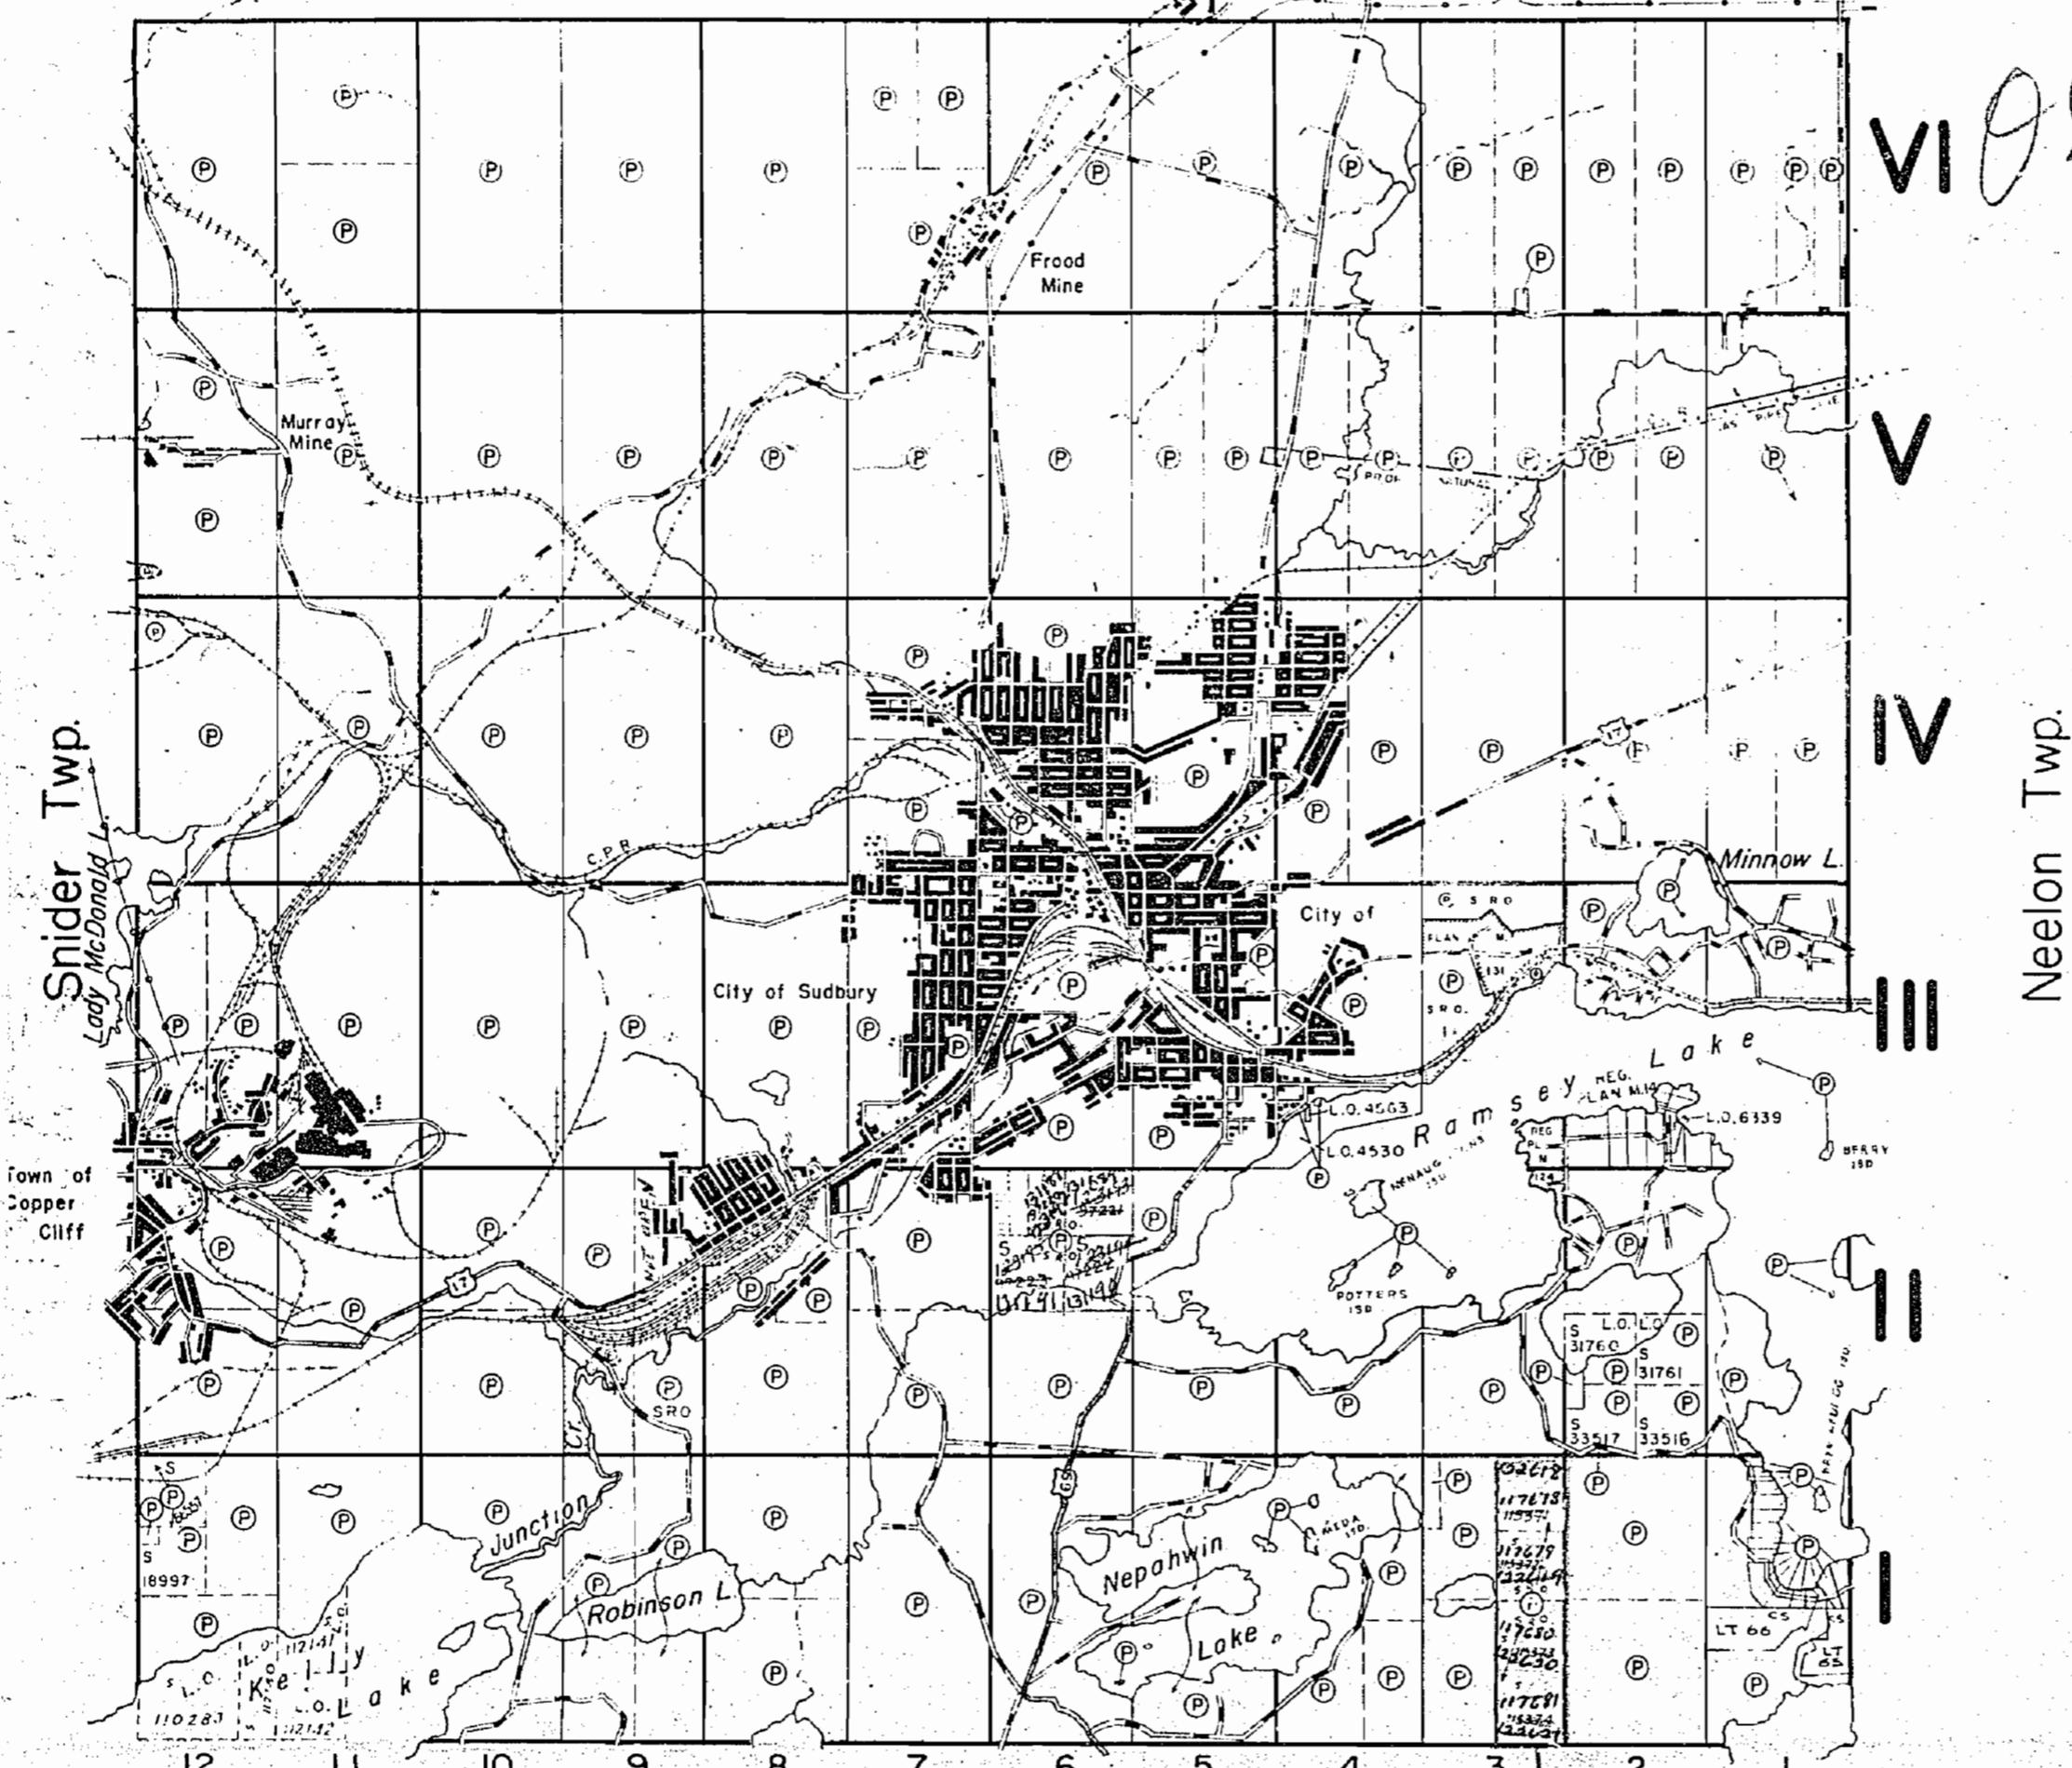

Broder Twp.

NOTE!
THE MINING RIGHTS OF
E 1/2 LOT 3 CON I ARE
WITHDRAWN FROM STAGING,
PROSPECTING, SALE, LEASE
AUG. 17/65.

THE TOWNSHIP
OF

McKIM

DISTRICT OF
SUDBURY

SUDBURY
MINING DIVISION

SCALE: 1-INCH= 40 CHAINS

LEGEND

(P)	PATENTED LAND
(S or C.S.)	CROWN LAND SALE
(L)	LEASES
Loc.	LOCATED LAND
L.O.	LICENSE OF OCCUPATION
M.R.O.	MINING RIGHTS ONLY
S.R.O.	SURFACE RIGHTS ONLY
ROADS	ROADS
IMPROVED ROADS	IMPROVED ROADS
KING'S HIGHWAYS	KING'S HIGHWAYS
RAILWAYS	RAILWAYS
POWER LINES	POWER LINES
MARSH OR MUSKEG	MARSH OR MUSKEG
MINES	MINES

NOTES

MINING RECORDERS OFFICE LOCATED
AT WAISBERG BLOCK 5 YOUNG ST.
NORTH SUDBURY.


400' surface rights reservation around all
lakes and river.

PLAN NO.- M- 1013

DEPARTMENT OF MINES
—ONTARIO—

1013

Blezzard Twp.

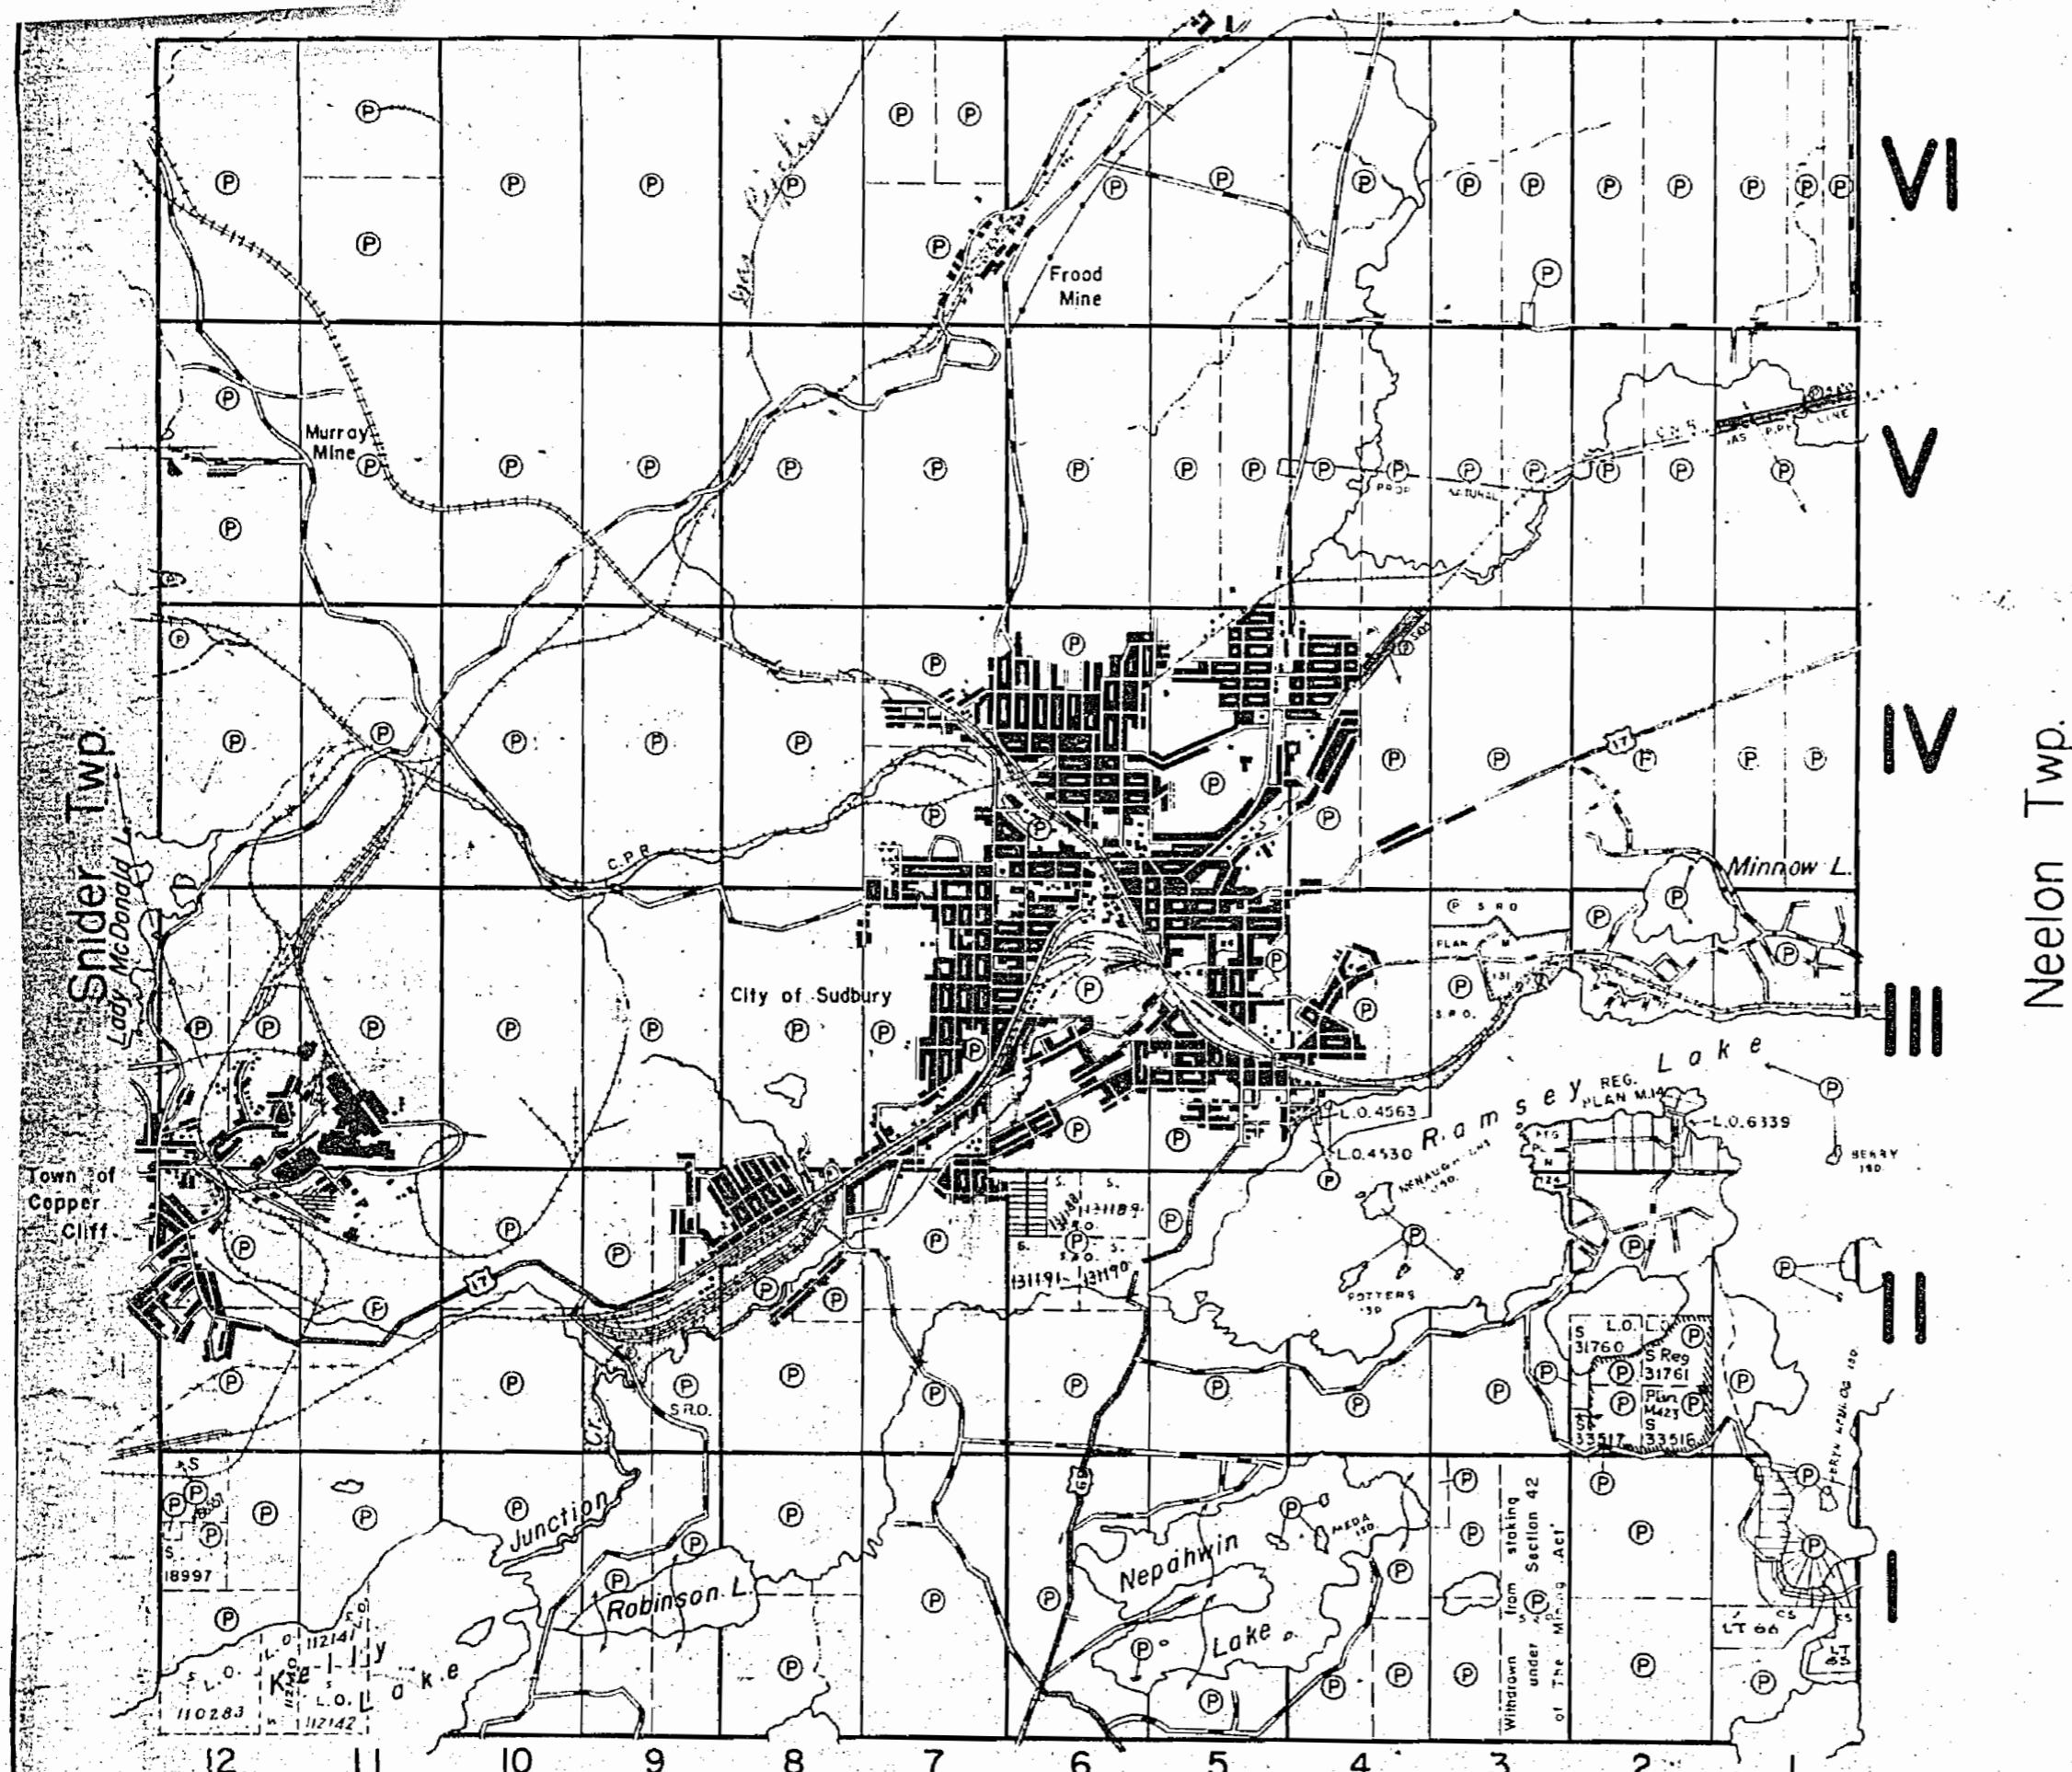

THE TOWNSHIP
OF
McKIM

DISTRICT OF
SUDBURY

SUDBURY
MINING DIVISION

SCALE: 1-INCH= 40 CHAINS

LEGEND

(P)	PATENTED LAND
(S or CS)	CROWN LAND SALE LEASES
(Loc.)	LOCATED LAND
(LO)	LICENSE OF OCCUPATION
(M.R.O.)	MINING RIGHTS ONLY
(S.R.O.)	SURFACE RIGHTS ONLY
Roads	ROADS
Improve Roads	IMPROVED ROADS
King's Highways	KING'S HIGHWAYS
Railways	RAILWAYS
Power Lines	POWER LINES
Mash or Muskeg	MASH OR MUSKEG
Mines	MINES

NOTES

MINING RECORDERS OFFICE LOCATED
AT WAISBERG BLOCK 5 YOUNG ST.
NORTH SUDBURY

400' surface rights reservation around all
lakes and river.

PLAN NO.- M- 1013


DEPARTMENT OF MINES
—ONTARIO—

Broder Twp.

surface rights along preserved
transmissions line
July 23/30 - Distructions

Norite
Sudbury Townsite

BLEZZARD

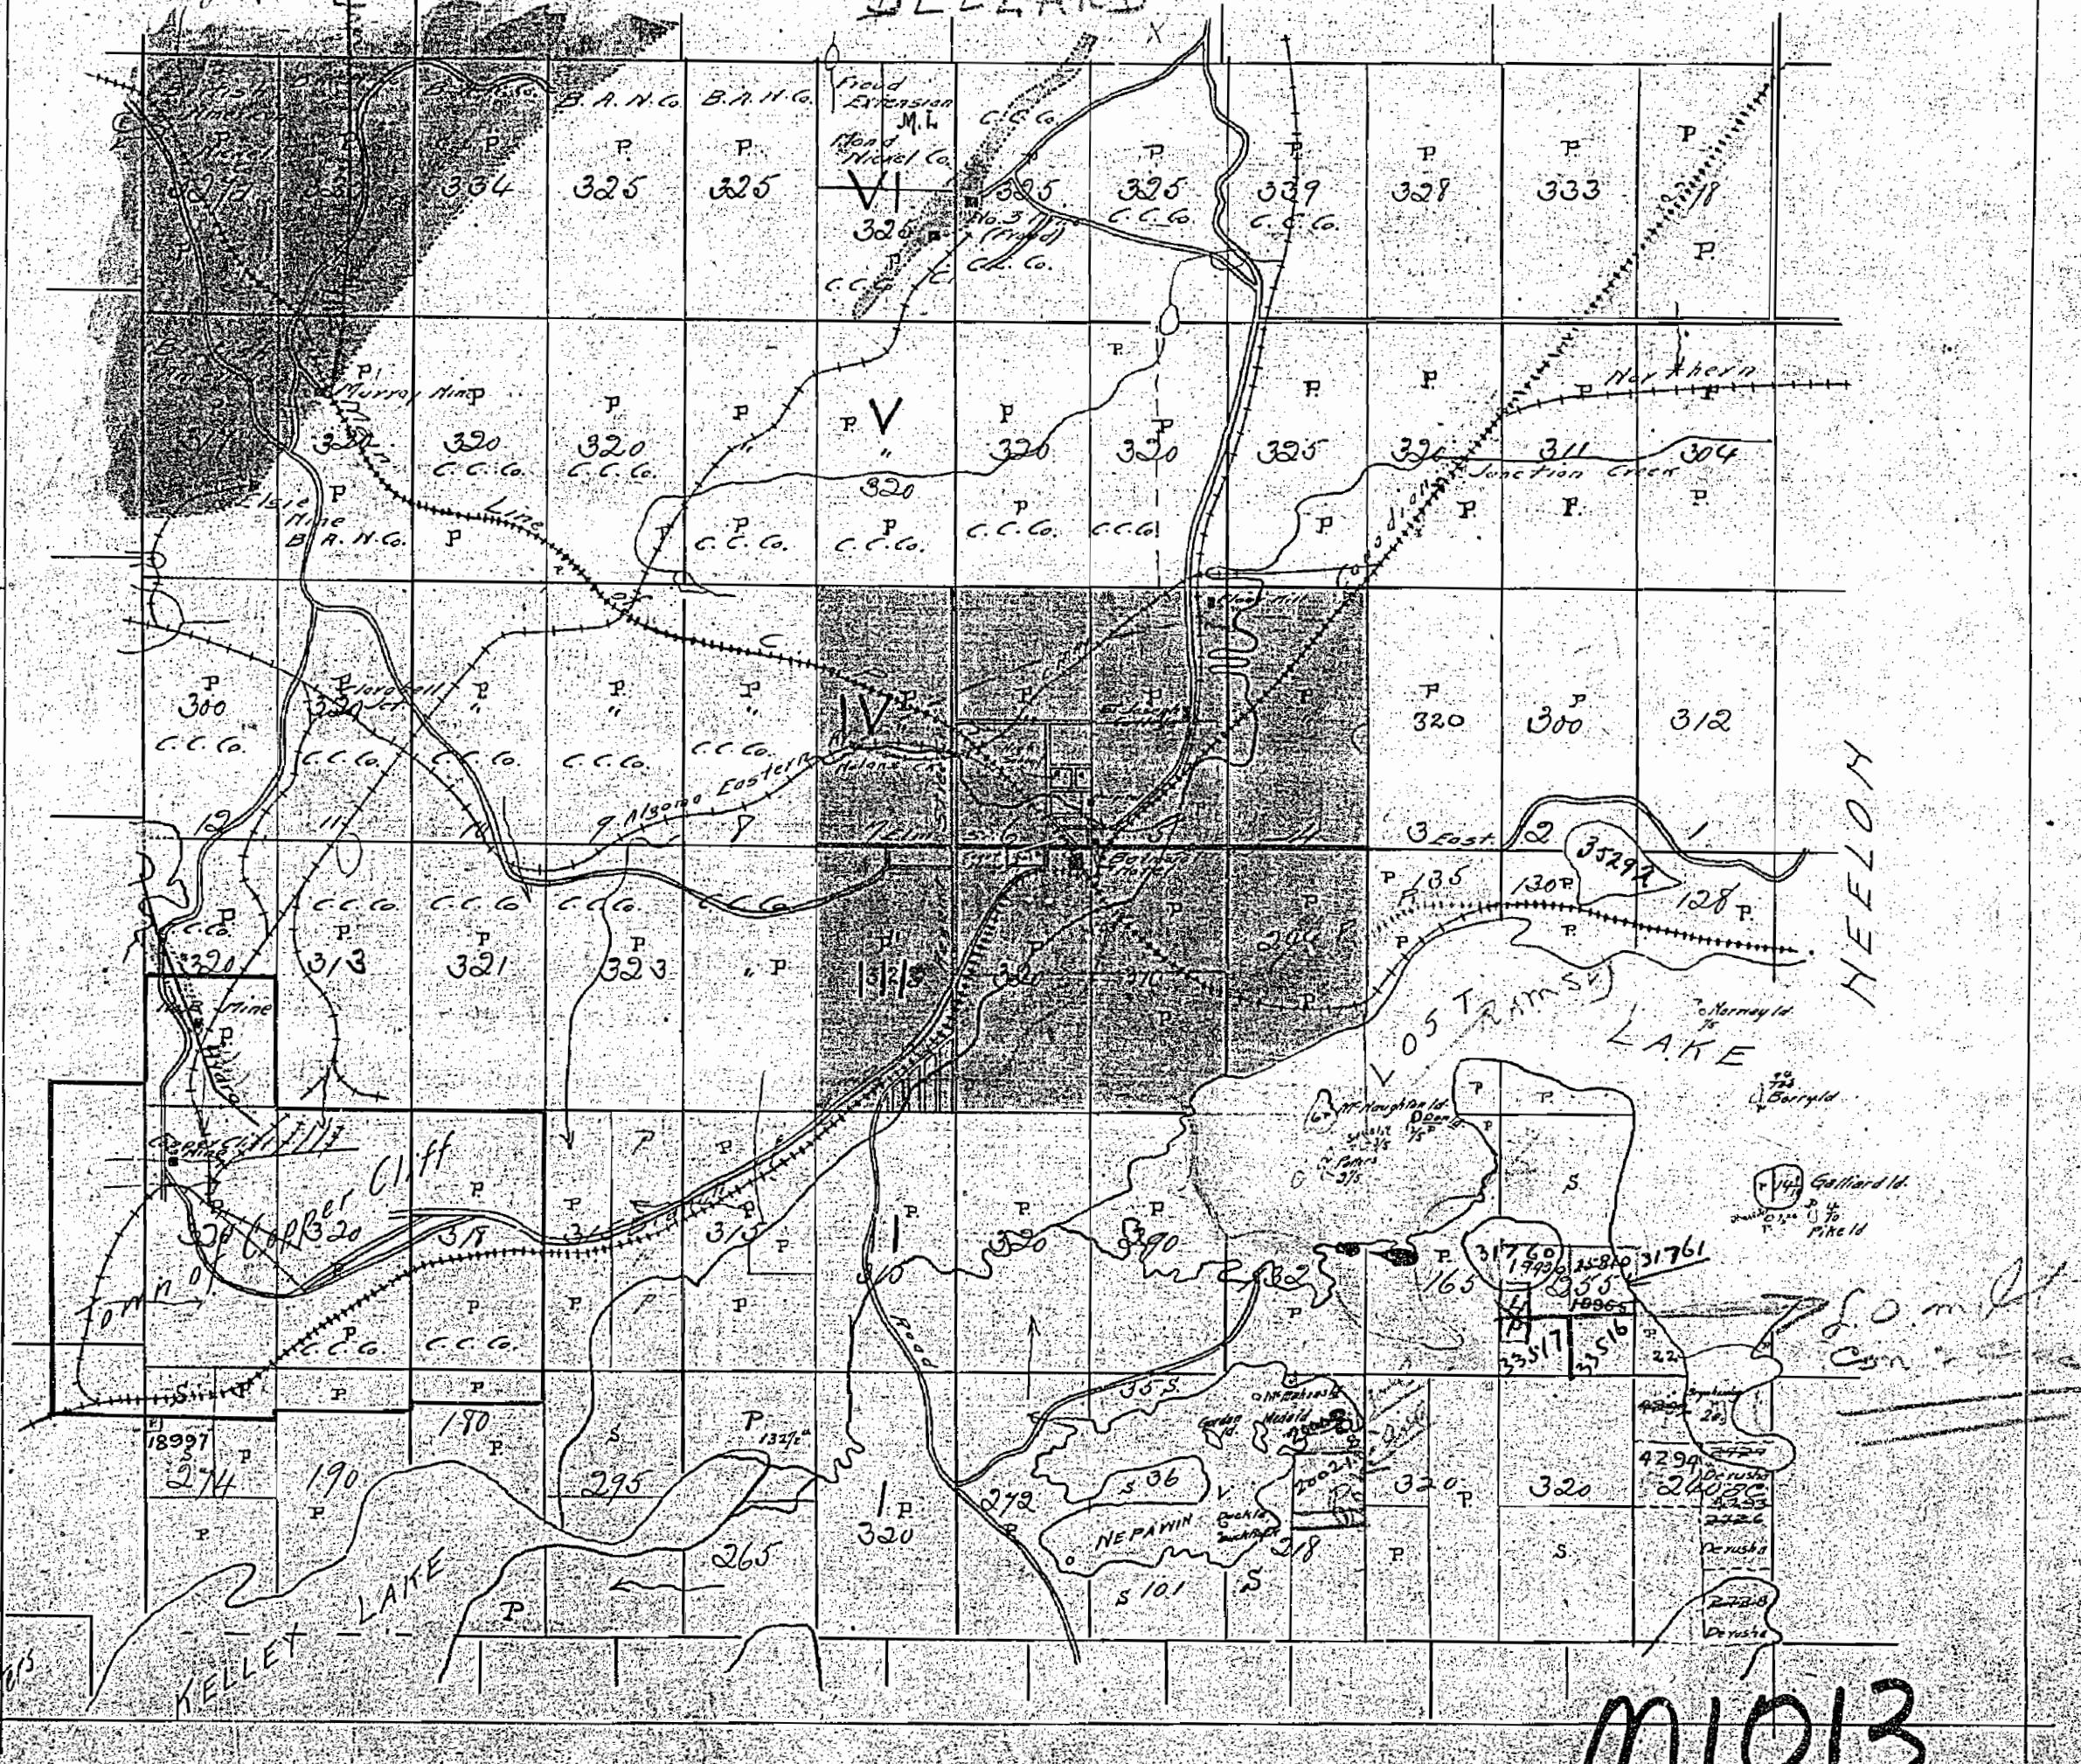

OFFICE USE ONLY

Blezzard Twp.

THE TOWNSHIP
OF
McKIM

DISTRICT OF
SUDBURY

SUDBURY
MINING DIVISION

SCALE: 1-INCH=40 CHAINS

LEGEND

- (P) PATENTED LAND
- (S) CROWN LAND SALE
- (L) LEASES
- (Loc.) LOCATED LAND
- (L.O.) LICENSE OF OCCUPATION
- (M.R.C.) MINING RIGHTS ONLY
- (S.R.O.) SURFACE RIGHTS ONLY
- (R.O.) ROADS
- (I.R.O.) IMPROVED ROADS
- (K.H.) KING'S HIGHWAYS
- (R.) RAILWAYS
- (P.L.) POWER LINES
- (M.M.) MARSH OR MUSKEG
- (M.) MINES

NOTES

MINING RECORDERS OFFICE LOCATED
AT WAISBERG BLOCK 5 YOUNG ST.
NORTH SUDBURY.

400' surface rights reservation around c.
lakes and river.

subj to see 37


* IN SERVICE 1971 04 13TH - NCM

MCKIM

PLAN NO.- M-1013


ONTARIO

DEPARTMENT OF MINES
AND NORTHERN AFFAIRS

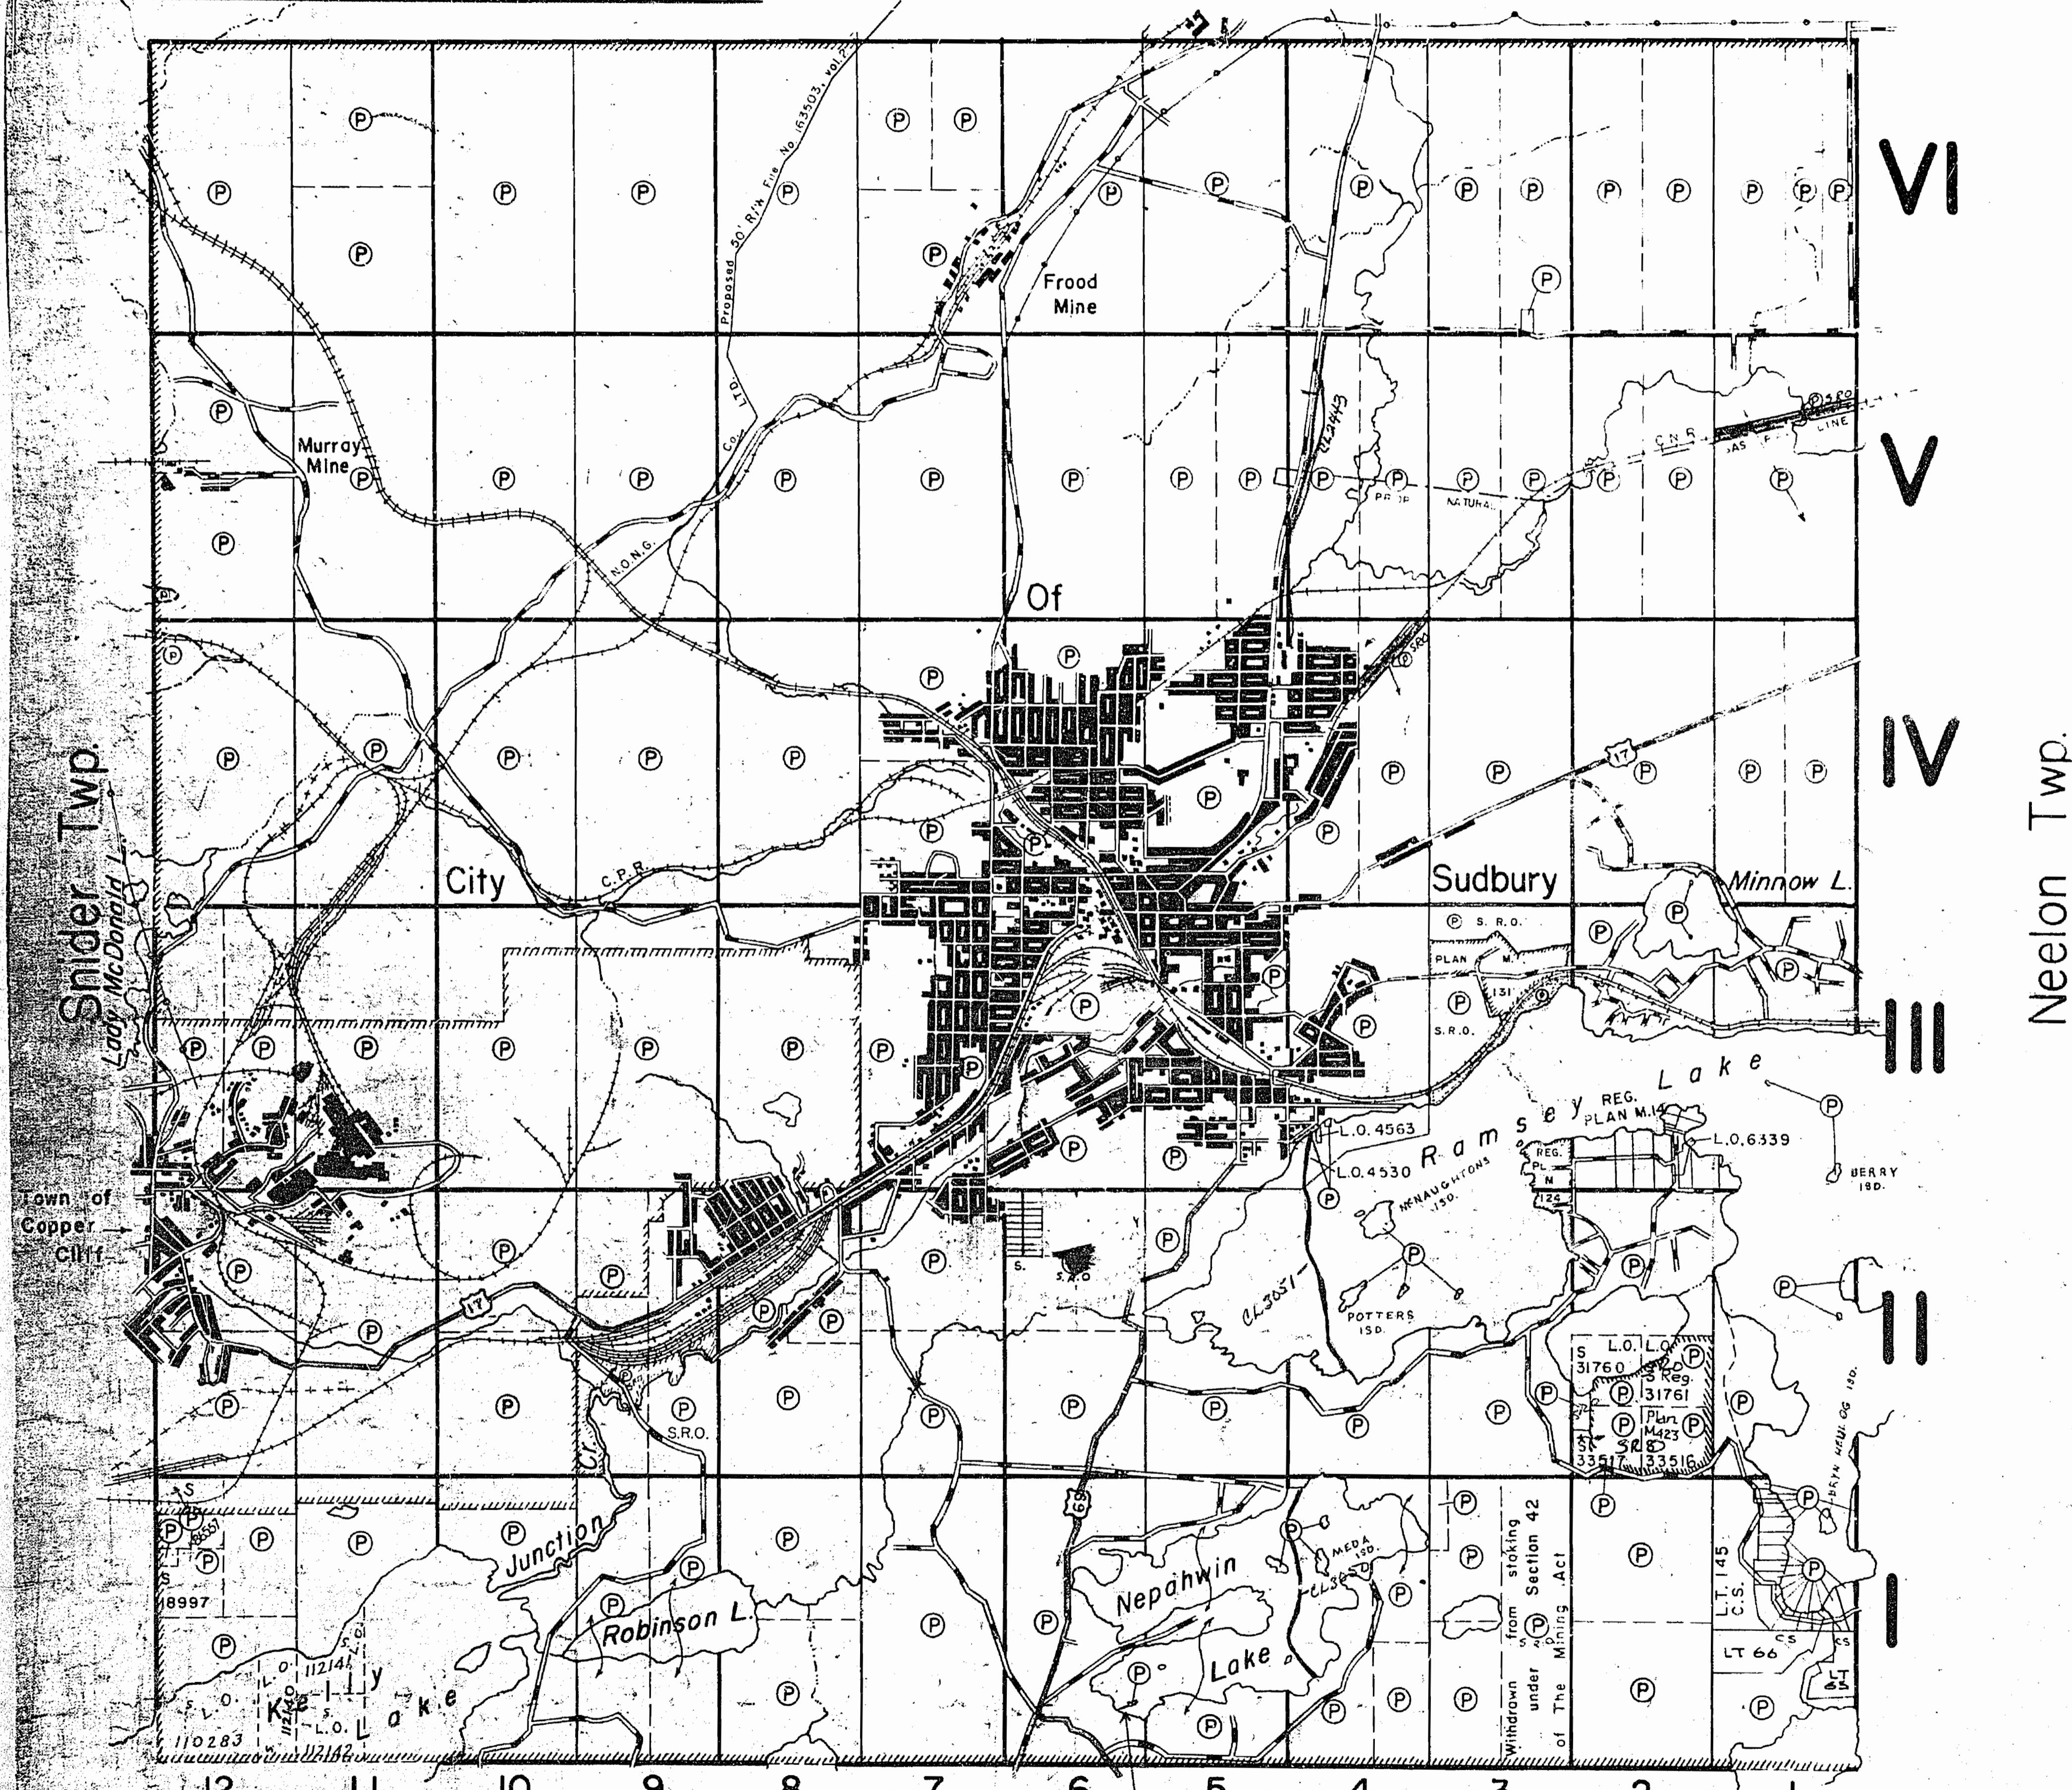

1013

Bleizard Twp.

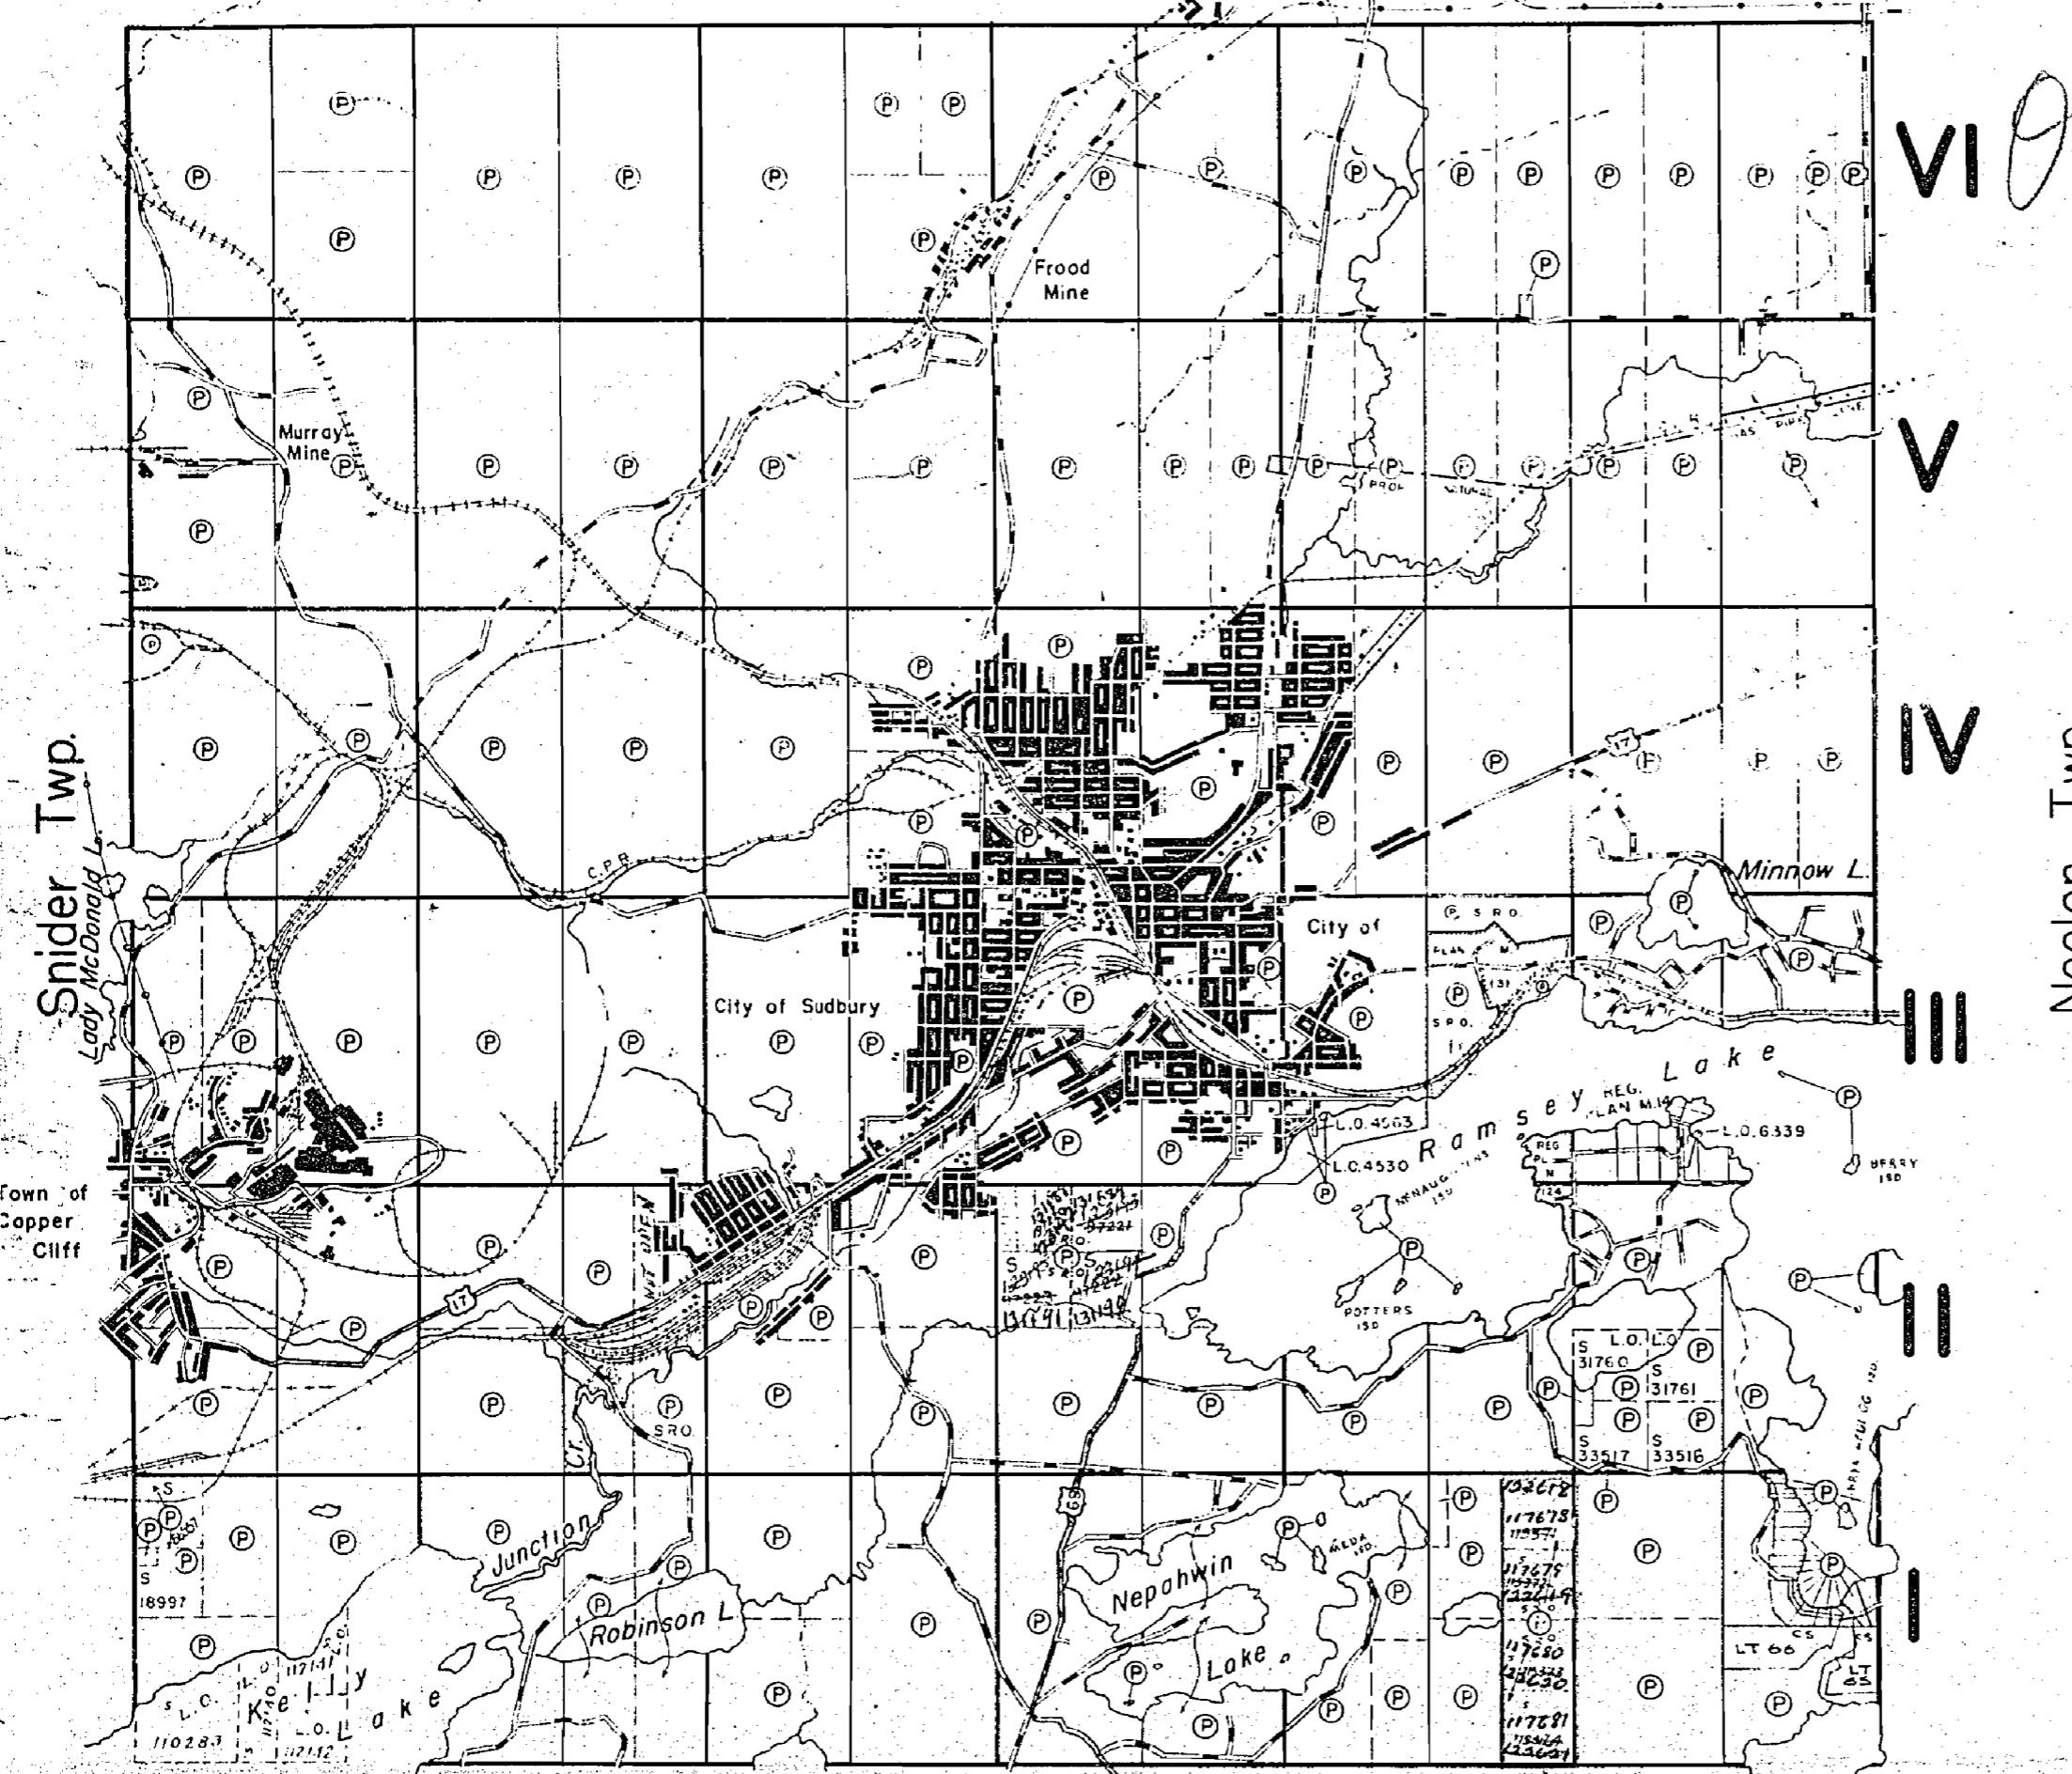

Broder Twp.

THE TOWNSHIP
OF**McKIM**DISTRICT OF
SUDBURYSUDBURY
MINING DIVISION

SCALE: 1-INCH=40 CHAINS

LEGEND

(P)	PATENTED LAND
(S) or C.S.	CROWN LAND SALE
(L)	LEASES
Loc.	LOCATED LAND
L.O.	LICENSE OF OCCUPATION
M.R.O.	MINING RIGHTS ONLY
S.R.O.	SURFACE RIGHTS ONLY
—	ROADS
- - -	IMPROVED ROADS
— — —	KING'S HIGHWAYS
— — — —	RAILWAYS
— — — — —	POWER LINES
— — — — — —	MARSH OR MUSKEG
X	MINES

NOTES

MINING RECORDERS OFFICE LOCATED
AT WAIISBERG BLOCK 5 YOUNG ST.
NORTH SUDBURY.

400' surface rights reservation around all
lakes and river.

PLAN NO.- M- 1013

DEPARTMENT OF MINES
—ONTARIO—