


DUNBAR TWP. M.768

SUDSBURY  
MINING DIV.  
**RECEIVED**

JUN 21 1971

A.M. 7, 8, 9, 10, 11, 12, 1, 2, 3, 4, 5, 6  
P.M.

EMO TWP. M.768

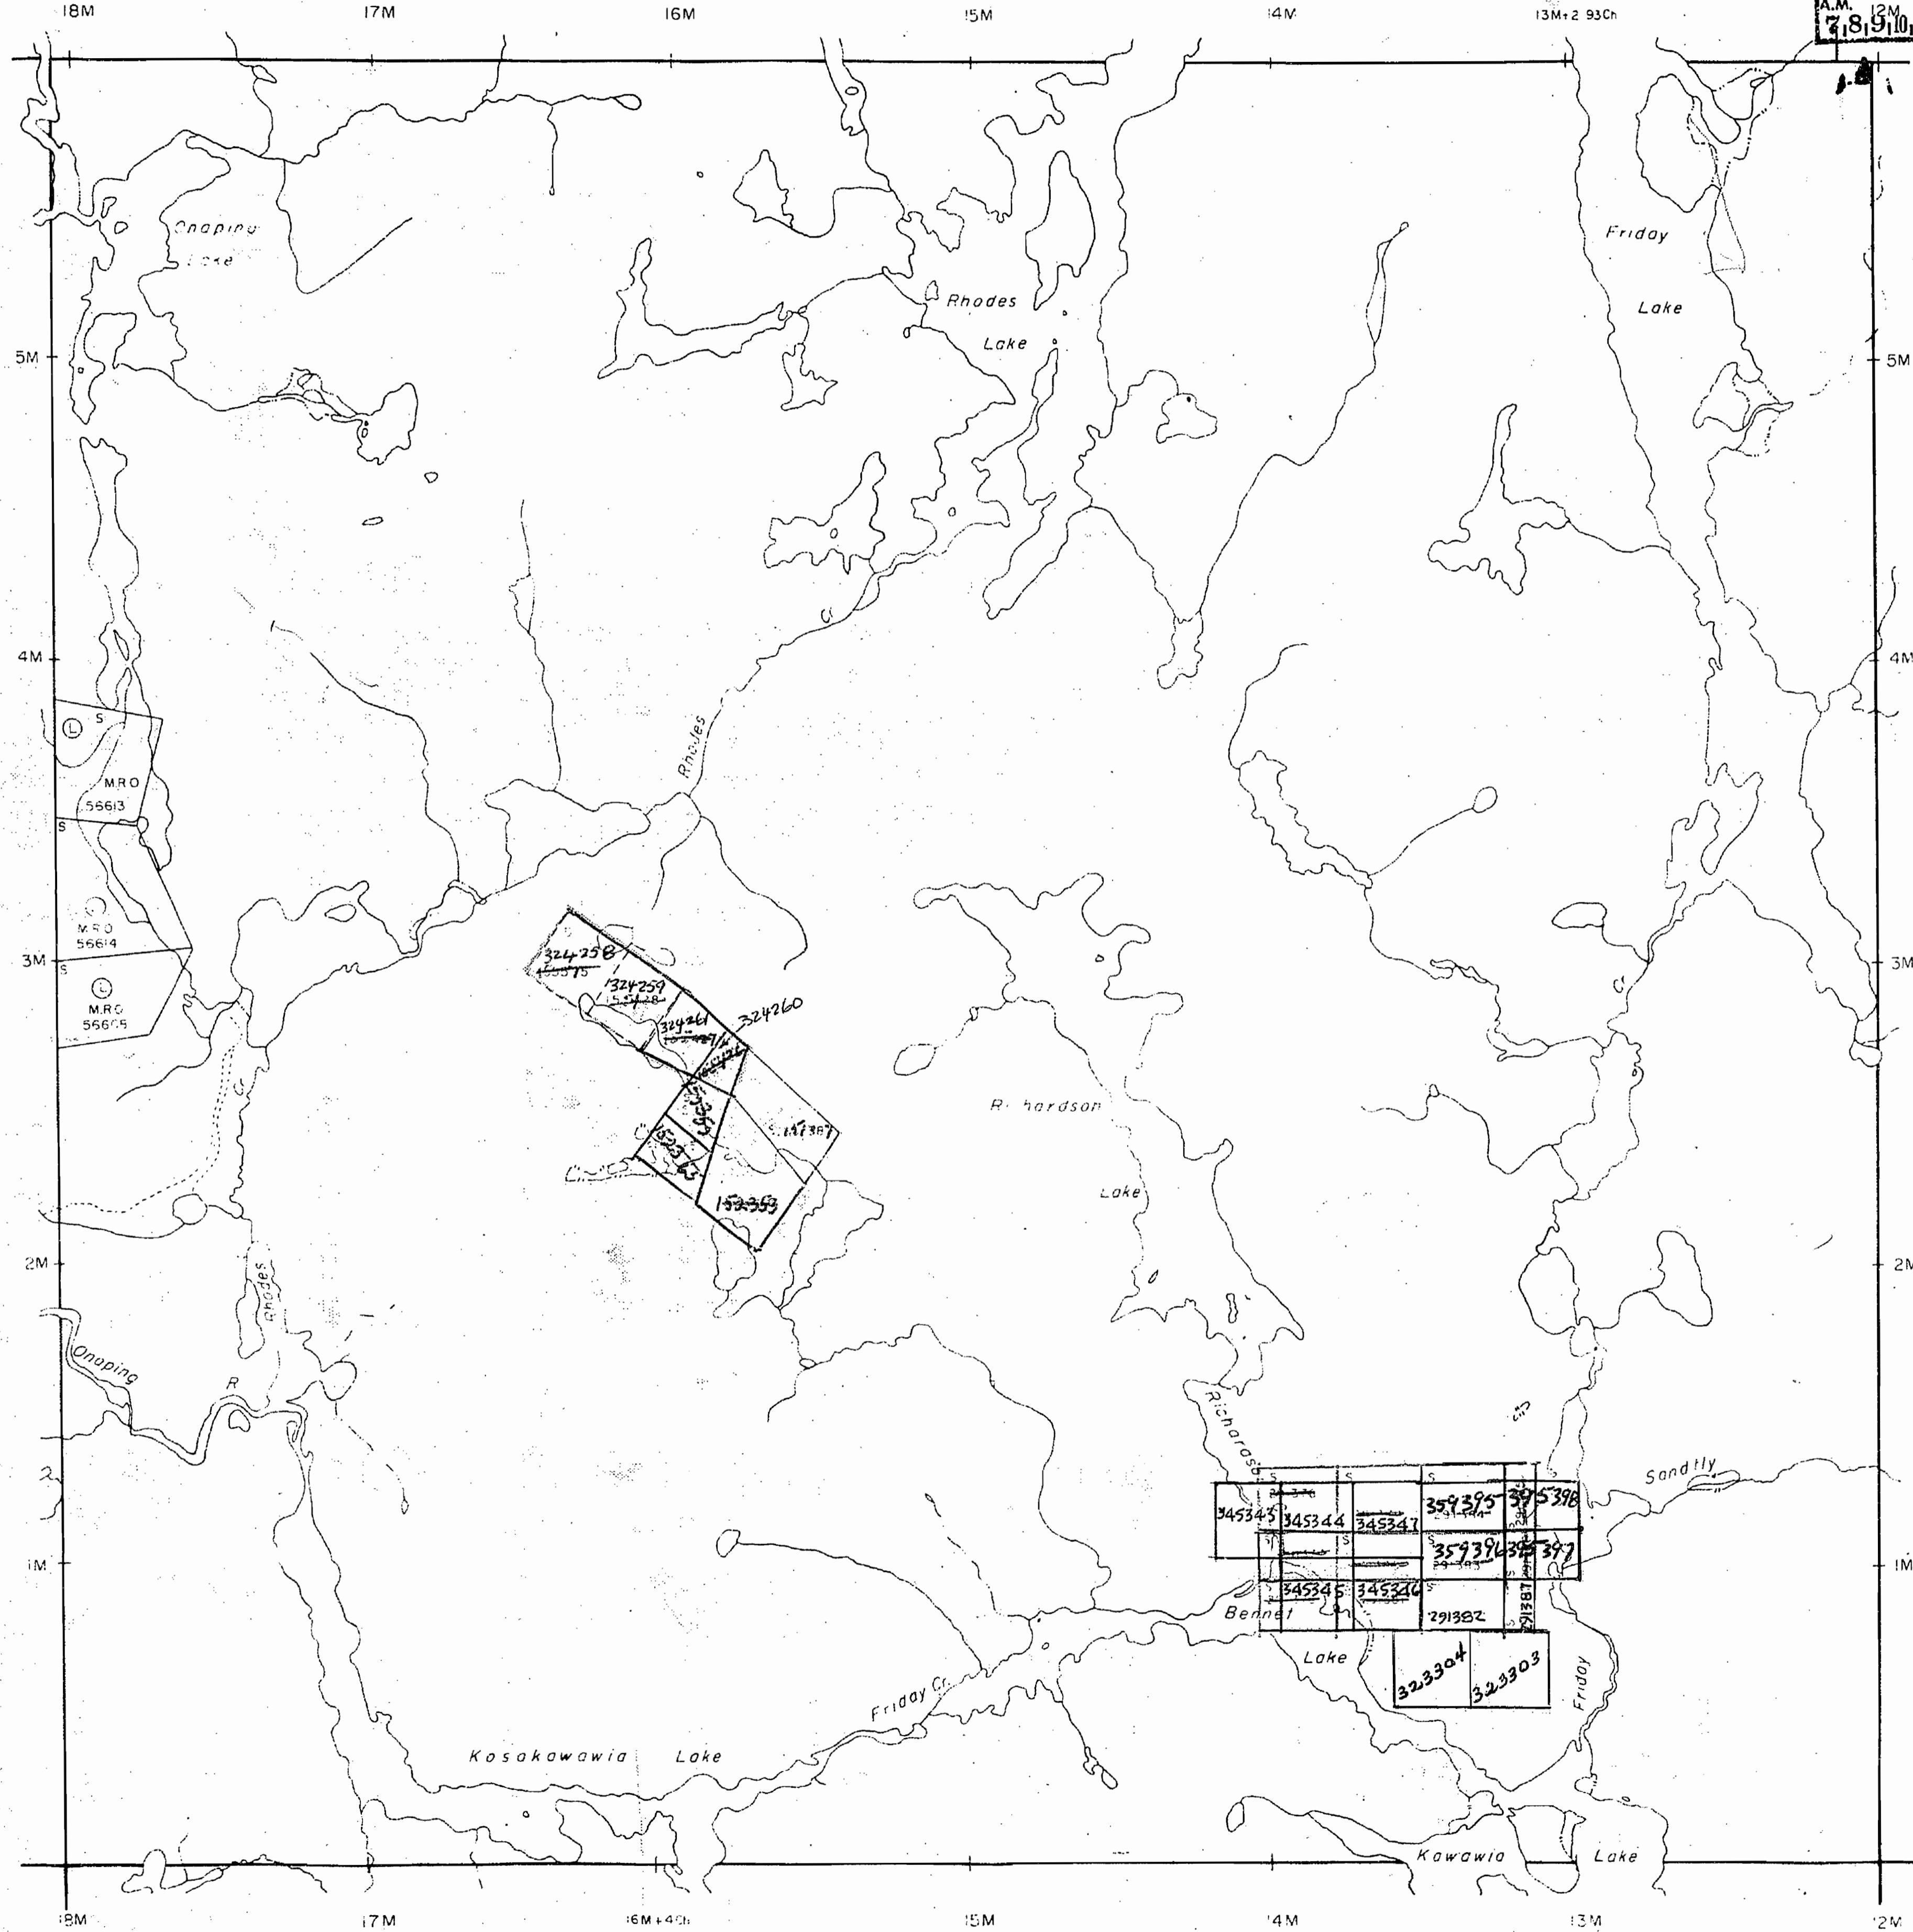

LEINSTER TWP. M.985

THE TOWNSHIP  
OF

RHODES


DISTRICT OF  
SUDBURY

SUDBURY  
MINING DIVISION

SCALE: 1-INCH 40 CHAINS

LEGEND

- PATENTED LAND
- CROWN LAND SALE LEASES
- LOCATED LAND
- LICENSE OF OCCUPATION
- MINING RIGHTS ONLY
- SURFACE RIGHTS ONLY
- ROADS
- IMPROVED ROADS
- KING'S HIGHWAYS
- RAILWAYS
- POWER LINES
- MARSH OR MUSKEG
- MINES
- CANCELLED

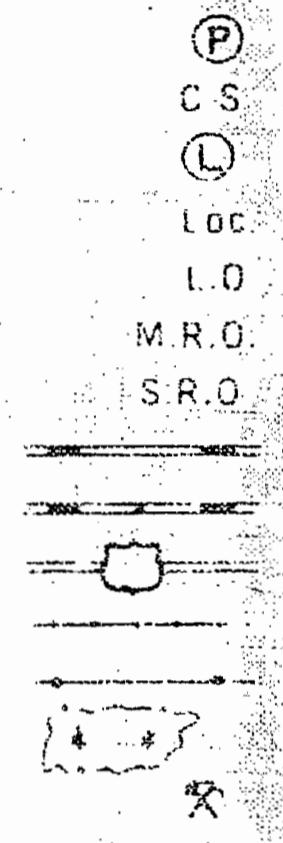

NOTES

400' surface rights reservation around the shores of all lakes and rivers.

Flooding rights to elevation III on Onaping Lake (L.O.6133) - File 9214

Old Plan 10/73

PLAN NO. M-1077

ONTARIO  
DEPARTMENT OF MINES  
AND NORTHERN AFFAIRS

1981

THE TOWNSHIP  
OF

## RHODES

DISTRICT OF  
SUDBURYSUDBURY  
MINING DIVISION

SCALE: 1-INCH 40 CHAINS

## LEGEND

- PATENTED LAND
- CROWN LAND SALE
- LEASES
- LOCATED LAND
- LICENSE OF OCCUPATION
- MINING RIGHTS ONLY
- SURFACE RIGHTS ONLY
- ROADS
- IMPROVED ROADS
- KING'S HIGHWAYS
- RAILWAYS
- POWER-LINES
- MARSH OR MUSKEG
- MINES
- CANCELLED

- C.S.
- L.O.
- M.R.O.
- S.R.O.

## NOTES

400' surface rights reservation around  
the shores of all lakes and rivers


Flooding rights to elevation III on  
Onaping Lake (L.O. 913) - File 9214

\* IN SERVICE 1981

PLAN NO. M-1077


ONTARIO  
MINISTRY OF NATURAL RESOURCES  
SURVEYS AND MAPPING BRANCH

## DUNBAR TWP. M.768

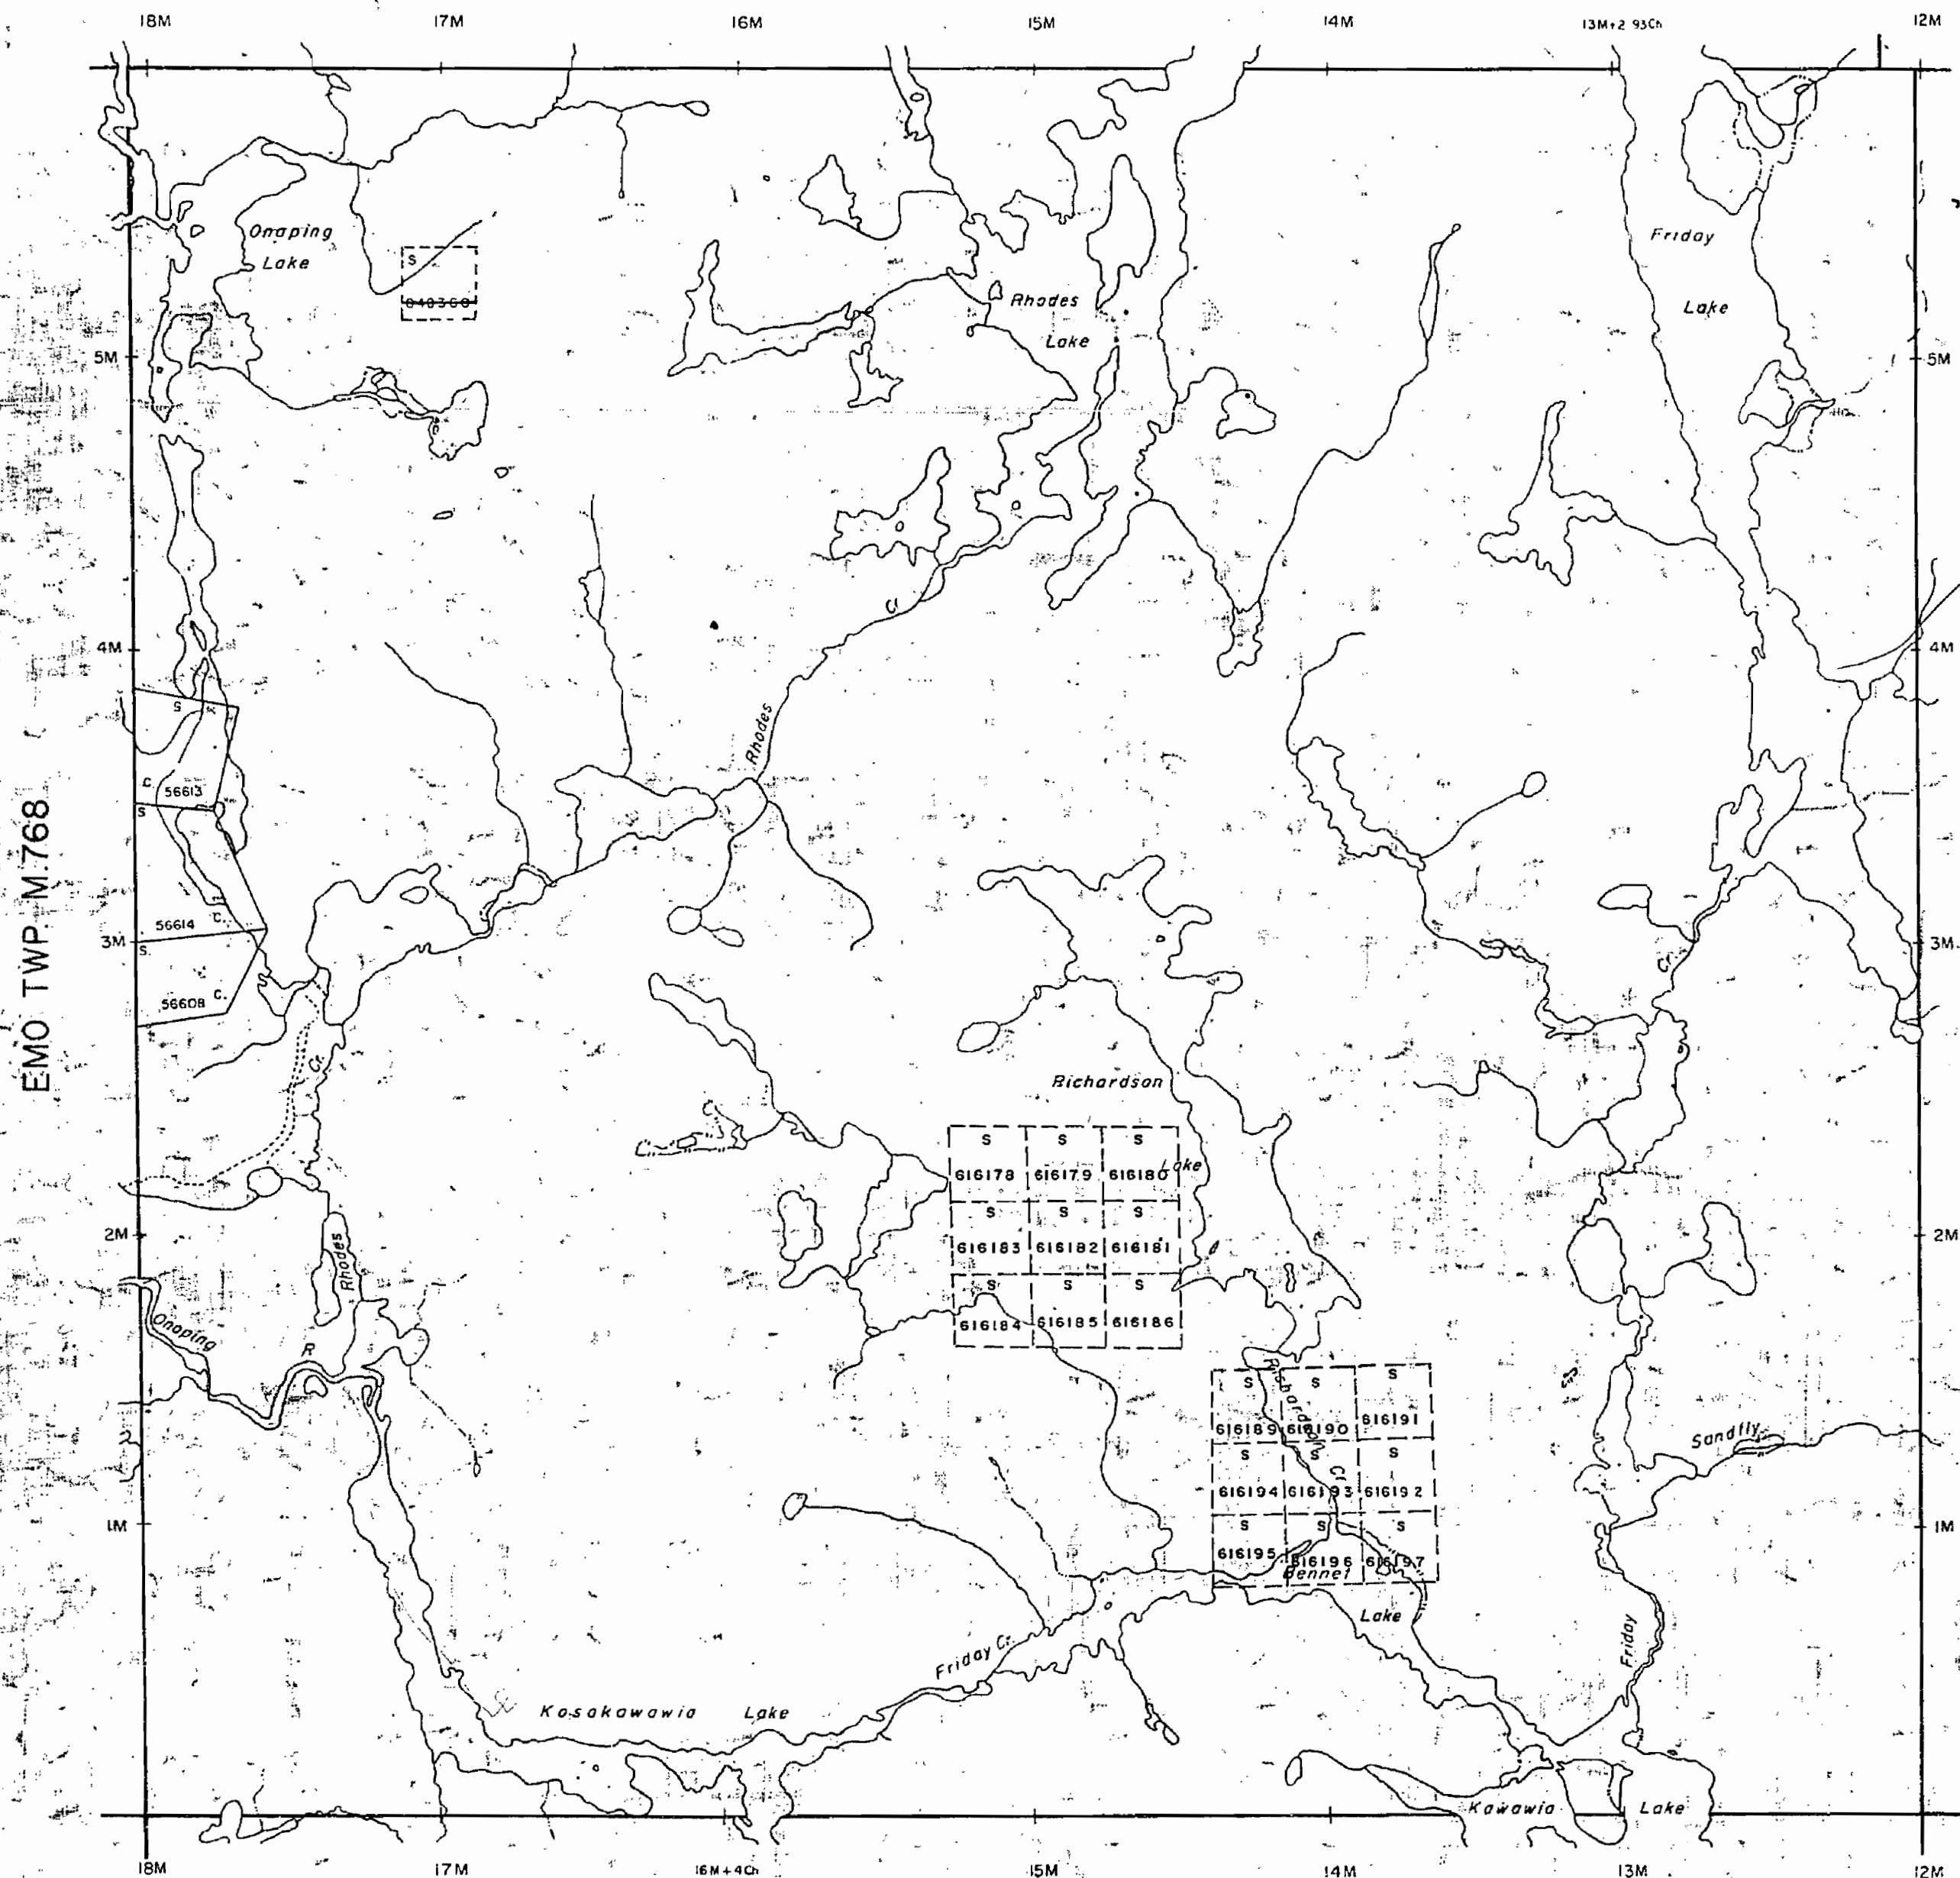

## LEINSTER TWP. M.985



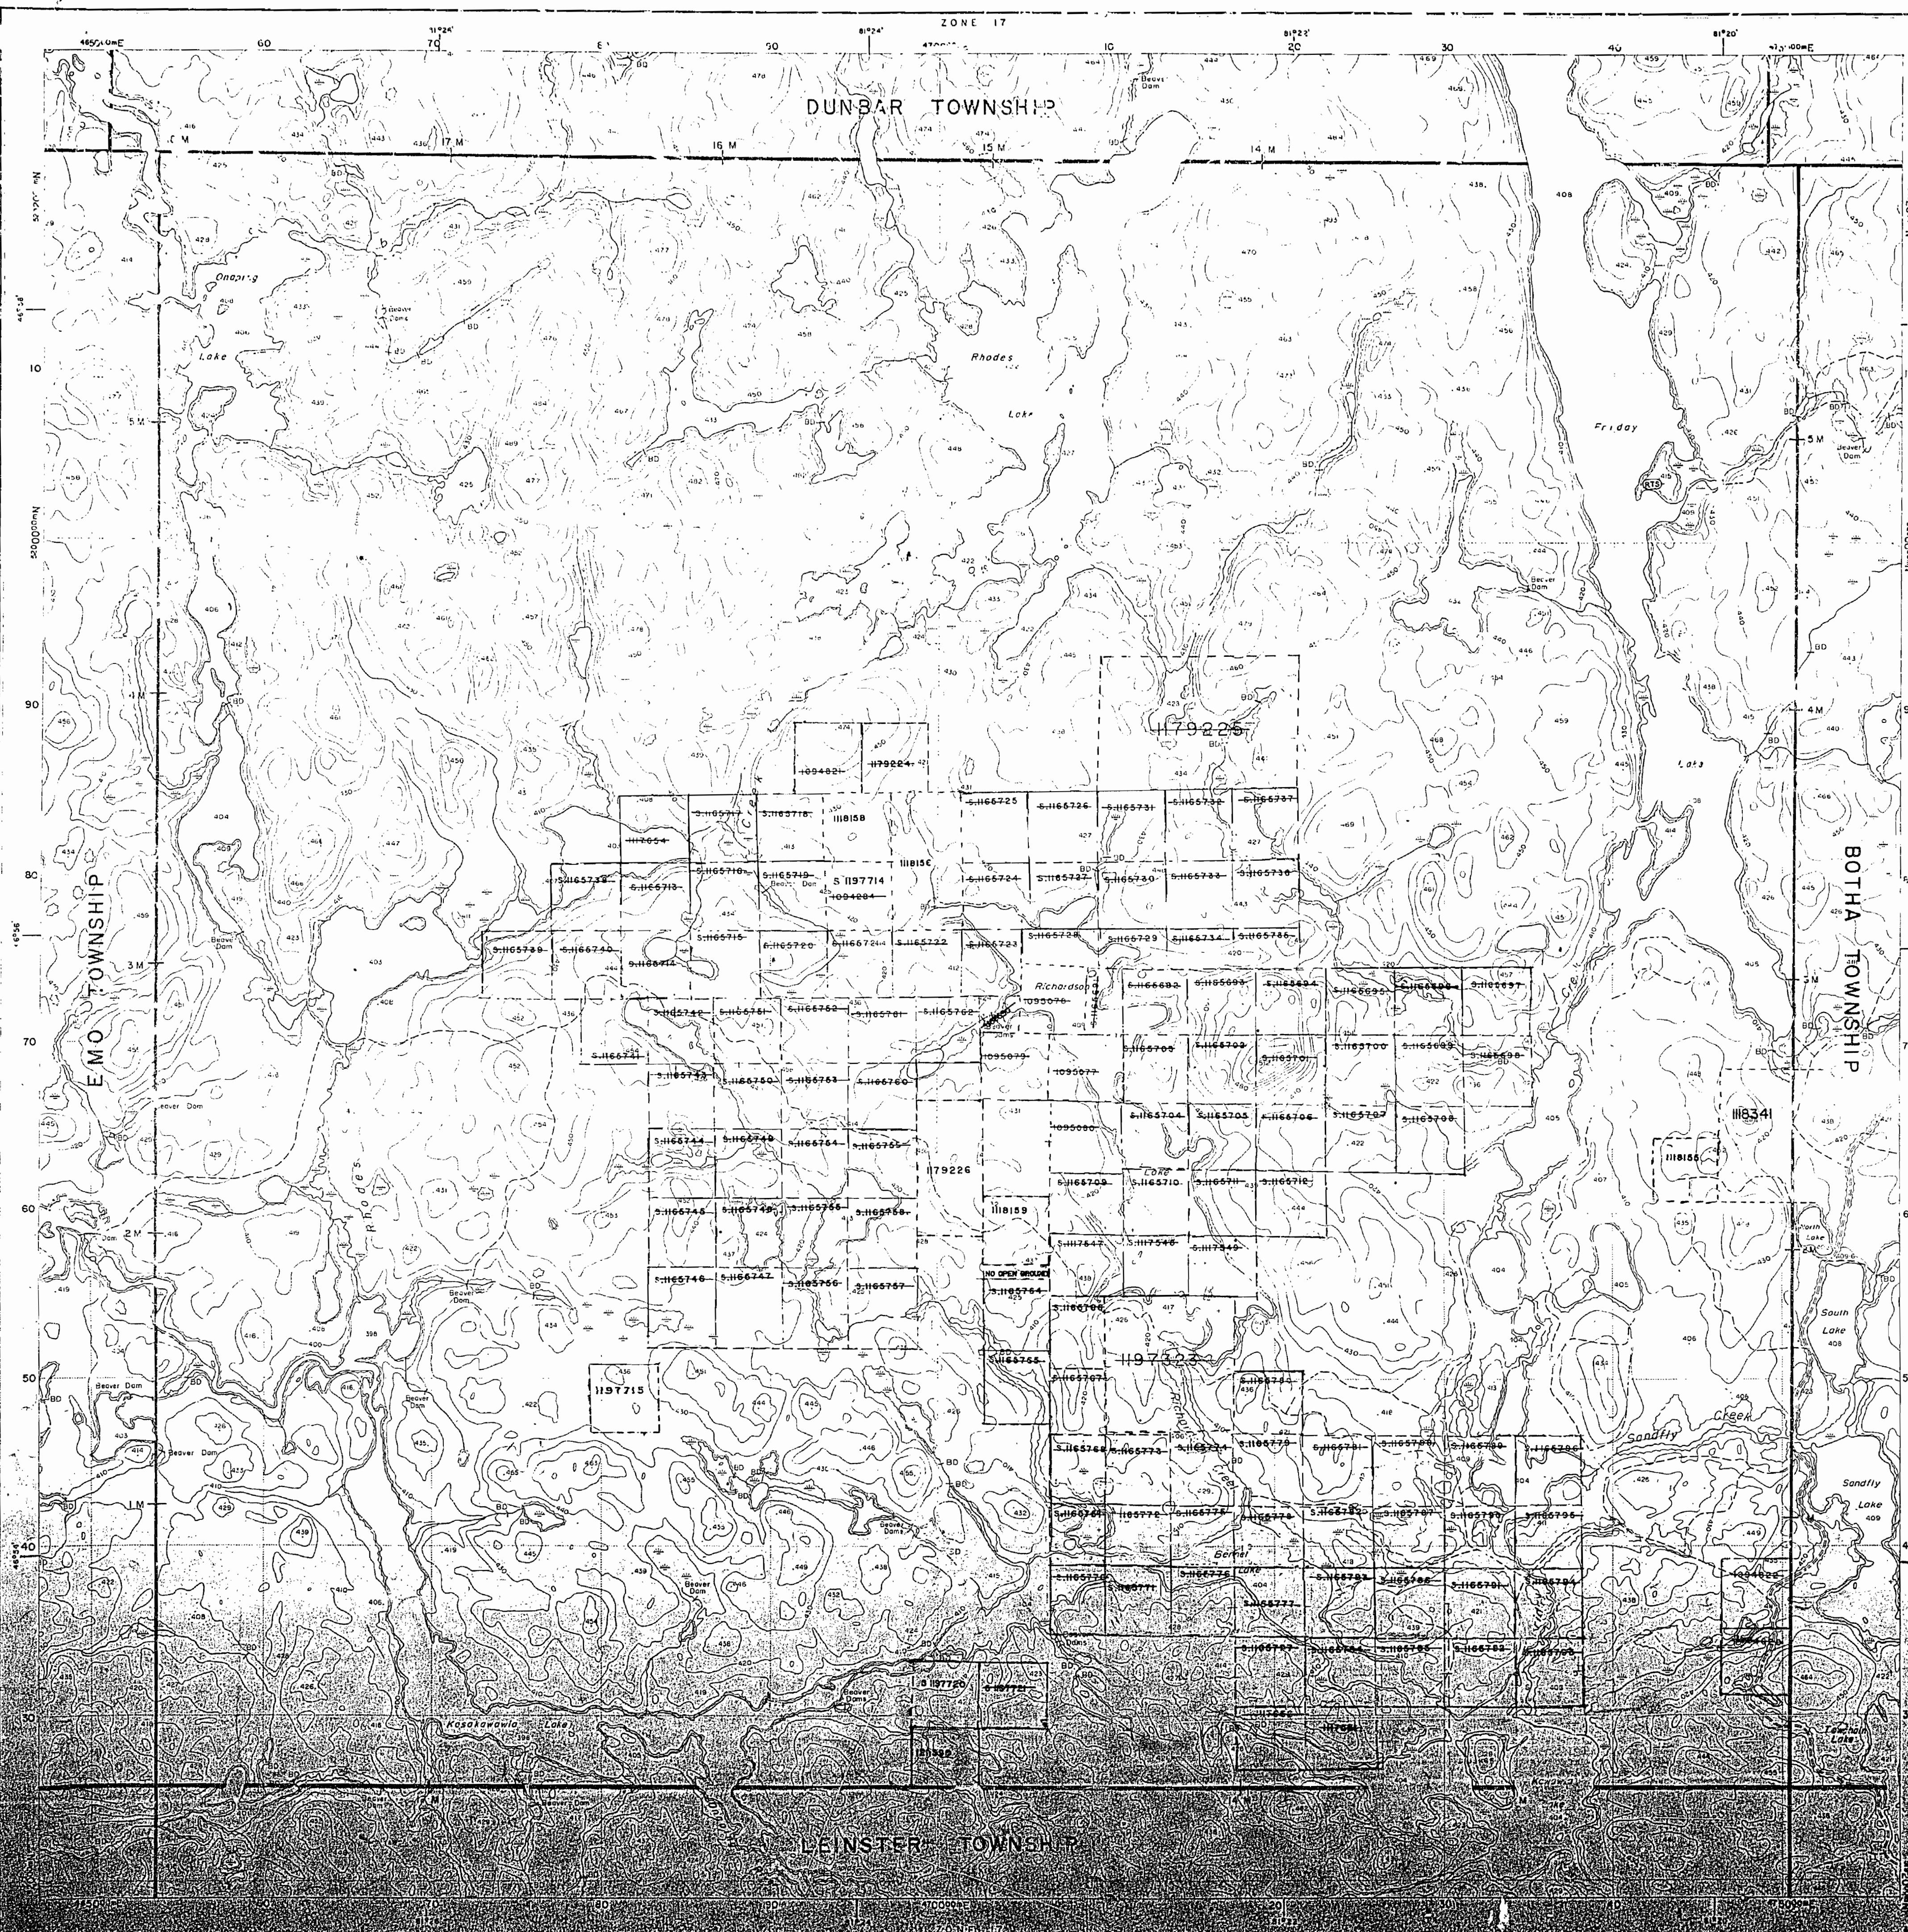

**Ministry of  
Natural  
Resources**

**Ministry of  
Northern Development  
and Mines**

In Service: March 30, 1985

## **INDEX TO LAND DISPOSITION**

P

G-4096

## TOWNSHIP

RHODES

## **I.N.R. ADMINISTRATIVE DISTRICT**

## SUDBURY

**DATE OF ISSUE**

JUN 18 1998

**PROVINCIAL RECORDING**

**OFFICE - SUDBURY**

Scale 1:20 000

Metres      1000      0      1000      2000      Metres

Feet      1000      0      1000      2000      3000      4000      5000      6000      7000      8000      9' 30      10000      Feet

Contour Interval 10 Metres

**AREAS WITHDRAWN FROM DISPOSITION**

- MRO - Mining Rights Only
- SRO - Surface Rights Only
- M+S - Mining and Surface Rights

Description	Order No.	Date	Disposition	File
-------------	-----------	------	-------------	------

## **SYMBOLS**

Boundary	
Township, Meridian, Baseline	.....
Road allowance; surveyed	.....
shoreline	.....
Lot/Concession; surveyed	.....
unsurveyed	.....
Parcel; surveyed	.....
unsurveyed	.....
Right-of-way; road	.....
railway	.....
utility	.....
Reservation	.....
Cliff, Pit, Pile	.....
Contour	.....
Interpolated	.....
Approximate	.....
Depression	.....
Control point (horizontal)	.....
Flooded land	.....
Mine head frame	.....
Pipeline (above ground)	.....
Railway; single track	.....
double track	.....
abandoned	.....
Road; highway, county, township	.....
access	.....
trail, bush	.....
Shoreline (original)	.....
Transmission line	.....
Wooded area	.....


## NOTES

THE INFORMATION THAT  
APPEARS ON THIS MAP  
HAS BEEN COMPILED  
FROM VARIOUS SOURCES,  
AND ACCURACY IS NOT  
GUARANTEED. THOSE  
WISHING TO STAKE MIN-  
ING CLAIMS SHOULD CONS-  
ULT WITH THE MINING  
REGISTRAR, MINISTRY OF  
NORTHERN DEVELOP-  
MENT AND MINES, FOR AD-  
DITIONAL INFORMATION  
ON THE STATUS OF THE  
LANDS SHOWN HEREON.

## **DISPOSITION OF CROWN LANDS**

- Patent
  - Surface & Mining Rights .....
  - Surface Rights Only .....
  - Mining Rights Only.....
- + Lease
  - Surface & Mining Rights .....
  - Surface Rights Only .....
  - Mining Rights Only.....
- + Licence of Occupation .....
- + Order-in-Council.....
- + Cancelled .....
- + Reservation .....
- + Sand & Gravel .....

DATE OF ISSUE  
MAR 30 1988  
SUBURB  
MING RECORDER'S OFFICE

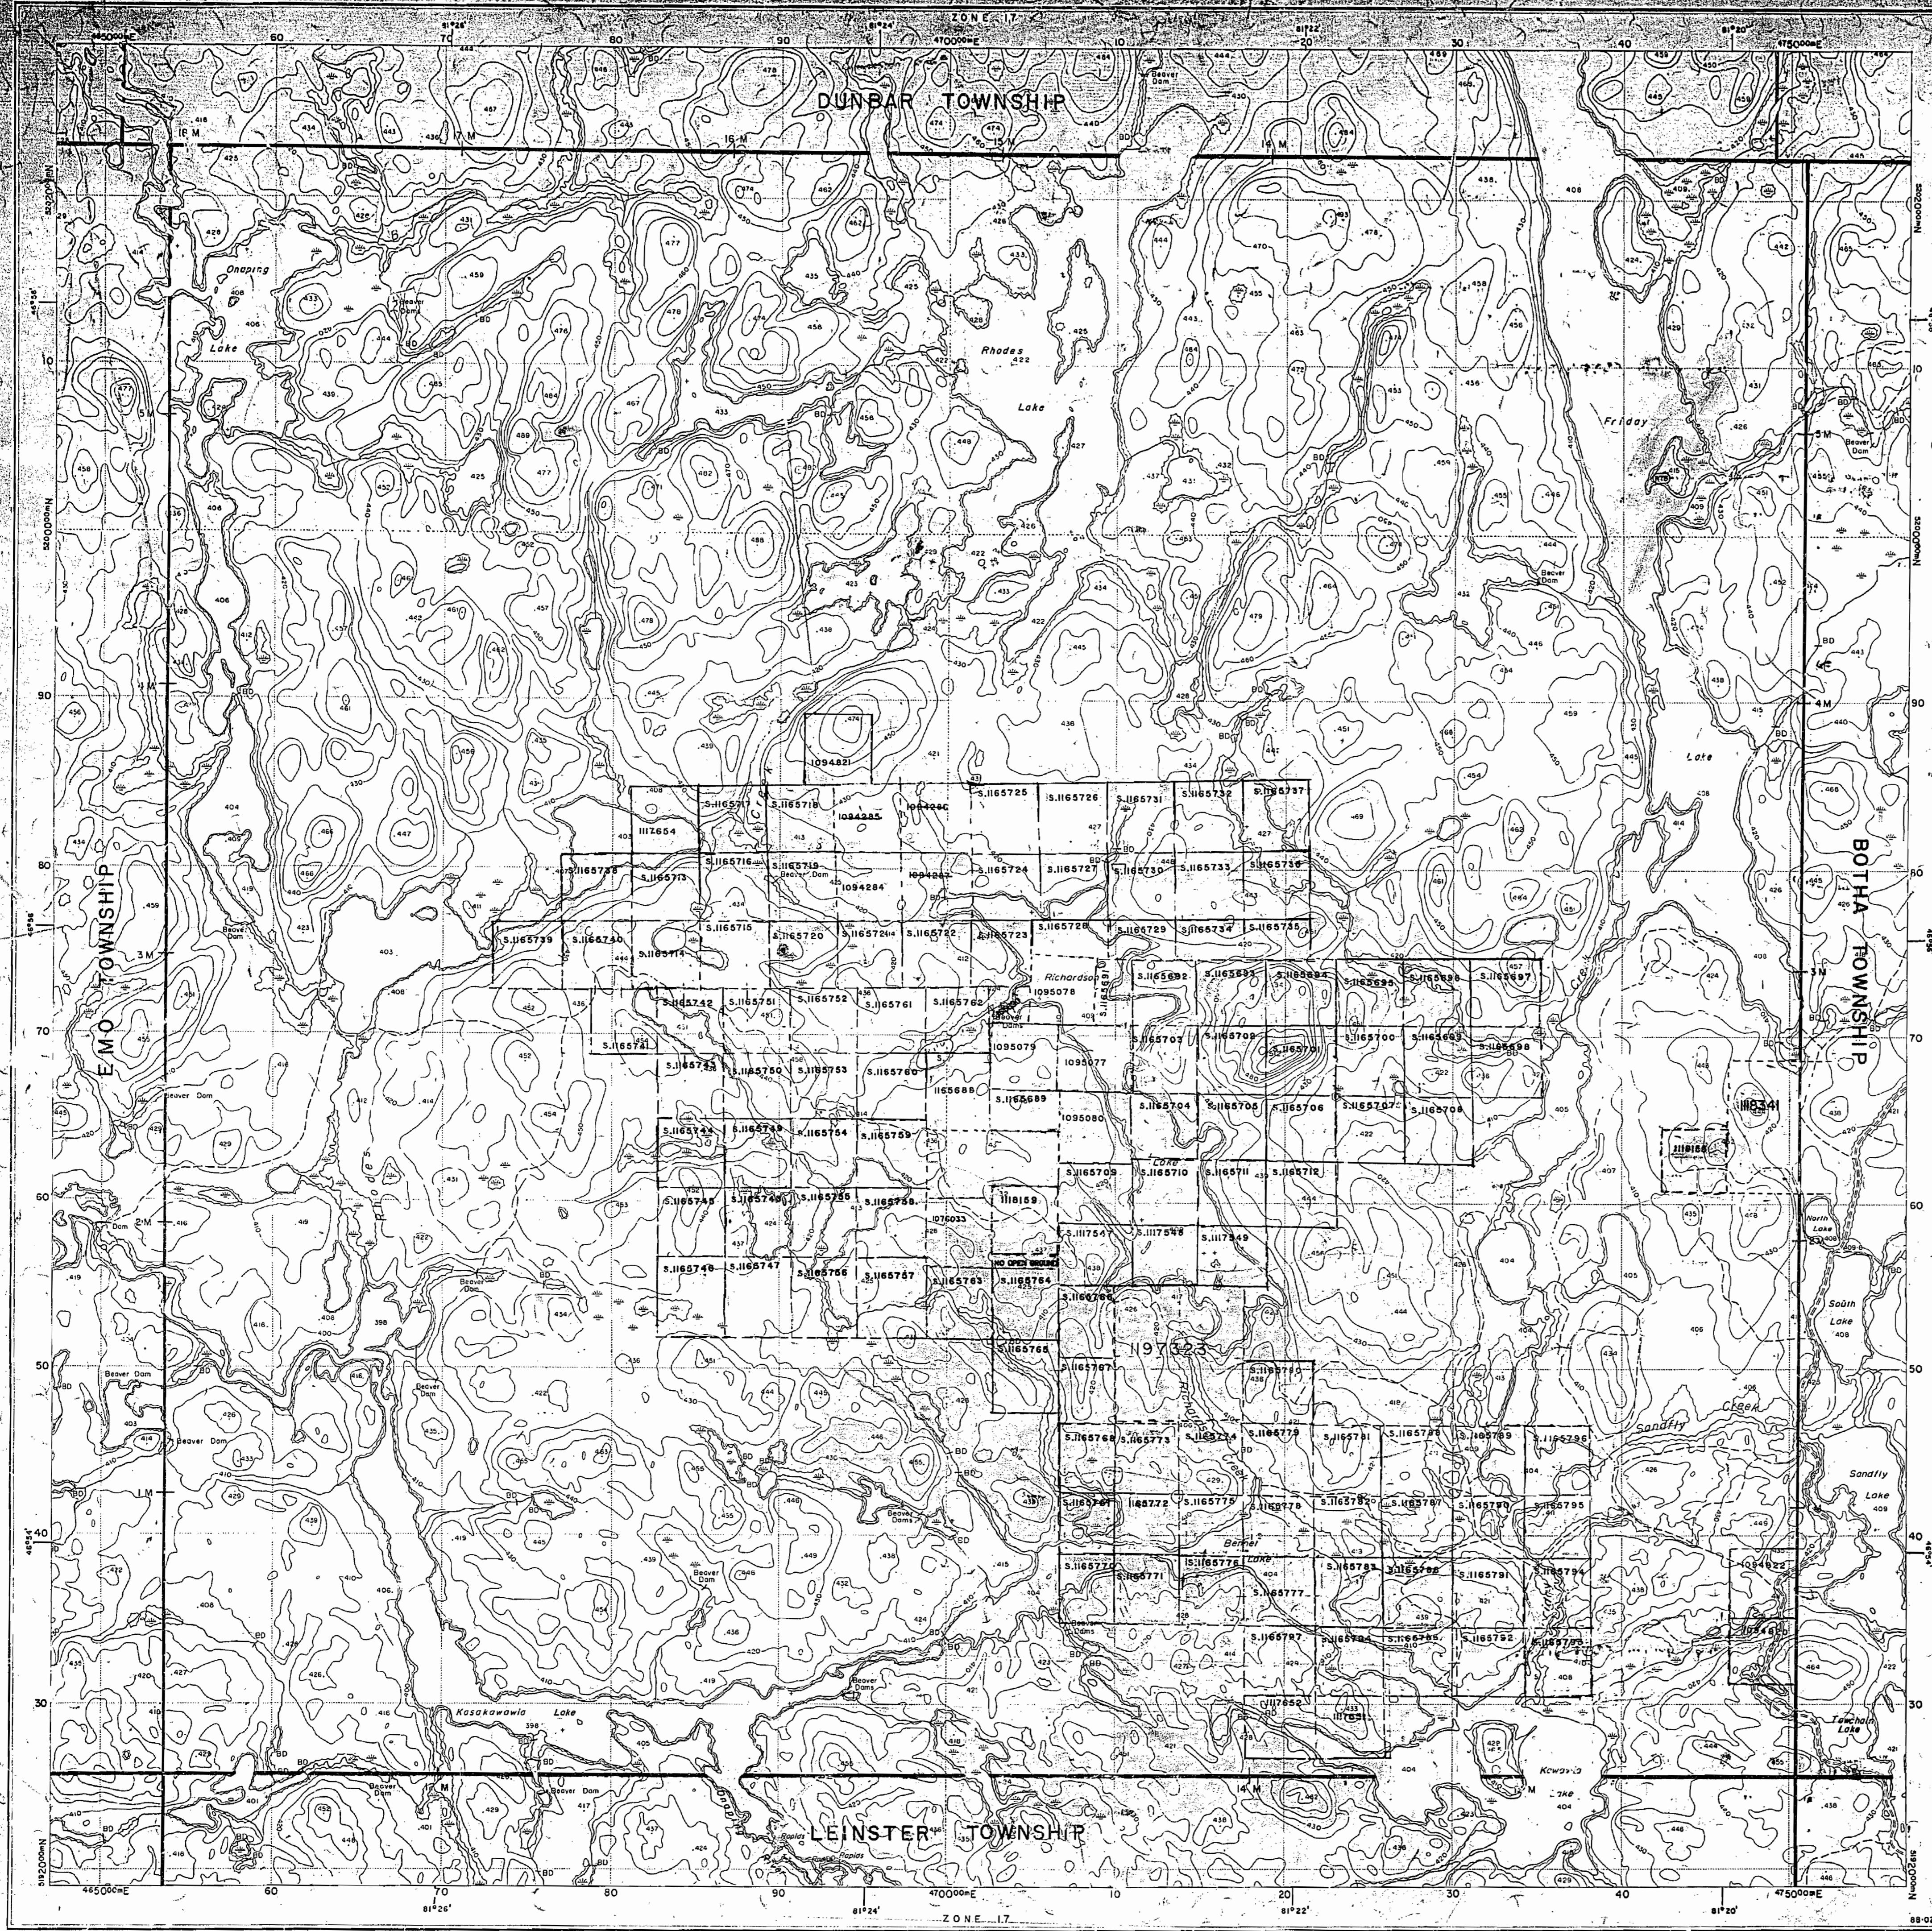

**Ministry of  
Natural  
Resources**

**Ministry of  
Northern Development  
and Mines**

To Service: March 30, 1984

# **INDEX TO LAND DISPOSITION**

PLA

G-4096

TOWNSHIP

# RHODES

Scale 1:20 000

Metres      0      1000      2000      3000      Metres

1000      0      1000      2000      3000      4000      5000      6000      7000      8000      9000      10000      Feet

Contour Interval 10 Metres

**DATE OF ISSUE**

MAY 13 1994

SUNBURY

## **SYMBOLS**

- |                                      |  |
|--------------------------------------|--|
| Boundary                             |  |
| Township, Meridian, Baseline.....    |  |
| Road allowance; surveyed.....        |  |
| shoreline.....                       |  |
| Lot/Concession; surveyed.....        |  |
| unsurveyed.....                      |  |
| Parcel; surveyed.....                |  |
| unsurveyed.....                      |  |
| Right-of-way; road.....              |  |
| railway.....                         |  |
| utility.....                         |  |
| Reservation.....                     |  |
| Cliff, Pit, Pile.....                |  |
| Contour.....                         |  |
| Interpolated.....                    |  |
| Approximate.....                     |  |
| Depression.....                      |  |
| Control point (horizontal).....      |  |
| Flooded land.....                    |  |
| Mine head frame.....                 |  |
| Pipeline (above ground).....         |  |
| Railway; single track.....           |  |
| double track.....                    |  |
| abandoned.....                       |  |
| Road; highway, county, township..... |  |
| access.....                          |  |
| trail, bush.....                     |  |
| Shoreline (original).....            |  |
| Transmission line.....               |  |
| Wooded area.....                     |  |

**AREAS WITHDRAWN FROM DISPOSITION**

MRO - Mining Rights Only  
SRO - Surface Rights Only

**Order No. \_\_\_\_\_ Date \_\_\_\_\_ Description \_\_\_\_\_ Place/Location \_\_\_\_\_ File \_\_\_\_\_**

**Prescription**      **Order No.**      **Date**      **Disposition**      **File**

## NOTES

Flooding rights to elevation 111' on Onaping  
Lake (L.O. 9839) - File 9214.

THE INFORMATION THAT APPEARS ON THIS MAP HAS BEEN COMPILED FROM VARIOUS SOURCES, AND ACCURACY IS NOT GUARANTEED. THOSE WISHING TO STAKE MINING CLAIMS SHOULD CONSULT WITH THE MINING RECORDER, MINISTRY OF NORTHERN DEVELOPMENT AND MINES, FOR ADDITIONAL INFORMATION ON THE STATUS OF THE LANDS SHOWN HEREON.

## **DISPOSITION OF CROWN LANDS**

- Patent**

  - Surface & Mining Rights .....
  - Surface Rights Only .....
  - Mining Rights Only .....

**Lease**

  - Surface & Mining Rights .....
  - Surface Rights Only .....
  - Mining Rights Only .....

**Licence of Occupation** .....

**Order-in-Council** .....

**Cancelled** .....


**Reservation** .....

**Sand & Gravel** .....

DATE OF ISSUE  
MAR 30 1988  
SUDBURY  
MINING RECORDER'S OFFICE

Map base and land disposition drafting by Surveys and Mapping Branch, Ministry of Natural Resources.

The disposition of land, location of lot fabric and parcel boundaries on this index was compiled for administrative purposes only.

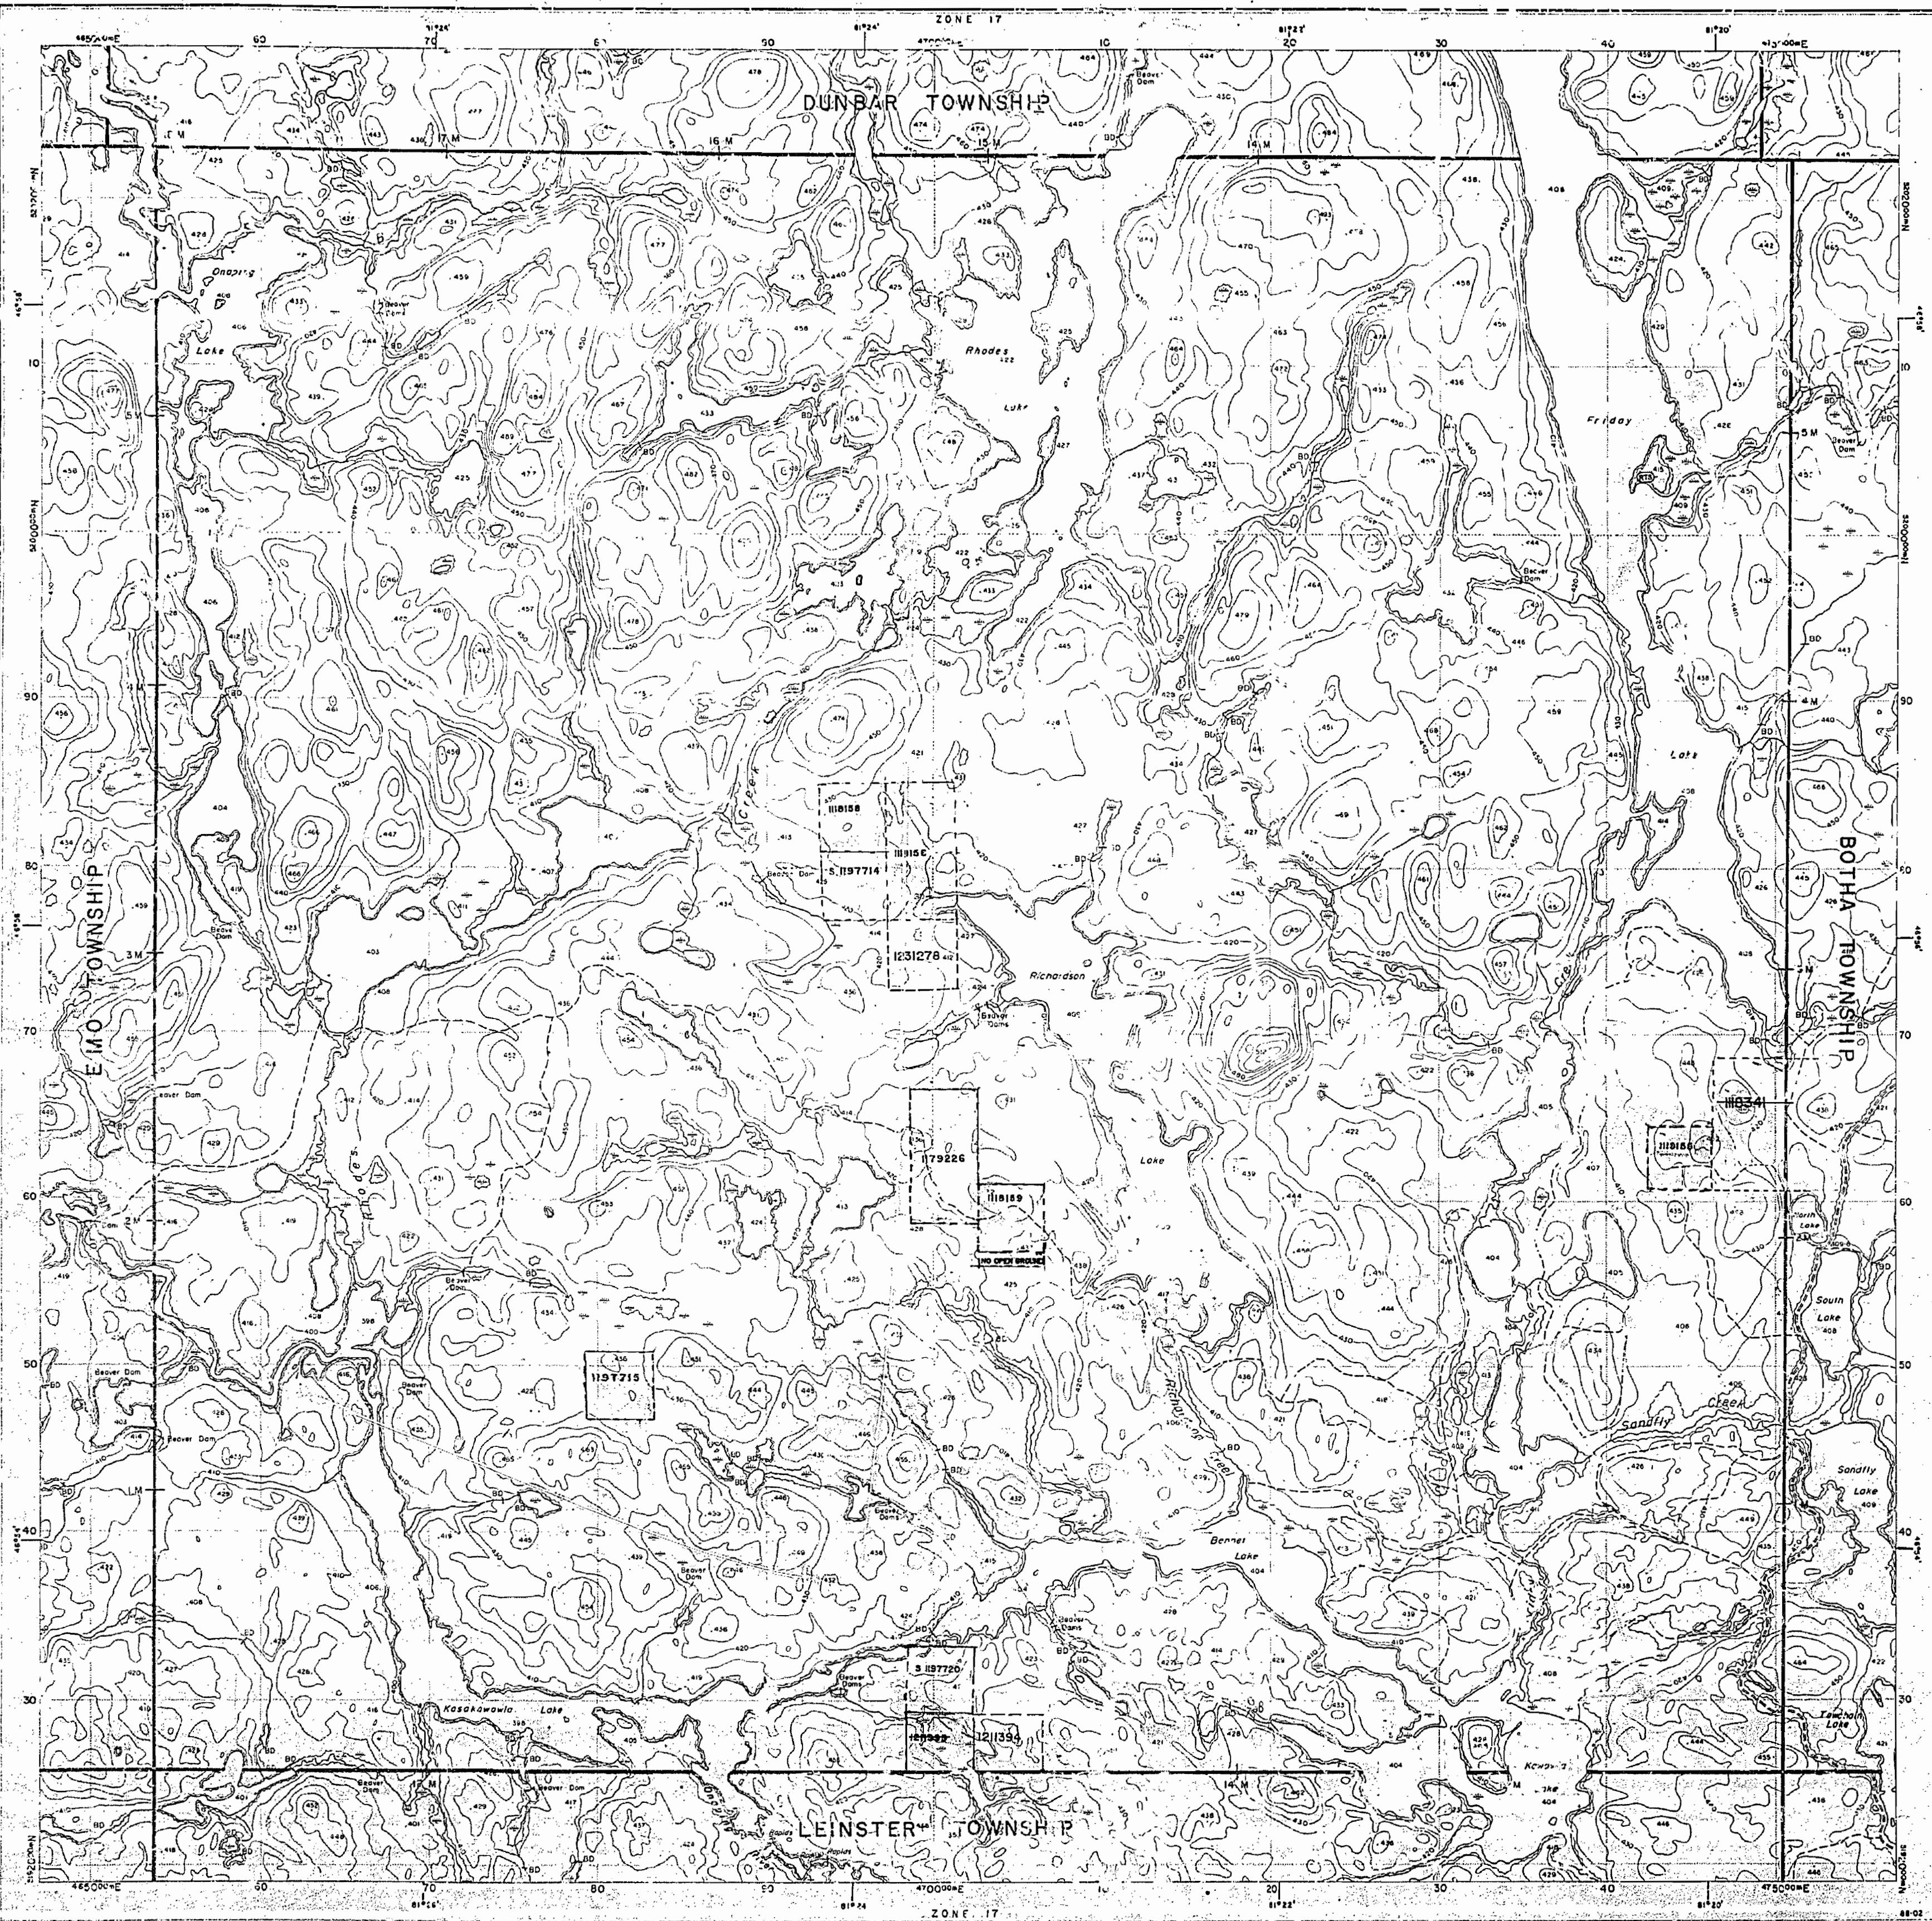

Ministry of  
Natural  
Resources  
Ontario

Ministry of  
Northern Development  
and Mines

To Service: March 30, 1988

## INDEX TO LAND DISPOSITION

PLAN

G-4096

TOWNSHIP

## RHODES

M.N.R. ADMINISTRATIVE DISTRICT

SUDSBURY

MINING DIVISION

SUDSBURY

LAND TITLES/REGISTRY DIVISION

SUDSBURY

Scale 1:20 000  
1000 2000  
Metres 0 1000 2000 Miles  
1000 2000 3000 4000 5000 6000 7000 8000 9000 10000  
Feet 0 1000 2000 3000 4000 5000 6000 7000 8000 9000 10000

Contour Interval 10 Metres

### AREAS WITHDRAWN FROM DISPOSITION:

MRO - Mining Rights Only  
SOC - Surface Rights Only  
M+S - Mining and Surface Rights

Description	Order No.	Date	Disposition	File
-------------	-----------	------	-------------	------

### SYMBOLS

Boundary	
Township, Meridian, Baseline.....	—
Road allowance; surveyed.....	—
shoreline.....	—
Lot/Concession; surveyed.....	—
unsurveyed.....	—
Parcel; surveyed.....	—
unsurveyed.....	—
Right-of-way; road.....	—
railway.....	—
utility.....	—
Reservation.....	—
Cliff, Pit, Pile.....	—
Contour.....	—
Interpolated.....	—
Approximate.....	—
Depression.....	—
Control point (horizontal).....	△
Flooded land.....	—
Mine head frame.....	□
Pipeline (above ground).....	—
Railway, singl. track.....	—
double track.....	—
abandoned.....	—
Road: highway, county, township.....	—
access.....	—
trail, bush.....	—
Shoreline (original).....	—
Transmission line.....	—
Wooded area.....	—
RTS - REMOTE TOURIST SET-UP.....	—

### NOTES

Flooding rights to elevation III' on Old Inlet Lake (L.O. 9839) - File 9214.

THE INFORMATION THAT  
HAS BEEN COMPILED  
FROM VARIOUS SOURCES  
AND ACCURACY IS NOT  
GUARANTEED. THOSE  
WISHING TO STAKE MIN-  
ING CLAIMS SHOULD CONS-  
ULT WITH THE MAPPING  
RECORDS, MINISTRY OF  
NORTHERN DEVELOP-  
MENT AND MINES, FOR AD-  
DITIONAL INFORMATION  
ON THE STATUS OF THE  
LANDS SHOWN HEREON.


### DISPOSITION OF CROWN LANDS

Patent	
Surface & Mining Rights	●
Surface Rights Only	○
Mining Rights Only	■
Lease	
Surface & Mining Rights	●
Surface Rights Only	○
Mining Rights Only	■
Licence of Occupation	▼
Ordin-In-Council	OC
Cancellation	○
Reservation	○
Sand & Gravel	○

DATE OF ISSUE  
MAR 3 1988  
SUDSBURY  
MINING RECORDER'S OFFICE

1077

## Dunbar Twp

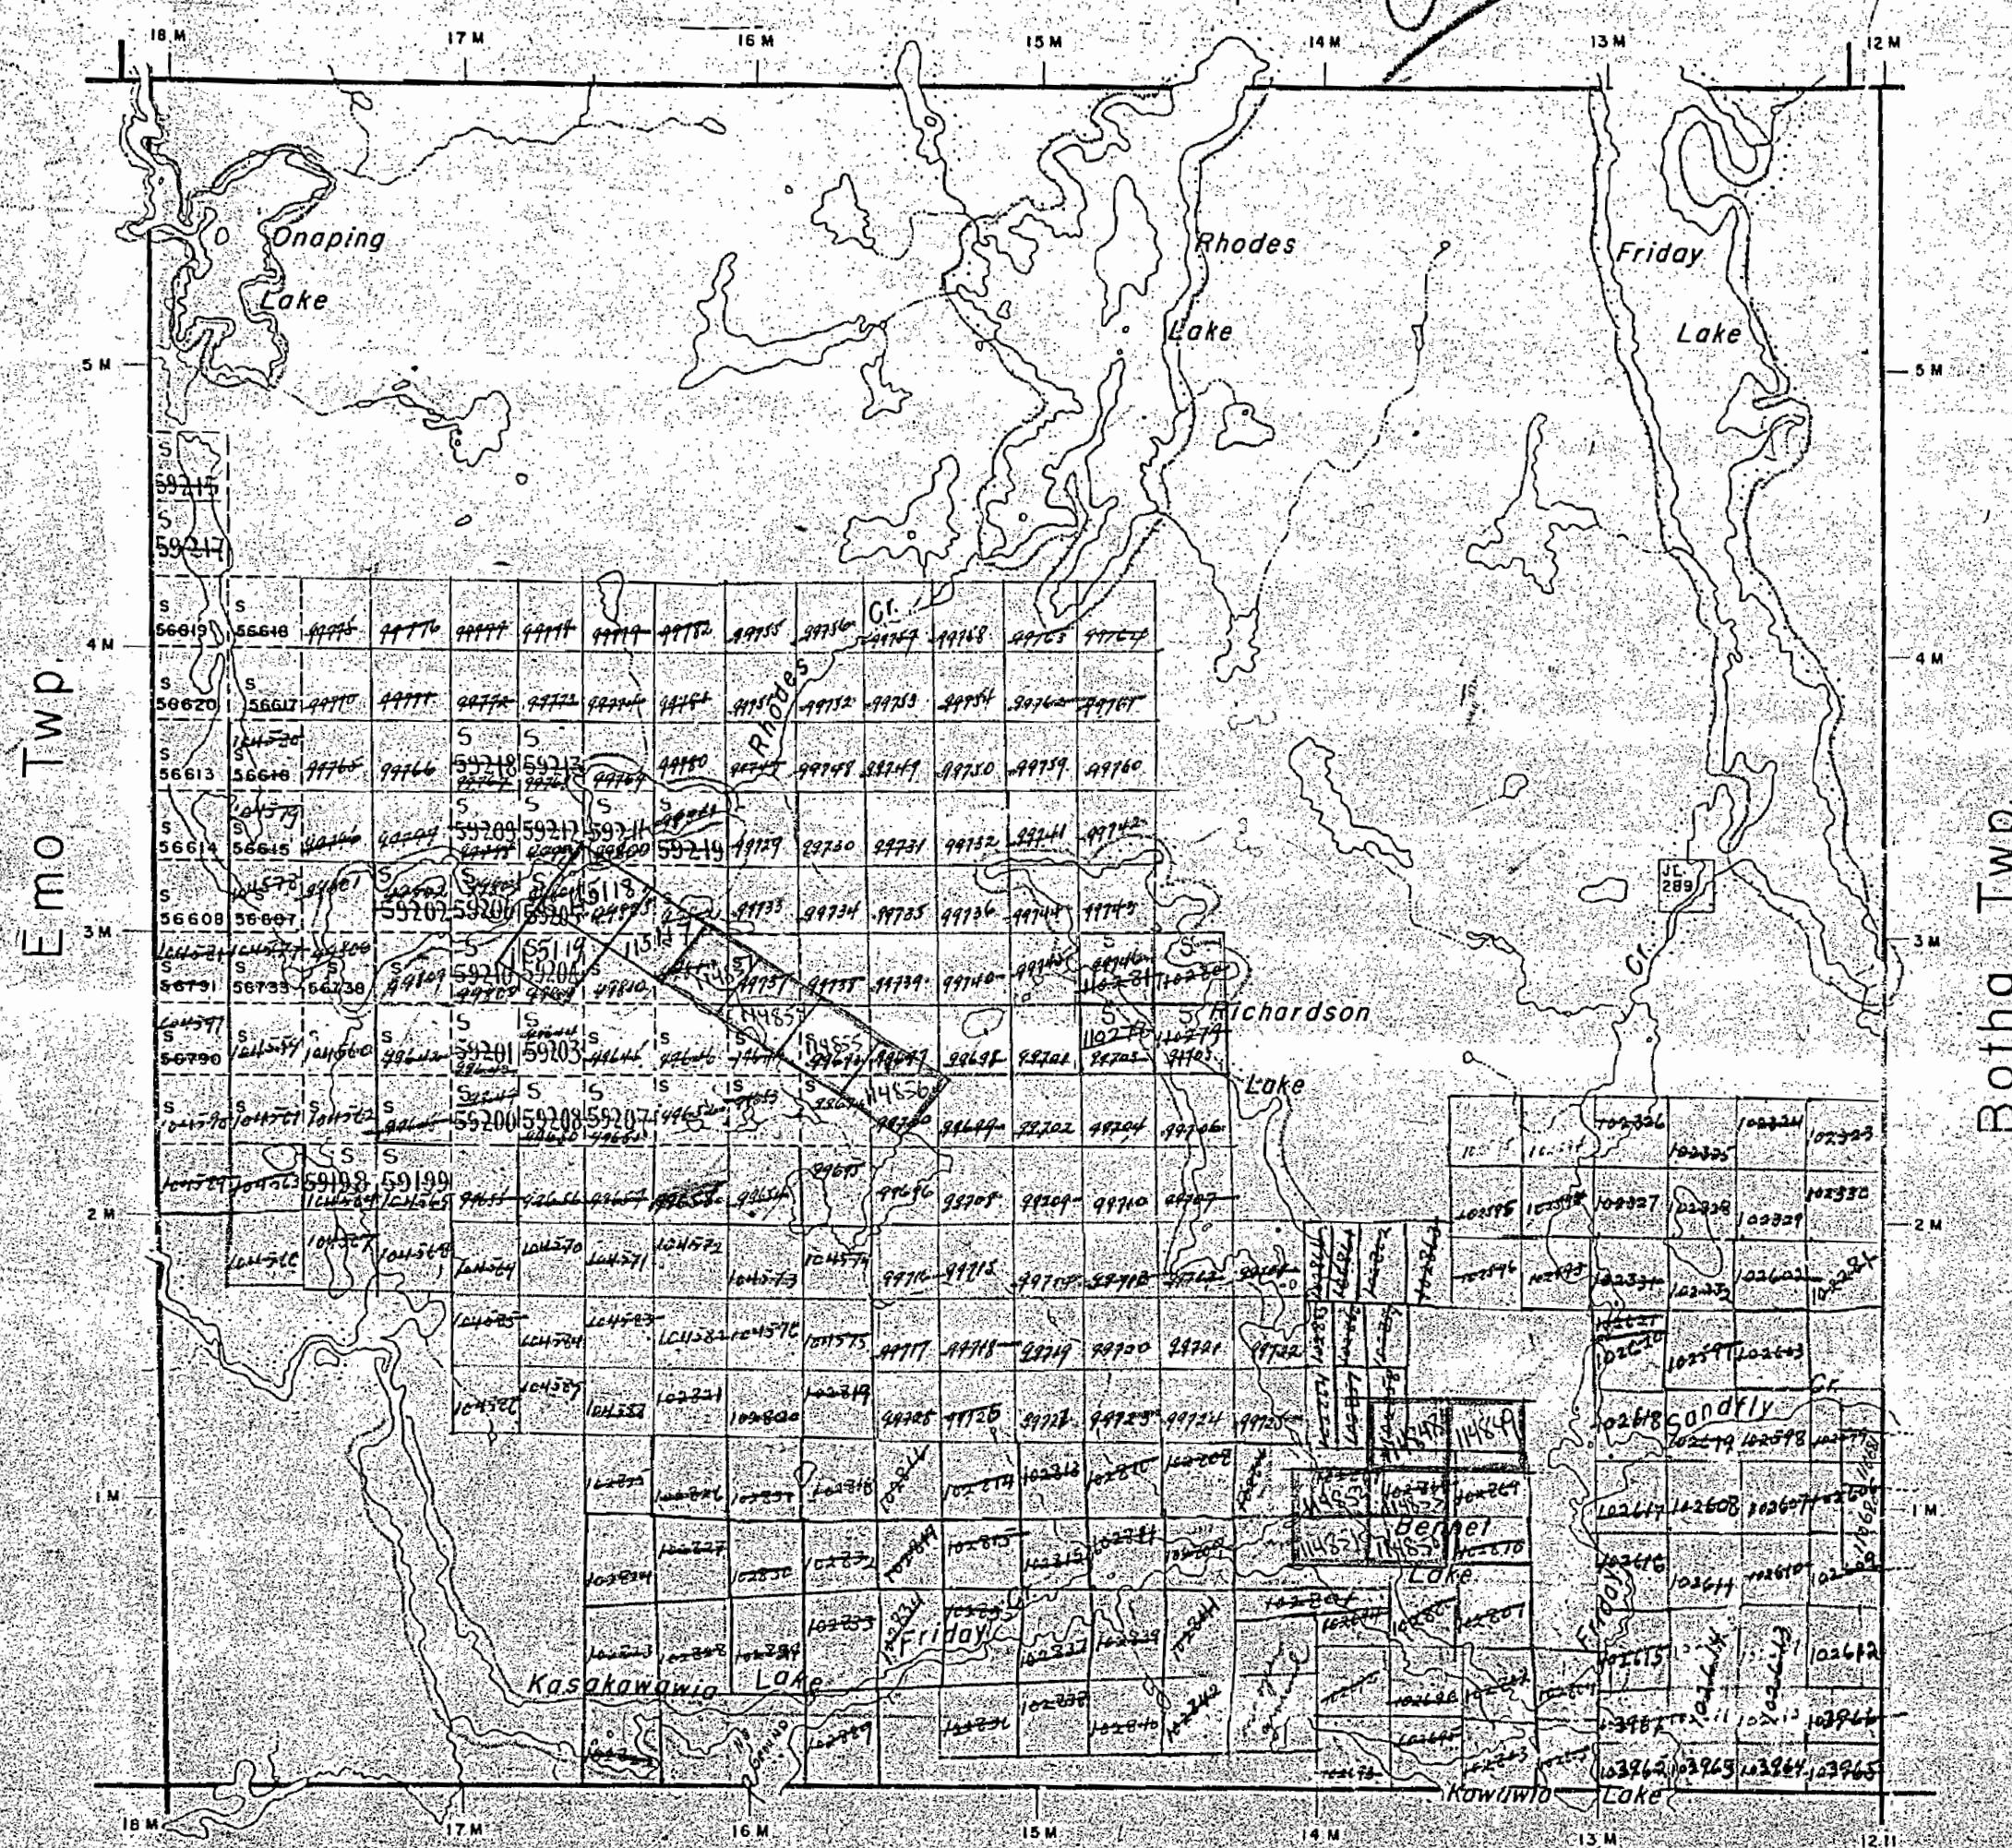

THE TOWNSHIP  
OF  
**RHODES**

DISTRICT OF  
SUDBURY  
SUDBURY  
MINING DIVISION  
ALE-LINCH-10 CHAINS

SCALE 1-INCH=40 CHAINS

## LEGEND

PATENTED LAND  
CROWN LAND SALE  
LEASES  
LOCATED LAND  
LICENSE OF OCCUPATION  
KING'S HIGHWAYS  
IMPROVED ROADS  
ROADS  
RAILWAYS  
POWER LINES  
MINES  
MARSH OR MUSKEG

## NOTES

4/40  
200' reservation to Dept. of Lands & Forests  
shown thus: \_\_\_\_\_

Flooding to elevation 111; (L.O. 6133) shown thus:


Mining Locations which have been cancelled  
have been removed from this plan under the  
Surveyor General's instructions.

~~400~~ 'R

M1077

PLAN NO.—S. 436

DEPARTMENT OF MINES  
— ONTARIO —

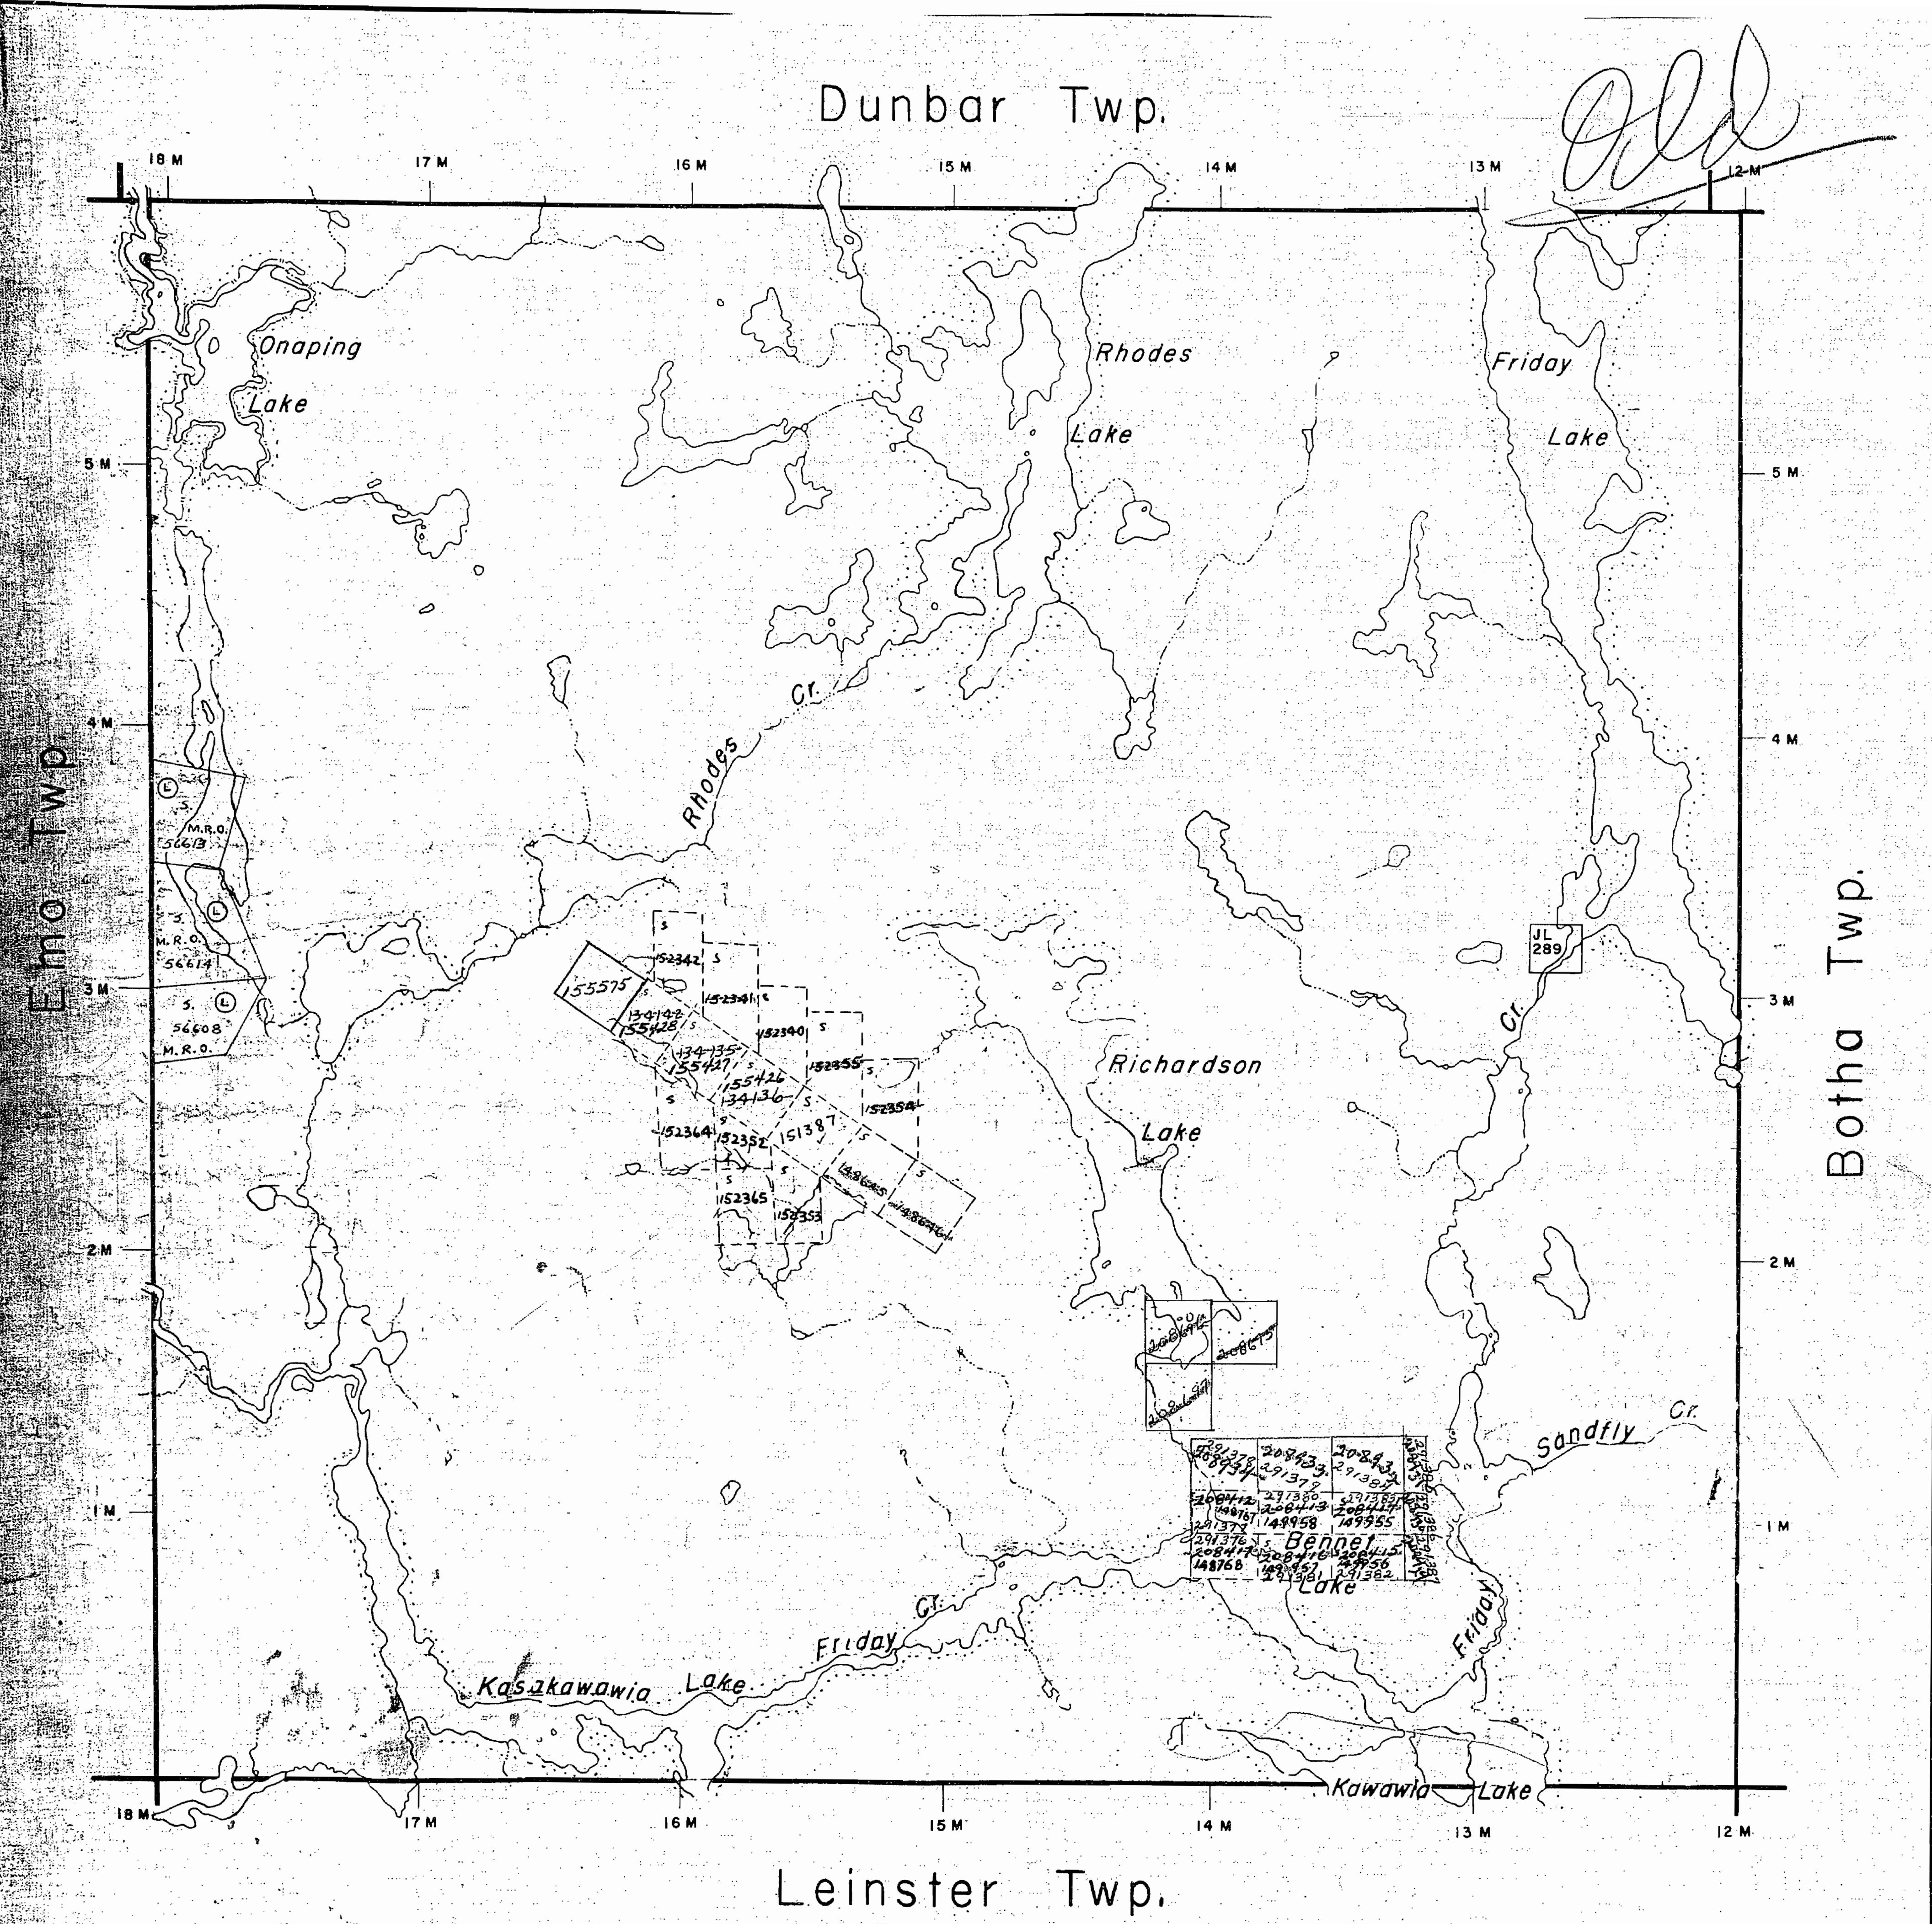

THE TOWNSHIP  
OF  
**RHODES**  
DISTRICT OF  
SUDBURY  
SUDBURY  
MINING DIVISION  
ONE INCH=40 CHAIN

## **LEGEND**

PATENTED LAND  
CROWN LAND SALE  
LEASES  
LOCATED LAND  
LICENSE OF OCCUPATION  
KING'S HIGHWAYS  
IMPROVED ROADS  
ROADS  
RAILWAYS  
POWER LINES  
MINES  
MARSH OR MUSKEG

(P)  
C.S.  
(L)  
LOC.  
L.O.



## NOTES

400' surface rights reservation around all lakes & rivers.


Flooding to elevation 111, (L.O. 6133) shown thus:

Mining Locations which have been cancelled  
have been removed from this plan under the  
Surveyor General's instructions.

PLAN NO - M-1077

# DEPARTMENT OF MINES —ONTARIO—

Dunbar Twp.

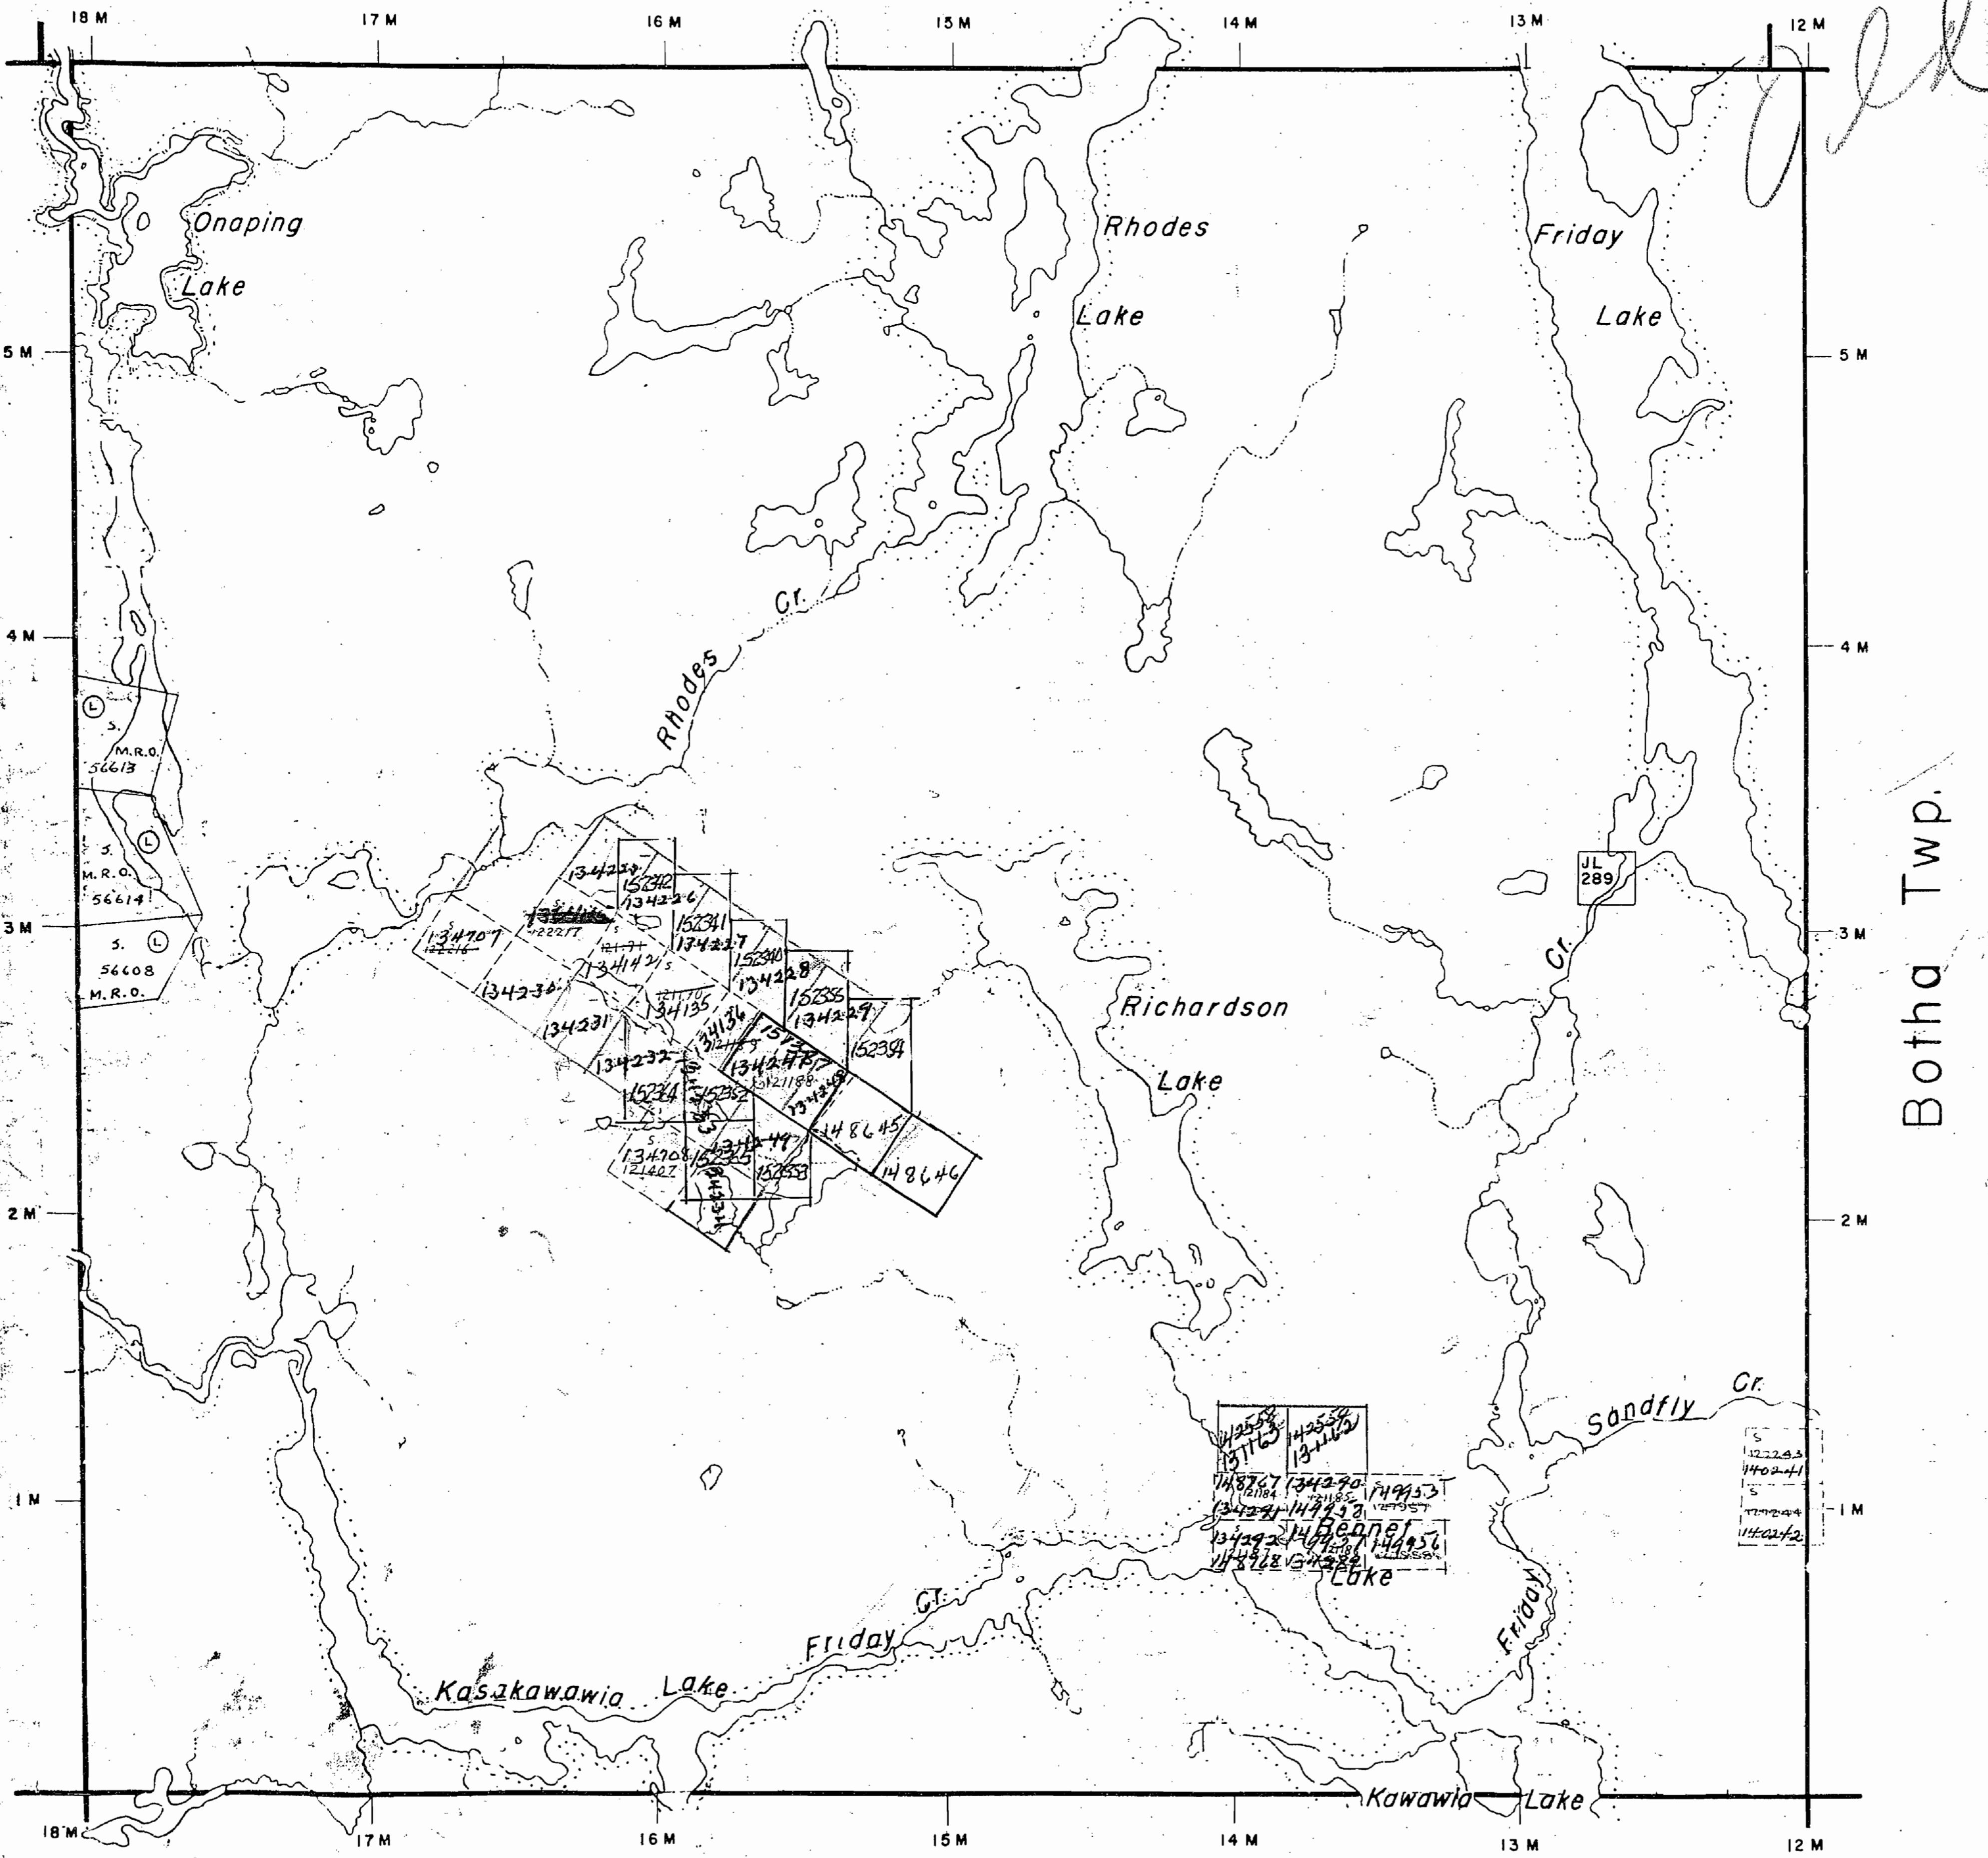




# THE TOWNSHIP OF RHODES

DISTRICT OF  
SUDBURY

# SUDBURY MINING DIVISION

SCALE: 1-INCH = 40 CHAINS

LEGEND

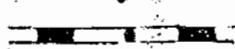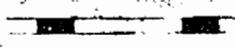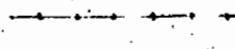- |                       |   |
|-----------------------|---|
| PATENTED LAND         | (P)   |
| CROWN LAND SALE       | C.S.  |
| LEASES                | (L)   |
| LOCATED LAND          | Loc.  |
| LICENSE OF OCCUPATION | L.O.  |
| KING'S HIGHWAYS       |  |
| IMPROVED ROADS        |  |
| ROADS                 |  |
| RAILWAYS              |  |
| POWER LINES           |  |
| MINES                 |  |
| MARSH OR MUSKEG       |   |

## NOTES

400' surface rights reservation around all lakes & rivers.

Flooding to elevation 11', (L.O. 6133) shown  
thus:

Mining Locations which have been cancelled  
have been removed from this plan under the  
Surveyor General's instructions.

July 30/08

PLAN NO.- M-1077

**DEPARTMENT OF MINES  
— ONTARIO —**

Dunbar Twp.

EMO Twp.

Leinster Twp.

THE TOWNSHIP  
OF  
**RHODES**  
DISTRICT OF  
SUDBURY  
SUDBURY  
MINING DIVISION  
SCALE 1-INCH=40 CHAINS

LEGEND

(P)	PATENTED LAND
(C.S.)	CROWN LAND SALE
(L)	LEASES
(Loc.)	LOCATED LAND
(L.O.)	LICENSE OF OCCUPATION
(K.H.)	KING'S HIGHWAYS
(I.R.)	IMPROVED ROADS
(R.)	ROADS
(R.W.)	RAILWAYS
(P.L.)	POWER LINES
(M.)	MINES
(M.M.)	MARSH OR MUSKEG

NOTES

200' reservation to Dept. of Lands & Forests shown thus:

Flooding to elevation 111', (L.O. 6133) shown thus:

Mining Locations which have been cancelled have been removed from this plan under the Surveyor General's instructions.

= 400' R.


M1077

PLAN NO.-S. 436


DEPARTMENT OF MINES  
ONTARIO

*PLAN OF*  
**RHODES TWP.**

— SCALE, 40 CHAINS TO AN INCH. —

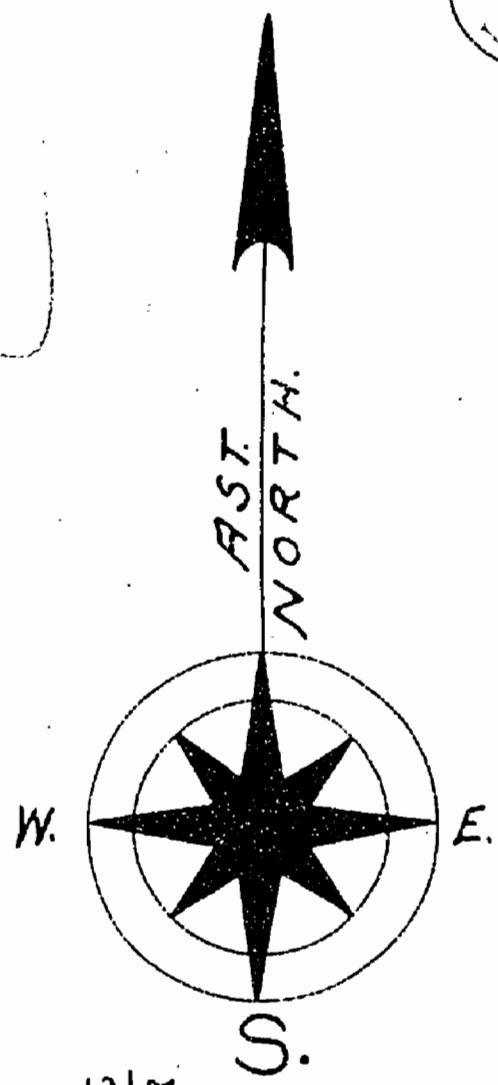

DUNBAR - TWP.

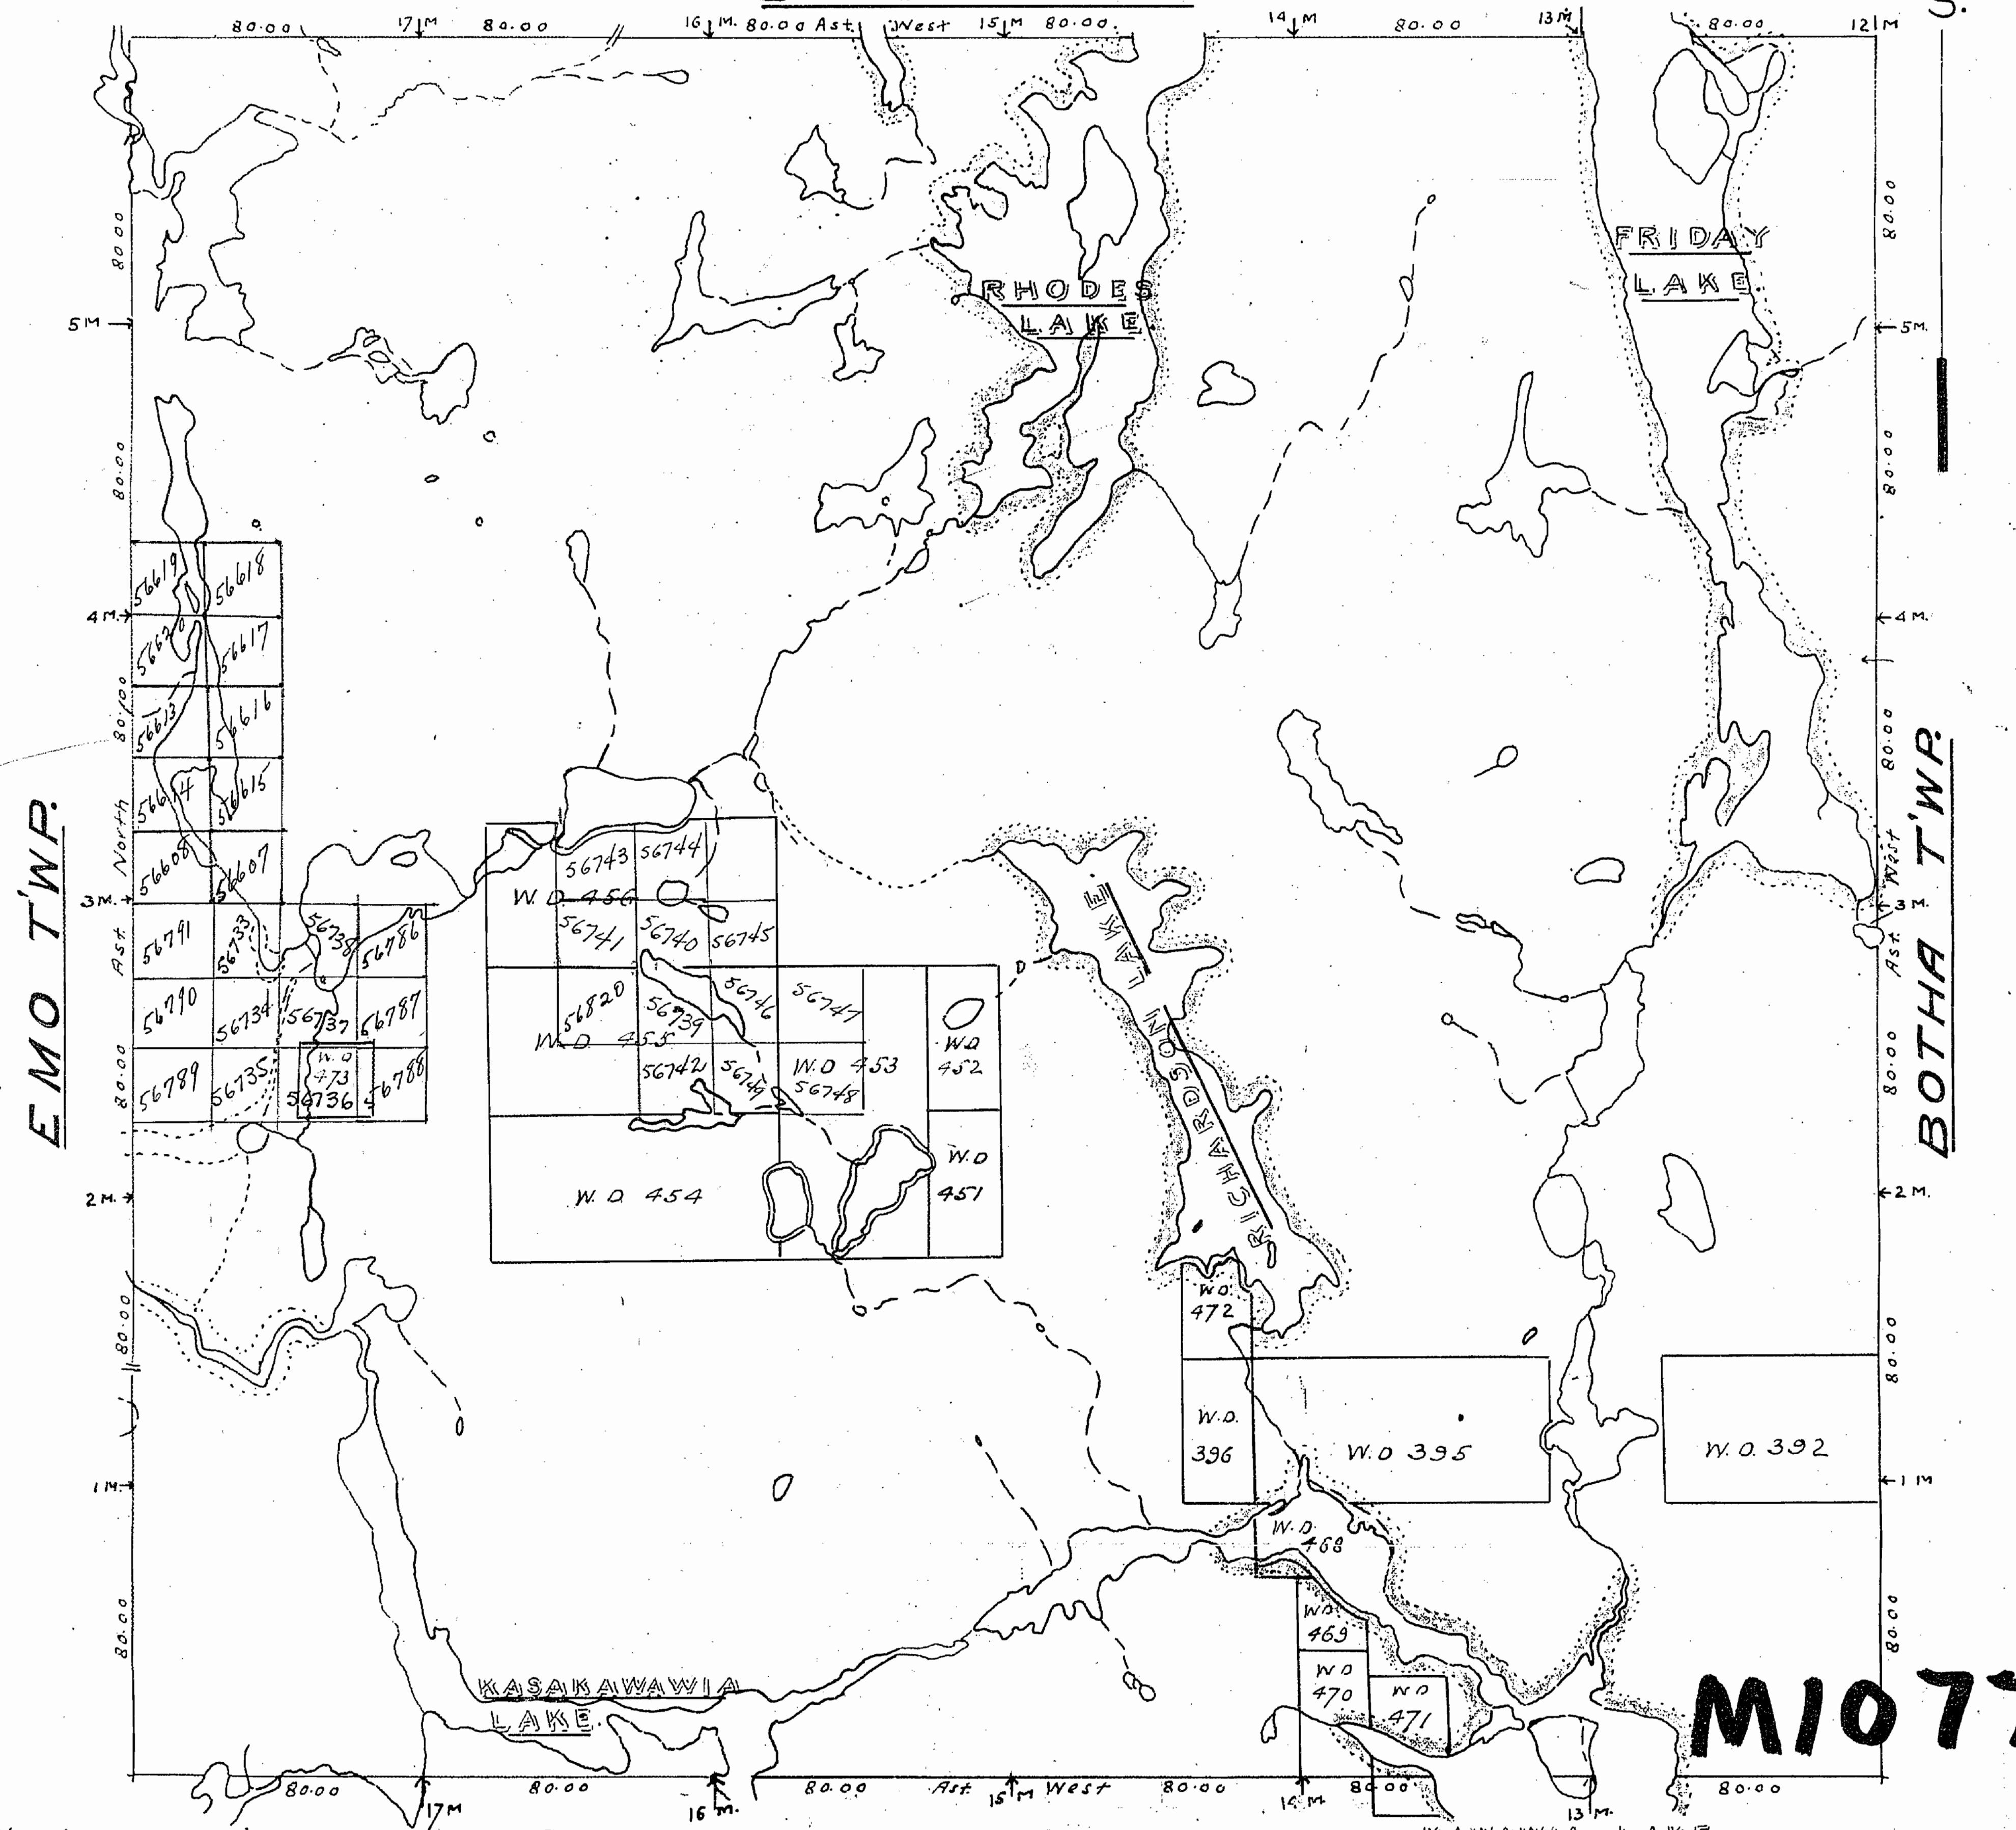


200' wide reservations on surface by Dept. of L. & F.  
shown hereon thus XXXXXXXXXX

# LEINSTER TWP.

M1077

# Dunbar Twp.

EMOTWON

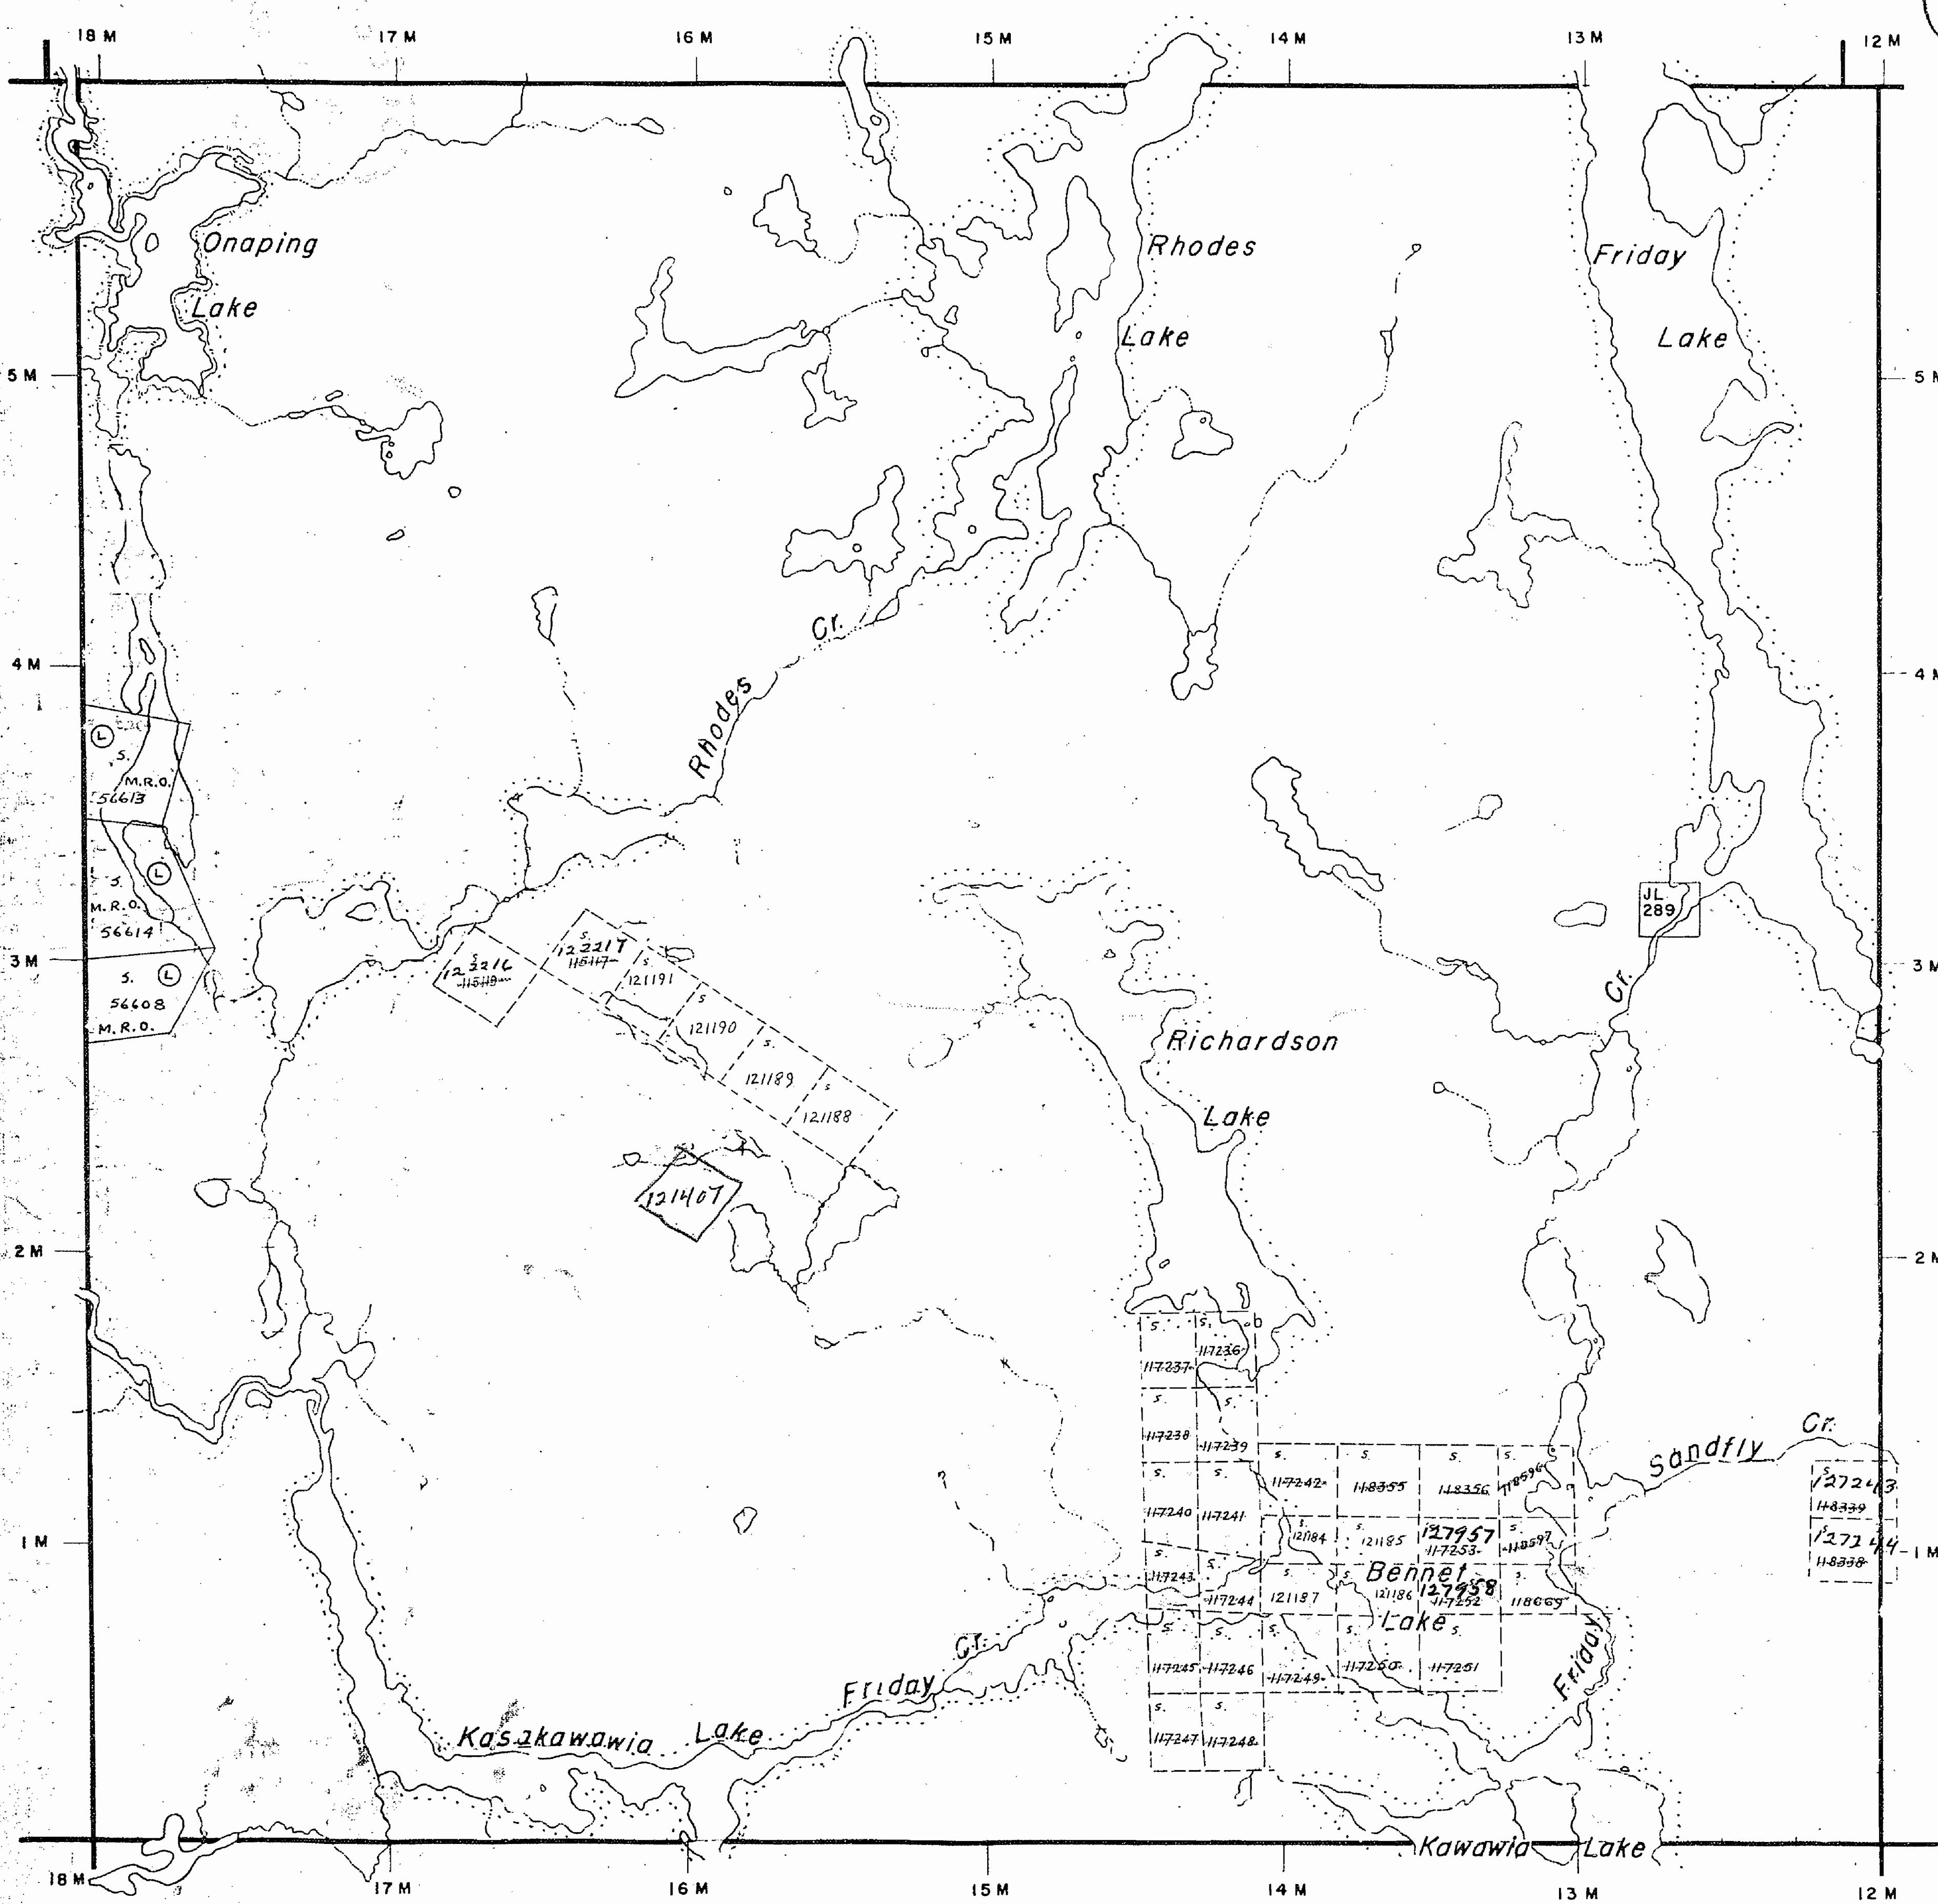

Leinster Twp.

# THE TOWNSHIP OF RHODES

# DISTRICT OF SUDBURY

# SUDBURY MINING DIVISION

SCALE: 1-INCH = 40 CHAINS

## LEGEND

PATENTED LAND  
CROWN LAND SALE  
LEASES  
LOCATED LAND  
LICENSE OF OCCUPATION  
KING'S HIGHWAYS  
IMPROVED ROADS  
ROADS  
RAILWAYS  
POWER LINES  
MINES  
MARSH OR MUSKEG

## NOTES

400' surface rights reservation around all lakes & rivers.

Flooding to elevation 111', (L.O. 6133) shown thus:


Mining Locations which have been cancelled  
have been removed from this plan under the  
Surveyor General's instructions.

PLAN NO.—M-1077.

# DEPARTMENT OF MINES —ONTARIO—

Dunbar Twp.

## Emotions Tw p.

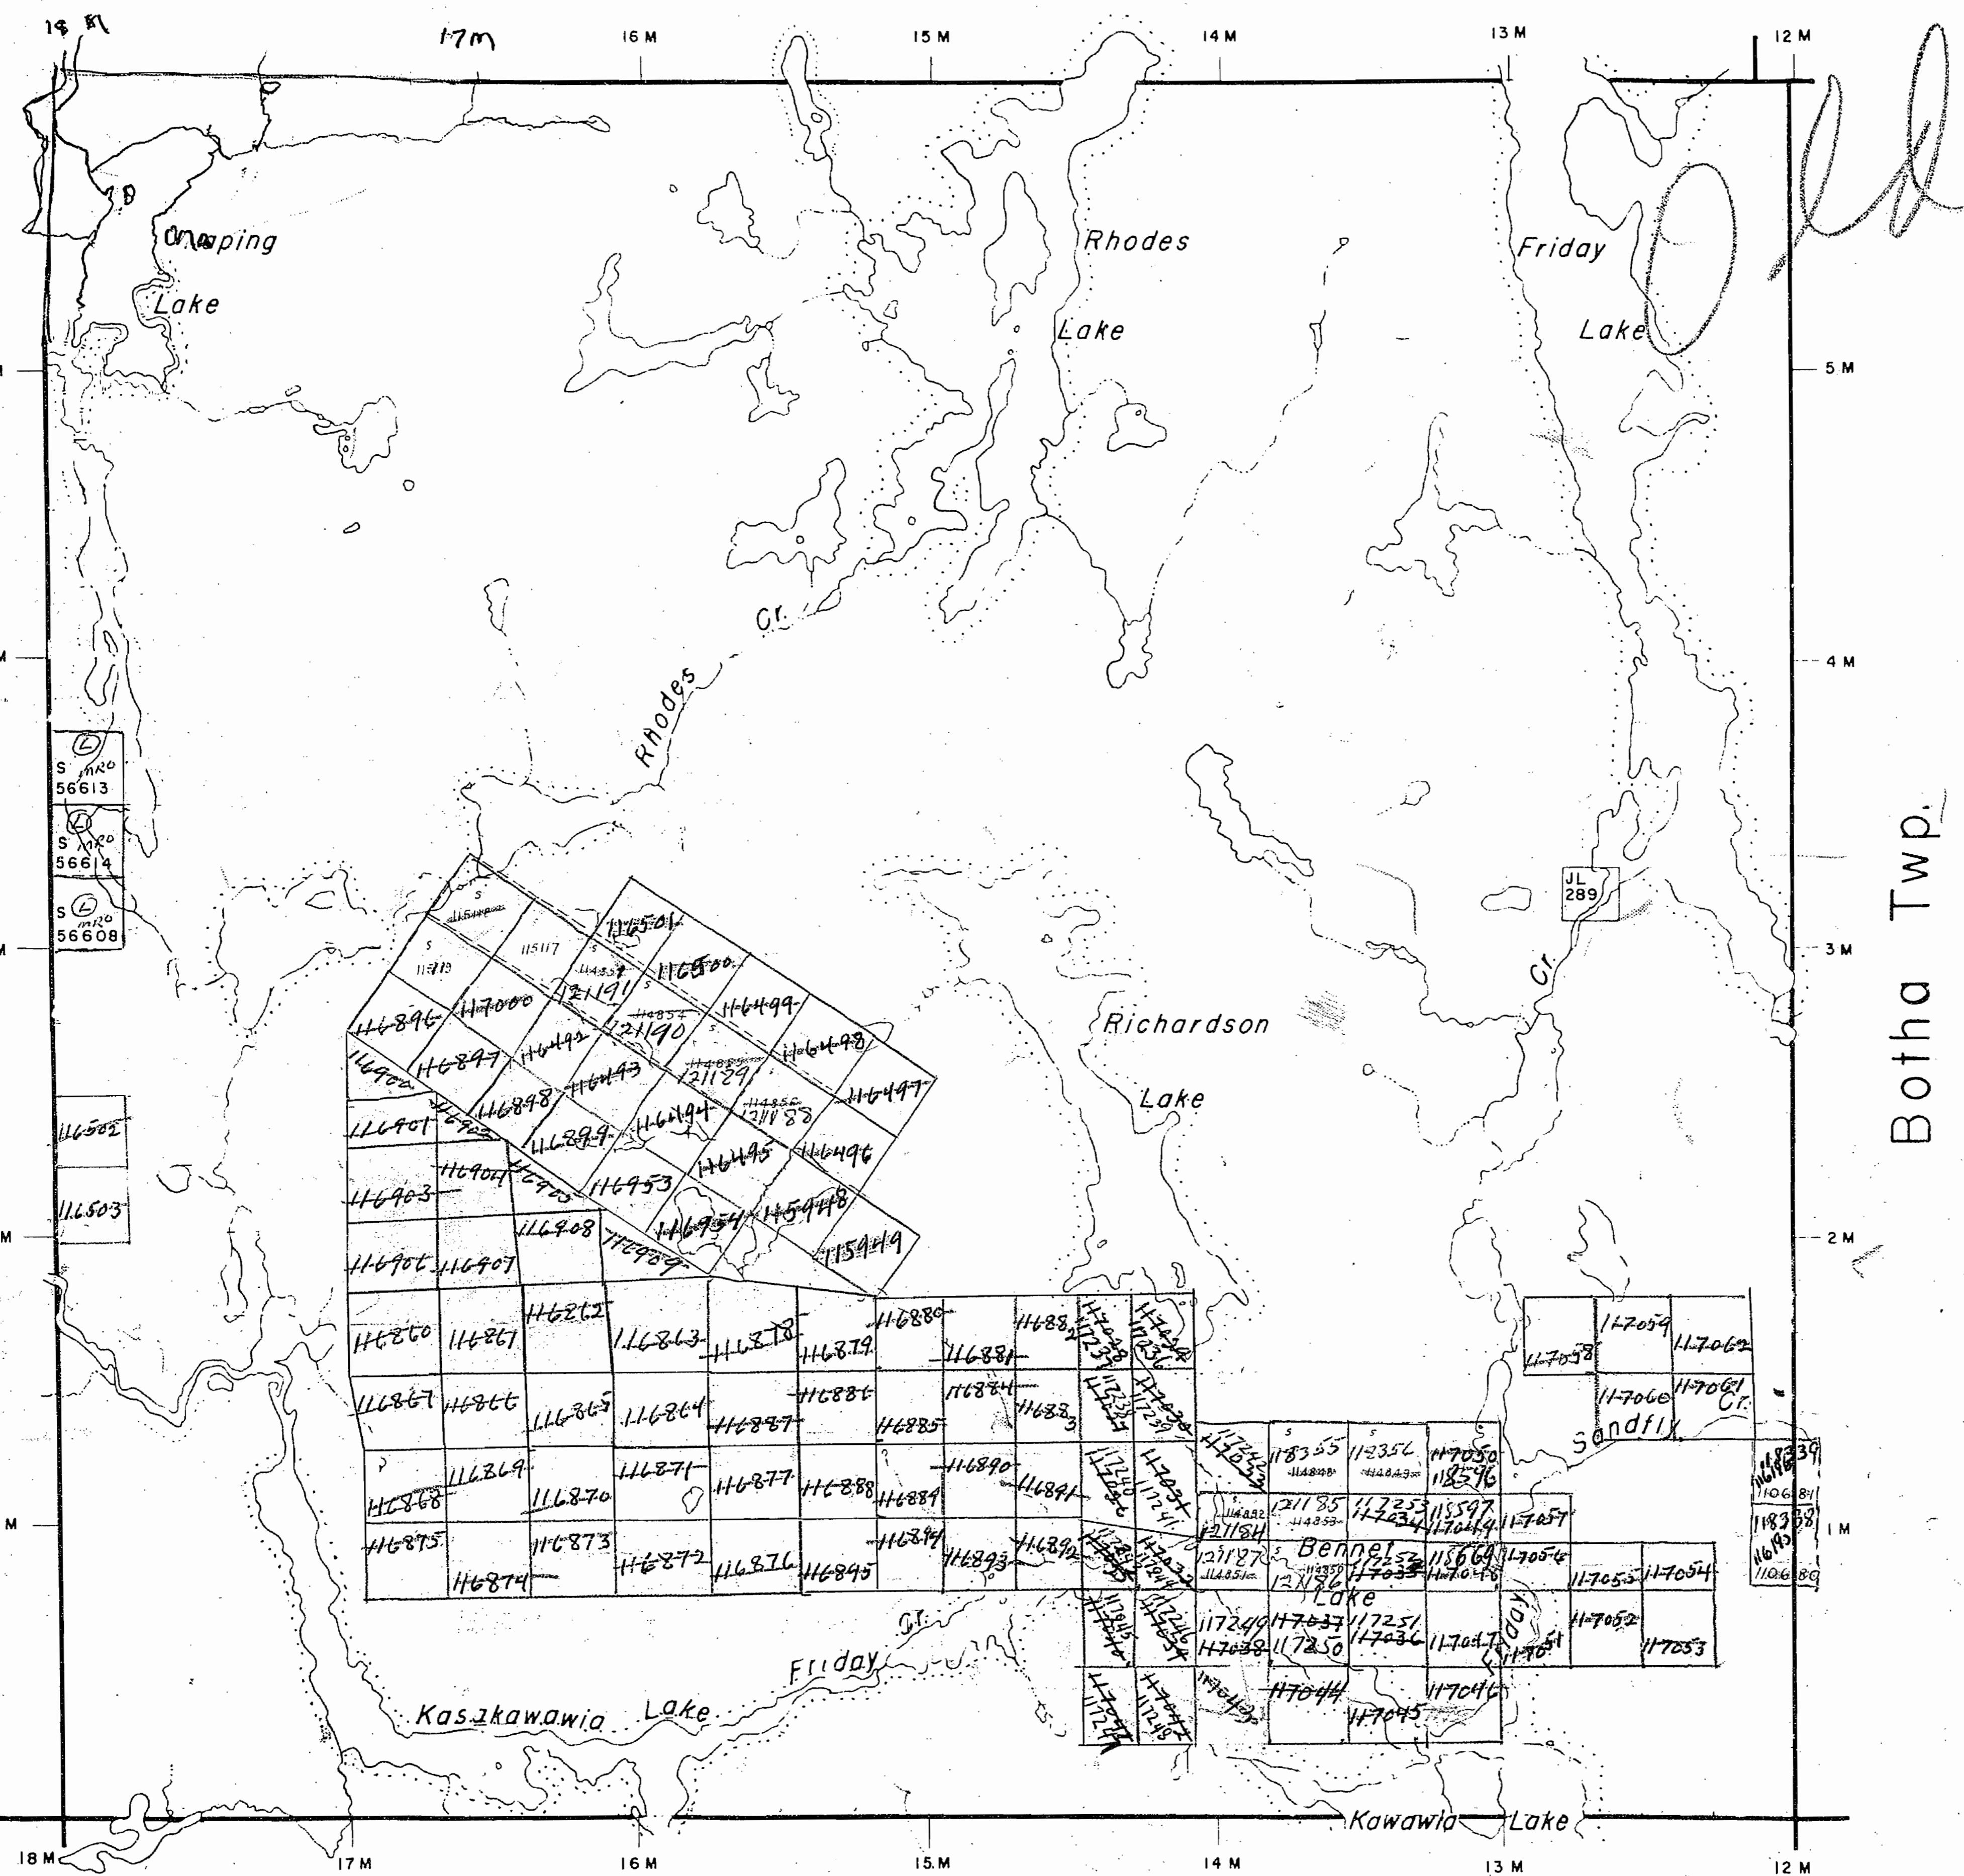

# Leinster Twp.

# THE TOWNSHIP OF

# RHODES

 
DISTRICT  
SUDBURY  
SUDBURY  
MINING DIVIS

SCALE:1-INCH=40

LEGEND

- |                       |   |
|-----------------------|---|
| PATENTED LAND         | (P)   |
| CROWN LAND SALE       | C.S.  |
| LEASES                | (L)   |
| LOCATED LAND          | Loc.  |
| LICENSE OF OCCUPATION | L.O.  |
| KING'S HIGHWAYS       |  |
| IMPROVED ROADS        |  |
| ROADS                 |  |
| RAILWAYS              |  |
| POWER LINES           |  |
| MINES                 |  |
| MARSH OR MUSKEG       |  |

## NOTES

400' reservation to Dept. of Lands & Forests  
shown thus: 

Flooding to elevation 111', (L.O. 6133) shown thus:


Mining Locations which have been cancelled have been removed from this plan under the Surveyor General's instructions.

PLAN NO.—M-1077.

# DEPARTMENT OF MINES — ONTARIO —

DUNBAR TWP. M.768

EMO TWP M 768

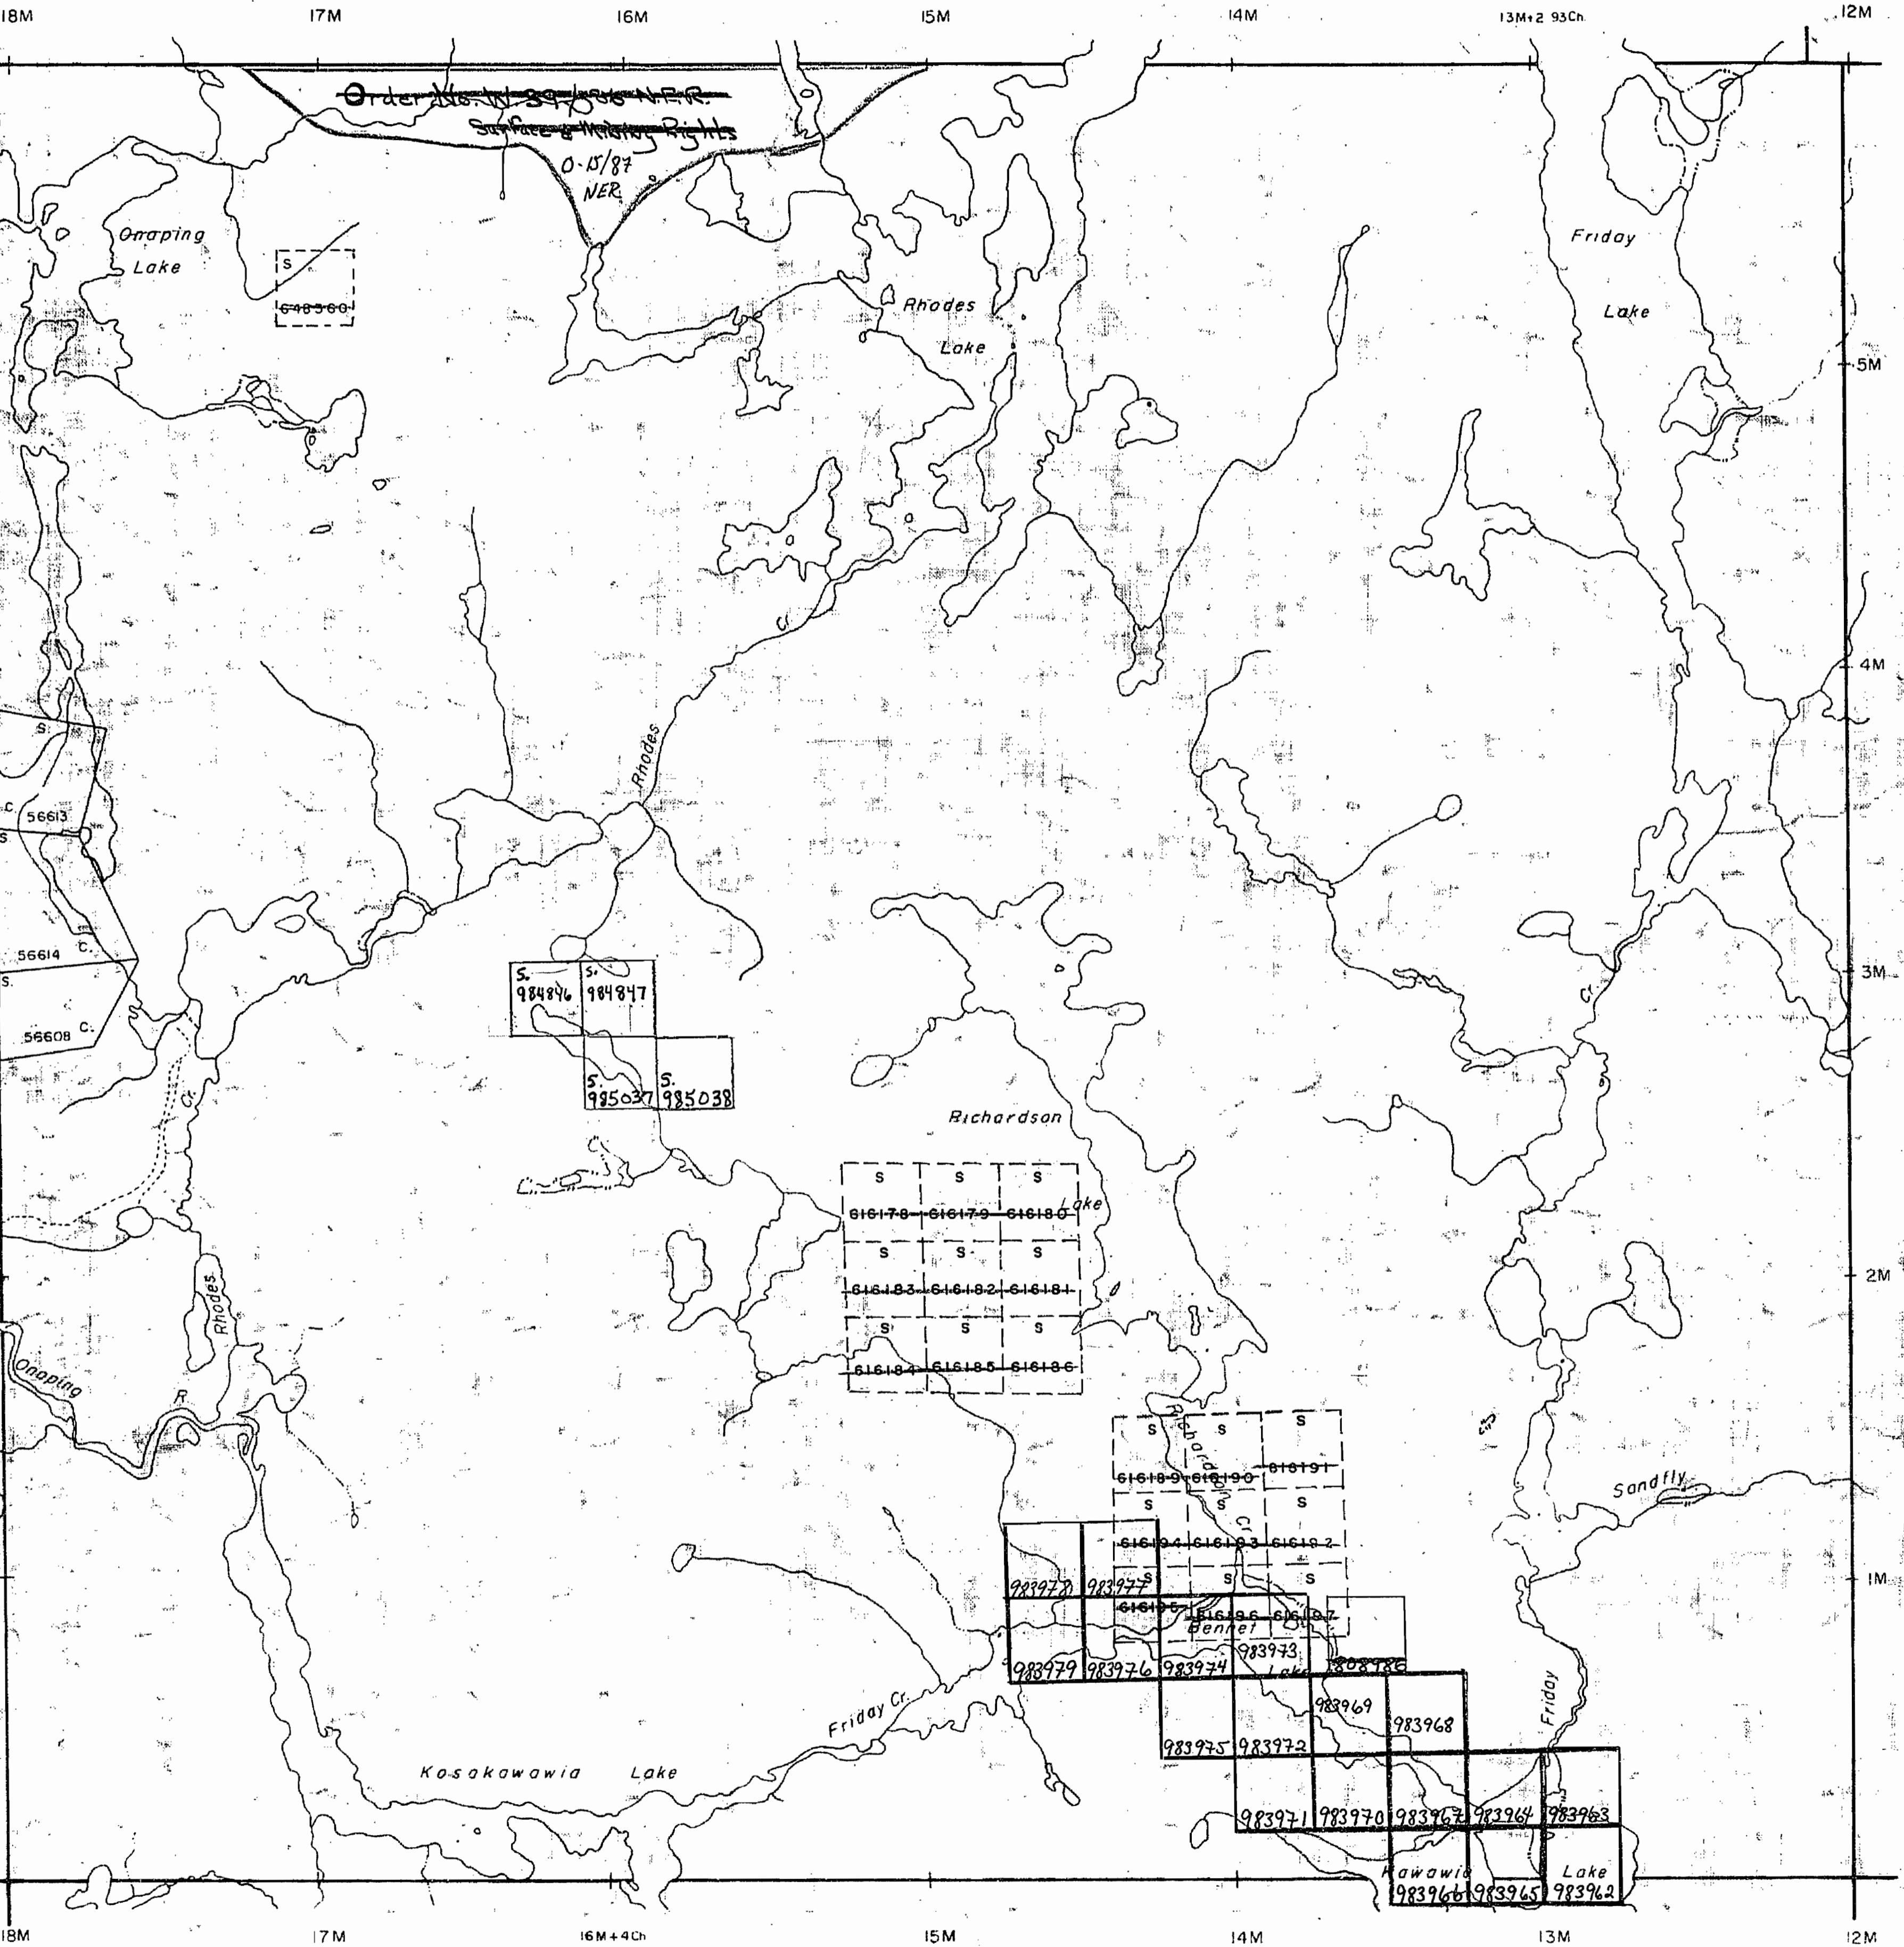

LEINSTER TWP. M.985

THE TOWNSHIP  
OF

RHODES

DISTRICT OF  
SUDBURY

SUDBURY  
MINING DIVISION

SCALE: 1-INCH 40 CHAINS

LEGEND

PATENTED LAND  
CROWN LAND SALE  
LEASES  
LOCATED LAND  
LICENSE OF OCCUPATION  
MINING RIGHTS ONLY  
SURFACE RIGHTS ONLY  
ROADS  
IMPROVED ROADS  
KING'S HIGHWAYS  
RAILWAYS  
POWER LINES  
MARSH OR MUSKEG  
MINES  
CANCELLED

NOTES

400' surface rights reservation around  
the shores of all lakes and rivers

Flooding rights to elevation III on  
Onaping Lake (L.O. 9113) - File 9214

~~Section 36/80 Mining Act~~

Order No. 37185 N.E.R. 1981-05-05

Surface Mining Rights  
MNR File: 7318 Vol. 14  
180554

Order No. 0-15/87-NER  
Subject to L.O. #9839 - See Annex  
Land Roll


RHODES

PLAN NO. M-1077

ONTARIO

MINISTRY OF NATURAL RESOURCES

SURVEYS AND MAPPING BRANCH

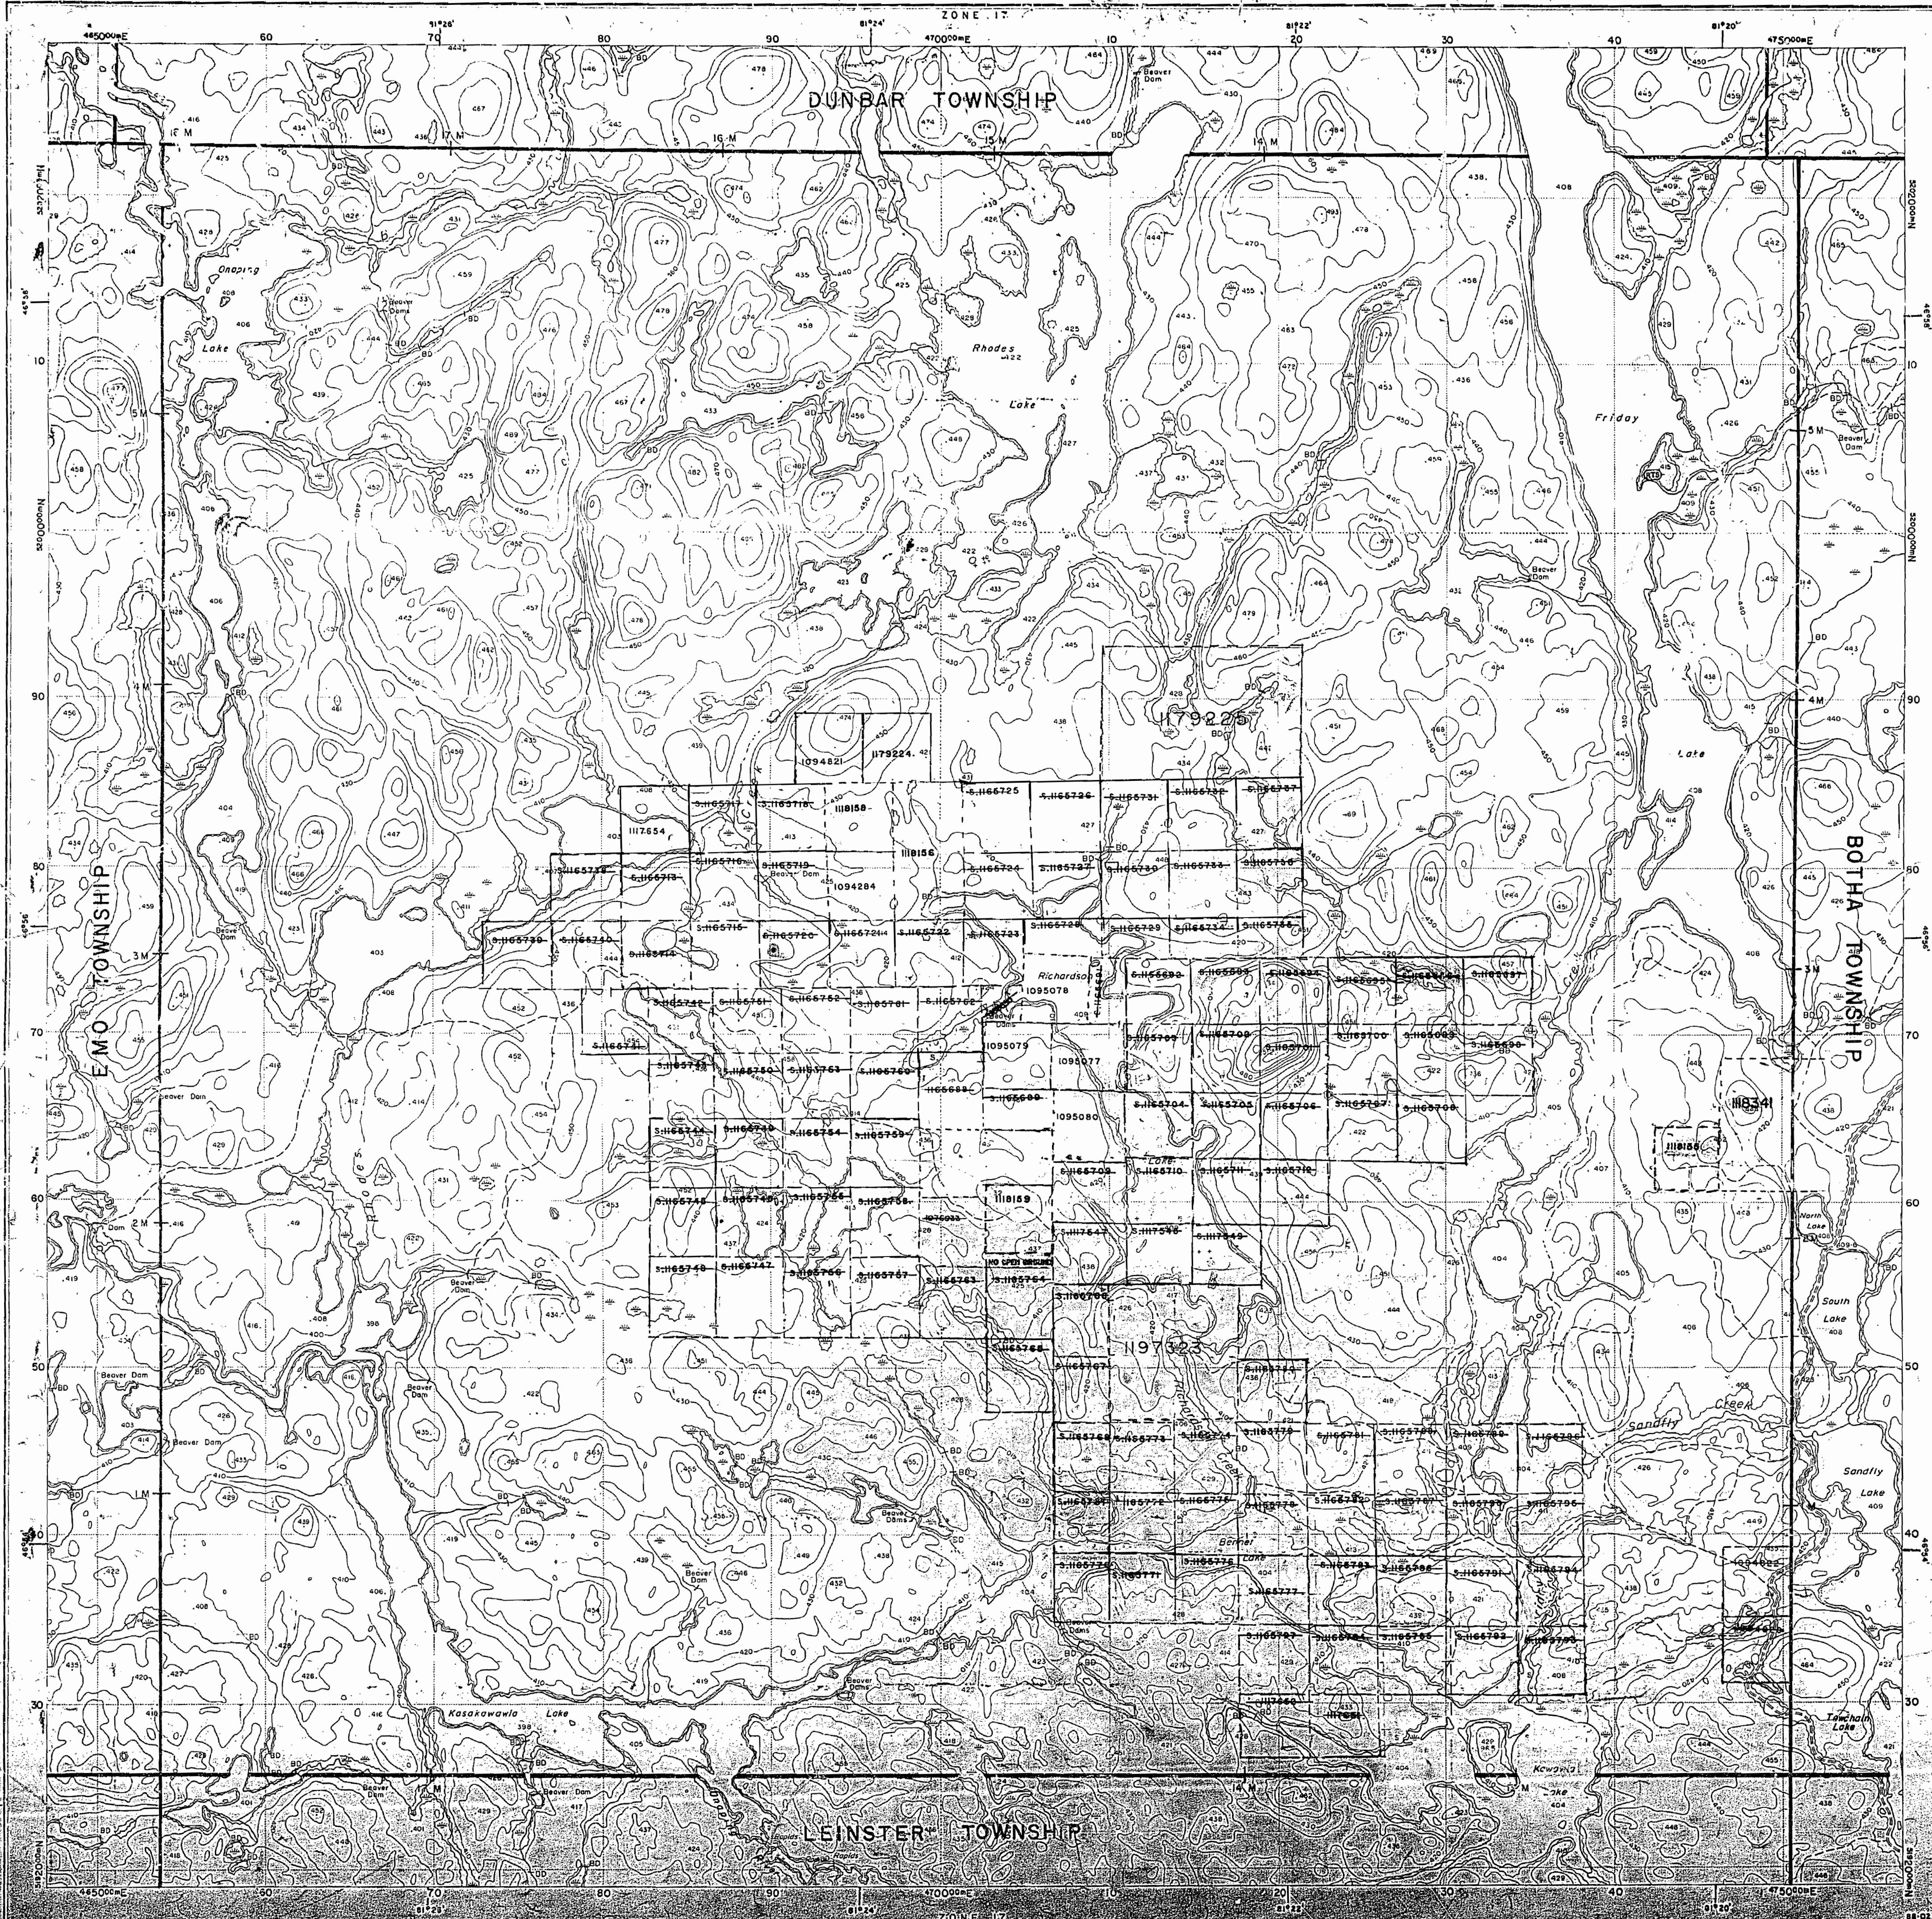

# Ministry of Natural Resources

**Ministry of  
Northern Development  
and Mines**

Service: March 30, 1988

## **INDEX TO LAND DISPOSITION**

PR

G-4096

**TOWNSHIP**

RHODES

## **M.N.R. ADMINISTRATIVE DISTRICT**

## SUDBURY

#### **MINING DIVISION**

## SUDBURY

**LAND TITLES/REGISTRY DIVISION**

**SUDSBURY**

Scale 1:20 000

Metres      1000      0      1000      2000      Metres

Feet      1000      0      1000      2000      3000      4000      5000      6000      7000      8000      9000      10000      Feet

Contour Interval 10 Metres

**AREAS WITHDRAWN FROM DISPOSITION**

MRO - Mining Rights Only  
SRO - Surface Rights Only  
M + S - Mining and Surface Rights

Order No.	Date	Disposition	File
-----------	------	-------------	------

## **SYMBOLS**

## DISPOSITION OF CROWN LANDS

<b>Patent</b>	
Surface & Mining Rights .....	▼
Surface Rights Only .....	□
Mining Rights Only .....	■
<b>Lease</b>	
Surface & Mining Rights .....	▼
Surface Rights Only .....	□
Mining Rights Only .....	■
<b>Licence of Occupation</b> .....	▼
<b>Order-in-Council</b> .....	OC
<b>Cancelled</b> .....	⊗
<b>Reservation</b> .....	◎
<b>Sand &amp; Gravel</b> .....	◎

#### NOTES

Flooding rights to elevation 111' on Onondaga  
Lake (L.O. 9839) - File 9214.

THE INFORMATION THAT  
APPEARS ON THIS MAP  
HAS BEEN COMPILED  
FROM VARIOUS SOURCES,  
AND ACCURACY IS NOT  
GUARANTEED. THOSE  
WISHING TO STAKE MIN-  
ING CLAIMS SHOULD CON-  
SULT WITH THE MINING  
RECORDER, MINISTRY OF  
NORTHERN DEVELOP-  
MENT AND MINES, FOR AD-  
DITIONAL INFORMATION  
ON THE STATUS OF THE  
LANDS SHOWN HEREON.

V 31 1996

ATE OF ISSUE  
MAR 3 0 1988  
SUDBURY  
RECORDER'S OFFICE

1077

DUNBAR TWP. M.768

SUDSBURY  
MINING DIV.  
**RECEIVED**  
JUN 21 1971  
A.M. 7 8 9 10 11 12 1 2 3 4 5 6  
P.M. 12 1 2 3 4 5 6

THE TOWNSHIP  
OF

RHODES

DISTRICT OF  
SUDSBURYSUDSBURY  
MINING DIVISION

SCALE: 1-INCH = 40 CHAINS

**LEGEND**

- PATENTED LAND
- CROWN LAND SALE
- LEASES
- LOCATED LAND
- LICENSE OF OCCUPATION
- MINING RIGHTS ONLY
- SURFACE RIGHTS ONLY
- ROADS
- IMPROVED ROADS
- KING'S HIGHWAYS
- RAILWAYS
- POWER LINES
- MARSH OR MUSKEG
- MINES
- CANCELLED

(P)  
CS  
(L)  
LOC  
LO  
M.R.O.  
S.R.O.

**NOTES**

400' surface rights reservation around  
the shores of all lakes and rivers

Flooding rights to elevation III on  
Onaping Lake (L.O.6133) - File 9214

John Hug 10/73

EMO TWP. M.768


PLAN NO. M-1077

LEINSTER TWP. M.985

ONTARIO  
DEPARTMENT OF MINES  
AND NORTHERN AFFAIRS

1077

Dunbar Twp.

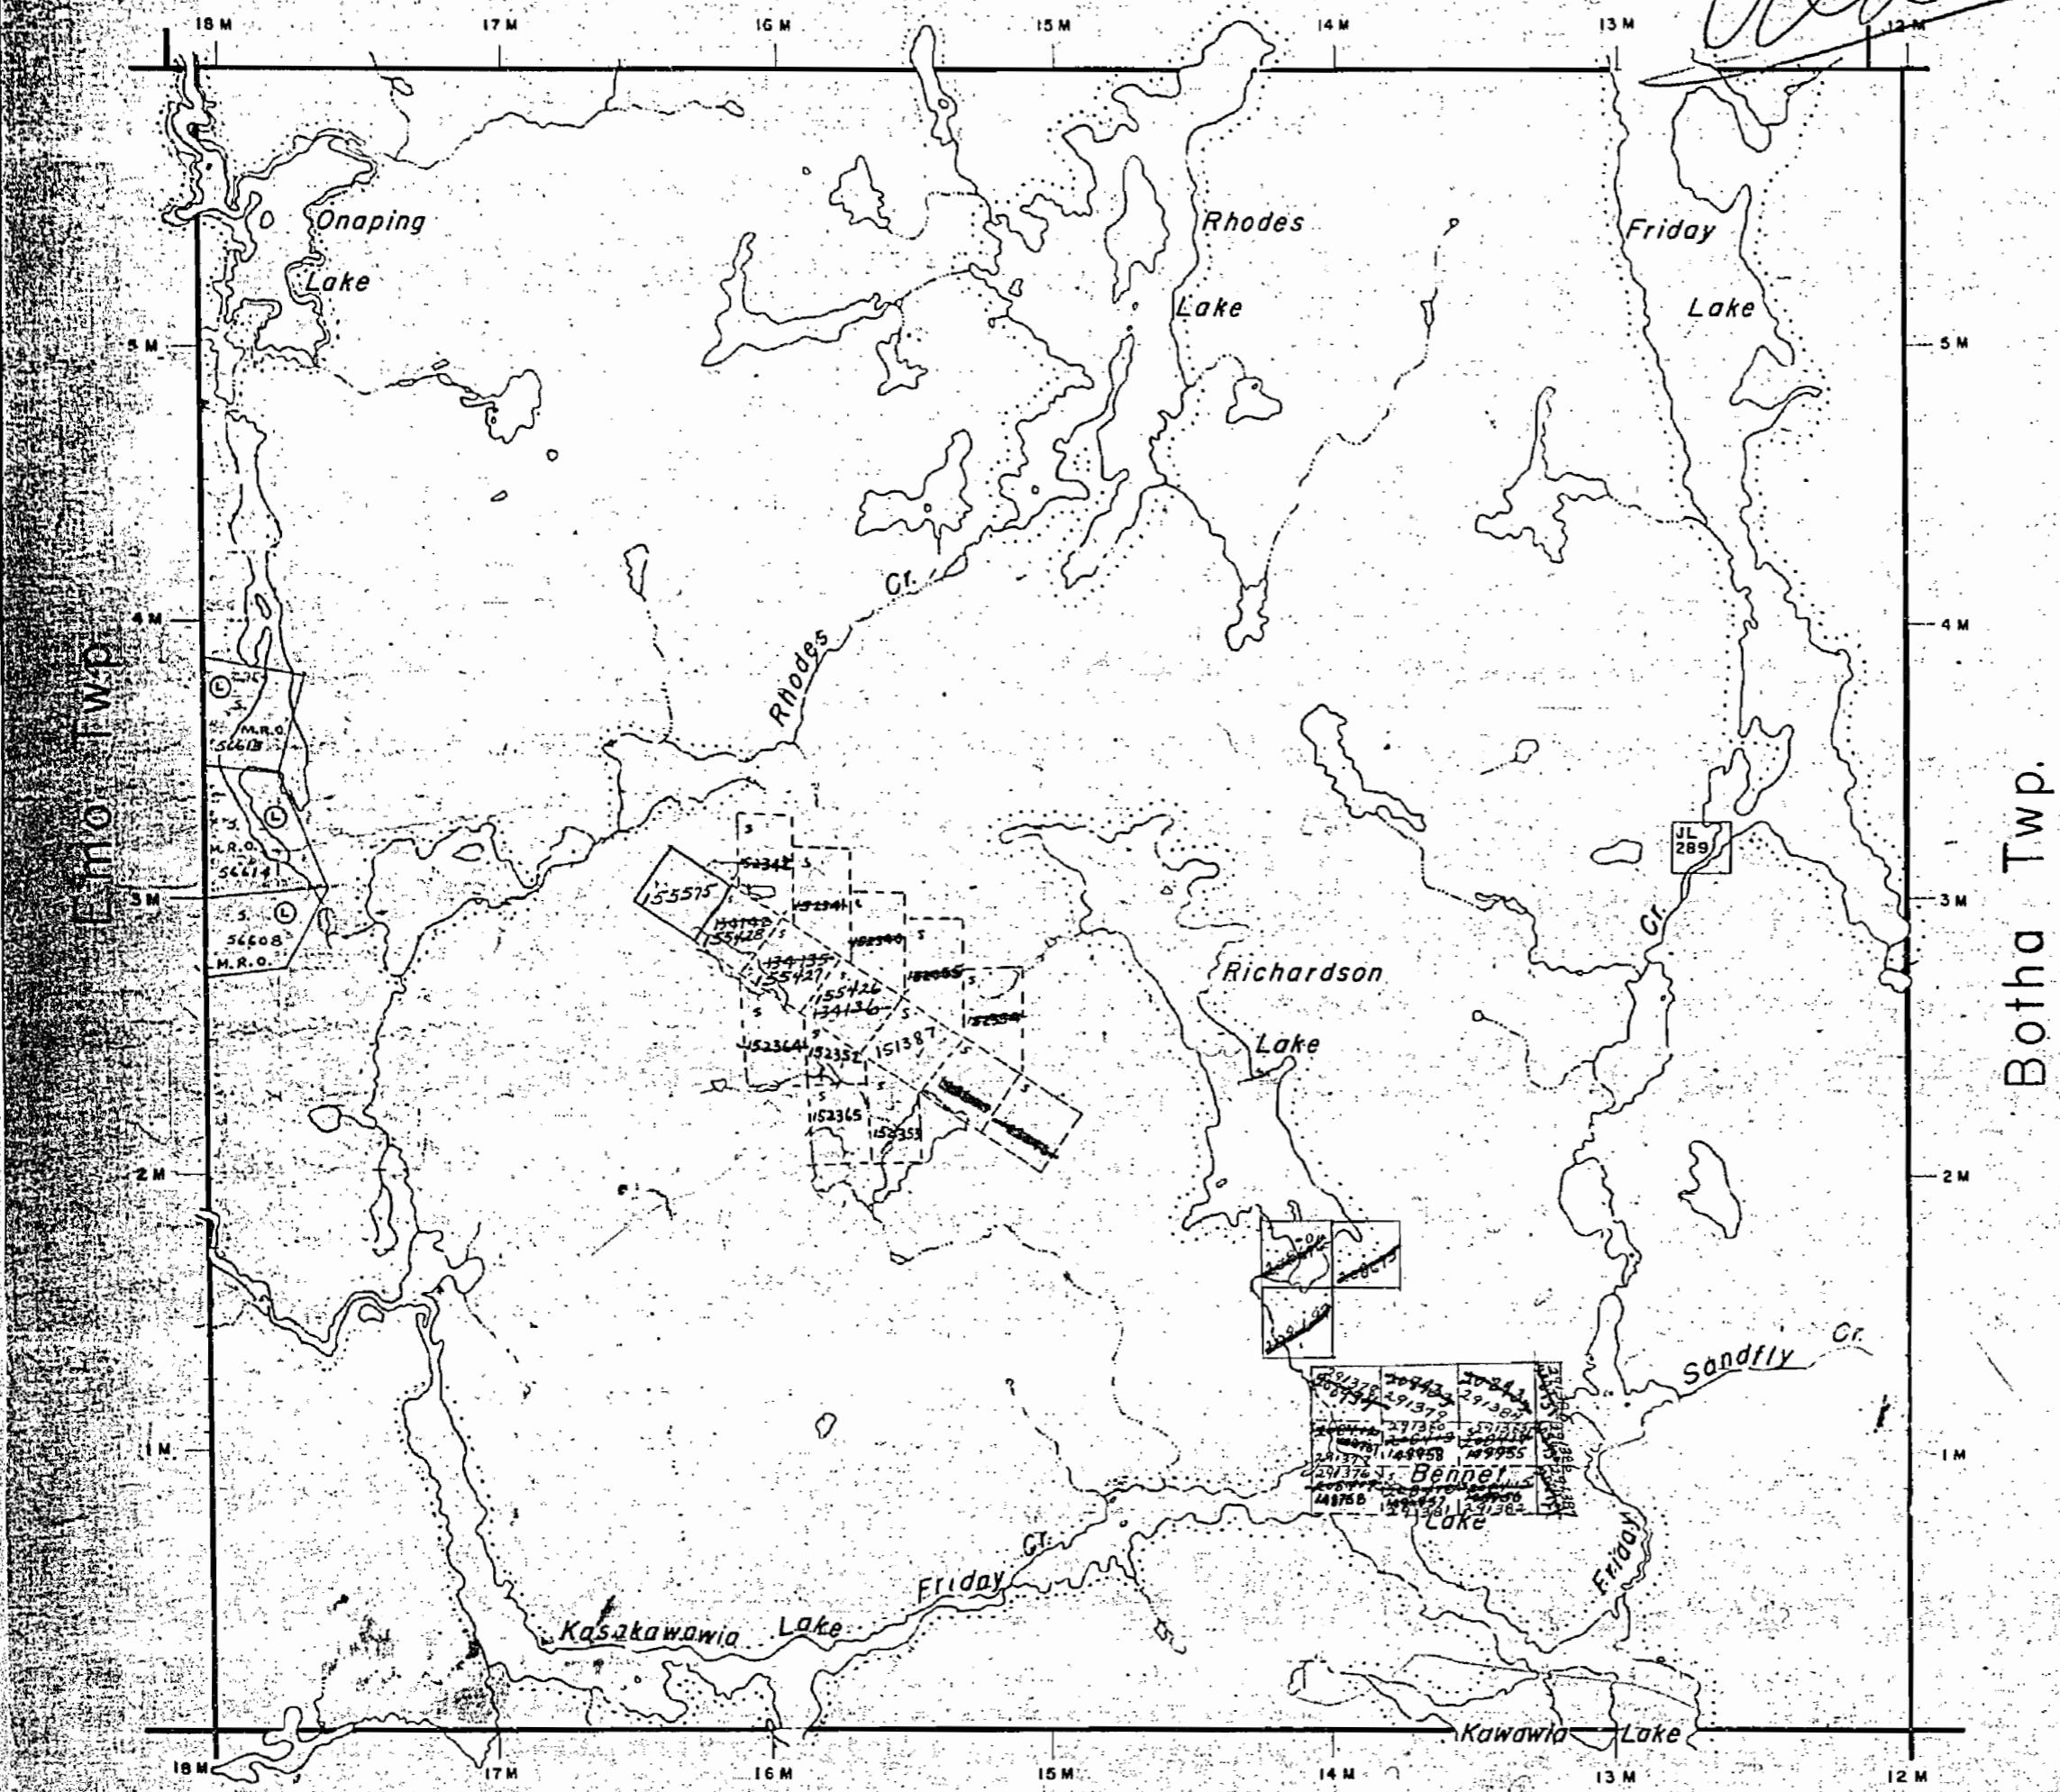

THE TOWNSHIP  
OF  
**RHODES**

DISTRICT OF  
SUDBURY

# SUDBURY MINING DIVISION

SCALE 1-INCH=40 CHAINS

LEGEND

- PATENTED LAND  
CROWN LAND SALE  
LEASES  
LOCATED LAND  
LICENSE OF OCCUPATION  
KING'S HIGHWAYS  
IMPROVED ROADS  
ROADS  
RAILWAYS  
POWER LINES  
MINES  
MARSH OR MUSKEG

## NOTES

400' surface rights reservation around all lakes & rivers.

Flooding to elevation (11) (L.O. 6133) shown thus:

Mining Locations which have been cancelled  
have been removed from this plan under the  
Surveyor General's instructions.


## Leinster Twp.

PLAN NO - M-1077

DEPARTMENT OF MINES  
—ONTARIO—

1077

Dunbar Twp.

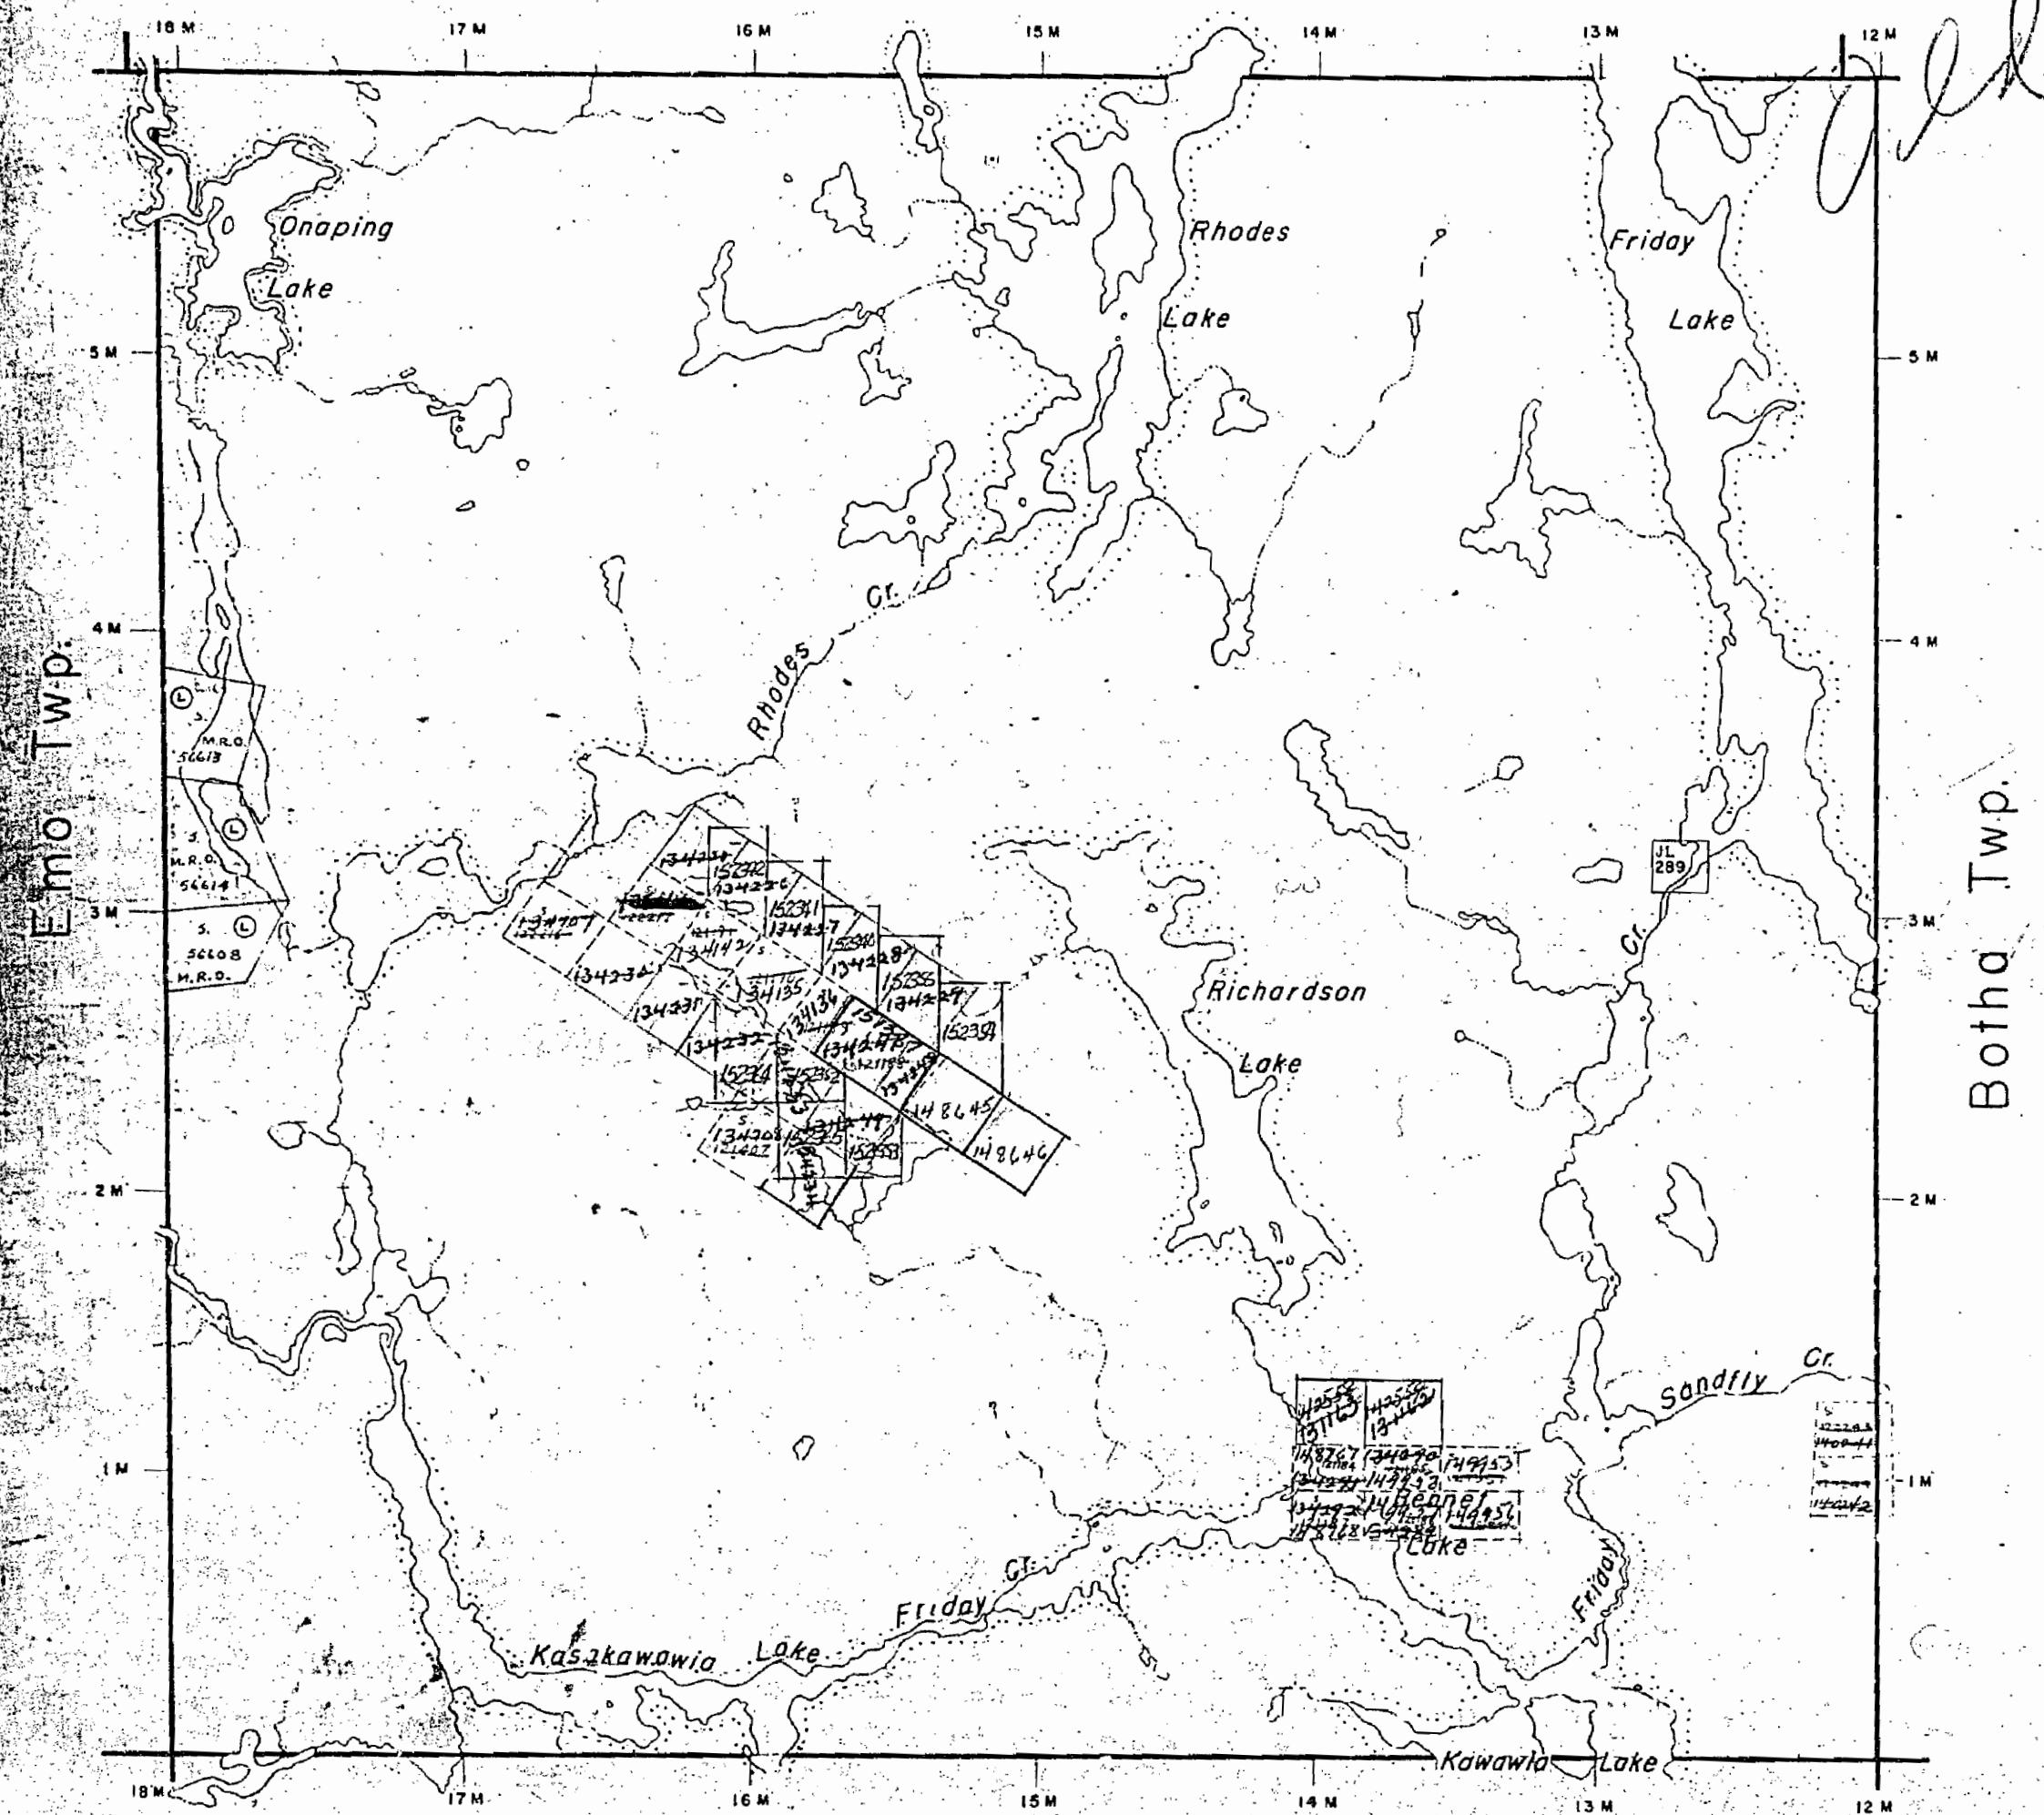

# THE TOWNSHIP OF **RHODES**


DISTRICT OF  
SUDBURY

SUDSBURY  
MINING DIVISION

SCALE: 1-INCH = 40 CHAINS

## LEGEND

- PATENTED LAND  
CROWN LAND SALE  
LEASES  
LOCATED LAND  
LICENSE OF OCCUPATION  
KING'S HIGHWAYS  
IMPROVED ROADS  
ROADS  
RAILWAYS  
POWER LINES  
MINES  
MARSH OR MUSKEG

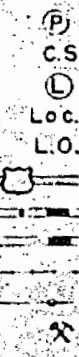

## NOTES

400' surface rights reservation around all lakes & rivers.

Flooding to elevation .11', (L 0.6133), shows thus:

Mining Locations which have been cancelled  
have been removed from this plan under the  
Surveyor General's instructions.

July 30, 1888.

PLAN NO.—M-1077

**DEPARTMENT OF MINES  
—ONTARIO—**

1077

**PLAN OF  
RHODES TWP.  
SUDBURY MINING DIVISION  
DISTRICT OF SUDBURY.**

~~— SCALE 40 CHAINS TO AN INCH. —~~

DUNBAR - TWP

17 M 80.00 // 16 M. 80.00 Ast. West 15 M 80.00


200' wide reservations on surface by  
shown hereon thus \_\_\_\_\_

LEINSTER T'WR

KAWAWIA LAKE

1077

Dunbar Twp.

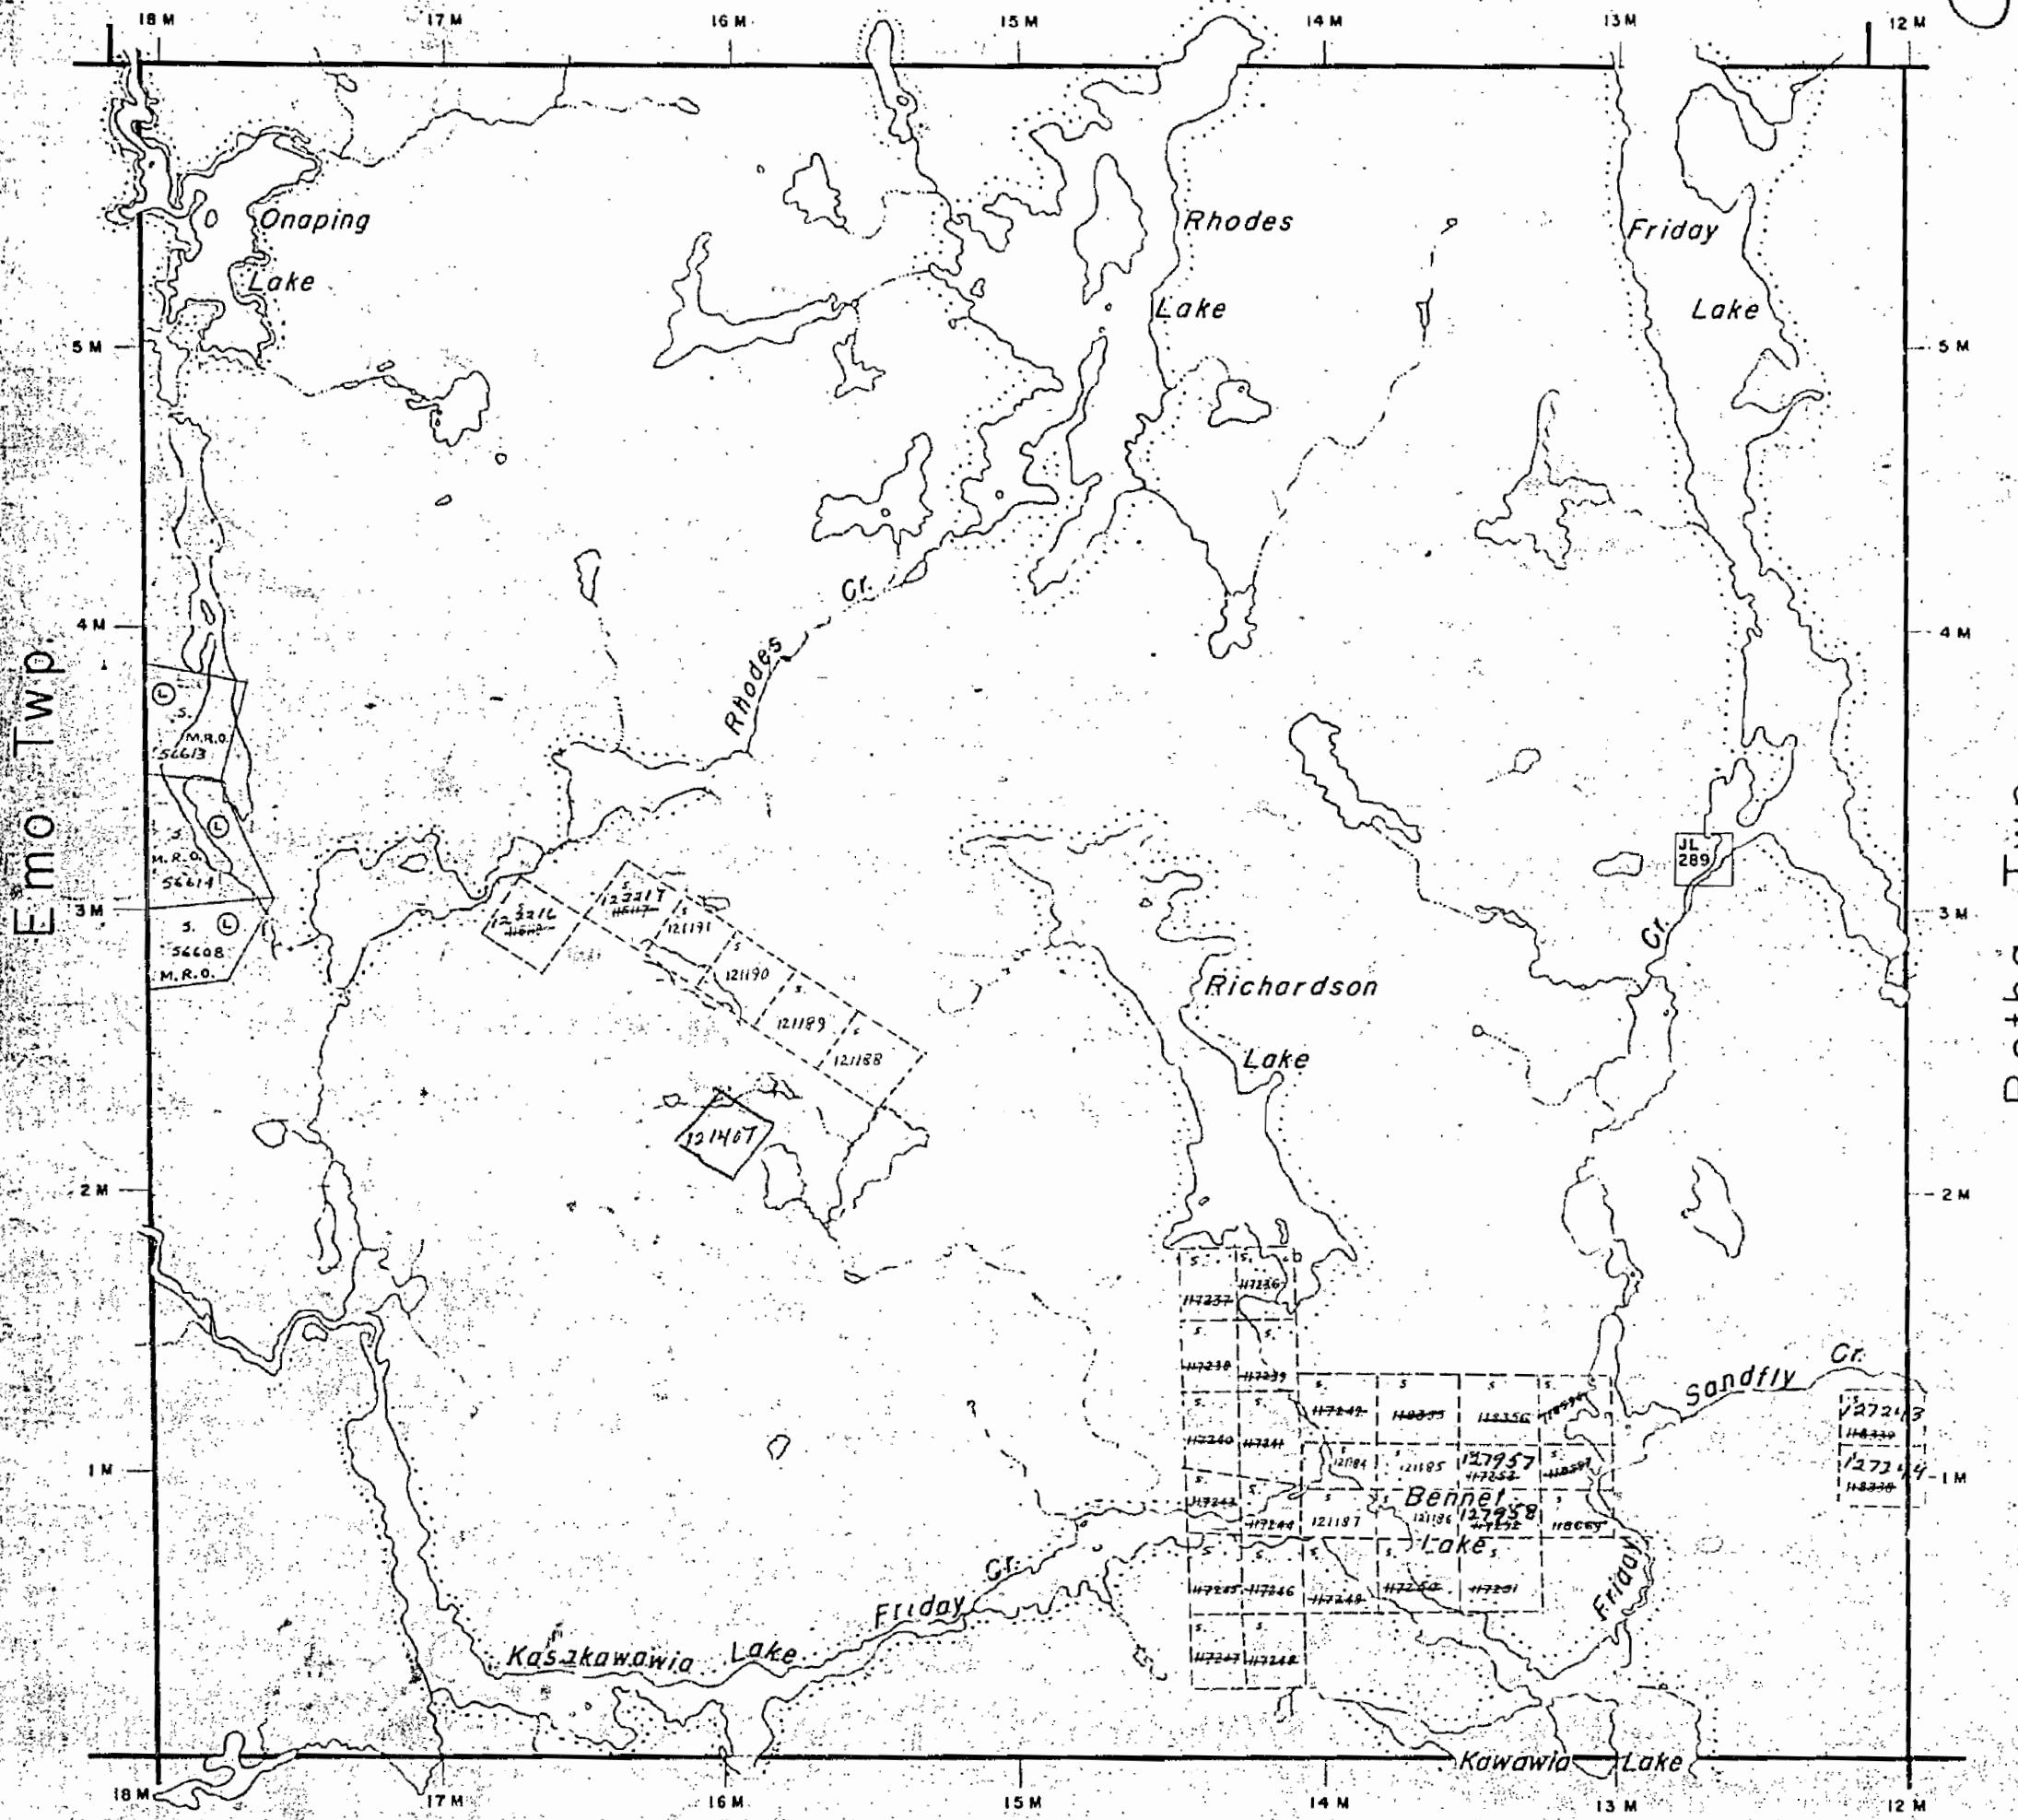

Leinster Twp.

THE TOWNSHIP  
OF  
**RHODES**

DISTRICT OF  
SUDBURY

SUDBURY  
MINING DIVISION

SCALE: 1-INCH=40 CHAINS

LEGEND

(P)	PATENTED LAND
(C.S.)	CROWN LAND SALE
(L)	LEASES
(Loc.)	LOCATED LAND
(L.O.)	LICENSE OF OCCUPATION
	KING'S HIGHWAYS
	IMPROVED ROADS
	ROADS
	RAILWAYS
	POWER-LINES
	MINES
	MARSH OR MUSKEG

NOTES

400' surface rights reservation around all lakes & rivers.

Flooding to elevation 111', (L.O. 6133) shown thus:


Mining Locations which have been cancelled have been removed from this plan under the Surveyor General's instructions.

PLAN NO.-M-1077

DEPARTMENT OF MINES  
ONTARIO

1077

## Dunbar Twp.

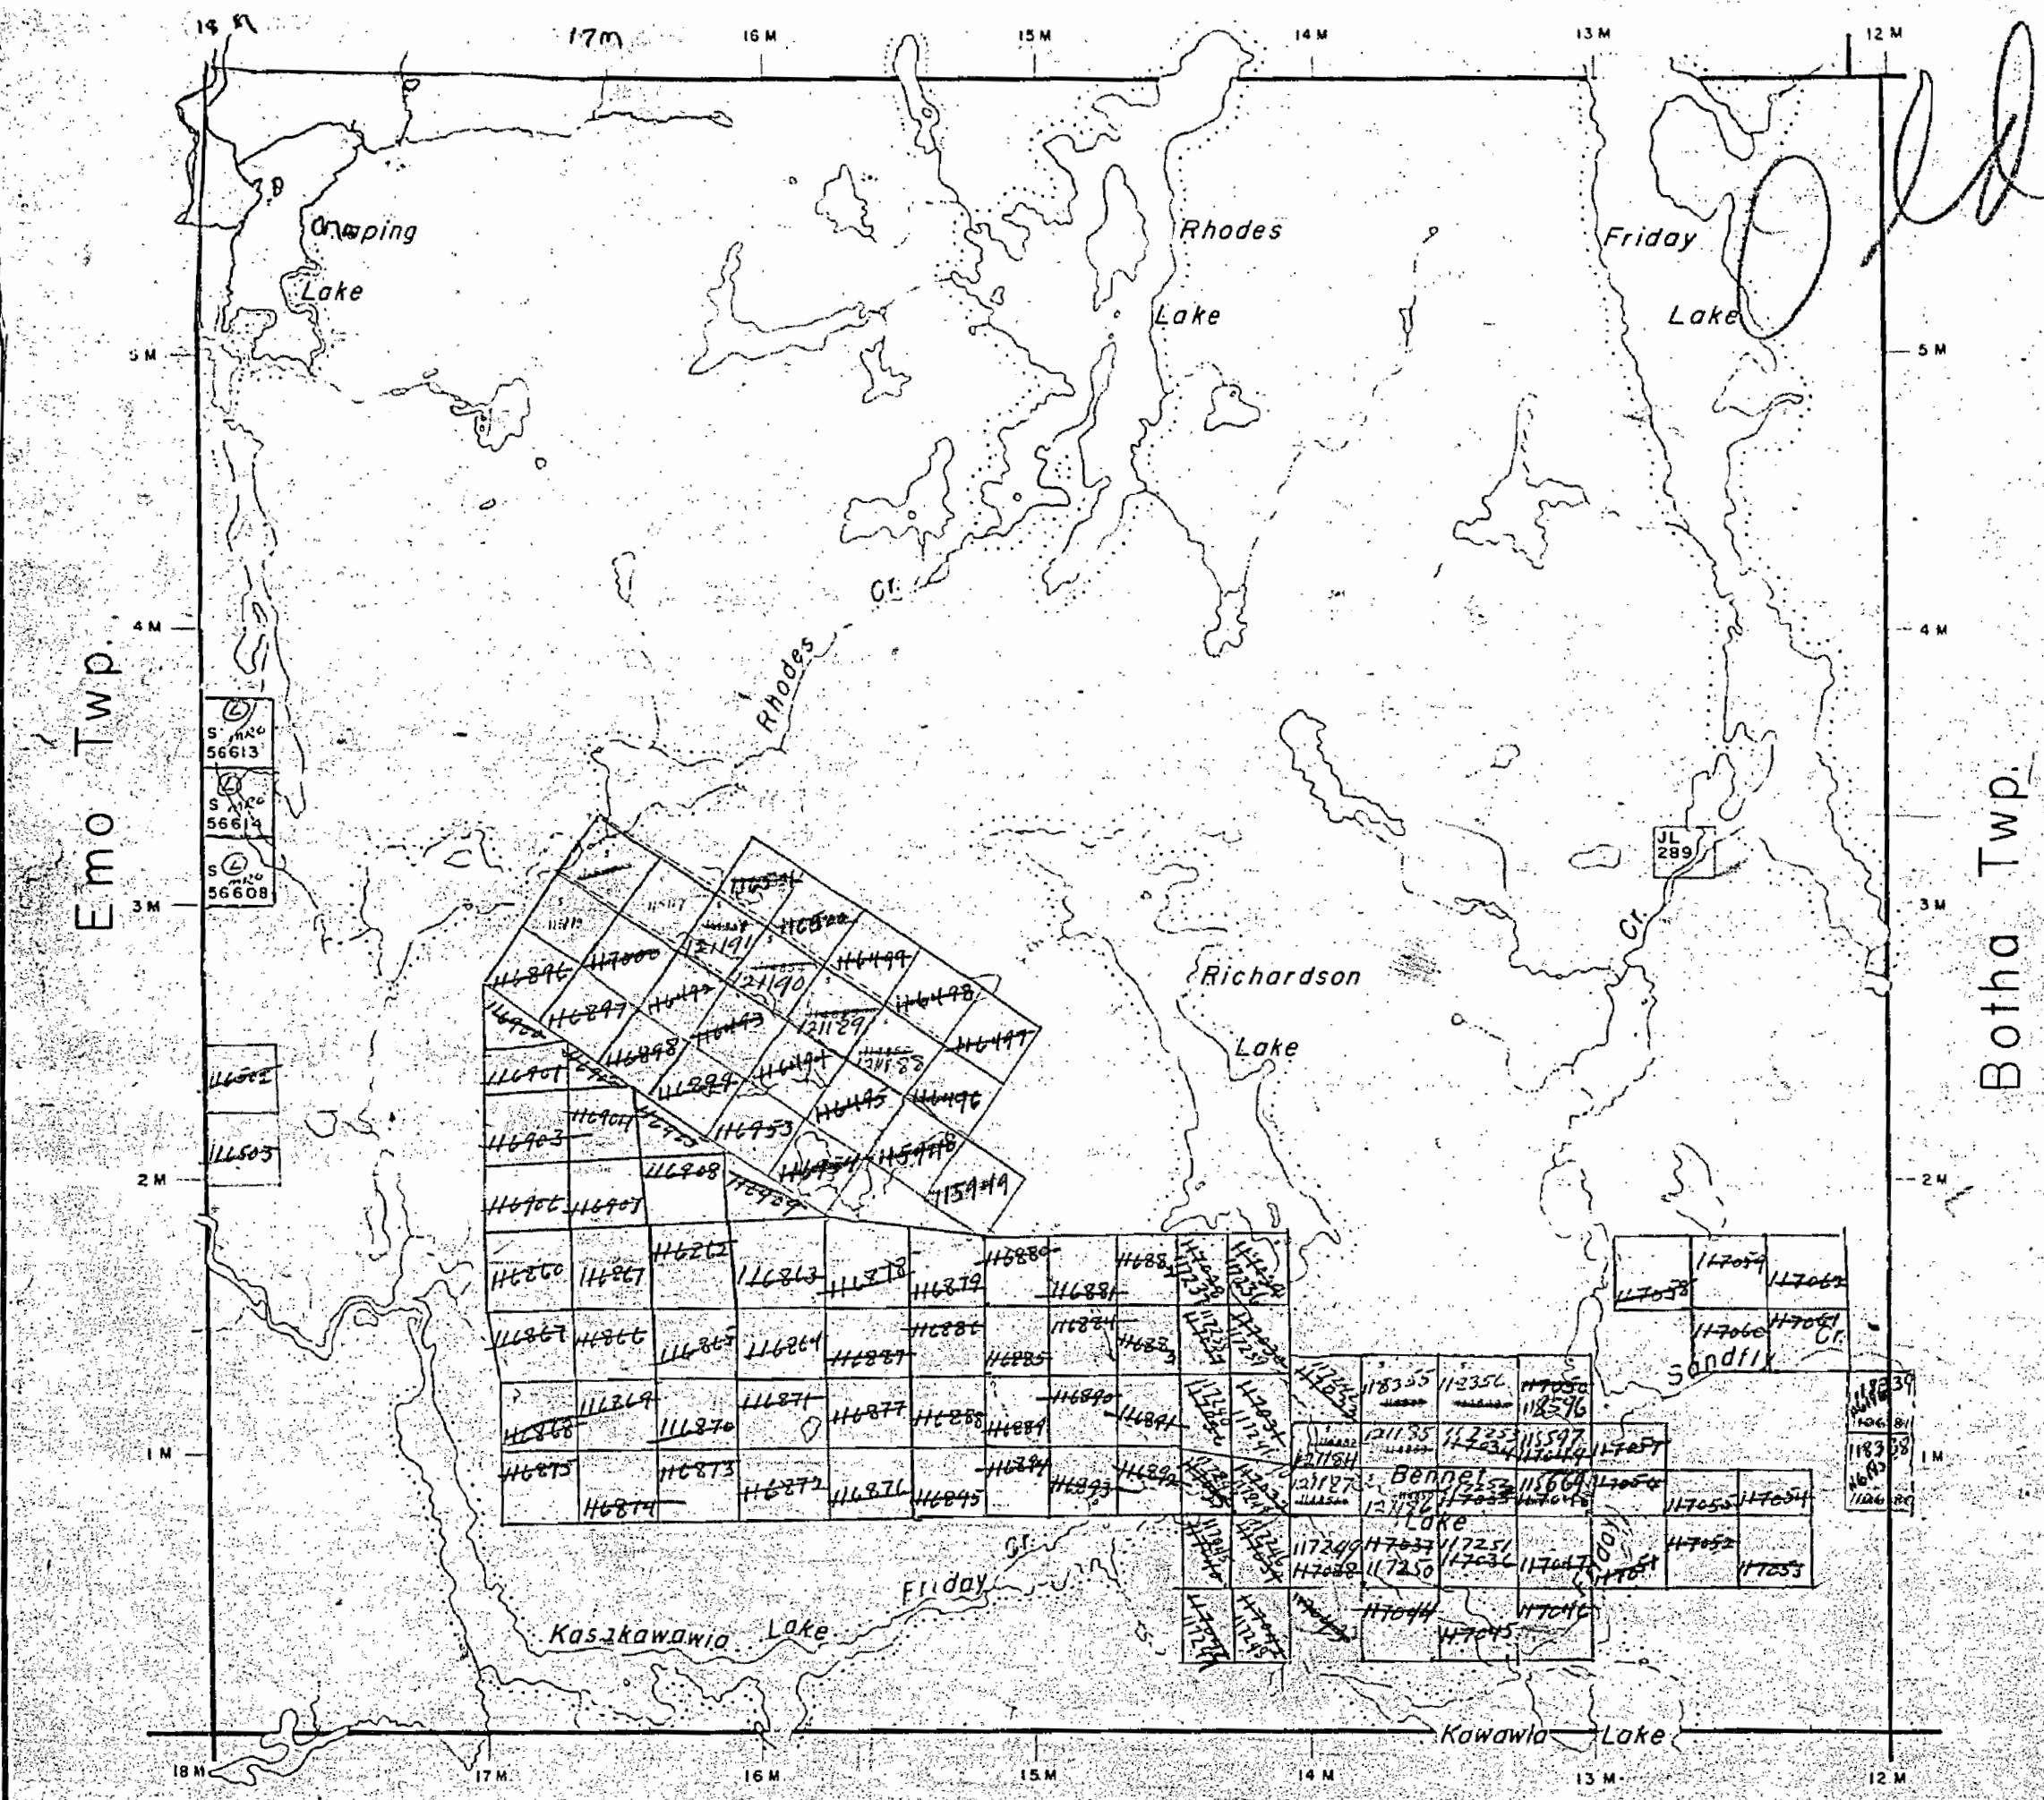

THE TOWNSHIP  
OF  
**RHODES**  
DISTRICT OF  
SUDBURY  
SUDBURY  
MINING DIVISION

SCALE 1-INCH=40 CHAINS

## LEGEND

PATENTED LAND  
CROWN LAND SALE  
LEASES  
LOCATED LAND  
LICENSE OF OCCUPATION  
KING'S HIGHWAYS  
IMPROVED ROADS  
ROADS  
RAILWAYS  
POWER LINES  
MINES  
MARSH OR MUSKEG

## NOTES

400' reservation to Dept. of Lands B-Forests  
shown thus:

Flooding to elevation 111,(L.O.6133) shown thus:

Mining Locations which have been cancelled  
have been removed from this plan under the  
Surveyor General's instructions.


PLAN NO.—M-1077.

DEPARTMENT OF MINES  
—ONTARIO—


1077

PLAN OF  
**RHODES TWP.**  
SUDBURY MINING DIVISION.  
DISTRICT OF SUDBURY.

SCALE 40 CHAINS TO AN INCH.

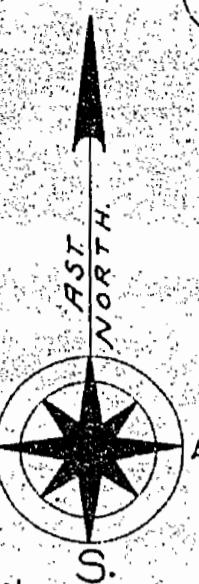

DUNBAR TWP.

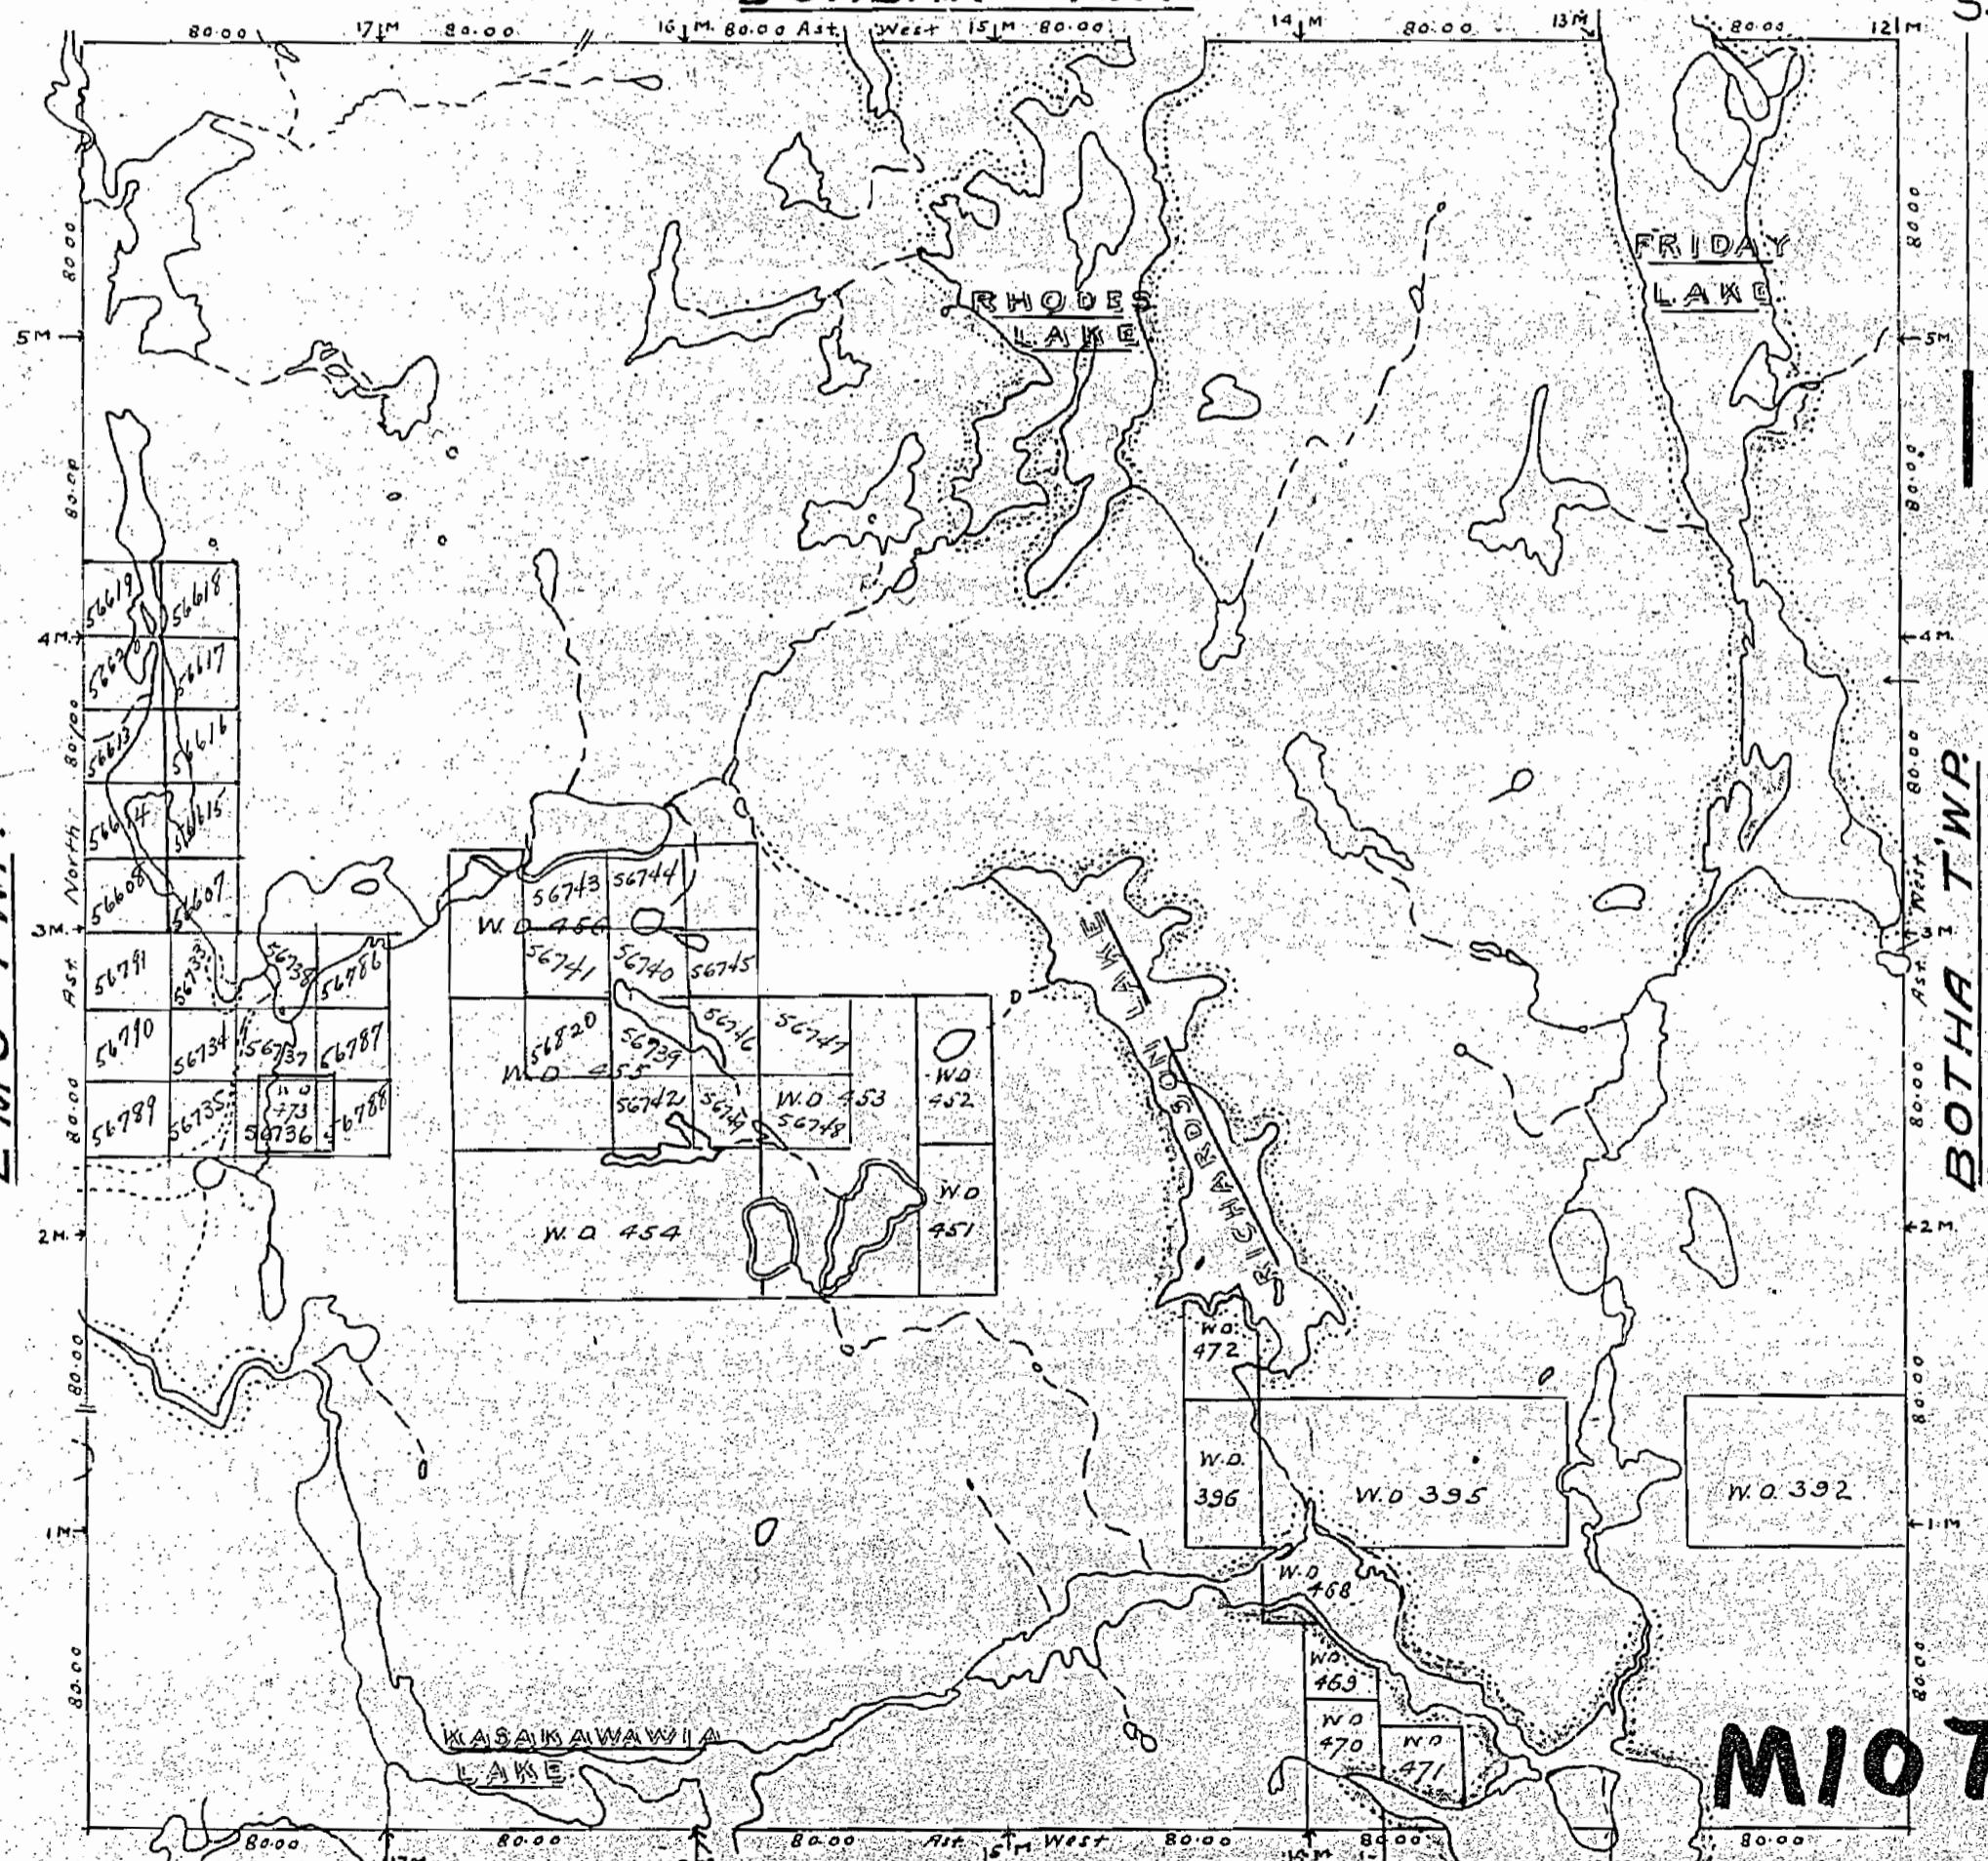


LEINSTER TWP.

200' wide reservations on surface by Dept. of L&F  
shown herein & thus

1077

## Dunbar Twp.

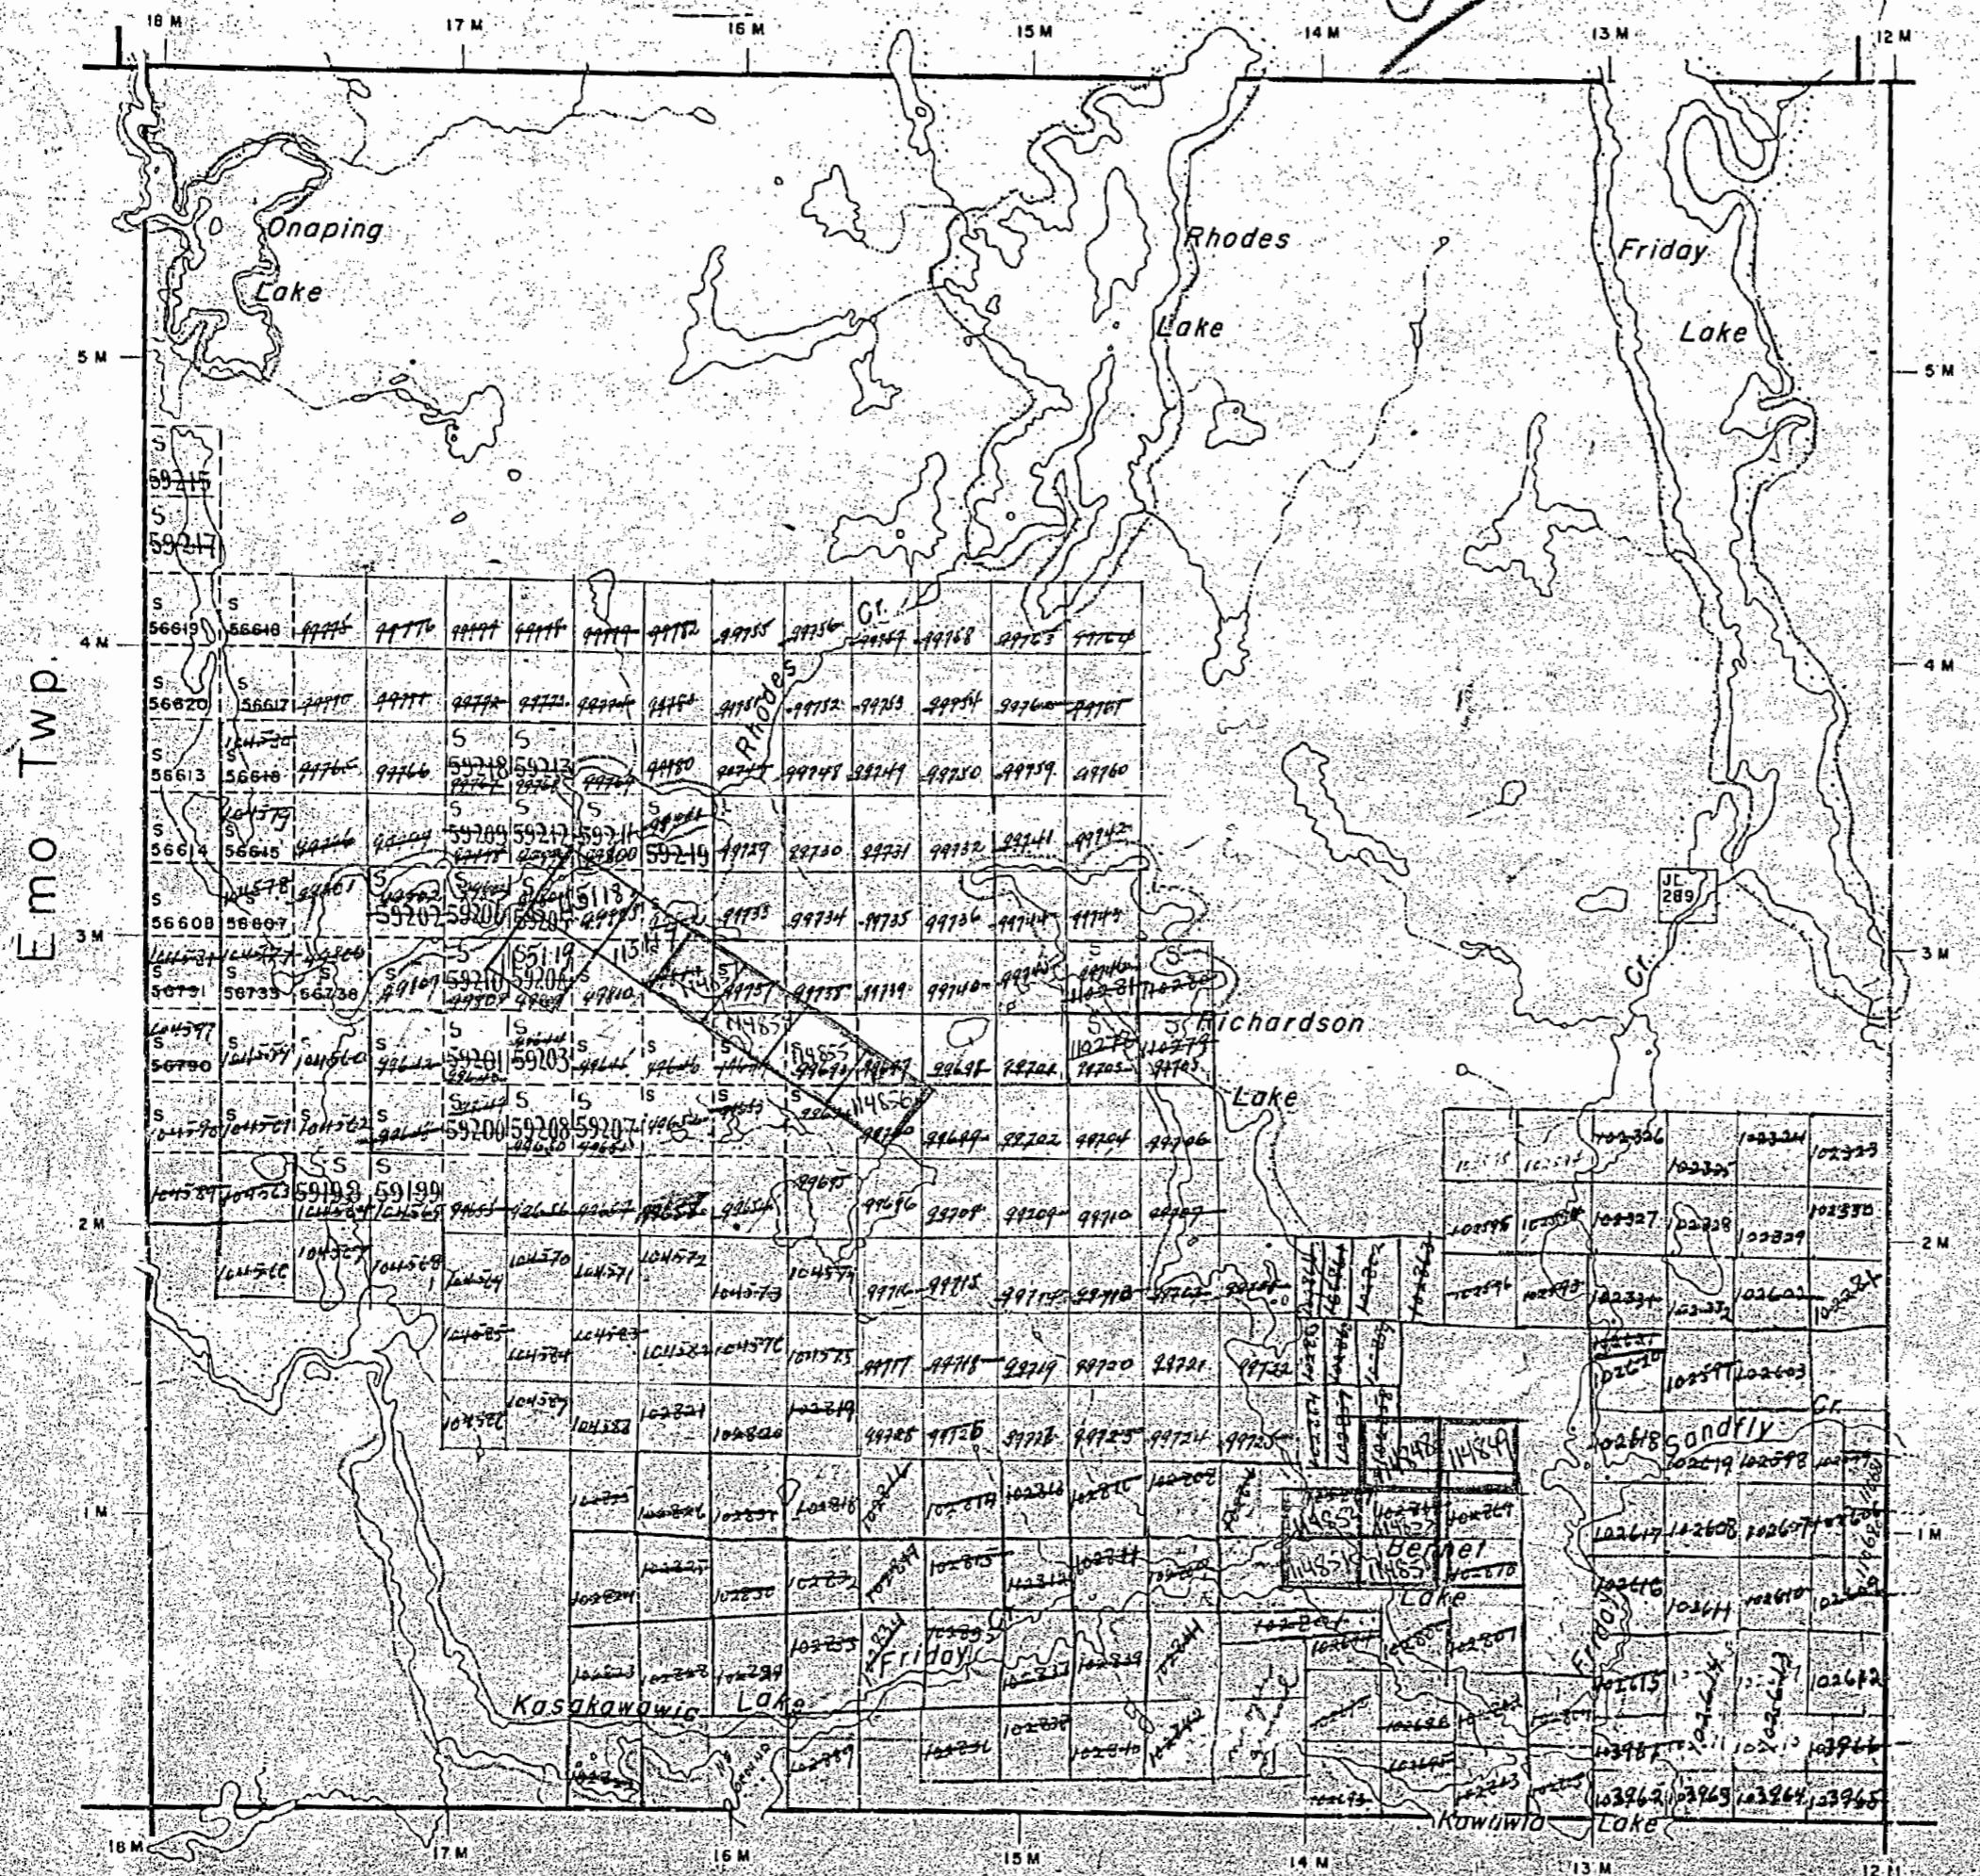

## Leinster Twp.

THE TOWNSHIP  
OF  
**RHODES**  
DISTRICT OF  
SUDBURY  
SUDBURY  
MINING DIVISION

## LEGEND

PATENTED LAND  
CROWN LAND SALE  
LEASES  
LOCATED LAND  
LICENSE OF OCCUPATION  
KING'S HIGHWAYS  
IMPROVED ROADS  
ROADS  
RAILWAYS  
POWER LINES  
MINES  
MARSH OR MUSKEG

## NOTES

440' NOTES  
200' reservation to Dept. of Lands & Forests  
shown thus: [diagram]

Flooding to elevation 111, (L.O. 6133) shown thus:

Mining Locations which have been cancelled  
have been removed from this plan under the  
Surveyor General's instructions.

— 400' R

M1077

PLAN NO.—S. 436

DEPARTMENT OF MINES  
—ONTARIO—

1077

Dunbar Twp.

THE TOWNSHIP  
OF

# RHODES

DISTRICT OF  
SUDBURY


SUDBURY  
MINING DIVISION

SCALE 1-INCH = 40 CHAINS

LEGEND

PATENTED LAND  
CROWN LAND SALE  
LEASES  
LOCATED LAND  
LICENSE OF OCCUPATION  
KING'S HIGHWAYS  
IMPROVED ROADS  
ROADS  
RAILWAYS  
POWER LINES  
MINES  
MARSH OR MUSKEG
 
## NOTES

+100' reservation to Dept. of Lands & Forests  
shown thus: 

Flooding to elevation 111', (L.O. 6133) shown thus:

Mining Locations which have been cancelled have been removed from this plan under the Surveyor General's instructions.


## Leinster Twp.

PLAN NO.—M-1077

DEPARTMENT OF MINES  
—ONTARIO—


1077

## Dunbar Twp.

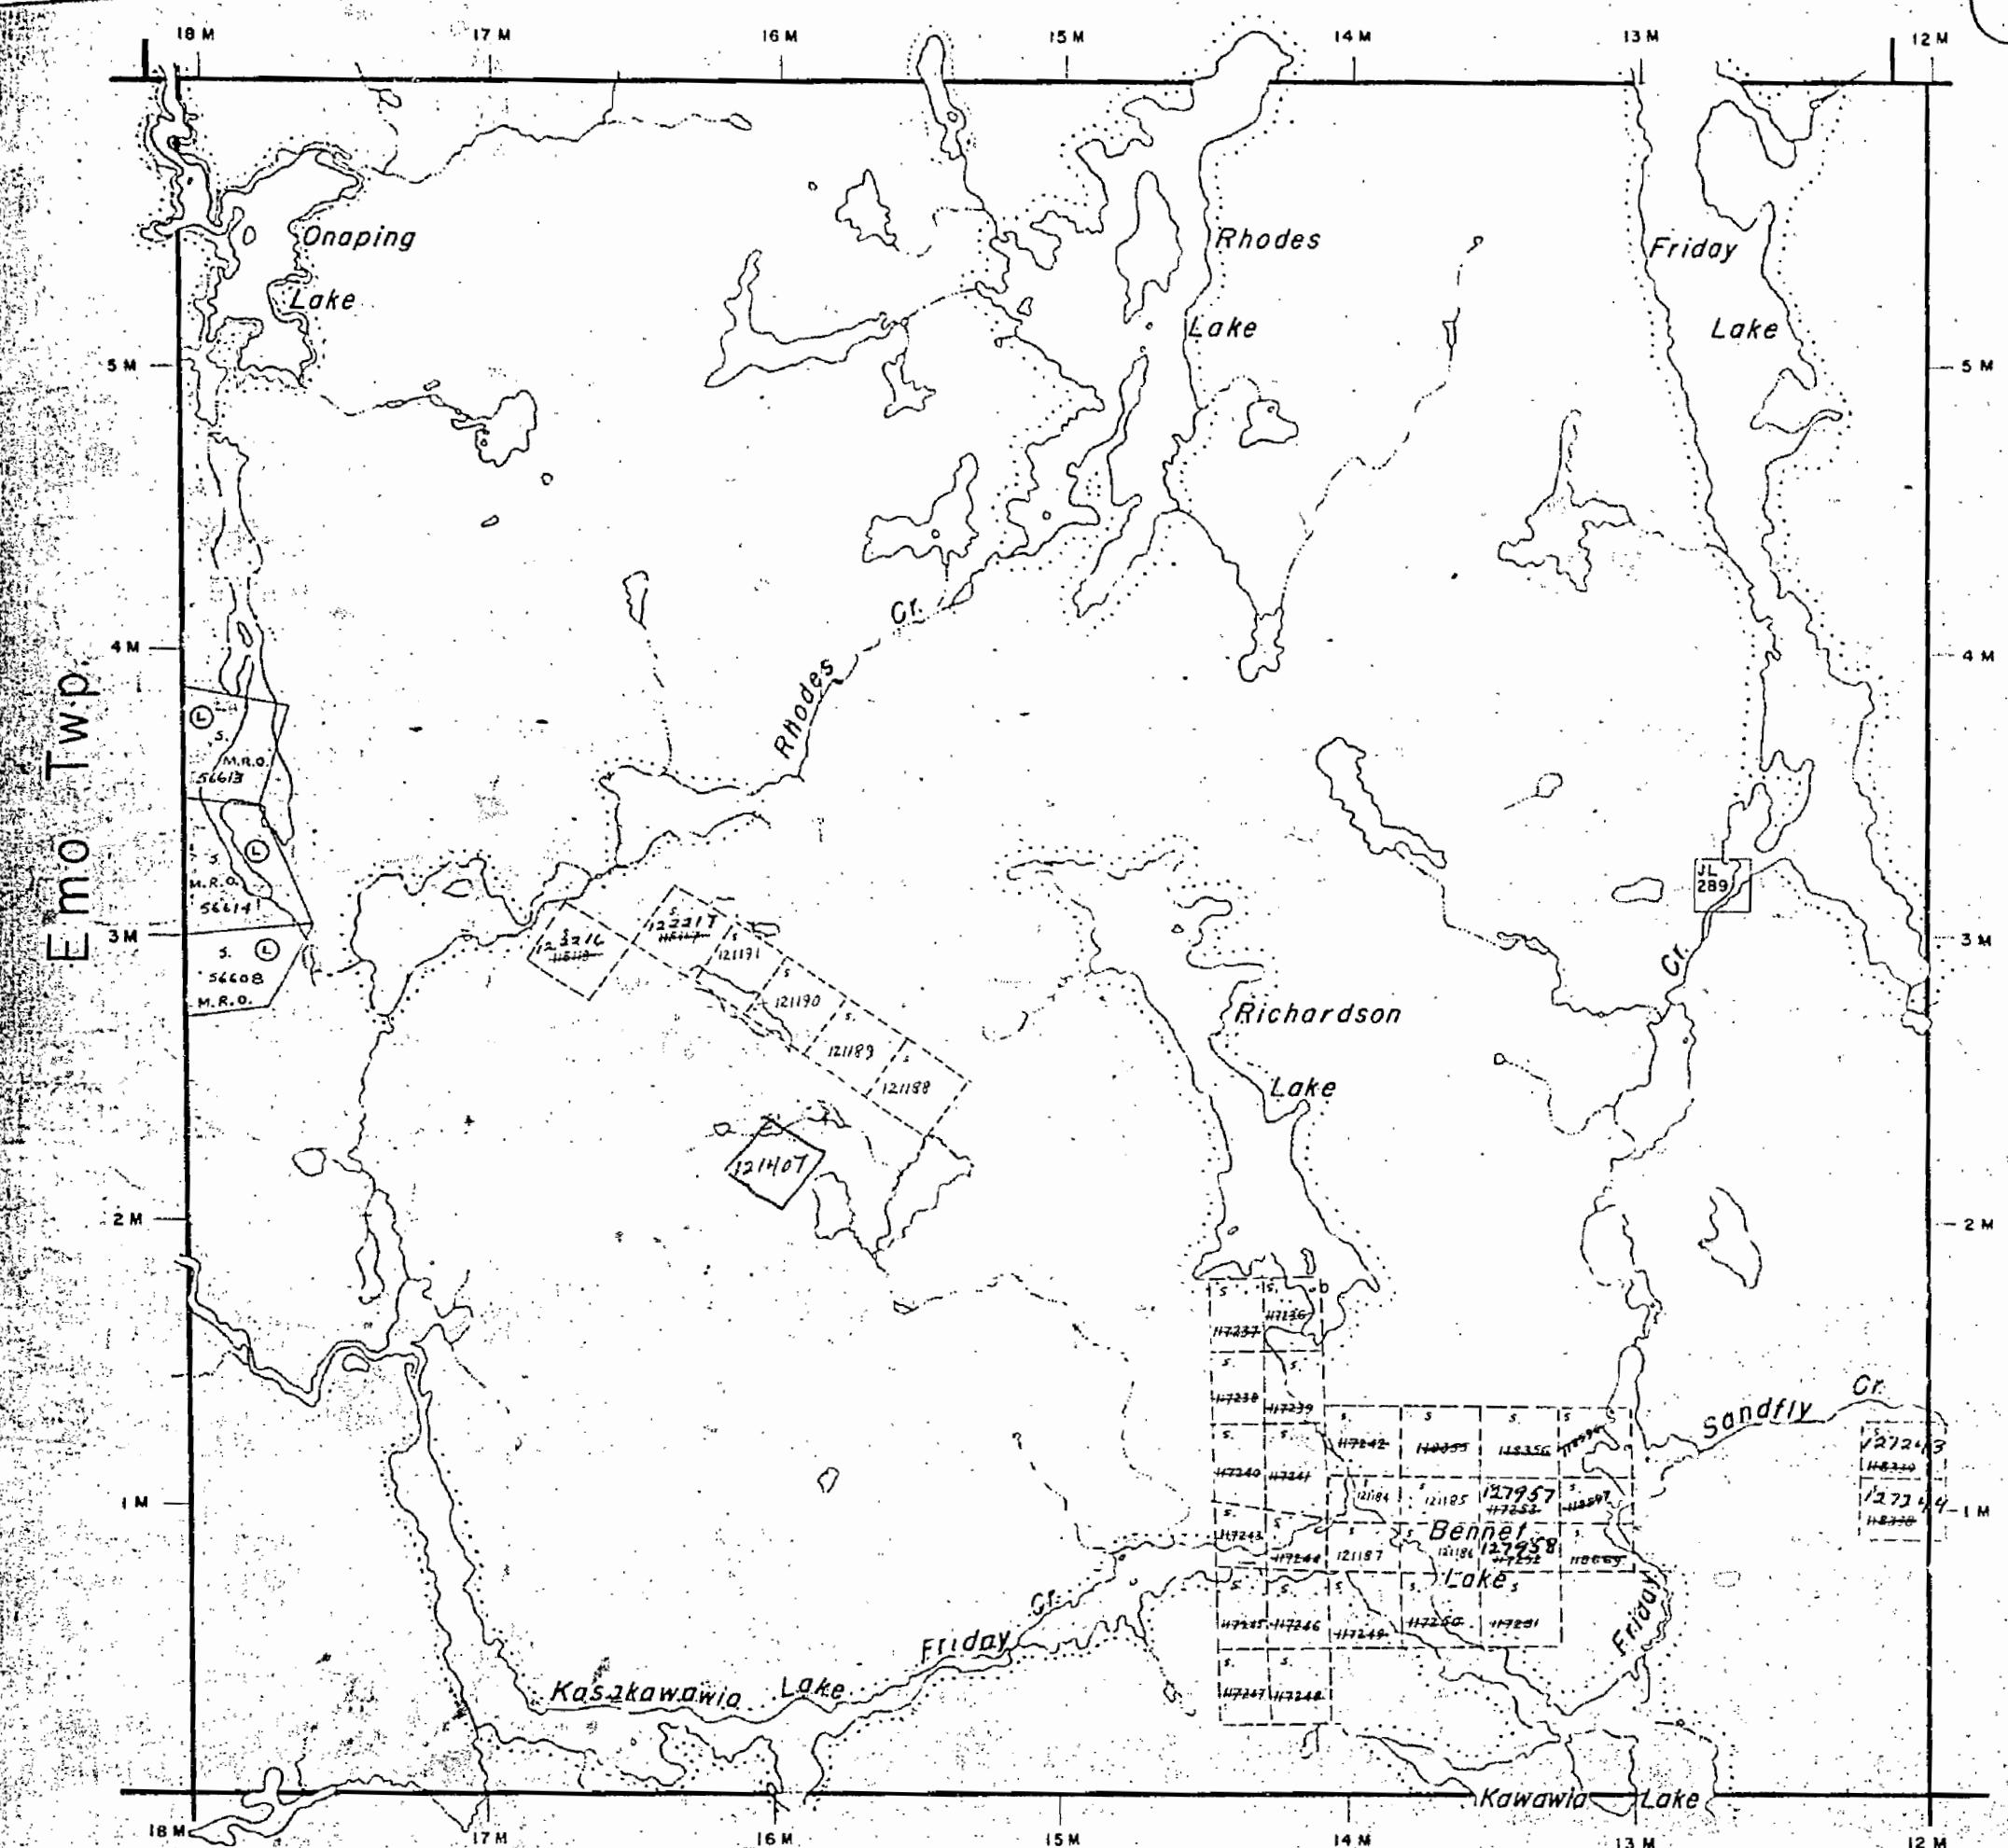

1077

Dunbar Twp.

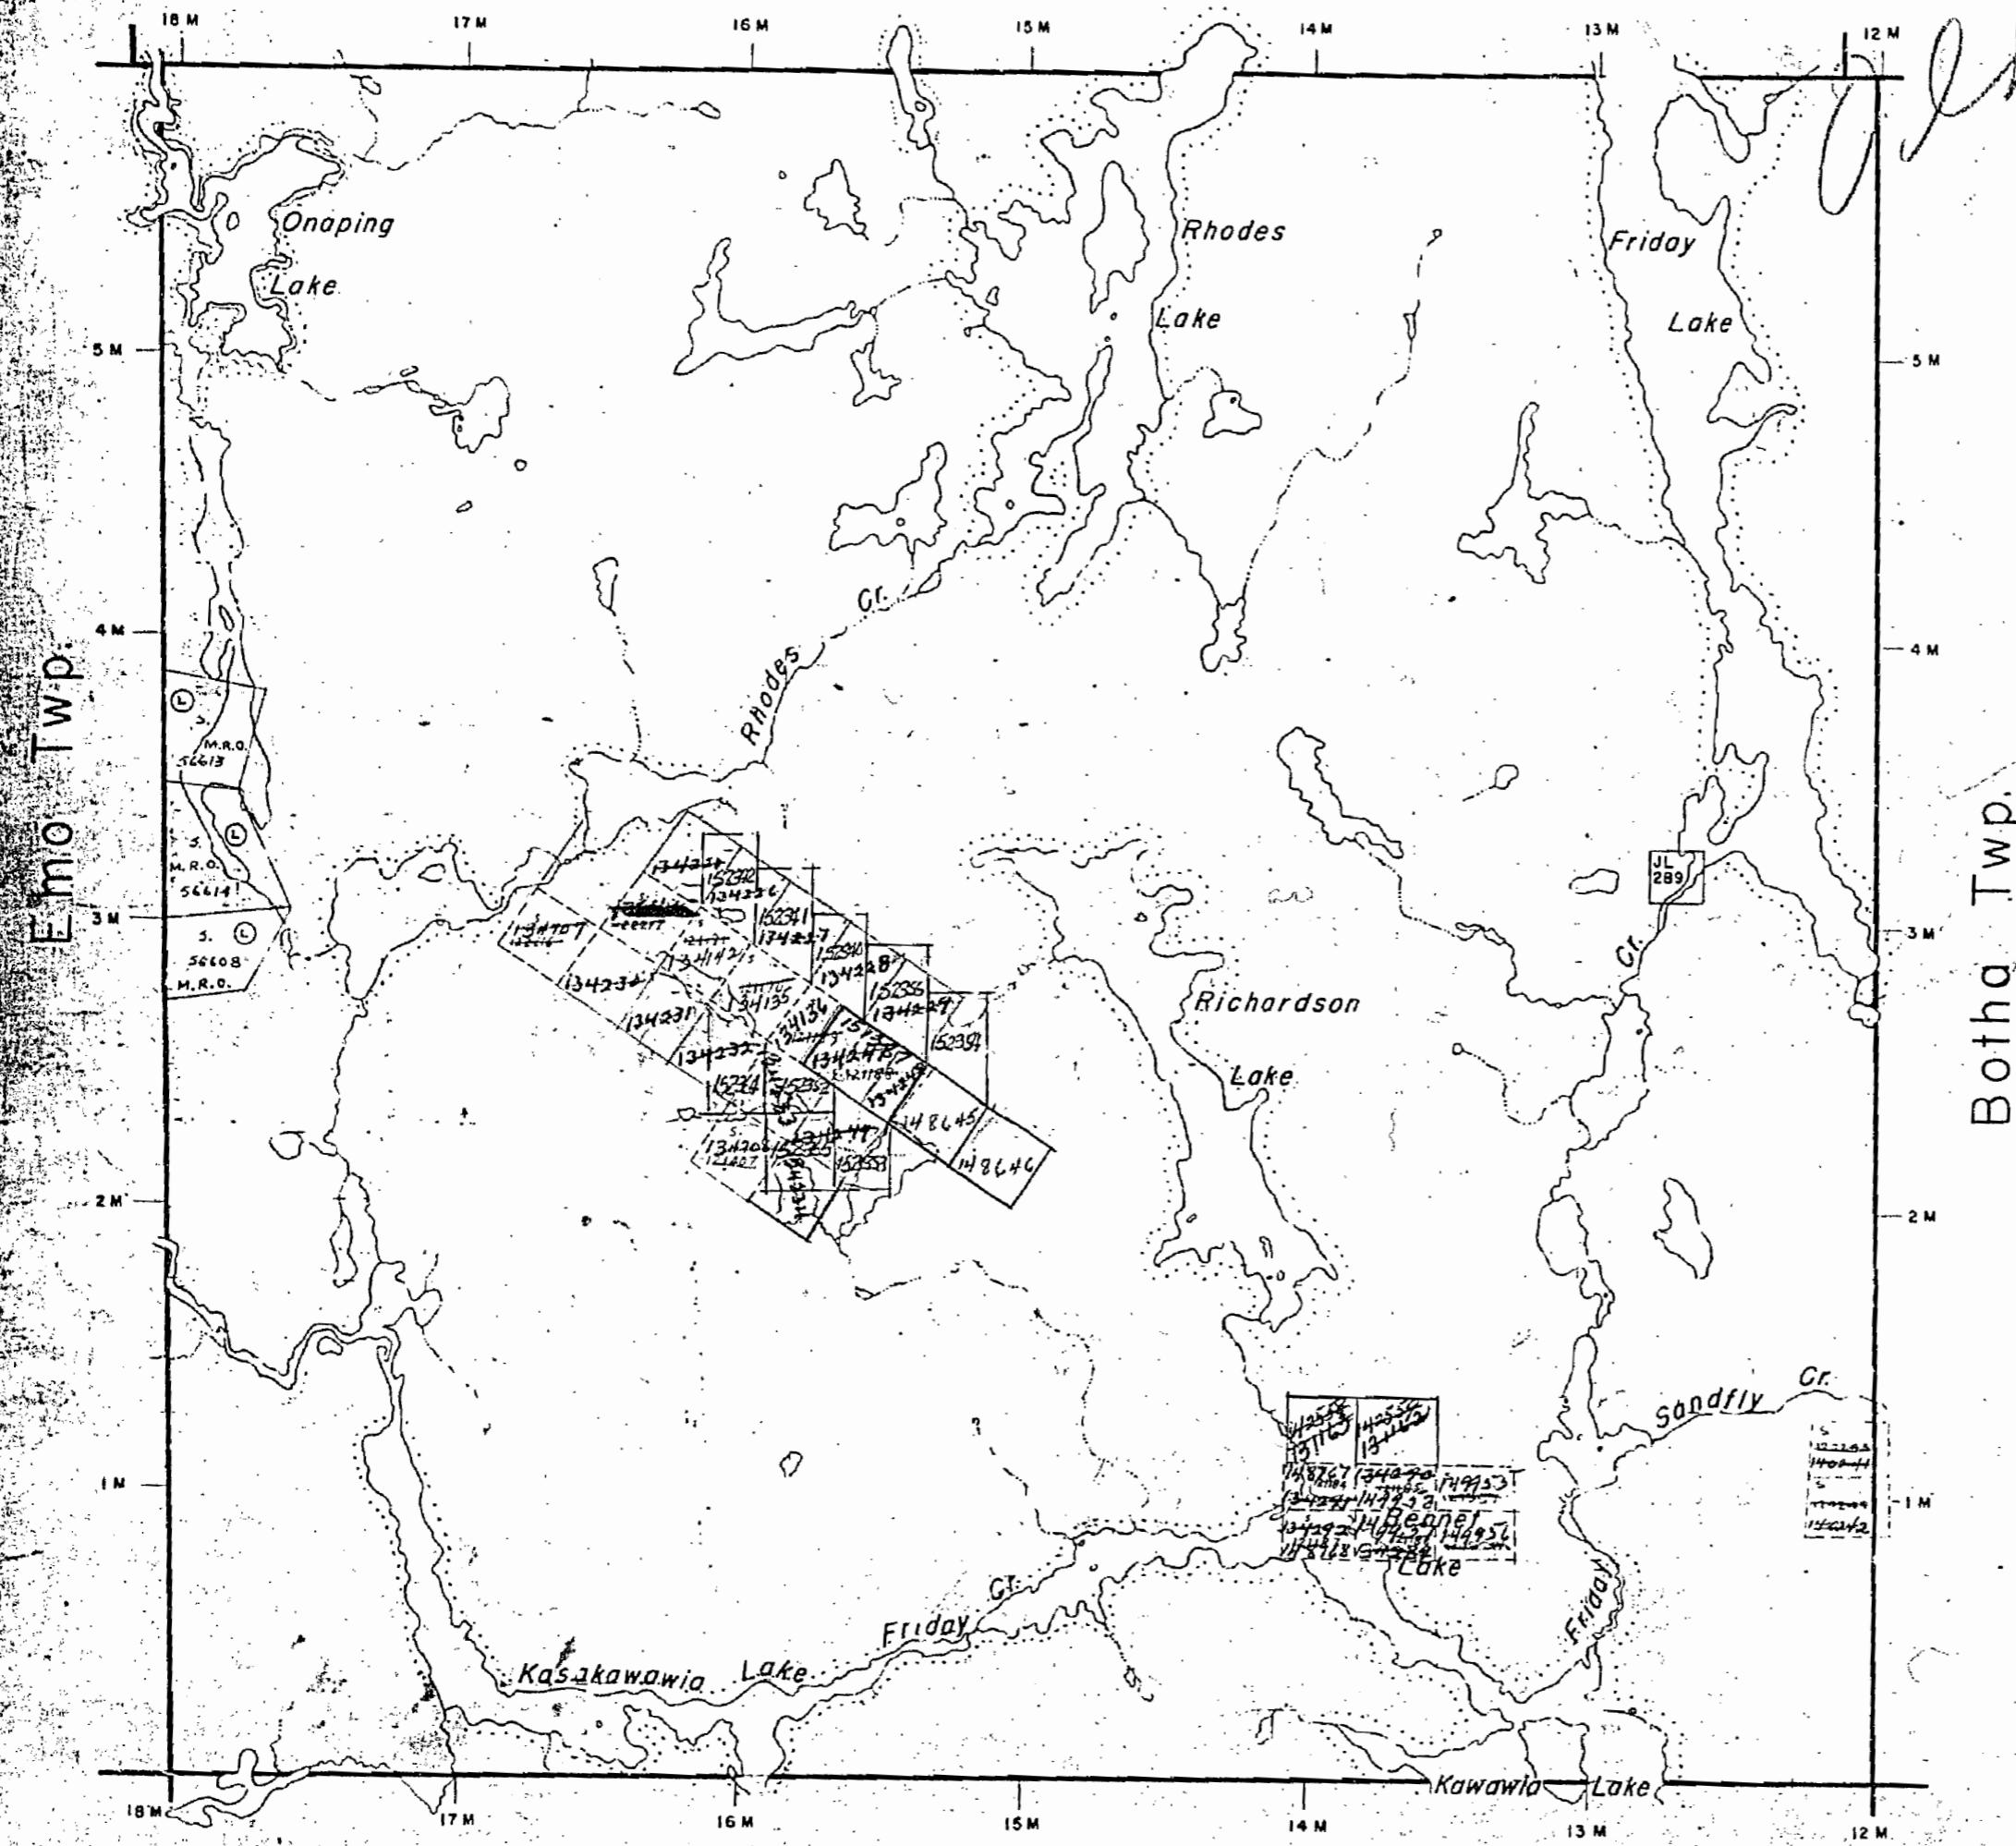

## Leinster Twp.

THE TOWNSHIP OF

# RHODES

DISTRICT OF  
SUDBURY

SUDSBURY  
MINING DIVISION

SCALE: 1 INCH = 40 CHAINS

LEGEND.

PATENTED LAND  
CROWN LAND SALE  
LEASES  
LOCATED LAND  
LICENSE OF OCCUPATION  
KING'S HIGHWAYS  
IMPROVED ROADS  
ROADS  
RAILWAYS  
POWER LINES  
MINES  
MARSH OR MUSKEG

## NOTES.

400' surface rights reservation around all lakes & rivers.

Flooding to elevation 111', (L.O. 6133) shown thus:

Mining Locations which have been cancelled  
have been removed from this plan under the  
Surveyor General's instructions.


July 3, 1888

PLAN NO.-M-1077

**DEPARTMENT OF MINES  
—ONTARIO—**

1077

## Dunbar Twp.

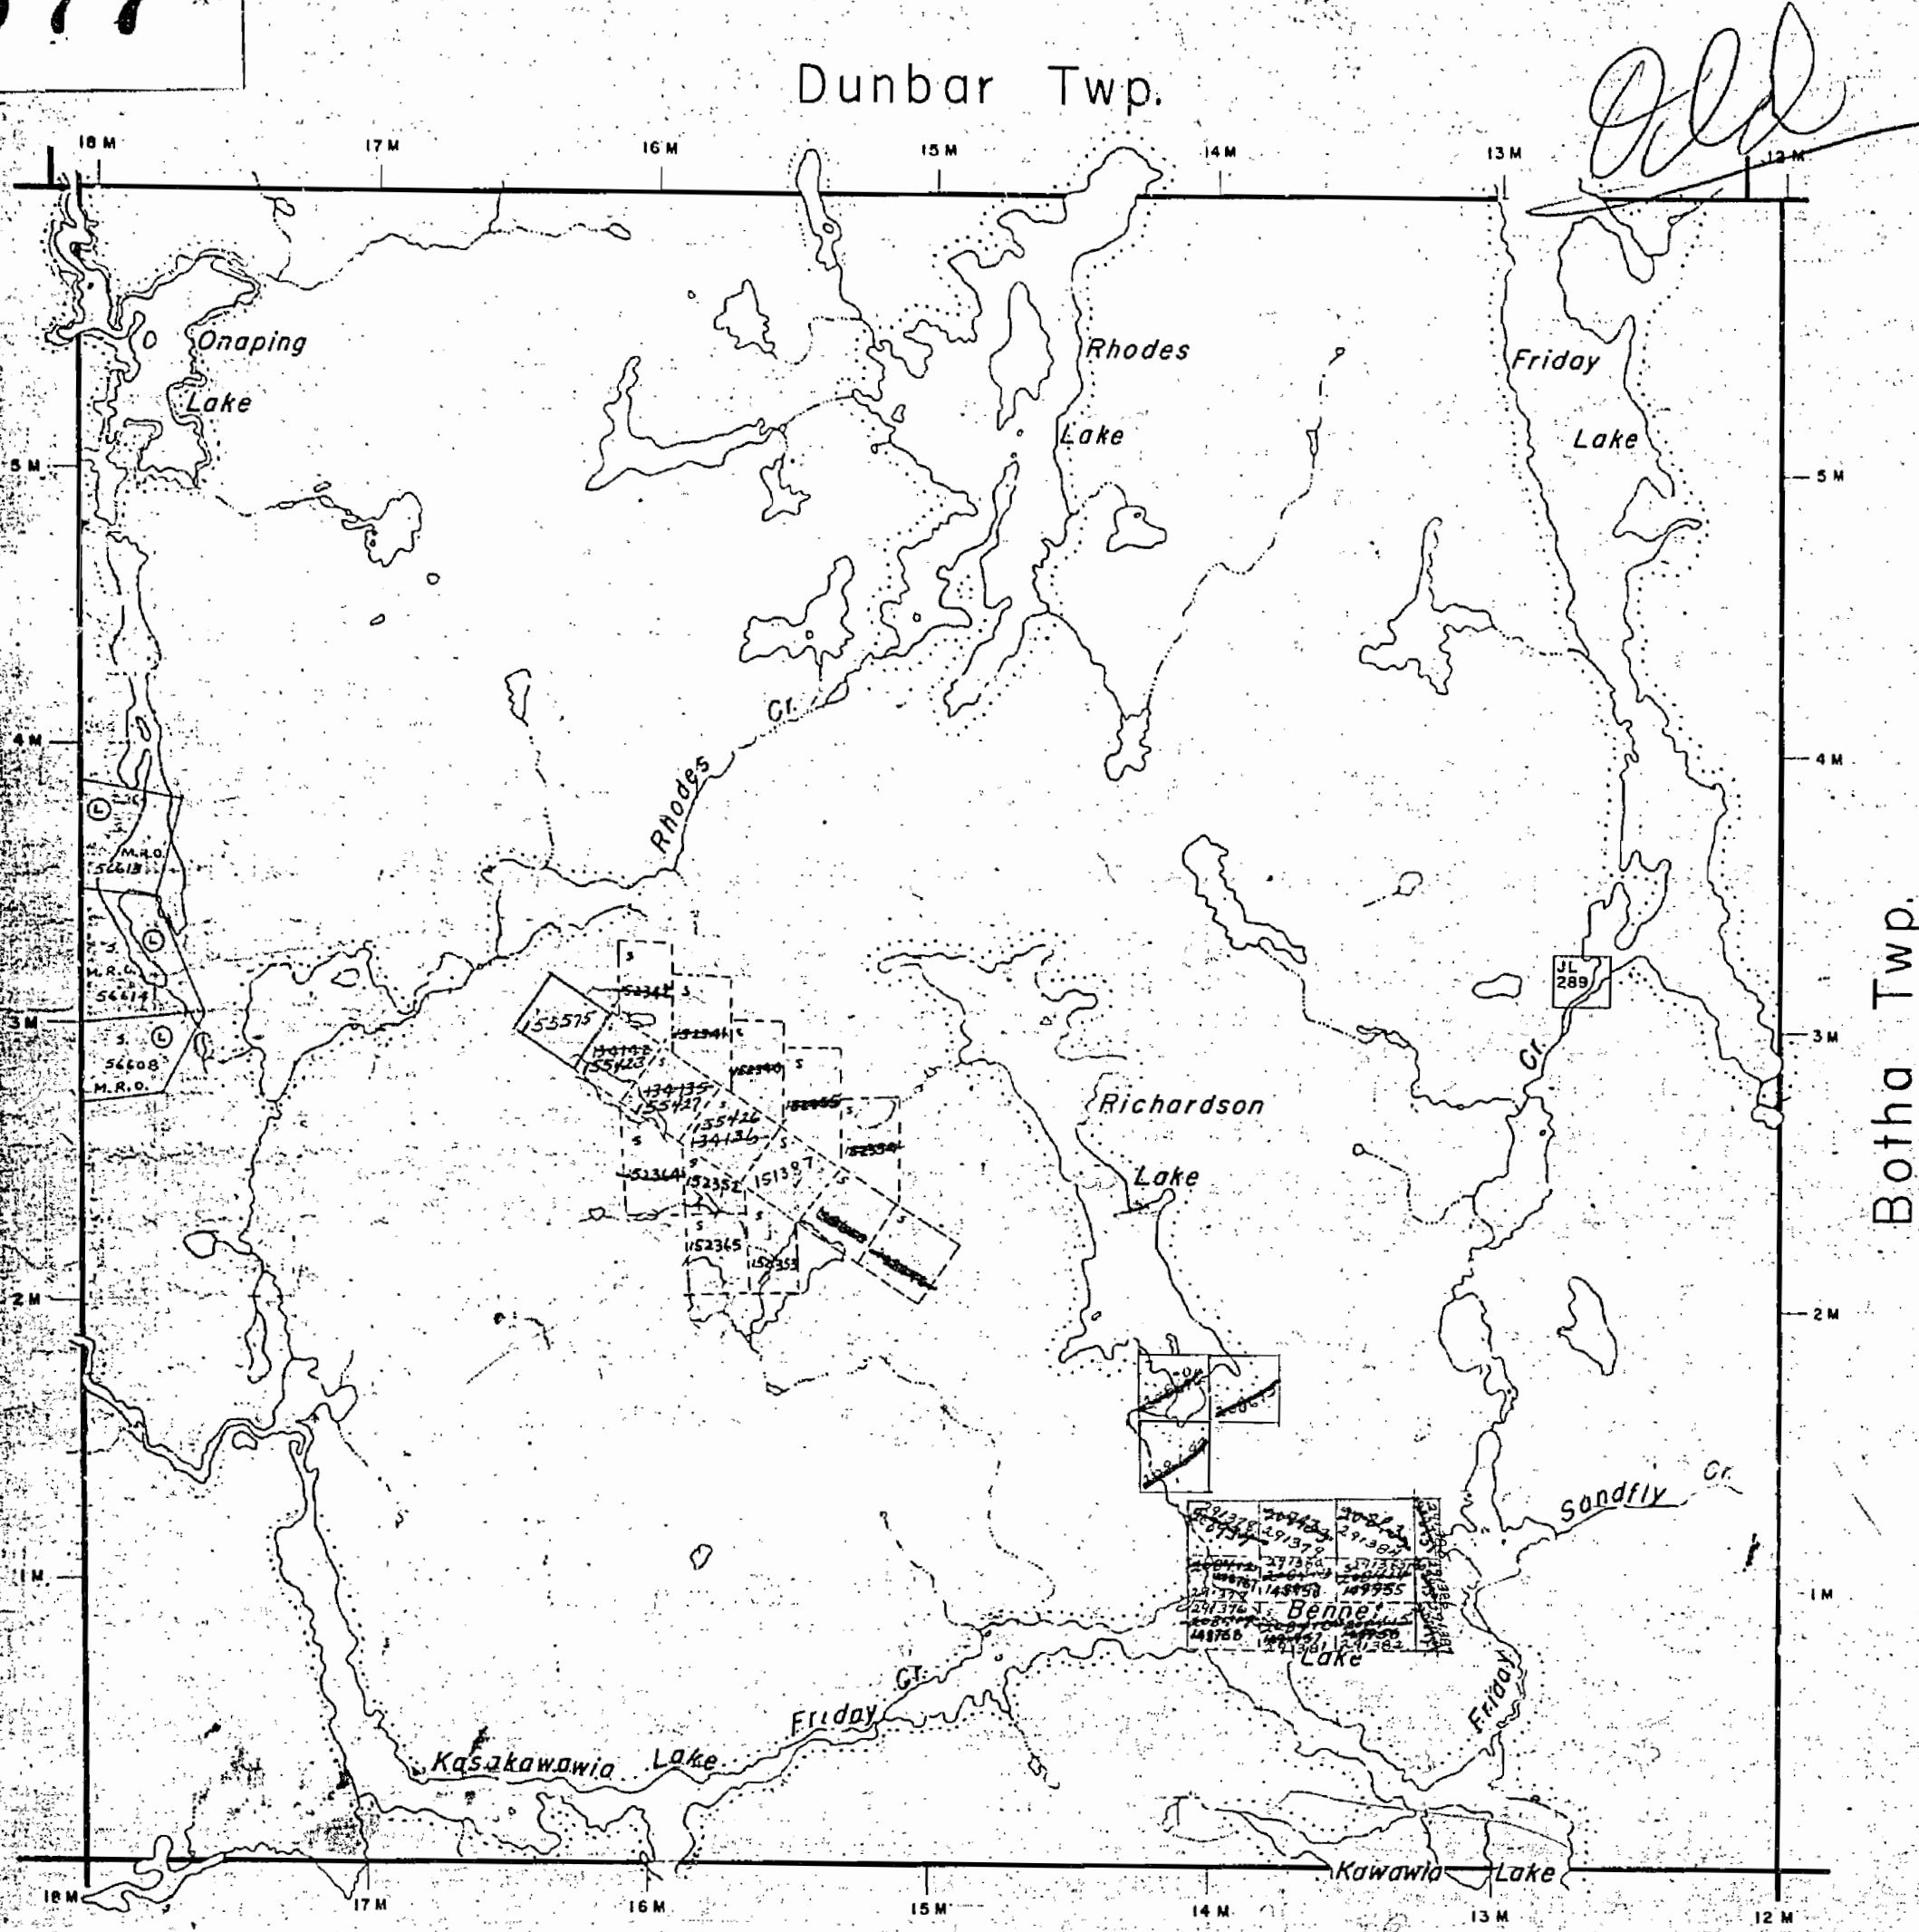

THE TOWNSHIP  
OF  
**RHODES**  
DISTRICT OF  
SUDBURY  
SUDBURY  
MINING DIVISION  
ALE : - INCH = 40 CHA

LEGEND

PATENTED LAND  
CROWN LAND SALE  
LEASES  
LOCATED LAND  
LICENSE OF OCCUPATION  
KING'S HIGHWAYS  
IMPROVED ROADS  
ROADS  
RAILWAYS  
POWER LINES  
MINES  
MARSH OR MUSKEG

## NOTES

400' surface rights reservation around all lakes & rivers.

Flooding to elevation 11 ft. (L.O. 6133) shown thus:

**Mining Locations which have been cancelled  
have been removed from this plan under the  
Surveyor General's instructions.**


PLAN NO - M-1077

DEPARTMENT OF MINES  
—ONTARIO—



OFFICE USE ONLY

DUNBAR TWP. M.768

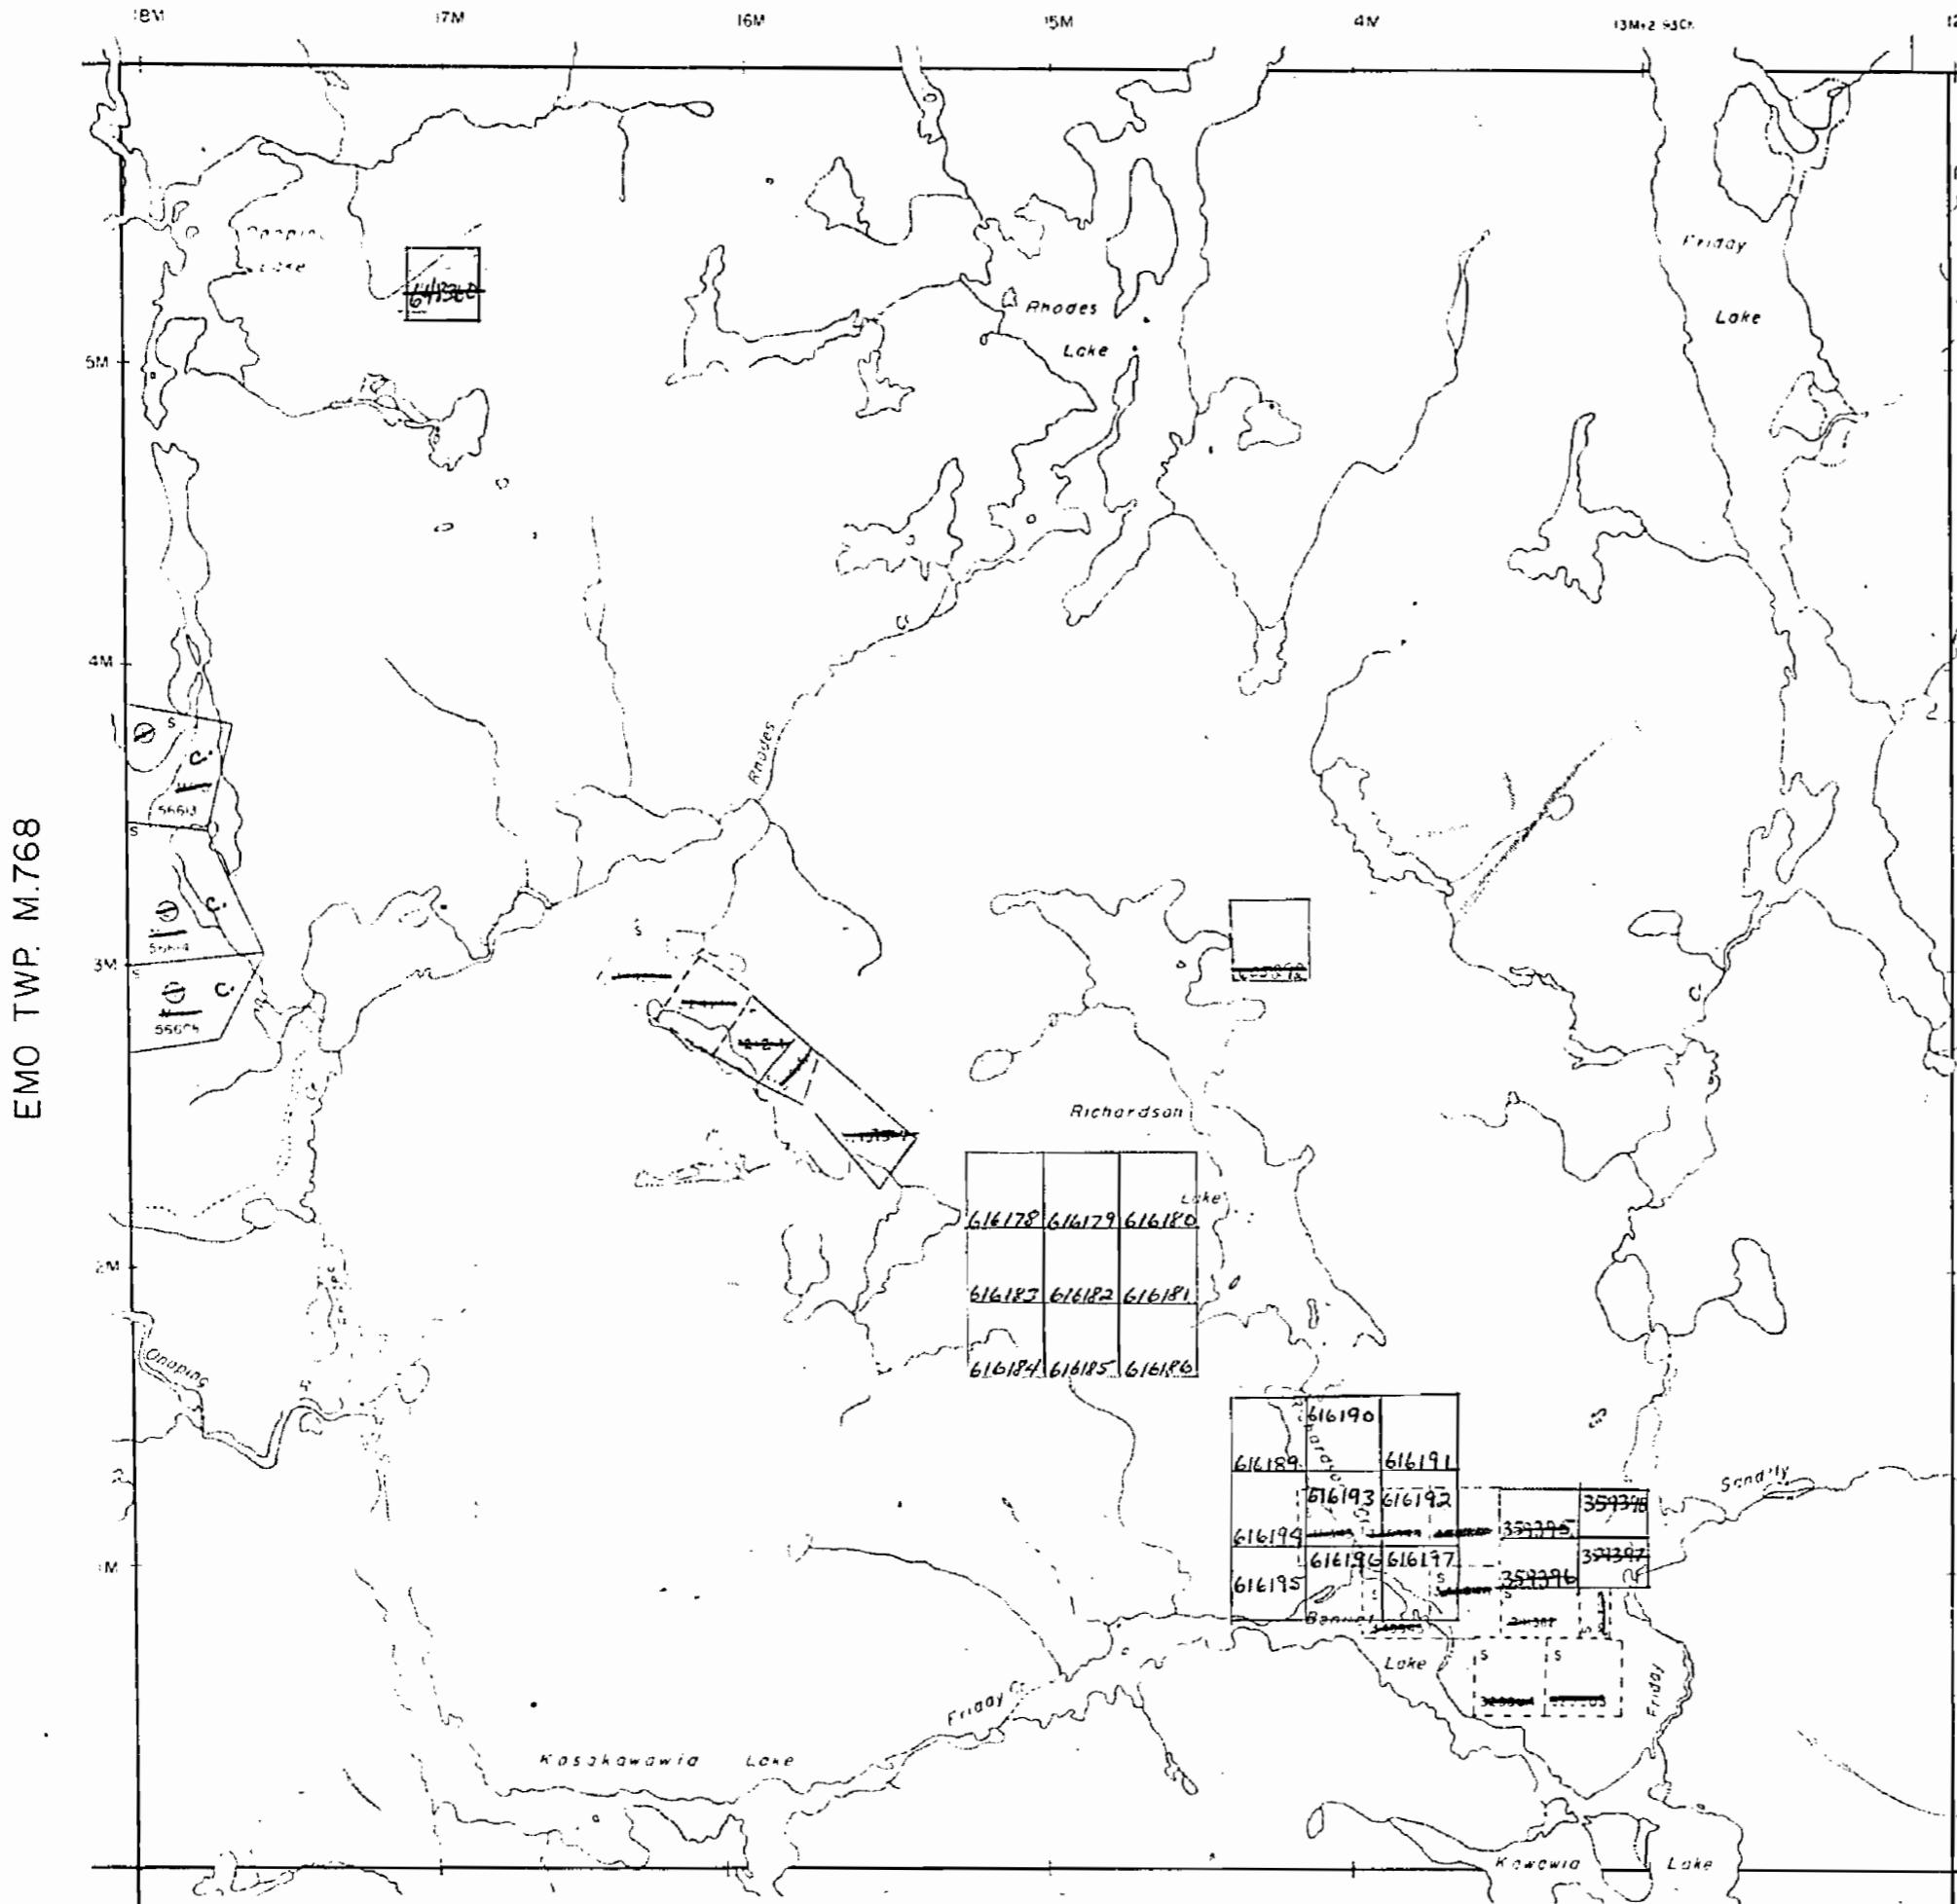

LEINSTER TWP. M.985

THE TOWNSHIP  
OF

RHODES

DISTRICT OF  
SUDBURY

SUDBURY  
MINING DIVISION

SCALE: 1-INCH 40 CHAINS

LEGEND

- PATENTED LAND
- CROWN LAND SALE
- LEASES
- LOCATED LAND
- LICENSE OF OCCUPATION
- MINING RIGHTS ONLY
- SURFACE RIGHTS ONLY
- ROADS
- IMPROVED ROADS
- KING'S HIGHWAYS
- RAILWAYS
- POWER LINES
- MARSH OR MUSKEG
- MINES
- CANCELLED




BOTHA TWP. M.674

NOTES

400' surface rights reservation around the shores of all lakes and rivers

Floating rights to elevation III' on Onaping Lake (L.O.6133) - File 9214

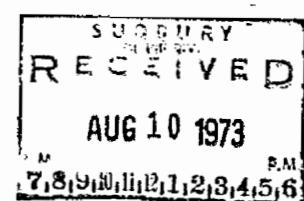

RHODES

PLAN NO. M-1077

MINISTRY OF NATURAL RESOURCES

SURVEYS AND MAPPING BRANCH

1981

THE TOWNSHIP  
OF


## RHODES

DISTRICT OF  
SUDBURYSUDBURY  
MINING DIVISION

SCALE: 1-INCH = 40 CHAINS

## LEGEND

PATENTED LAND  
CROWN LAND SALE  
LEASES  
LOCATED LAND  
LICENSE OF OCCUPATION  
MINING RIGHTS ONLY  
SURFACE RIGHTS ONLY  
ROADS  
IMPROVED ROADS  
KING'S HIGHWAYS  
RAILWAYS  
POWER LINES  
MARSH OR MUSKEG  
MINES  
CANCELLED

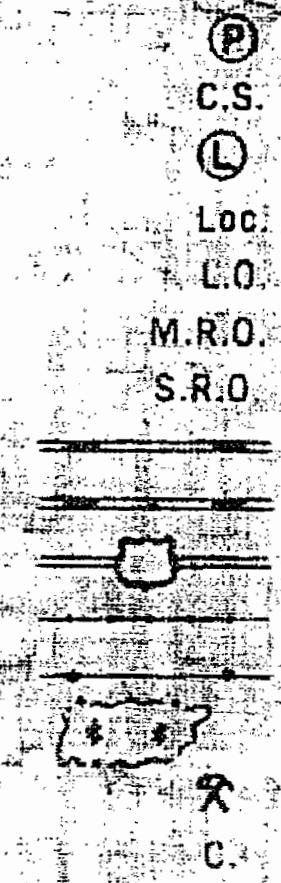

## NOTES


400' surface rights reservation around  
the shores of all lakes and rivers

Flooding rights to elevation III on  
Onaping Lake (L.O.9113) - File 9214

\* IN SERVICE 1981 - NOV

EMO TWP. M.768

DUNBAR TWP. M.768

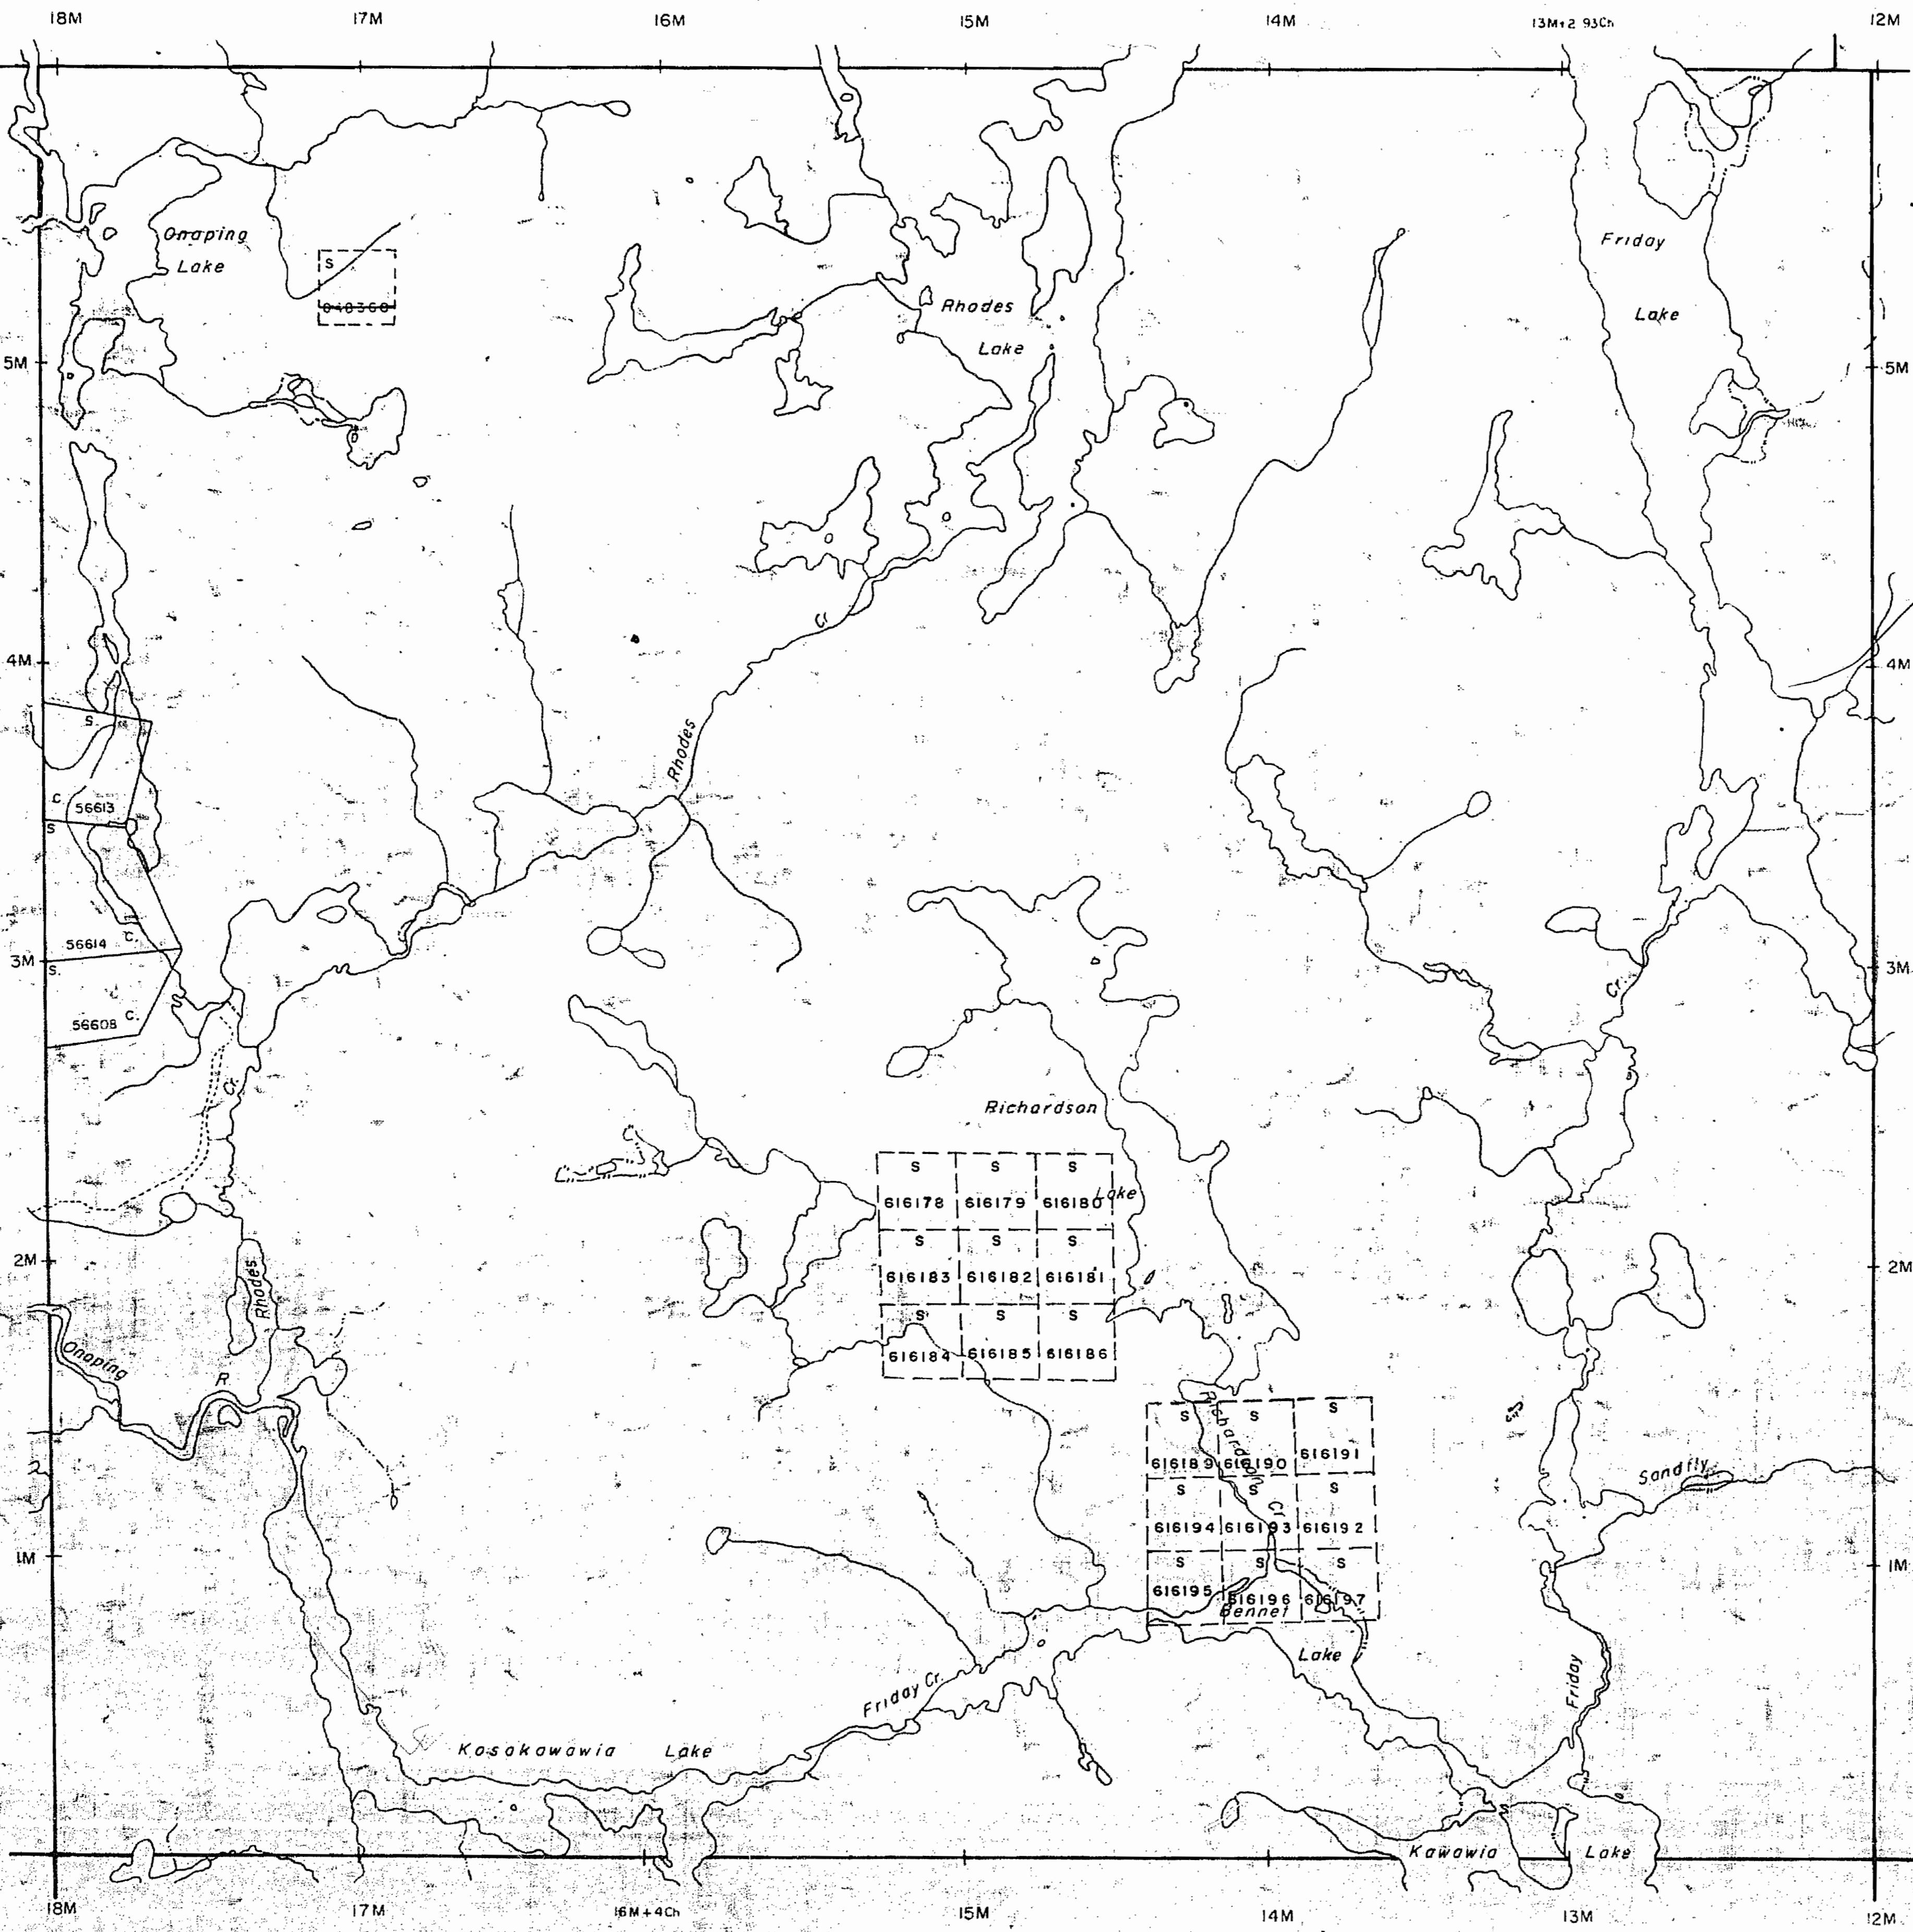

LEINSTER TWP. M.985

PLAN NO. M-1077

ONTARIO

MINISTRY OF NATURAL RESOURCES  
SURVEYS AND MAPPING BRANCH