



31M04NE0055 11 BEST

010

## Diamond Drilling

Township of Best

Report NO: 11

Work performed by: J. H. Sutherland

Claim NO	Hole NO	Footage	Date	Note
T 45436	2	111'	Oct/60	

Notes:

TUS436



Buck Trap

Hole

100 yds


See Pitts  
how

James Hill Road

No 11 Highway

12th Ave Road

N

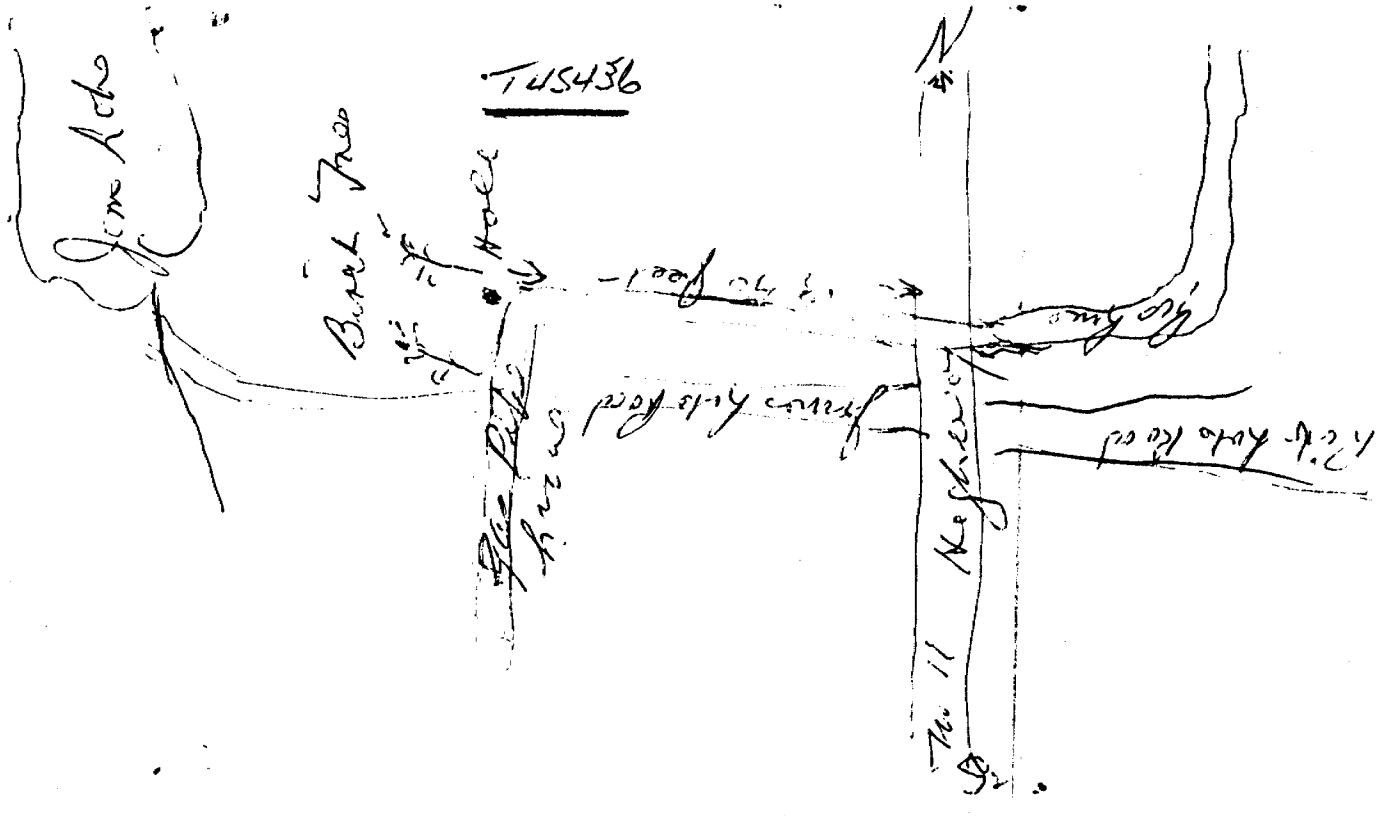

# DIAMOND DRILL RECORD

Hole No. 2 Sheet No. 1

Property WJSD 36 GILLES LIMIT  
 Location James Lake  
 Latitude \_\_\_\_\_  
 Departure \_\_\_\_\_  
 Bearing \_\_\_\_\_

Dip \_\_\_\_\_  
 \_\_\_\_\_  
 \_\_\_\_\_  
 Total Footage 111 feet

Elev. Collar \_\_\_\_\_  
 Datum \_\_\_\_\_  
 Date Started 12 Oct 1960  
 Date Completed 19 Oct 1960  
 Drilled by J. Sutherland  
 Logged by \_\_\_\_\_

Footage		Formation	Sample Number	Sample Footage	Sample Width	Gold Sample	Gold Sludge	Remarks
From	To							
0'	10.2	Kewatin - medium gray fine carb. stringers.						
10.2	11.0	Fine grain Silicious						
11.0	12.4	Highly altered-very silicious. Carbonated.						
12.4	26.2	Fine to medium grained- <del>numerous</del> fine carbonated stringers.						
26.2	60.8	Graywacke contact-green med.grained slightly schisted-1" quarts stringer at 45.8' contains some chalco pyrite.						
60.8	61.3	Broken core highly altered.						
61.3	68.1	Graywacke very slightly schisted fine carbonated stringers.						
68.1	72.4	Brecciated sheared section some pyhotite.						
72.4	75.6	Graywacke slightly schisted.						
75.6	76.6	Quartz carbonated stringer.						
76.6	93.0	Graywacke slightly schisted -very slightly mineralized with pyrotite.						
93.0	94.4	Graywacke altered carbonated slightly mineralized with chalco pyrite.						
94.4	96.0	<del>Lost core</del> . Lost core - samples in Toronto.						
96.0	97.2	<del>Lost core</del> core. samples in Toronto.						
97.2	98.0	<del>Lost core</del> core. samples in Toronto.						
98.0	100.00	Graywacke broken core slightly mineralized chalco pyrite.						
100.0	108.8	Lost core.						
108.8	111.0	Graywacke carbonated some chalco pyrite, associated with carbonates.						

Date of Examination \_\_\_\_\_

*J. Sutherland*