



31M04SE0018 16 CASSELS

010

Diamond Drilling

Township of CASSELS

Report No 16

Work performed by: Aldage Mines Limited

Claim No	Hole No	Footage	Date	Note
T 52656	1	50.0'	1964	
	2	101.0'	1964	
	4	101.0'	1964	
	5	116.0'	1964	
	6	116.0'	1964	
	7	101.0'	1964	
	8	102.0'	1964	
	9	101.0'	1964	

8/788'

Notes:

REPORT OF DIAMOND DRILLING DONE ON PROPERTY OF

ALDAGE MINES LIMITED

TIMISKAMING MINING DIVISION, ONTARIO

G.L. Kirwan  
September 21, 1964

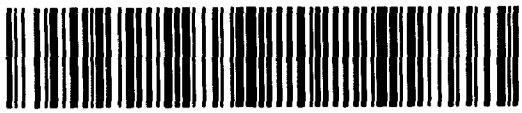


TABLE OF CONTENTS

	Page
PURPOSE OF REPORT .....	1
PROPERTY .....	1
HISTORY .....	2
DIAMOND DRILLING .....	2
DIAMOND DRILL RESULTS .....	3
CONCLUSIONS .....	4
RECOMMENDATIONS .....	4

REPORT OF DIAMOND DRILLING DONE ON PROPERTY OF

ALDAGE MINES LIMITED

TIMISKAMING MINING DIVISION, ONTARIO

PURPOSE OF REPORT:

The report contained herein evaluates the results of a diamond drill program carried out on the Timagami, Ontario, property of Aldage Mines Limited.

PROPERTY:

Locations: Aldage Mines Ltd. is the recorded holder of 22 mining claims situated adjoining Cassel's Lake in the central portion of Cassel's Township, District of Nipissing, Timiskaming Mining Division, Province of Ontario.

Access: From Zimmerman's Camps situated one-half mile east of the townsite of Timagami, Ontario, a four mile water route northeast over Smoke Lake and Cassel's Lake affords the easiest access. Float-equipped or ski-equipped charter aircraft operate from Timagami.

Claim Groups: Consisting of 22 unpatented, contiguous, mining claims in one block approximately  $1\frac{1}{2}$  miles square, the Aldage group of claims may be described as follows:

T 52656 - 659 incl.	4 claims
T 53370 - 371 incl	2 "
T 52456 - 466 incl.	11 "
T 53542 - 546 incl.	5 "
	<u>22 claims</u>

Company records indicate these mining claims are in good standing with the Ontario Department of Mines.

D. J. K.

The report contained herein covers diamond drilling done on mining claims numbered T 53370 and T 52461.

HISTORY:

Originally the Aldage group consisted of six mining claims staked in 1961 on the north shore of Cassel's Lake. This group is overlain by Gosselin Lake. Since that time, another 16 mining claims have been added to the group on the west and north.

During the summer of 1963, a geological and prospecting program was carried out on the original 6 claim group. In the summer of 1964, the remaining 16 claim group was geologized and prospected.

During the 1963 program, various aplite structures occupying shear zones were noted and some of these zones contained narrow but substantial veins of chalcopyrite notably in claim No. T 53370 on the west shore of Gosselin Lake.

Subsequently, the most prominent structure was trenched for a distance of 113' to a depth of 6' and it was observed that the chalcopyrite vein increased in width with depth. Sampling for assay purposes proved the presence of commercial grade copper associated with interesting amounts of silver.

Because of the importance of the copper-silver values and because the aplite structure carrying the chalcopyrite vein showed strong continuity along a shear zone, short probe diamond drilling was recommended in order to ascertain the below groundlevel continuity, thickness, attitude and proponderance of the vein as well as to determine the copper-silver values that may occur below the trenched area.

DIAMOND DRILLING:

The diamond drill program was begun June 20, 1964, and terminated

JKK

September 7, 1964.

Employing a Packsack diamond drill, a total of 788 ' of 7/8 inch core was removed for examination from a total of 8 diamond drill holes. These holes are numbered 1-9 incl. (see enclosed map and drill logs) Hole No. 3 was not drilled. All holes were between 101' - 116' with the exception of No. 1 hole which is 50' in length. Holes 4-7 incl. were collared on claim No. T 52461 while holes 1,2,8, and 9 were collared on claim No. T 53370. Drill holes 4-7 incl. and 9 have a magnetic bearing of 312 while holes 1,2, and 8 have a magnetic bearing of 130 . All holes were drilled at 45 dip from the horizontal.

Drill holes 1,2; 4-7 inclusive were placed in a position to examine below the trenched area and were drilled on each side of the aplite-chalcopyrite structure taking into consideration possible rake of the structure, while No. 8 hole was collared some 100' south southwest of D.D.H. No. 1 on a small chalcopyrite vein which could be the south extension of the main target area. No. 9 hole was collared some 220' south of D.D.H. No. 1 to similarly investigate a chalcopyrite surface show which is located at the south surface end of another but parallel aplite dike being 75' west of the target dike.

DIAMOND DRILL RESULTS:

Eleven core sections were removed for assay purposes, the maximum core length being 3". Of the samples, all were tested for silver content while 4 of the 11 were assayed for copper where chalcopyrite was evidenced. The silver results ranged from nil to a high of 2.28 ounces per ton with an average silver content of 0.57 ounces per ton over an average width of 1.6". Copper values ranged from 0.33% copper per ton to 21.35% with an average value of 10.10% copper per ton. The average width of the copper

A.K.

vein material is about one inch.

CONCLUSION:

Diamond drilling did not support previous surface indications. The aplite structure with the resident chalcopyrite vein appears to pinch out rapidly with depth. In most cases, the target aplite was not intersected.

Despite this, two copper veins were intersected that were not from the target aplite zone, notably in hole No. 5 and 8. These intersections indicate that copper veins do occur on the property in greater abundance than is evidenced on surface.

Because of the rapid pinching out of both the aplite and the copper vein material, it is unlikely that economic material would exist at greater depth than that arrived at under the Backpack drill program.

RECOMMENDATION:

Because of the lack of prominent copper intersections resulting from the diamond drill program and because of the negative results obtained from electro-magnetic and self-potential tests conducted by the writer over known chalcopyrite zones on the property, it is recommended that no further work be done on the claim group.

All of which is respectfully submitted,

*Gerald L. Kirwan*

Gerald L. Kirwan B.Sc., F.R.G.S.  
Advance Geology & Geophysics Ltd.

GLK/lk

September 21, 1964  
Willowdale, Ont.

# DIAMOND DRILL RECORD

Hole No. \_\_\_\_\_ Sheet No. 1

Property Aldage Mines Limited  
 Location Timagami, Ontario

	Dip
D.D.H. 1	45
D.D.H. 2	45
D.D.H. 3	Not drilled
D.D.H. 4	45
D.D.H. 5	45

Elev. Collar \_\_\_\_\_  
 Datum \_\_\_\_\_  
 Date Started \_\_\_\_\_  
 Date Completed \_\_\_\_\_  
 Drilled by Advance Geology & Geophysics Ltd.  
 Logged by G.L. Kirwan BSc

Latitude \_\_\_\_\_  
 Departure \_\_\_\_\_  
 Bearing 312° (DDH 1&2); 130° (DDH 4&5)

Total Footage Holes 1-5 incl.: 368'

silver copper

Footage		Formation	Sample Number	Sample Footage	Sample Width	<del>Gold</del> Sample	<del>Silver</del> sample	Remarks
From	To							
<u>DRILL HOLE 1</u>								
0	50	Diabase; Nipissing variety - even textured. Hole end.						
	23	1" calcite vein						
<u>DRILL HOLE 2</u>								
0	5	casing in sandy loam						
5	101	diabase; Nipissing variety. End of hole.						
	29'6"	1" calcite vein with chalcopyrite (minor)	1	29'6"	1"	1.40 oz.	0.33%	
	53'0"	1.5" quartz-calcite stringer	2	53'0"	2"-1.5"	0.16 oz.		
<u>DRILL HOLE 3 (not drilled)</u>								
<u>DRILL HOLE 4</u>								
0	6	casing						
6	101	diabase; Nipissing variety. End of hole.						
	17	1" calcite stringer						
	33	2" calcite stringer						
	42	1.5" calcite stringer						
	48	3" aplite vein						
	67	calcite vein (1")	3	67'0"	1"	0.38 oz.		
<u>DRILL HOLE 5</u>								
0	7	casing						
7	116	diabase; Nipissing variety. End of hole.						
	15	1" chalcopyrite vein	4	15	1"	2.28 oz.	21.35%	
25	40	15' aplite, pink, even textured, minor chalcopyrite						
	37	1" chalcopyrite vein	5	37	1"	1.26 oz.	10.50%	
	65	2" aplite-quartz-calcite						

Date of Examination September 10, 1964

*Gerald L. Kirwan*



# DIAMOND DRILL RECORD

Hole No. \_\_\_\_\_ Sheet No. \_\_\_\_\_

Property Aldage Mines Limited  
 Location Timagami, Ont.  
 \_\_\_\_\_  
 \_\_\_\_\_  
 Latitude \_\_\_\_\_  
 Departure \_\_\_\_\_  
 Bearing DDH 6-9 incl. 130

D.D.H. 6	45
D.D.H. 7	45
D.D.H. 8	45
D.D.H. 9	45

Total Footage Holes 6-9 incl.: 420'

Elev. Collar \_\_\_\_\_  
 Datum \_\_\_\_\_  
 Date Started \_\_\_\_\_  
 Date Completed Advance Geology & Co.  
 Drilled by \_\_\_\_\_  
 Logged by G.L. Kirwan BSc

Footage		Formation	Sample Number	Sample Footage	Sample Width	silver copper		Remarks
From	To					Gold Sample	<del>Gold Sample</del>	
<u>DRILL HOLE 6</u>								
0	116	Diabase; Nipissing variety. End of Hole						
	10	2" Calcite vein	S-2	10'	2"	0.05 oz.		
	55'	2" quartz-calcite vein	S-3	55'	2"	0.07 oz.		
	93	4" aplite, pink.						
<u>DRILL HOLE 7</u>								
0	101	Diabase; Nipissing variety. End of hole						
	7	2" quartz-calcite stringer						
	11	2" quartz-calcite stringer						
	22'	1" quartz-calcite stringer						
	26	1" quartz-calcite stringer						
	41	1" quartz-calcite stringer (some chalcopyrite)						
	48	3" quartz-calcite stringer	S-4	48'	3"	nil		
	83	1.5" aplite, pink.						
<u>DRILL HOLE 8</u>								
0	102	Diabase; Nipissing variety. End of hole						
	27	2" aplite, pink						
	36	2" aplite, pink						
	49	2" calcite stringer	S-6	49'	2"	0.13 oz.		
	96	4" calcite stringer						
	2	1" calcite stringer	S-5	2'	1"	0.58 oz. 8.25%		
<u>DRILL HOLE 9</u>								
	0-5'	casing						
5 0	101	Diabase; Nipissing variety. End of hole						
48 0		3" calcite stringer	S-7	48'	3"	nil		
	74	1" aplite, pink						

Date of Examination September 10, 1964

*Gerald L. Kirwan*

POST 4  
CLAIM T 53370

M N

CLAIM T 52461

GOSSELIN  
LAKE

DDH 7 (101')

DDH 6 (116')

DDH 5 (116')

DDH 4 (101')

(#10) 2.50; 12.70 3"  
 (#9) 3.90; 23.26 4"  
 (#8) 2.28; 13.18 6"  
 (#7) 1.78; 9.50 5"  
 (#6) 4.02; 21.81 4"  
 (#5) 2.05; 14.62 6"  
 (#4) 2.66; 15.23 6"  
 (#3) 2.08; 11.61 5"  
 (#2) 2.76; 19.93 3"

R = RELIEF DDH TO VEIN

LOCATION POST: 300' SOUTH, 100' WEST OF POST 4, CLAIM T 53370

DDH 2 (101')  
(R: -8)

ASSAYS = SILVER IN OZS./TON, COPPER IN PERCENT - OVER GIVEN WIDTH

DDH 1 (50')  
(R: -15)

DDH 8 (102)

DDH 9 (101)

CASSEL'S TOWNSHIP



ALDAGE MINES LTD.

TIMAGAMI PROPERTY

ASSAY & PROPOSED D.D.H. MAP



POST 4  
CLAIM T 53370


M  
N

CLAIM T 52461

GOSSELIN

LAKE

DDH 7 (101')

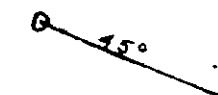


DDH 6 (116')




(#10) 2.50 ; 12.70 3"  
(#9) 3.90 ; 23.24 4"

DDH 5 (116')

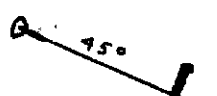

DDH 4 (101')

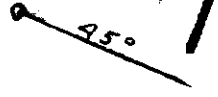

(#8) 2.28 ; 13.18 6"  
(#7) 1.78 ; 9.50 6"  
(#6) 4.02 ; 21.81 4"  
(#5) 2.05 ; 14.62 6"  
(#4) 2.66 ; 15.23 6"  
(#3) 2.08 ; 11.61 5"  
(#2) 2.76 ; 14.93 3"

'R' RELIEF DDH TO VEIN

LOCATION POST: 300' SOUTH, 100' WEST OF POST 4, CLAIM T 53370

(#1) 1.28 ; 8.33 4"

DDH 2 (101')

(R:-8)


(R:-20)

ASSAYS = SILVER IN OZS./TON, COPPER IN PERCENT—OVER GIVEN WIDTH

DDH 1 (50')

(R:-15)

DDH 8 (102)

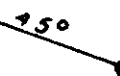

DDH 9 (101)



CASSEL'S TOWNSHIP



ALDAGE MINES LTD.



TIMAGAMI PROPERTY

ASSAY & PROPOSED D.D.H. MAP






31M04SE0018 16 CASSELS

D.D.H. 1

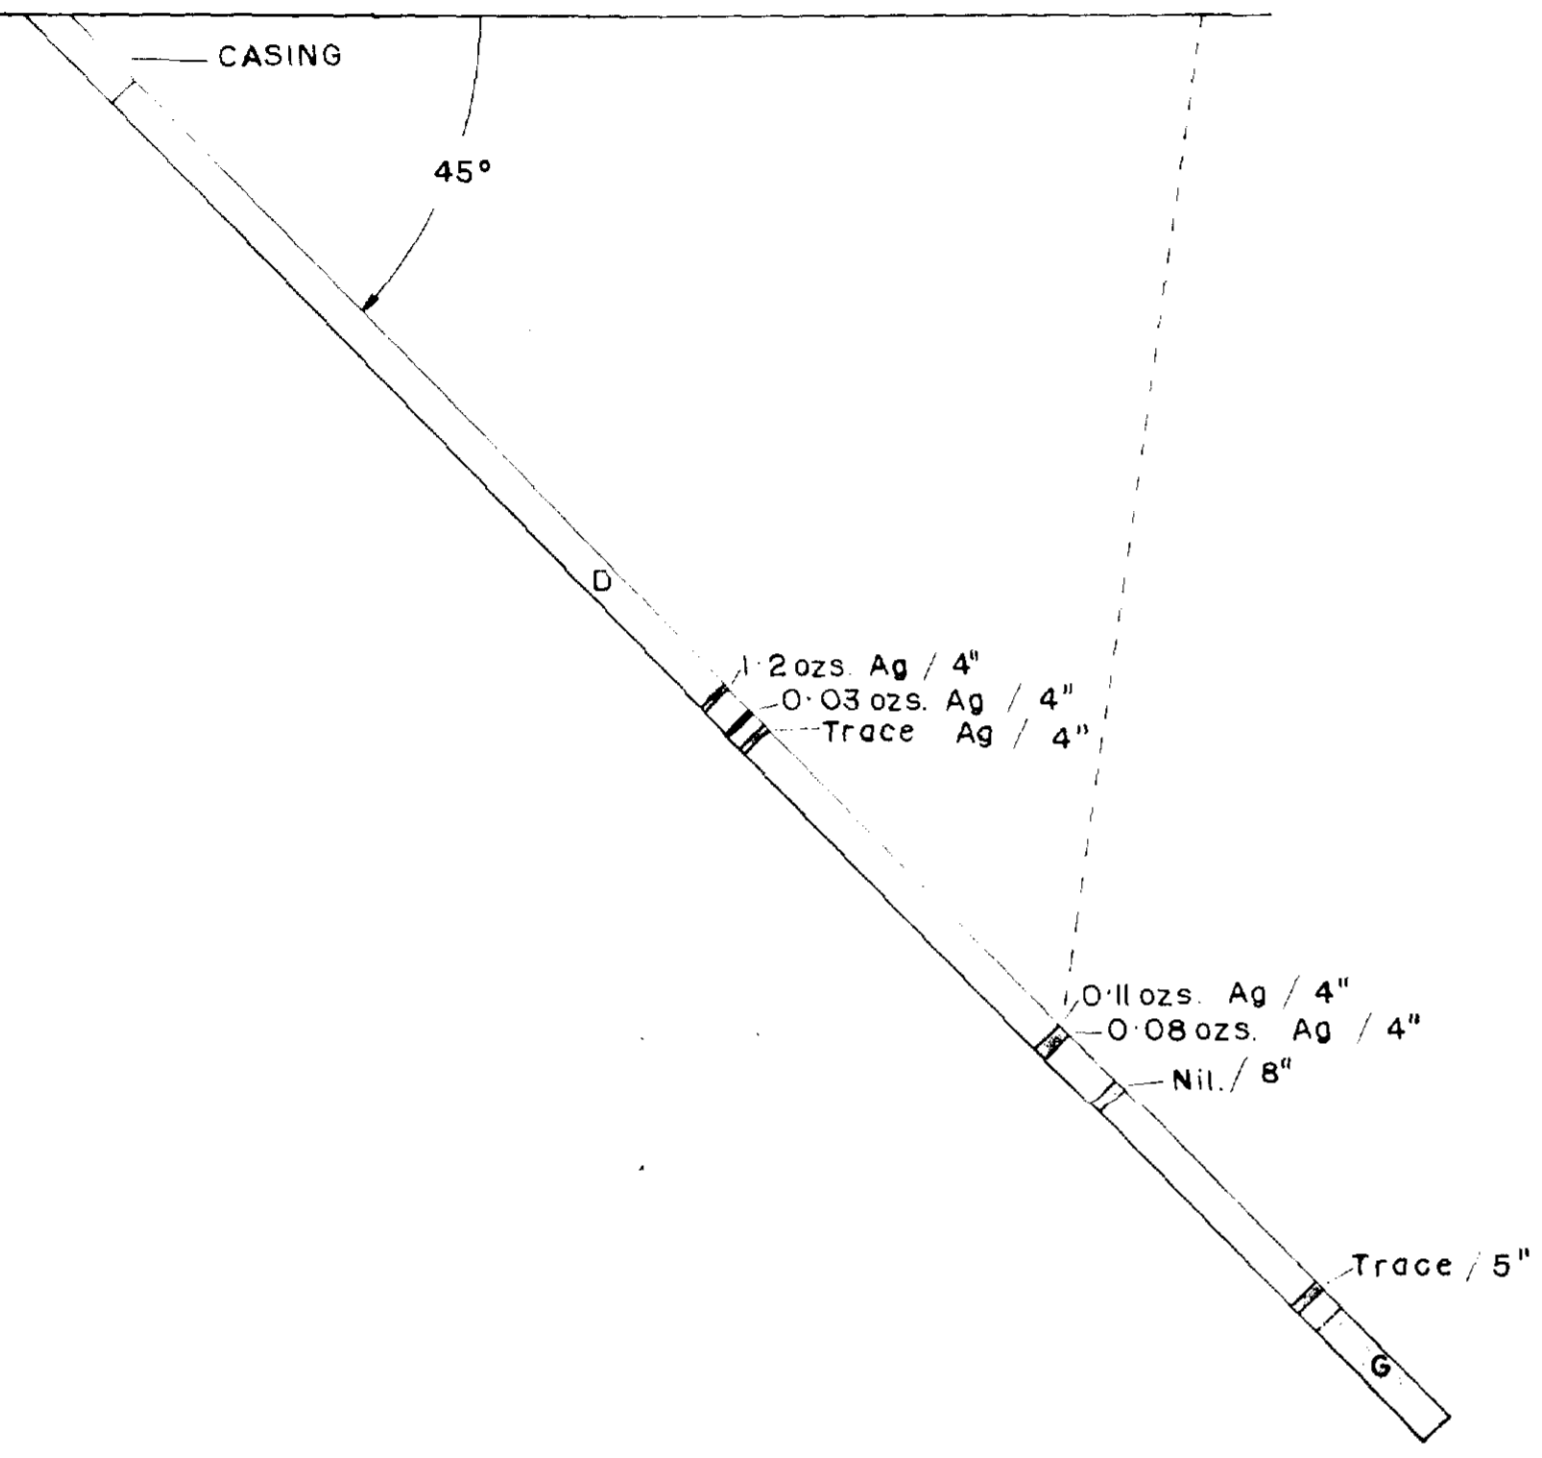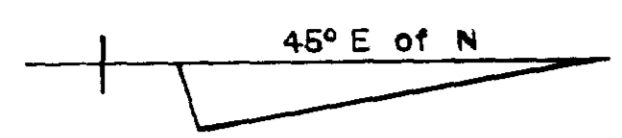


D.D.H. 2

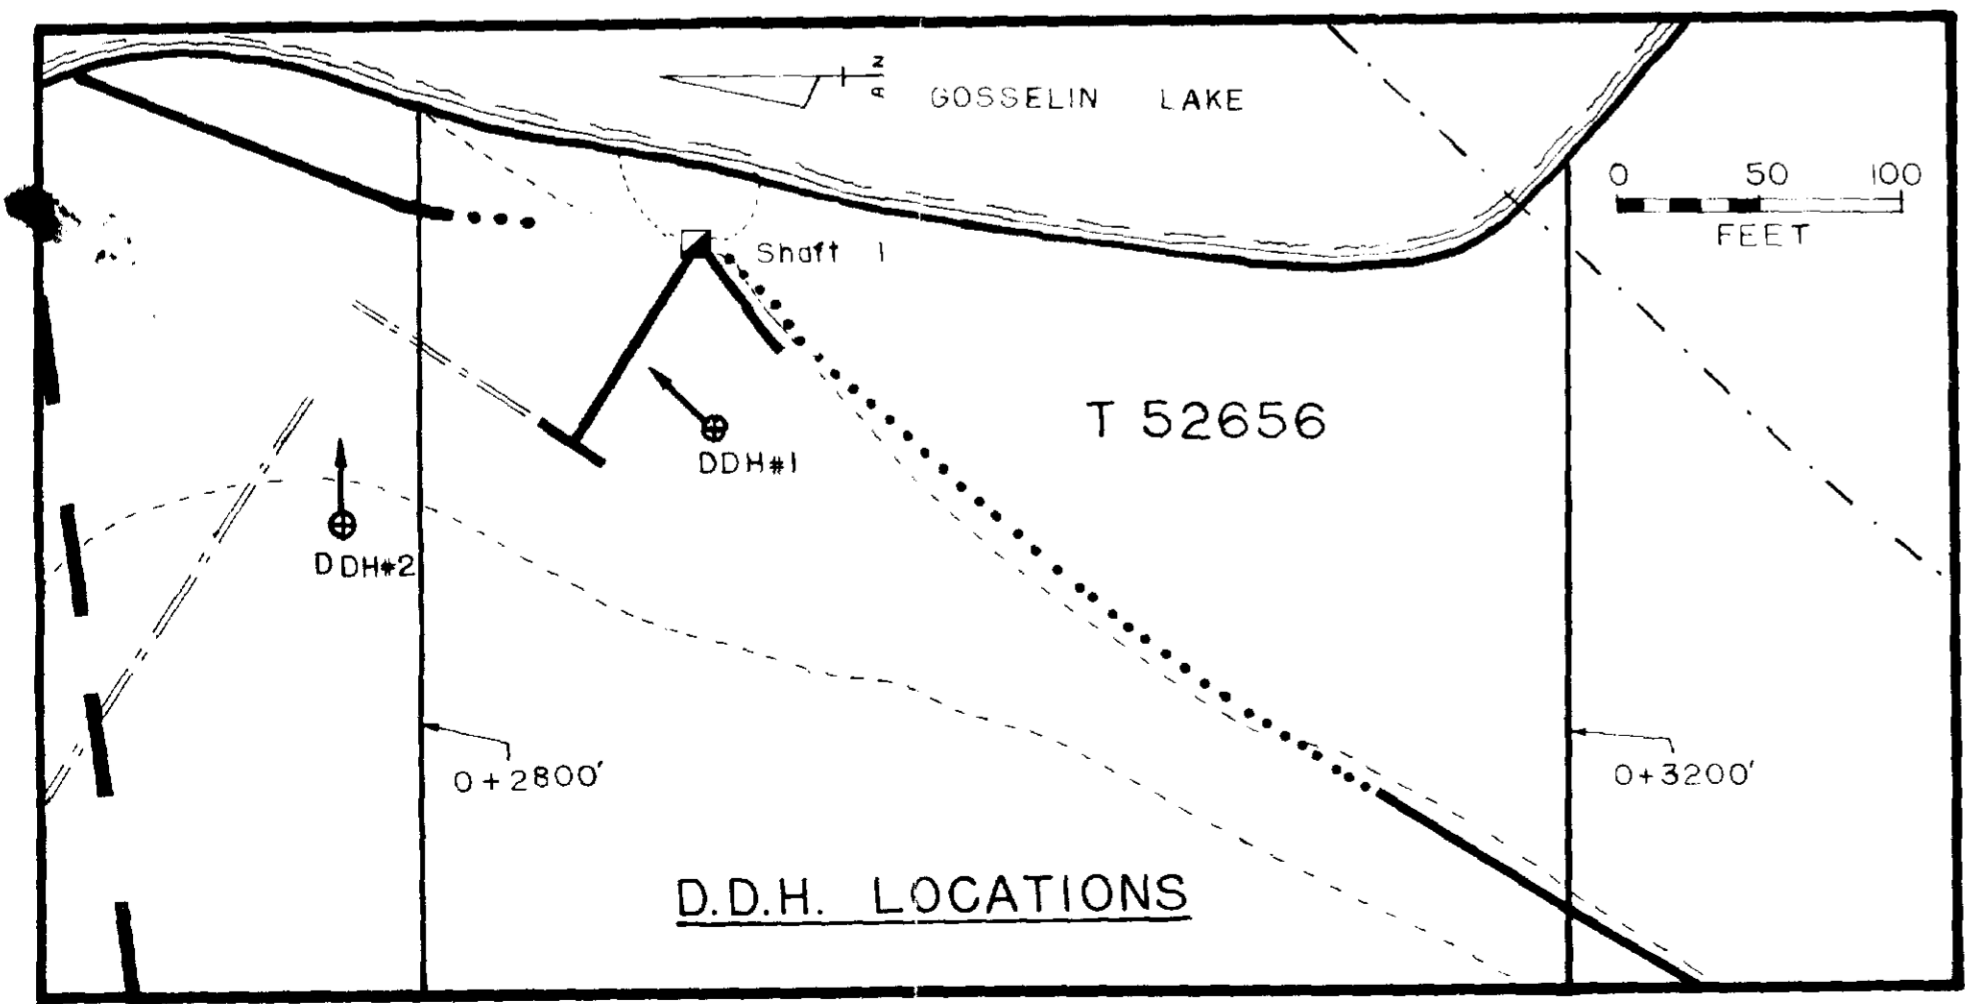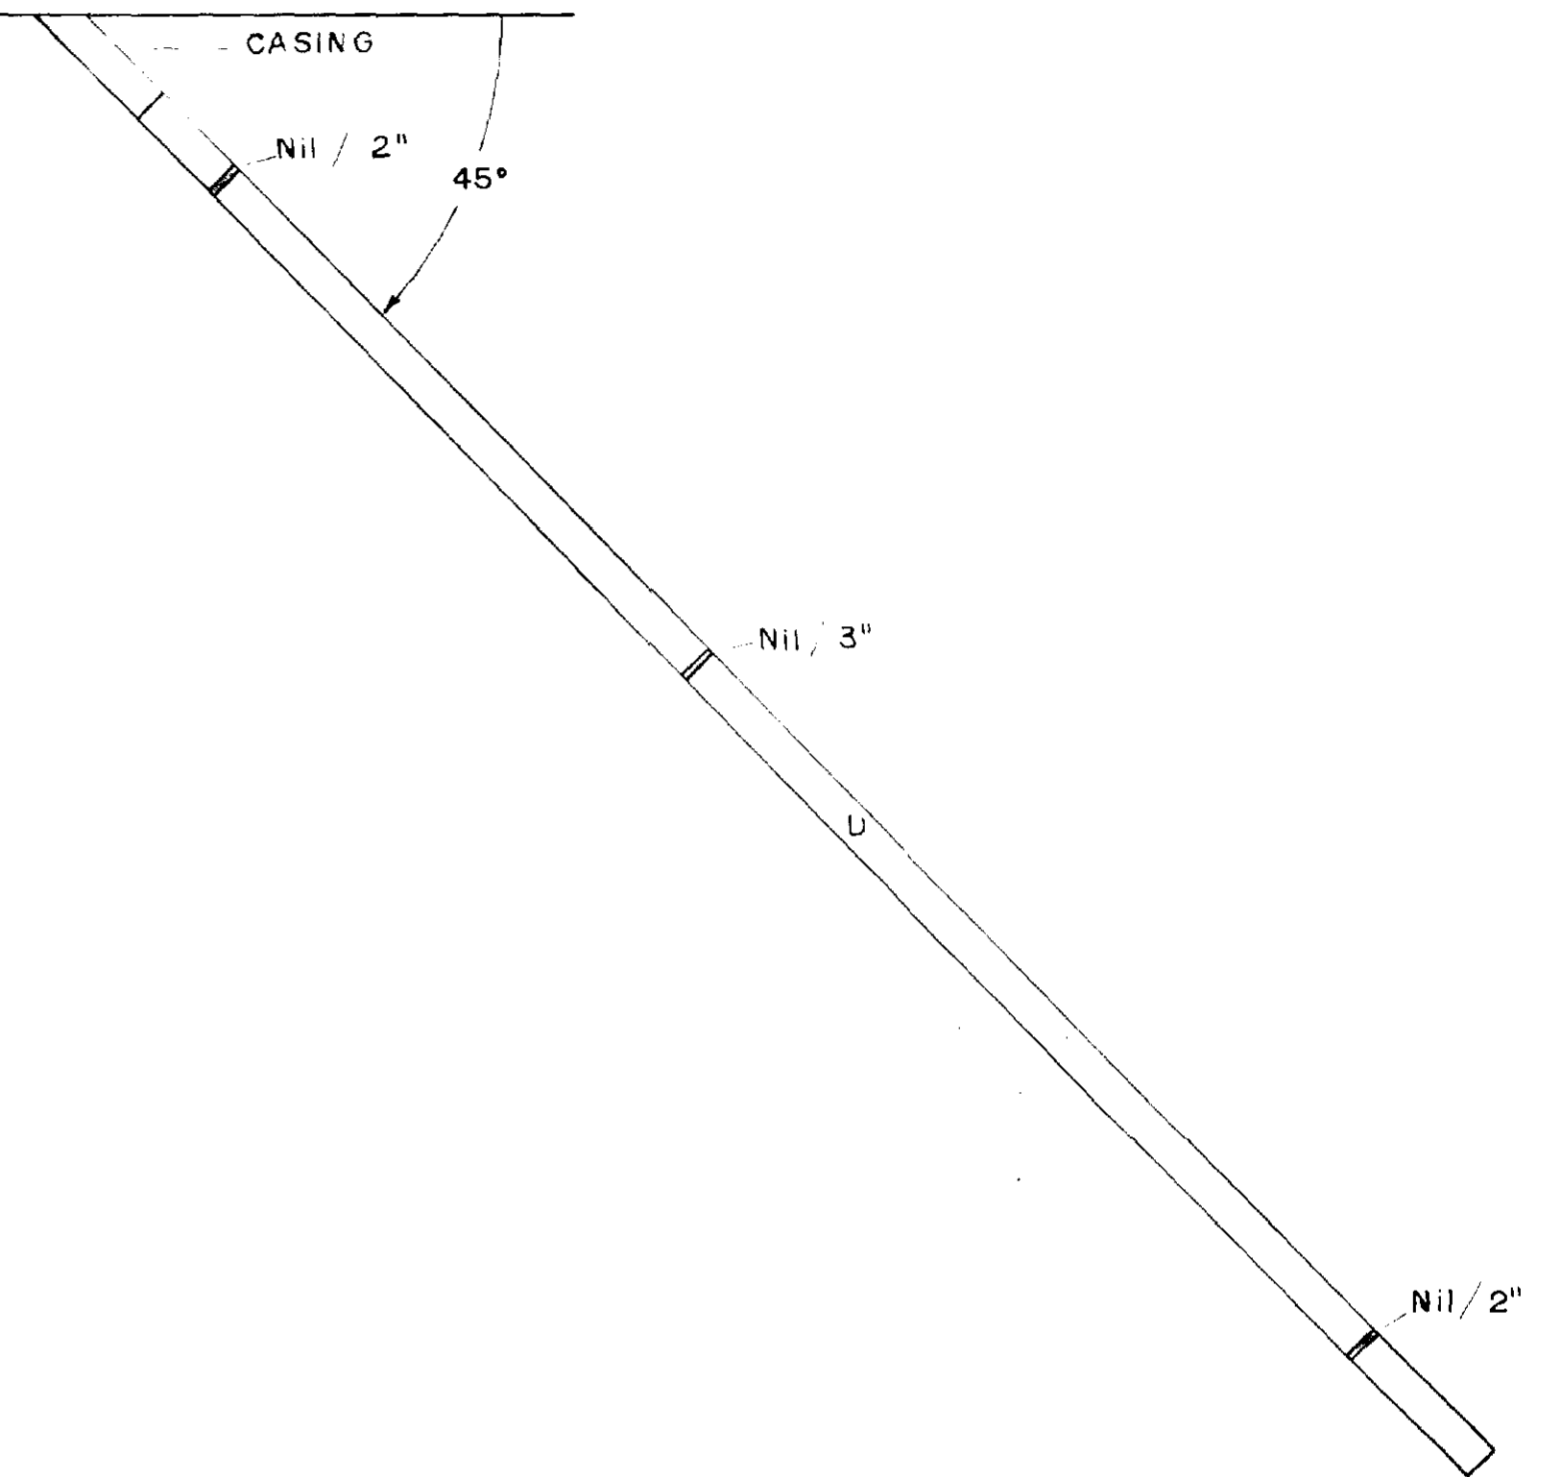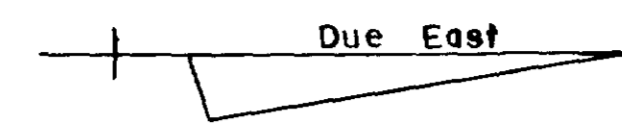

# ALDAGE MINES LIMITED DIAMOND DRILL HOLE SECTIONS

- ROCK TYPES
- D Diabase
  - G Gabbro

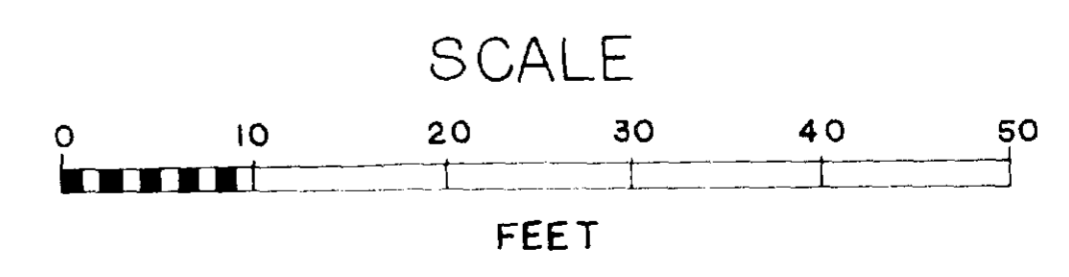

MAP No. 3.

G. L. KIRWAN. JUNE, 1963

*D.D. Report # 16*

*G.L. Kirwan*

