

#### DIAMOND DRILLING

TOWNSHIP: ABBOTSFORD


REPORT NO:15

WORK PERFORMED FOR: Keevil Mining Group Ltd.

RECORDED HOLDER: Same as Above [xx] : Other [ ]

Claim No.	Hole No.	<u>Footage</u>	<u>Date</u>	<u>Note</u>
L 94112	A66-1	479 '	March/66	(1)
	A66-2	321'	Apri1/66	(1)

NOTES: (1) Material received from Mining Recorder - cancelled claims - placed on file in Toronto, April/88.

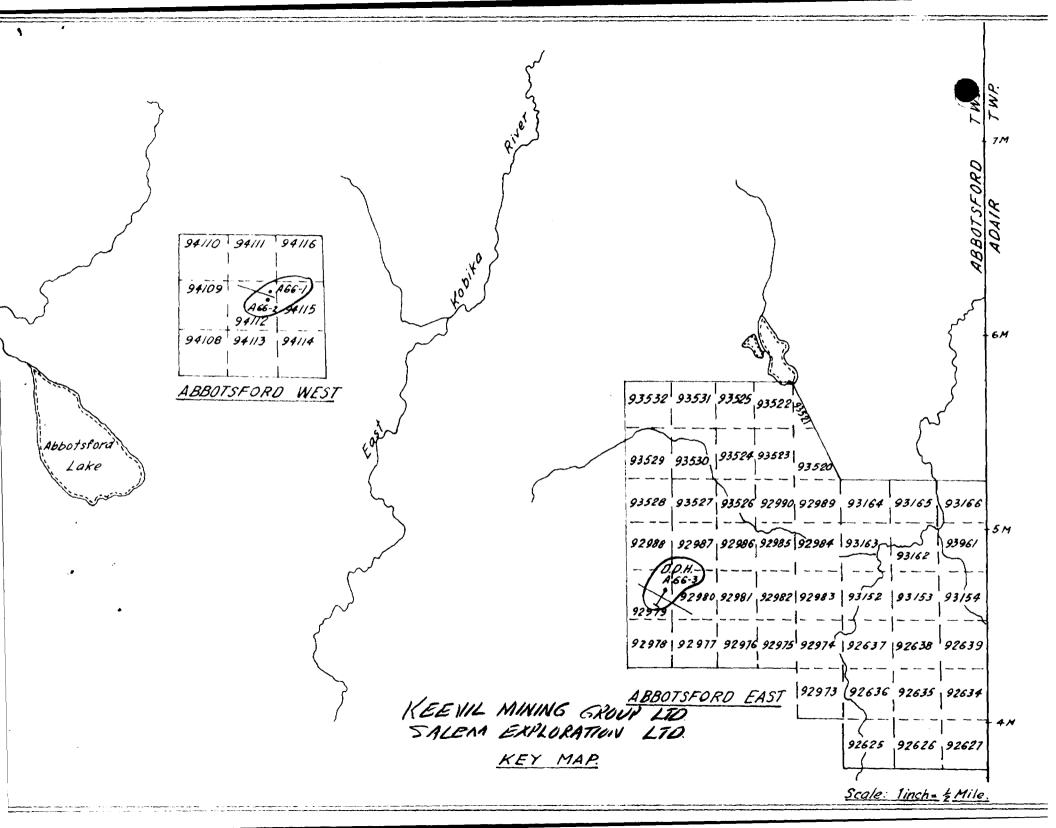

	PROPERTYAB	BOTSFORD WEST GROUP	- 794	но	LE NO	AW66-1				
SHEET NUMBER _	1	SECTION FROM	то_		STA	RTED Ma	rch 21,	1966		
LATITUDE	1 ≠ 50 N	DATUM			COMPLETED March 30, 19					
DEPARTURE	4 / 00 W	BEARING	BEARING As. 2150 ULTIMATE DEPTH							
ELEVATION		DIP <b>Collar 50°</b> ,	400' -	420	_ PRO	POSED DE	PTH	· · · · · · · · · · · · · · · · · · ·		
DEPTH FEET		FORMATION		SAMPLE No.	WIDTH OF SAMPLE	GOLD 6	SLUDGE GOLD S			
0.0 - 104.0	CASING									
104.0 - 106.0	Volcanic, dark	gray green, hard, she	eared and							
		s, laminated at 300								
106.0 - 110.0		aricoloured gray, med	,	4 :						
		ded, occasional band								
		to 400 to core exis.								
	to negative.									
110.0 - 120.0	Intermediate fl	ow rock, mostly gray	green							
	medium to fine	grain, hard, schiston	sity 30°	j: å						
	to core axis, p	yrite, pyrrhotite, s	peck <b>s</b>		·					
		in. sparse to negative	70.							
120.0 - 122.0	Acid Tuff, (as	above).				·	1			
122.0 - 242.5	Intermediate fl	ow rock, (as above),	parts of t	his			3			
	section could b	e tuffacious, fine g	ernet and				OFESS			
	bronse biotite,	schistosity 30° to	core axis.	<b></b>			PROFESS			
	160.0'-175.0' s	chistosity almost par	rallel to			/,	g	15 J		
		gated phenocryst, son					H. D. Mc	EOD m		
		ontorted, gannet and	bronze bio	tite	:: 		<u></u>	71/		
	rich.					······	1 P. S.	MILENO		
242.5 - 325.0	Basic flow rock	, very dark gray gree	en, medium				VACE OF			
<u> </u>	grain, hard, so	histosity varies from	n 20° to 30	to co	re axis	<b>&gt;</b>				

N.M.P., TORONTO-STOCK FORM No. 501 REV. 12/51

SIGNED 2/D m Level P. Eng.

	PROPERTY	HOLE NO. AW66-1							
SHEET NUMBER _	2	SECTION FROM	то_	W	STA	RTED			
LATITUDE		DATUM			_ CON	MPLETED_		<u>, , , , , , , , , , , , , , , , , , , </u>	
DEPARTURE		BEARING			_ ULT	'IMATE DE	PTH		
ELEVATION		DIP	£		_ PRO	POSED DE	PTH		
DEPTH FEET		FORMATION		SAMPLE No.	WIDTH OF SAMPLE	GOLD \$	SCADGE		Т
325.0 - 351.5		biotite, min. negat: rock, (as above).	ive.						
	345.0'-345.8' que	ertz, barren.							
		centrations of garne						<b> </b>	
351.5 - 385.5	Acid Tuff, (as al	ove), bedding 10° to	20° to						
	core axis.		· · · · · · · · · · · · · · · · · · ·						
385.5 - 401.0	Intermediate flor	rock, (as above), s	potty !*	ามีเดย					
	garnet concentrat	ions, sections amphi	bole nee	ile					_
	rich.							<u> </u>	
401.0 - 403.5	Acid Tuff, (as al	ove), bedding 40° to	core ax	is.					
403.5 - 414.6	Intermediate flor	rock, (as above).							
	Lost core 408.0-	,08.8, 414.0-414.6							
414.5 - 425.0	Basic flow rock,	(as above).							
	Lost core 418.0-	18.8.			<u> </u>				
425.0 - 428.0	Volcanic, dark,	cherty, some pale epi	dote.						
		ove), bedding 450 to		is.					
439.5 - 479.0	Intermediate flow	rock, (as above), s	chistosi	ty at					
	250 to core axis.	,							
		entration of amphibo	le needl	88					
		orted, fine garnets							
	biotite up to 609								

N.M.P., TORONTO-STOCK FORM No. 501 REV. 12/51

	PROPERTY		HOLE NO. AW66-1						
SHEET NUMBER _	3	SECTION FROM	то_	·	STA	RTED			
LATITUDE		DATUM	·		CO	MPLETED_			
DEPARTURE		BEARING		<del></del>	ULT	TIMATE DE	EPTH		
ELEVATION		_ DIP			_ PRC	POSED DE	PTH		
DEPTH FEET		FORMATION		SAMPLE No.	WIDTH OF SAMPLE	GOLD \$	SOLD \$		Γ
	463.0-465.0 qua	rts carbonate 401							
	471.0 6 1	nch concentration	of large ga	net.					1_
479.0	END OF HOLE.			<u> </u>					┫_
	No.								├
•	Note:	hornblende hornfe	le. A vell-	1					十
	bedded hornblend								
	original tuff.			1 - 1					
	suggest a relati	vely acid origin.	Highly	ļ					$\perp$
	recrystallized.			<del> </del>			<u> </u>		╀-
	abundant. Carne			<del> </del>					╀
,			<u>.</u>	<del>                                     </del>					十
•				<u> </u>					十
									L
			,						1
		·		1.4					$\vdash$
				<del> </del>					+
	` · · · · · · · · · · · · · · · · · · ·			<del>                                     </del>					十

N.M.P., TORONTO-STOCK FORM No. 501 REV. 12/51

	PROPERTY ABBOT	SFORD WEST GROUP	- 794	<u> </u>	OLE NO.	AW66-2		
SHEET NUMBER _	1	_ SECTION FROM		то	_ STA	RTED API	ril 1, 19	266
LATITUDE	2 / 50 S	DATUM				MPLETED_	April 7	1966
DEPARTURE	4 / 00 W	BEARING	As. 350	A	ULT	IMATE D	EPTH 321	.01
ELEVATION		DIP	0	· · · · · · · · · · · · · · · · · · ·	PRC	POSED DI	EPTH	
DEPTH FEET		FORMATION		SAMPLE NO	WIDTH OF SAMPLE	GOLD \$	SOLD \$	
0.0 - 107.5	CASING							
107.5 - 187.5	Intermediate flow	rock, dark to gr	ray green.					
	medium fine grain	, hard, schistos	e at 65° t	0				
	core axis, minera	lization sparse	to negativ	78,				
	contains some nar							
	generally high in	fine grain garn	et and bro	nze				
,	biotite, bedding 118.4-120.0 - Bas			stority.				
	medium grai							
	127.2-128.0 - Bas		rk green.					
	medium grai							
	134.0-135.9 - 60%	barren quarts a	nd feldspa	r				
•	aggregates.							
	140.7-141.4 - Aci	d tuff, brownish	gray.				PROFESS	0,1
•	142.6-146.7 - Ac1			iding			DNINIM	12
	70° to core	real control of the c				618	H. D. McL	
	151.0-152.7 - Aci	d tuff, brownish	gray, bec	iding		RE		00 i.E.
	650 to core		<u>.</u>				0.75	<i>V. Y.</i>
	170.7-174.0 - Aci	d tuff, consider	able garn	et			INCE OF ON	
	alteration.						-	
187.5 - 191.6	Volcanic, green,	fine grain, drag	folded,		4			

N.M.P., TORONTO-STOCK FORM No. 501 REV. 12/51

SIGNED N.D. M. Level P. Eng.

	PROPERTY		H	OLE NO.	W66-2	<del></del>	
SHEET NUMBER	2	SECTION FROM	то	_ STA	RTED		
LATITUDE		DATUM	<u> </u>	CON	MPLETED_		
DEPARTURE		BEARING		UL1	IMATE DI	EPTH	
					POSED DE	PTH	
DEPTH FEET		FORMATION	SAMPLE NO	WIDTH OF SAMPLE	GOLD \$	SLUDGE GOLD S	
	chloritized,	mineralization very sparse.				Cu%	Zn%
		Quartz, barren.	2.7				
191.6 - 230.7		flow rock. (as above).					
		Acid tuff, (as above).					
		Acid tuff, (as above).					
		Pyrite, pyrrhotite, thin st	reak				
1		rite, mineralization 20% /	18	1.0	Wil	0.04	
	222.4-223.2 -	Acid tuff, (as above).					
		Acid tuff, bedding 700 to c	ore				
		ernet rich, pyrite, pyrrhoti					
		ization 10%-15%.	19	2.0	Nil	0.04	None
230.7 - 232.4	Rhyolite, ligh	nt colour, fine grain, hard,	į				
•	schistose, min	eralization very aparae.					
232.4 - 255.8	Intermediate f	flow rock, (as above).					
· ·	253.8-255.8 -	Biotite, chlorite.					
255.8 - 262.0	Intermediate t	to acid tuff, colour varies	from				
		to gray green, medium grain					
		75° to core axis, thin beds		ļ			<b></b>
		tite rich, some quarts carb			·		1
	mineralization	sparse to negative. 261.0	minor				<b>_</b>
I	contontion			1		1	1

N.M.P., TORONTO-STOCK FORM No. BOL REV. 12/51

PROPERTY			НС	LE NO.A	W66-2	<del></del>	4			
3	SECTION FROM	то		. STAI	RTED		•			
	DATUMCOMPLETED									
	BEARING	1		ULT	IMATE DE	PTH			-	
	DIP			_ PRO	POSED DE	PTH			•	
	FORMATION		SAMPLE No.	WIDTH OF SAMPLE	GOLD \$	SLUDGE			•	
		medium	tion						,	
END OF HOLE.									-	
hole to be in a rich hornblende common in many obvious in place probably originabut containing.  The conductions	well banded feldspar quant and biotite. Garnets and biotite. Garnets and baddings. A recrystallised to ally mainly acid in compasic sections.	uarts roc are ng is uff - position	k						· · · ·	
	Volcanic, green 80° to core axi mineralization Acid tuff, (as Intermediate flow rock grain, hard, sci minor chlorite negative. END OF HOLE.  Note -  A study of hole to be in a rich hornblende common in many obvious in place probably originate but containing the conduct	DATUM  BEARING  DIP  FORMATION  Volcanic, green, fine grain, hard, sch  80° to core axis, minor quarts carbons mineralization sparse to negative.  Acid tuff, (as above).  Intermediate flow rock, (as above).  Basic flow rock, very dark gray green, grain, hard, schistosity 85° to core a: minor chlorite and quarts carbonate, m negative.  END OF HOLE.  Note -  A study of specimens indicates the hole to be in a well banded feldspar quarts common in many horizons. Graded badding obvious in places. A recrystallised to probably originally mainly acid in com- but containing basic settions.	DATUM  BEARING  DIP  FORMATION  Volcanic, green, fine grain, hard, schistosity 80° to core axis, minor quarts carbonate, mineralization sparse to negative.  Acid tuff, (as above).  Intermediate flow rock, (as above).  Basic flow rock, very dark gray green, medium grain, hard, schistosity 85° to core axis, minor chlorite and quarts carbonate, minoralize negative.  END OF HOLE.  Note -  A study of specimens indicates the entire hole to be in a well banded feldspar quarts recrich hornblende and biotite. Garnets are common in many horizons. Graded badding is obvious in places. A recrystallized tuff - probably originally mainly acid in composition but containing basic sections.  The conductor is sections of heavy to	Acid tuff, (as above).  Intermediate flow rock, (as above).  Basic flow rock, very dark gray green, medium grain, hard, schistosity spain, minor chlorite and quarts carbonate, minor chlorite and common in meant and indicates the entire hole to be in a well banded feldspar quarts rock rich hornblende and biotite. Garnets are common in many horizons. Graded badding is obvious in places. A recrystallised tuff probably originally mainly acid in composition but containing basic sections.  The conductor is sections of heavy to	DATUM COMBEARING ULT  DIP PRO  FORMATION SAMPLE NO OF SAMPLE  Yolcanic, green, fine grain, hard, schistosity 80° to core axis, minor quarts carbonate, mineralization sparse to negative.  Acid tuff, (as above).  Intermediate flow rock, (as above).  Basic flow rock, very dark gray green, medium grain, hard, schistosity 85° to core axis, minor chlorite and quarts carbonate, mineralization negative.  END OF HOLE.  Note -  A study of specimens indicates the entire hole to be in a well banded feldspar quarts rock rich hornblende and biotite. Garnets are common in many horizons. Graded bädding is obvious in places. A recrystallized tuff probably originally mainly acid in composition but containing basic sebtions.  The conductor is sections of heavy to	3 SECTION FROM TO STARTED  DATUM COMPLETED  BEARING ULTIMATE DE  PROPOSED DE  FORMATION SAMPLE NO OF SAMPLE QUID S  Volcanic, green, fine grain, hard, schistosity  80° to core axis, minor querts carbonate, mineralization sparse to negative.  Acid tuff, (as above).  Intermediate flow rock, (as above).  Basic flow rock, very dark gray green, medium grain, hard, schistosity 85° to core axis, minor chlorite and querts carbonate, mineralisation negative.  END OF HOLE.  Note —  A study of specimens indicates the entire hole to be in a well banded feldspar quarts rock rich hornblende and biotite. Garnets are common in many horizons. Graded bedding is obvious in places. A recrystallised tuff — probably originally mainly acid in composition but containing basic sections.  The conductor is sections of heavy to	3 SECTION FROM TO STARTED  DATUM COMPLETED  BEARING ULTIMATE DEPTH  DIP PROPOSED DEPTH  FORMATION SAMPLE NO OF SAMPLE SOLD S SOLD S  VOICANIC, green, fine grain, hard, schistosity  80° to core axis, minor quarts carbonate, mineralization sparse to negative.  Acid tuff, (as above).  Intermediate flow rock, (as above).  Basic flow rock, very dark gray green, medium grain, hard, schistosity 85° to core axis, minor chlorite and quarts carbonate, mineralisation negative.  END OF HOLE.  Note -  A study of specimens indicates the entire hole to be in a well banded feldspar quarts rock rich hornblende and biotite. Garnets are common in many horizons. Graded bedding is obvious in places. A recrystallised tuff probably originally mainly sold in composition but containing basic settions.  The conductor is sections of heavy to	3 SECTION FROM TO STARTED  DATUM COMPLETED  BEARING ULTIMATE DEPTH  DIP PROPOSED DEPTH  FORMATION SAMPLE NO OF SAMPLE COLD S SALURAS OCCUPY  Yolcanic, green, fine grain, hard, schistosity  80° to core axis, minor quarts carbonate, mineralization sparse to negative.  Acid tuff, (as above).  Basic flow rock, (as above).  Basic flow rock, vary dark gray green, medium grain, hard, schistosity 85° to core axis, minor chlorite and quarts carbonate, mineralization nagative.  END OF HOLE.  Note -  A study of specimens indicates the entirs hole to be in a well banded feldspar quarts rock rich hornblende and biotite. Qarnets are common in many horizons. Graded badding is obvious in places. A recrystallized tuff probably originally mainly acid in composition but containing basic settions.  The conductor is sections of heavy to	DATUM COMPLETED  DATUM COMPLETED  DIP PROPOSED DEPTH  FORMATION SAMPLE No. OF SAMPLE N	

N.M.P., TORONTO-STOCK FORM No. 501 REV. 12/51





ONTARIO

#### THE MINING ACT REPORT OF WORK

required for each type of work to be recorded.

					L		
	of	• • • • • • • • • • • • • • • • • • • •	arder Lake	•••••	••••••	Mining	Division
Keevil M	Mining Group		•••••	• • • • • • • • • • • • • • • • • • • •	A35389	•••••	
Suite 10	name of Recorded 200, 11 Adel	aide St. W.	, Toronto,	Ontario.	Miner's L	icence	
do hereby report	the performance of	<b>8</b> 00 F	ost Office Addres	of diamo	nd dril	ling.	•••••
not before report	ed to be applied on	the following conf	tiguous claims		1700	WOIK	
Claim No	Days	Claim No.	Days	Claim N	o.	Days	
L94109	100/	L94116/	160			·	
L94110/	100	L94 <b>V</b> 16	100	*********	•••	•••••	
L941.M.	1.00						
L941\2/	100		•••••	•••••	· · ·		
194113/	100	***********	******	*********	· · ·	•••••	
494114	1.99	***************************************	******	********	•••	•••••	
	s performed on Mini			********	•••	•••••	
READ CAREFUL	LLY: THE FOLLO	WING INFORMATION	I IS REQUIRED BY	THE MINING	RECORDER,	<u>.</u>	
addresses of the	, Stripping or Open men who performed	d the work and the	dates and hours o	f their emplo	yment.		
owner or operator	d other Core Drillin or of drill. Dates wh	en drilling was do	ne. Signed core lo				iagress of
	Air or Other Power equipment. Names (			erating equip	nent and the	dates and	d hours of
their employment							
work was done. I	Proof of actual cos	t must be submitte	d within 30 days o	of recording.			
With each of the	above types of wo	rk sketches are re- ase of diamond or a	quired to show the other core drilling	e location an the sketch i	d extent of nust be sub	the work i mitted in	n relation duplicate.
For Geological o	and Geophysical Su	<u>irvey</u> - The name:	s and addresses o	f men emplo	yed as well	as dates.	. Type of
within 60 days o	in the case of geo of recording. o - the name and ad			in duplicate	must be tile	d with the	e Minister
	nformation is as Fo		•	ace is insuffi	cient)		
D D !! 1//			<b>5.</b> 50	0 0	٠.		
D.D.H. A66	6-1 - Bear	ing S 35° W	- Dip 50		re Size ngth		1/8" 479.'0
D.D.H. 466	5-2 - Bear	ing N 35 <sup>0</sup> E	- Din 50	o _ co	re Size	<b>A</b> XT_1	1 /Att
bebene Roo	Jew - Bear	1.15 1. 77 1	- Dip )0	Le	ngth tal		321.10 800.00
Drilled by	Continenta	l Drilling (	Co. Ltd., R	ouyn, P.	Q.		
	ch 21 to Ap	ril 7, 1966.	•	_	700	-a/ /	
Date June 3	1966.		Sig	nature of Rec	orded Hold	or Agen	rd
		The Certificate Ver	Mining Act ifying Report of W		······································	· · · · · · · · · · · · · · · · · · ·	1
1,	•••••	Н	O. McLeod	• • • • • • • • • • • • • • • • • • • •		• • • • • • • • • • • • • • • • • • • •	•••••
***************************************	566	Murray St., (Post O	Timmins, ffice Address)	Ontario	•••••	•••••	•••••
hereby certify:					_		
1. That to, having perfor	I have a personal or wi	and intimate knowle itnessed same duri	edge of the facts : ng and/or after its	set forth in th s completion.	ne report of	work anne	xed here-
2. That	the annexed report	is true.		7.0			,
DatedJune	301	966			M S	Zesa	<i></i>