Ministry of Northern Development and Mines

# 87-51 Report of Work

Name and address of Ontario land surveyer,


Land Survey

768 (85/12)

Nii

Nil

Word	Recorded Holder	Min		41103MW3040 W0707	-00031 DA	****		שוש
G. DAW						C. 3	2835	
1 01	NRER SY. M	ARK ST	AC	1,0NY.				
Summary of Work Perform	nance and Distribution of Cred	its	/					
Total Work Days Cr. claimed	Mining Claim Prefix Number	Work Days Cr. P	N refix	lining Claim Number	Work Days Cr.	Mining Prefix	Claim Number	Work Days Cr.
for Performance of the follow work. (Oheck one only)		4						
Manual Work	808726	54			<u> </u>			_
Shaft Sinking Drifting of other Lateral Work.	or	1				_		
Compressed Air, other Power griven or 'mechanical equip.			, ,		<del> </del>		·	
Power Stripping					<del>                                     </del>			
Diamond or other Core								
Land Survey								
All the work was performed o	on Mining Claim(s): 5 808	5723,	7	24				
	type of equipment, Names, A							
	th al Prones.		, r	IARKSTA	4,8	N/ -		
MAPRIL 1	-12 - 12d	py 5						
	1-30 - 17di	py 5		/ /				
	Total 29da	45 @	) /.	zars/d	Ay			
				T <sub>NO</sub>		<u></u>	3da	110
						<i>J</i> (		7 5
SUDBURY MINING DIV.				ONT	ARID GED	LOGICAL SUR	VEY	
RECEIV	ED				કહ સ	ن الله الله الله الله الله الله الله الل	1	
10 195	77	St.				* n und d	Ì	
A.M.	P.M.				JUN	. 1 1301	1	
7,8,9,10,11,12,1,2	3141516			Dale of Report	<b>/</b> (2.50)	Redrag Hold	er or Agent (	Signature)
70	, C.N	<del></del>		purekap	17	1 Poca	The same	
Certification Verifying Rep	port of Work	·		/		/	/_	
	a personal and intimate knowledge nd/or after its completion and the a				ork annex	d hereto, having	performed t	he work
Name and Postel Address of P	Person Certifying	2 1/0	///	and Ra	1. 5	a dou	KU, O	117.
	117009	1 10	660	Pate Certified		Certified (Si	gnature)	
Table of Information/Atta	chments Required by the Mini	ng Recorder		June 19	8/	711	est	
Type of Work	Specific information per	type	Oti	er information (Co	mmon to 2	or more types)	Attach	nents
Manual Work								
Shaft Sinking, Drifting or other Lateral Work	Nil		m	Names and addresses of men who performed manual work/operated equipment, together are required to show with dates and hours of employment.				
Compressed air, other power driven or mechanical equip.	Type of equipment			obtes pilo nouis (			the location extent of v relation to	work in the
Power Stripping	Type of equipment and amount expended.  Note: Proof of actual cost must be submitted within 30 days of recording.  Names and addresses of owner or operator together with dates when drilling/stripping						nearest cla	an post.
Diamond or other core drilling	Signed core log showing; footage, core, number and angles of holes.		do	done. Work Sketch (as above) in duplicate				

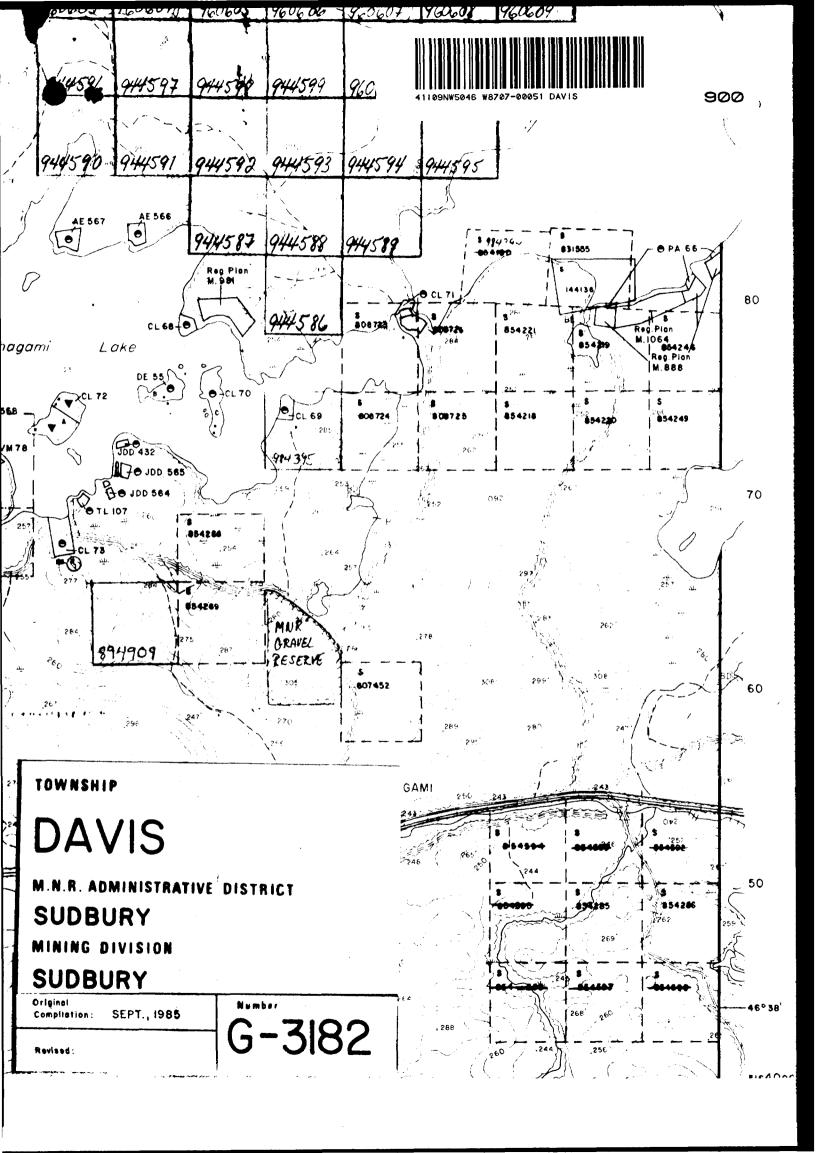

		LOCATION: DAVIS Tup.	No	STRIPPED	Trenched	Assay sheet No.
		MAP No.		45'×7"×1'	35'x 6'x3'	
·	508726		@	50' X 5' X 1'	HO'K4'K3'	
808723			3	)	7'X5'XZ'	
			4	15×6'×1'	12×5'K4'	
	808725			300 Mini	BURY NG DIV.	
					10.000	
				7.8;9;10;11;	P. 1 2 3 4 5	
808724			N			
3-3-12-7					/ - # # A'	
ŧ				cale: 1'		
•				6-U1	whith	
•	Dush Rd.					
•						