



41010NE0013 37 CUNNINGHAM

010

DIAMOND DRILLING

TOWNSHIP: ~~CUNNINGHAM TWP.~~

REPORT NO: # 37

WORK PERFORMED FOR: ~~TECK EXPLORATIONS LTD.~~

RECORDED HOLDER: SAME AS ABOVE

: OTHER

<u>CLAIM NO.</u>	<u>HOLE NO.</u>	<u>FOOTAGE</u>	<u>DATE</u>	<u>NOTE</u>
961132	1554-7	326.5 FEET	JUNE/90	(1)

NOTES: (1) W 9006.60460, FILED NOVEMBER 22, 1990

TECK EXPLORATIONS LIMITED DIAMOND DRILL LOG

Hole 1554-7
Sheet 1 of 3

Job <u>15540</u> <u>N.T.S.</u> <u>41 0/10</u> Property <u>Cunningham Township</u> Township <u>Cunningham</u> Location: Line <u>2+00W</u> Station <u>2+25N</u> Elevation <u>Block I</u> Logged <u>A. Christopher</u>	Objective <u>To Test Conductors #5</u> Drilling Co. <u>Norex</u> Commenced <u>June 22, 1990</u> Completed <u>June 24, 1990</u> Length <u>326.5 ft</u>	Core Location <u>North Bay</u> Distance to Water <u>1300 ft</u> Casing Lost <u>Nil</u> Core Size <u>80</u>	Tests <table style="width: 100%; border-collapse: collapse;"> <tr> <td></td> <td style="text-align: center;">Dip</td> <td style="text-align: center;">Azimuth</td> </tr> <tr> <td>At Collar</td> <td style="text-align: center;">-45°</td> <td style="text-align: center;">018°</td> </tr> <tr> <td style="text-align: right;">150.0</td> <td style="text-align: center;">-44.5°</td> <td style="text-align: center;">-</td> </tr> <tr> <td style="text-align: right;">326.0</td> <td style="text-align: center;">-43°</td> <td style="text-align: center;">-</td> </tr> <tr><td> </td><td> </td><td> </td></tr> <tr><td> </td><td> </td><td> </td></tr> <tr><td> </td><td> </td><td> </td></tr> <tr><td> </td><td> </td><td> </td></tr> <tr><td> </td><td> </td><td> </td></tr> <tr><td> </td><td> </td><td> </td></tr> <tr><td> </td><td> </td><td> </td></tr> </table>		Dip	Azimuth	At Collar	-45°	018°	150.0	-44.5°	-	326.0	-43°	-																					
	Dip	Azimuth																																		
At Collar	-45°	018°																																		
150.0	-44.5°	-																																		
326.0	-43°	-																																		
Remarks <u>Conductor explained as massive sulphides at 123.9-140.0.</u>																																				


Depth (ft)		Rock Type	Description	Sample No.	From	To	Length (ft)	Au ppb	Ag ppm	Cu ppm	Zn ppm
From	To										
0	10.0	OVERBURDEN	Casing.								
10.0	52.5	SEDIMENTS	Dark grey to grey-green, moderately well foliated/bedded, very hard (siliceous), magnetic to locally sporadically magnetic unit of magnetic siltstones? (lean iron formation) with 5-10% magnetite. (This unit may possibly be dacitic tuffs??). 10.0-35.2 - Relatively homogeneous and laminated. 27.0 - Foliation at 72° to core axis. 35.2-52.5 - Interbedded with non-magnetic siltstones or greywackes. 40.0-41.0 - Brecciated with 10% quartz + carbonate veining. 52.5 - Contact gradational (not sharp).								
52.5	123.9	MAFIC VOLCANICS	Medium green to locally grey-green, weakly to moderately foliated/bedded mafic ash and lapilli tuffs. Unit contains 1-2% irregular quartz ± carbonate veinlets and trace to locally 1% pyrite. 54.1 - 1" with 3-5% pyrite. 55.1-57.2 - Light to medium-grey, intermediate to felsic lapilli tuff. 56.5 - Foliation at 71° to core axis. 57.9-58.5 - Grey-brown, massive, intermediate dyke with 5-8% feldspar phenocrysts and 5% biotite phenocrysts. Upper contact sharp at 54° to core axis. Lower contact is irregular. 59.9-61.0 - As above.								

Depth (ft)		Rock Type	Description	Sample No.	From	To	Length (ft)	Au ppb	Ag ppm	Cu ppm	Zn ppm
From	To										
			67.4 - ½" quartz + carbonate vein. 78.0 - ½" quartz + carbonate vein. 78.8-79.9 - 4-6% quartz ± carbonate veinlets and 1-2% pyrite. 80.9 - ½" quartz + carbonate vein. 85.8 - 1" quartz + carbonate vein. 117.0 - Foliation at 75° to core axis.								
123.9	140.0	MASSIVE SULPHIDES AND FELDSPAR PORPHYRY DYKES	Mixed unit of massive to semi-massive sulphides and feldspar porphyry dykes. 123.9-126.9 - 40-45% pyrite, 5-7% pyrrhotite and 50% grey-green siliceous sediments with minor chert and two ¼" graphitic beds. 126.9 - Contact sharp at 86° to core axis. 126.9-132.3 - Grey, massive, very hard feldspar porphyry dyke with 5-10% feldspar phenocrysts. Trace pyrrhotite + pyrite. 132.3 - Contact sharp at 39° to core axis. 132.3-133.7 - 15-20% pyrrhotite, 4-8% pyrite, 75% siliceous sediment (some chert). Section appears brecciated. 133.7 - Contact sharp at 32° to core axis. 133.7-136.2 - Feldspar porphyry as 126.9-132.3. 136.2 - Contact sharp at 55° to core axis. 136.2-140.0 - 40-45% pyrrhotite, 10-15% pyrite, 40-50% siliceous (chert) and chloritic sediment fragments. Section appears brecciated. 140.0 - Contact sharp at 63° to core axis.	F7262	123.9	126.9	3.0	Nil	0.1	99	689
				F7263	126.9	129.5	2.6	Nil	0.1	12	125
				F7264	129.5	132.3	2.8	Nil	0.2	11	71
				F7265	132.3	133.7	1.4	2	0.1	115	81
				F7266	133.7	136.2	2.5	Nil	0.1	7	185
				F7267	136.2	140.0	3.8	Nil	0.4	107	497
140.0	216.1	SEDIMENTS (INTER-MEDIATE TUFFS?)	Moderately to strongly foliated/bedded/laminated siltstones, greywackes and siliceous sediments (possibly tuffs) with colour varying from grey-green to light grey-buff. Some sections are dark green and chloritic. Trace to 1% pyrite + pyrrhotite. 140.0-164.5 - 5-15% pink garnets and generally chloritic. 140.0-144.5 - 3-6% pyrrhotite, 1-2% pyrite. 144.5-151.5 - 2-3% pyrrhotite, 1% pyrite. 151.5-164.5 - 1% pyrite + pyrrhotite. 171.0 - Foliation at 78° to core axis.								
				F7268	140.0	144.5	4.5	Nil	0.1	37	124
				F7269	144.5	148.5	4.0	Nil	0.1	24	163
				F7270	148.5	151.9	3.4	3	0.1	23	105

Depth (ft)		Rock Type	Description	Sample No.	From	To	Length (ft)	Au ppb	Ag ppm	Cu ppm	Zn ppm
From	To										
			174.7-176.0 - Feldspar porphyry dyke similar to 126.9-132.3.								
			189.3-190.9 - Fine-grained, grey siliceous felsic dyke (or flow?) with a ropy texture. Contacts sharp at 71° to core axis.								
			203.2-204.3 - Quartz vein with trace to 1% pyrite + pyrrhotite.	F7271	203.2	204.3	1.1	N11	0.1	38	73
			211.0 - Foliation at 70° to core axis.								
			216.1 - Gradational contact.								
216.1	326.5	SEDIMENTS/ INTERMEDIATE TUFFS	Similar to above unit but locally moderate sericite and moderate chlorite alteration are present. Unit is strongly foliated/laminated with minor schistose sections. Trace pyrite is present.								
			221.0-224.0 - Strong sericite alteration and schistose to contorted sections.	F7272	221.0	224.0	3.0	N11	0.1	35	61
			235.3 - 3/4" quartz vein with 5% chalcopyrite and 5% pyrite at 78° to core axis.	F7273	235.0	236.0	1.0	1091	0.7	863	69
			246.3 - Foliation at 66° to core axis.								
			253.0 - 1/2" quartz vein with trace chalcopyrite.								
			Below 294.5 unit becomes darker in colour, less foliated and very hard and appears to be a hornfels.								
			300.0-302.0 - Very strong sericite alteration (section is buff-pink in color).								
326.5		END OF HOLE									



RANSOM
LAKE

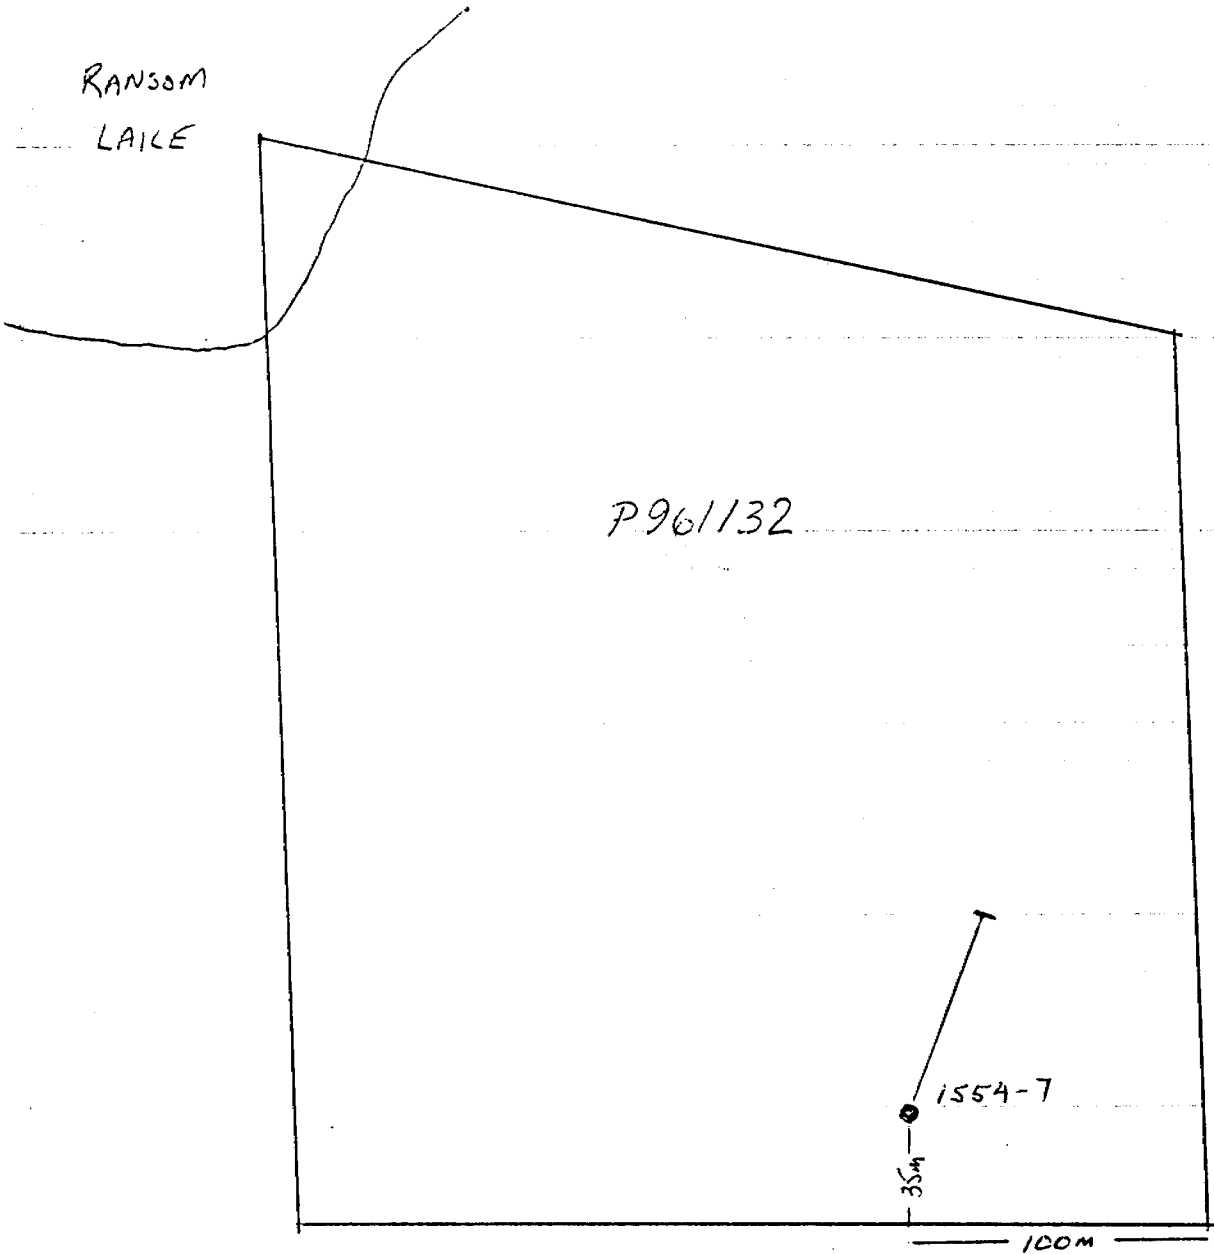

Scale 1:2500



W9006-60460

DOCUMENT No.
W 9006-60460

- Refer to Sections 76 and 77, the Mining Act for assessment work requirements and the reverse side of this form for table of information.

Mining Act

Report of Work

Name and Address of Recorded Holder Teck Explorations Limited	Prospector's Licence No. A32498
P.O. Box 170, Suite 7000, 1 First Canadian Place, Toronto	Telephone No. 416-862-7102

Summary of Distribution of Credits and Work Performance

Mining Division Porcupine	Mining Claim			Mining Claim			Mining Claim		
	Prefix	Number	Work Days Cr.	Prefix	Number	Work Days Cr.	Prefix	Number	Work Days Cr.
Township or Area Cunningham Twp.	P	961130	16	P	1013152	16			
Total Assessment Credits Claimed 326.5	P	961131	16	P	1013168	60			
Type of Work Performed (Check one only) <input type="checkbox"/> Manual Work <input type="checkbox"/> Shaft Sinking Drifting or other Lateral Work <input type="checkbox"/> Mechanical equipment <input type="checkbox"/> Power Stripping other than Manual (maximum credit allowed - 100 days per claim) <input checked="" type="checkbox"/> Diamond or other Core drilling <input type="checkbox"/> Core Specimens	P	961132	18.5						
	P	961133	16						
	P	1013133	60						
	P	1013147	60						
	P	1013148	16						
	P	1013149	16						
P	1013150	16							
P	1013151	16							

Dates when work was performed From: June 22/90 To: June 24/90	Total No. of Days Performed 326.5	Total No. of Days Claimed 326.5	Total No. of Days to be Claimed at a Future Date - 0 -
--	---	---	--

All the work was performed on Mining Claim(s): Indicate no. of days performed on each claim. * (See note No. 1 on reverse side)		Mining Claim 961132	No. of Days 326.5	Mining Claim	No. of Days	Mining Claim	No. of Days	Mining Claim	No. of Days	Mining Claim	No. of Days
Mining Claim	No. of Days	Mining Claim	No. of Days	Mining Claim	No. of Days	Mining Claim	No. of Days	Mining Claim	No. of Days	Mining Claim	No. of Days

Required Information eg. type of equipment, Names, Addresses, etc. (See Table on reverse side)
If space below is insufficient, attach schedules with required information and location sketches

Norex Drilling, Timmins, Ontario

June 22, 1990 to June 24, 1990

Certification of Beneficial Interest * (See Note No. 2 on reverse side)

I hereby certify that, at the time the work was performed, the claims covered in this report of work were recorded in the current recorded holder's name or held under a beneficial interest by the current recorded holder.

Date: **July 26, 1990**

Recorded Holder or Agent (Signature): *[Signature]*

Certification Verifying Report of Work

I hereby certify that I have a personal and intimate knowledge of the facts set forth in the Report of Work annexed hereto, having performed the work or witnessed same during and/or after its completion and the annexed report is true.

Name and Address of Person Certifying
K. Thorsen, 2189 Algonquin Avenue, North Bay, Ontario P1B 4Z3

Telephone No. **705-474-5500**

Date: **July 26, 1990**

Certified By (Signature): *[Signature]*

For Office Use Only



Work Assignments		Received Stamp	
------------------	--	----------------	--

SWAYZE TWP.

3M

4M

5M

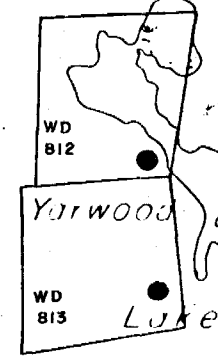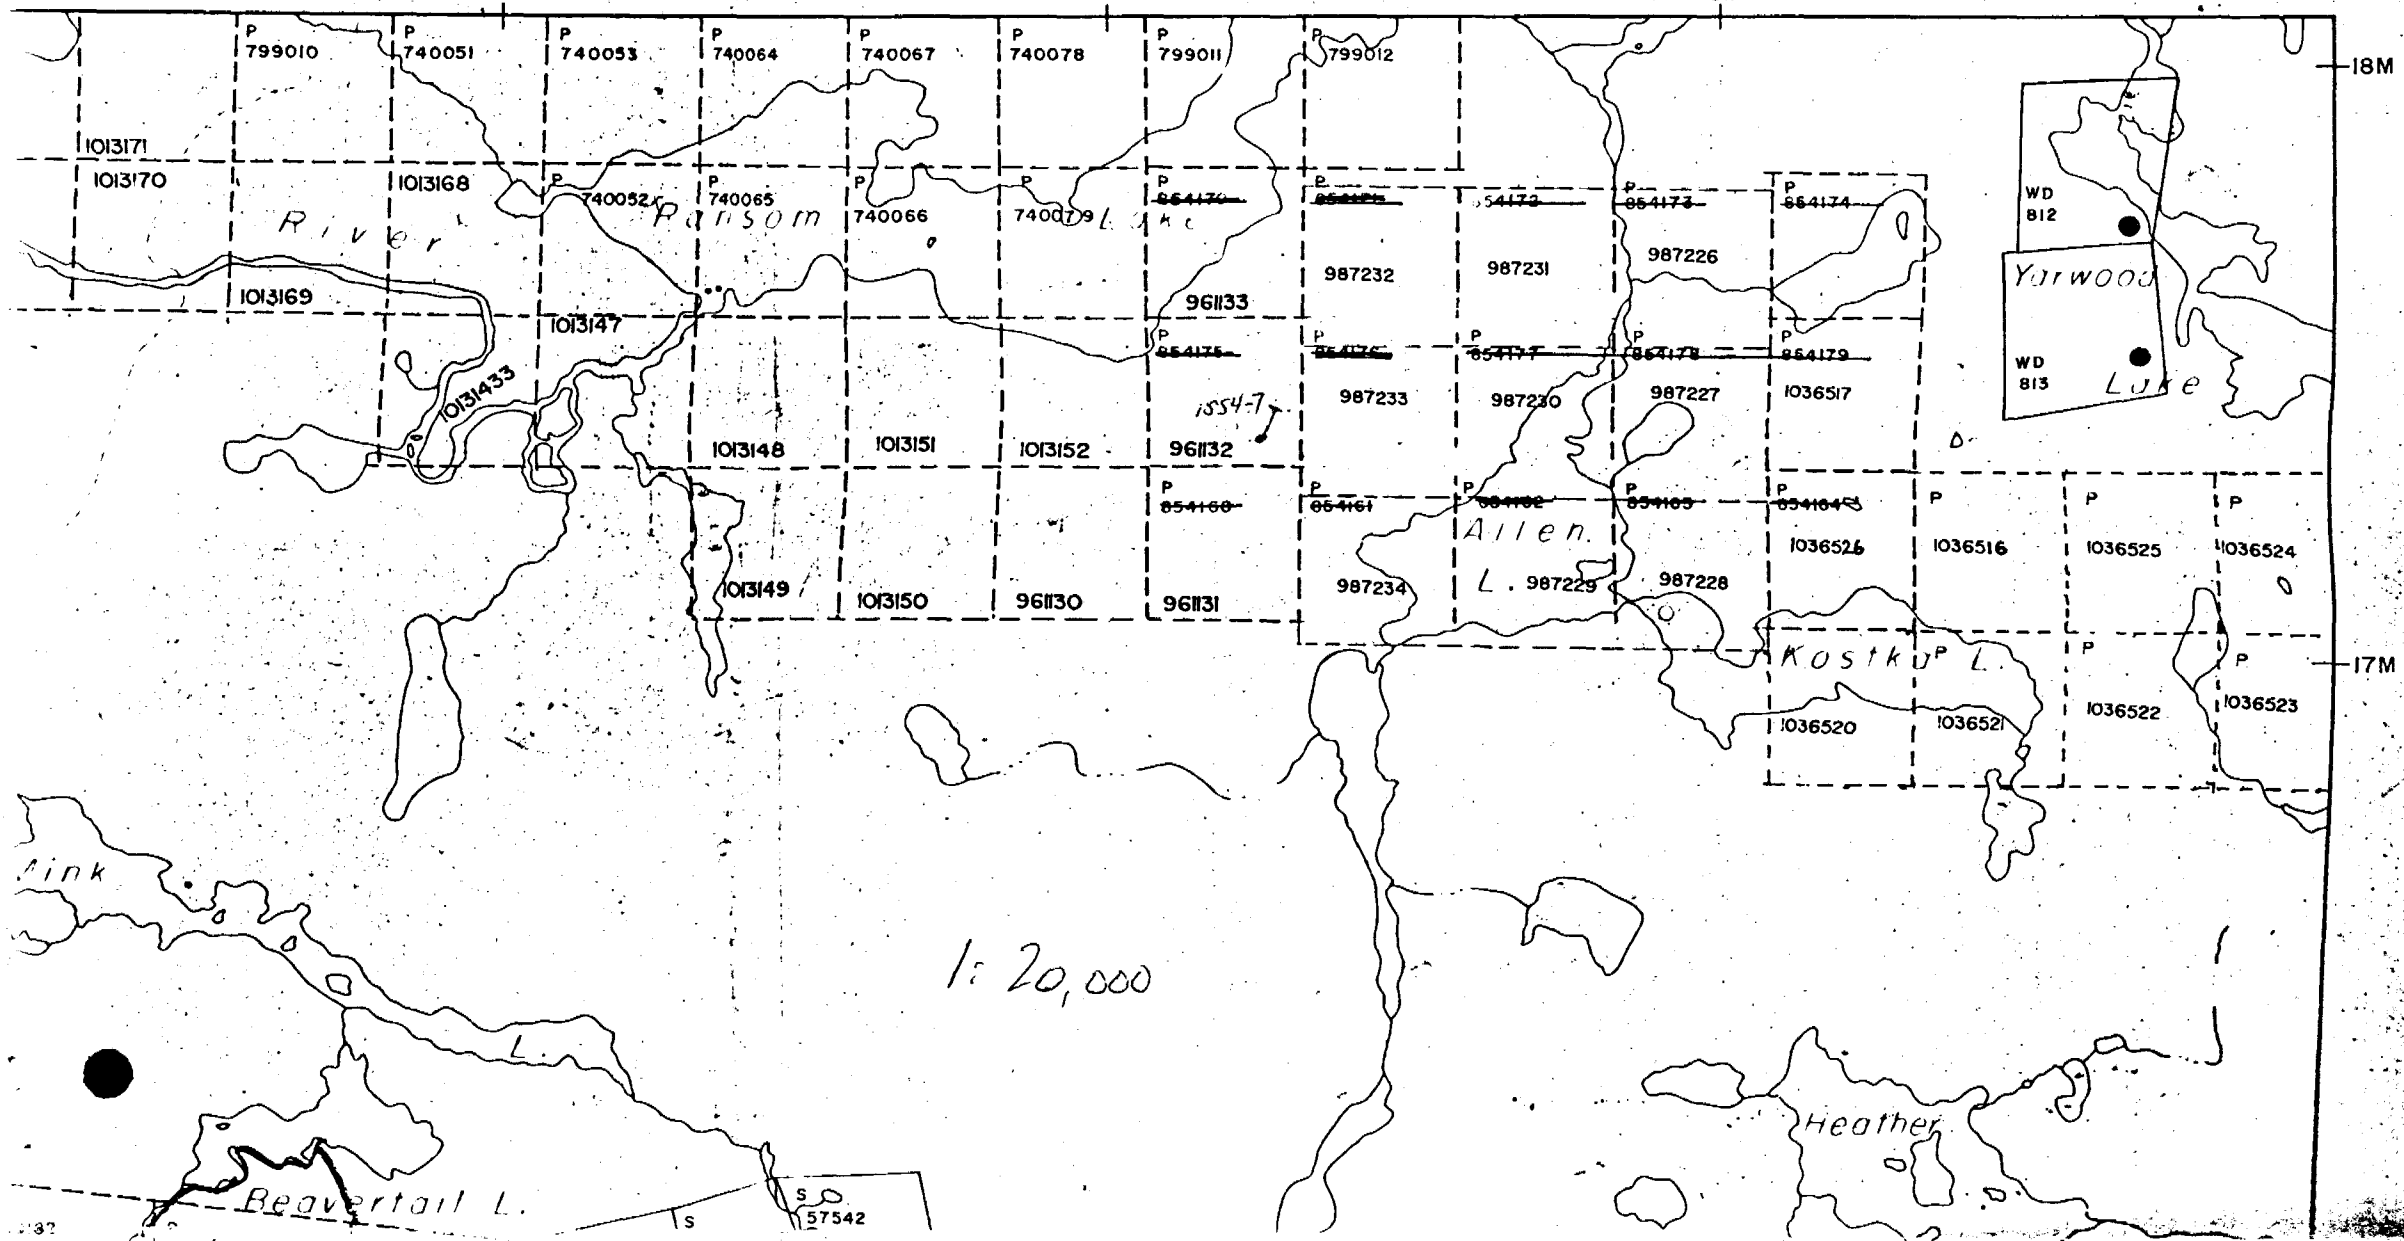

MAGNETIC DECLINATION 9° WEST

SWAYZE TWP.



CUNNINGHAM
TWP.

2M

3M

4M

5M

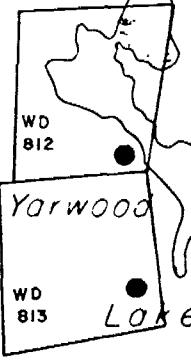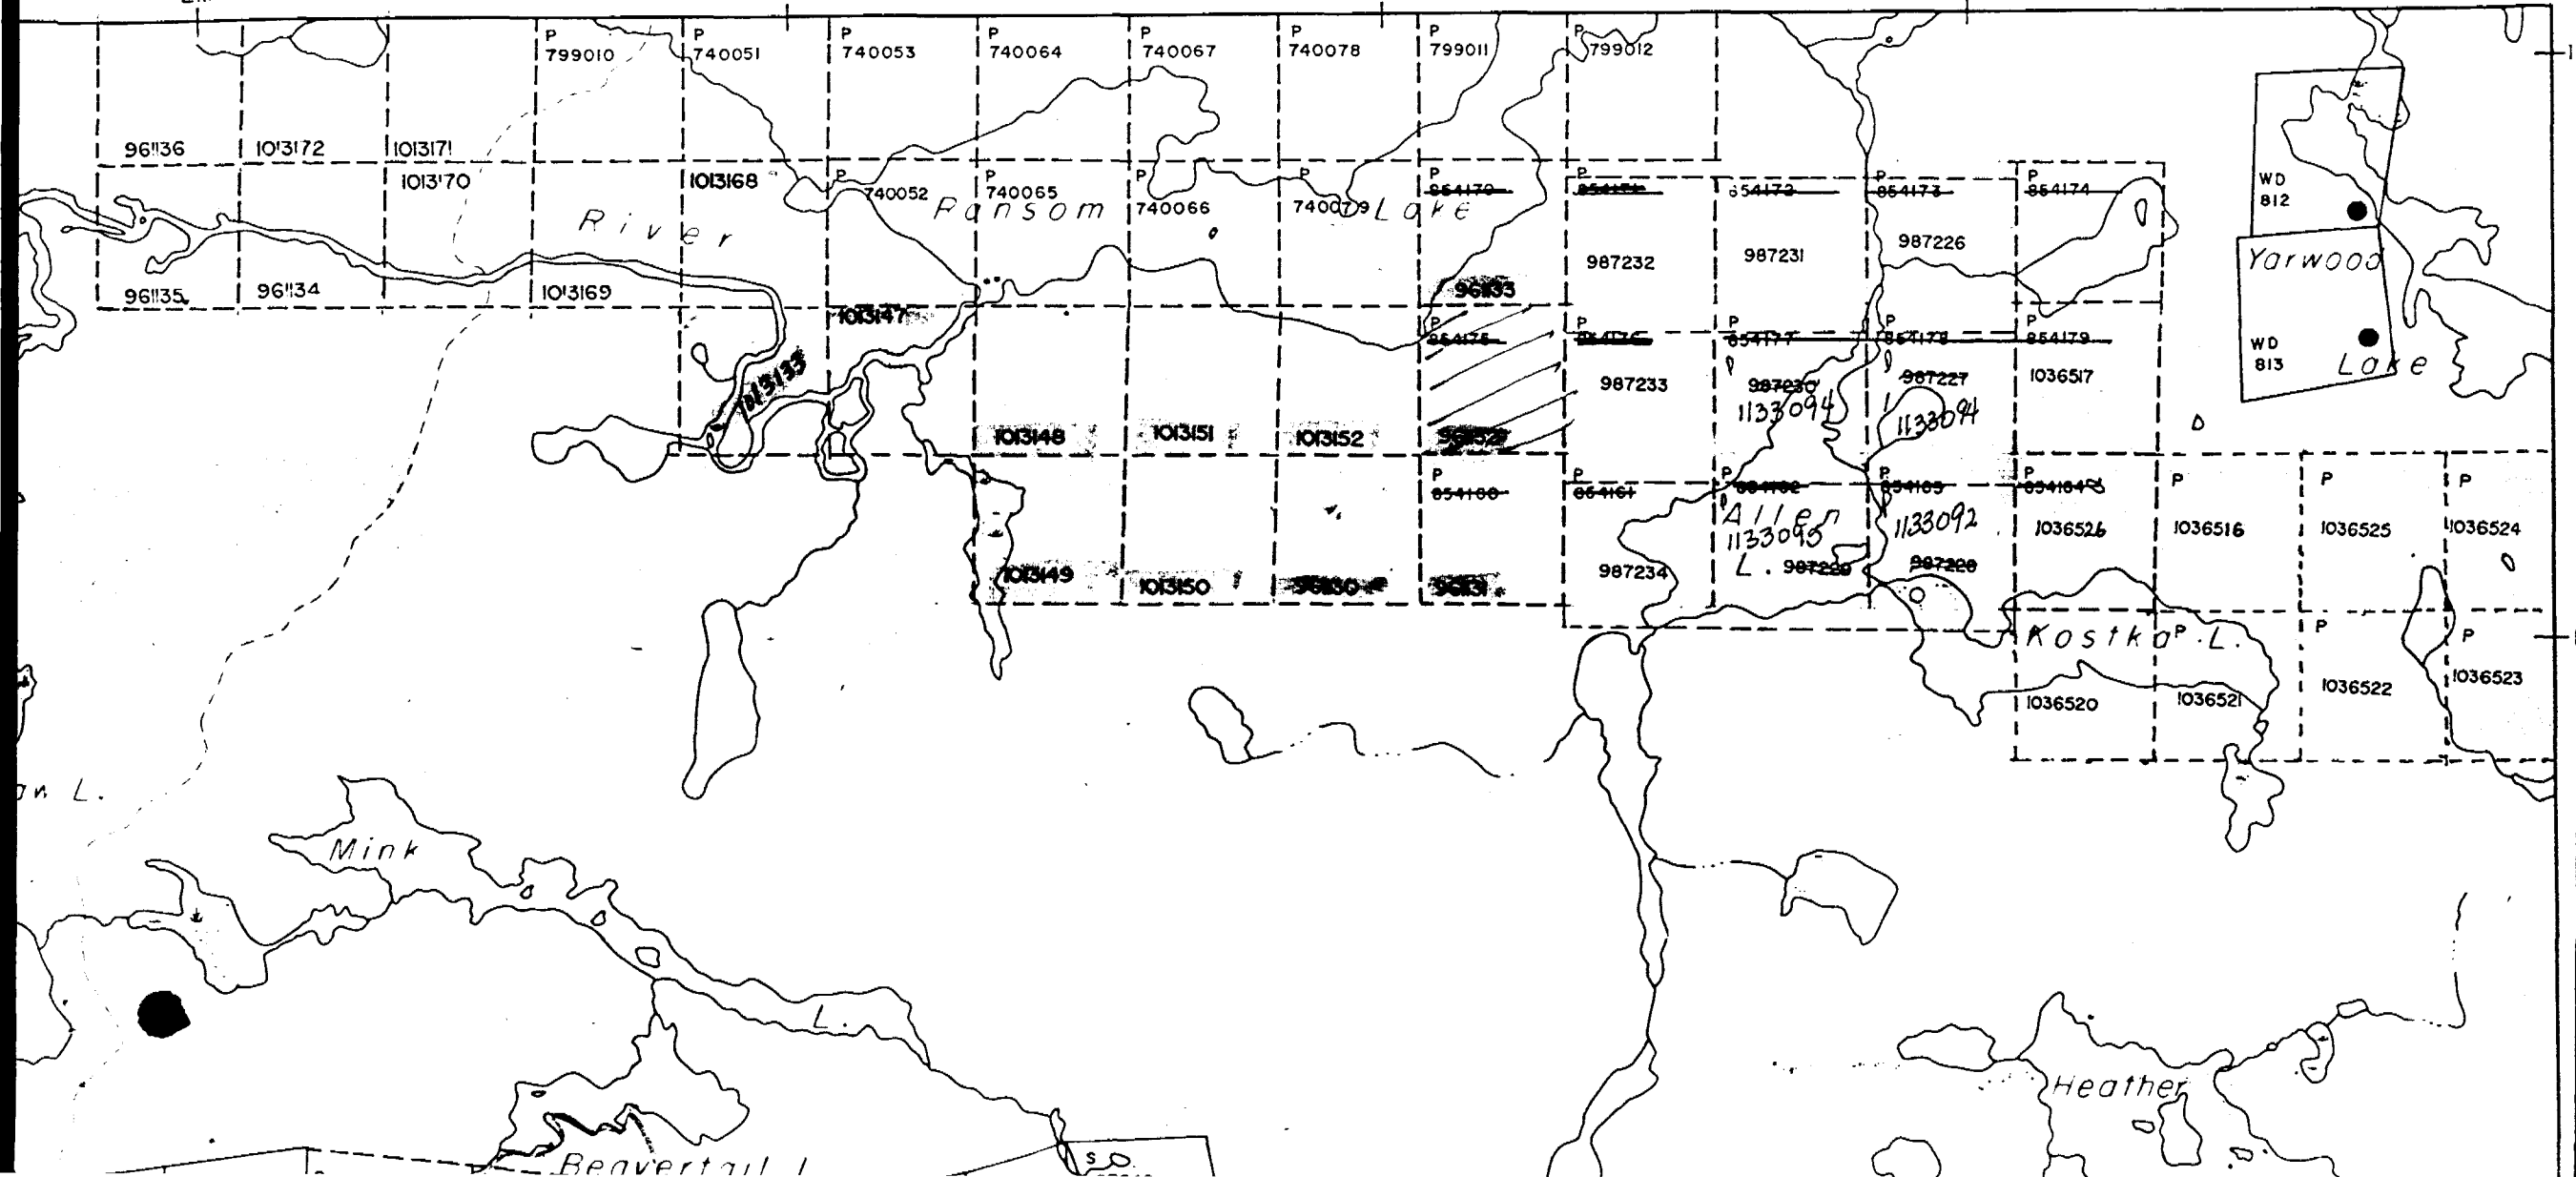

on L.

Mink

L.

Beaver Tail L.

Heather

SD