



42A04NW0058 11 SEWELL

010

### Diamond Drilling

Township of Sewell

Report NO: 11

Work performed by: Cons. Thor Mines

Claim NO	Hole NO	Footage	Date	Note
S-91674	2	493'	Apr/56	
	3	457'	Apr/56	
	4	654'	May/56	
	5	568'	May/56	
S-91673	7	369'	July/56	
	8	608'	July/56	
		<u>3149'</u>		

Notes:

Co-ordinates of Collar **W13314**  
**S 595**

COMPANY Consolidated Thor Mines Ltd Logged by:

Claim No. **5-6-321** D.D.H# **2**

Dip **50°** Strike **S 9E**


PROPERTY **Sewell Township**

*[Signature]*  
 Signature

**591674**

Date: **April 1956**

Sample Number	Mr/Hr	Dist. from ft.	Formation	Width ft.	Assay Value \$	%	%	Oz.	Oz.	Remarks
		0 - 22	Over burden							Casing
		22 - 80	Andesite	58						Much augite or hornblende. Mottled appearance
		80 - 96	Andesite	16						Calcite & quartz stringers here
		96 - 121	"	25						With very scant pyrite.
		121 - 149		28						Altered. Minor pyrite throughout.
		149 - 185.5		36.5						Altered. Numerous vein stringers. Minor pyrite.
37		185.5-188.9		3.4						15% pyrrhotite
		188.9-190.2	Andesite	1.3						Barren
38		190.2-191.7		1.5						15% pyrrhotite
		191.7-196.5	Andesite	4.8						Barren
39		196.5-200.2		3.7						15% pyrrhotite
		200.2-201.5	Andesite	1.3						Barren
40		201.5-209.5		8						15% pyrrhotite
41		209.5-216		<del>7.2</del>						15% pyrrhotite
		216- 335	Andesite	119						Greenish
		335-350	Andesite	15						Dark grey.
		350-450	Gabbro	100						Probably volcanic origin. Gradational contact.
		450-493	Dark grey rhyolite	43						
		493	END OF HOLE	<i>[Signature]</i>						

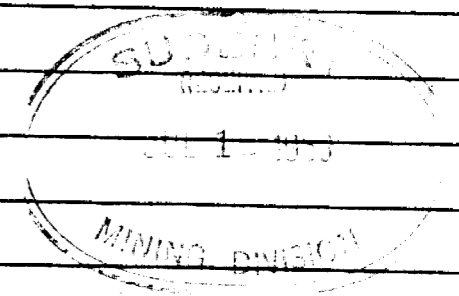

Co-ordinates of Collar: W13314

COMPANY Consolidated Thor Mines Ltd Logged by:


Claim No.

D.D.H# 3

Dip 65°

Strike S595  
S9°E

PROPERTY Sewell Township


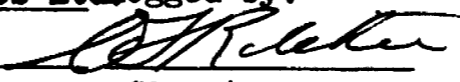


S-91674

Date: April 13/56

Signature

Sample Number	Mr/ Hr	Dist. from ft.	Formation	Width ft.	Assay Value \$	%	%	Oz.	Oz.	Remarks
		0 - 21	Overburden							Casing
		21- 37	Andesite	16						Altered
		37-102	"	65						Mottled with augite & hornblende.
		102-115	"	13						Numerous vein stringers. Minor pyrite.
		115-118	"	3						Mottled. Minor pyrite
		118-122	"	4						Numerous stringers. Minor pyrite.
		122-133	"	11						Mottled. Minor pyrite.
		133-136	"	3						Minor pyrite.
		<del>136-143</del>	"	7						Mottled. Lathes of pyroxene <del>XXXXXXXXXXXXXXXXXXXXXXXXXXXXXXXXXXXX</del>
		143-153	"	10						Mottled. Lathes of pyroxene.
		153-155	"	2						Andesite. Not mottled
		155-157	"	2						Mottled. Minor pyrite & chalcopyrite.
		157-173	"	16						Numerous stringers of quartz. Minor pyrite.
		173-188	"	15						Mottled as above. Minor pyrite and chalcopyrite.
		188-191	"	3						Barren. No stringers.
		191-216	"	25						Very scant pyrite.
		216-240	"	24						Mottled.
		240-289	"	49						Barren.
		289-314	"	25						Many barren stringers
		314-349	"	35						Green but turning grey.
		349-386	Rhyolite	37						Dark grey cherty rhyolite.
		386-457	Gabbro	71						Probably part of a thick flow.
		457	END OF HOLE.							

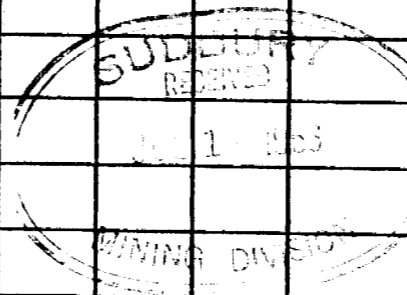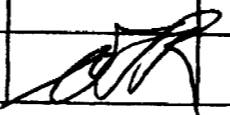Co-ordinates of Collar: W13257

COMPANY Consolidated Thor Mines Ltd Logged by:

Claim No.

D.D.H# 4

Dip 45° Strike S657 S90°W


PROPERTY Sewell Township

*[Signature]*  
Signature

S 91674

Date: May 1956

Sample Number	Mr/Hr	Dist. from ft.	Formation	Width ft.	Assay Value \$	%	%	Oz.	Oz.	Remarks
		0- 50	Overburden	50						Casing
		50-152	Andesite	12						
		152-162	Rhyolite	10						
		162-321.5	Andesite	159.5						
		321.5-325	Diorite	3.5						Barren of sulphides
		325-654	Andesite	329						
		654	END OF HOLE							
		95-147	Quartz threads and stringers							numerous - one about every 2 feet
		162-321.5	"	"	"	"	"	"	"	" 2 "
		325-654	"	"	"	"	"	"	"	" 2 "
			Very minor pyrrhotite, chalcopyrite and pyrite throughout almost entire core.							
			Eutaxitic banding at 45° to length of hole.							
			<i>[Signature]</i>							

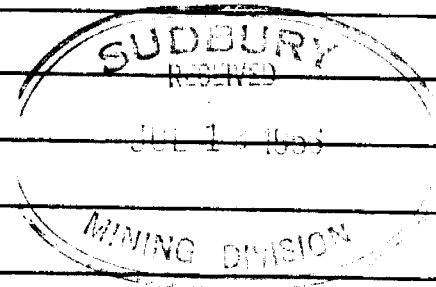

Co-ordinates of Collar: **W13036**  
**S538**

COMPANY **Consolidated Thor Mines Ltd**, logged by:

Claim No.

D.D.H# **5**

Dip **50°**

Strike **S 9°E**

PROPERTY **sewell Township**


*[Signature]*  
Signature

**S-1674**

Date: **May 1956**

Sample Number	Mr/Hr	Dist. from ft.	Formation	Width ft.	Assay Value \$	%	%	Oz.	Oz.	Remarks
		0 - 4	Casing	4						Overburden
		4 - 70	Diorite	66						Probably crystallized layer of andesite.
		70 - 78	Andesite	8						It is observed, however, that the diorite in these holes is never as well mineralized as the fine grained andesite. The contacts are gradational.
		78 - 100	Diorite	22						
		100-104	Quartz vein	4						
		104-568	Andesite	464						
		568	END OF HOLE							
<p>Flow lines are generally 50° to 60° to core axis as are most of the quartz stringers.</p> <p>Chalcopyrite, pyrrhotite and pyrite, generally associated, are found in very minor amounts throughout most of the core.</p>										

*[Signature]*

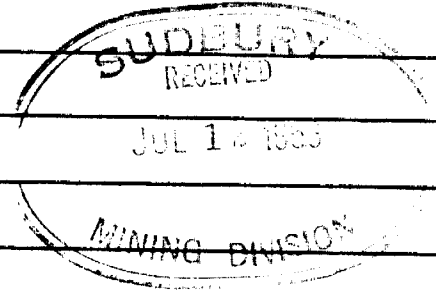

Co-ordinates of Collar: **W1400**  
**W12700**

COMPANY **Consolidated Thor Mines Ltd** Logged by:

Claim No.

D.D.H# 7

Dip **45°**

Strike **South**

PROPERTY **Sewell Twp.**

*[Signature]*  
Signature

**S-91673**

Date: **July 3/56**

Sample Number	Mr/Hr	Dist. from ft.	Formation	Width ft.	Assay Value \$	%	%	Oz.	Oz.	Remarks
		0 - 10	Overburden	10						Casing
		10 - 56	Gabbro	46						Coarse intrusive gabbro cut by narrow pink granite and felsite dykelets. Contacts of dykelets are 80° to 90° to length of hole. Dark grey. Traces chalcopryite and pyrite.
		56 - 59	Andesite	3						
		59 - 117	Gabbro	58						Cut by granite as above.
		117 - 127	Volcanic	10						Highly silicified and sheared volcanic. Greenish. Contacts sharp, about 48° to core axis. More basic. Sheared.
		127 - 196	Andesite	69						
		196 - 206.5	Gabbro	10.5						Intrusive. Pyrite content quite noticeable.
		206.5 - 208	Pyrite zone	1.5						50% pyrite with definite but inconsequential chalcopryite.
		208 - 220	Andesite	12						Basic.
		220 - 245	Gabbro	25						Intrusive. Pyrite. Note pyrite is mostly confined to the gabbro or contact. The gabbro is sheared like the volcanic. Some of the shearing is therefore post intrusion.
		245 - 252	Basalt	7						Sharp contact 80° to length of hole. Sheared contact. Very minor Cu & Fe mineralization.
		252 - 254	Gabbro	2						Sheared. Contact 80° to axis.
		254 - 333	Basalt	79						Sheared at 30° to 65° to core axis. Noticeable pyrite and pyrrhotite but only minor chalcopryite. Part of the body is gabbroic. Lower contact is 70° to axis of hole.
		333 - 338	Amphibolite	5						
		338 - 365	Basalt	27						Sheared. Polished surfaces vary from 40° to zero or parallel to axis of hole.
		365	Graphite Shear	About one inch	of 20% graphite					
		365 - 369	Basalt Sheared	4						Quite Magnetic
		369	END OF HOLE							

SUBMITTED  
1 1956  
MINING DIVISION

*[Signature]*

Co-ordinates of Collar:

150' S of Hole No. 7  
Dip 45° Strike SouthCOMPANY Cons. Thor Mines Limited

Logged by:

Claim No.


D.D.H# 8

PROPERTY Sewell TownshipC. F. Ritchie  
Signature8-91673Date: July 17-July 29/56

Sample Number	Mr/ Hr	Dist. from ft.	Formation	Width ft.	Assay Value \$	%	%	Oz.	Oz.	Remarks
		0 - 12	Overburden	12						Casing.
		12 - 29.5	Gabbro	17.5						Coarse - Grey. Diorite.
		29.5-33	Gabbro	3.5						Minor pyrite and chalcopyrite.
		33 - 90	Gabbro	57						Minor pyrrhotite.
		90 - 97	Basalt	7						Fine, black. Minor pyrite.
		97 -114	Gabbro	17						
		114- 115	Basalt	1						
		115- 117	Gabbro	2						
		117 -118	Basalt	1						
		118 -125	Basalt	7						Strong shear. Post alteration.
		125- 126	Gabbro	1						Minor pyrite.
		126 - 277	Basalt	151						Sheared. Slickensided. Some sections are coarse amphibolite.
		277-282	Gabbro	5						Recrystallized basalt.
		282-297	Basalt	15						
		297-313	Gabbro	16						Recrystallized basalt.
		313-323	Pyromorphite	10						Minor ep <sub>2</sub> sulphides.
		323-425	Gabbro	102						Recrystallized basalt or center of flow.
		425-440	Andesite	15						Green. Old qtz.-carbonate shear. 65° to core axis.
		440-470	Basic flow	30						Andesitic basalt.
		470-514	Andesite	44						Green. Schistosity here is 45° to axis.





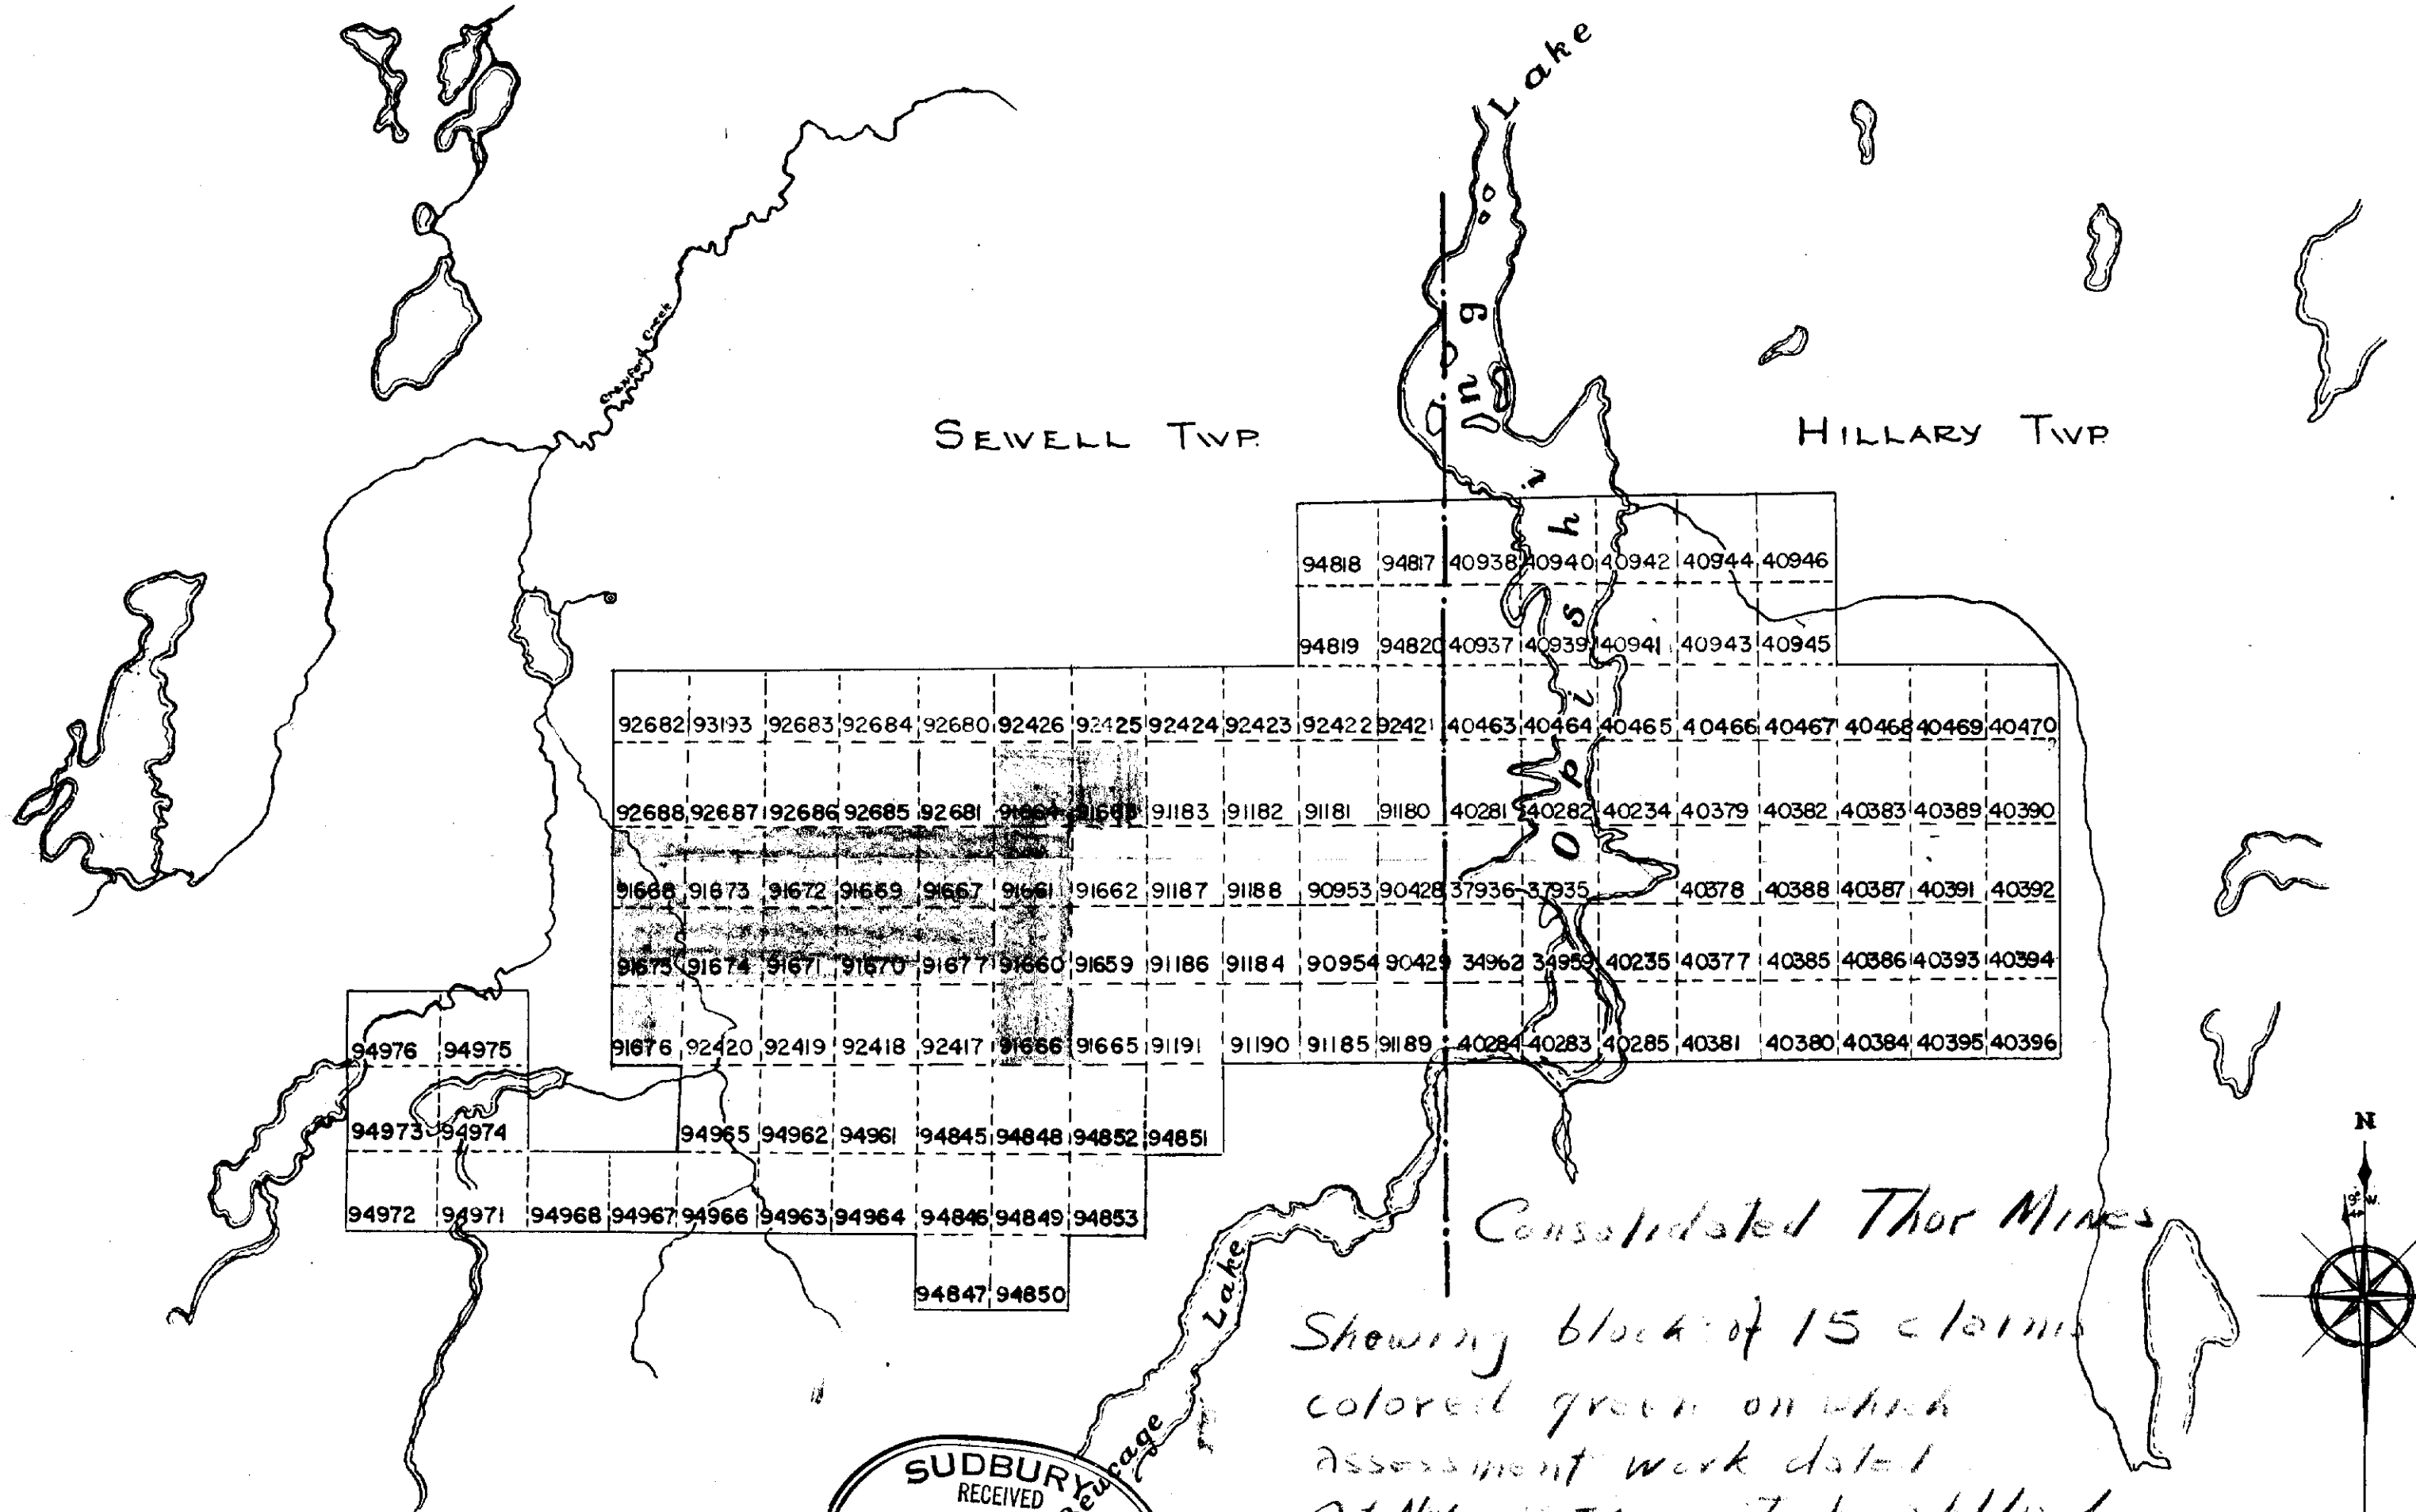


92682	93193	92683	92684	92680	92426	92425	92424	92423	92422	92421	40463	40464	40465	40466	40467	40468	40469	40470
92688	92687	92686	92685	92681	91668	91669	91183	91182	91181	91180	40281	40282	40234	40379	40382	40383	40389	40390
91666	91673	91672	91669	91667	91661	91662	91187	91188	90953	90428	37936	37935	40378	40388	40387	40391	40392	
91675	91674	91671	91670	91677	91660	91659	91186	91184	90954	90429	34962	34959	40235	40377	40385	40386	40393	40394
91676	92420	92419	92418	92417	91666	91665	91191	91190	91185	91189	40284	40283	40285	40381	40380	40384	40395	40396

94976	94975	94965	94962	94961	94845	94848	94852	94851	
94973	94974	94968	94967	94966	94963	94964	94846	94849	94853
94972	94971	94847	94850						



*Consolidated Thor Mines*  
 Showing block of 15 claims colored green on which assessment work dated Oct, Nov., 1956, is to be applied

SUDBURY RECEIVED  
 OCT 18 1956  
 MINING DIVISION

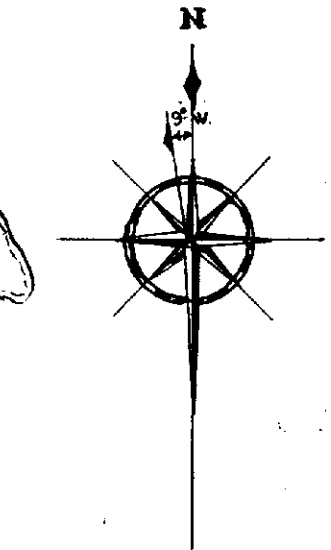

Dwg. No 416




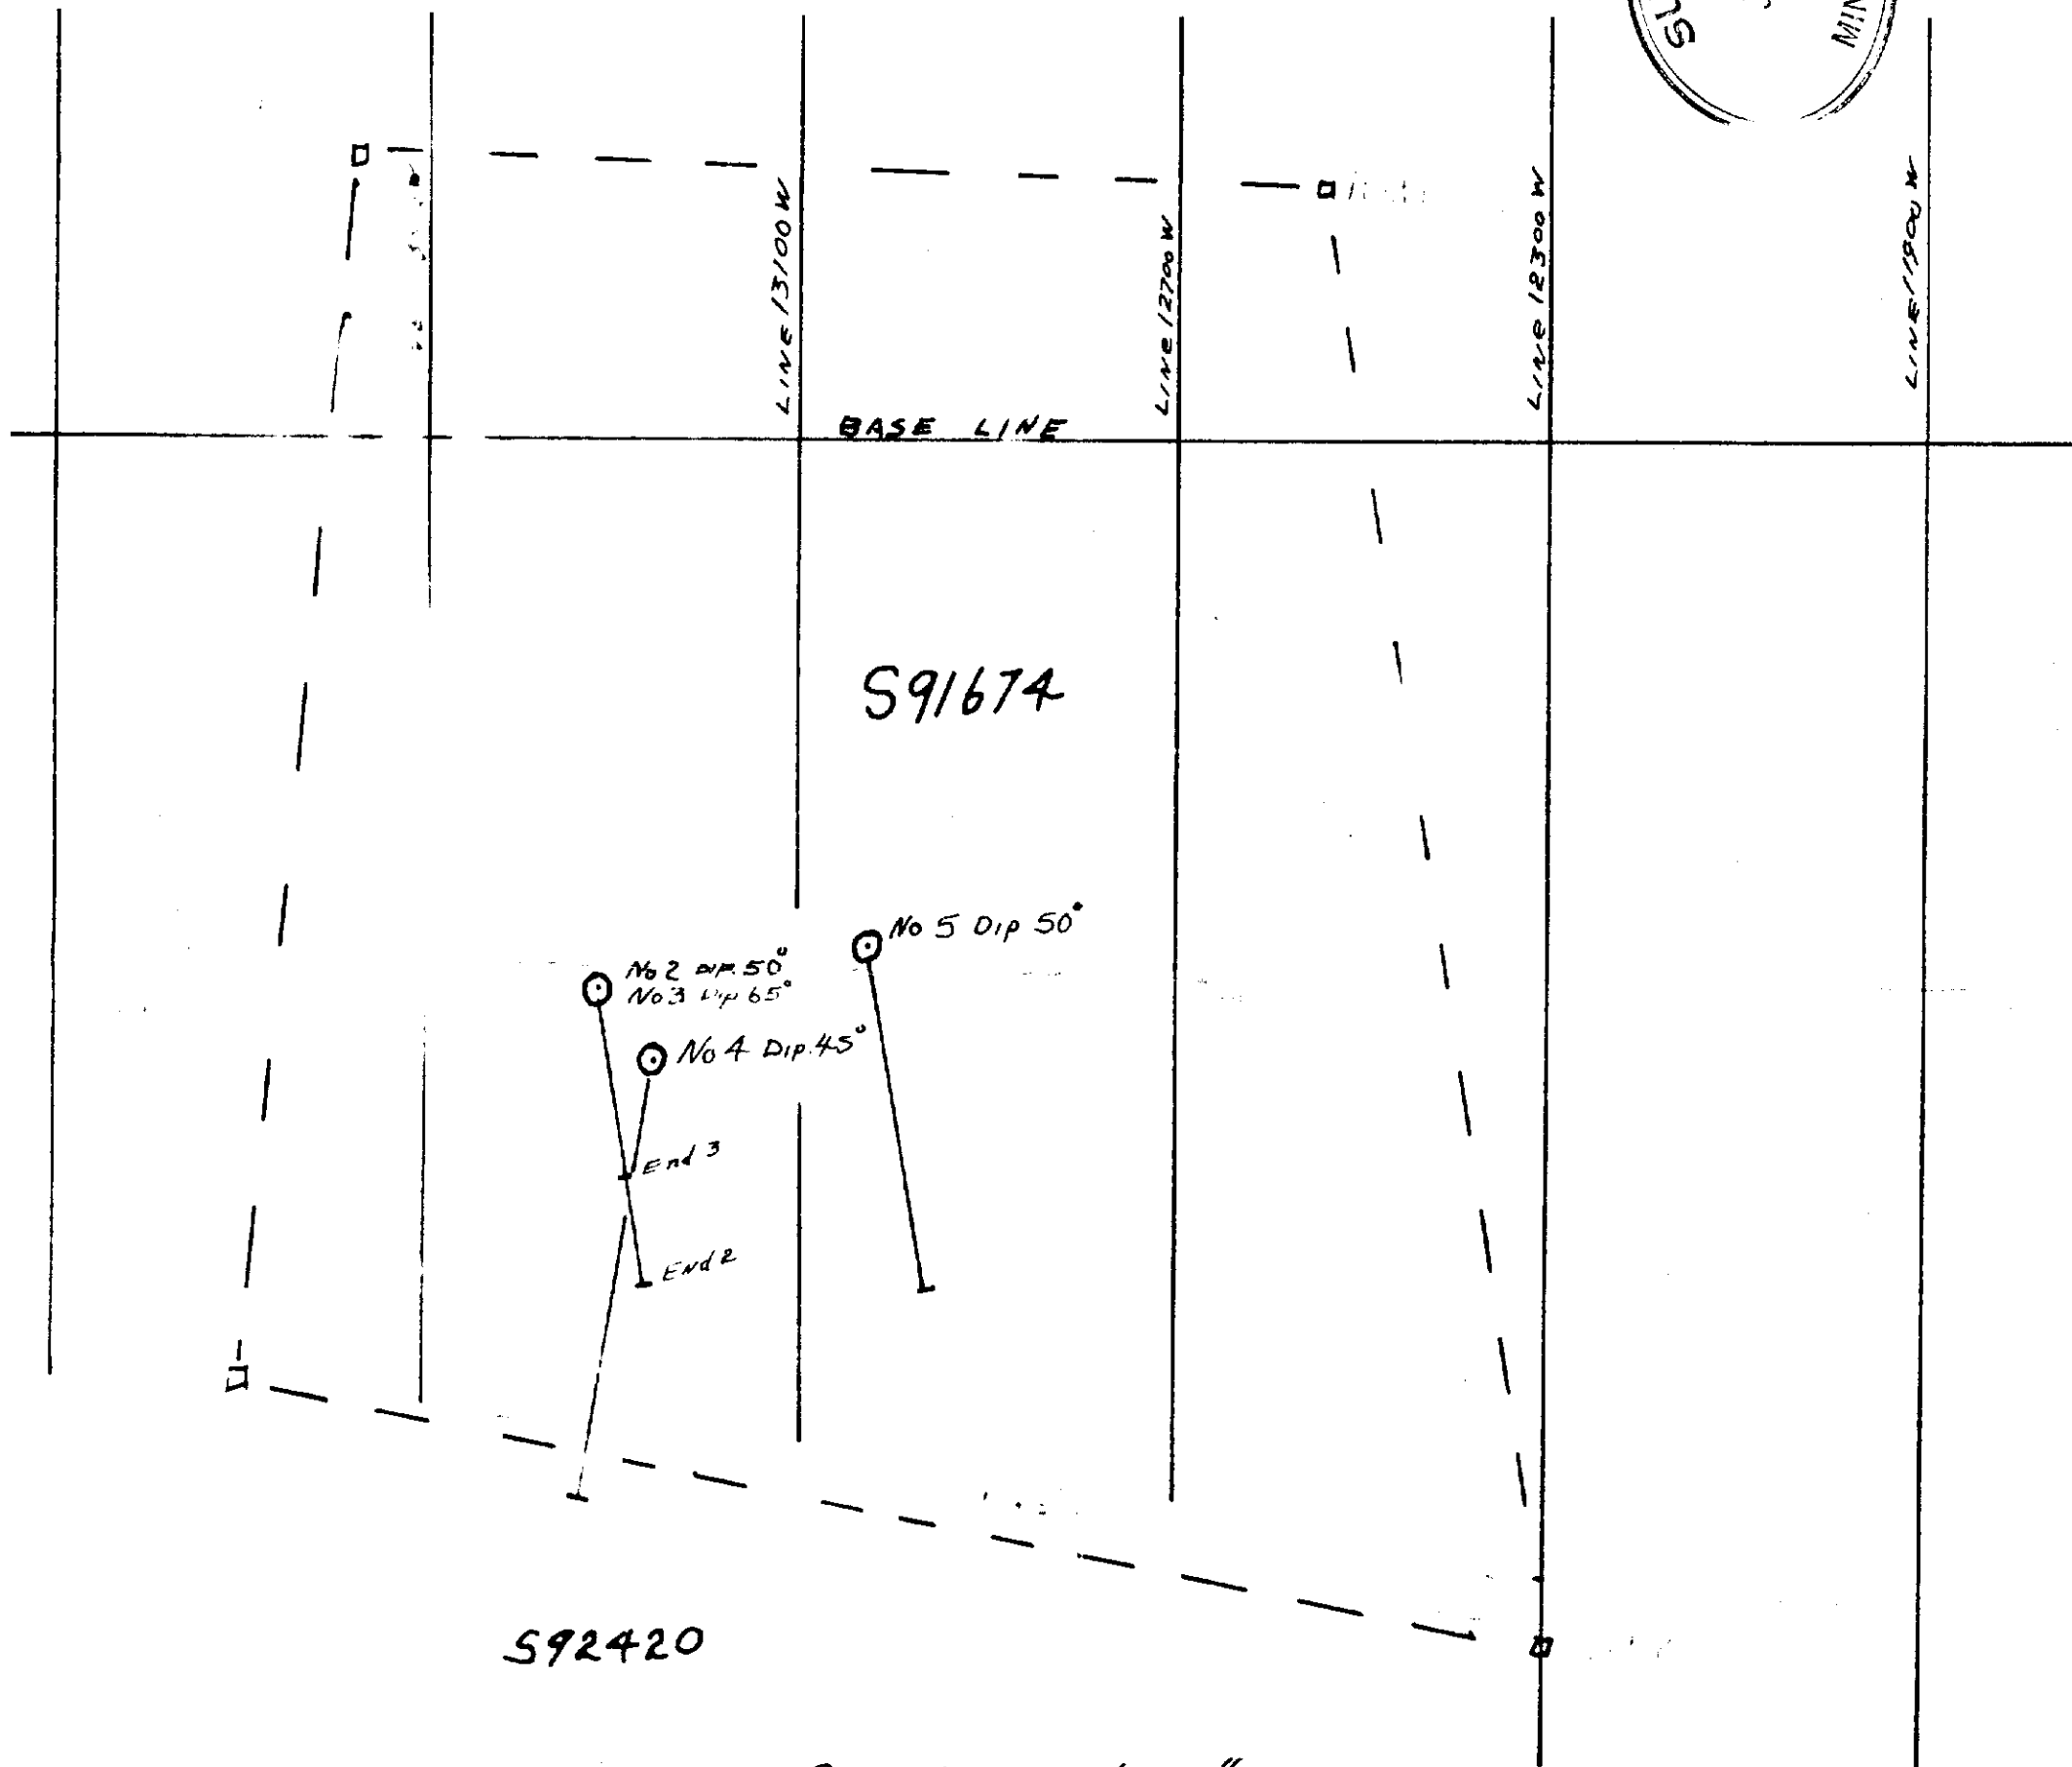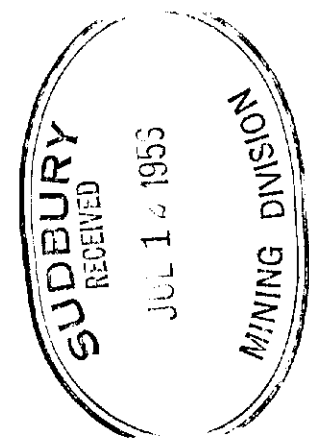

Scale 200' = 1"

Plan of Diamond Drilling on  
Claim S 91674  
Sevell Township  
Consolidated Thor Mines limited




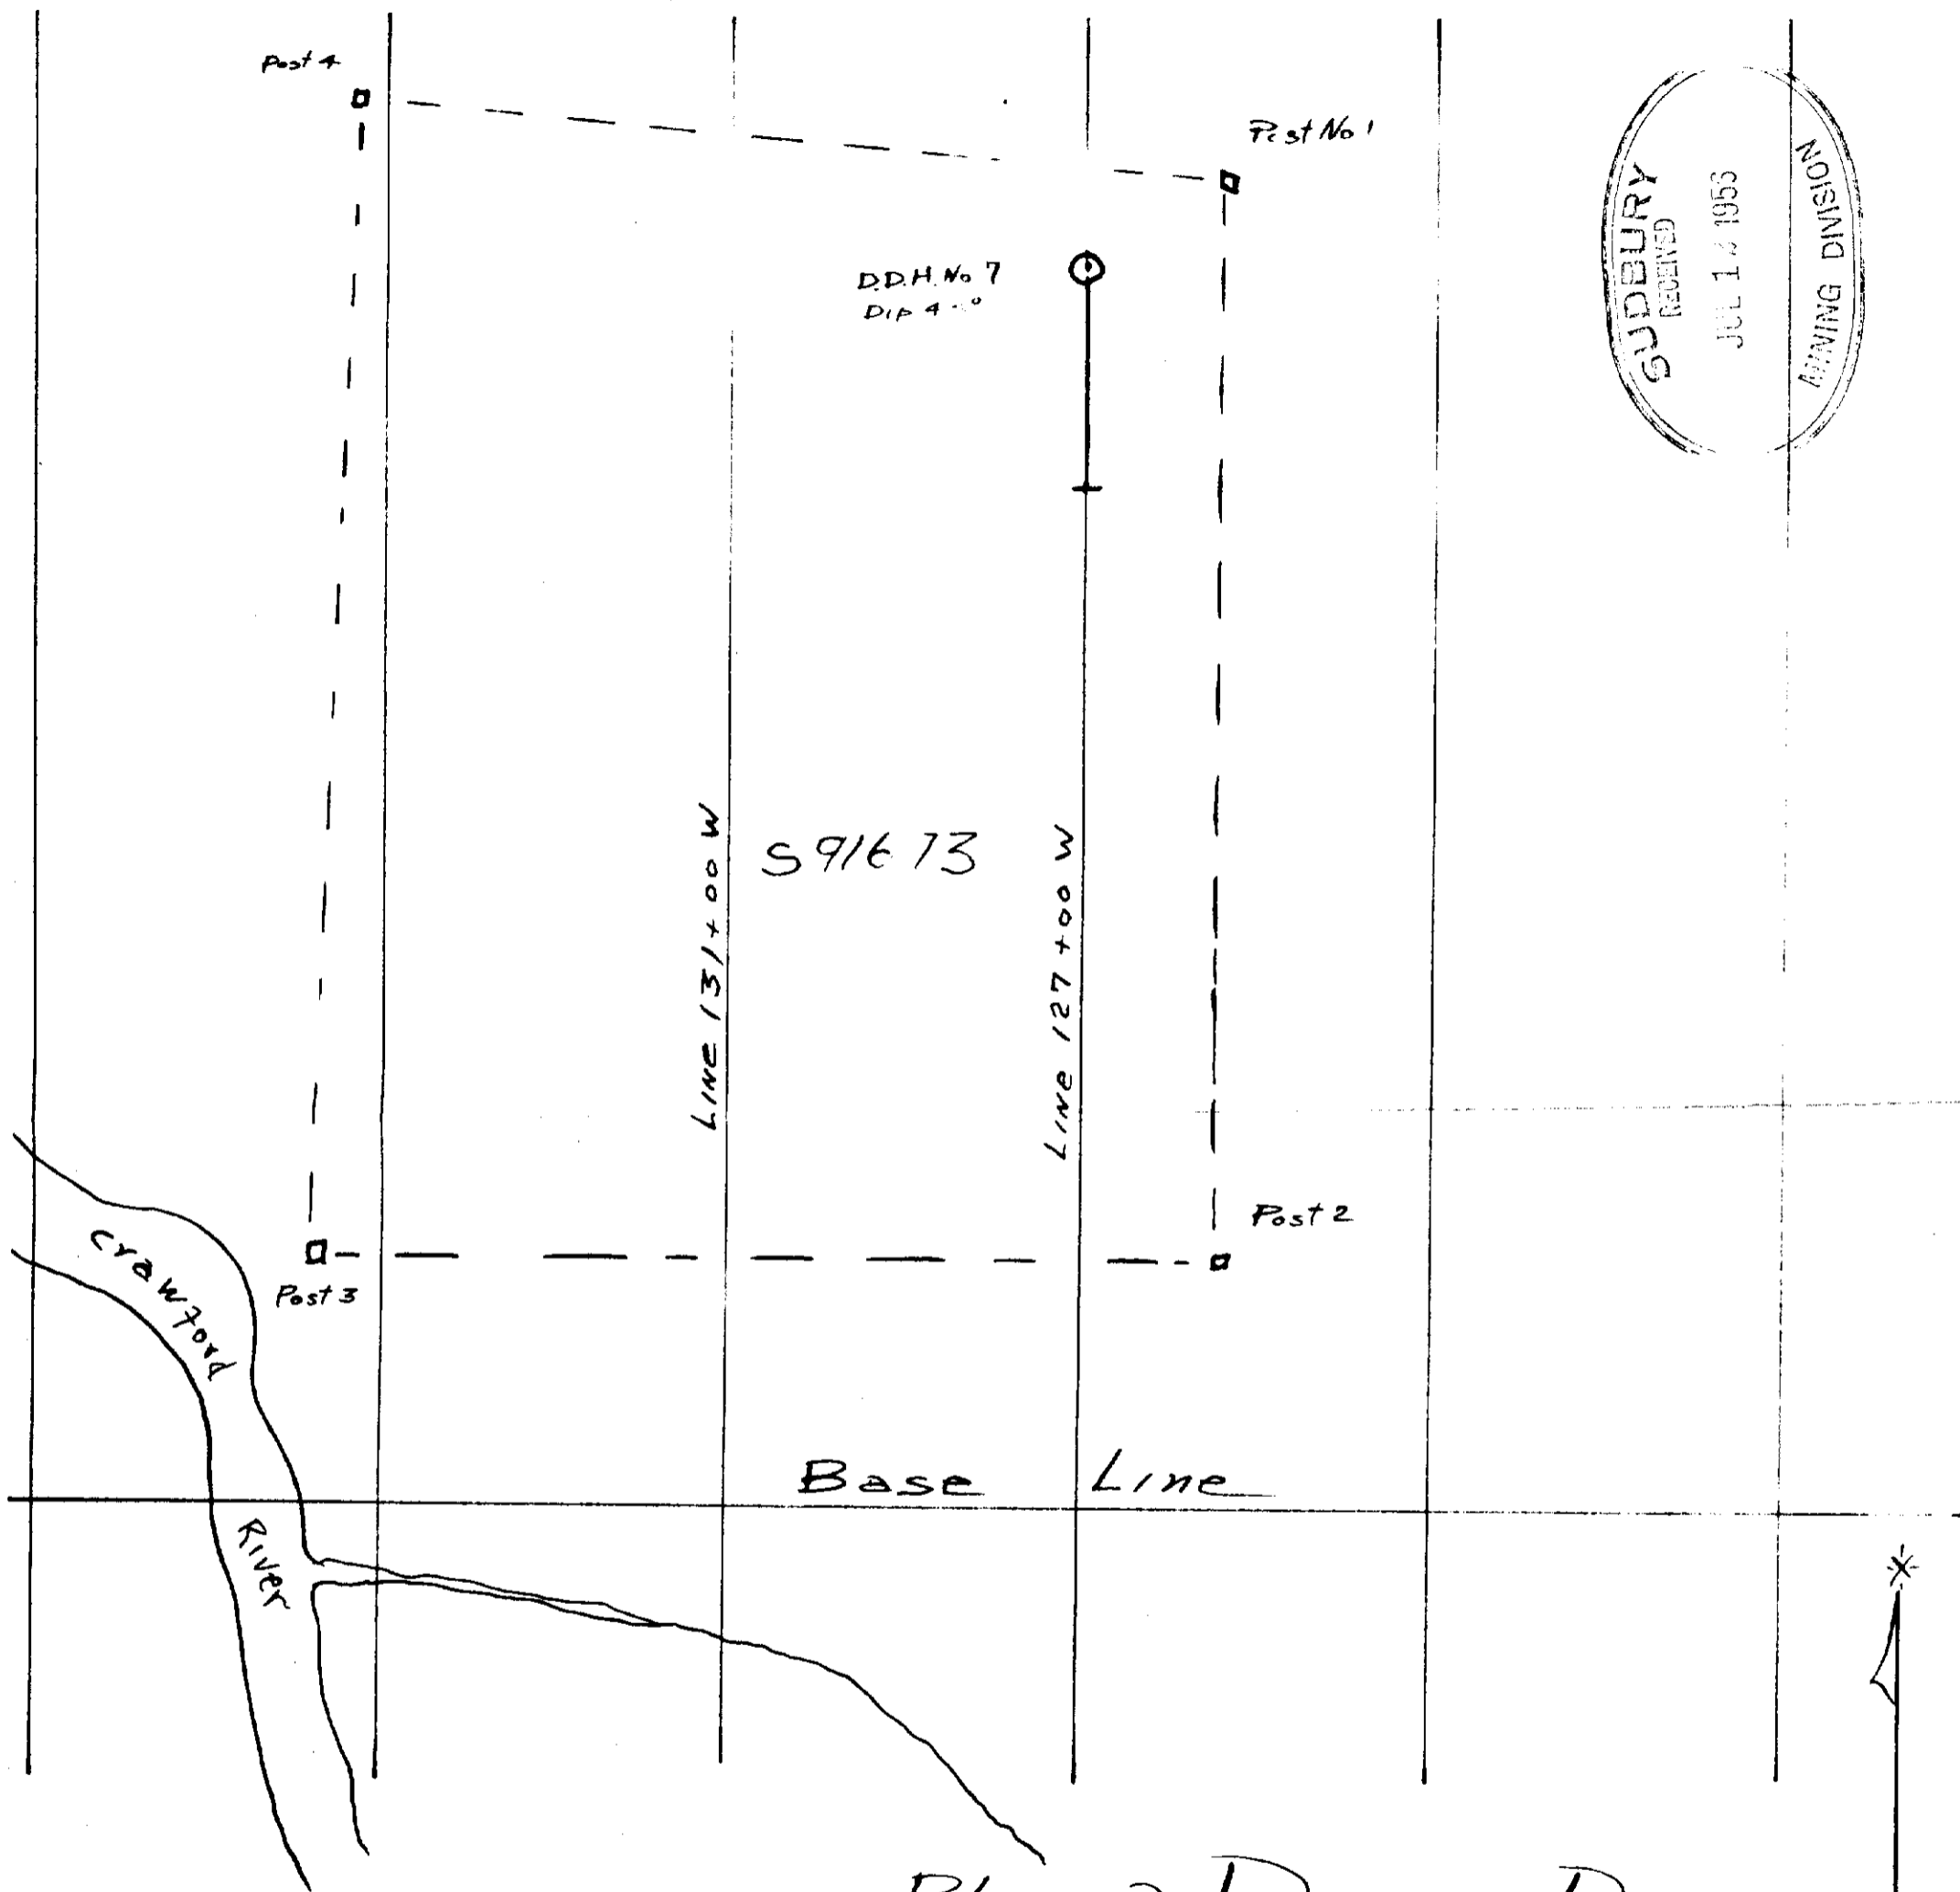

SUPPLY RECEIVED  
 JUL 14 1953  
 MINING DIVISION

Plan of Diamond Drilling  
 Claim 591673  
 Sewell Township  
 Consolidated Thor Mines Ltd  
 Scale 200' = 1"





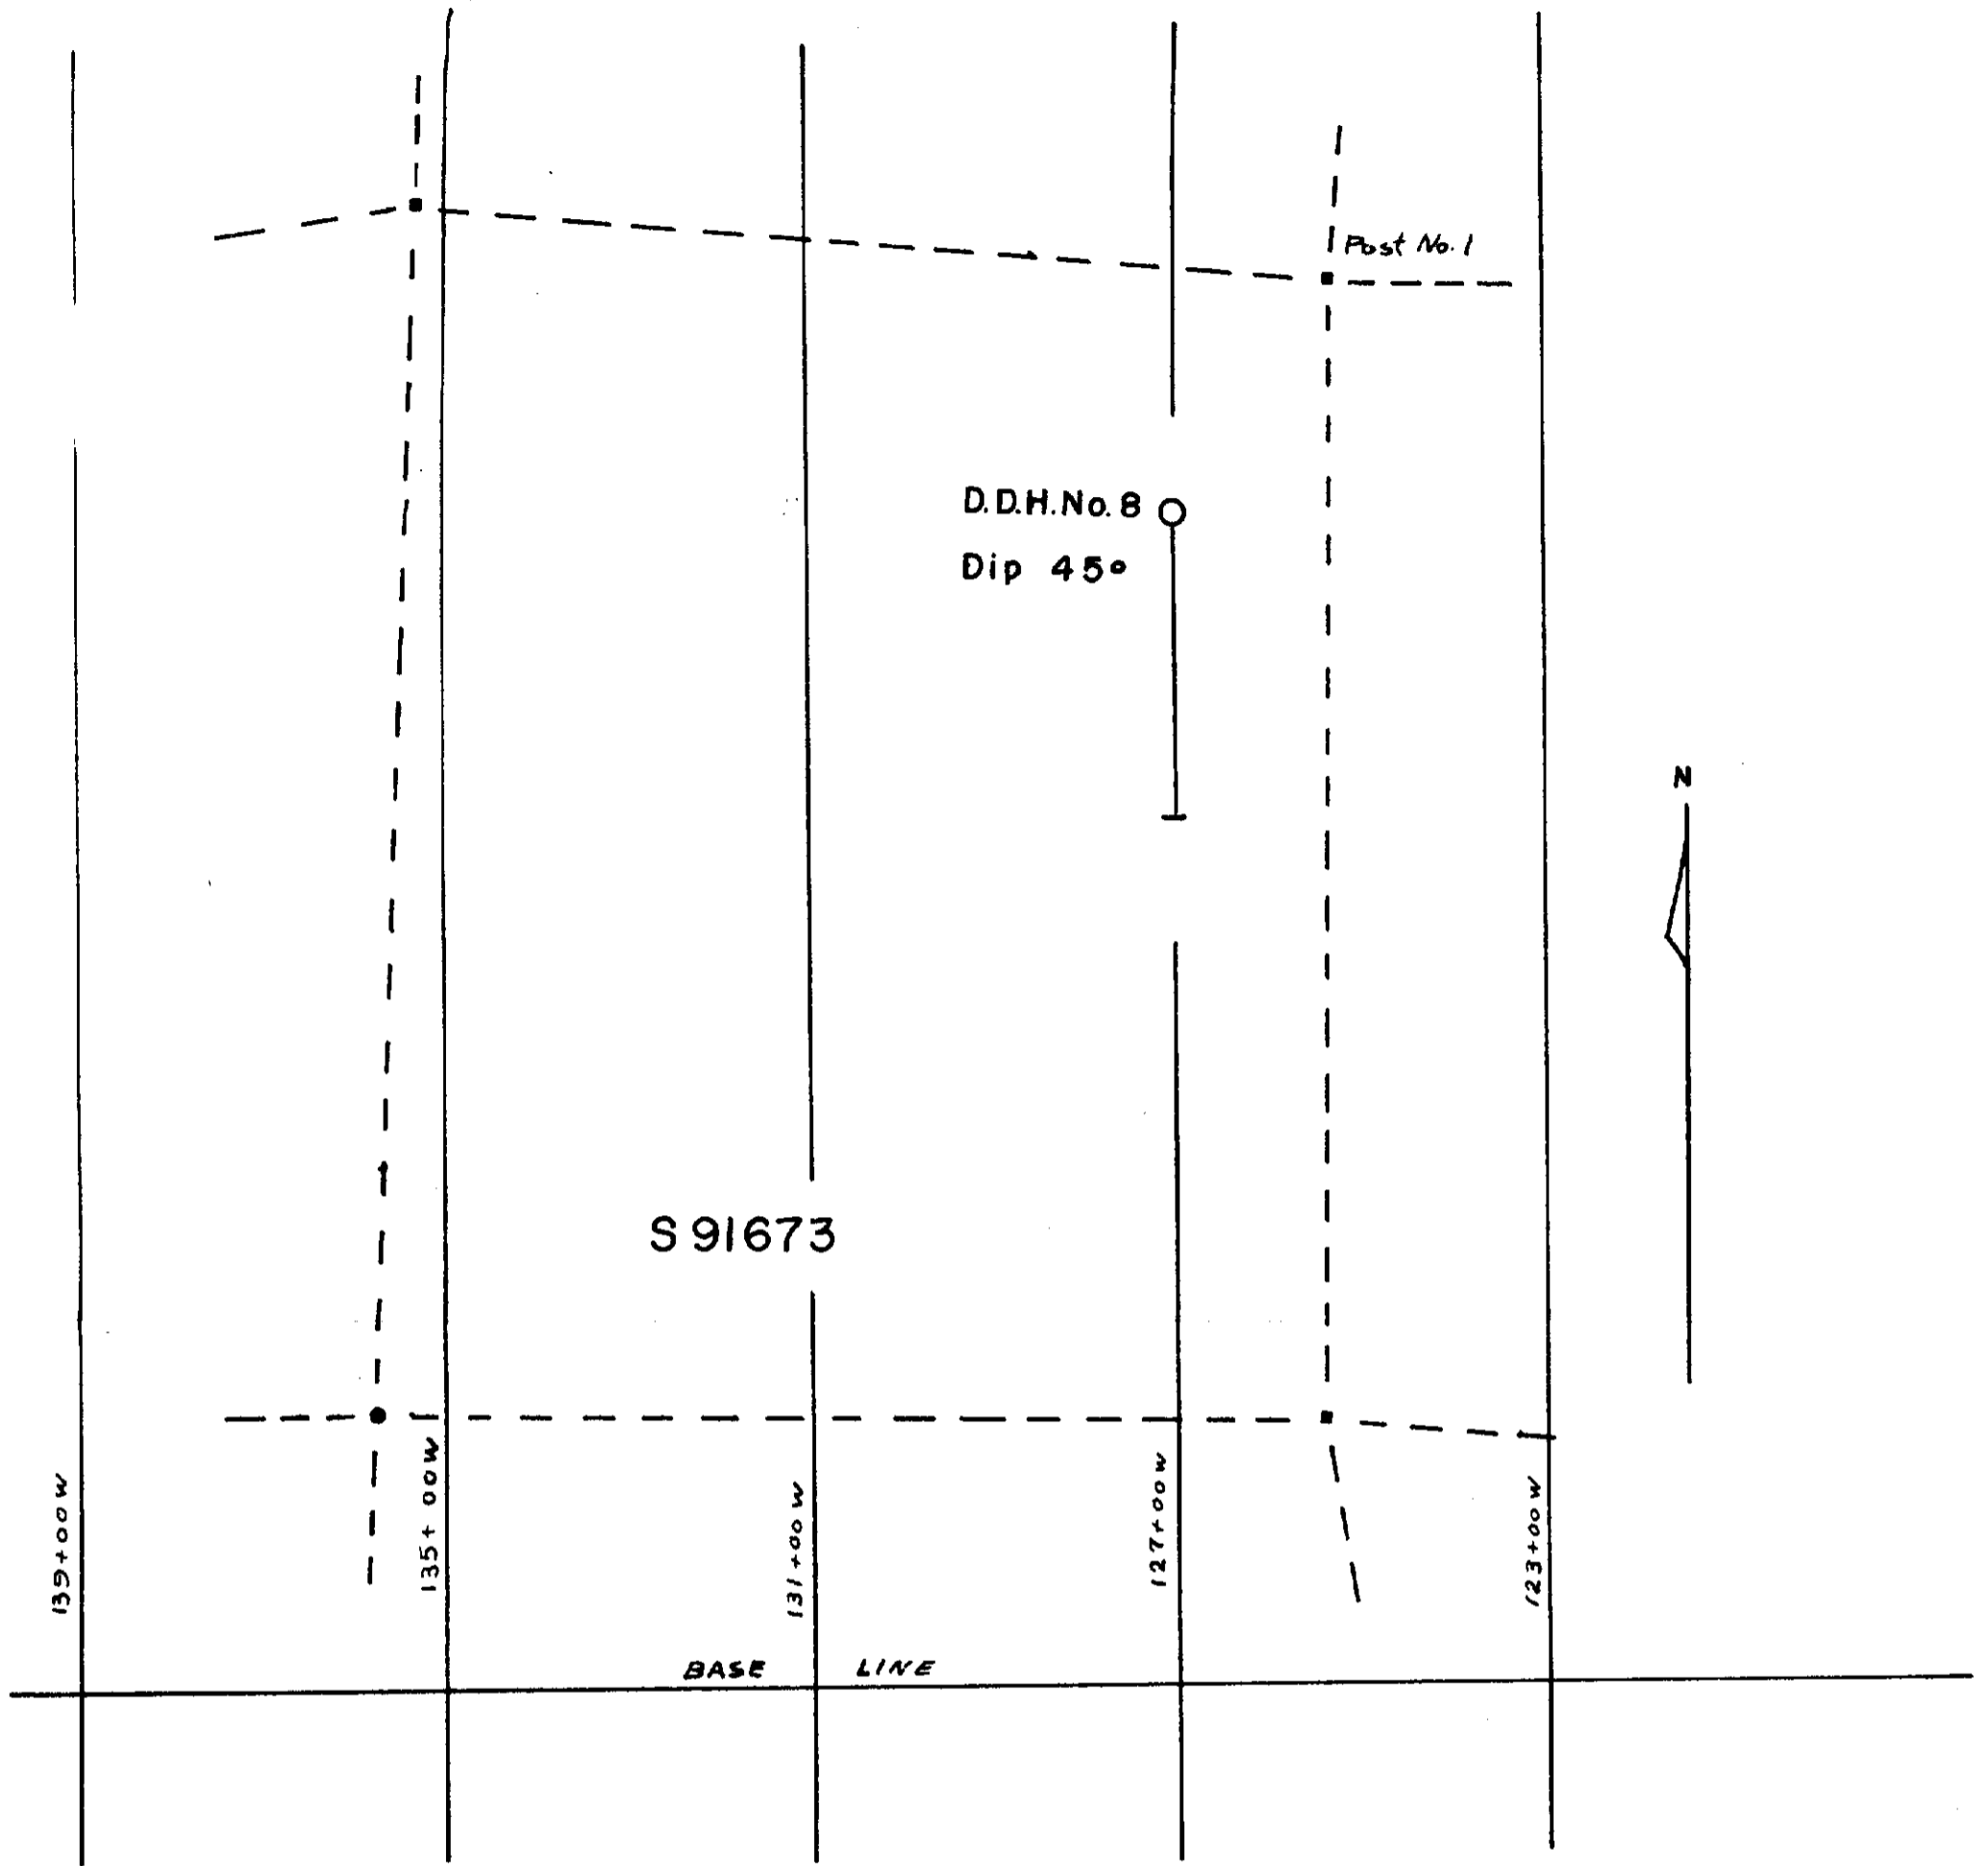

CONSOLIDATED THOR MINES LIMITED

SEWELL TWP.

SCALE 200' = 1"

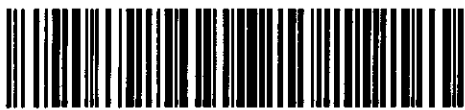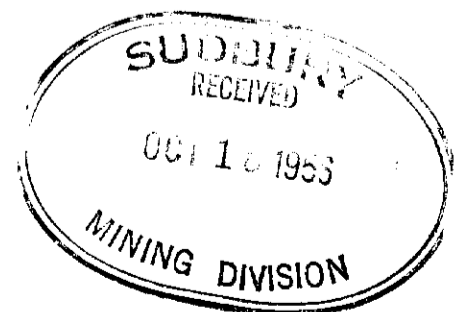

42A04NW0058 11 SEWELL

230

*W. H. ...*