


REFERENCES

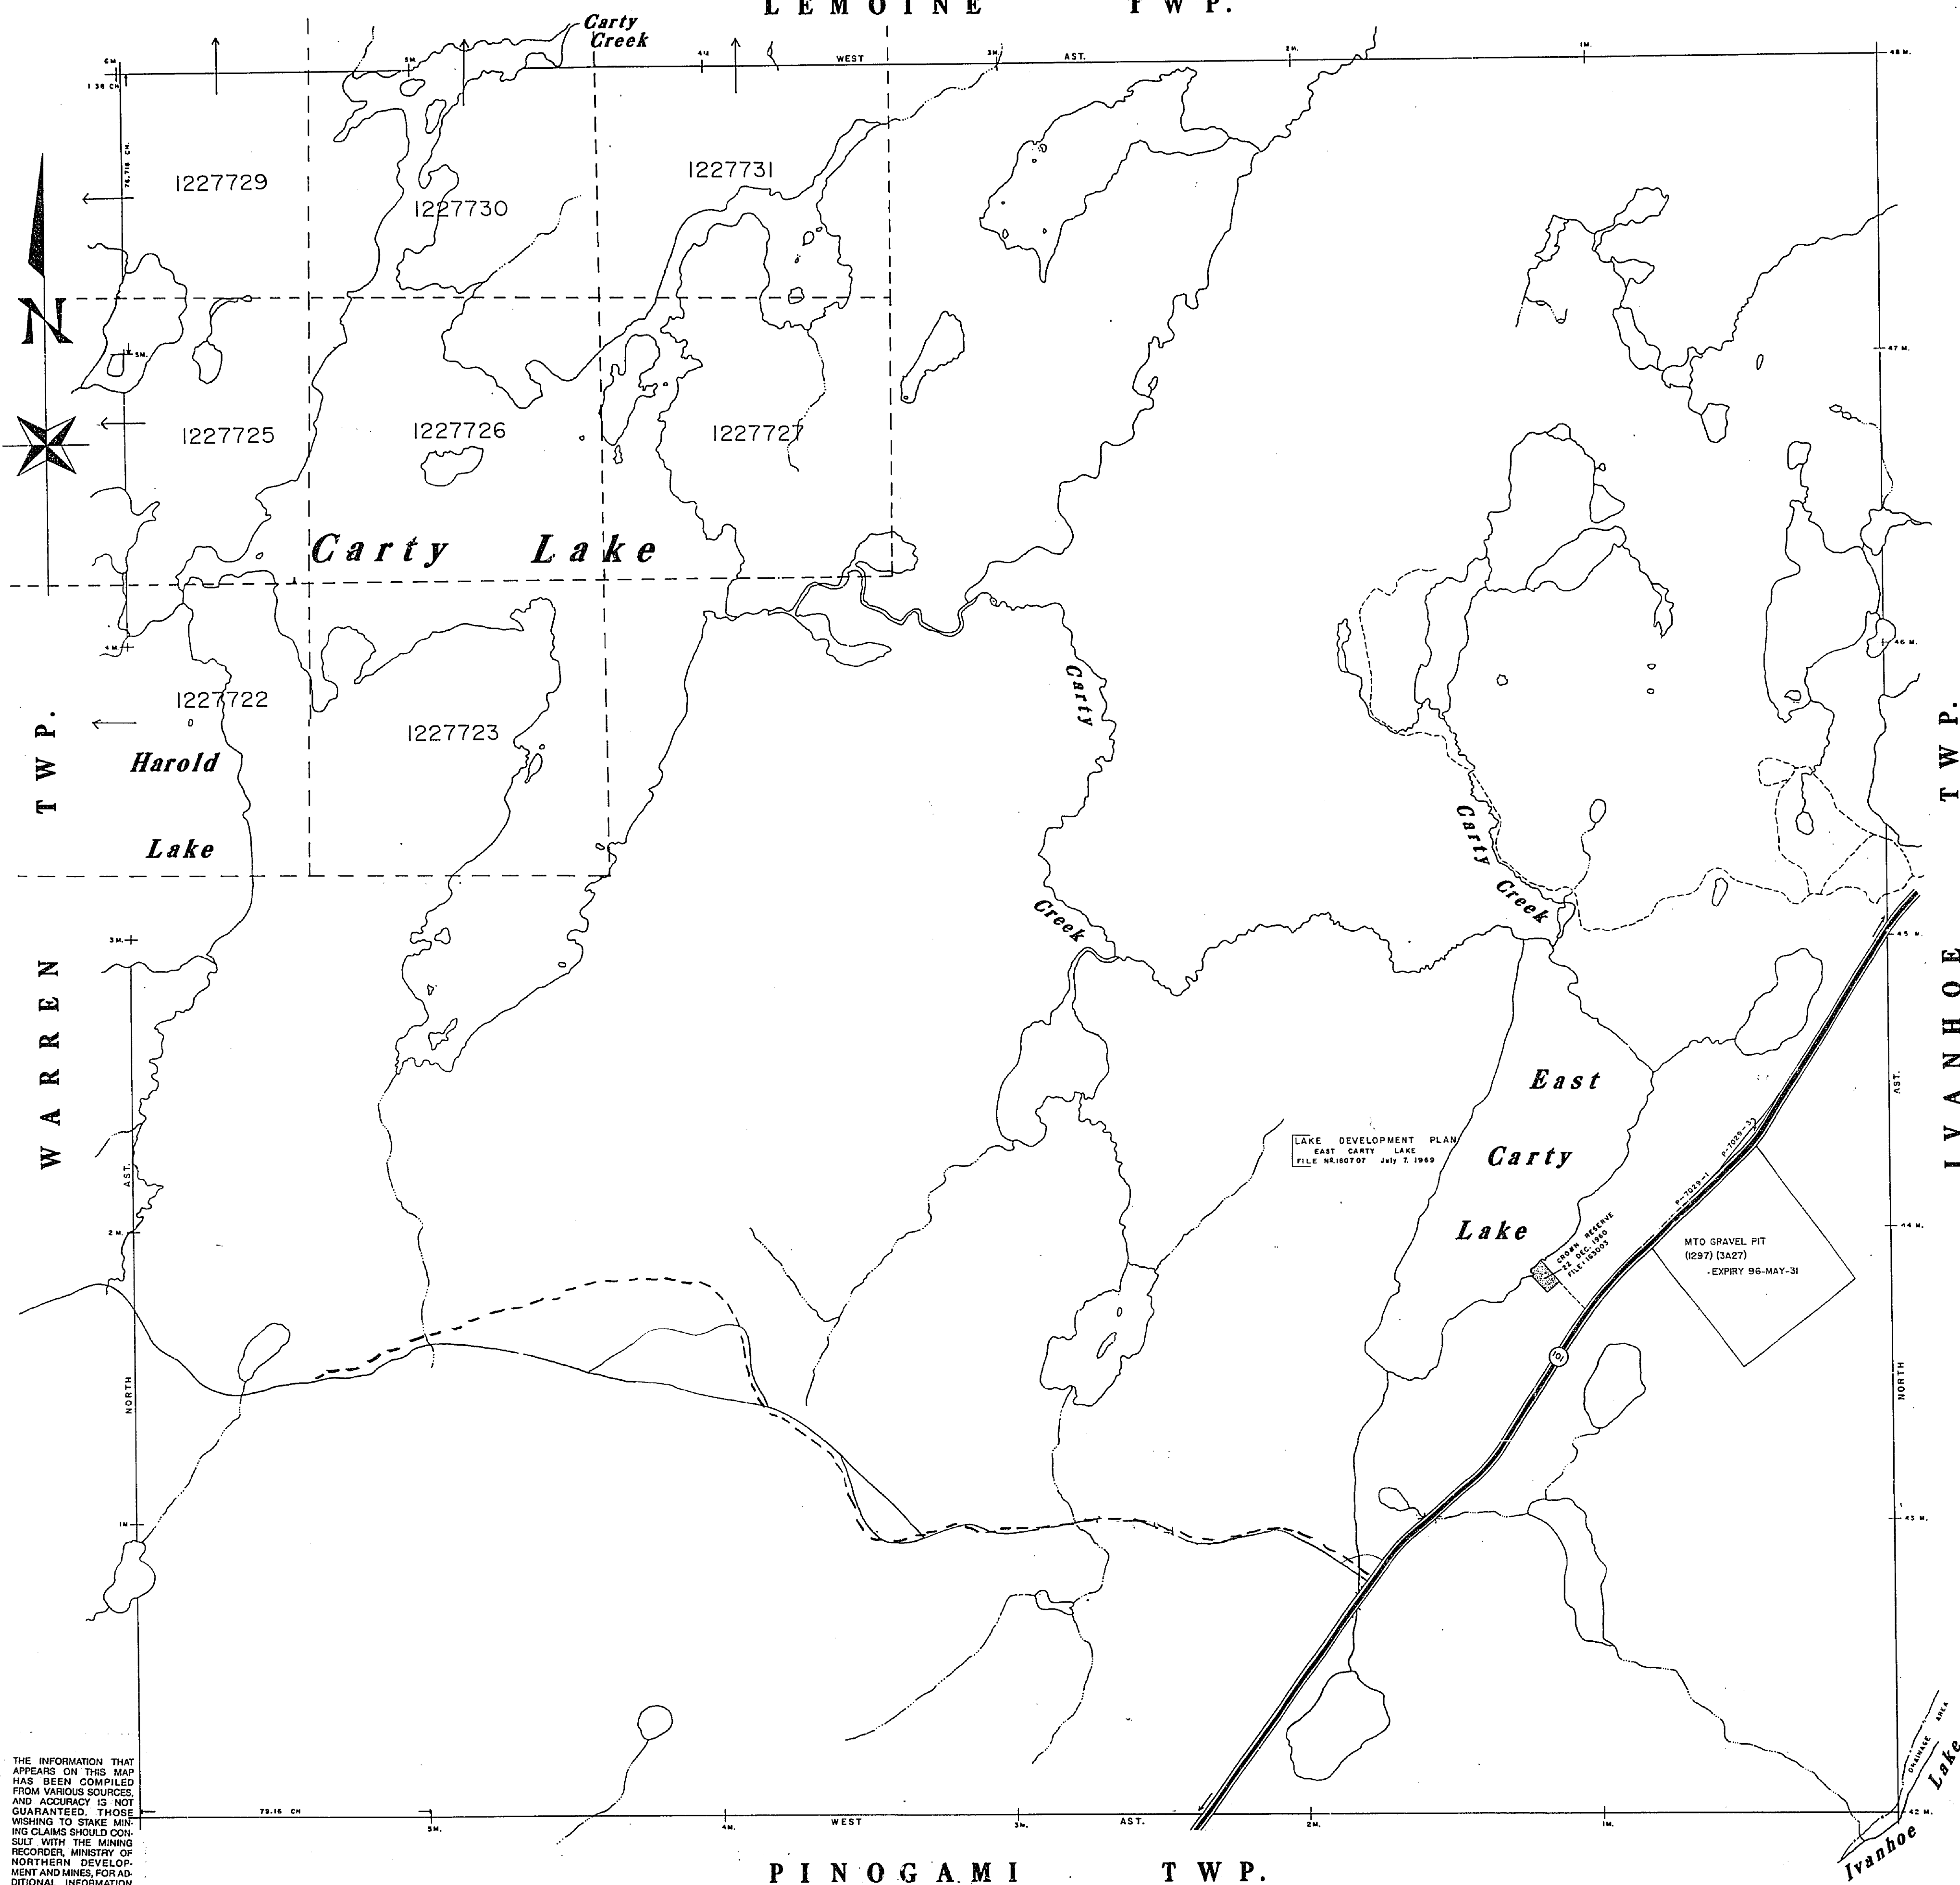

REFERENCES

TOPOGRAPHY

LAKES, RIVERS, ECT., FROM FOREST RESOURCES
INVENTORY SHEET NO'S. 481 823, & 482 823.

SURVEYS

NORTH AND EAST BOUNDARIES OF CARTY TWP.
BY SPEIGHT & VANDOSTRAND O.L.S. 1905.
FIELD NOTE BOOK NO. 2540.

SOUTH AND WEST BOUNDARIES OF CARTY TWP.
BY H.J. BEATTY O.L.S. 1920. FIELD NOTE
BOOK NO. 2292.

IVANHOE LAKE DRAINAGE AREA BY T.G. CODE
O.L.S. 1919. PLAN L2-28.

HIGHWAYS

HIGHWAY NO. 101 FROM MINISTRY OF TRANSPORT
PLAN NO. P-7029-1. (MA.1718.)

F. Forestry Activity 96/97

LEGEND

TOWNSHIP BOUNDARY SURVEYED	---
TOWNSHIP BOUNDARY PROJECTED	---
SURVEYED LINES LAND	---
SURVEYED LINES WATER	---
BLIND LINES	---
UNSURVEYED PARCEL BOUNDARY	---
MAIN ROAD	---
OTHER ROADS	---
HIGHWAY ROUTE NO.	---
TRAIL OR PATH	---
ELECTRIC TRANSMISSION LINE	---
PIPE LINE	---
RAILWAY AND RIGHT OF WAY	---
SUBDIVISION OR COMPOSITE PLAN	---
RESERVATION	---
BRIDGE, BUILDINGS	---
DAM, RAPIDS, FALLS, PORTAGE	---
NON-PERENNIAL STREAM	---
EDGE OF CLEARING	---
TREELESS MUSKEG OR MARSH	---
FLOODING	---
TRAVERSE POST	---
PROPOSED ROAD MNR	---

LANDS ALIENATED FROM CROWN

TYPE OF DOCUMENT	SYMBOL
LICENCE OF OCCUPATION	---
LEASE, SURFACE RIGHTS ONLY	---
MINING RIGHTS ONLY	---
SURFACE AND MINING RIGHTS	---
PATENT, SURFACE RIGHTS ONLY	---
MINING RIGHTS ONLY	---
SURFACE AND MINING RIGHTS	---
SURFACE RIGHTS-LEASE MINING RIGHTS	---
MINING RIGHTS-LEASE SURFACE RIGHTS	---
ORDER IN COUNCIL	---
RESERVATION	---

TOWNSHIP

CARTY

M.N.R. ADMINISTRATIVE DISTRICT

CHAPLEAU

MINING DIVISION

PORCUPINE

LAND TITLES/ REGISTRY DIVISION

SUDBURY

ACTIVATED 91-NOV-21

Ministry of Natural Resources
Ontario
Ministry of Northern Development and Mines

DR. D.L.T. CH. E.J.D. APP. E.J.D. DATE

SCALE 1 INCH = 20 CHAINS

TORONTO, CANADA

G-1070

705

CVBIA 1MB

TOWNSHIP OF


CARTY.

m. 705

DISTRICT OF SUDBURY.
SUDBURY MINING DIVISION.


Scale, 40 chains = 1 inch.

LEMOINE T.R.

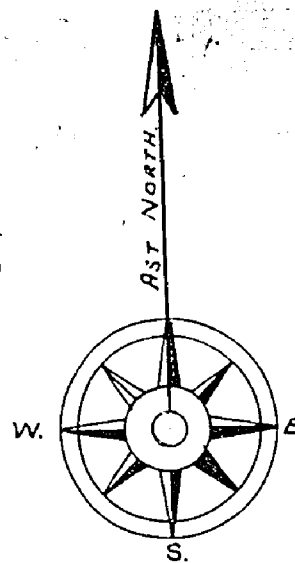

NOTE

400' Surface Rights Reservation
around all Lakes and Rivers.

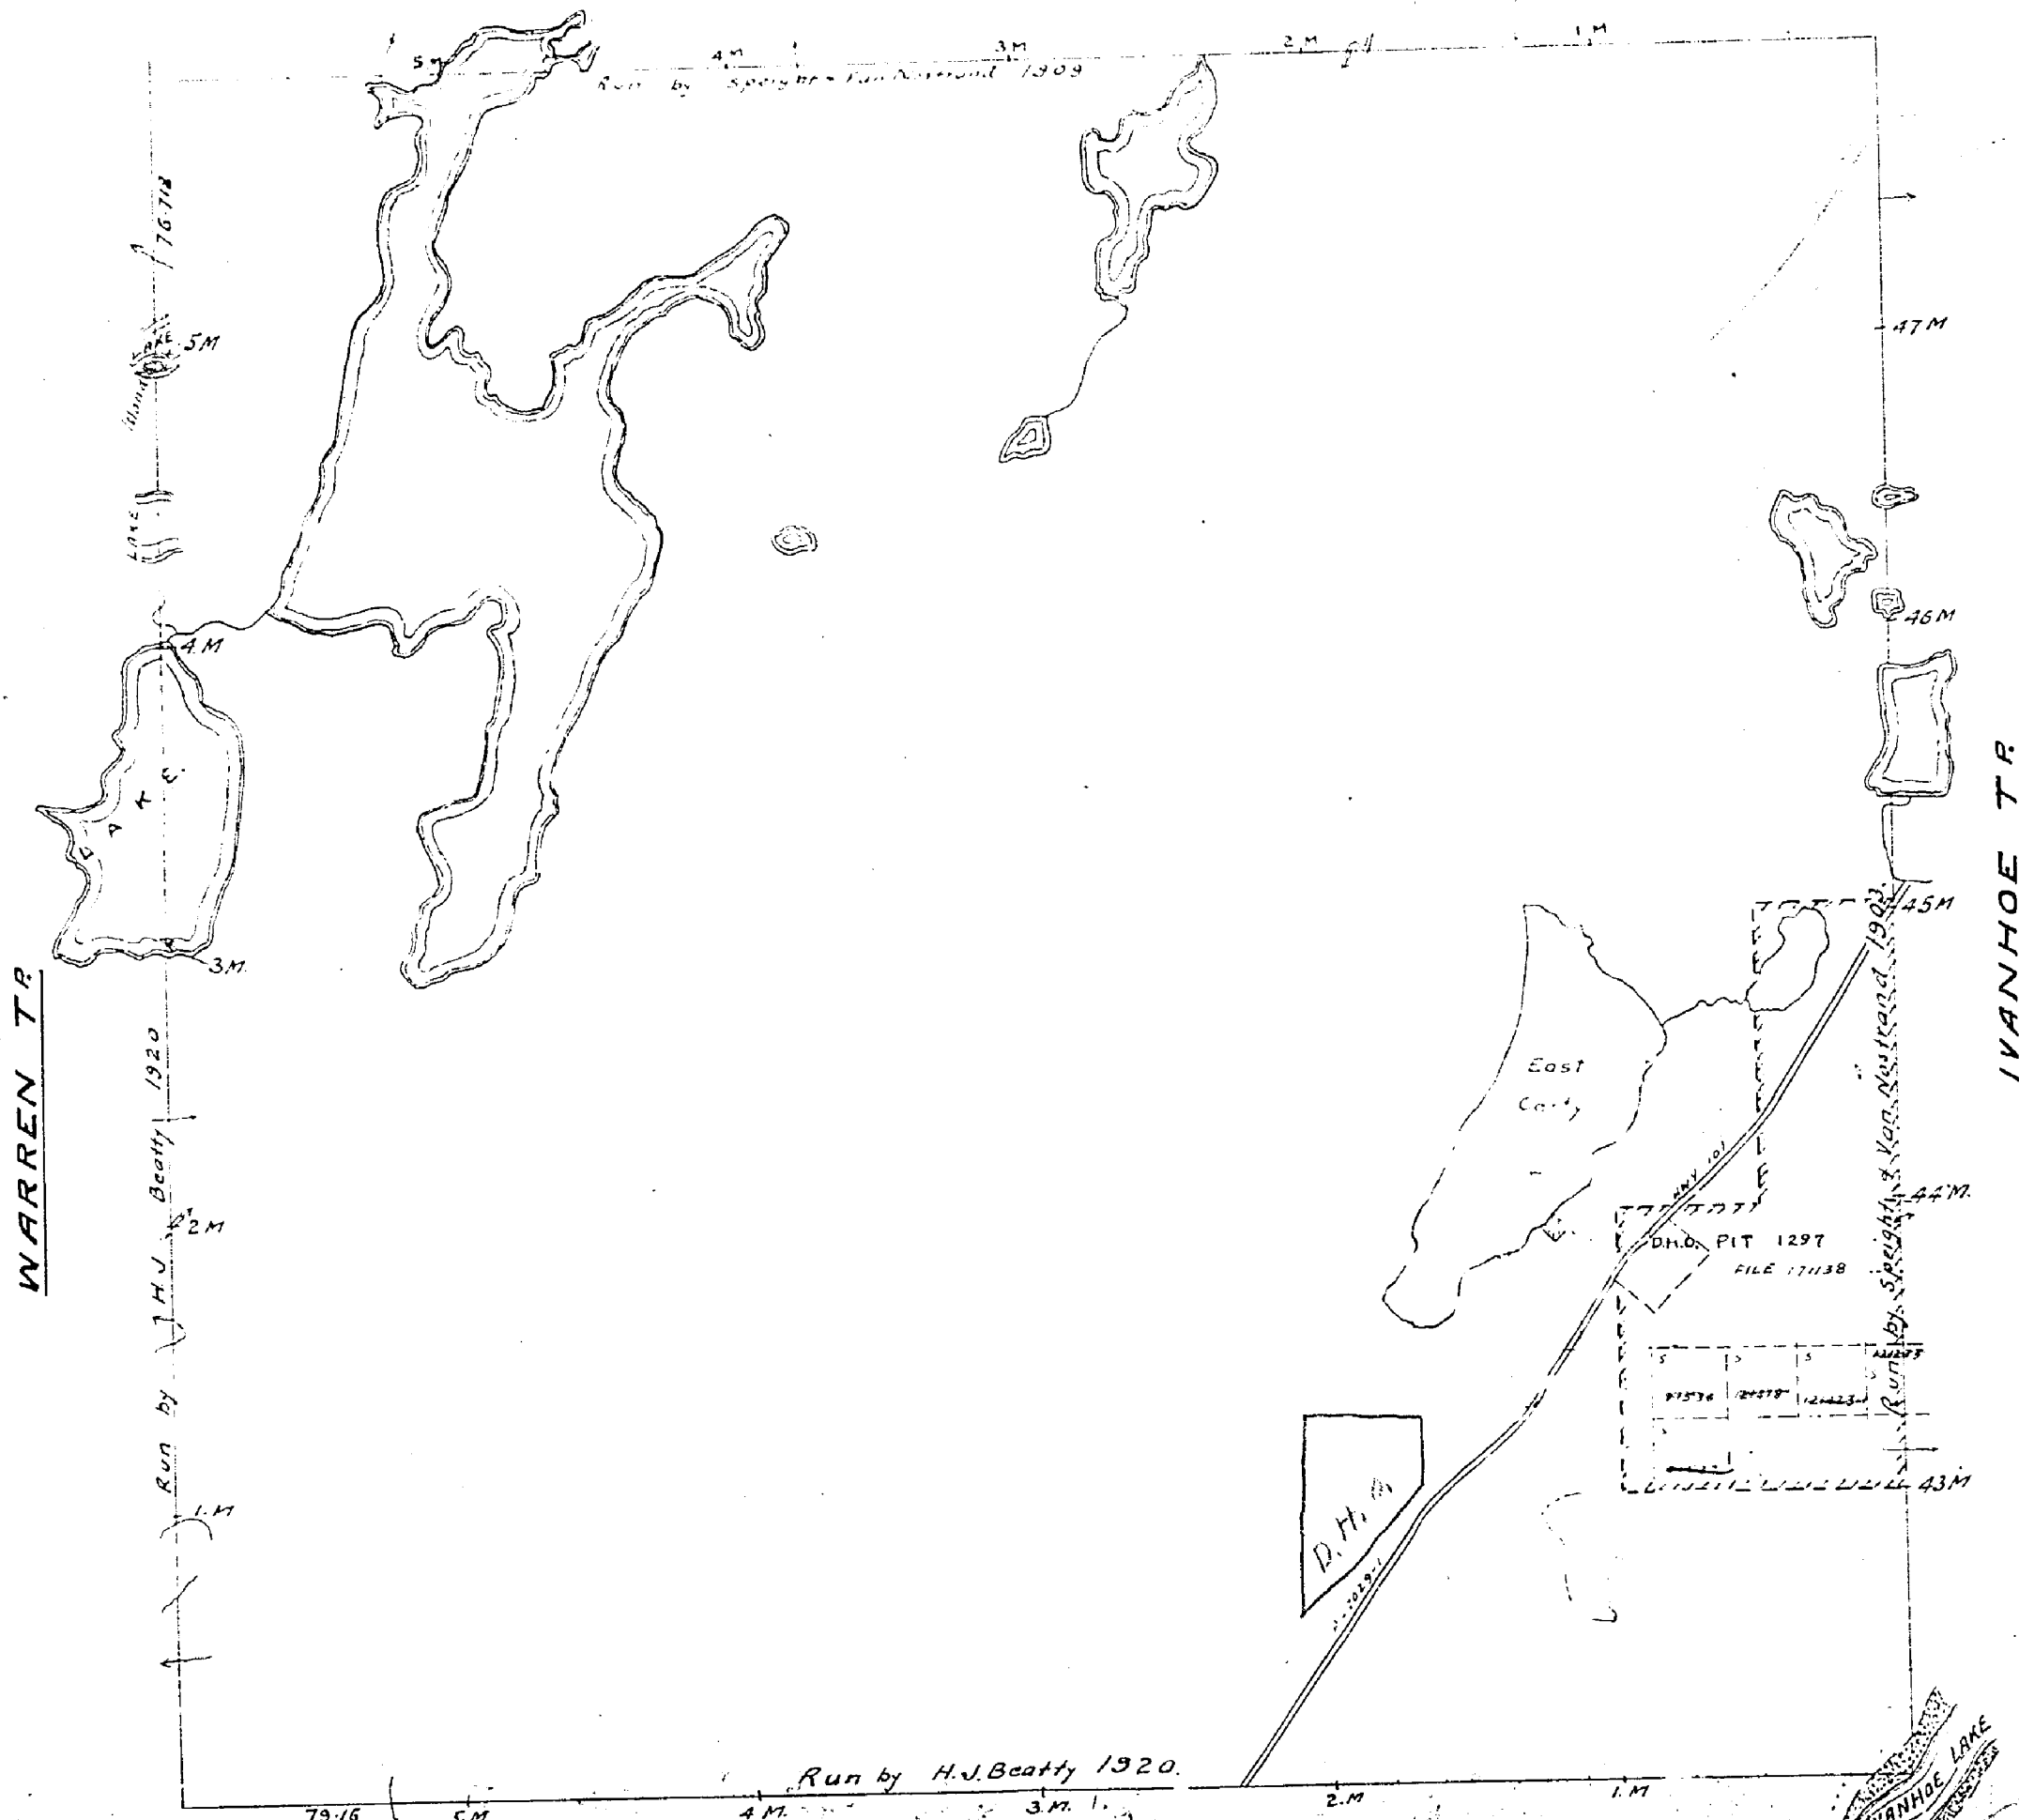

Run by H.J. Beatty 1920.

PINOAMI T.R.

Traverse of Ivanhoe Lake by T.G. Cade, O.L.S. 1919.
Present shore line of Ivanhoe Lake shown thus [solid line].
Old Drainage Area shown thus [dashed line].

Note. Subsequent to the construction of a Dam in 1931-2 at the new or artificial outlet of Ivanhoe Lake
the water level has been restored to about its original level. See File 79858.

505-M GWT YTRAC

PLAN
OF THE TOWNSHIP OF
CARTY

Scale 40 - Chains = 1 inch

Temoine

CARTY

Pinogami.

Section of French Lake by T.G. Code, D.L.S. 1919.
 Section of French Lake shown thus ——— Note - Subsequent to the construction of a Dam in 1931 & 1932 at the lower artificial outlet of French Lake
 the water level has been restored to about its original level. See File 79858.
 Drainage area shown thus ~~XXXXXX~~ " ———

CARTY.


m. 705

DISTRICT OF SUDBURY.

SUBBURY MINING DIVISION


Scale, 40 chains = 1 inch.

LEMOINE T P

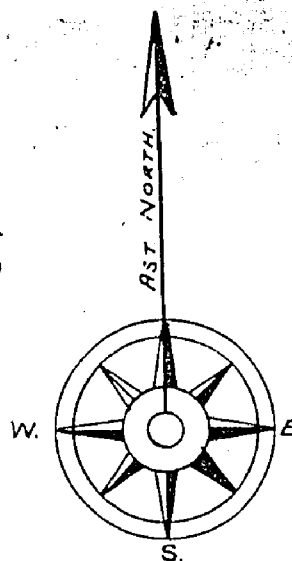

NOTE

400' Surface Rights Reservation
around all Lakes and Rivers.

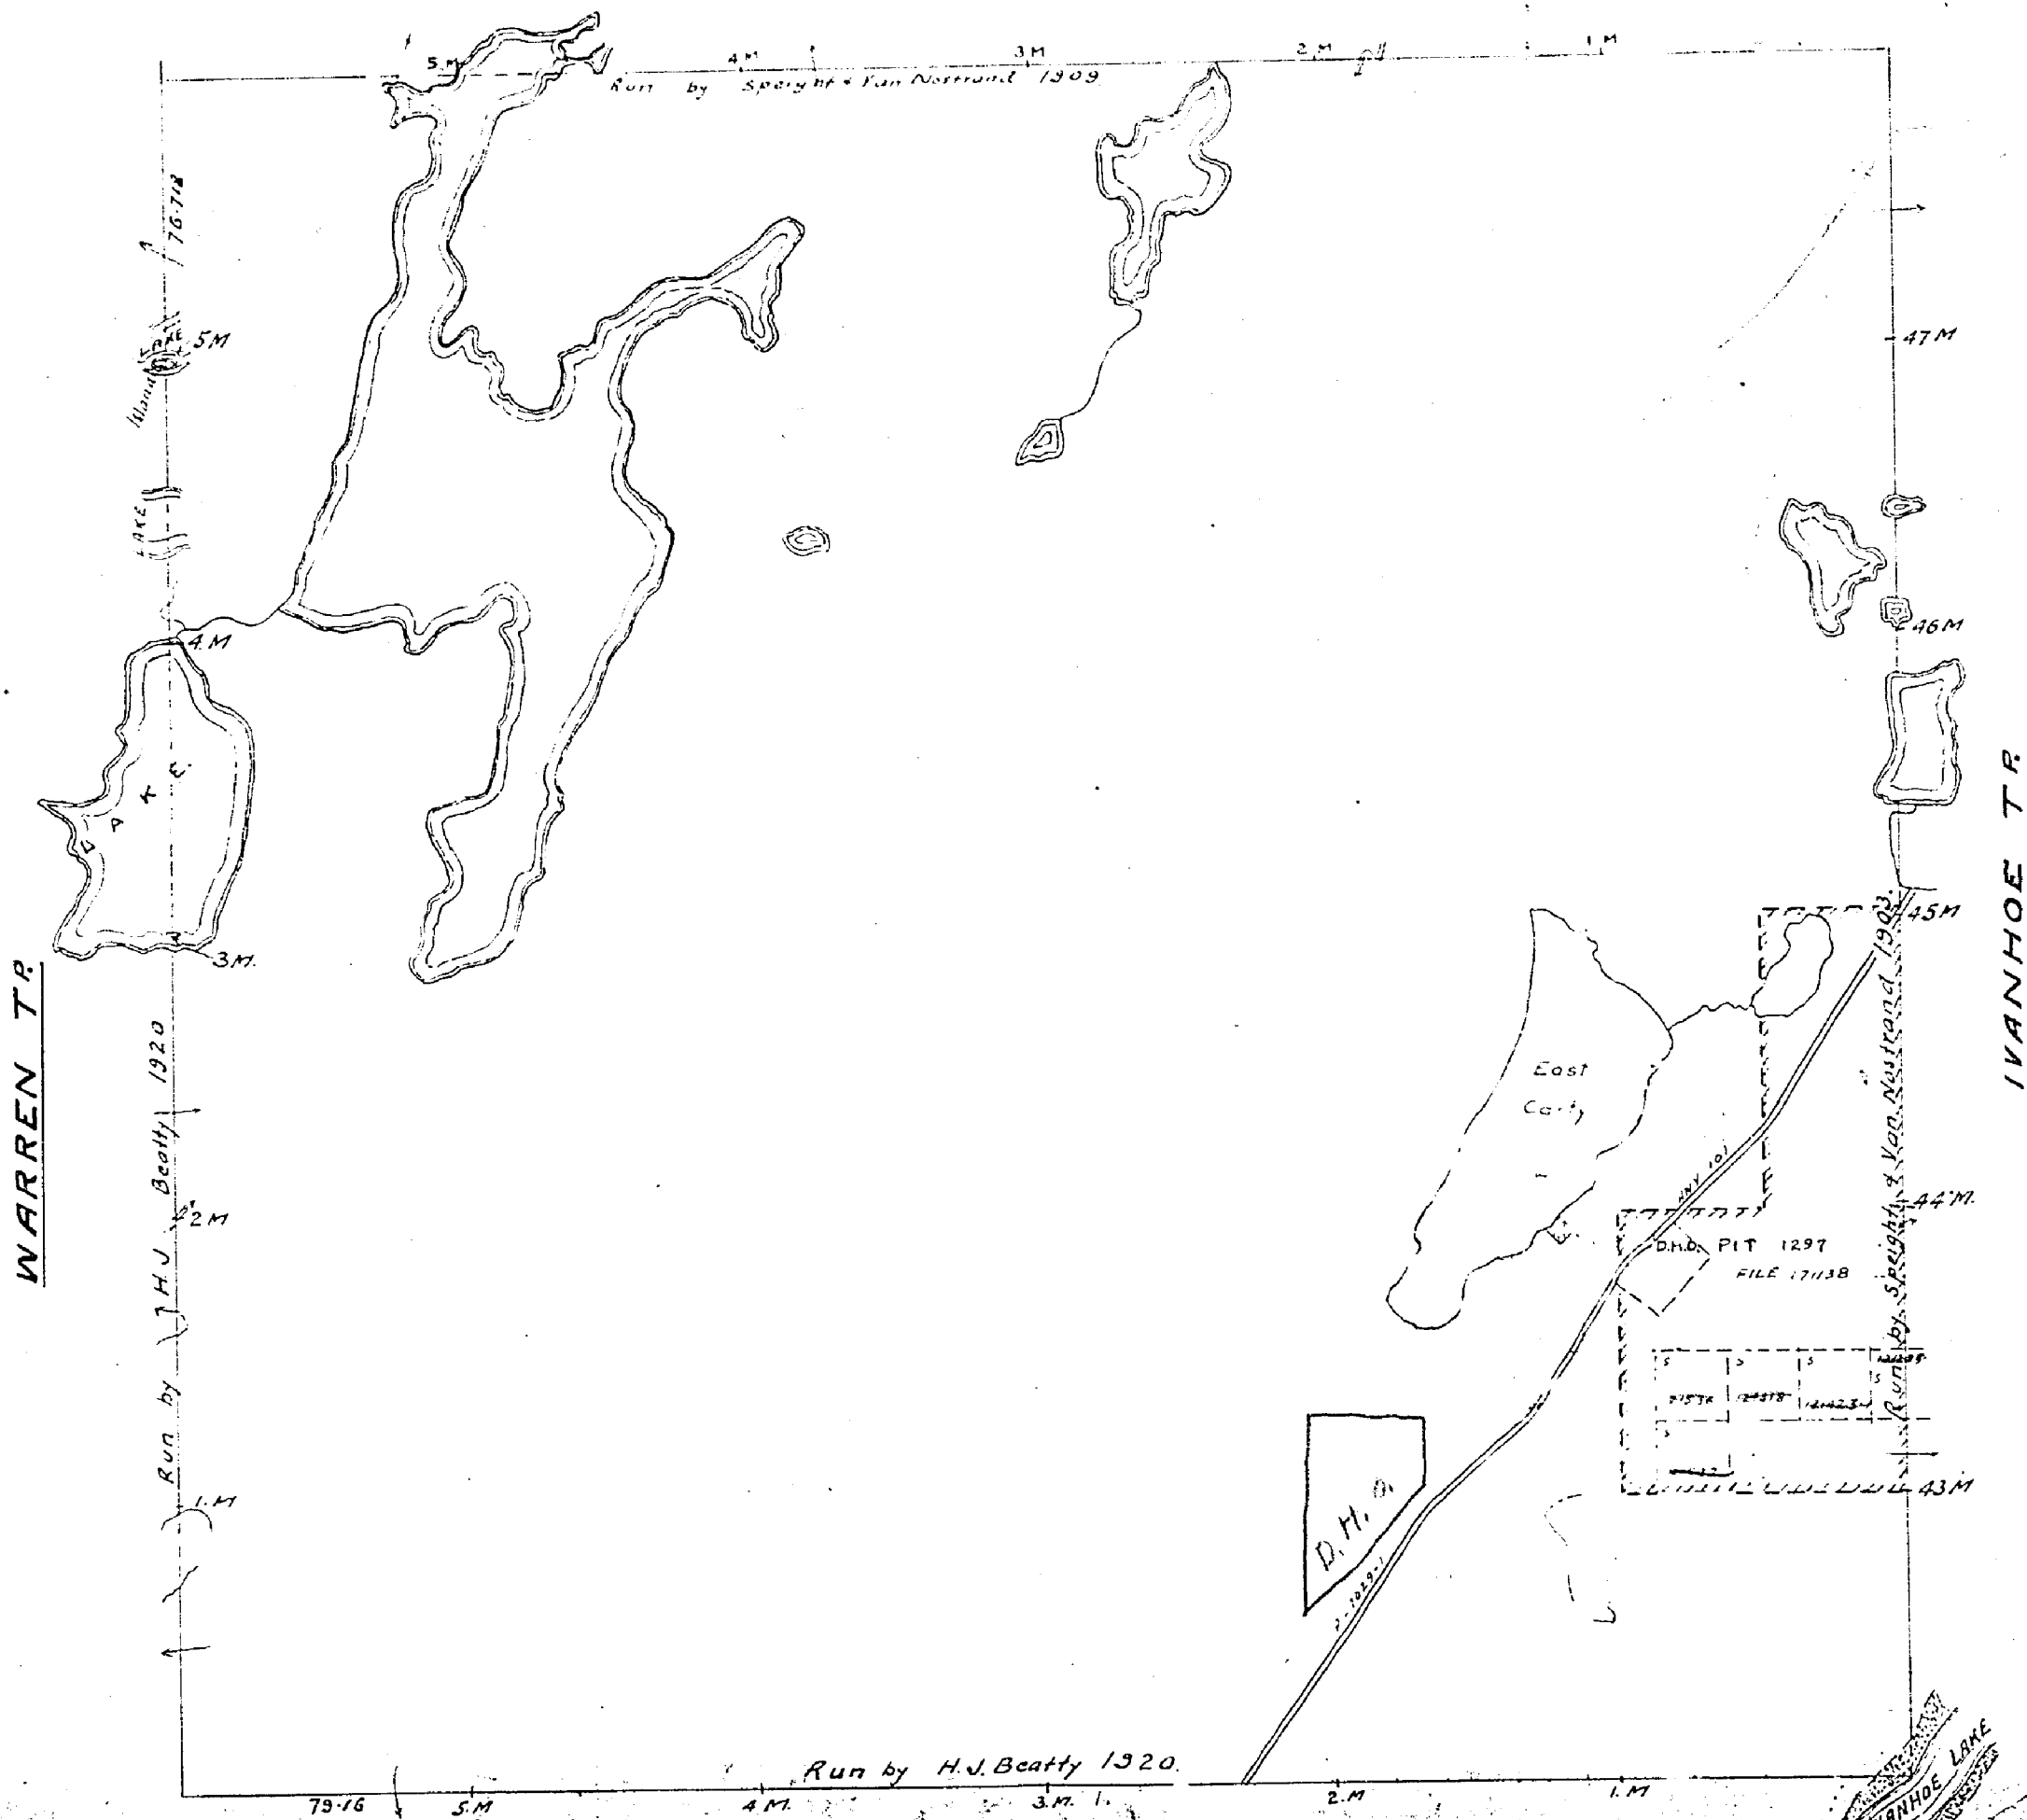

Surface Rights Only withdrawn from staking

Sec 34(d) Mg. Act shown thus ~~FOIA~~ File 163003

PINO GAMI TR

Traverse of Ivanhoe Lake by T.G. Code Q.L.S. 1919.

Present shore line of Ivanhoe Lake shown the

Note: Subsequent to the construction of a Dam in 1931-2 at the new or artificial outlet at Ivanhoe Lake the water level has been restored to about its original level. See File 79858.

Subsequent to the construction of a dam in 1901, the water level has been restored to about its original level. See File 798.58.

CARTY, TWP. M-705


705

PLAN OF THE TOWNSHIP OF CARTY

Scale 40 Chains = 1 Inch

Lemoine

400 Res
200
M-705
off

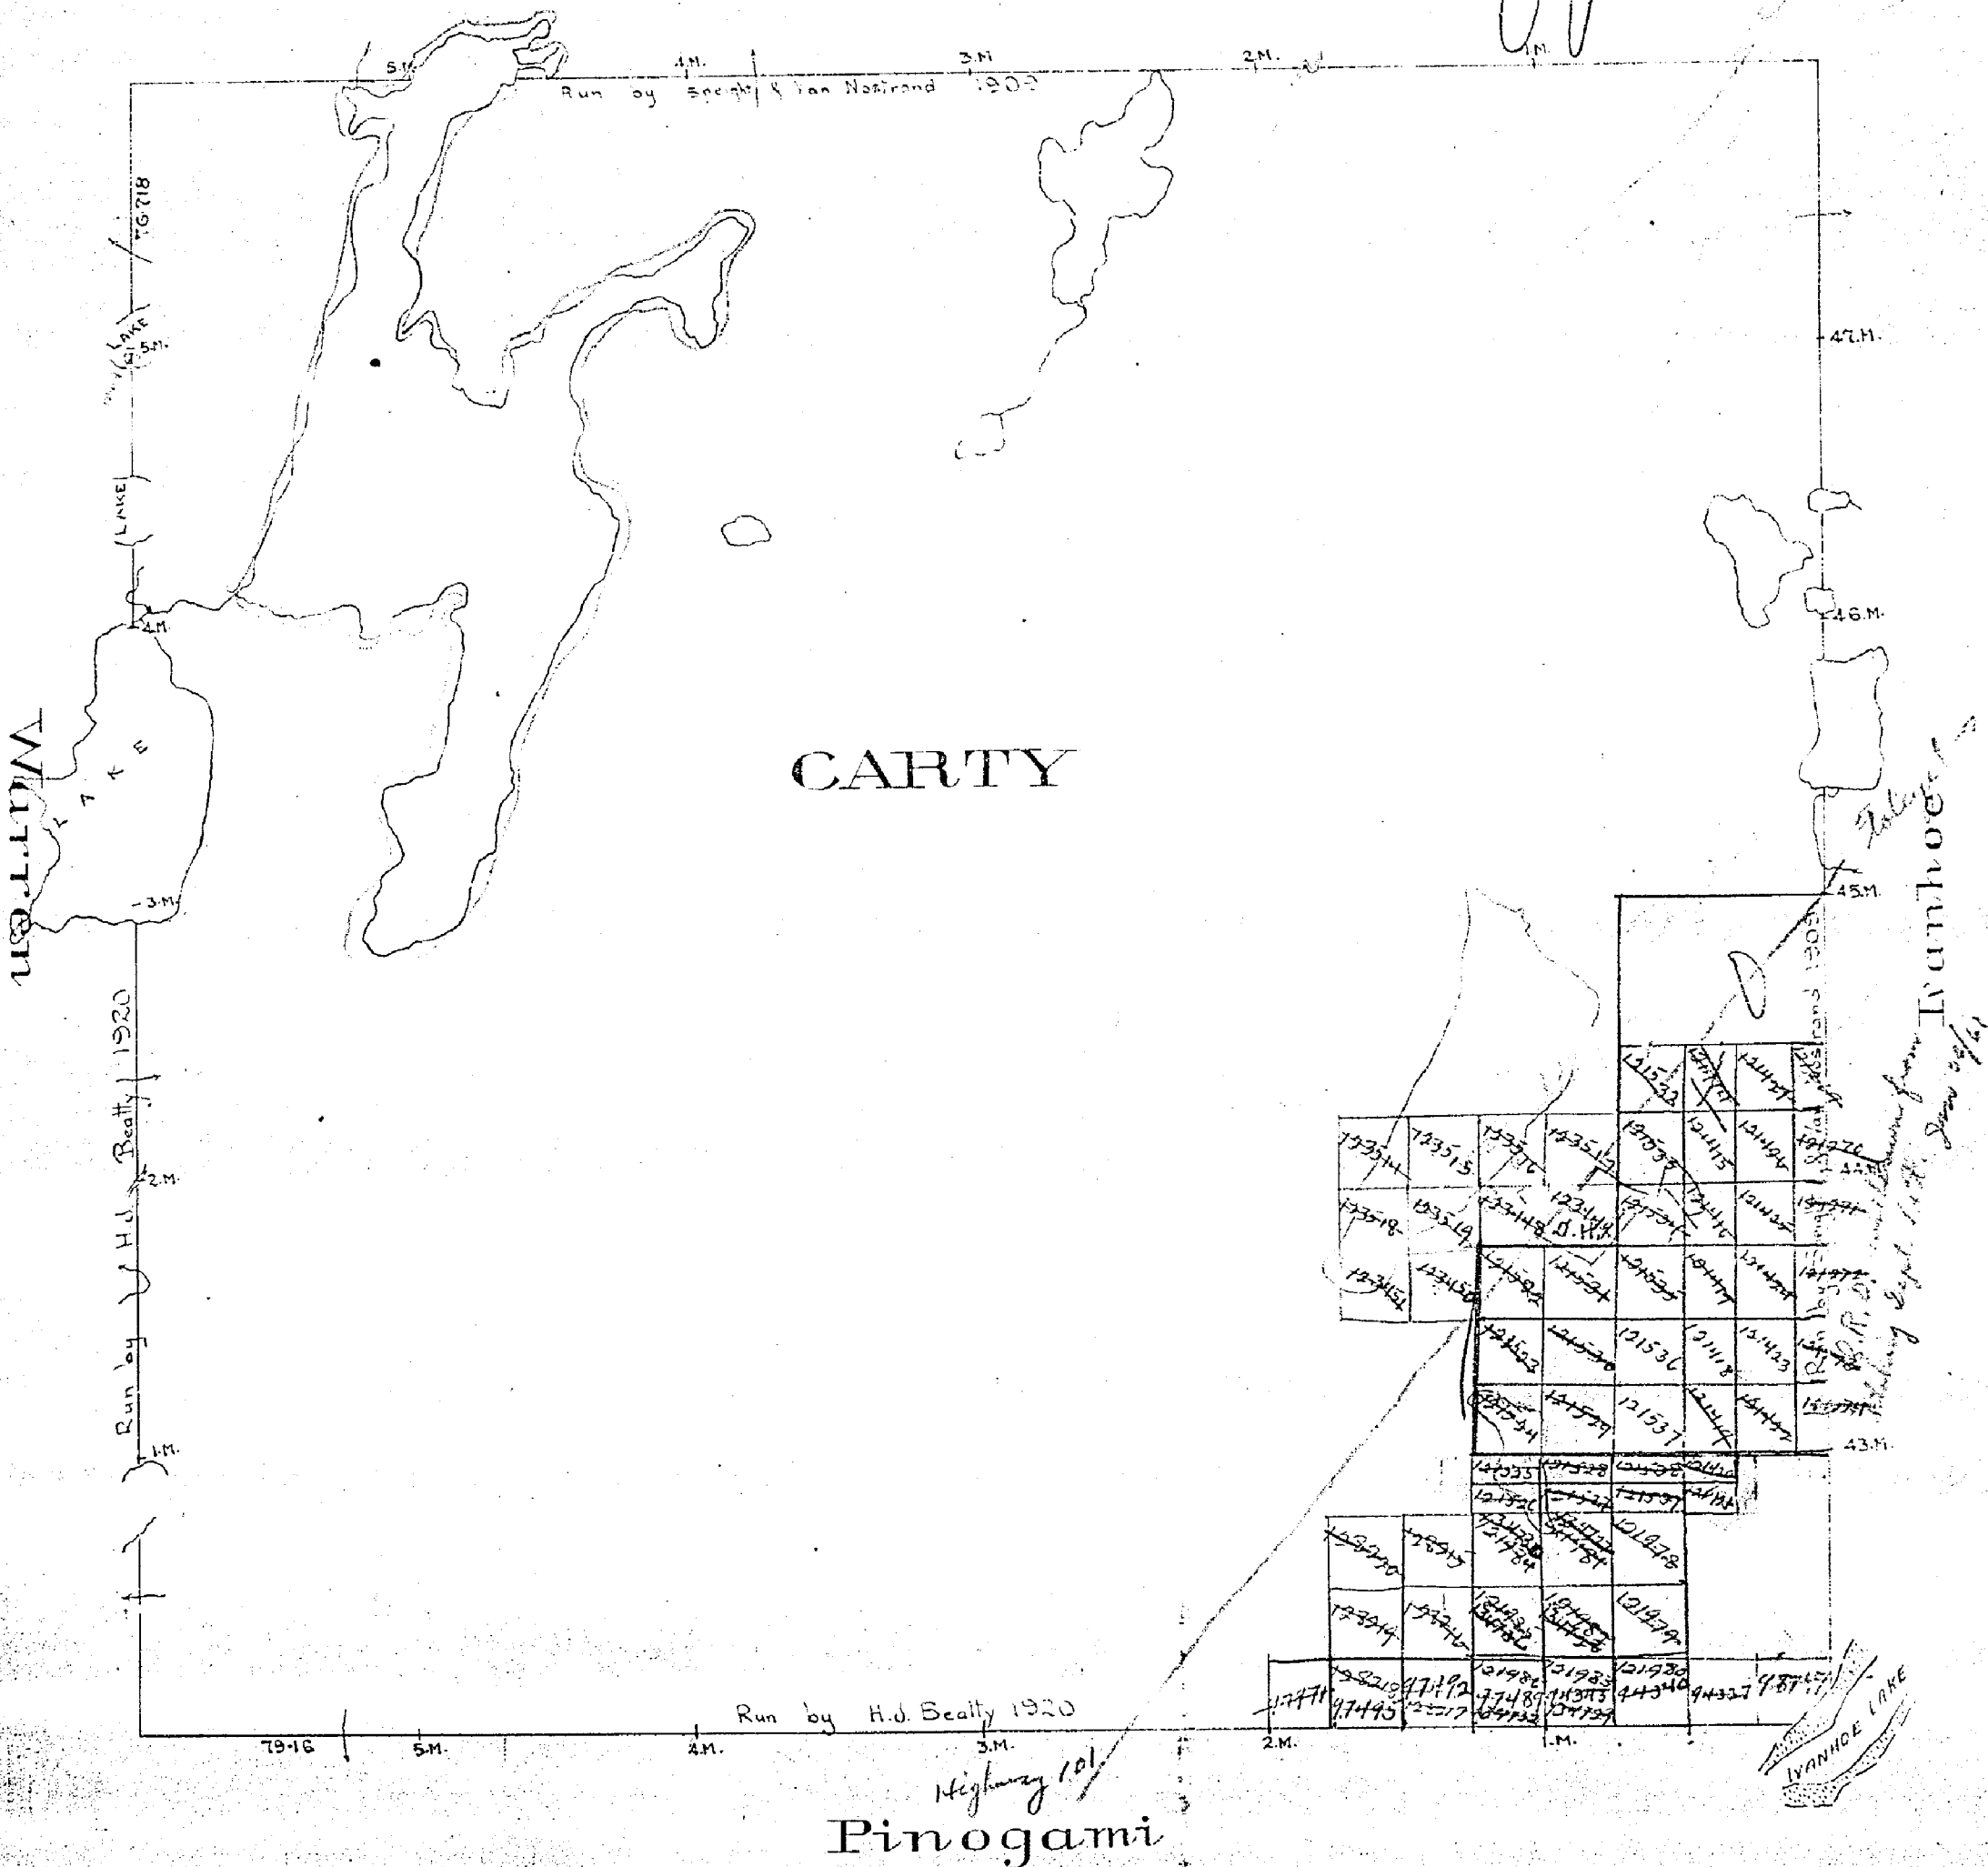

Map of Ivanhoe Lake by T.G. Code, O.S. 1919. Note - Subsequent to the construction of a Dam in 1931 & 1932 at the new or artificial outlet of Ivanhoe Lake the water level has been restored to about its original level. See File 79858.

TOWNSHIP OF

CARTY.

DISTRICT OF SUDBURY.
PORCUPINE MINING DIVISION

Scale, 40 chains = 1 inch.


LEMOINE T.R.

NOTE

400' Surface Rights Reservation
around all Lakes and Rivers.

Q.U.P.

RECEIVED
OCT 9 1969
123456
Replaced Jan. 20/89
D.C.

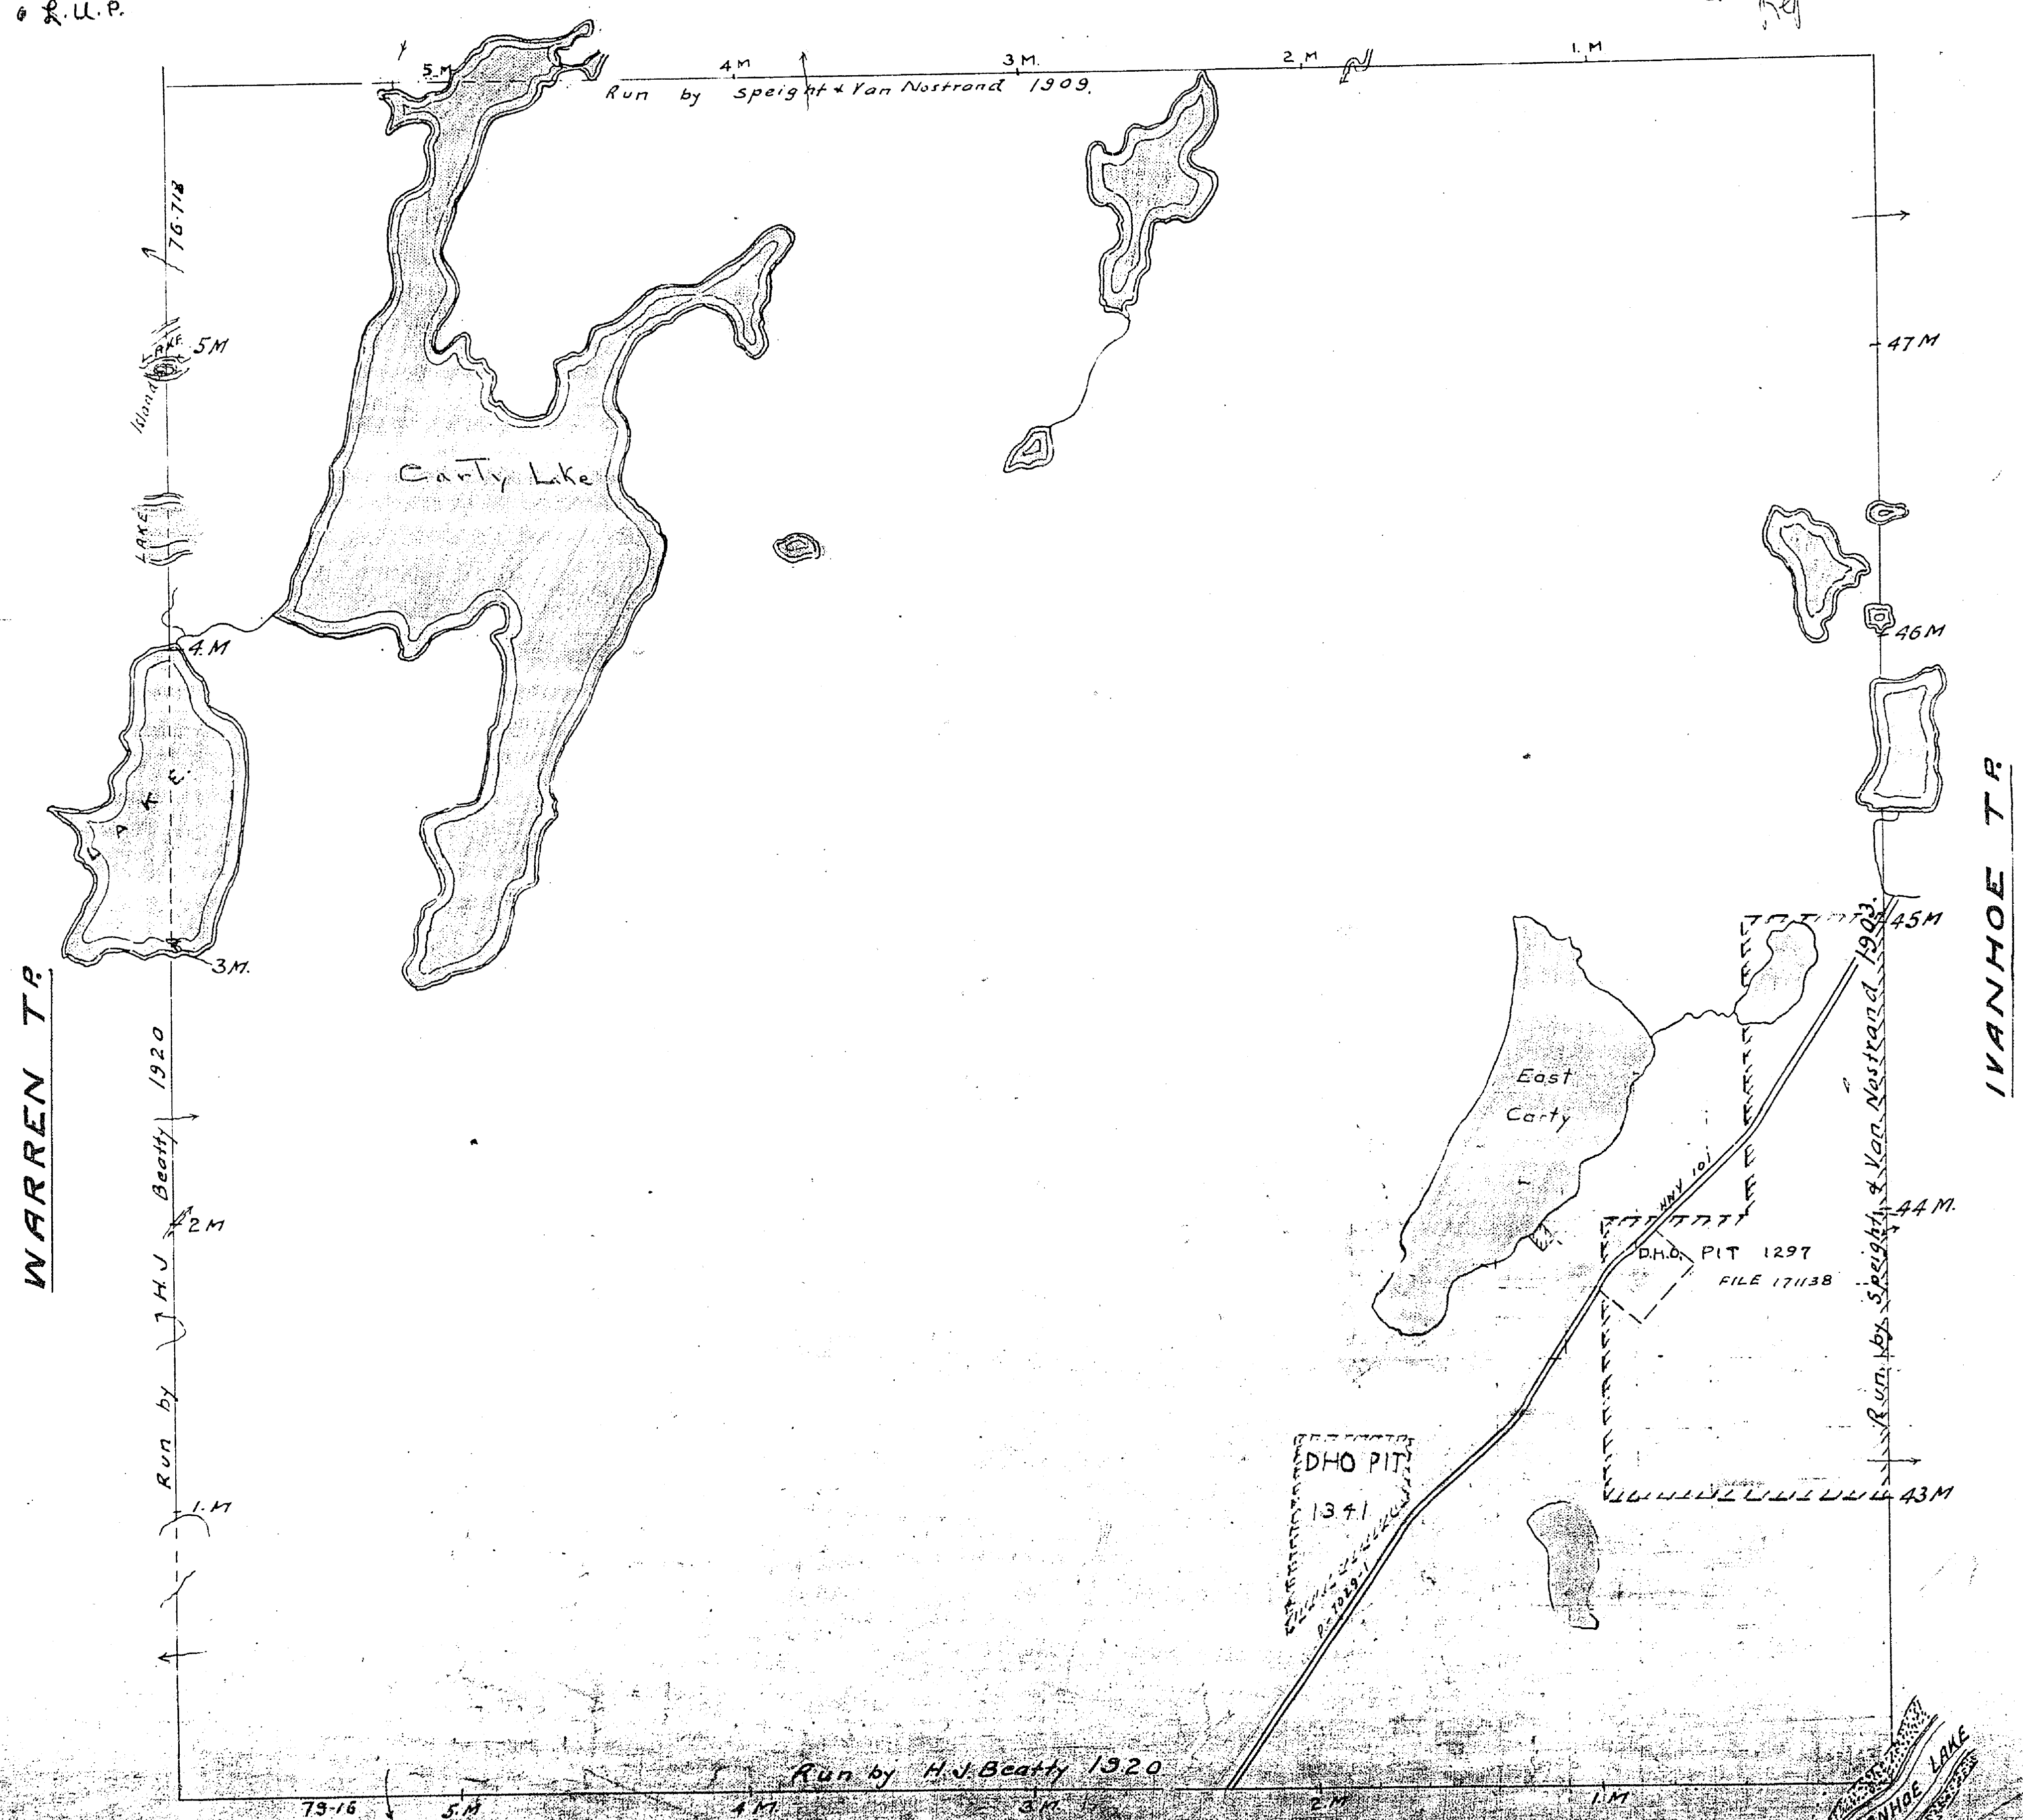

WARREN T.R.

IVANHOE T.R.

Run by H.J. Beatty 1920

PINOGE T.R.

Surface Rights Only withdrawn from staking
Sec. 34(a) Mo. Act shown thus [X] File 163003

IVANHOE LAKE
PINOGE T.R.

REMOVED FROM SERVICE 91-NOV-21 RB.

TOWNSHIP OF

CARTY.

DISTRICT OF SUDBURY.
PORCUPINE MINING DIVISION


Scale, 40 chains = 1 inch.

LEMOINE T R


NOTE

400' Surface Rights Reservation
around all Lakes and Rivers.

⑥ QUARRY PERMIT

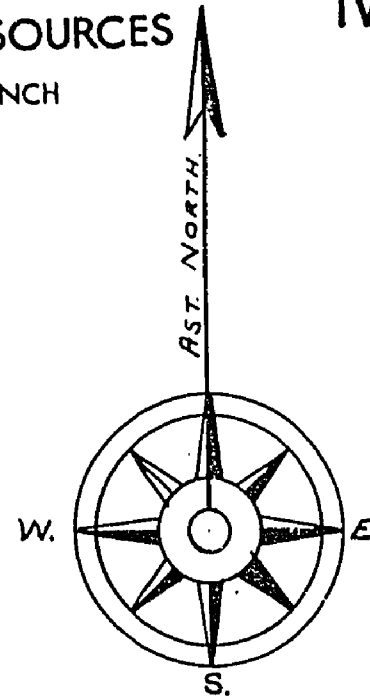

PLACED IN ACTIVE FILE JAN. 20/89
D.C.

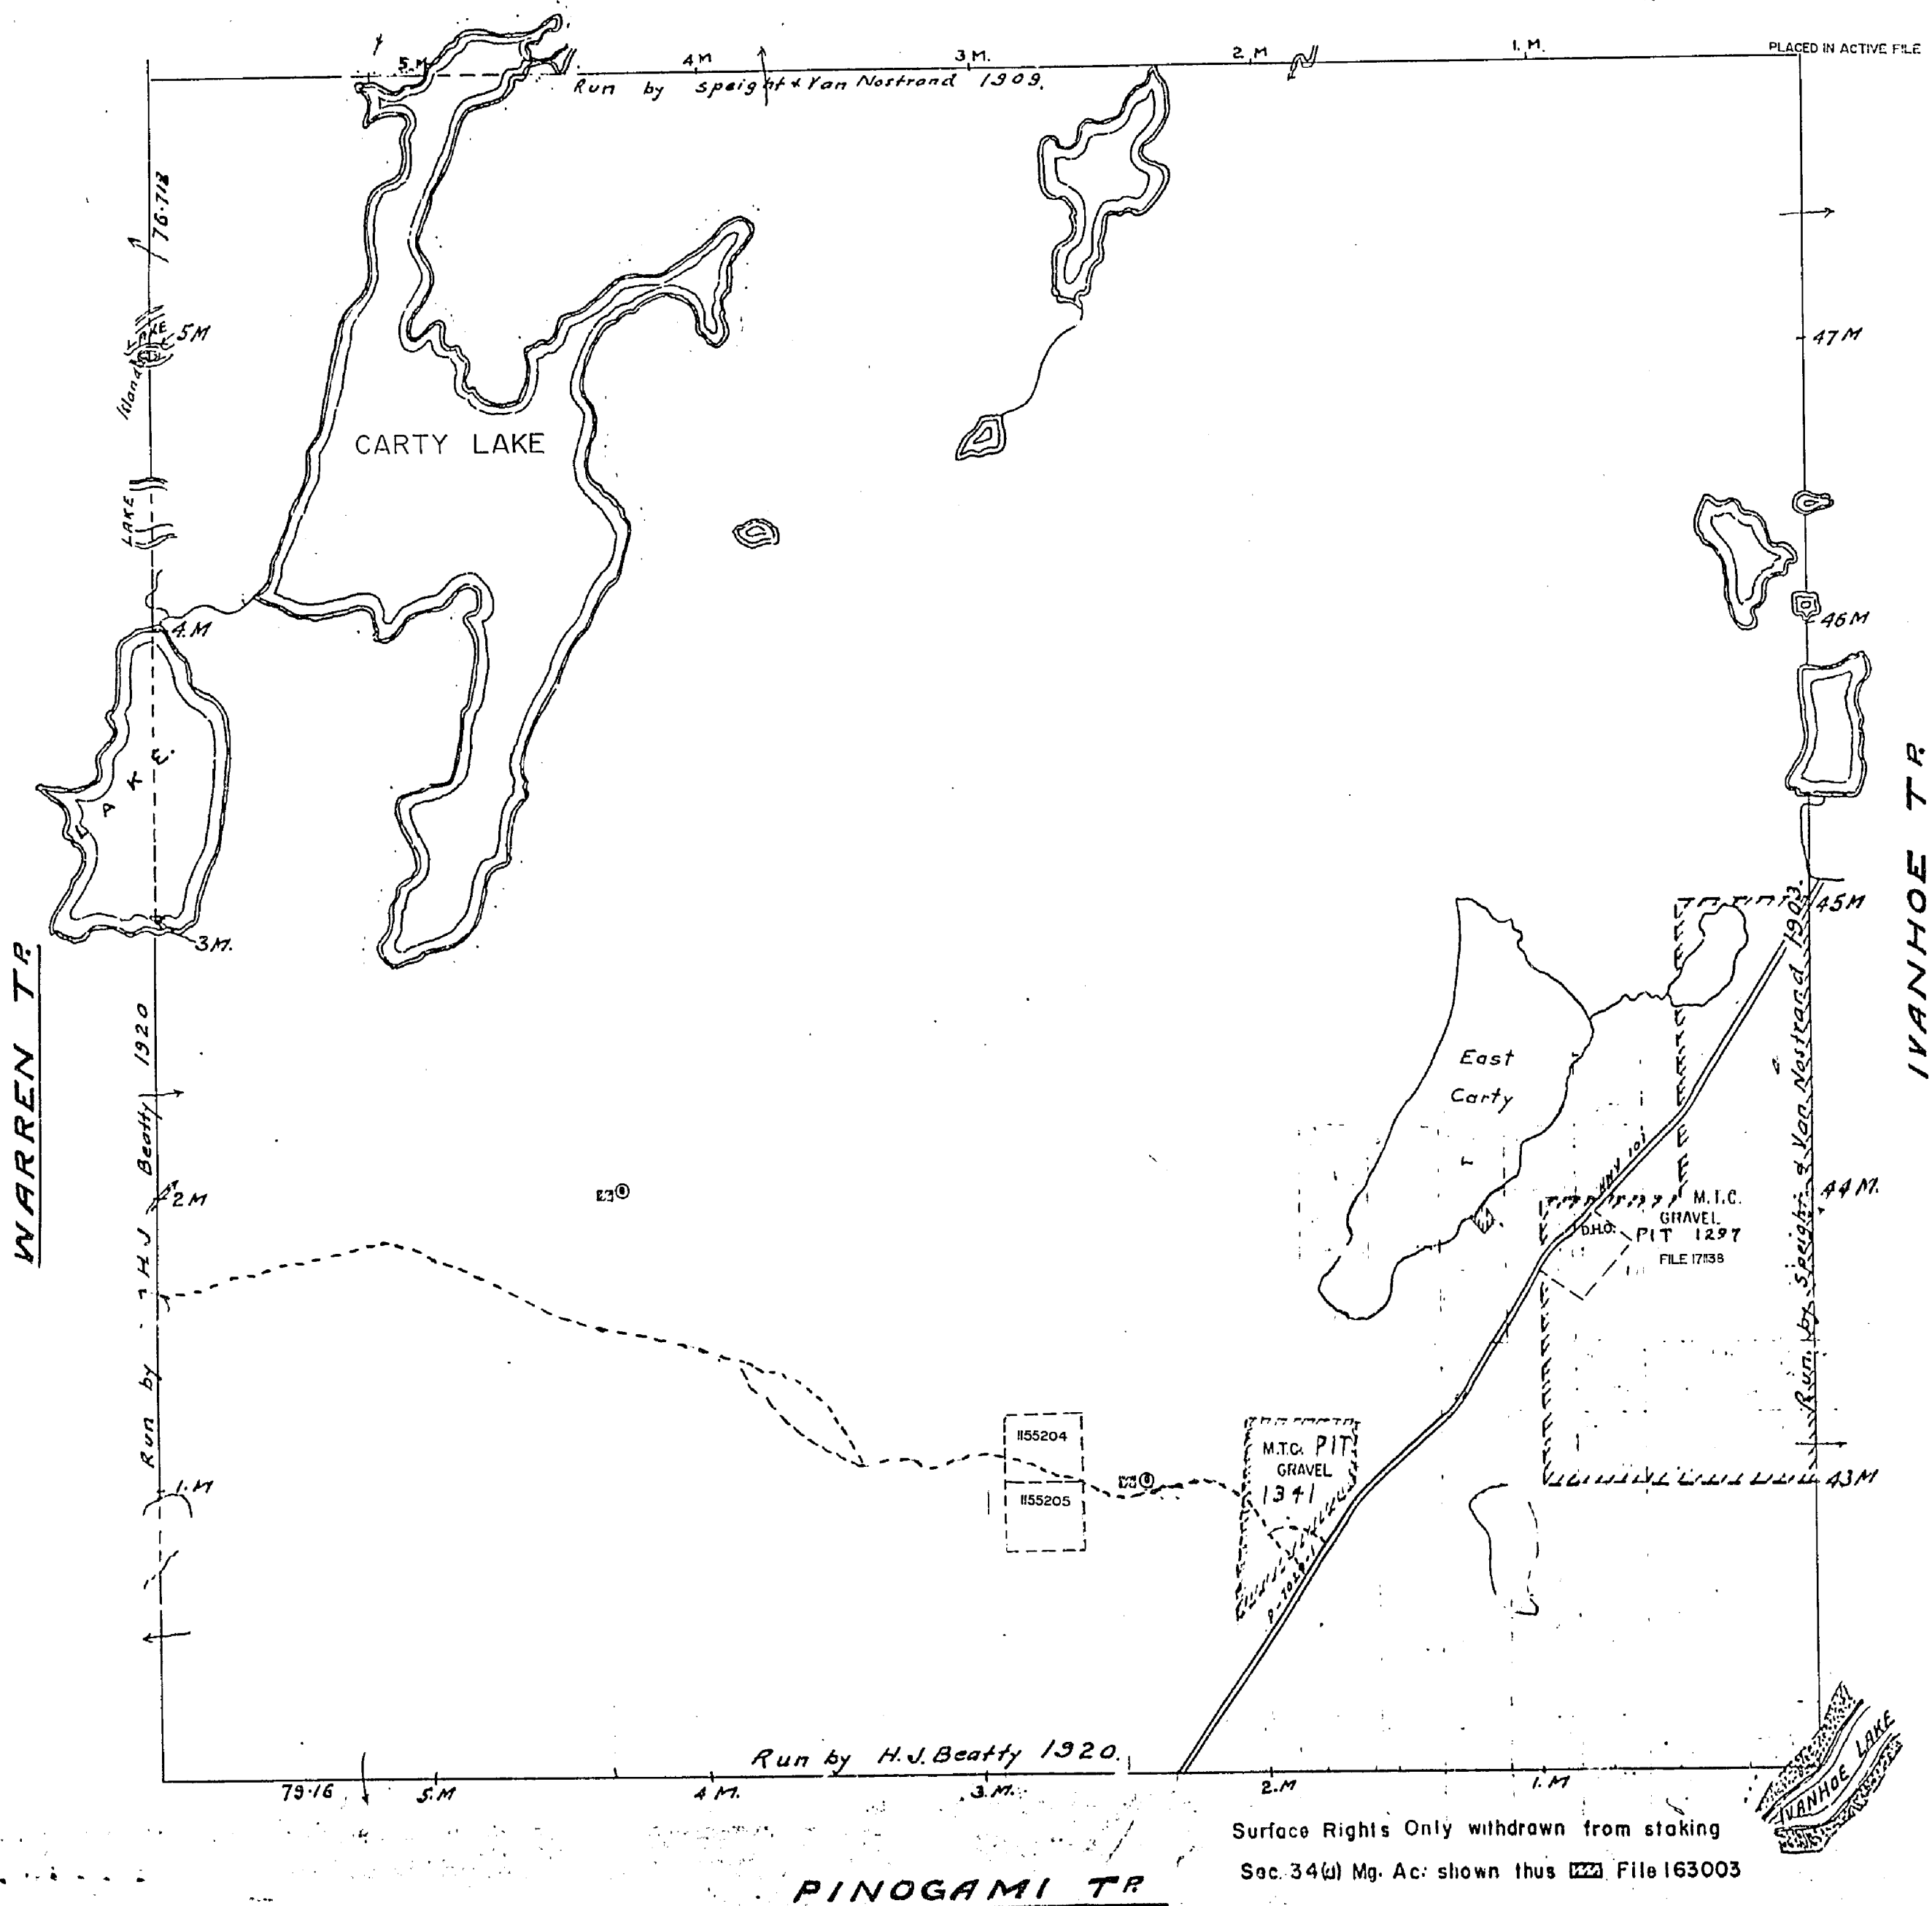

Traverse of Ivanhoe Lake, by T.G. Coda O.L.S. 1919.
Present shoreline of Ivanhoe Lake shown thus ———
Old Drainage Area shown thus ———

Note. Subsequent to the construction of a Dism in 1931-2 at the new an. artificial outlet at Ivanhoe Lake
the water level has been restored to about its original level. See File 79858.

Surface Rights Only withdrawn from staking
Sec. 34(u) Mg. Ac. shown thus [hatched] File 163003

PINO GAMI T R

REFERENCES

TOPOGRAPHY
LAKES, RIVERS, ECT., FROM FOREST RESOURCES
INVENTORY SHEET NO'S. 481 823, & 482 823.

SURVEYS
NORTH AND EAST BOUNDARIES OF CARTY TWP.
BY SPEIGHT & VANOSTRAND O.L.S. 1909.
FIELD NOTE BOOK NO. 2540.
SOUTH AND WEST BOUNDARIES OF CARTY TWP.
BY H.J. BEATTY O.L.S. 1920. FIELD NOTE
BOOK NO. 2292.

IVANHOE LAKE DRAINAGE AREA BY T.G. CODE
O.L.S. 1919. PLAN L2-28.

HIGHWAYS
HIGHWAY NO. 101 FROM MINISTRY OF TRANSPORT
PLAN NO. P-7029-1. (MA.1718.)

F. Forestry Activity 96/97

LEGEND

TOWNSHIP BOUNDARY SURVEYED	---
TOWNSHIP BOUNDARY PROJECTED	---
SURVEYED LINES LAND	---
SURVEYED LINES WATER	---
BLIND LINES	---
UNSURVEYED PARCEL BOUNDARY	---
MAIN ROAD	---
OTHER ROADS	---
HIGHWAY ROUTE NO.	---
TRAIL OR PATH	---
ELECTRIC TRANSMISSION LINE	---
PIPE LINE	---
RAILWAY AND RIGHT OF WAY	---
SUBDIVISION OR COMPOSITE PLAN	---
RESERVATION	---
BRIDGE, BUILDINGS	---
DAM, RAPIDS, FALLS, PORTAGE	---
NON-PERENNIAL STREAM	---
EDGE OF CLEARING	---
TREELESS MUSKEG OR MARSH	---
FLOODING	---
TRAVERSE POST	---
PROPOSED ROAD MNR	---

LANDS ALIENATED FROM CROWN

TYPE OF DOCUMENT	SYMBOL
LICENCE OF OCCUPATION	○
LEASE, SURFACE RIGHTS ONLY	○
MINING RIGHTS ONLY	○
SURFACE AND MINING RIGHTS	○
PATENT, SURFACE RIGHTS ONLY	○
MINING RIGHTS ONLY	○
SURFACE AND MINING RIGHTS	○
SURFACE RIGHTS-LEASE MINING RIGHTS	○
MINING RIGHTS-LEASE, SURFACE RIGHTS	○
ORDER IN COUNCIL	○
RESERVATION	○

TOWNSHIP CARTY

M.N.R. ADMINISTRATIVE DISTRICT
CHAPLEAU
MINING DIVISION
PORCUPINE
LAND TITLES/REGISTRY DIVISION
SUDBURY
ACTIVATED 91-NOV-21


Ministry of Natural Resources
Ministry of Northern Development and Mines
Ontario

DR. D.L.T. CH. E.J.D. APP. E.J.D. DATE APR. 15, 1980

SCALE: 1 INCH = 20 CHAINS
TORONTO, CANADA G-1070

REFERENCES

LEMOINE TWP.

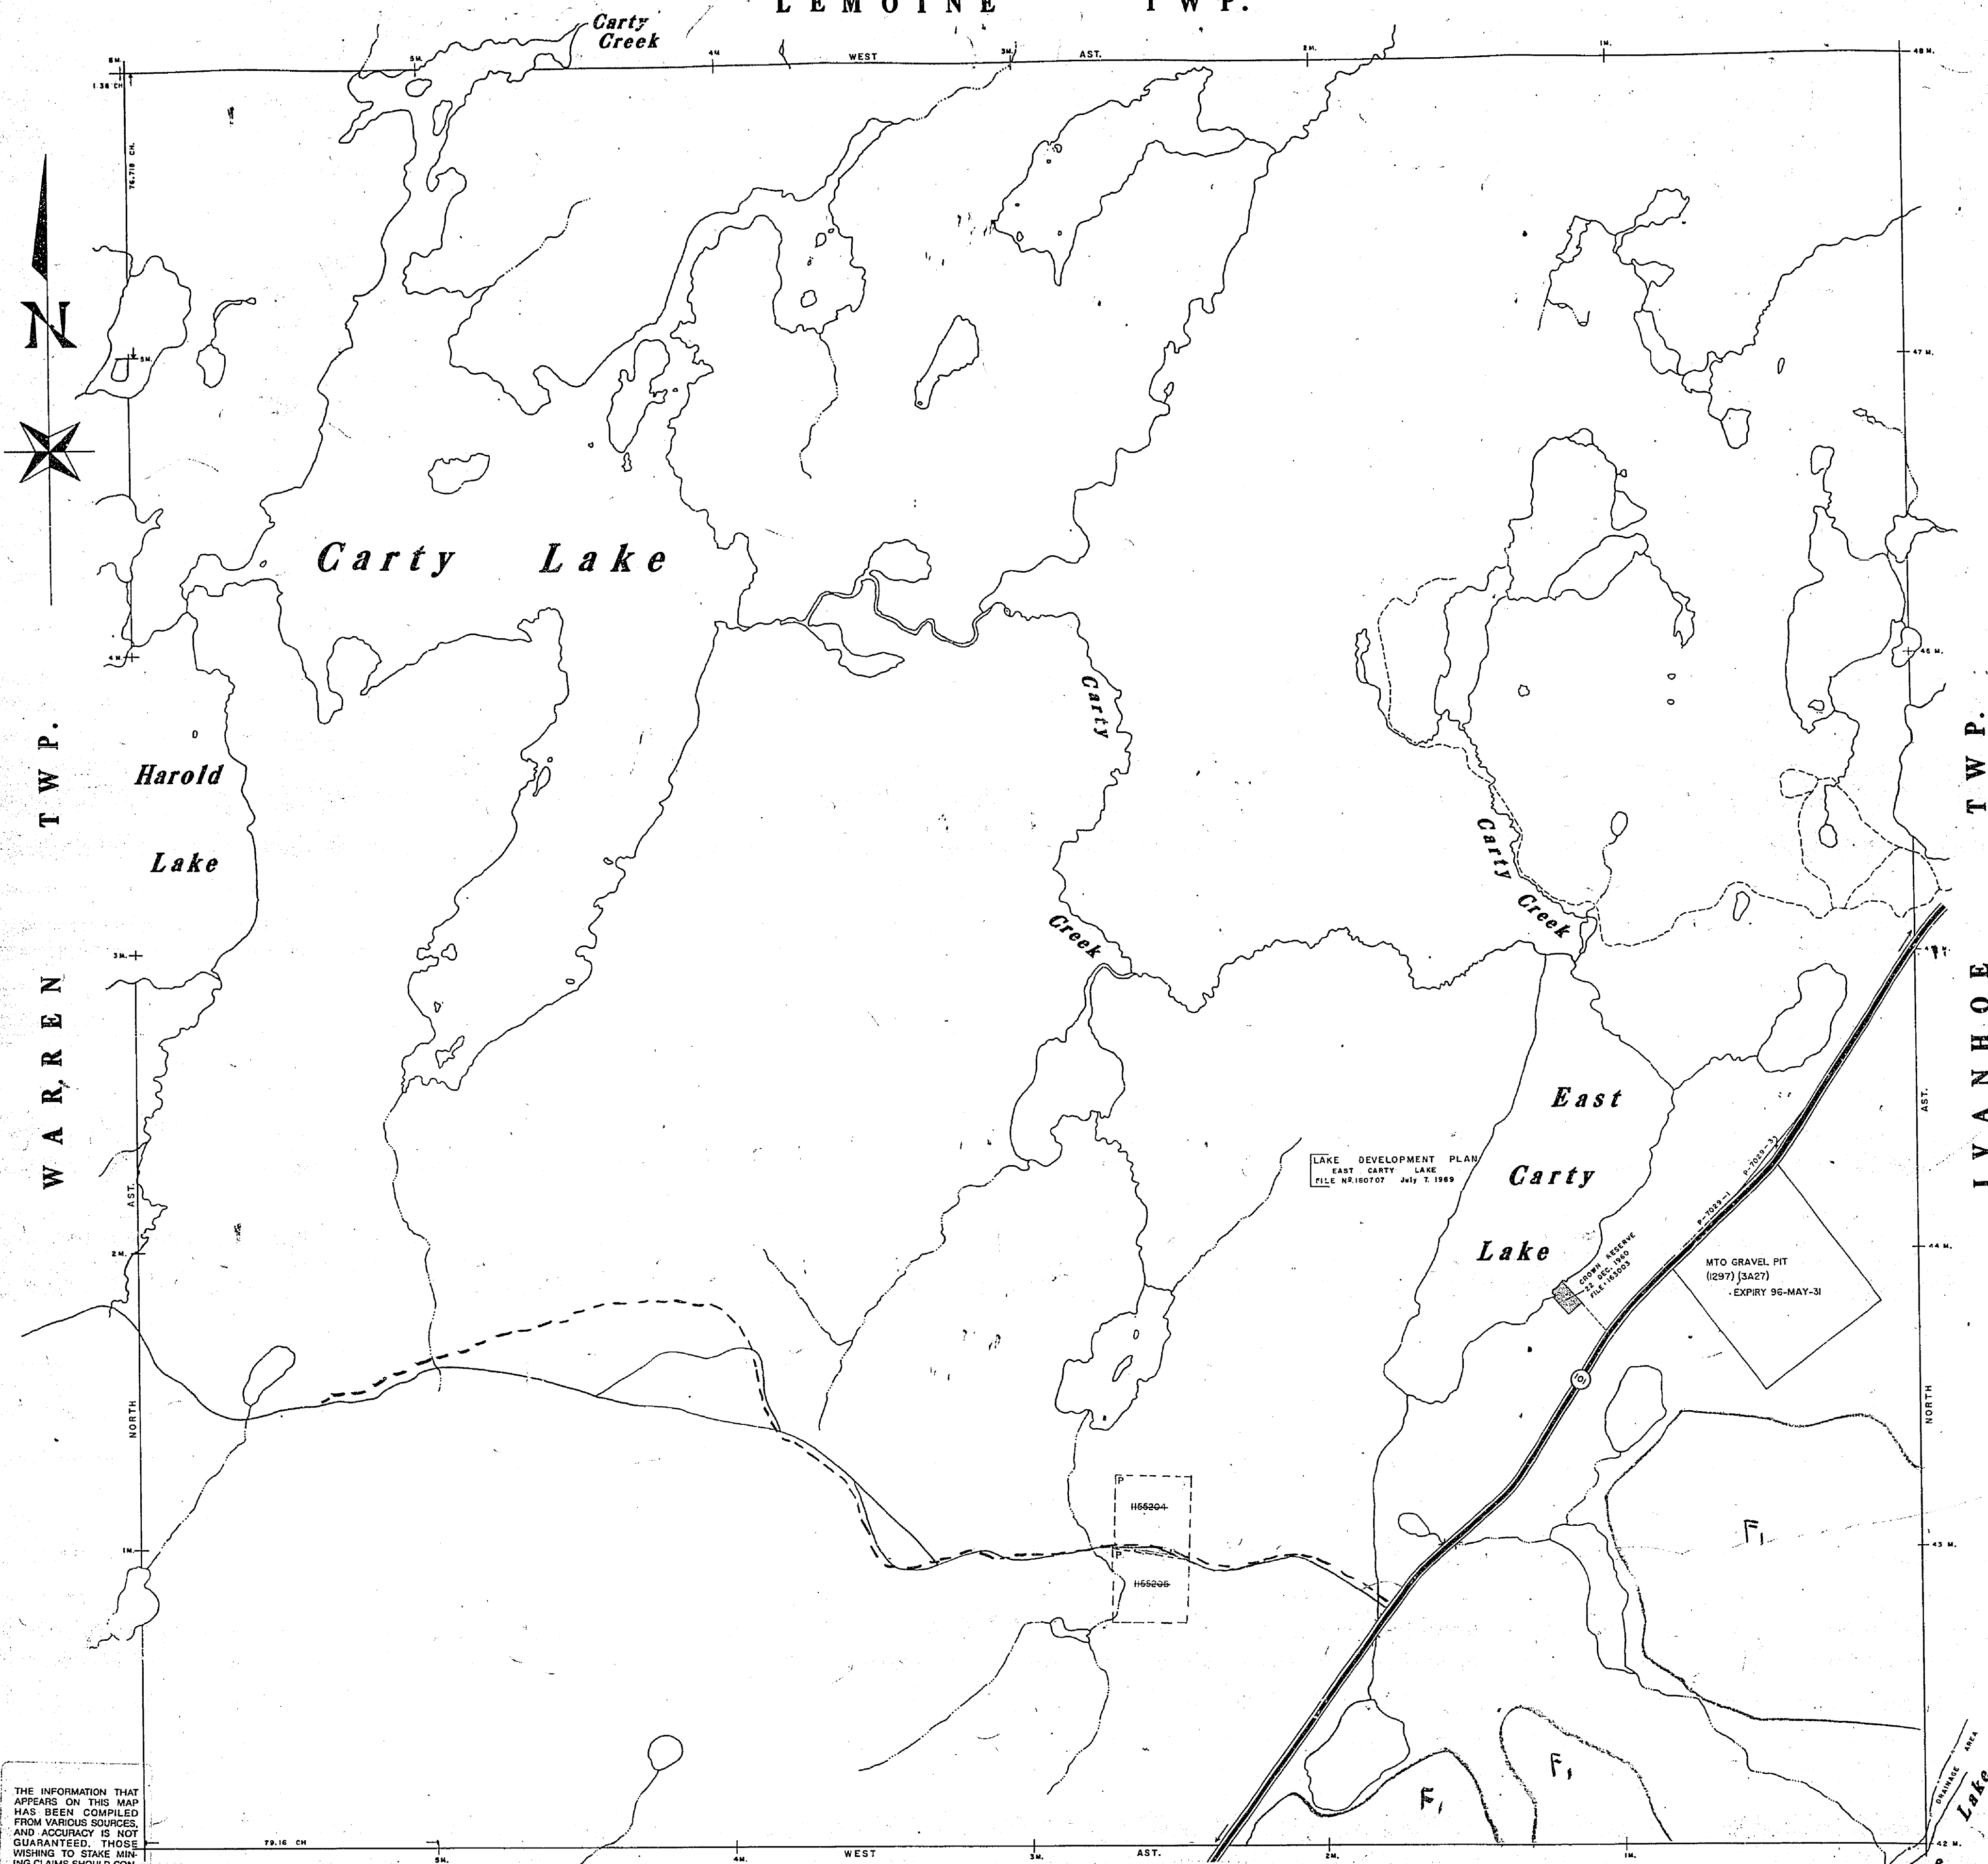

DATE OF ISSUE

MAY 06 1998
PROVINCIAL RECORDING
OFFICE - SUDBURY

THE INFORMATION THAT
APPEARS ON THIS MAP
HAS BEEN COMPILED
FROM VARIOUS SOURCES
AND ACCURACY IS NOT
GUARANTEED. THOSE
WISHING TO STAKE MIN-
ING CLAIMS SHOULD CON-
SULT WITH THE MINING
RECORDER, MINISTRY OF
NORTHERN DEVELOP-
MENT AND MINES, FOR AD-
DITIONAL INFORMATION
ON THE STATUS OF THE
LANDS SHOWN HEREON.