

DATE-0

AREAS WITHDRAWN FROM DISPOSITION

M.F.S. - MINING RIGHTS ONLY

M.R.O. - SURFACE RIGHTS ONLY

M.+S. - MINING AND SURFACE RIGHTS

Description Order No. Date Disposition File

SKINNER TOWNSHIP G 3758

NARROW LAKE TOWNSHIP G 1824

LITTLE BEAR LAKE G 1809

TOWNSHIP

77M.

76M.

75M.

74M.

73M.

5M.

4M.

3M.

2M.

1M.

5M.

4M.

3M.

2M.

1M.

DENT TOWNSHIP G 3737

KNOTT TOWNSHIP G 1809

THE INFORMATION THAT APPEARS ON THIS MAP HAS BEEN COMPILED FROM VARIOUS SOURCES AND ACCURACY IS NOT GUARANTEED. THOSE WISHING TO STAKE MINING CLAIMS SHOULD CONSULT WITH THE MINING RECORDER, MINISTRY OF NORTHERN DEVELOPMENT AND MINES, FOR ADDITIONAL INFORMATION ON THE STATUS OF THE LANDS SHOWN HEREON.


LEGEND

- HIGHWAY AND ROUTE NO.
OTHER ROADS
TRAILS
SURVEYED LINES:
TOWNSHIPS, BASE LINES, ETC.
LOTS, MINING CLAIMS, PARCELS, ETC.
UNSURVEYED LINES:
LOT LINES
PARCEL BOUNDARY
MINING CLAIMS ETC.
RAILWAY AND RIGHT OF WAY
UTILITY LINES
NON PERENNIAL STREAM
FLOODING OR FLOODING HEIGHTS
SUBDIVISION OR COMPOSITE PLAN
RESERVATIONS
ORIGINAL SHORELINE
MARSH OR MUSKEG
MINES
TRAVERSE MONUMENT

DISPOSITION OF CROWN LANDS

TYPE OF DOCUMENT	SYMBOL
PATENT, SURFACE & MINING RIGHTS	●
" SURFACE RIGHTS ONLY	○
" MINING RIGHTS ONLY	○
LEASE, SURFACE & MINING RIGHTS	○
" SURFACE RIGHTS ONLY	○
" MINING RIGHTS ONLY	○
LICENCE OF OCCUPATION	○
ORDER-IN-COUNCIL	OC
RESERVATION	○
CANCELLED	○
SAND & GRAVEL	○

NOTE: MINING RIGHTS IN PARCELS PATENTED PRIOR TO MAY 6, 1912, VESTED IN ORIGINAL PATENTEE BY THE PUBLIC LANDS ACT, R.S.O. 1970, CHAP. 380, SEC. 63 SUBSEC. 1.

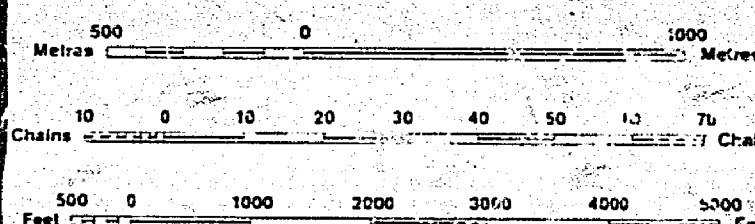

SCALE 1:20 000

RECEIVED
FEB 27 1987
RED LAKE
MINING DIV.

TOWNSHIP
CORLESS

M.N.R. ADMINISTRATIVE DISTRICT
RED LAKE
MINING DIVISION
RED LAKE
LAND TITLES / REGISTRY DIVISION
KENORA/PATRICIA

Ministry of Natural Resources
Ontario
Ministry of Northern Development and Mines

SEPTEMBER, 1986

G-3746

DATE-0

2154

Skinner Twp. - M.2205

THE TOWNSHIP
OF

CORLESS

DISTRICT OF
KENORA - PATRICIA PORTION

RED LAKE
MINING DIVISION


SCALE: 1-INCH = 40 CHAINS

LEGEND

PATENTED LAND	Ⓟ
CROWN LAND SALE	C.S.
LEASES	Ⓢ
LOCATED LAND	Loc.
LICENSE OF OCCUPATION	L.O.
MINING RIGHTS ONLY	M.R.O.
SURFACE RIGHTS ONLY	S.R.O.
ROADS	—
IMPROVED ROADS	—
KING'S HIGHWAYS	—
RAILWAYS	—
POWER LINES	—
MARSH OR MUSKEG	—
MINES	✕
CANCELLED	C

NOTES


400' Surface Rights Reservation around
all Lakes and Rivers.

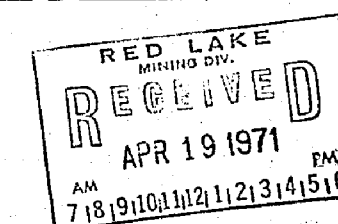

PLAN NO. M-2154

ONTARIO
DEPARTMENT OF MINES
AND NORTHERN AFFAIRS

Area Maps: M.2472 and M.2690

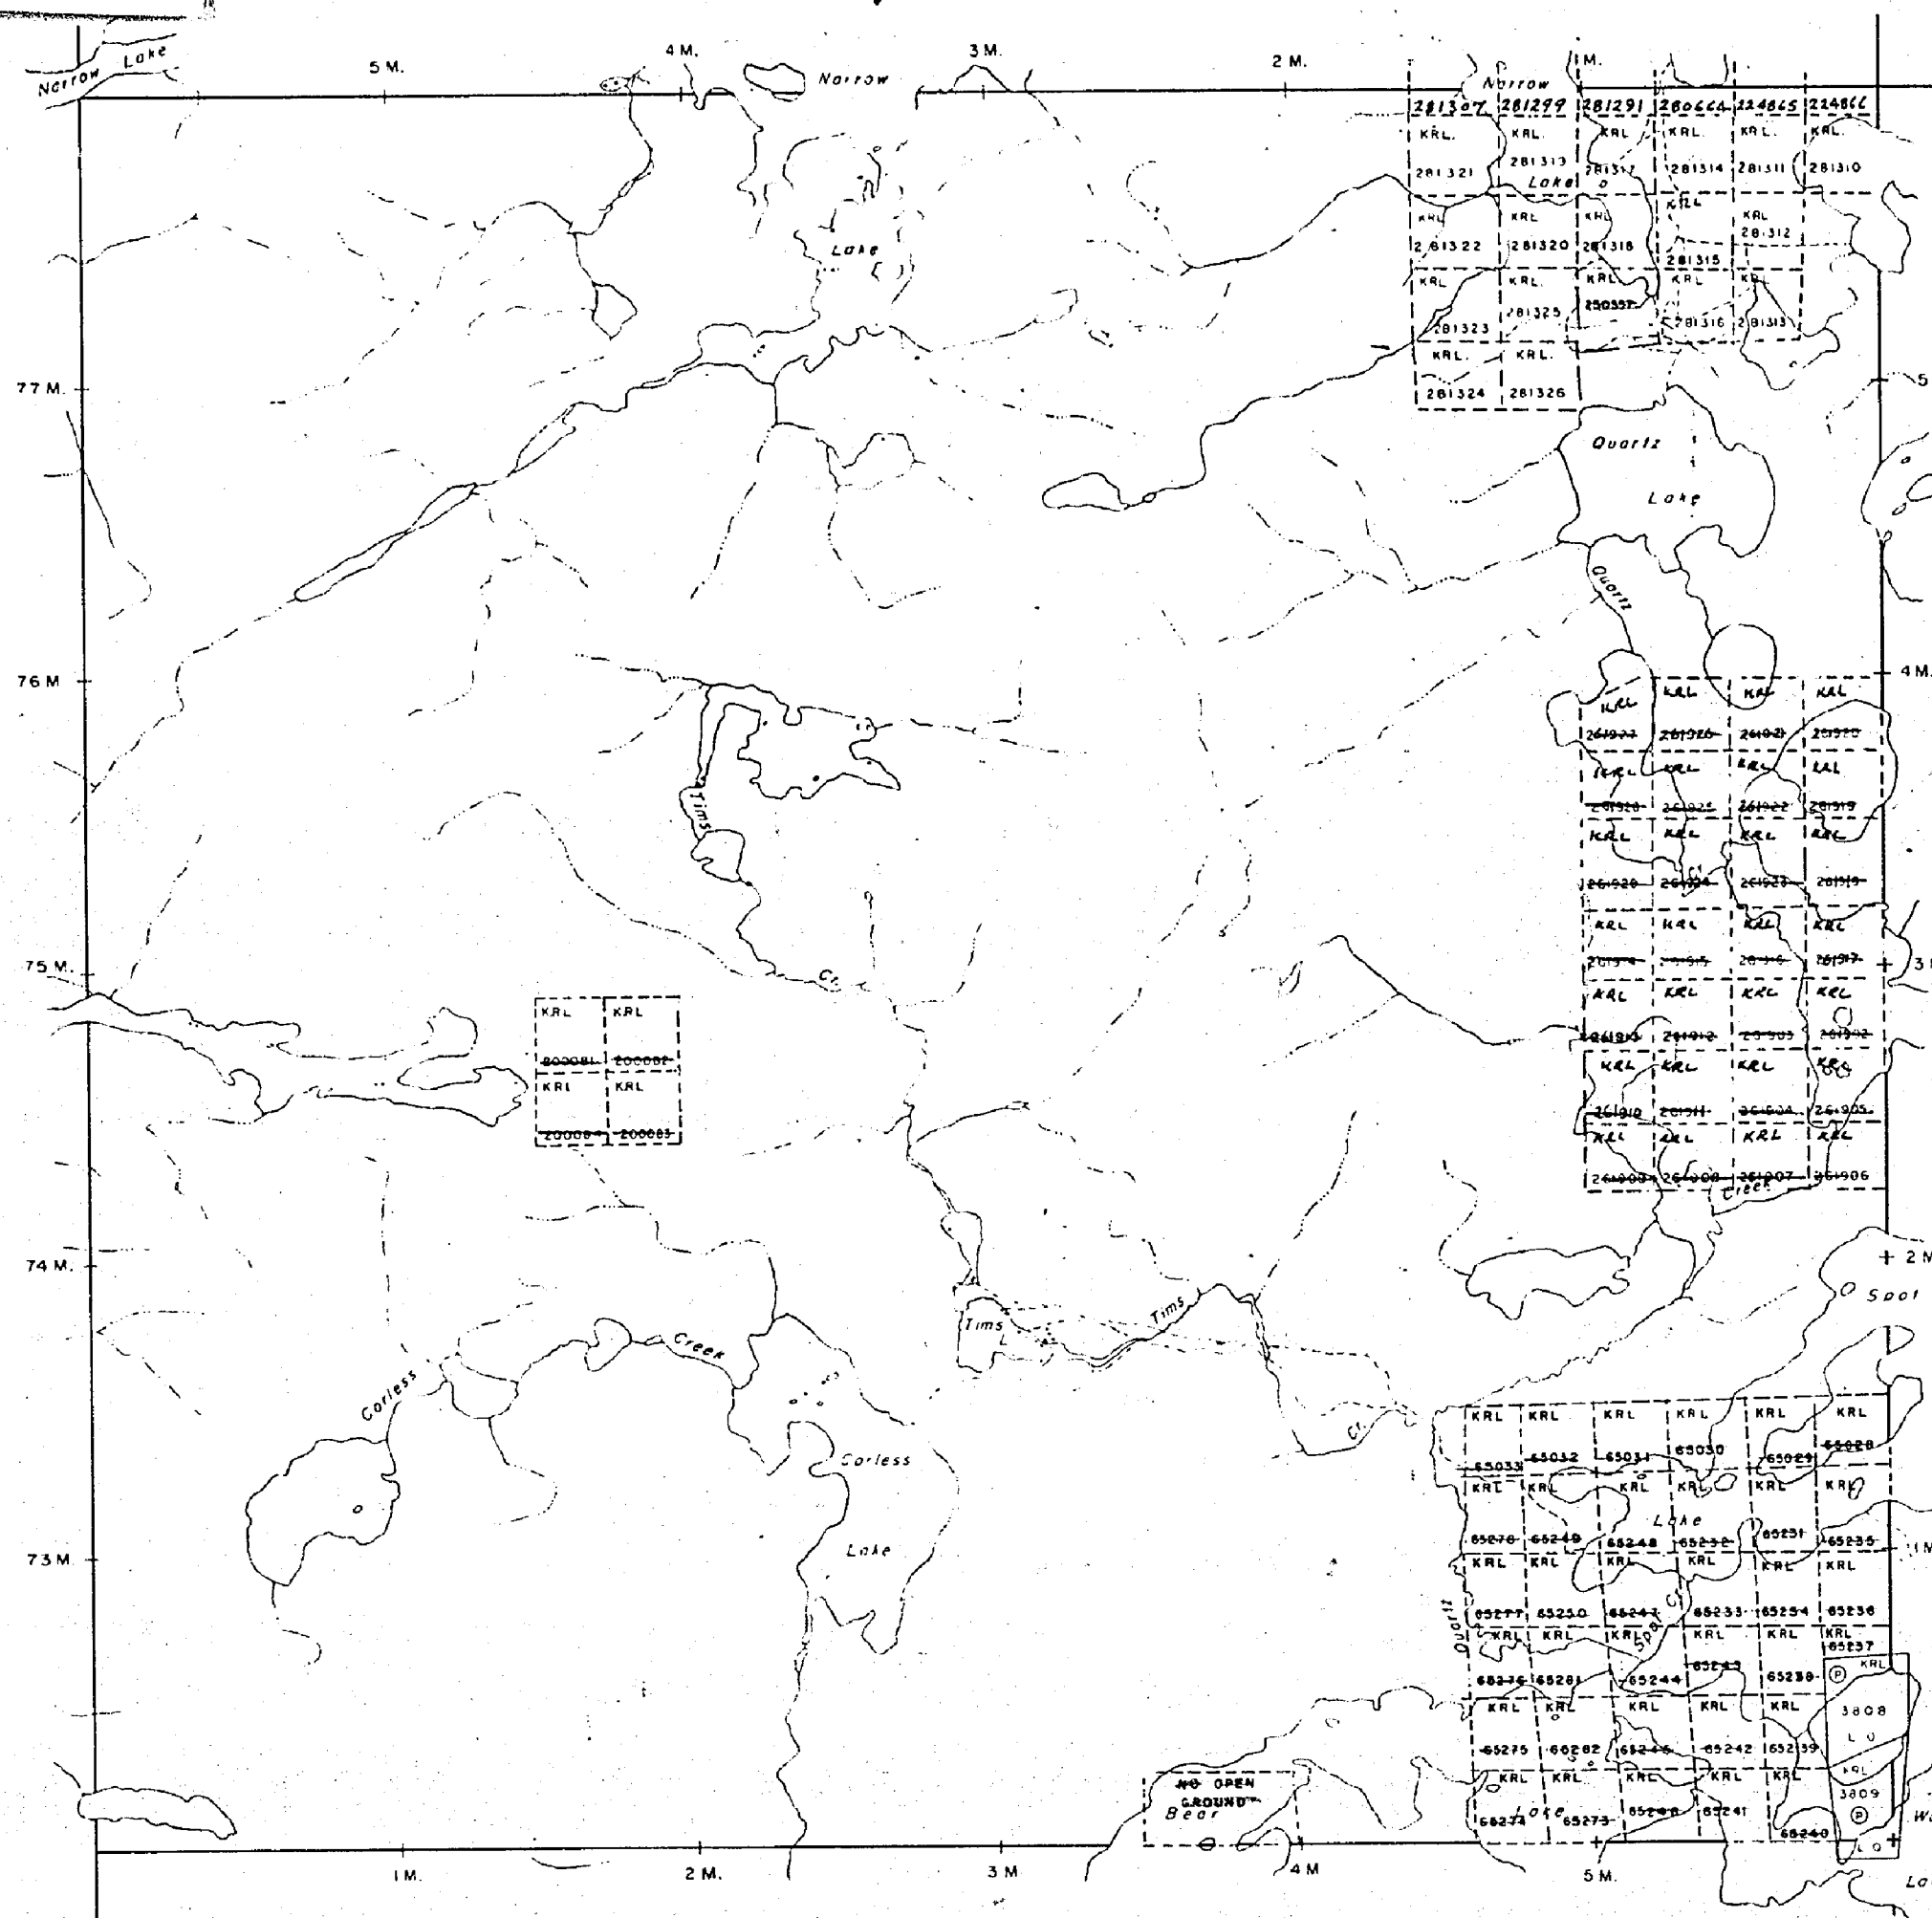

Dent Twp. - M.2155

Knott Twp. - M.2472


COMFEE2 IMB KF5

RED LAKE MINING DIVISION

Scale 40 Chains = 1 inch

M. 2154

SKINNER.

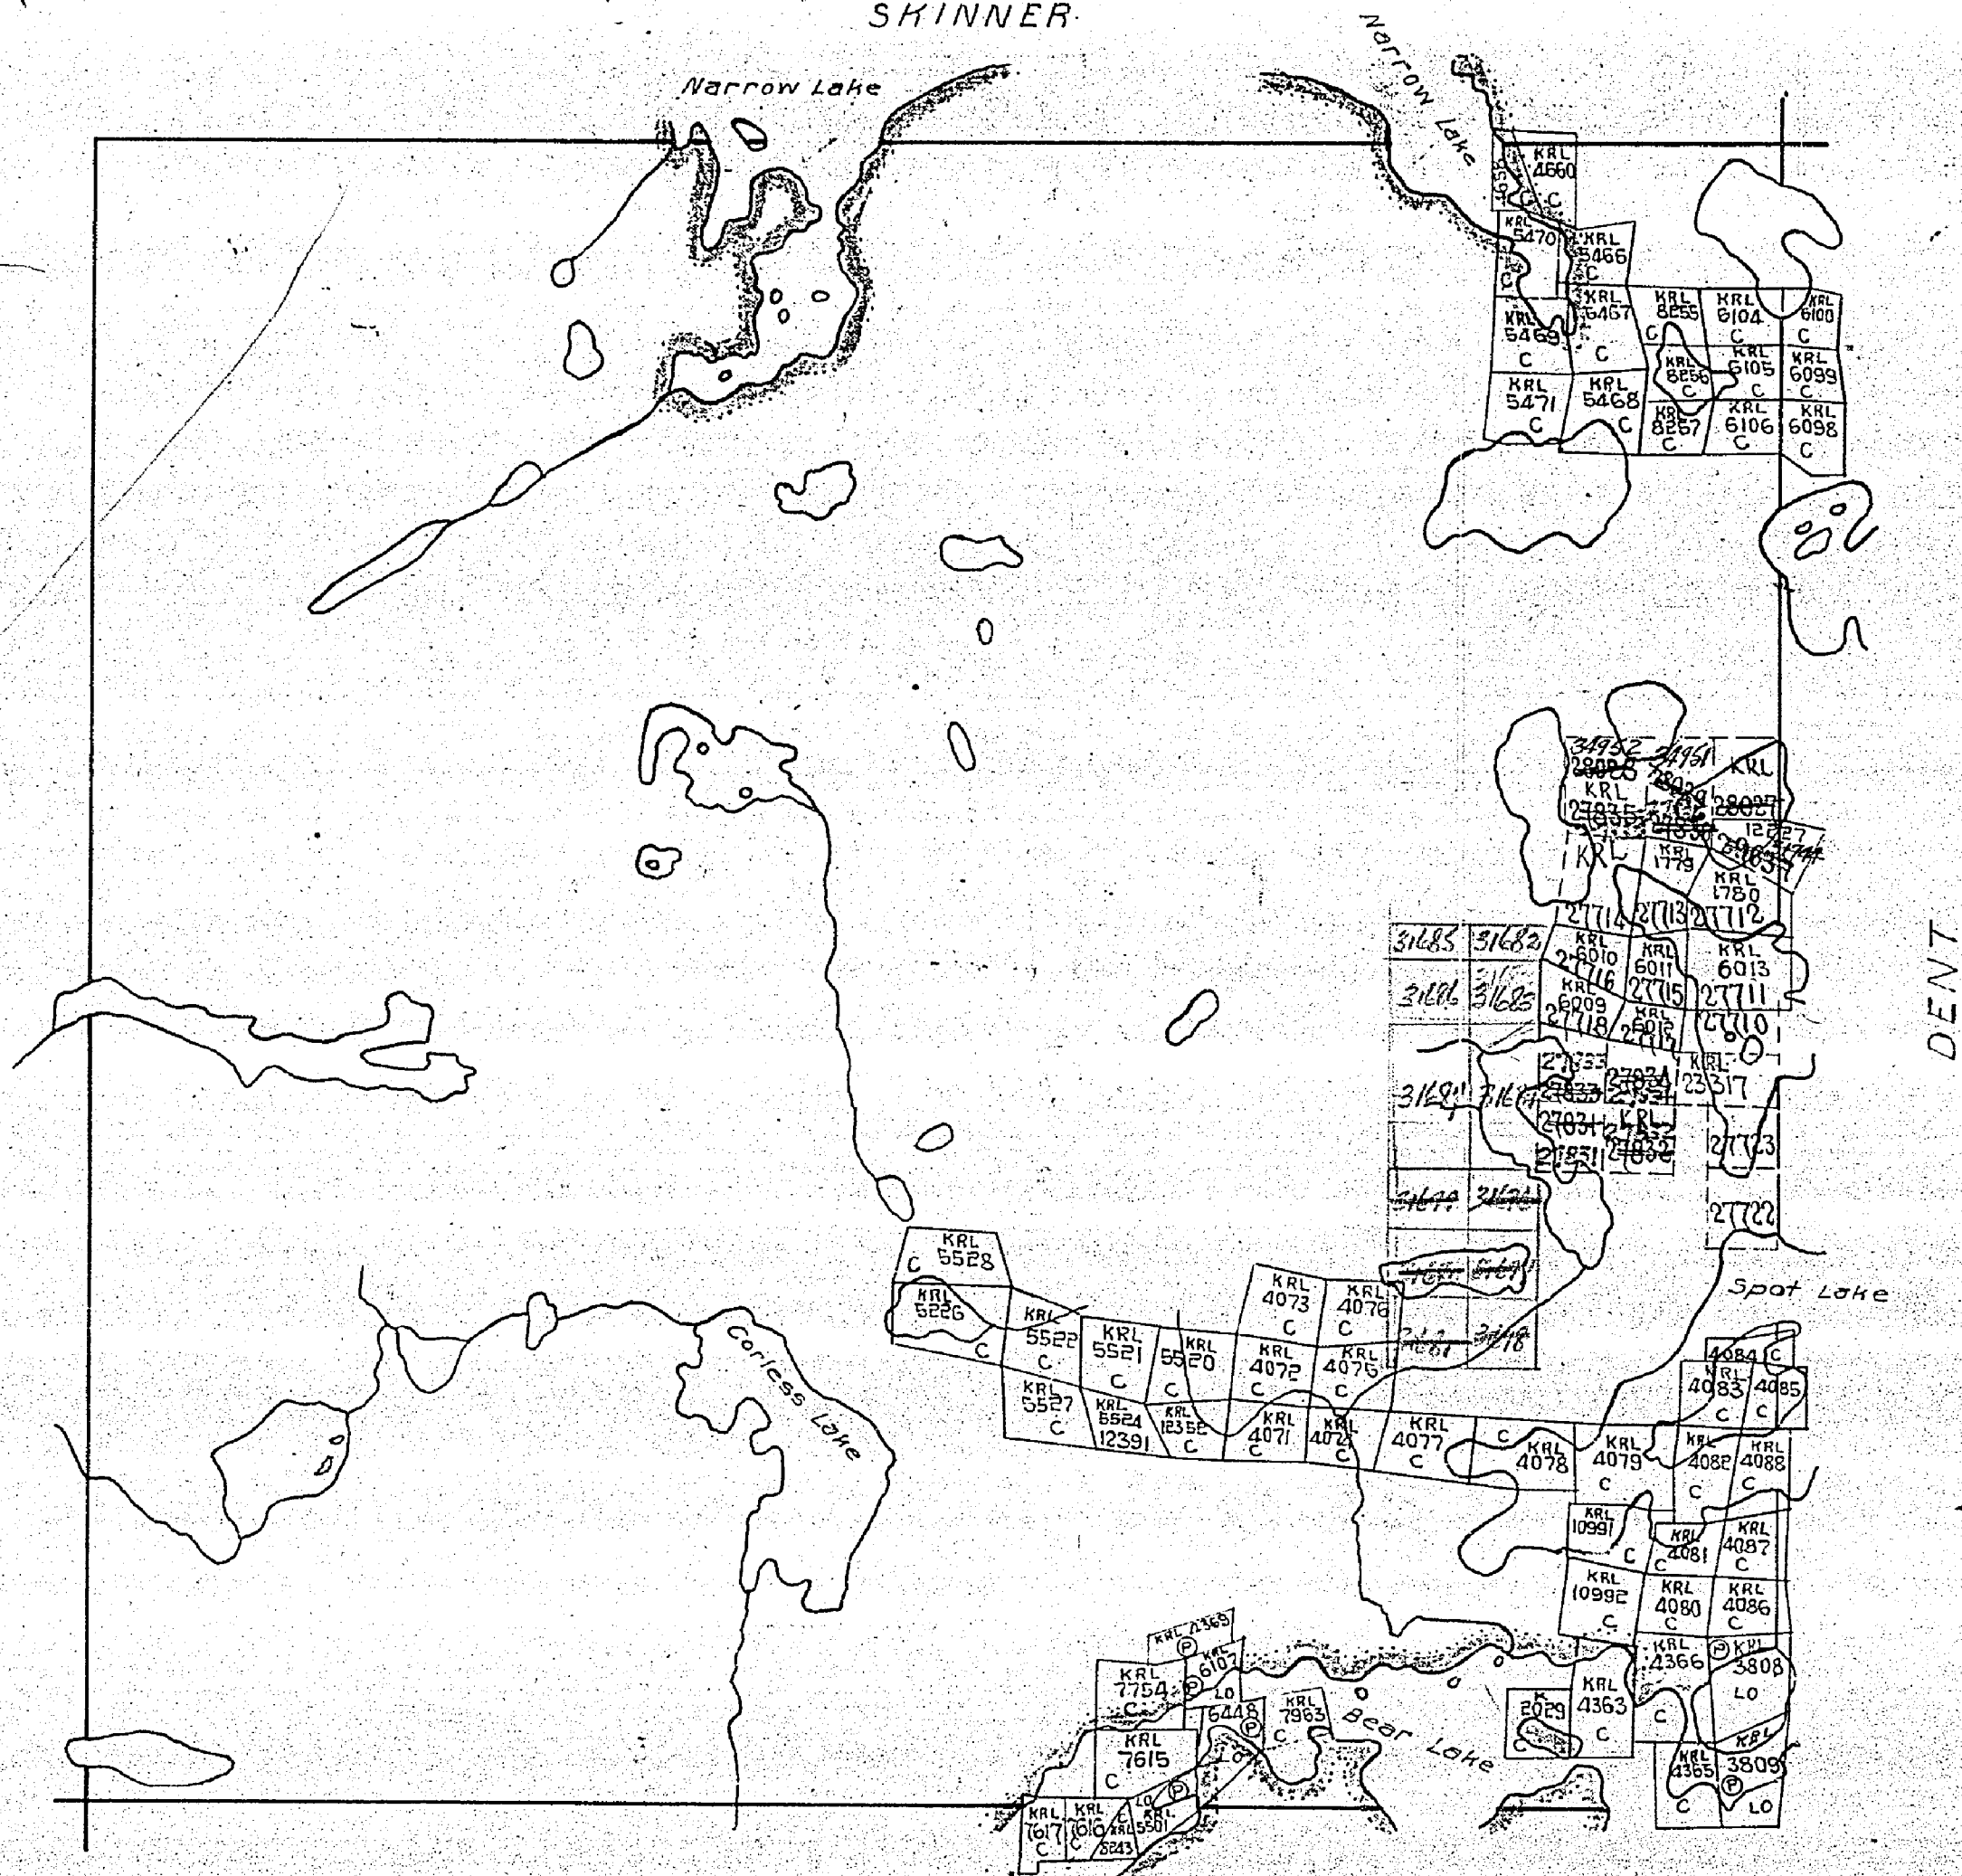

Surface reservations 200' wide by Dept of L. & E. shown
hereon this ~~reservation~~.

KNOTT

2154

CORLESS

RED LAKE MINING DIVISION

Scale 40 Chains = 1 inch

M.2154

SKINNER

Narrow Lake

Narrow Lake

DENT

Spot Lake

Corless Lake

Gear Lake

Surface reservations 200 wide by Depth of L.T.F. shown
hereon that ~~is~~ is

KNOTT



M. 2154

2154

CORLESS

RED LAKE MINING DIVISION


M.2154

Scale 40 Chains = 1 inch

SKINNER

Narrow Lake


Narrow Lake

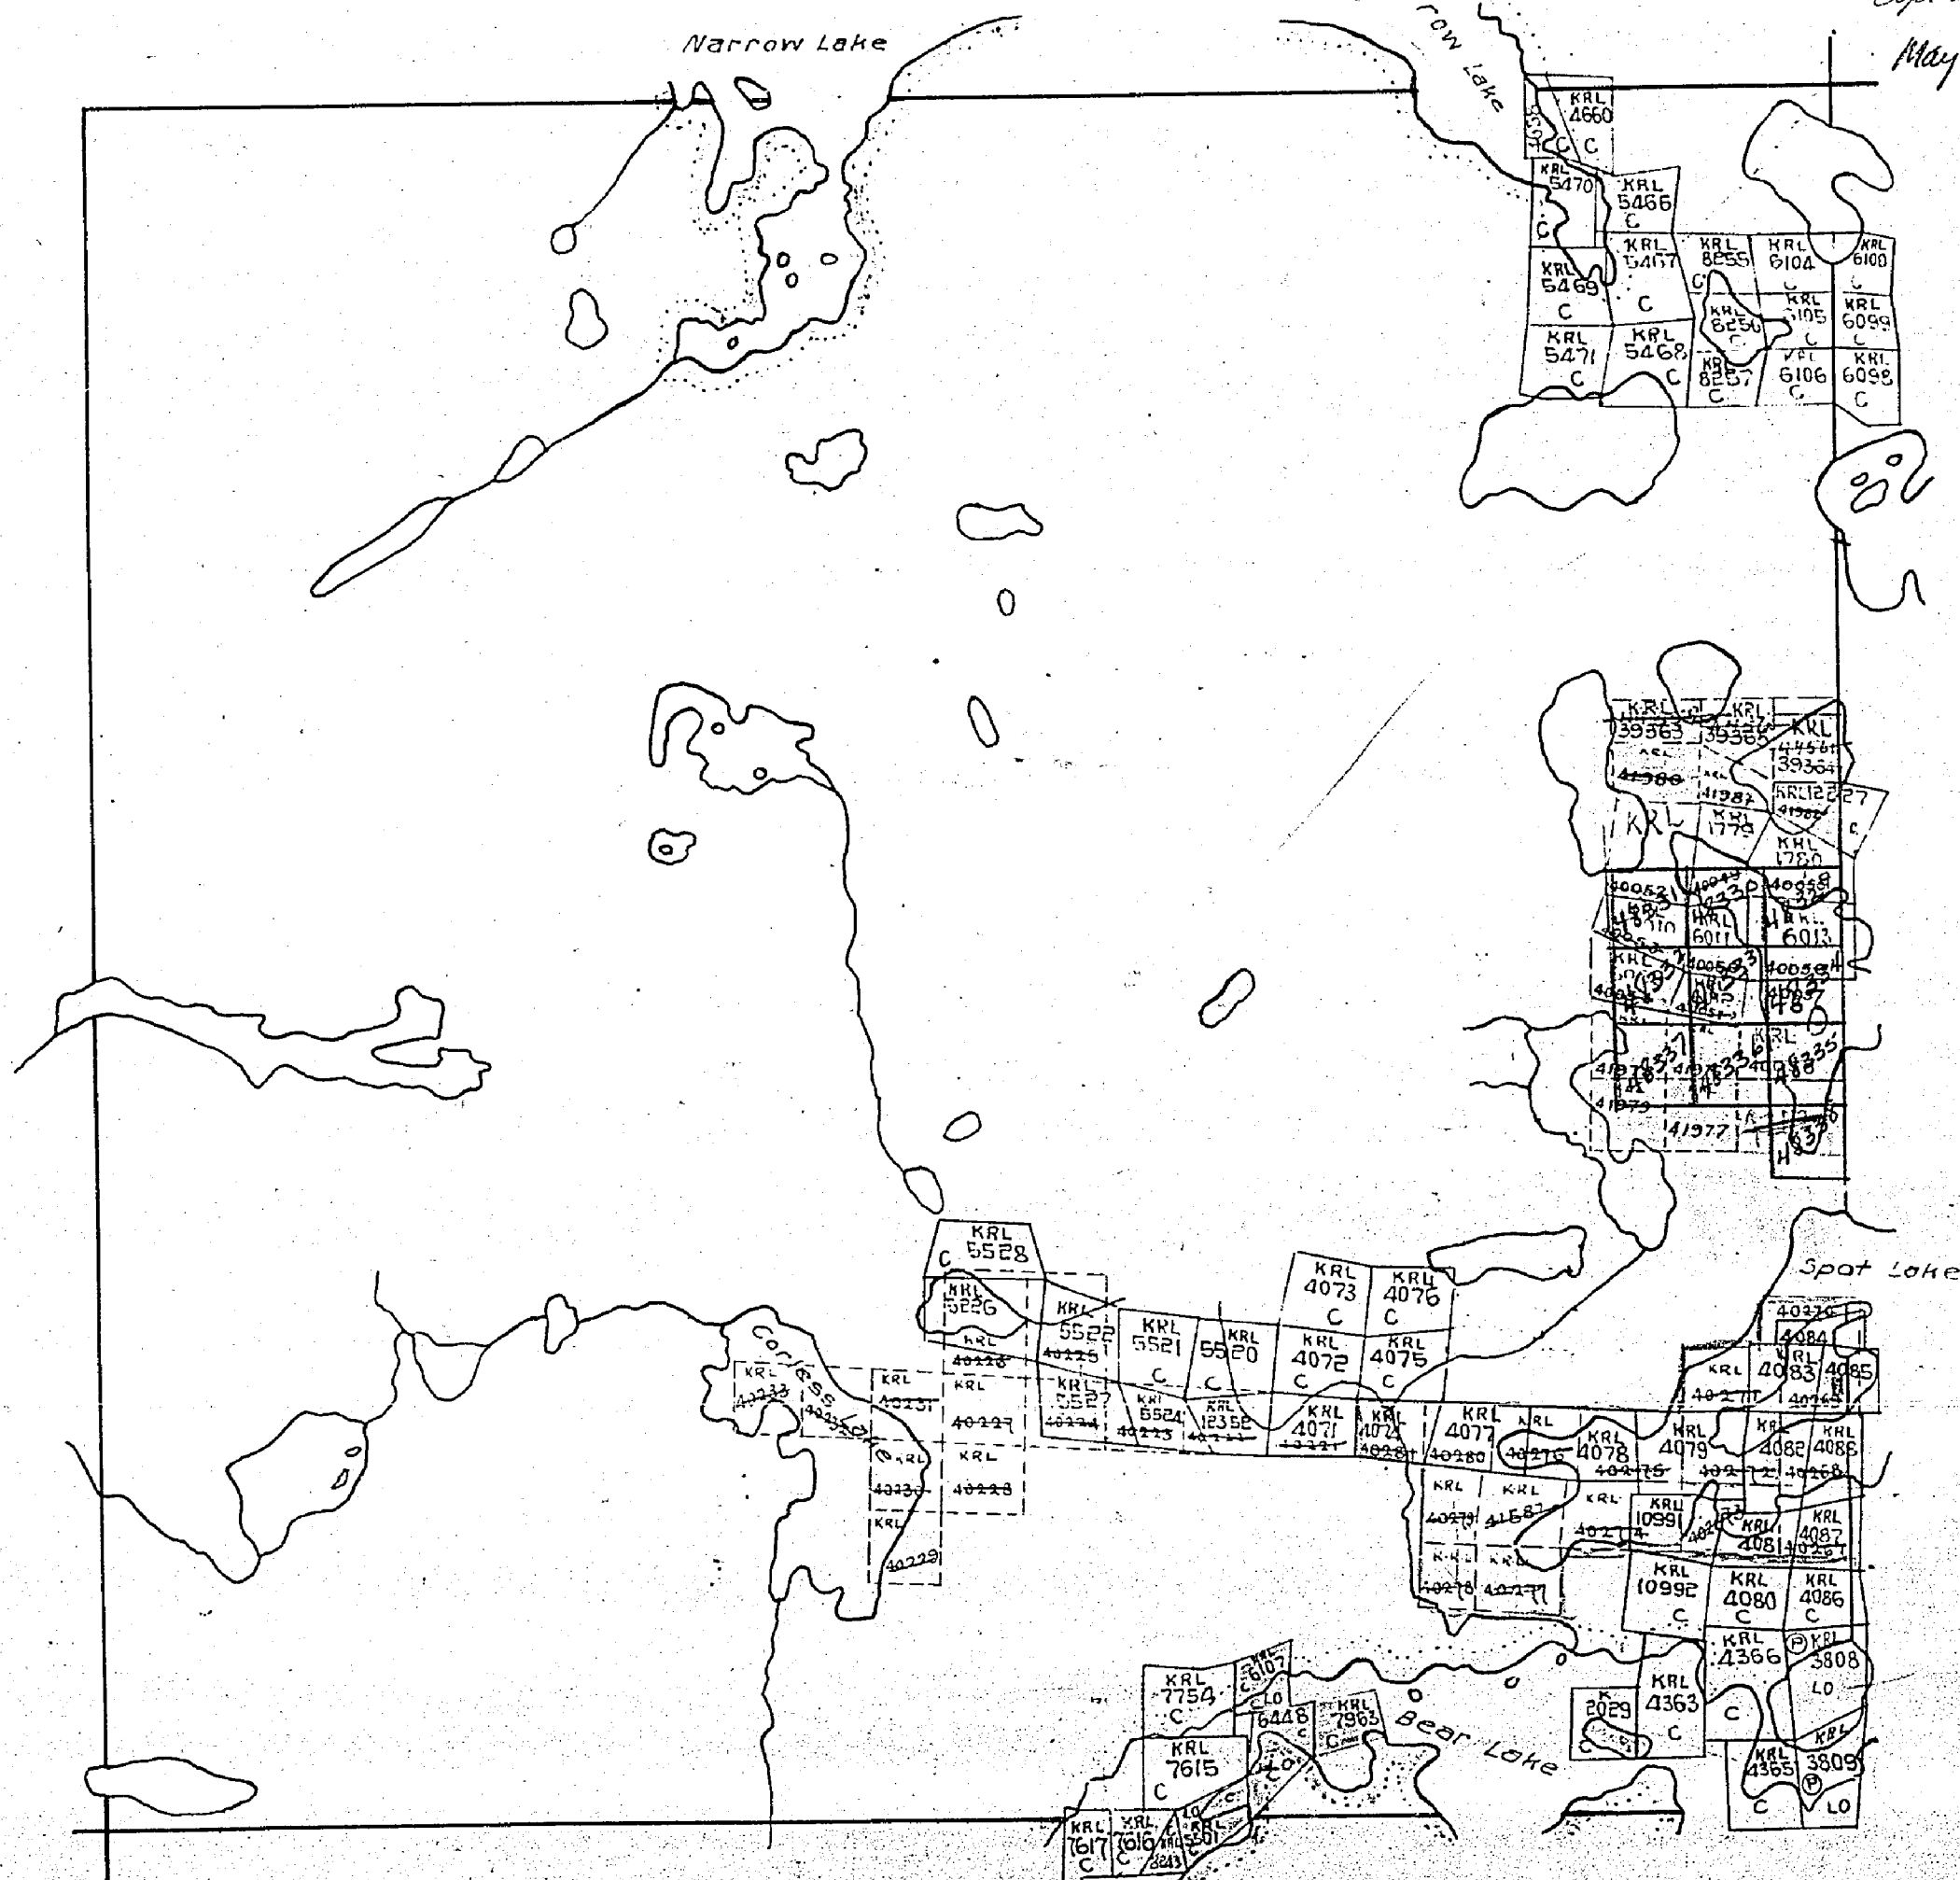Apr 27/60
May 31/60

Surface reservations 200' wide by Dept of L.T.F. shown
hereon after 1950-1951.

SURVEYS REMAINED
7 25/100

KNOTT

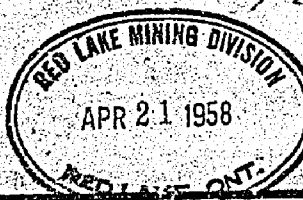


M.2154

RED LAKE MINING DIVISION

Scale 40 Chains = 1 inch

M. 2154

SKINNER

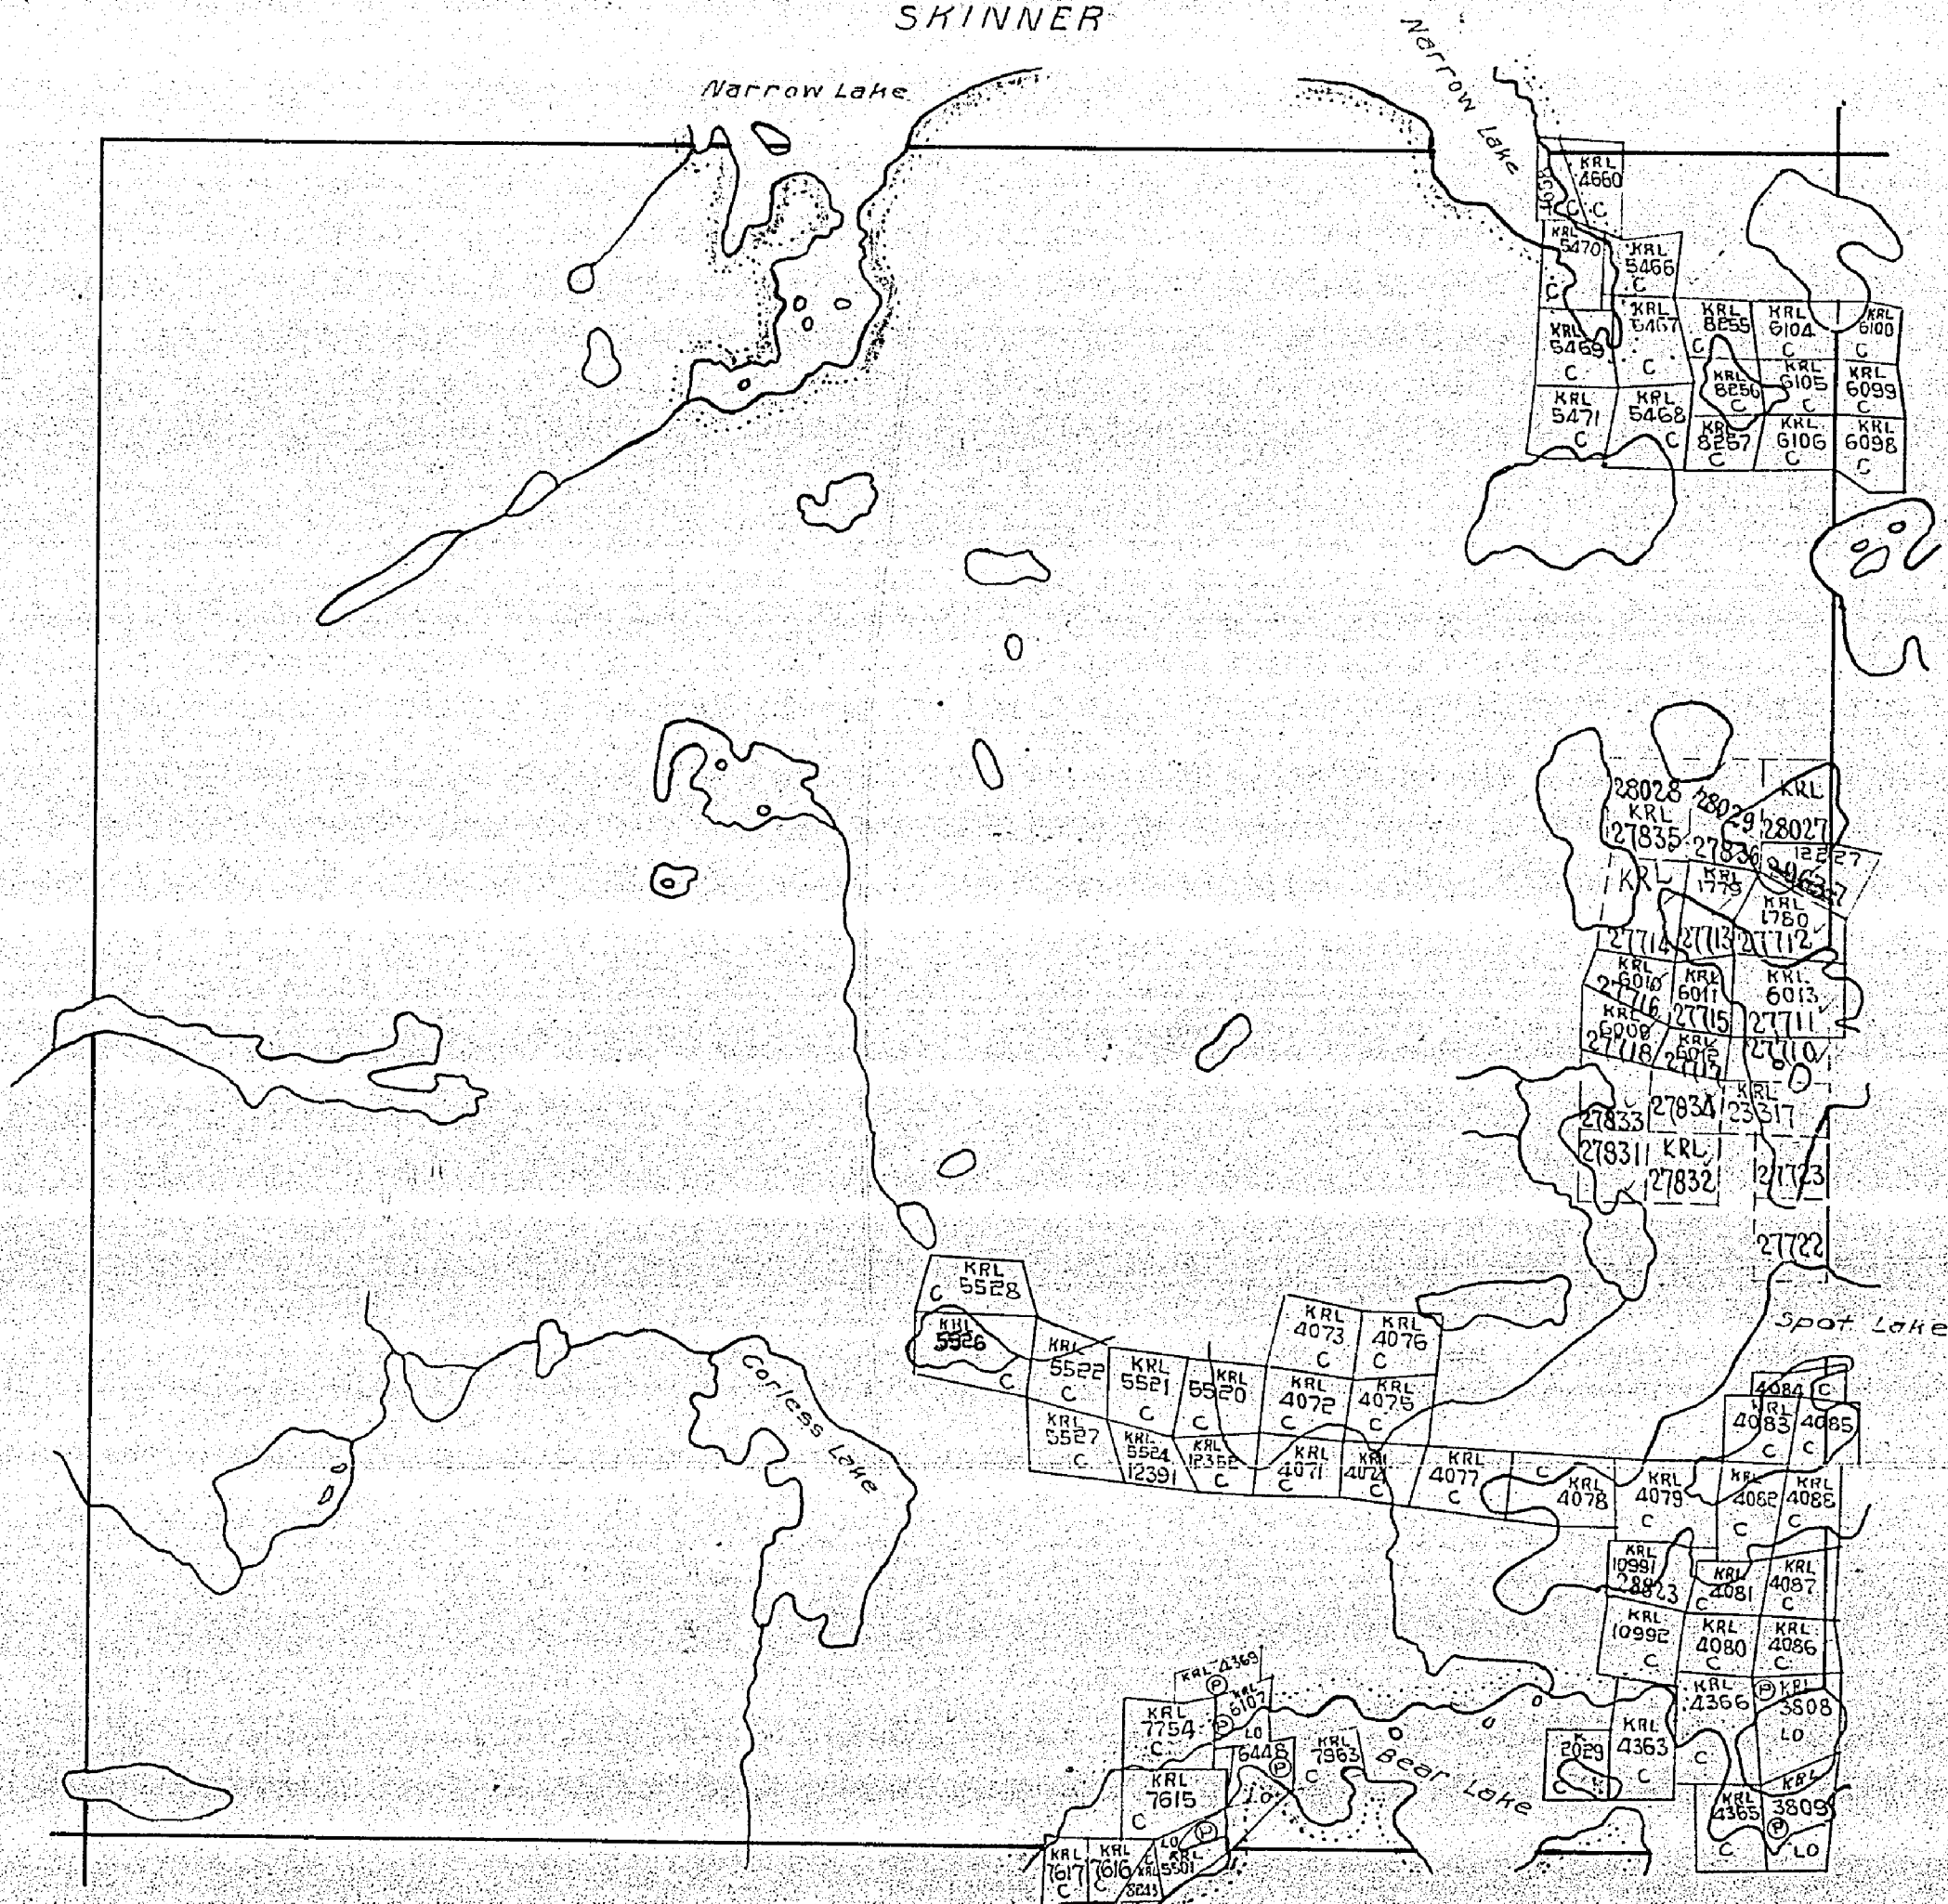

2177

Surface reservations 200' wide by Dept of L & F shown
hereon and 200' wide.

KNOTT

Skinner Twp. - M.2205

Area Maps: M.2472 and M.2690

THE TOWNSHIP
OF

CORLESS

DISTRICT OF
KENORA - PATRICIA PORTION

RED LAKE
MINING DIVISION

SCALE: 1-INCH = 40 CHAINS

LEGEND

PATENTED LAND
CROWN LAND SALE
LEASES
LOCATED LAND
LICENSE OF OCCUPATION
MINING RIGHTS ONLY
SURFACE RIGHTS ONLY
ROADS
IMPROVED ROADS
KING'S HIGHWAYS
RAILWAYS
POWER LINES
MARSH OR MUSKEG
MINES
CANCELLED


(P)
C.S.
(L)
Lo
L.C.
MR
SR

NOTES

400' Surface Rights Reservation around
all Lakes and Rivers.

PLAN NO. M-2154

DEPARTMENT OF MINES
- ONTARIO -

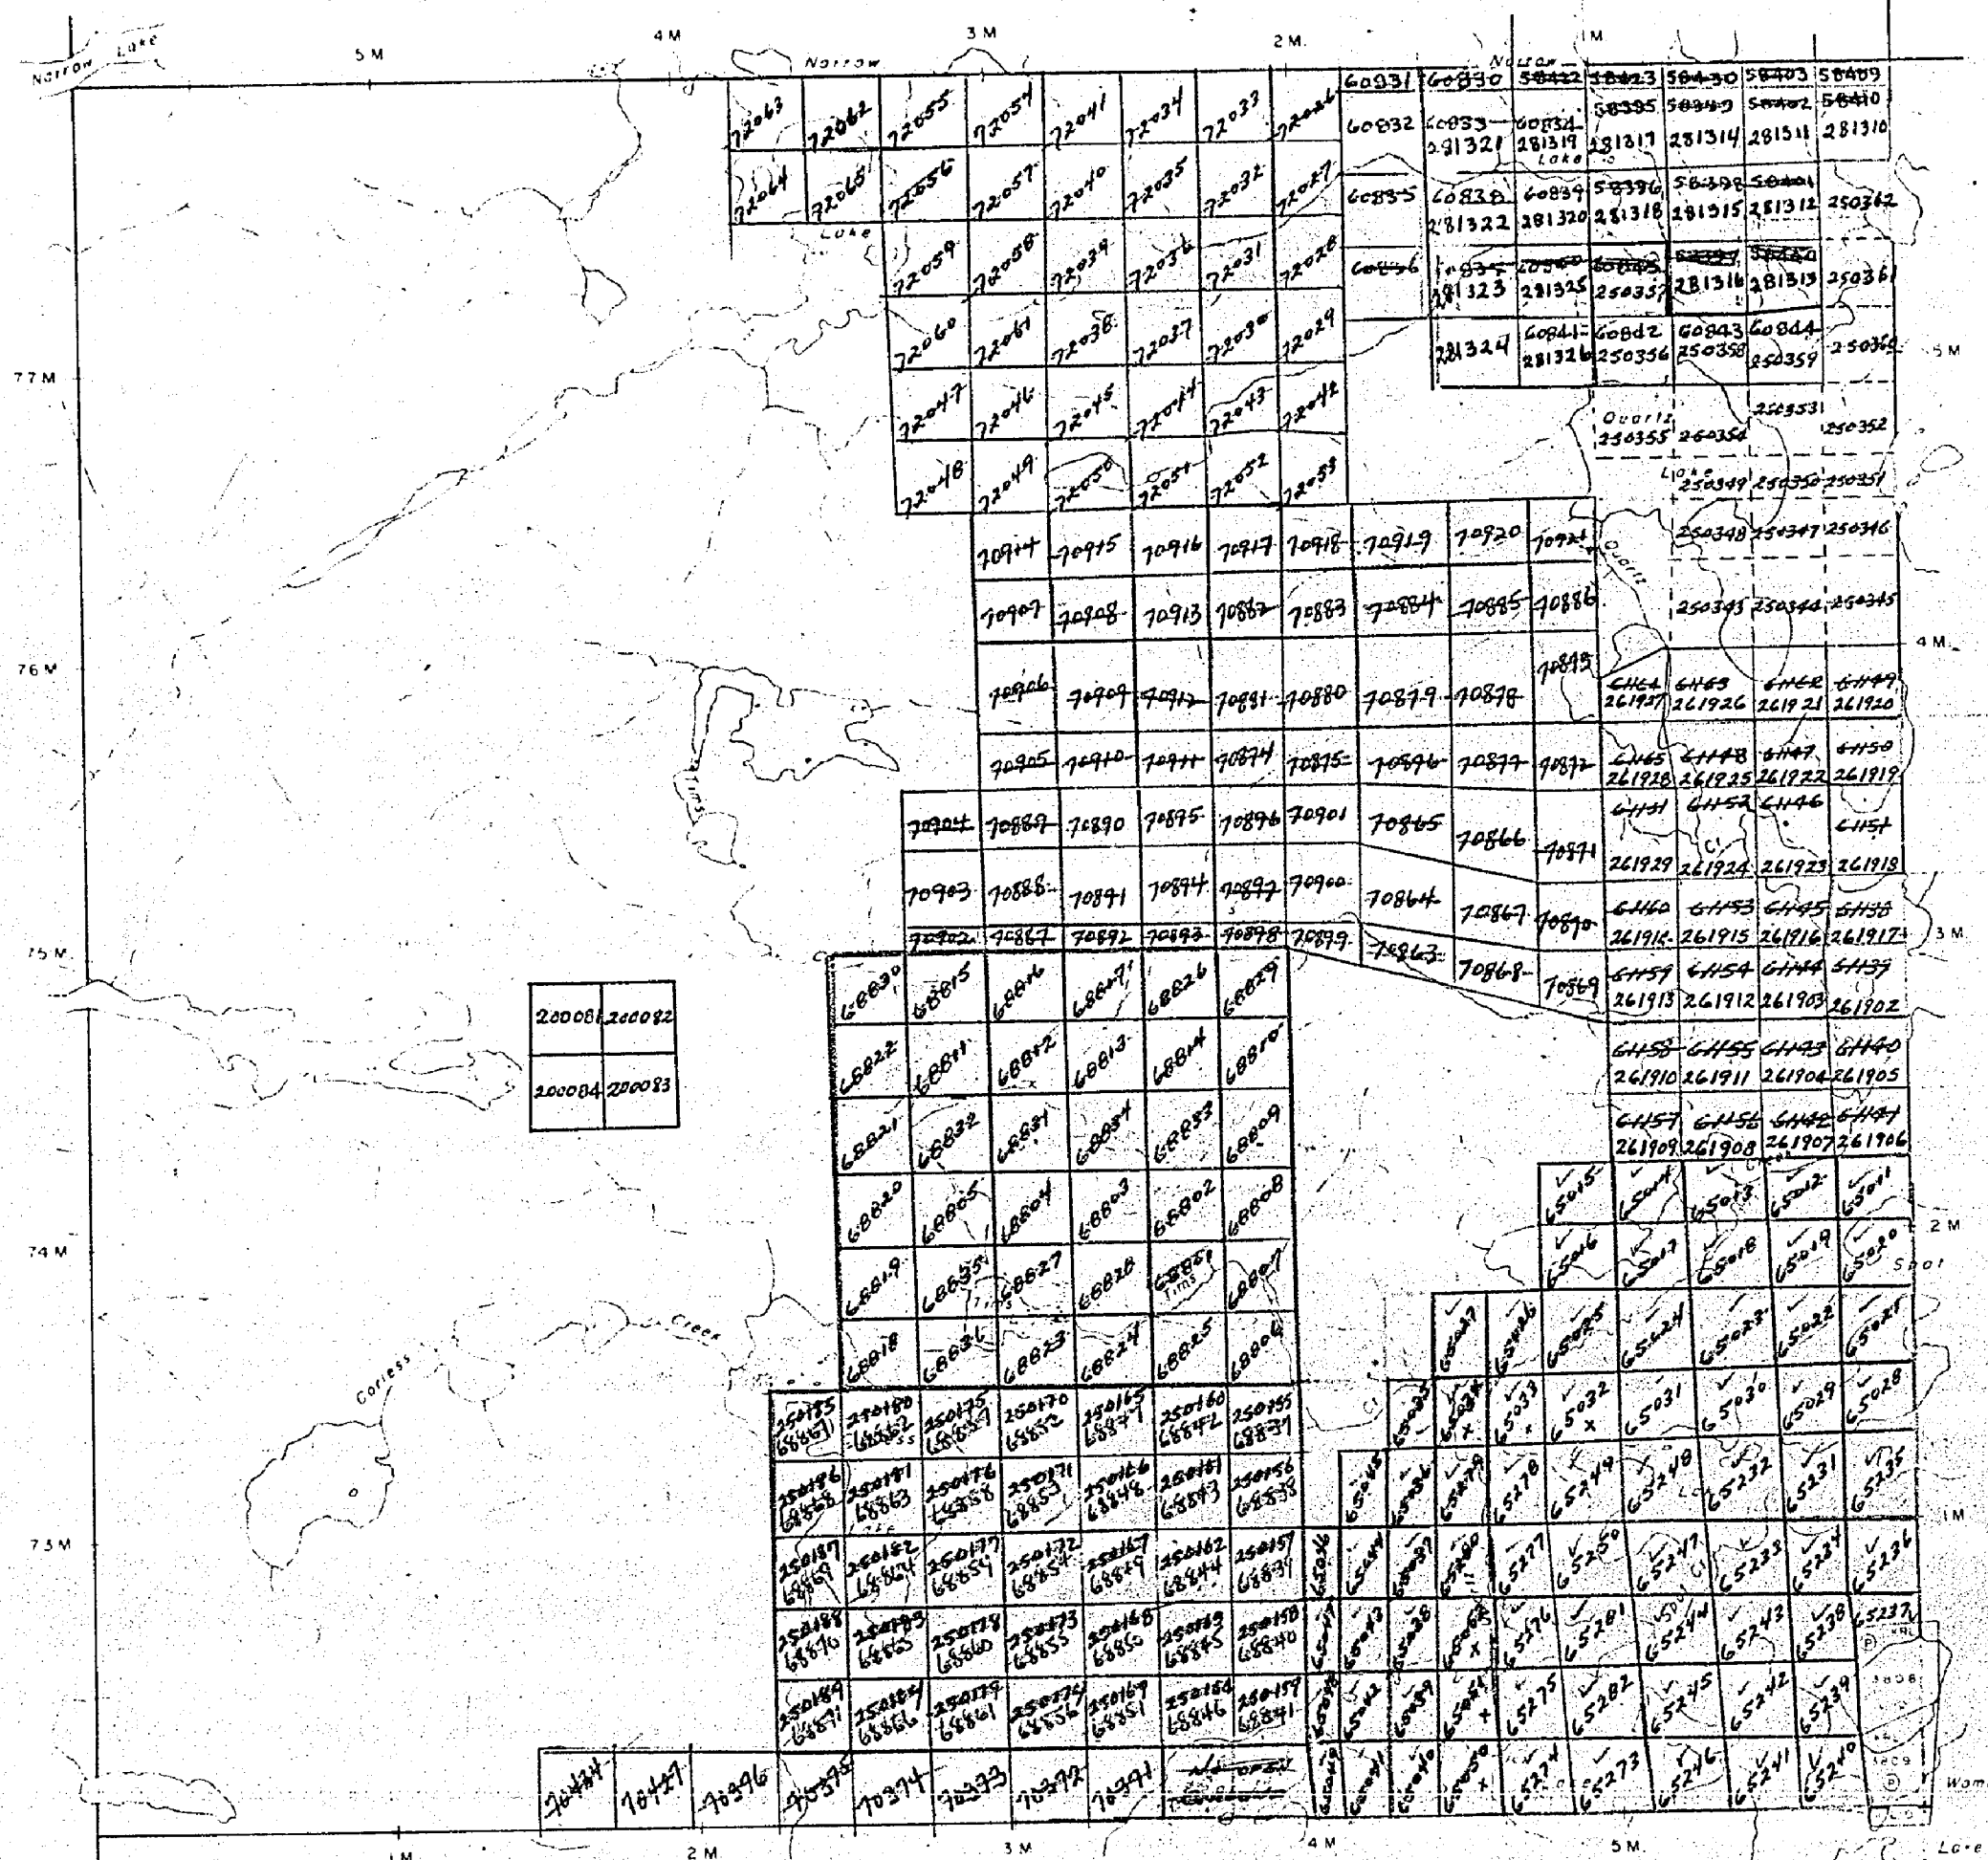

2154

Skinner Twp. - M.2205

THE TOWNSHIP
OF
CORLESS

DISTRICT OF
KENORA - PATRICIA PORTION

RED LAKE
MINING DIVISION


SCALE: 1-INCH 40 CHAINS

LEGEND

PATENTED LAND	Ⓟ
CROWN LAND SALE	C.S.
LEASES	Ⓛ
LOCATED LAND	Loc
LICENSE OF OCCUPATION	L.O.
MINING RIGHTS ONLY	M.R.O.
SURFACE RIGHTS ONLY	S.R.O.
ROADS	—
IMPROVED ROADS	—
KING'S HIGHWAYS	—
RAILWAYS	—
POWER LINES	—
MARSH OR MUSKEG	—
MINES	ⓧ
CANCELLED	C

NOTES

400' Surface Rights Reservation around
all Lakes and Rivers.

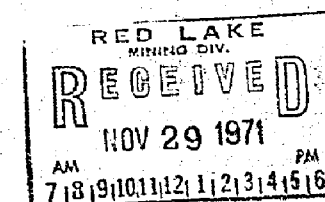


PLAN NO M-2154

ONTARIO
DEPARTMENT OF MINES
AND NORTHERN AFFAIRS


Area Maps: M.2472 and M.2690

Dent Twp. - M.2155

Knott Twp. - M.2472

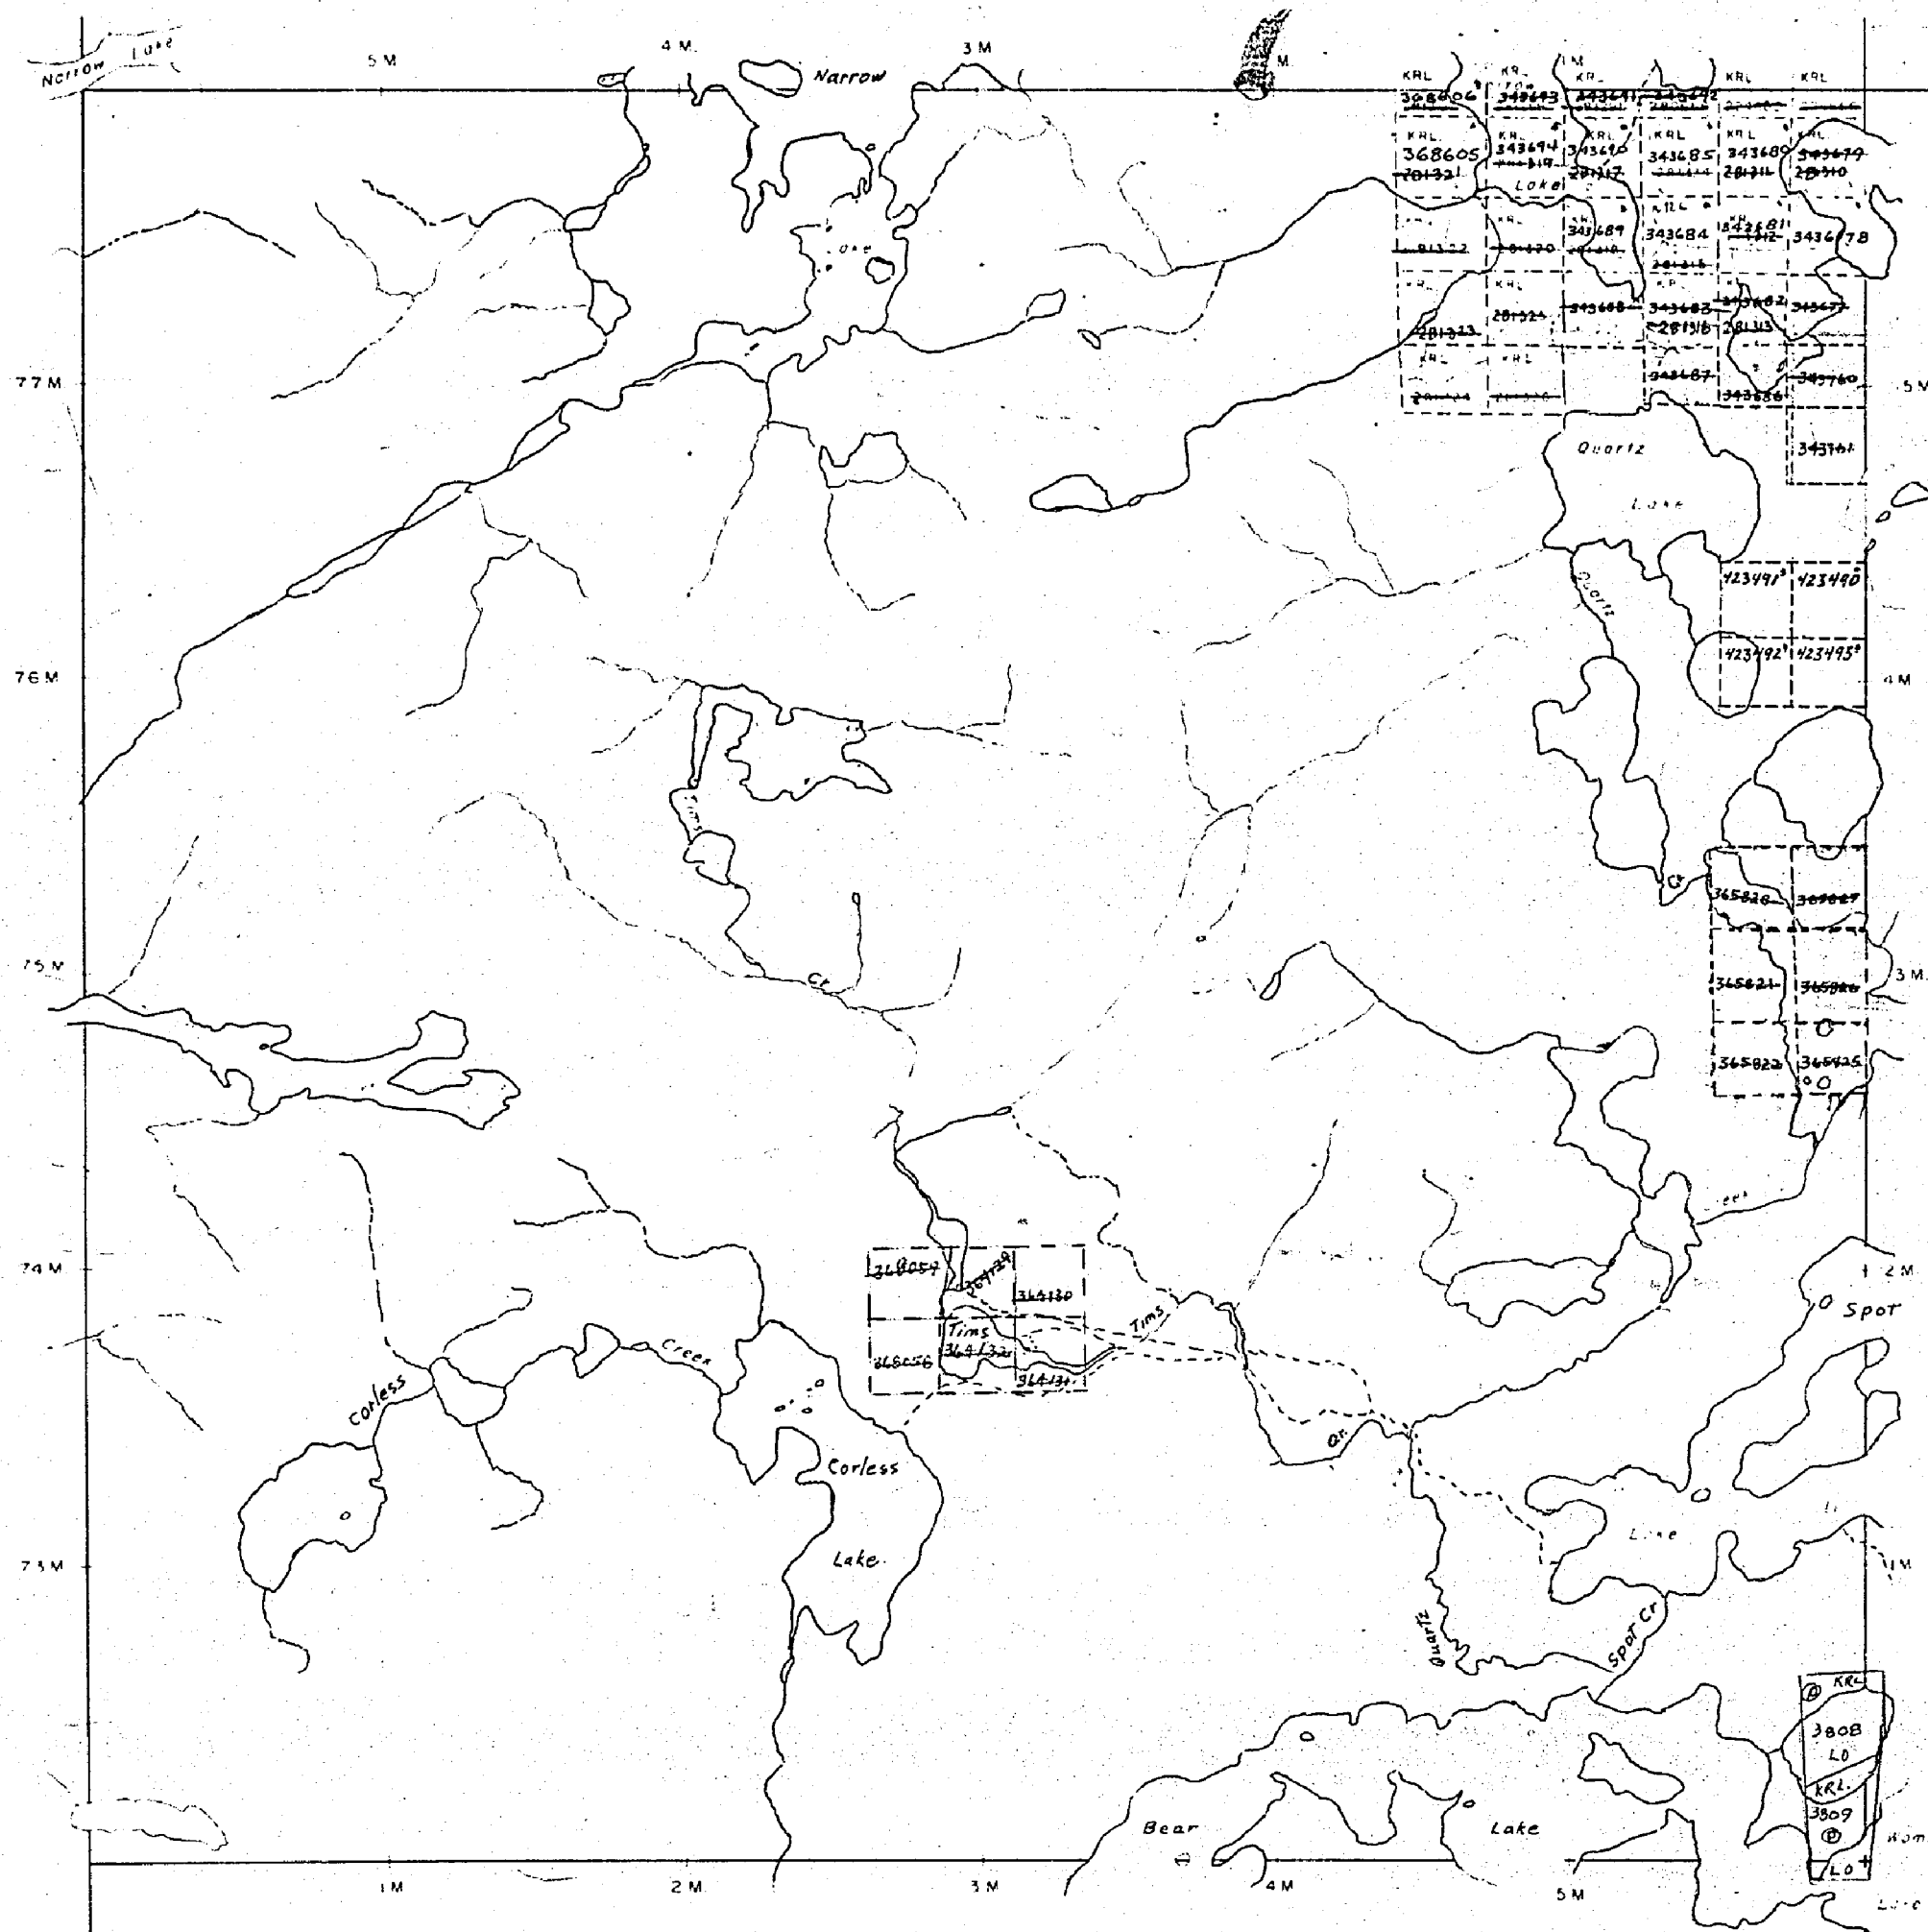

COPIES

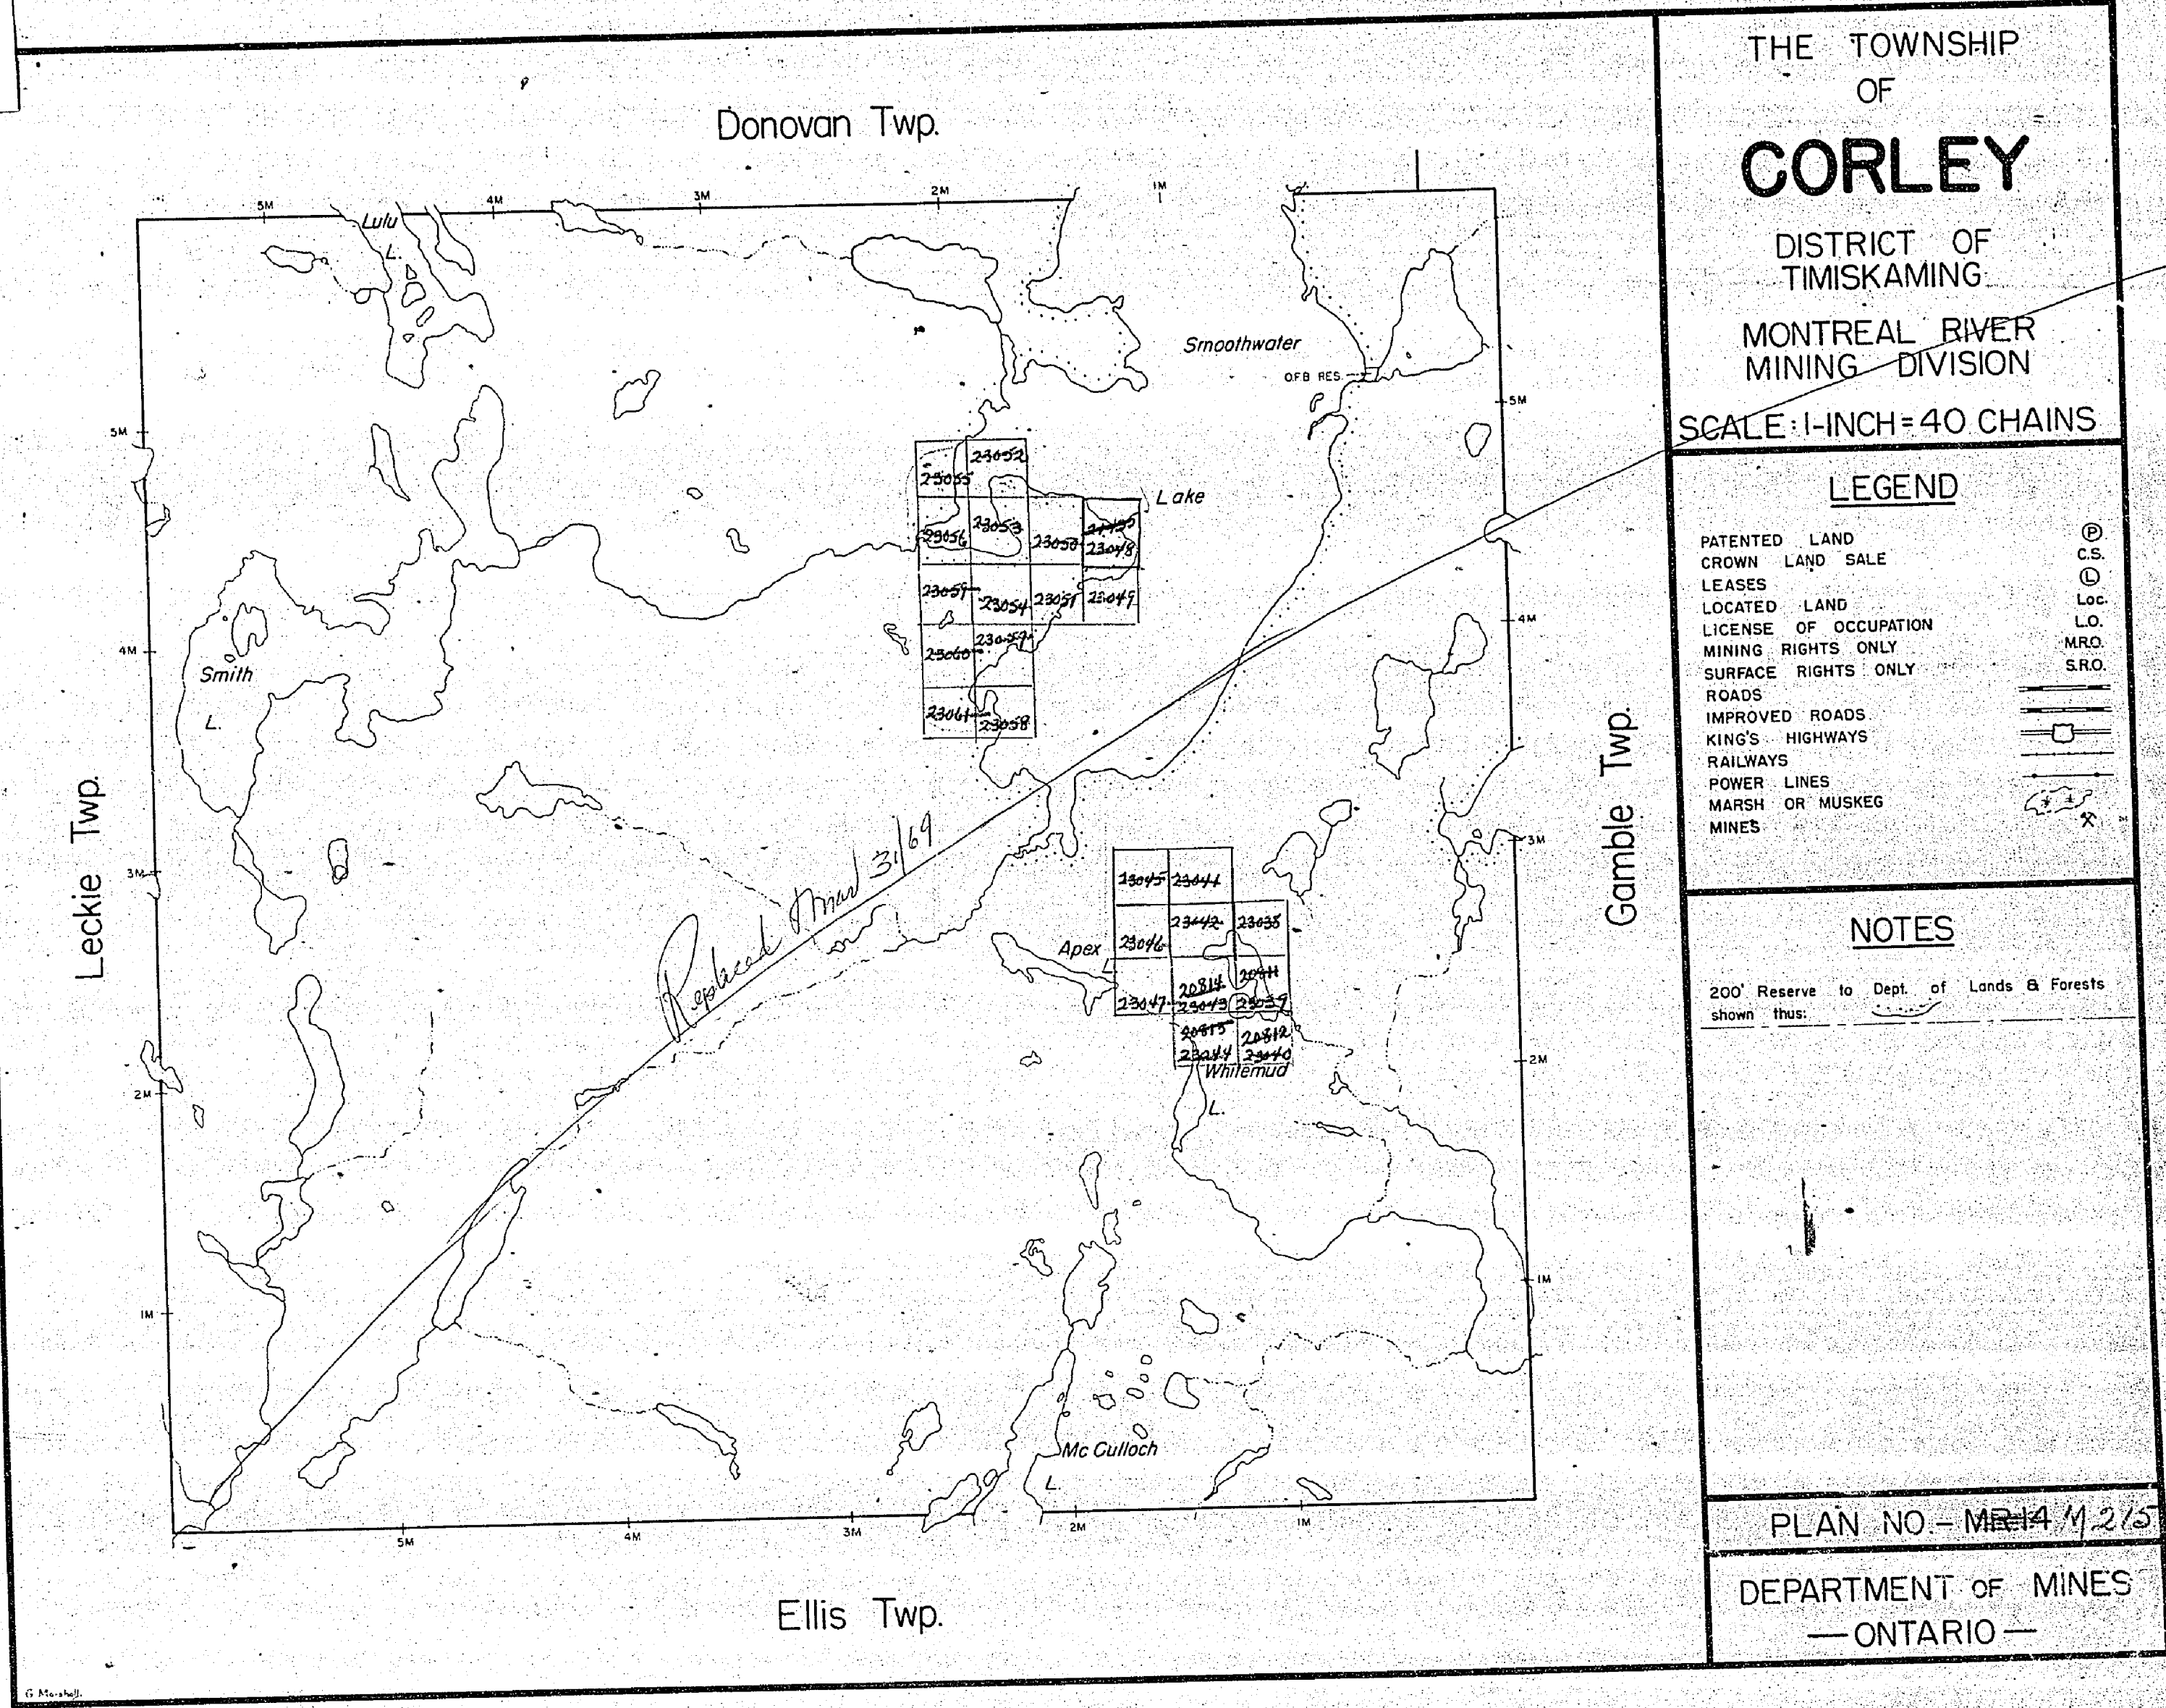

0-2500

ABRILAS DRAWN FROM D

M.S. - MINING RIGHTS ONLY
M.S. - SURFACE RIGHTS ONLY
M.S. - MINING AND SURFACE RIGHTS

Description Order No. Date Disposition File

SKINNER TOWNSHIP G 3758

NARROW LAKE TOWNSHIP G 1824

DEAR LAKE G 1809
TOWNSHIP

THE INFORMATION THAT
APPEARS ON THIS MAP
HAS BEEN COMPILED
FROM VARIOUS SOURCES,
AND ACCURACY IS NOT
GUARANTEED. THOSE
WISHING TO STAKE MIN-
ING CLAIMS SHOULD CON-
SULT WITH THE MINING
RECORDER, MINISTRY OF
NORTHERN DEVELOP-
MENT AND MINES, FOR AD-
DITIONAL INFORMATION
ON THE STATUS OF THE
LANDS SHOWN HEREON.

KNOTT TOWNSHIP G 1809

LE. 20
HIGHWAY AND ROUTE No
OTHER ROADS
TRAILS
SURVEYED LINES:
TOWNSHIPS, BASE LINES, ETC
LOTS, MINING CLAIMS, PARCELS, ETC
UNSURVEYED LINES
LOT LINES
PARCEL BOUNDARY
MINING CLAIMS ETC
RAILWAY AND RIGHT OF WAY
UTILITY LINES
NON PERENNIAL STREAM
FLOODING OR FLOODING RIGHTS
SUBDIVISION OR COMPOSITE PLAN
RESERVATIONS
ORIGINAL SHORELINE
MARSH OR MUSKEG
MINES
TRAVERSE MONUMENT

DISPOSITION OF CROWN LANDS

TYPE OF DOCUMENT	SYMBOL
PATENT, SURFACE & MINING RIGHTS	○
" SURFACE RIGHTS ONLY	○
" MINING RIGHTS ONLY	○
LEASE, SURFACE & MINING RIGHTS	○
" SURFACE RIGHTS ONLY	○
" MINING RIGHTS ONLY	○
LICENCE OF OCCUPATION	○
ORDER-IN-COUNCIL	○
RESERVATION	○
CANCELLED	○
SAND & GRAVEL	○

NOTE: MINING RIGHTS IN PARCELS PATENTED PRIOR TO 1915
1915 VESTED IN ORIGINAL PATENTEE BY THE PUBLIC
LANDS ACT, R.S.O. 1970, CHAP. 380, SEC. 63, SUBSEC. 1.

500 0 500 Metres
10 0 10 20 30 40 50 60 70 Chains
500 0 1000 2000 3000 4000 5000 Feet

SCALE 1:20 000

DATE OF ISSUE

AUG 26 1998

PROVINCIAL RECORDING
OFFICE - SUDBURY

TOWNSHIP
CORLESS
M.N.R. ADMINISTRATIVE DISTRICT
RED LAKE
MINING DIVISION
RED LAKE
LAND TITLES / REGISTRY DIVISION
KENORA/PATRICIA

Ministry of Natural Resources
Ministry of Northern Development and Mines

SEPTEMBER, 1998

0-3746

0-2500

DATE 0-3-86

AREAS DRAWN FROM DISPOSITION

M.H.S. - MINING RIGHTS ONLY
S.R.O. - SURFACE RIGHTS ONLY
M.+S. - MINING AND SURFACE RIGHTS


Description Order No. Date Disposition File

SKINNER TOWNSHIP G 3758

NARROW LAKE TOWNSHIP G 1824

LITTLE BEAR LAKE G 1809

THE INFORMATION THAT APPEARS ON THIS MAP HAS BEEN COMPILED FROM VARIOUS SOURCES, AND ACCURACY IS NOT GUARANTEED. THOSE WISHING TO STAKE MINING CLAIMS SHOULD CONSULT WITH THE MINING RECORDER, MINISTRY OF NORTHERN DEVELOPMENT AND MINES, FOR ADDITIONAL INFORMATION ON THE STATUS OF THE LANDS SHOWN HEREON.

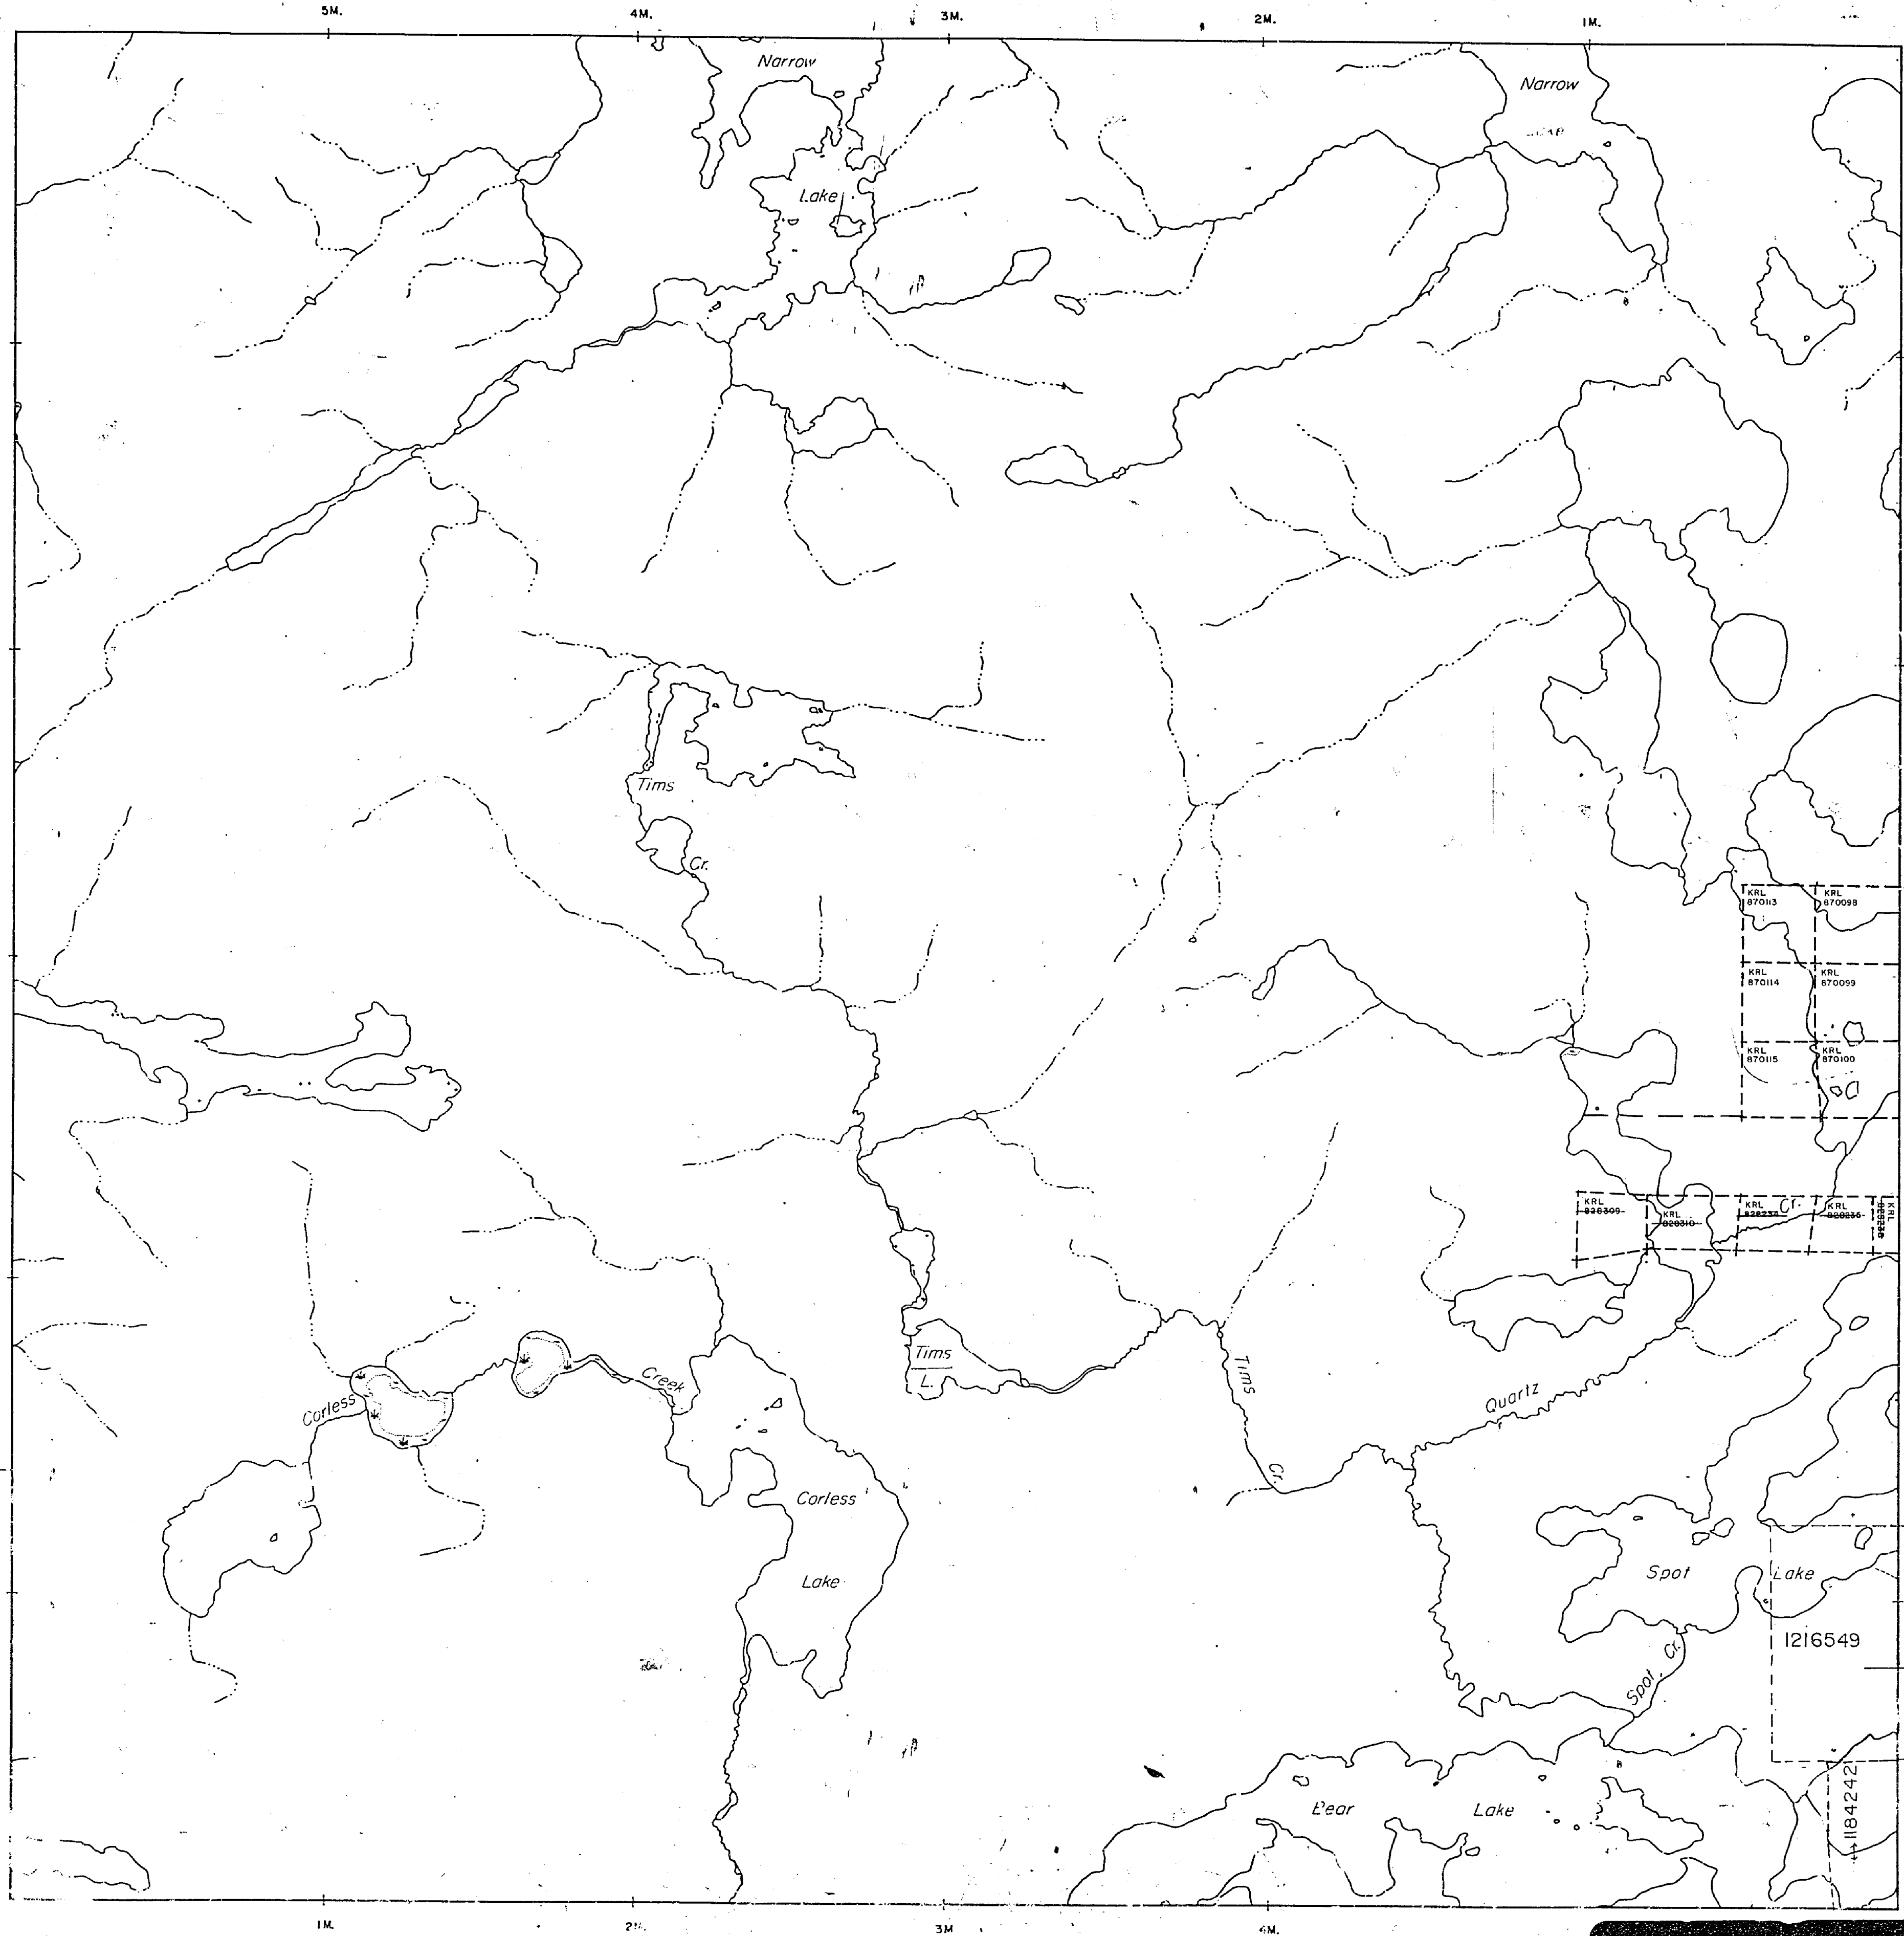

KNOTT TOWNSHIP G 1809


LE-EN

HIGHWAY AND ROUTE No.	
OTHER ROADS	
TRAILS	
SURVEYED LINES:	
TOWNSHIPS, BASE LINES, ETC.	
LOTS, MINING CLAIMS, PARCELS, ETC.	
UNSURVEYED LINES:	
LOT LINES	
PARCEL BOUNDARY	
MINING CLAIMS ETC.	
RAILWAY AND RIGHT OF WAY	
UTILITY LINES	
NON PERENNIAL STREAM	
FLOODING OR FLOODING HEIGHTS	
SUBDIVISION OR COMPOSITE PLAN	
RESERVATIONS	
ORIGINAL SHORELINE	
MARSH OR MUSKEG	
MINES	
TRAVERSE MONUMENT	

DISPOSITION OF CROWN LANDS

TYPE OF DOCUMENT	SYMBOL
PATENT, SURFACE & MINING RIGHTS	●
" SURFACE RIGHTS ONLY	○
" MINING RIGHTS ONLY	○
LEASE, SURFACE & MINING RIGHTS	○
" SURFACE RIGHTS ONLY	○
" MINING RIGHTS ONLY	○
LICENCE OF OCCUPATION	○
ORDER-IN-COUNCIL	OC
RESERVATION	○
CANCELLED	○
SAND & GRAVEL	○

NOTE: MINING RIGHTS IN PARCELS PATENTED PRIOR TO MAY 6, 1912, VESTED IN ORIGINAL PATENTEE BY THE PUBLIC LANDS ACT, R.S.O. 1970, CHAP. 380, SEC. 63, SUBSEC. 1.

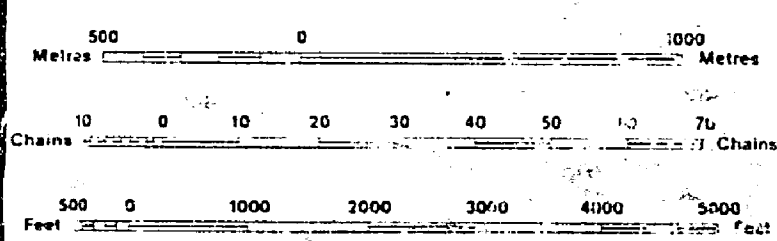

SCALE 1:20 000

DENT TOWNSHIP G 3737

TOWNSHIP
CORLESS
M.N.R. ADMINISTRATIVE DISTRICT
RED LAKE
MINING DIVISION
RED LAKE
LAND TITLES / REGISTRY DIVISION
KENORA/PATRICIA


Ministry of Natural Resources
Ministry of Northern Development and Mines
Ontario

SEPTEMBER, 1986
G-3746

2154

Skinner Twp. - M.2205

Area Maps: M.2472 and M.2690

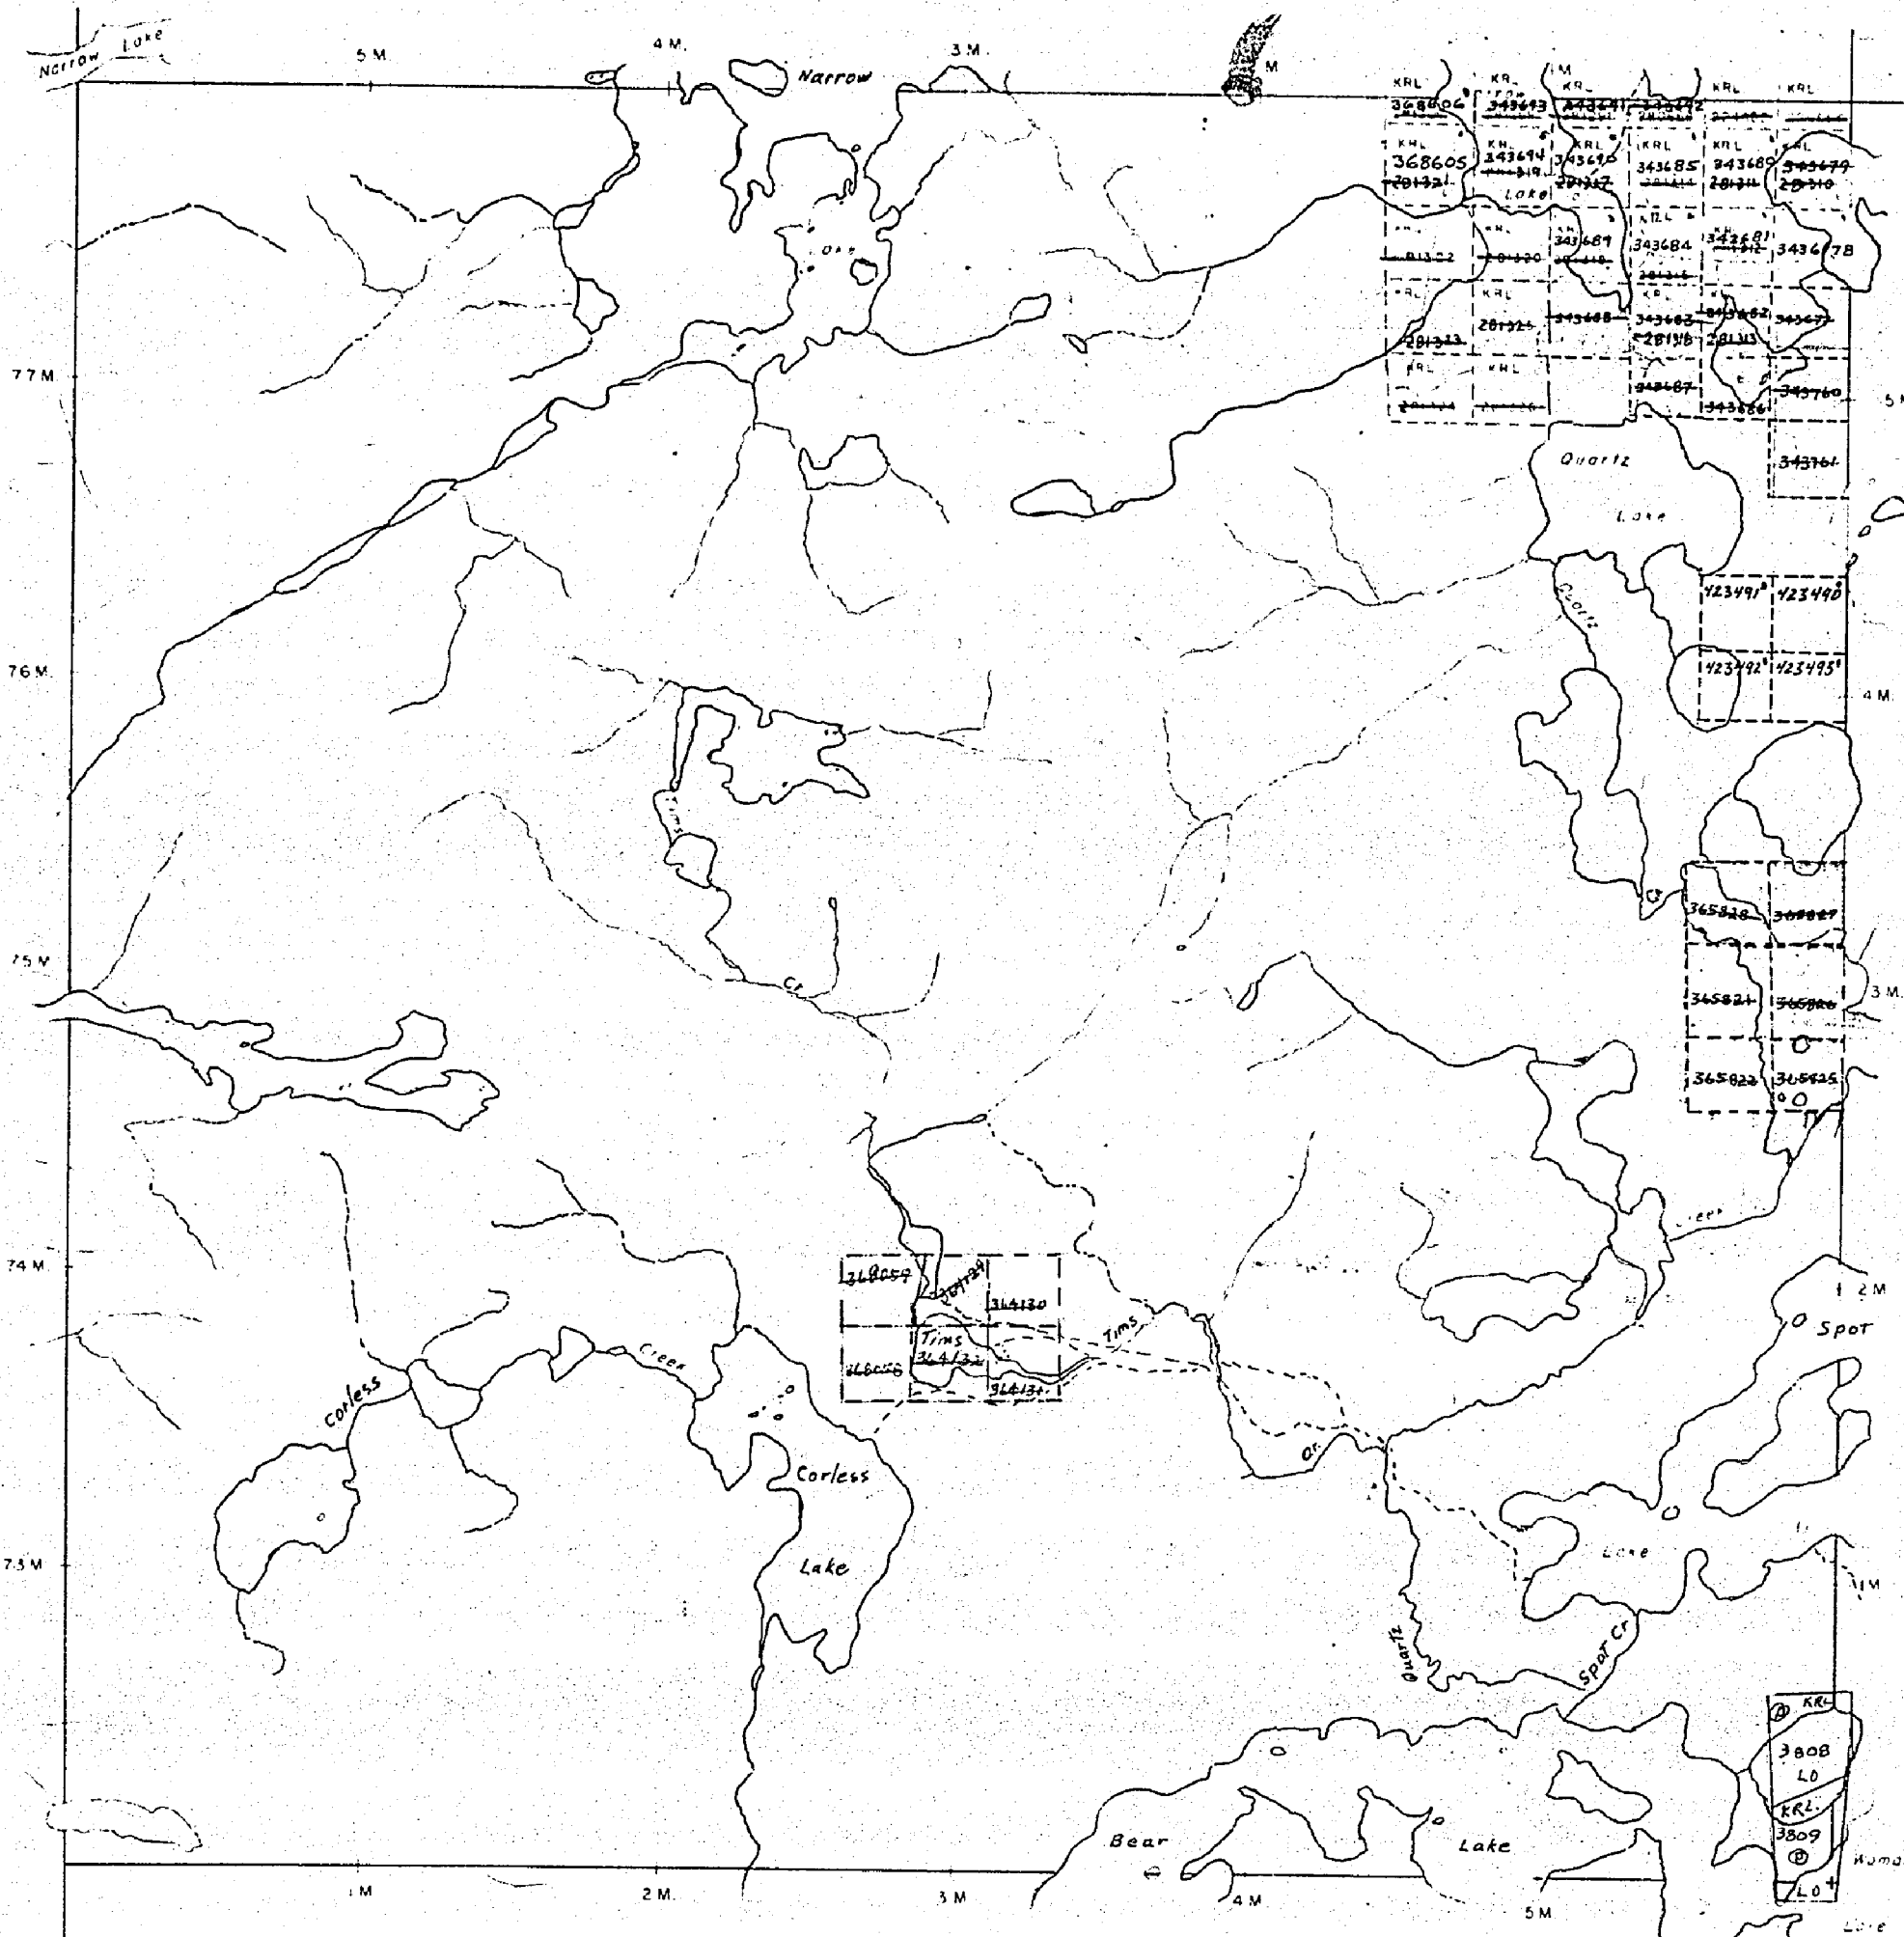

Knott Twp. - M.2472

THE TOWNSHIP OF

CORLESS

DISTRICT OF
KENORA - PATRICIA PORTION

RED LAKE
MINING DIVISION


SCALE: 1-INCH 40 CHAINS

LEGEND

PATENTED LAND	Ⓢ
CROWN LAND SALE	C.S.
LEASES	Ⓛ
LOCATED LAND	Loc
LICENSE OF OCCUPATION	L.O.
MINING RIGHTS ONLY	M.R.O.
SURFACE RIGHTS ONLY	S.R.O.
ROADS	—
IMPROVED ROADS	—
KING'S HIGHWAYS	—
RAILWAYS	—
POWER LINES	—
MARSH OR MUSKEG	—
MINES	ⓧ
CANCELLED	C

NOTES

400' Surface Rights Reservation around
all Lakes and Rivers.

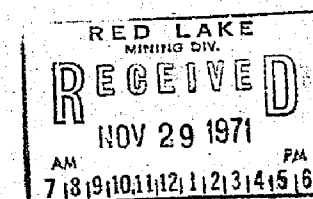


PLAN NO M-2154

ONTARIO
DEPARTMENT OF MINES
AND NORTHERN AFFAIRS

2154

Skinner Twp. - M.2205

Area Maps: M.2472 and M.2690

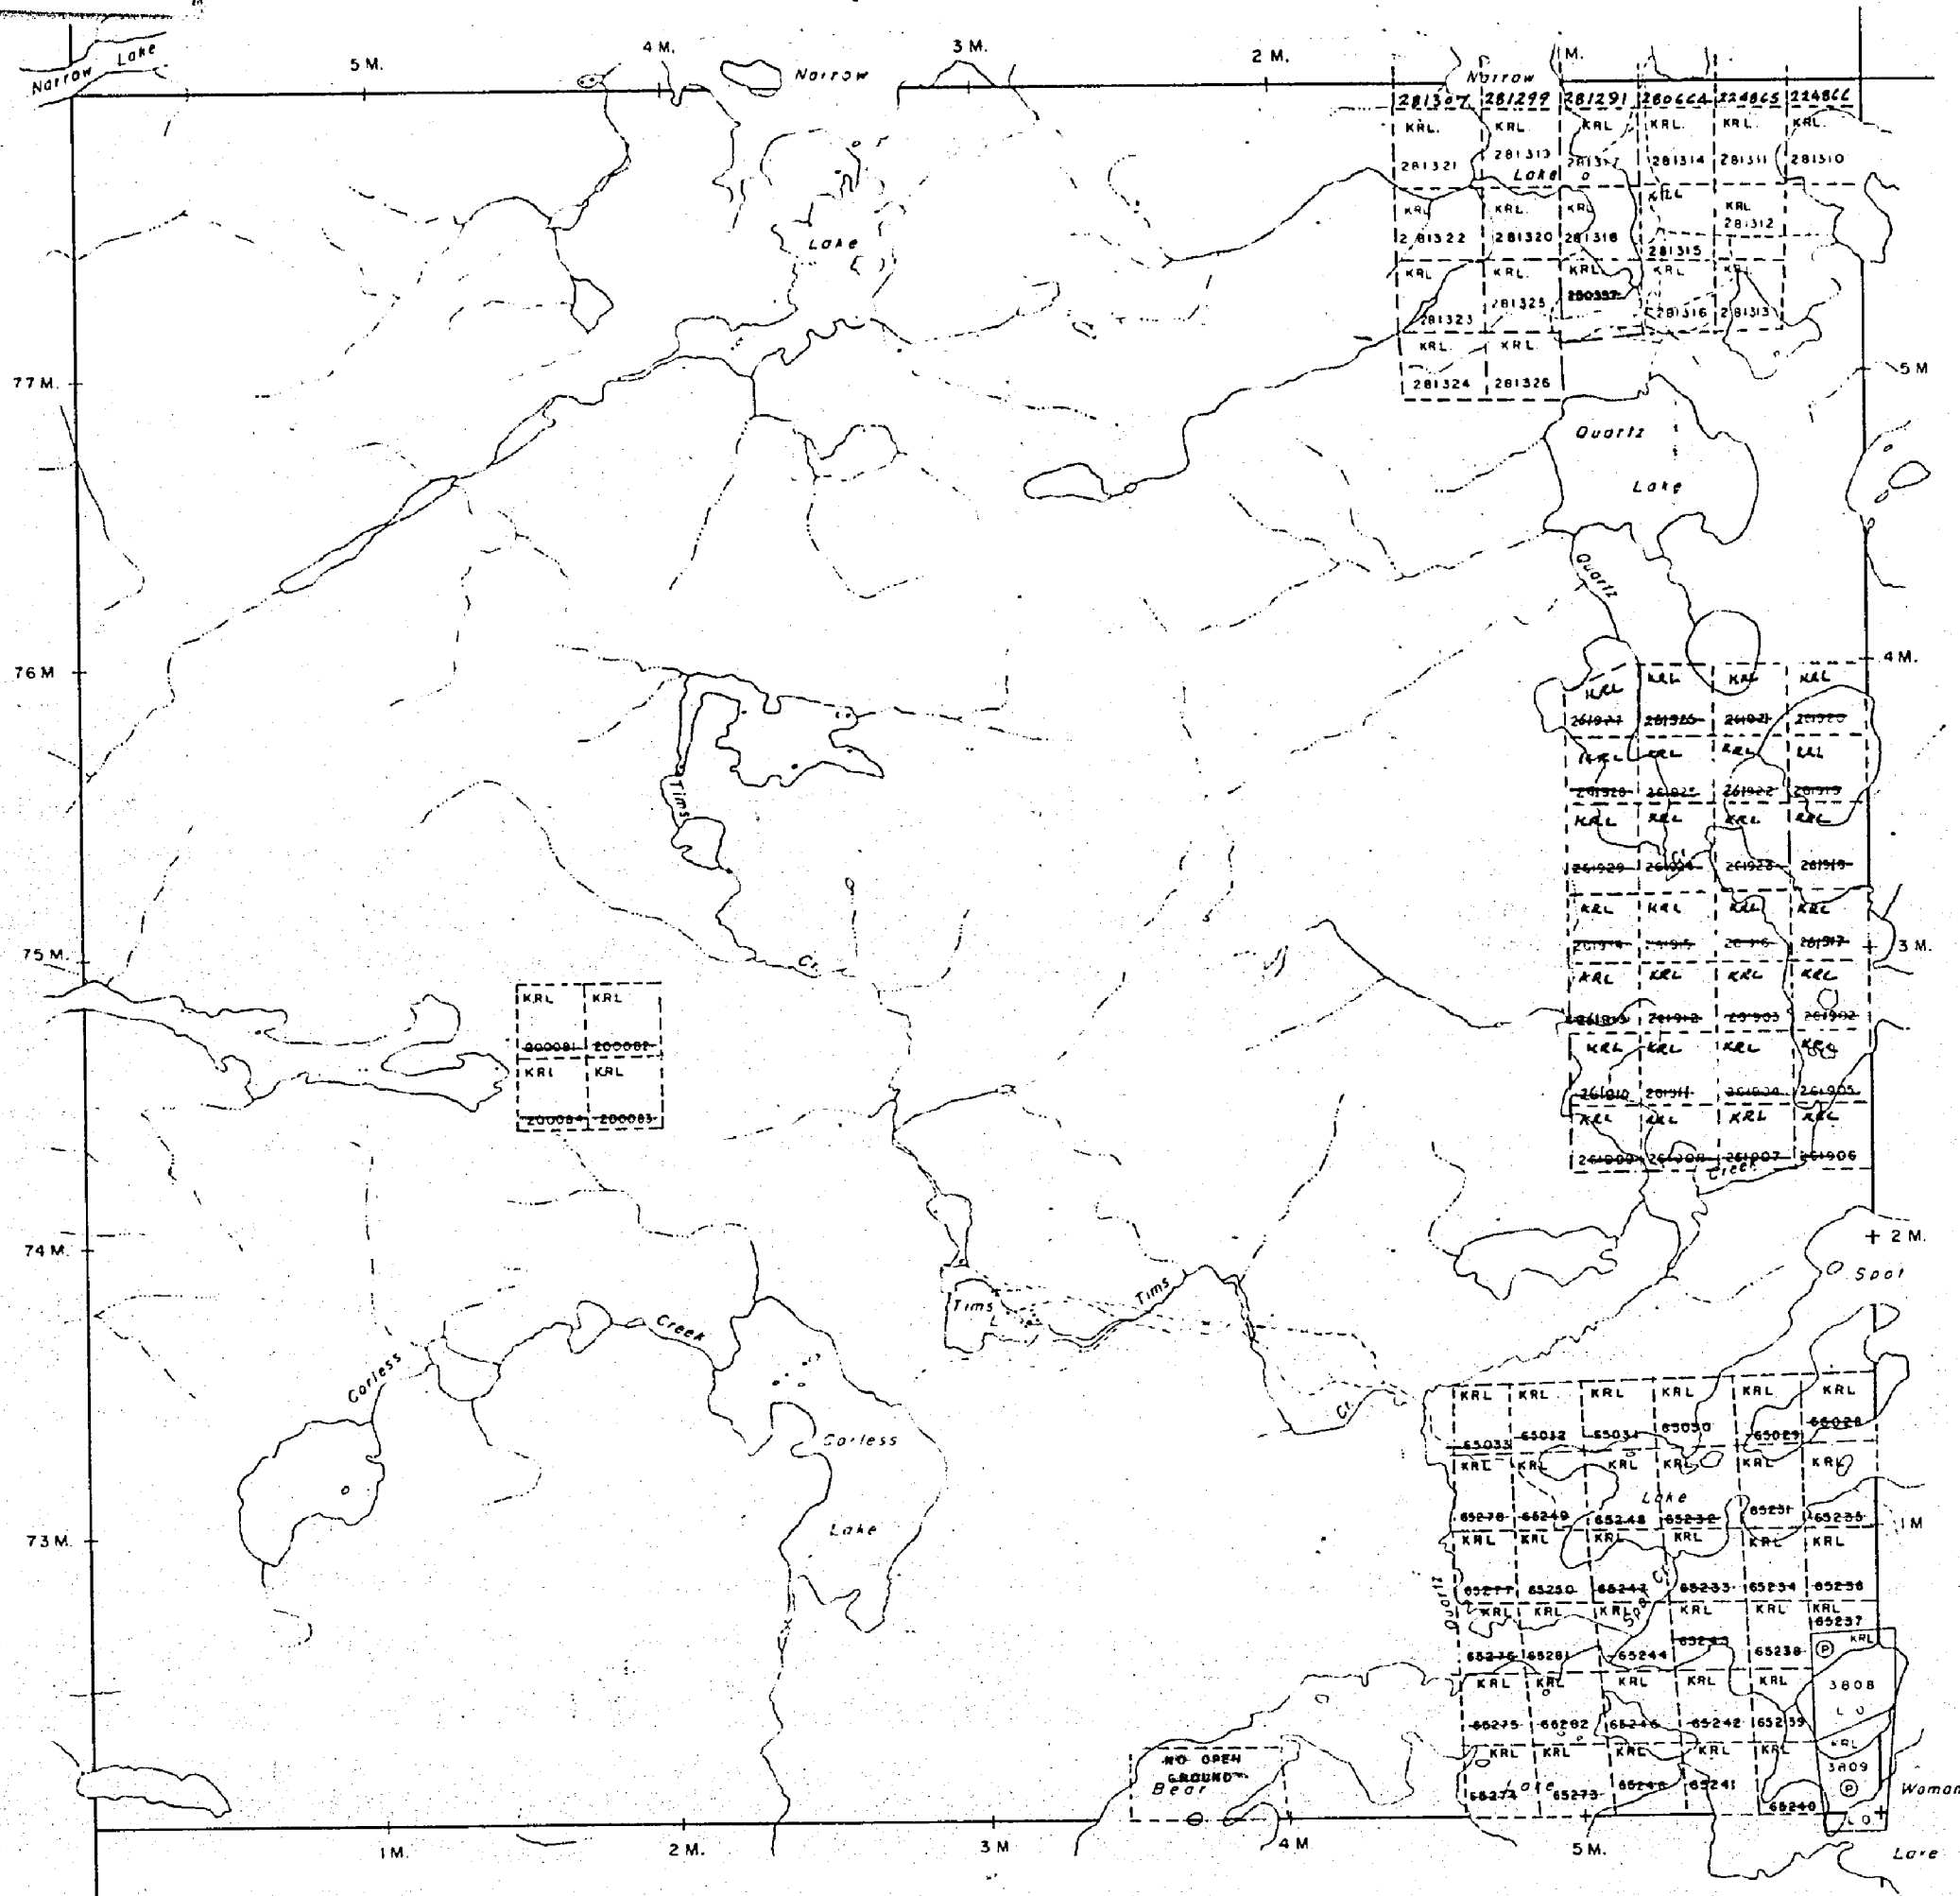

Knott Twp. - M.2472

THE TOWNSHIP OF
OF

CORLESS

DISTRICT OF
KENORA - PATRICIA PORTION

RED LAKE
MINING DIVISION


SCALE: 1-INCH 40 CHAINS

LEGEND

PATENTED LAND	Ⓢ
CROWN LAND SALE	C.S.
LEASES	Ⓢ
LOCATED LAND	Loc.
LICENSE OF OCCUPATION	L.O.
MINING RIGHTS ONLY	M.R.O.
SURFACE RIGHTS ONLY	S.R.O.
ROADS	—
IMPROVED ROADS	—
KING'S HIGHWAYS	—
RAILWAYS	—
POWER LINES	—
MARSH OR MUSKEG	—
MINES	Ⓢ
CANCELLED	C

NOTES

400' Surface Rights Reservation around
all Lakes and Rivers.

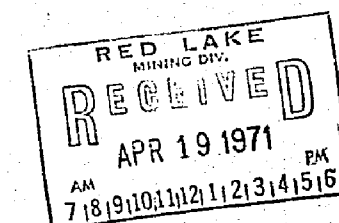

PLAN NO. M-2154

ONTARIO
DEPARTMENT OF MINES
AND NORTHERN AFFAIRS

Area Maps: M.2472 and M.2690

THE TOWNSHIP
OF
CORLESS
DISTRICT OF
KENORA - PATRICIA PORTION

SCALE: 1-INCH 40 CHAINS

PATENTED LAND
CROWN LAND SALE
LEASES
LOCATED LAND
LICENSE OF OCCUPATION
MINING RIGHTS ONLY
SURFACE RIGHTS ONLY


(P)
 C.S.
 (L)
 Loc.
 L.O.
 M.R.O.
 S.R.O.

ROADS
IMPROVED ROADS
KING'S HIGHWAYS
RAILWAYS
POWER LINES
MARSH OR MUSKE
MINES
CANCELLED

400' Surface Rights Reservation around
all Lakes and Rivers.

PLAN NO. M-2154

DEPARTMENT OF MINES
- ONTARIO -

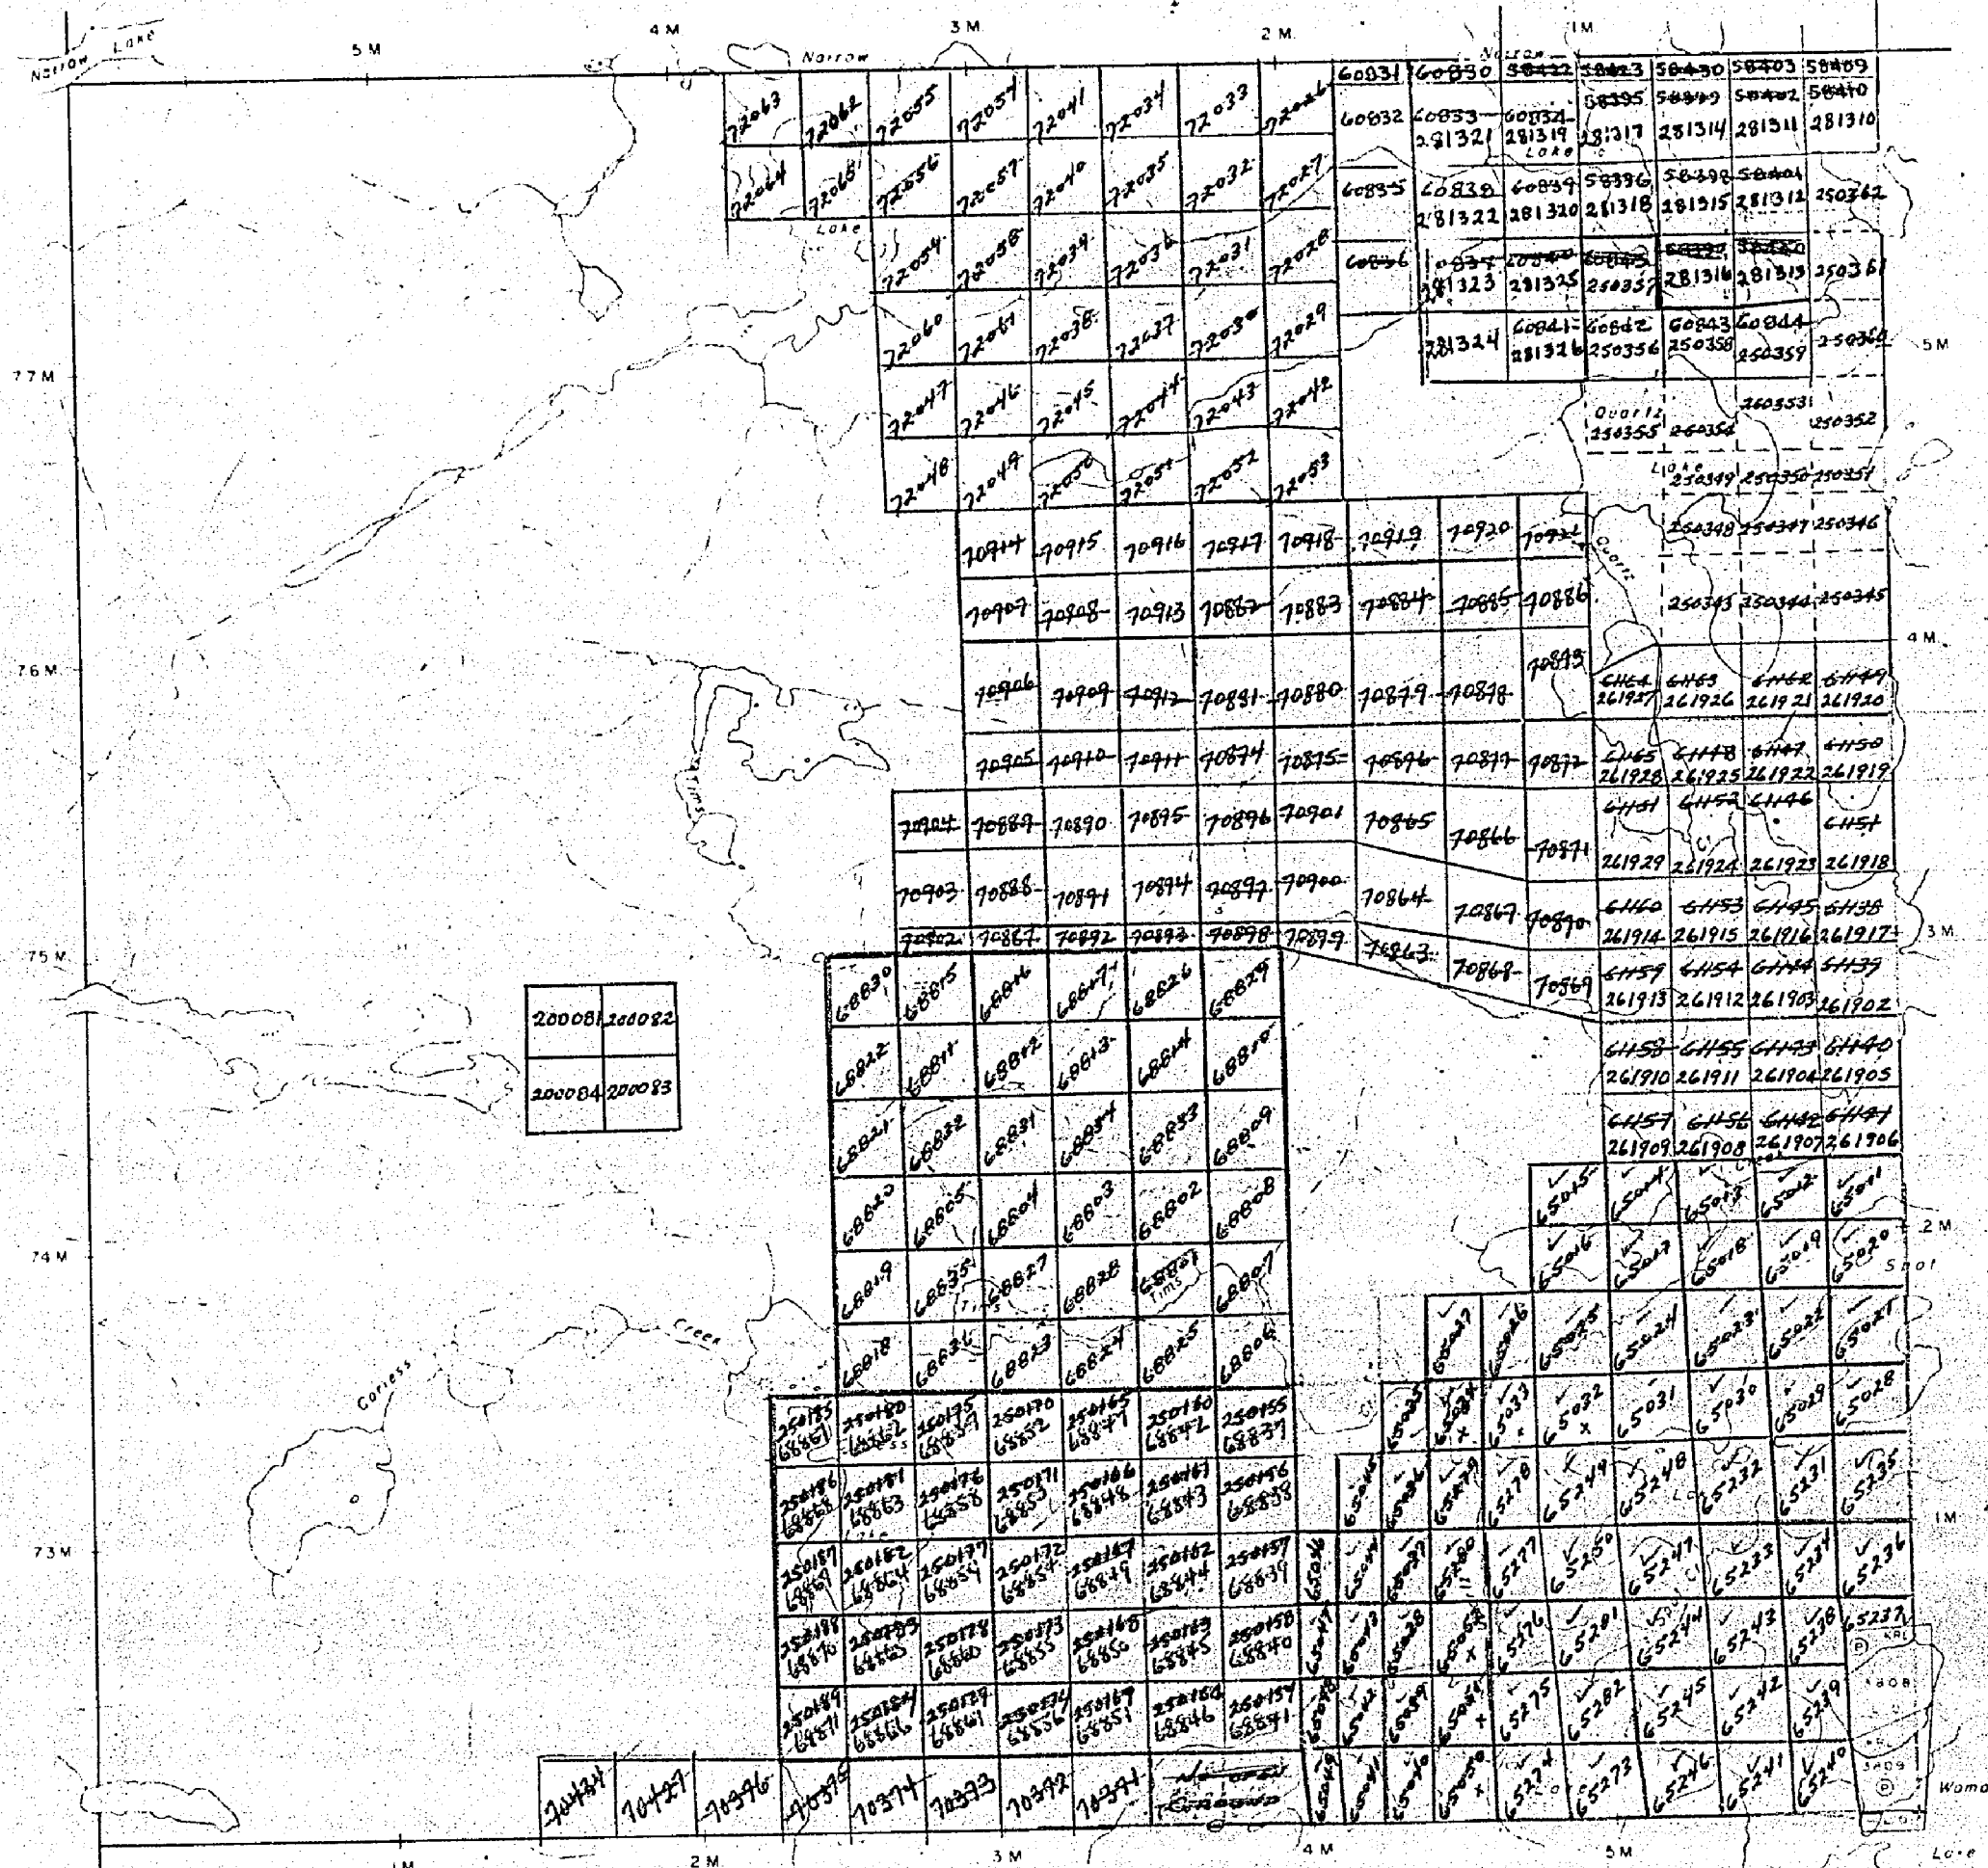

Dent Twp. - M. 2155

Knott Twp. - M.2472

2154

CORLESS

RED LAKE MINING DIVISION


Scale 40 Chains = 1 inch

M.2154

SKINNER

Narrow Lake

Narrow Lake

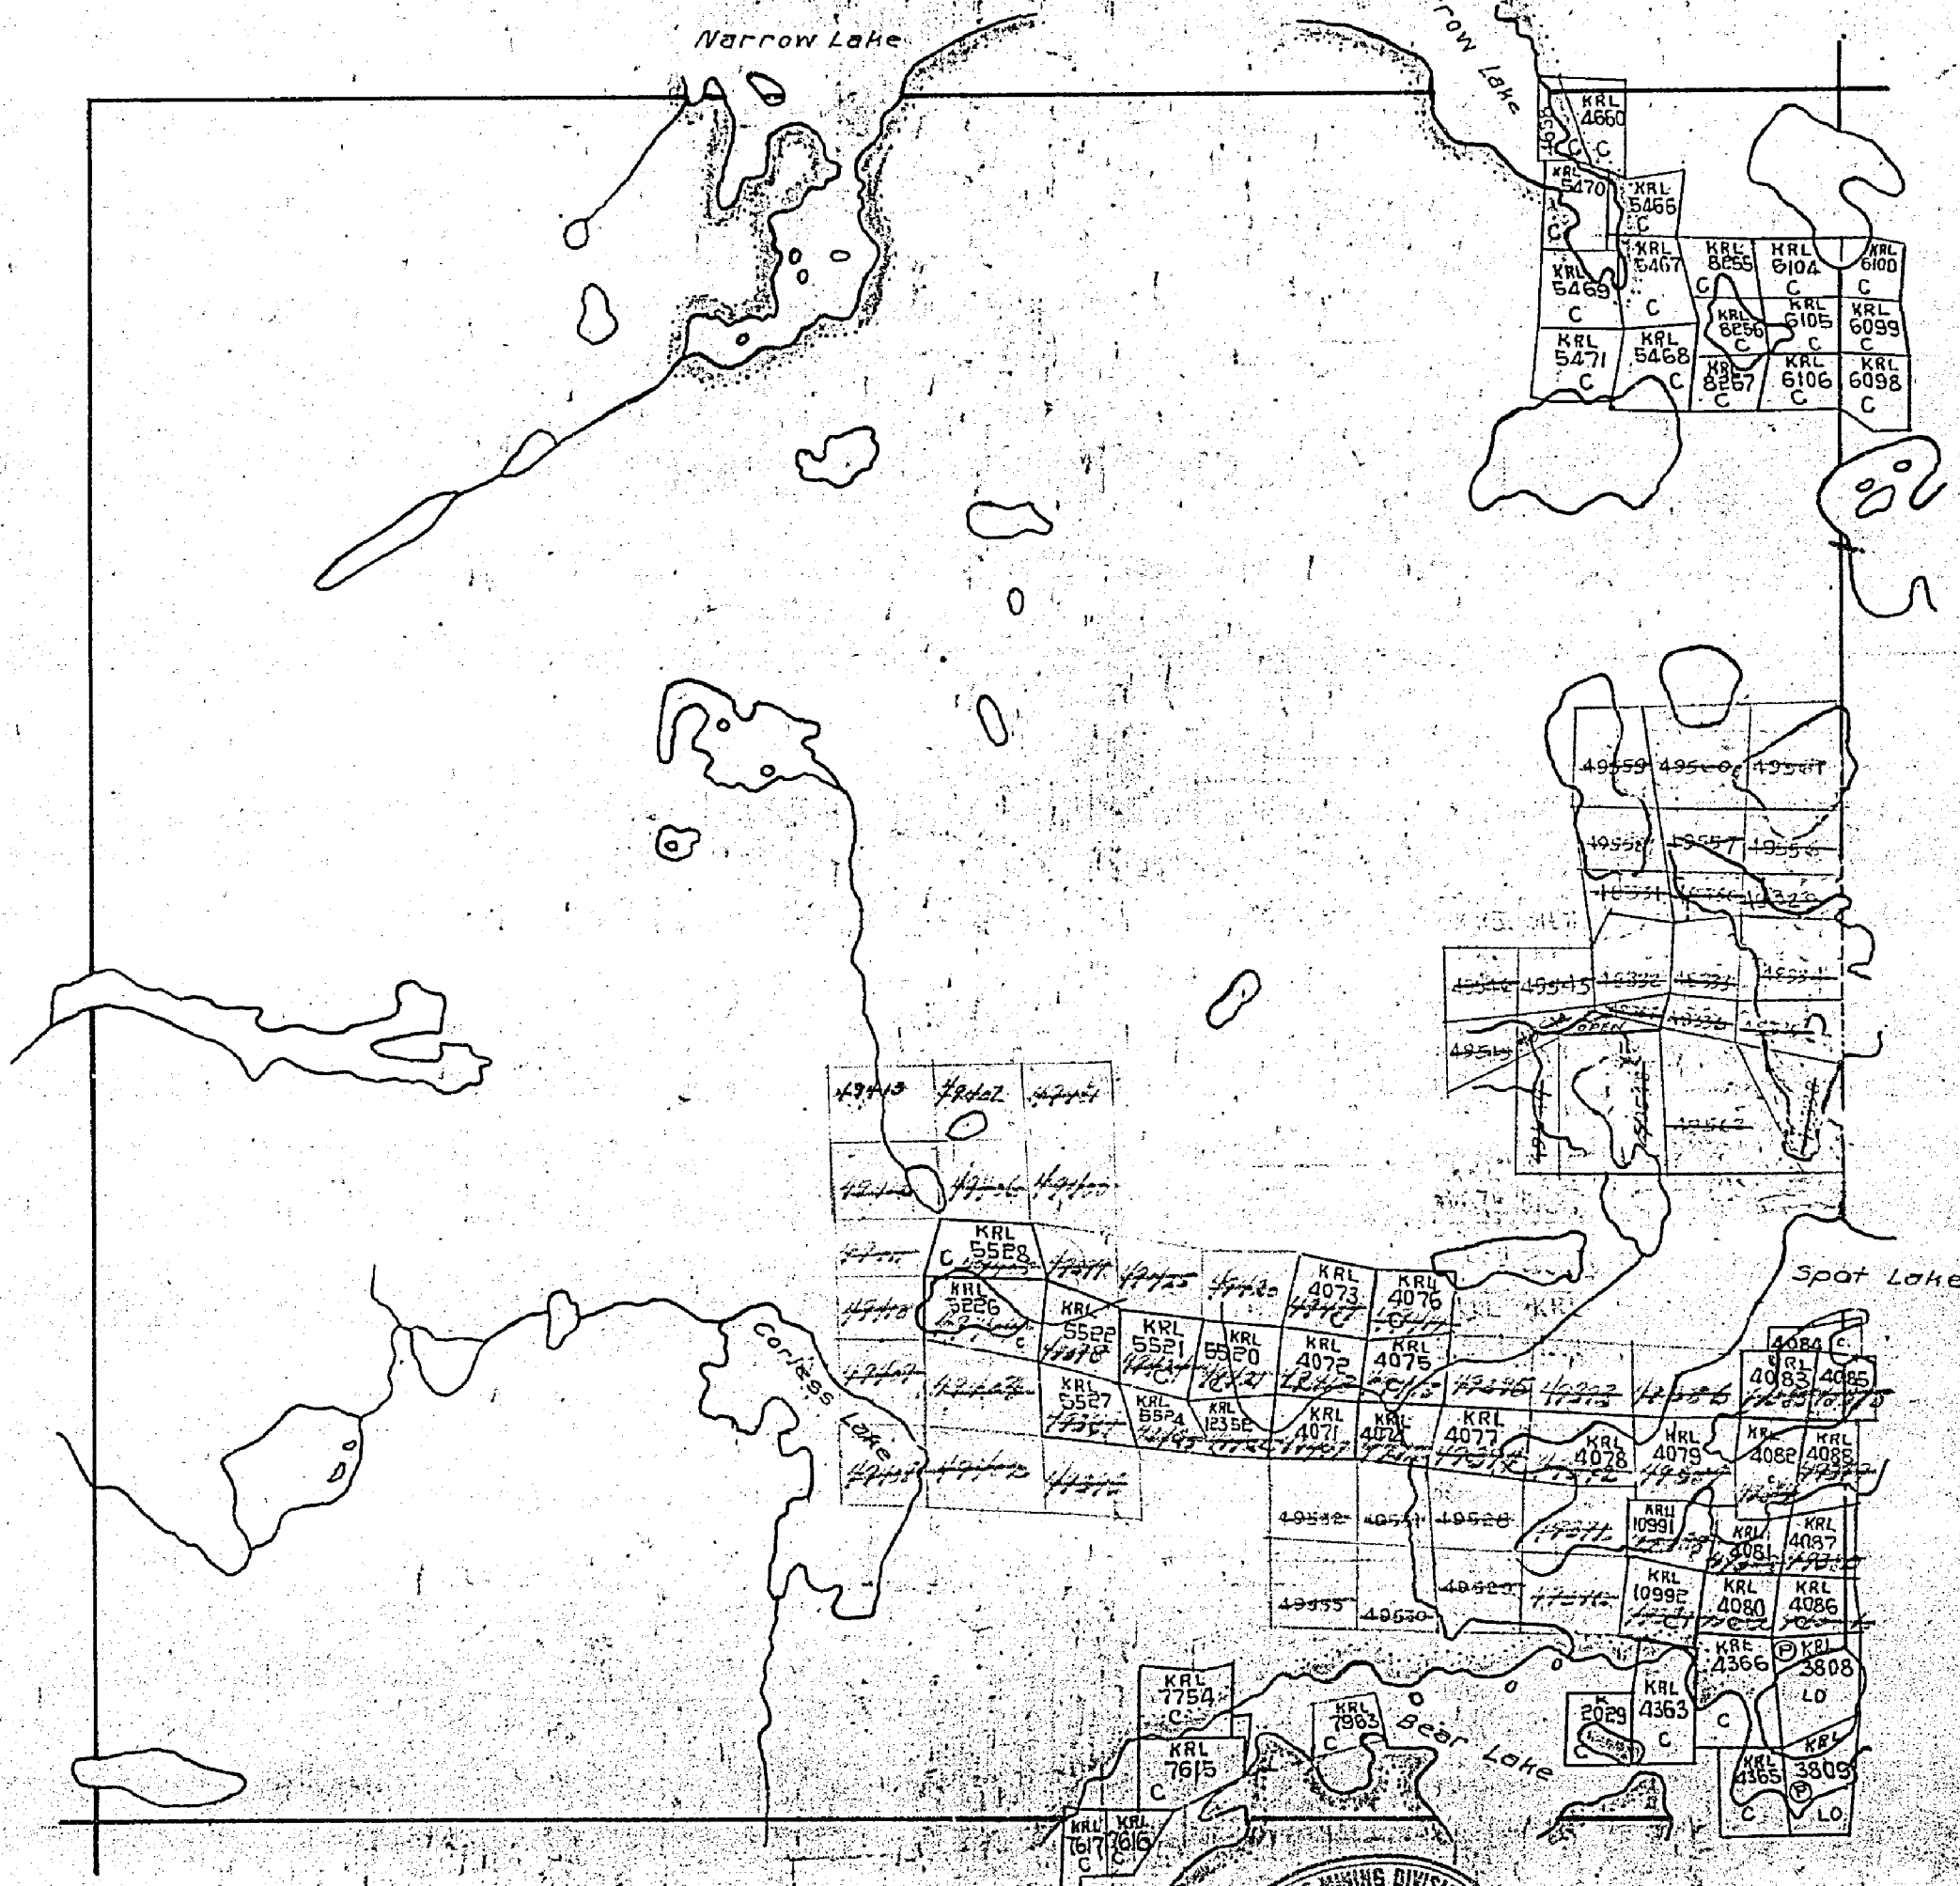

Surface reservations 200' wide by Dept. of L. & F. shown hereon thus ~~XXXXXX~~



M. 2154

2154

CORLESS

RED LARE MINING DIVISION

M. 2154

Scale 40 Chains = 1 inch

SKINNER

Narrow Lake

Narrows Lake

Apr 27/62
May 31/62

DEFEND

Surface reservations 200' wide by Dept. of L. & F. shown
hereon filed 2300-8800.

SURVEYS REMOVED $\rightarrow$ 25 yrs

КНОТТ



M 2154

2154


CORLESS

RED LAKE MINING DIVISION

Scale 40 Chains = 1 inch

M. 2154

SKINNER

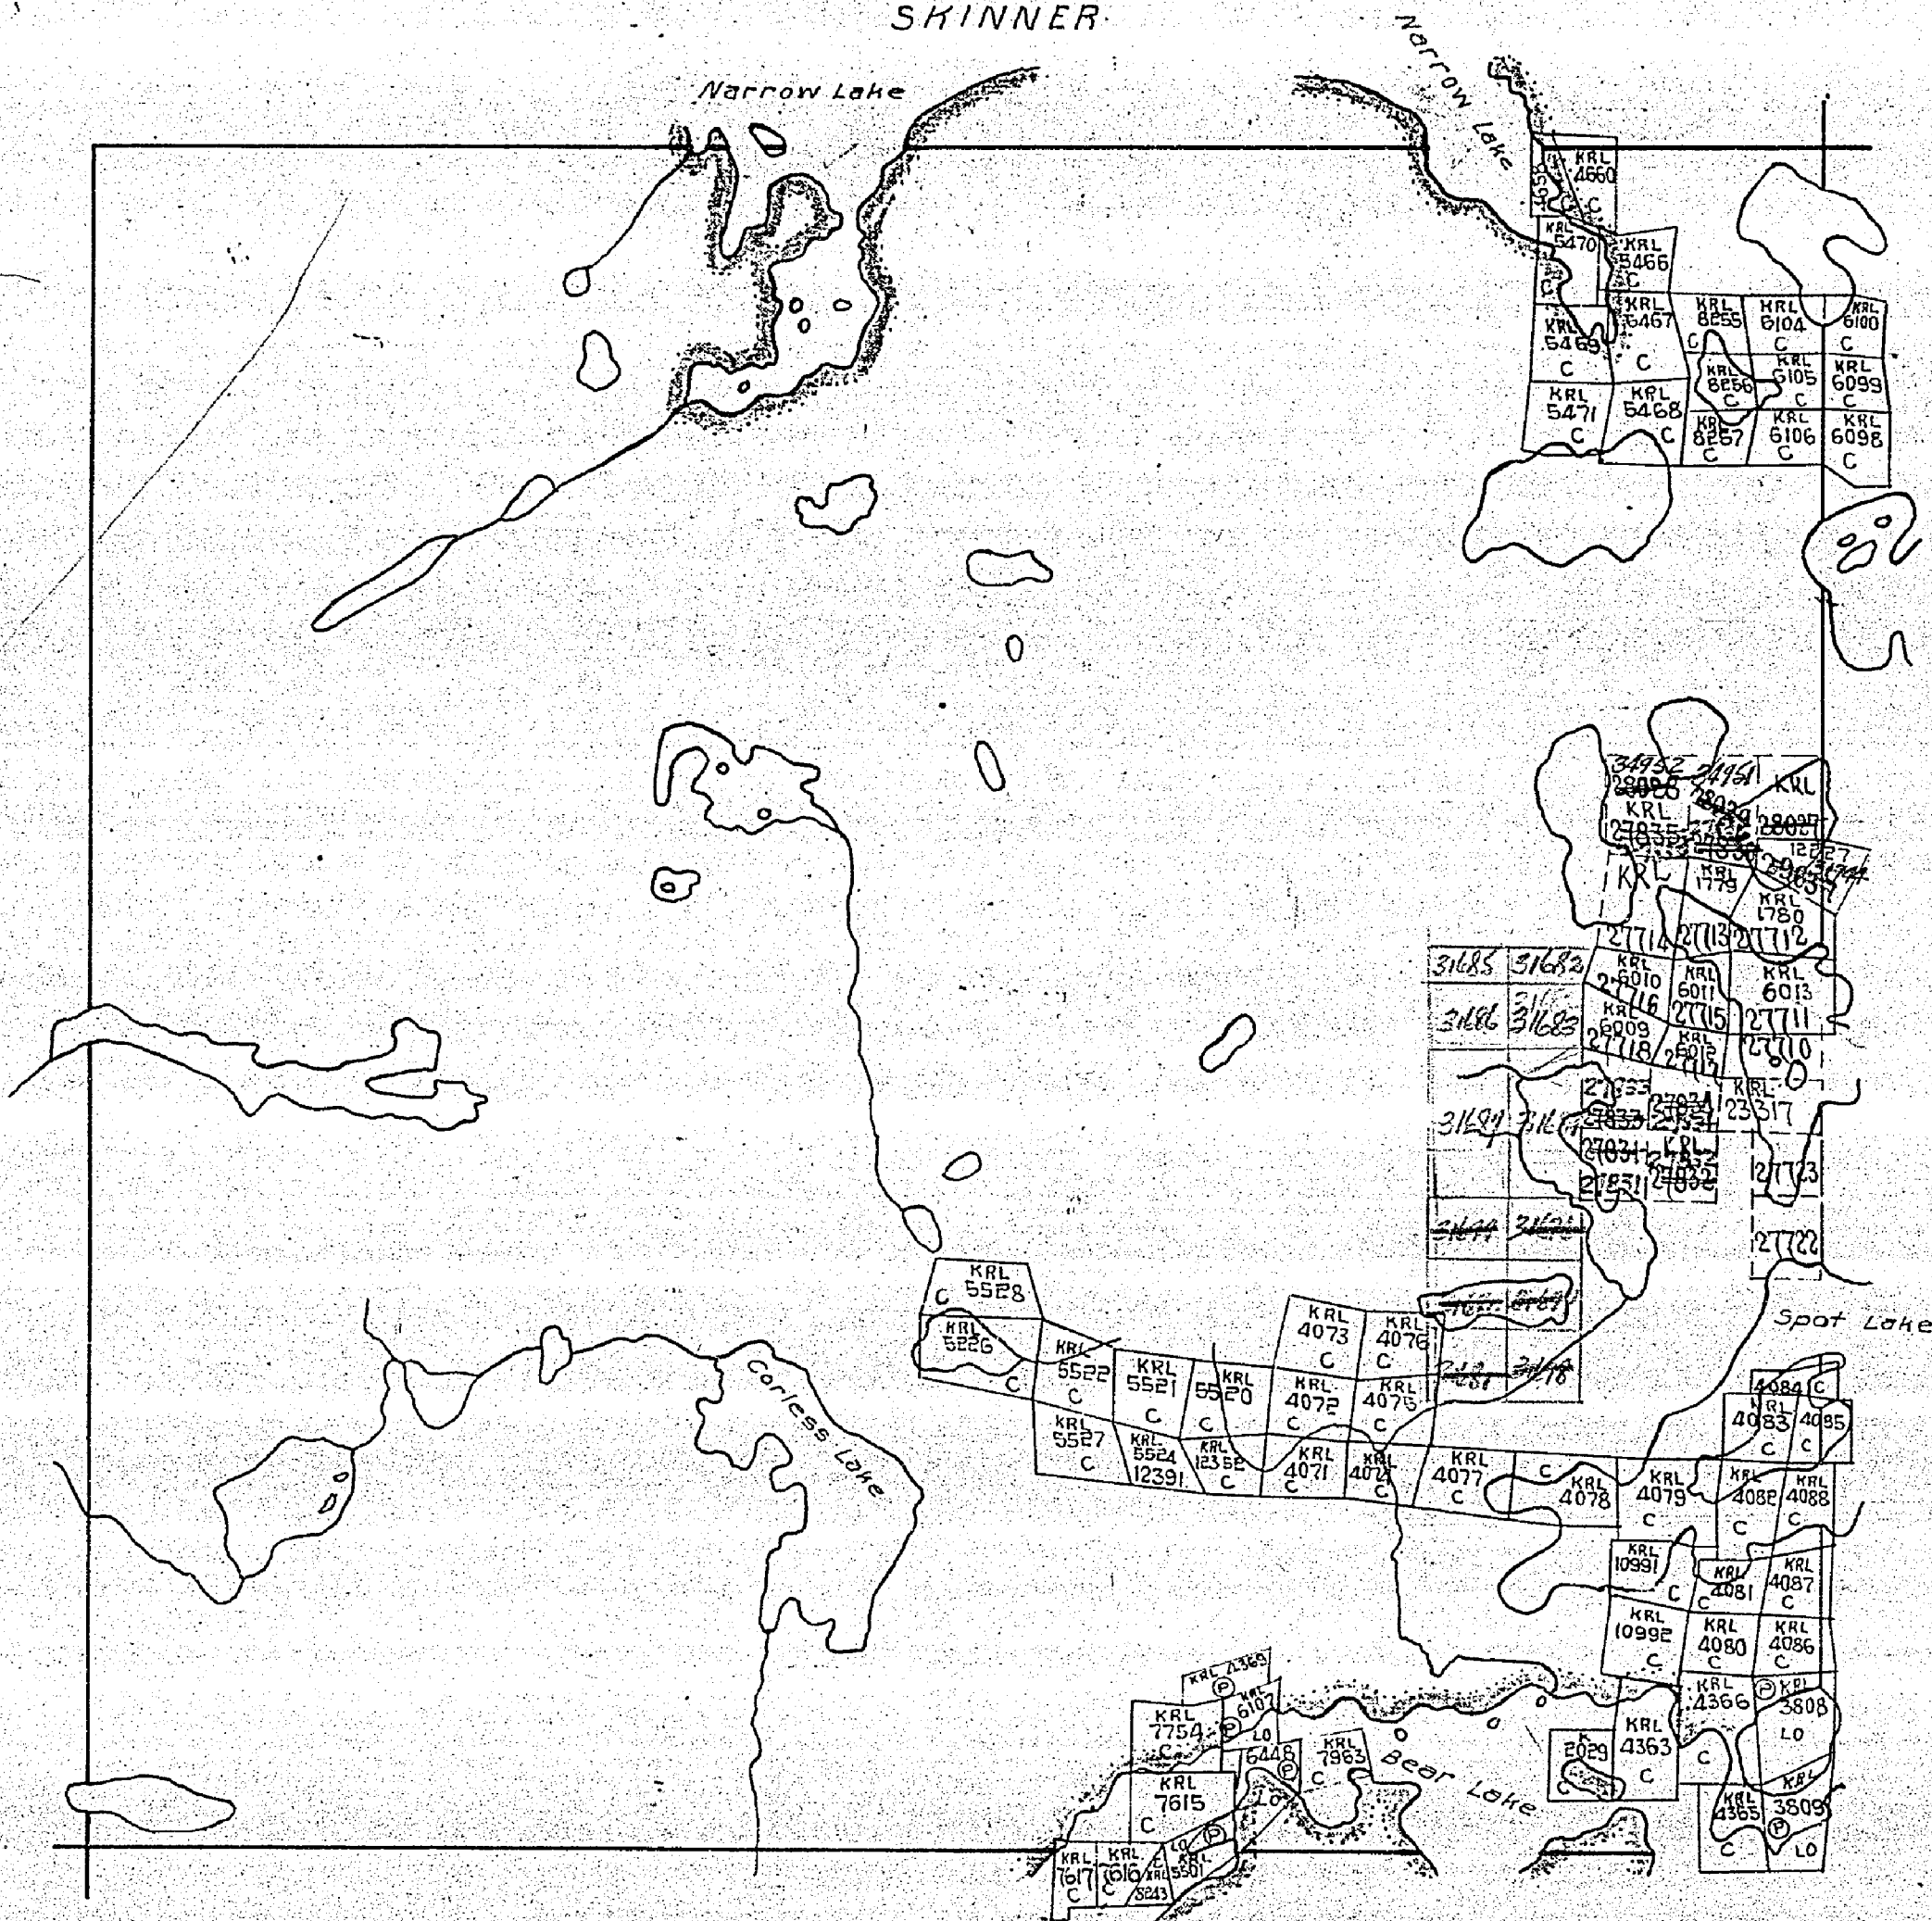

Surface reservations 200' wide by Dept. of L. & F. shown hereon this ~~map~~.

KNOTT

RED LAKE MINING DIVISION

Scale 40 Chains = 1 inch

M. 2154

SKINNER

Narrow Lake

Narrow Lake

25-77

Spot Lake

A map of Bear Lake, showing its irregular shoreline and a small island in the center. The lake is surrounded by a hilly or mountainous terrain. The text "Bear Lake" is written across the top of the lake.

Surface reservations 200' wide by Dept of L & F shown
hereon this 2112 2112 2112.

KNOTT