


McNish Twp.

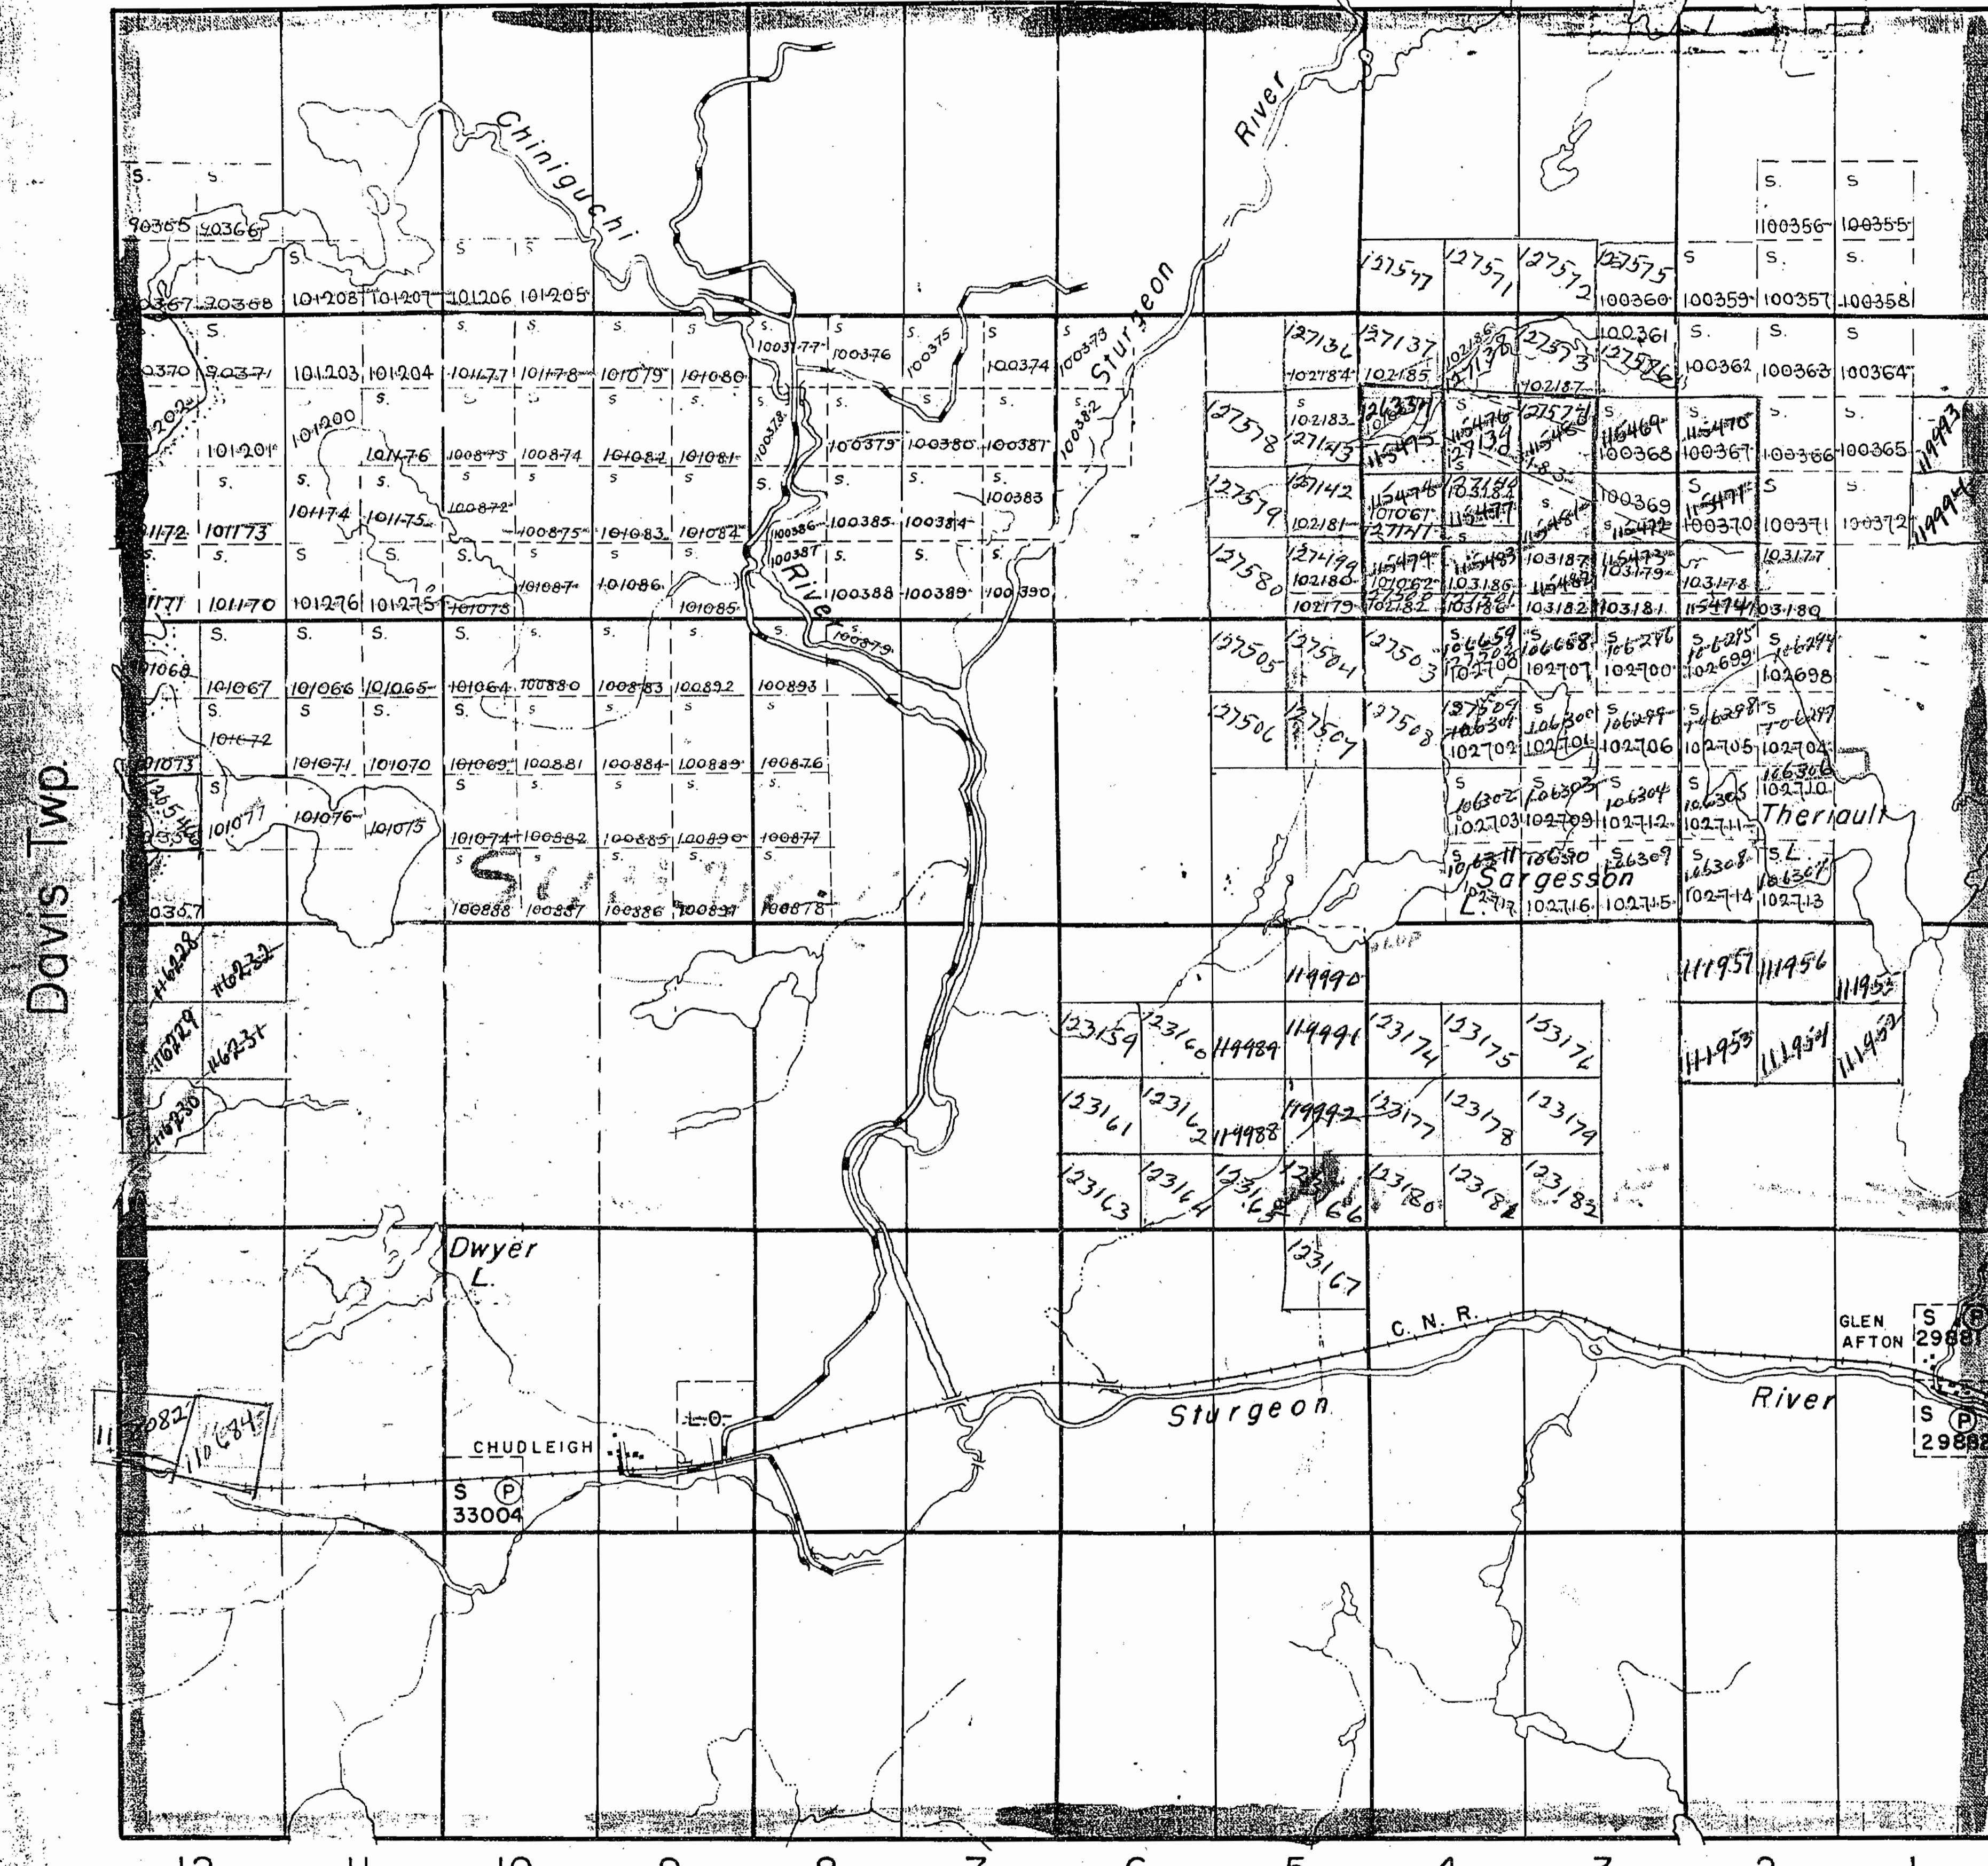

Turf file

THE TOWNSHIP
OF

Glen
JANES

DISTRICT OF
SUDBURY

SUDBURY
MINING DIVISION

SCALE: 1-INCH = 40 CHAINS

LEGEND

(P)	C.S.
(L)	Loc.
(O)	L.O.
M.R.O.	
S.R.O.	

PATENTED LAND
CROWN LAND SALE
LEASES
LOCATED LAND
LICENSE OF OCCUPATION
MINING RIGHTS ONLY
SURFACE RIGHTS ONLY
ROADS
IMPROVED ROADS
KING'S HIGHWAYS
RAILWAYS
POWER LINES
MARSH OR MUSKEG
MINES


Dana Twp.

NOTES

Mining Claims Accepted Under The Provision Of Section 53 Of The Mining Act.

400' Reserve to Dept. of Lands & Forests shown thus:

*Land 53
S.R.O. on Pt. lots 142 Con 4
by L. & F.*

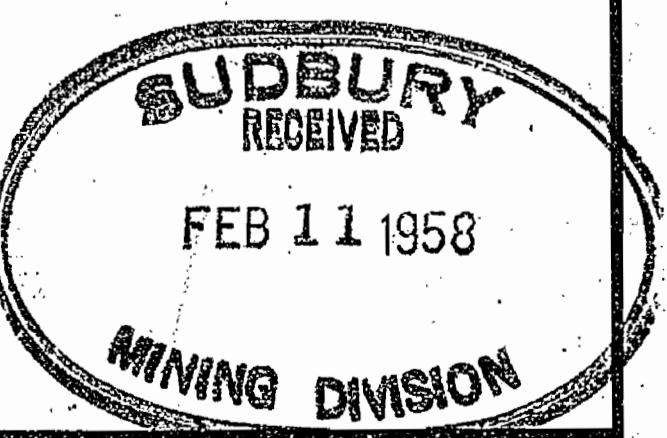

PLAN NO.- M-955

DEPARTMENT OF MINES
—ONTARIO—

Davis Twp. (M-748)

Henry Twp. (M-929)

Sept 19/68

THE TOWNSHIP OF

JANES

DISTRICT OF
SUDBURY

SUDBURY MINING DIVISION

SCALE: 1-INCH = 40 CHAINS

LEGEND

PATENTED LAND	(P)
CROWN LAND SALE	C.S.
LEASES	(L)
LOCATED LAND	Loc.
LICENSE OF OCCUPATION	L.O.
MINING RIGHTS ONLY	M.R.O.
SURFACE RIGHTS ONLY	S.R.O.
ROADS	—
IMPROVED ROADS	—
KING'S HIGHWAYS	—
RAILWAYS	—
POWER LINES	—
MARSH OR MUSKEG	—
MINES	
CANCELLED	C.

NOTES

400' Surface Rights Reservation
around all Lakes and Rivers.

Surface Rights Only reserved to the
Dept. of Lands & Forests under
Sec. 39 (d) of the Mining Act shown
thus: [REDACTED]

This Township has been Annulled.
Dec. 29, 1953.


PLAN NO. M.955

DEPARTMENT OF MINES

— ONTARIO —

Davis Twp. (M-748)

McNish Twp. (M-1020)

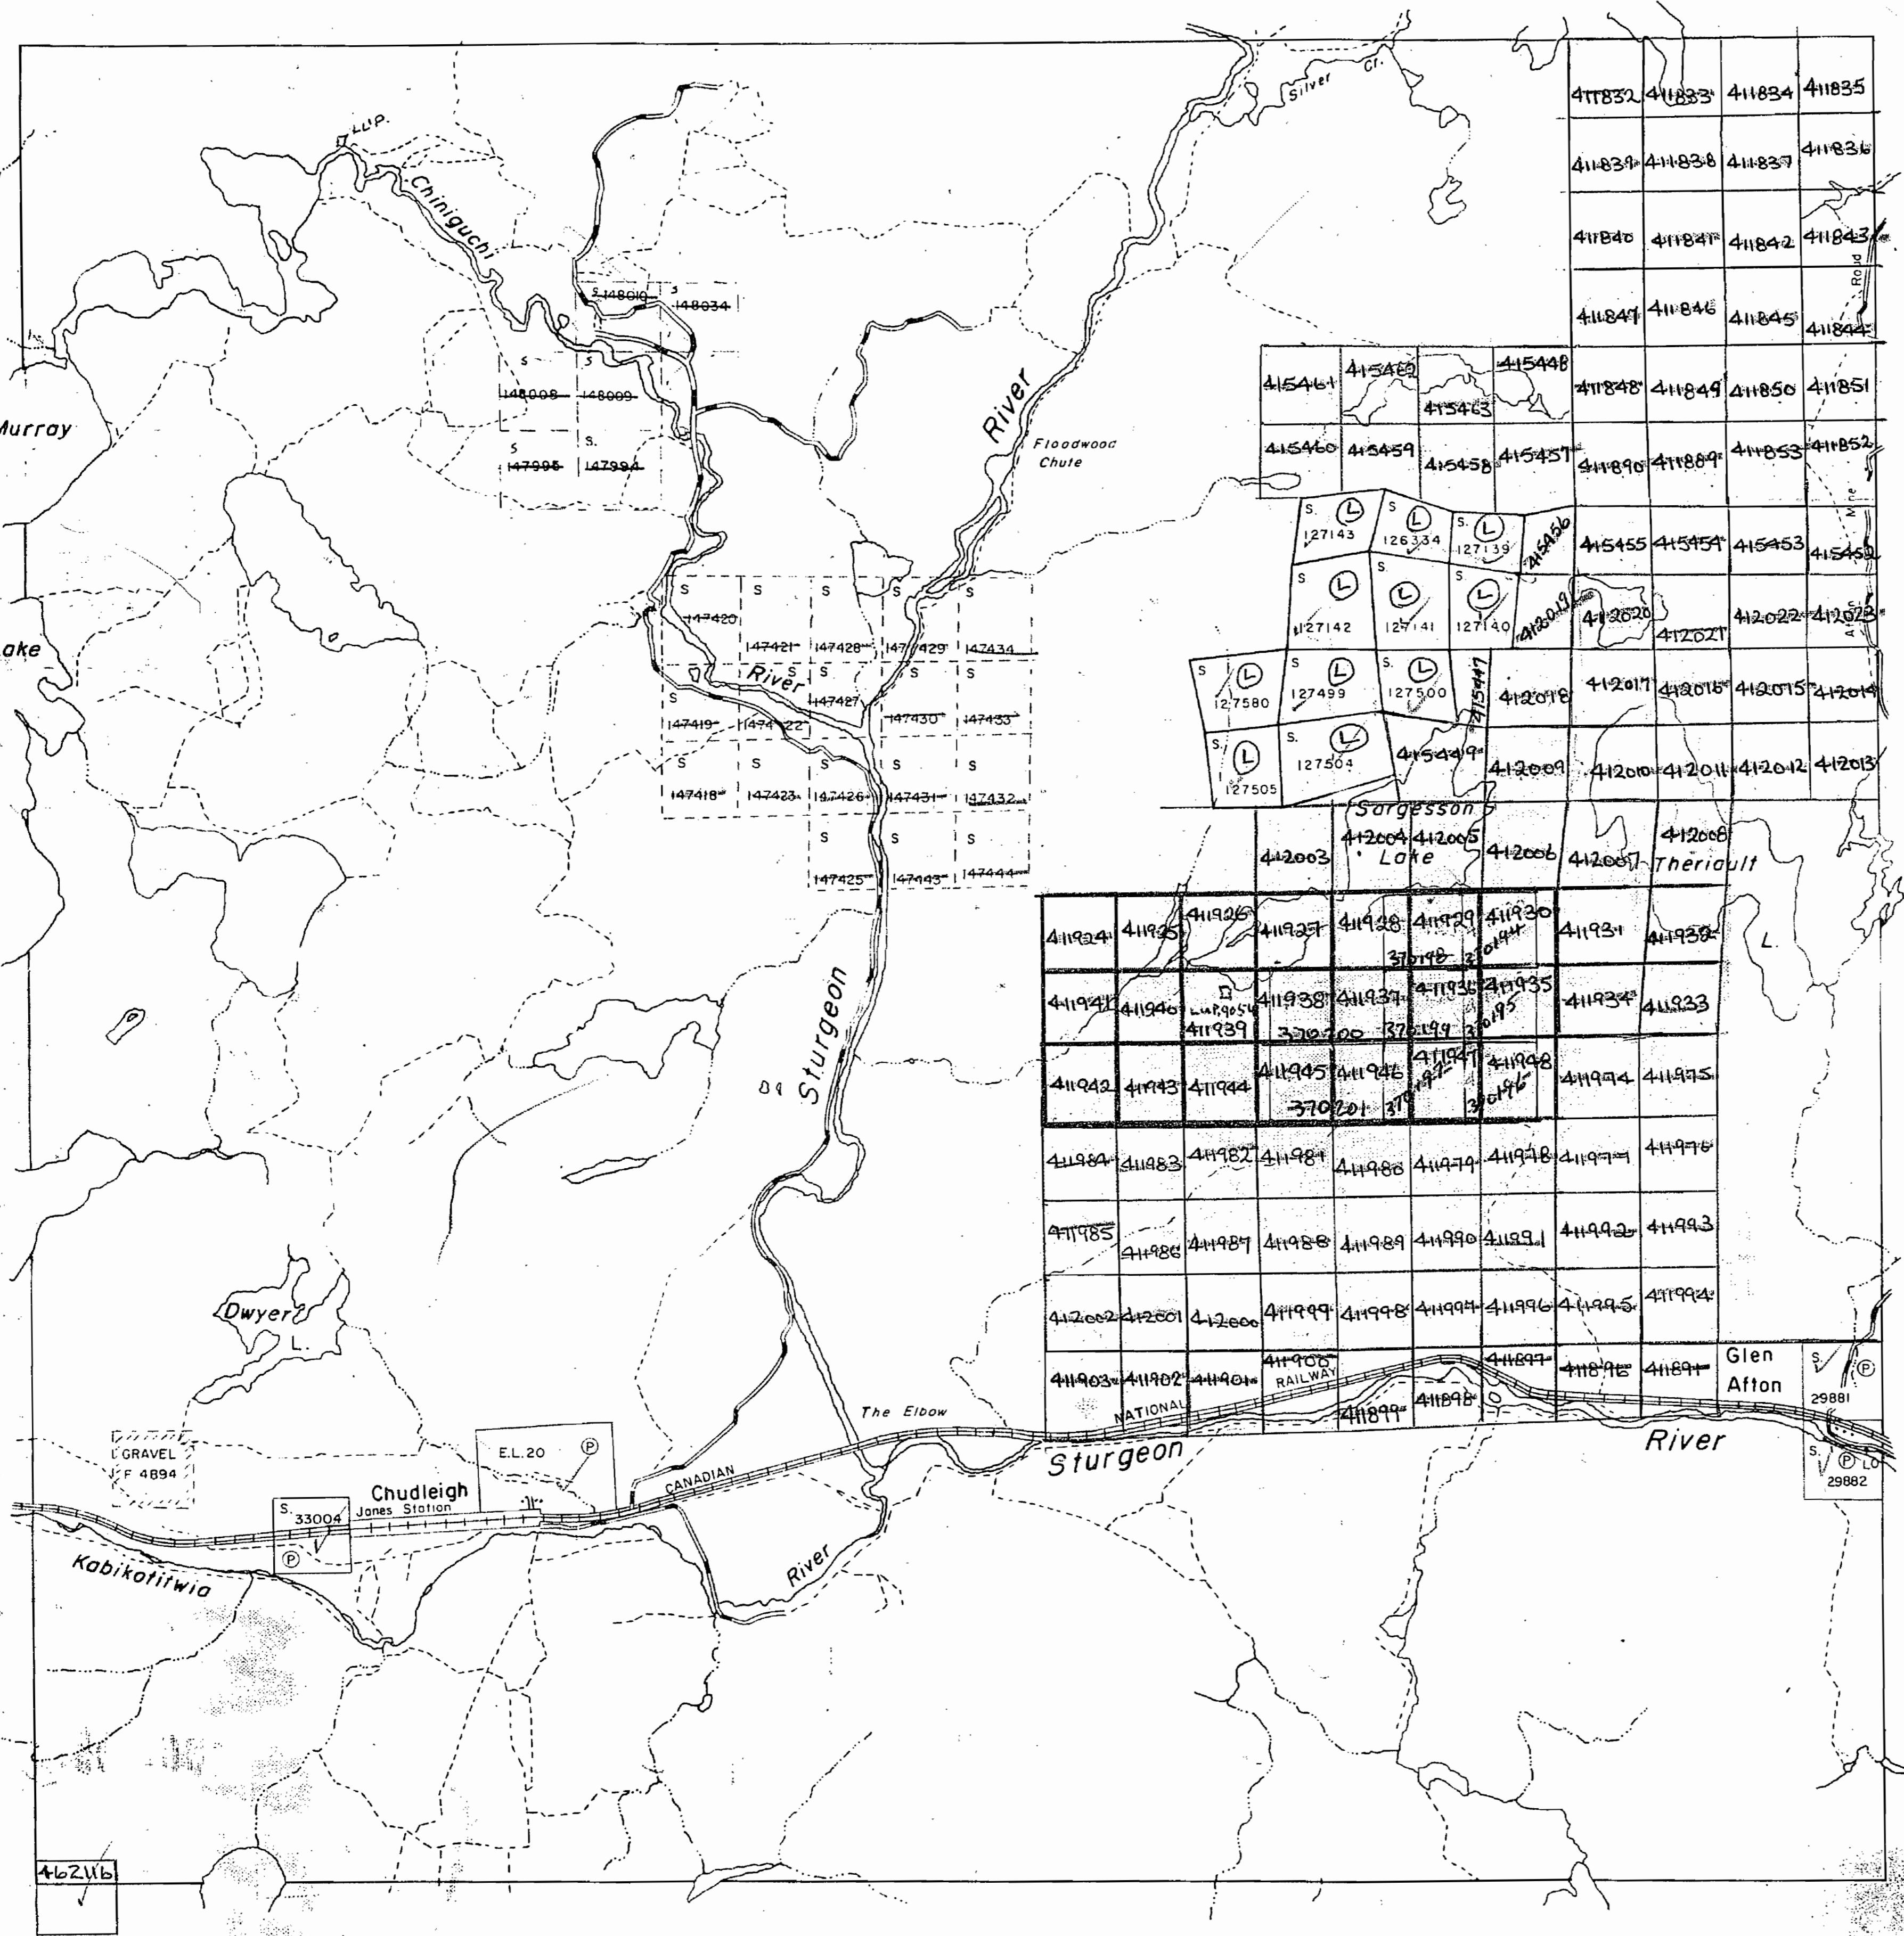

Henry Twp. (M-929)

THE TOWNSHIP
OF

JANES[®]

**DISTRICT OF
SUDBURY**

SUDBURY MINING DIVISION

SCALE: 1-INCH = 40 CHAINS

LEGEND

PATENTED LAND	(P)
CROWN LAND SALE	(C.S.)
LEASES	(L)
LOCATED LAND	(Loc.)
LICENSE OF OCCUPATION	(L.O.)
MINING RIGHTS ONLY	(M.R.O.)
SURFACE RIGHTS ONLY	(S.R.O.)
ROADS	=====
IMPROVED ROADS	====
KING'S HIGHWAYS	=====
RAILWAYS	=====
POWER LINES	=====
MARSH OR MUSKEG	=====
MINES	(Map)
CANCELLED	(X)

NOTES

400' Surface Rights Reservation
around all Lakes and Rivers.

Surface Rights Only reserved to the
Dept. of Lands & Forests under
Sec. 39 (d) of the Mining Act shown
thus: 

This Township has been Annulled
Dec 29, 1953.

SUBJURY
STYLING DIV.
R E C E I V E D


~~BLANKET QUARRY PERMIT~~
~~#6307 COVERING PART~~
~~OF JANES TOWNSHIP~~
BLANKET QUARRY PERMIT #7151
COVERING PART OF JANES TWP
JANES
PLAN NO. M.955

ONTARIO DEPARTMENT OF MINES AND NORTHERN AFFAIRS

TRIM LINE

* Oct/13

McNish Twp. (M-1020)

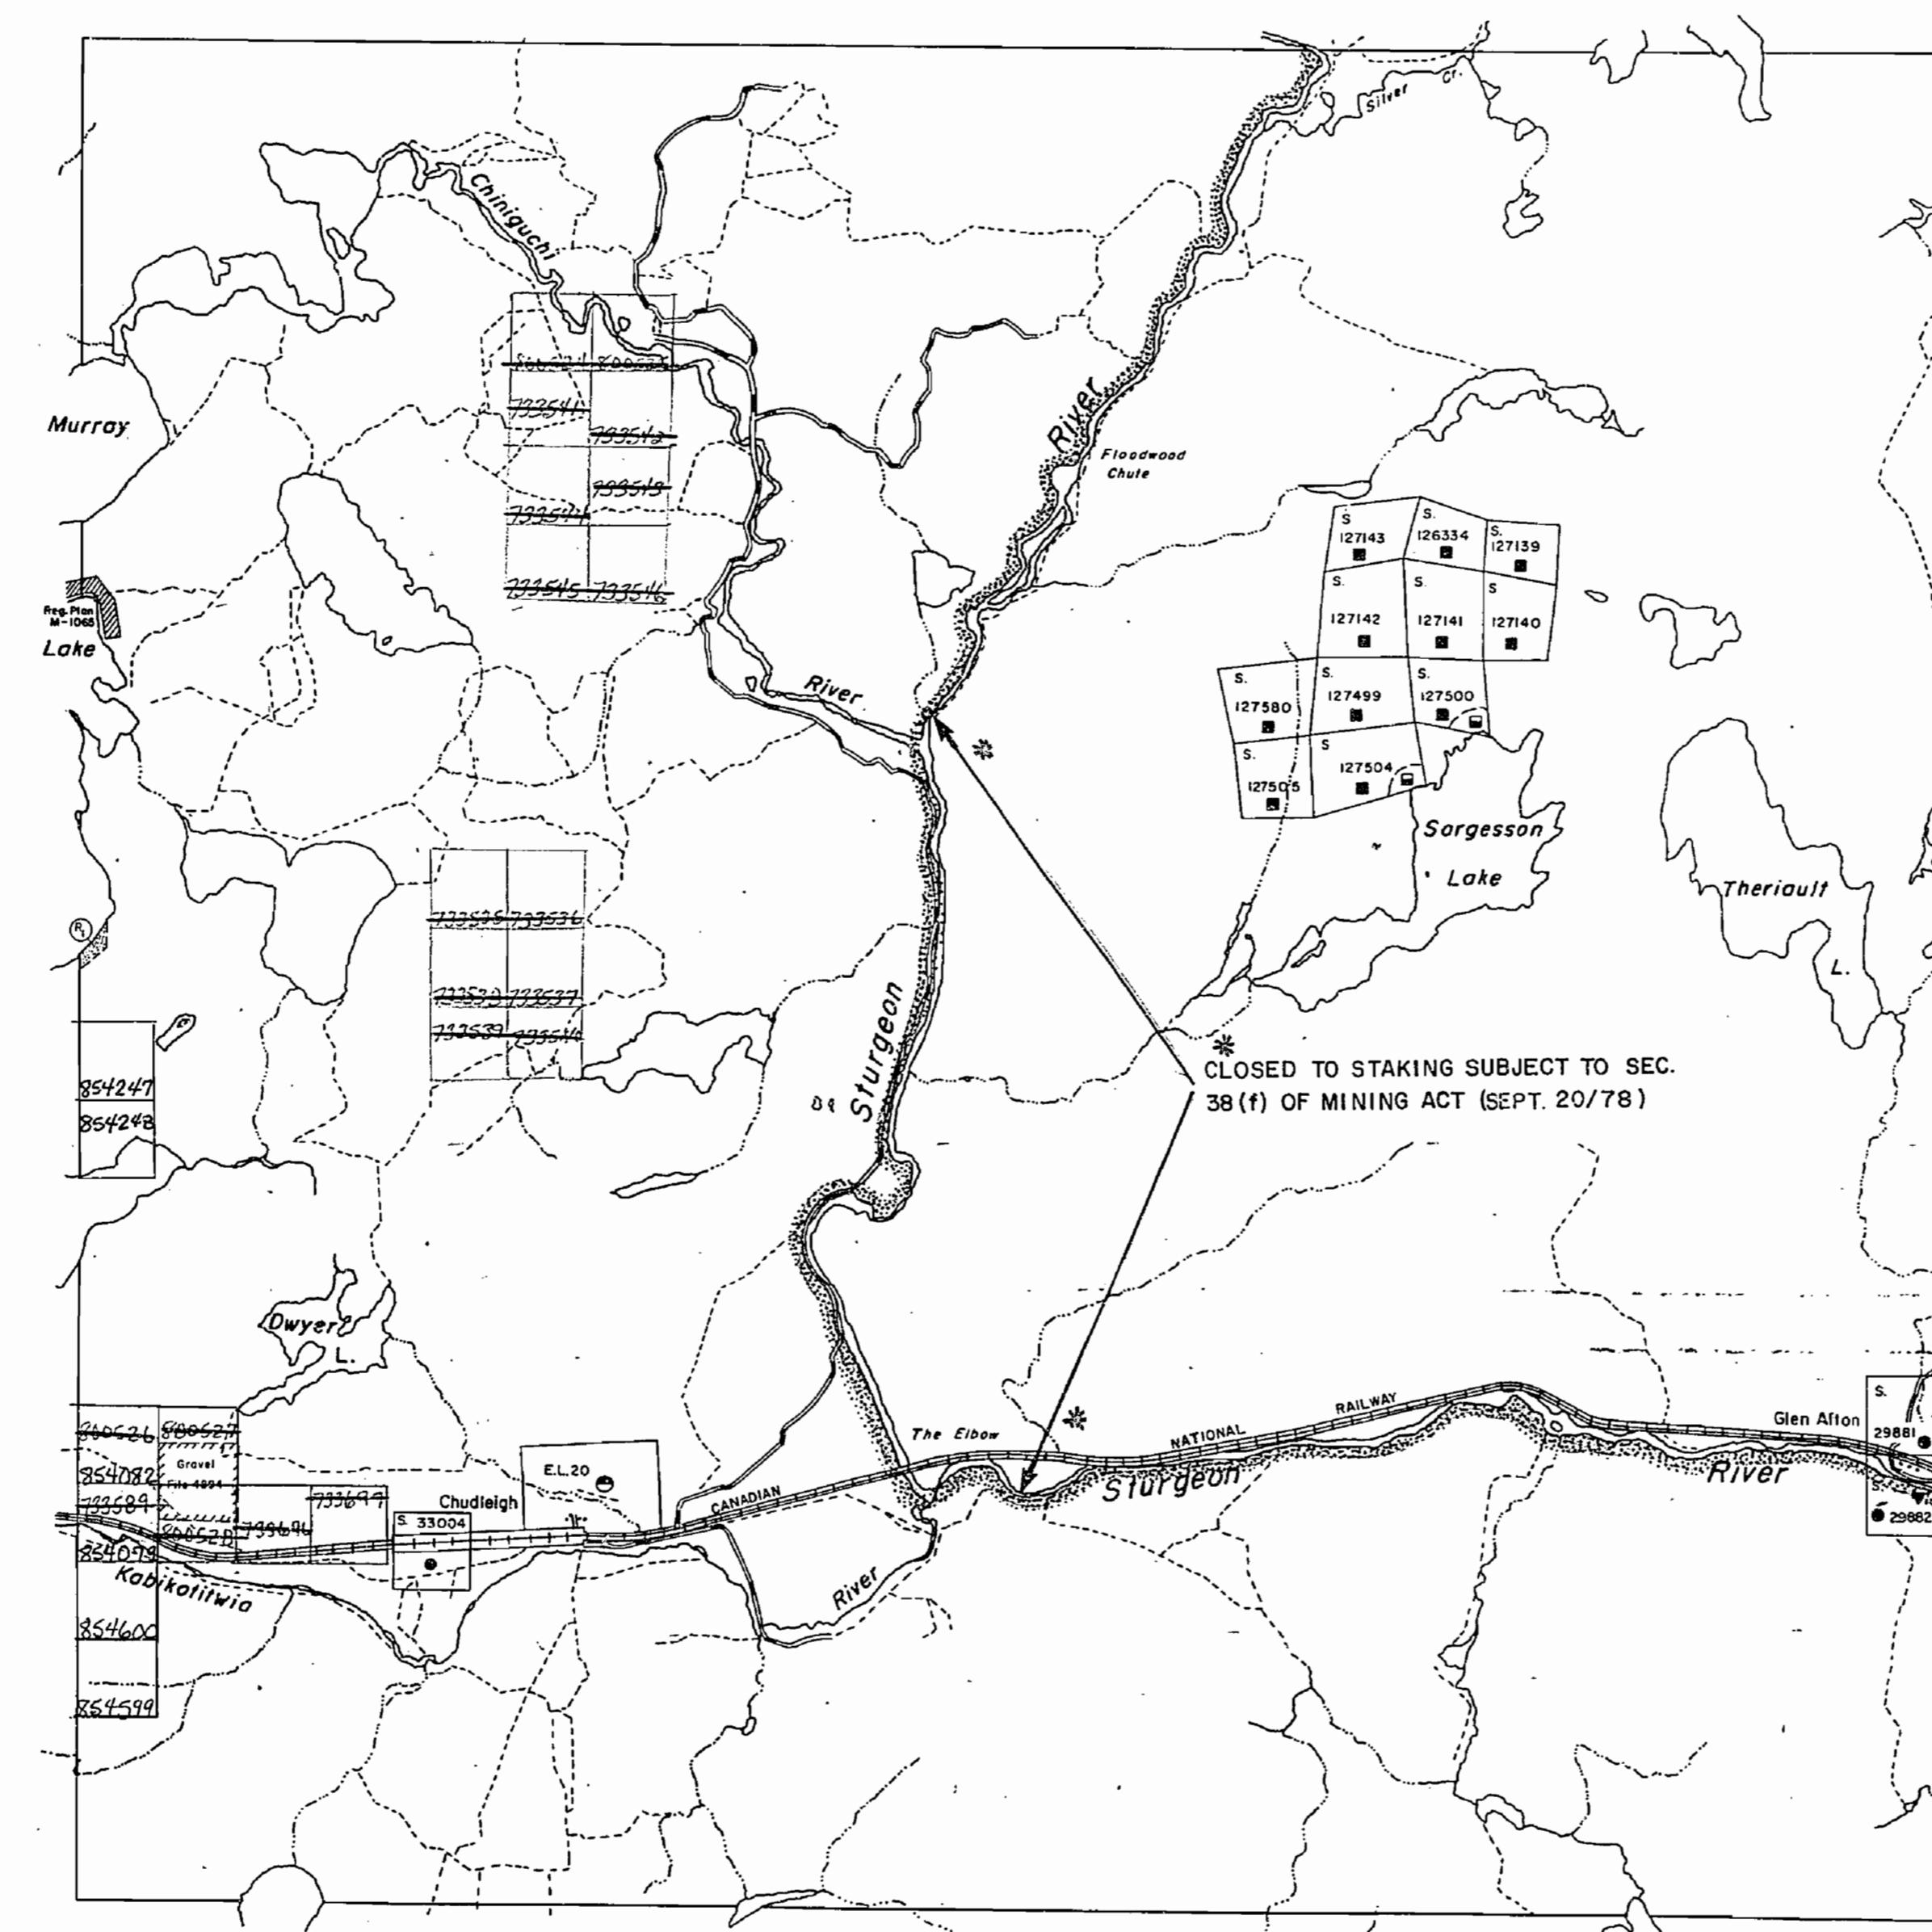

Henry Twp. (M-929)

THE TOWNSHIP
OF

JANES

DISTRICT OF
SUDBURY

SUDBURY
MINING DIVISION

SCALE: 1-INCH = 40 CHAINS

DISPOSITION OF CROWN LANDS

- PATENT, SURFACE AND MINING RIGHTS _____
" , SURFACE RIGHTS ONLY _____
" , MINING RIGHTS ONLY _____
LEASE, SURFACE AND MINING RIGHTS _____
" , SURFACE RIGHTS ONLY _____
" , MINING RIGHTS ONLY _____
LICENCE OF OCCUPATION _____

ROADS

- | | |
|-----------------|----|
| IMPROVED ROADS | |
| KING'S HIGHWAYS | |
| RAILWAYS | |
| POWER LINES | |
| MARSH OR MUSKEG | |
| MINES | |
| CANCELLED | C. |
| QUARRY PERMIT | @ |

NOTES

400' surface rights reservation along the shores
of all lakes and rivers.

Subdivision of this township into Lots and Concessions was annulled 29 Dec., 1953.

**Areas withdrawn from staking under Section
43 of the Mining Act (R.S.O. 1970).**


W.I.T. - WITNESSES
R1 W.94/77 188530 6/12/77 S.R.

* CLOSED TO STAKING EFFECTIVE
MARCH 16, 1984, SECTION 36 OF
THE MINING ACT

JANES

PLAN NO. M.955

ONTARIO
MINISTRY OF NATURAL RESOURCES
SURVEYS AND MAPPING BRANCH

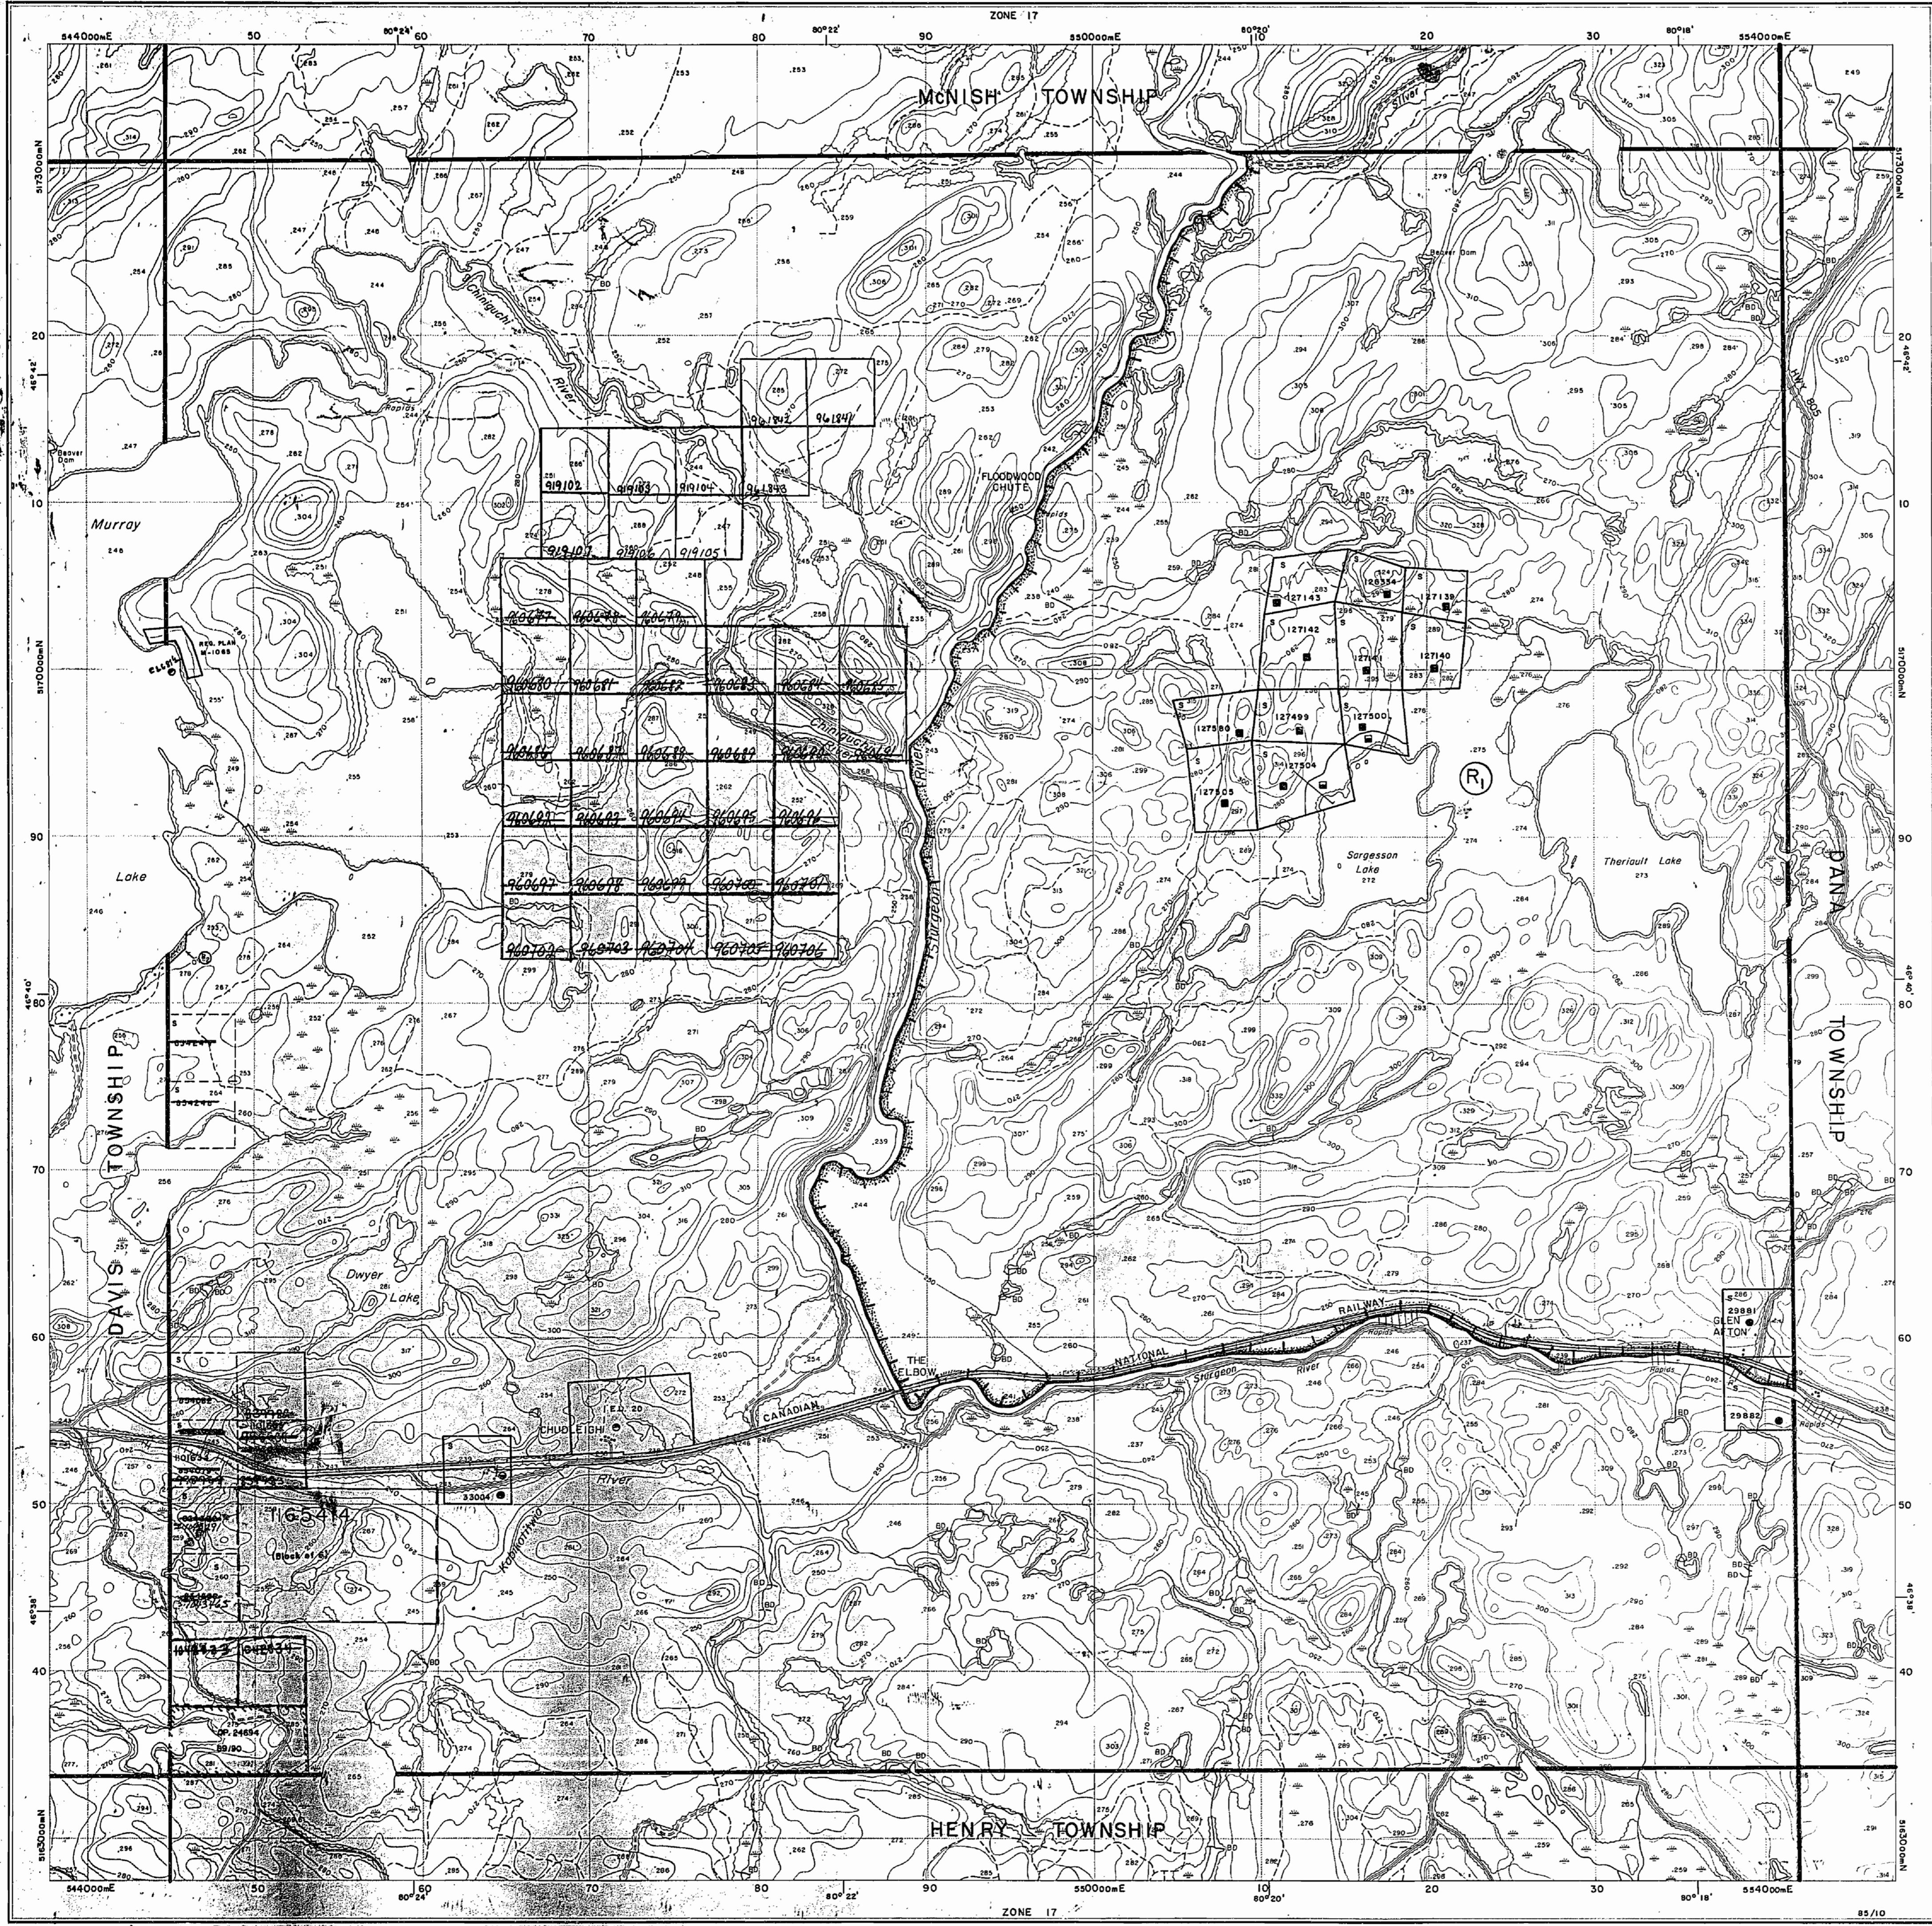

Ministry of
Natural
Resources
Ontario

Ministry of
Northern Affairs
and Mines

INDEX TO LAND DISPOSITION


PLAN

G-2907

TOWNSHIP

JANES

M.N.R. ADMINISTRATIVE DISTRICT
NORTH BAY
MINING DIVISION
SUDSBURY
LAND TITLES/REGISTRY DIVISION
SUDSBURY

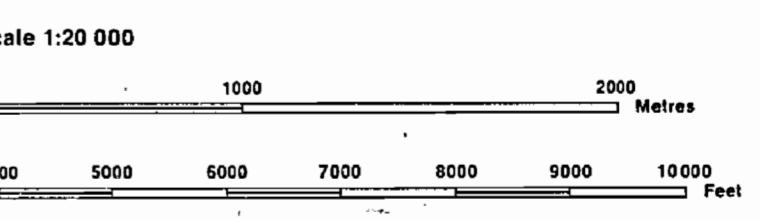

Contour Interval, 10 Metres

AREAS WITHDRAWN FROM DISPOSITION

MRO - Mining Rights Only
SRO - Surface Rights Only
M + S - Mining and Surface Rights

Description	Order No.	Date	Disposition	File
① Sec. 36/80	W. 2/84	16/3/84	M + S	188540
② Sec. 43/70	W. 94/77	6/12/77	SRO	188530

Part of order W 2/84 REOPENED by order
O-ML O/30 NER effective April 3/990 at 7:00 AM E.S.T.

SYMBOLS

Boundary	Township, Meridian, Baseline.....
Road allowance; surveyed shoreline.....
Lot/Concession; surveyed unsurveyed.....
Parcel; surveyed unsurveyed.....
Right-of-way; road railway..... utility.....
Reservation
Cliff, Pit, Pile
Contour 20.....
Interpolated
Approximate
Depression
Control point (horizontal)	△
Flooded land
Mine head frame
Pipeline (above ground)
Railway; single track
double track
abandoned
Read; highway, county, township
access
trail, bush
Shoreline (original)
Transmission line
Wooded area

NOTES

Subdivision of this Township into Lots and Concessions was
announced 29th December, 1953.

"THIS MAP SHOWS THE APPROXIMATE LOCATION OF THE BOUNDARIES OF THE AREA WHICH IS THE SUBJECT OF CURRENT LITIGATION, THE EXACT LOCATION WILL BE SHOWN FOLLOWING CONFIRMATION BY THE PARTIES TO THE ACTION"

DISPOSITION OF CROWN LANDS

Patent	Surface & Mining Rights.....
	Surface Rights Only.....
	Mining Rights Only.....
Lease	Surface & Mining Rights.....
	Surface Rights Only.....
	Mining Rights Only.....
Licence of Occupation
Order-in-Council	OC
Cancelled
Reservation
Sand & Gravel


QUARRY PERMITS

DESCRIPTION	FILE NO.	ISSUE DATE	EXPIRATION DATE
③ QUARRY PERMIT FOR BUILDING STONE	OP 24694	89/03/01	90/02/28

DATE OF ISSUE
JUL 27 1992
SUDSBURY
MINING RECORDER'S OFFICE

THE INFORMATION THAT APPEARS ON THIS MAP HAS BEEN OBTAINED FROM VARIOUS SOURCES AND ACCURACY IS NOT GUARANTEED. THOSE WISHING TO STAKE MINING CLAIMS SHOULD CONSULT THE MINING RECORDER, MINISTRY OF NORTHERN DEVELOPMENT AND MINES, FOR ADDITIONAL INFORMATION ON THE STATUS OF THE LANDS SHOWN HEREON.

C-5

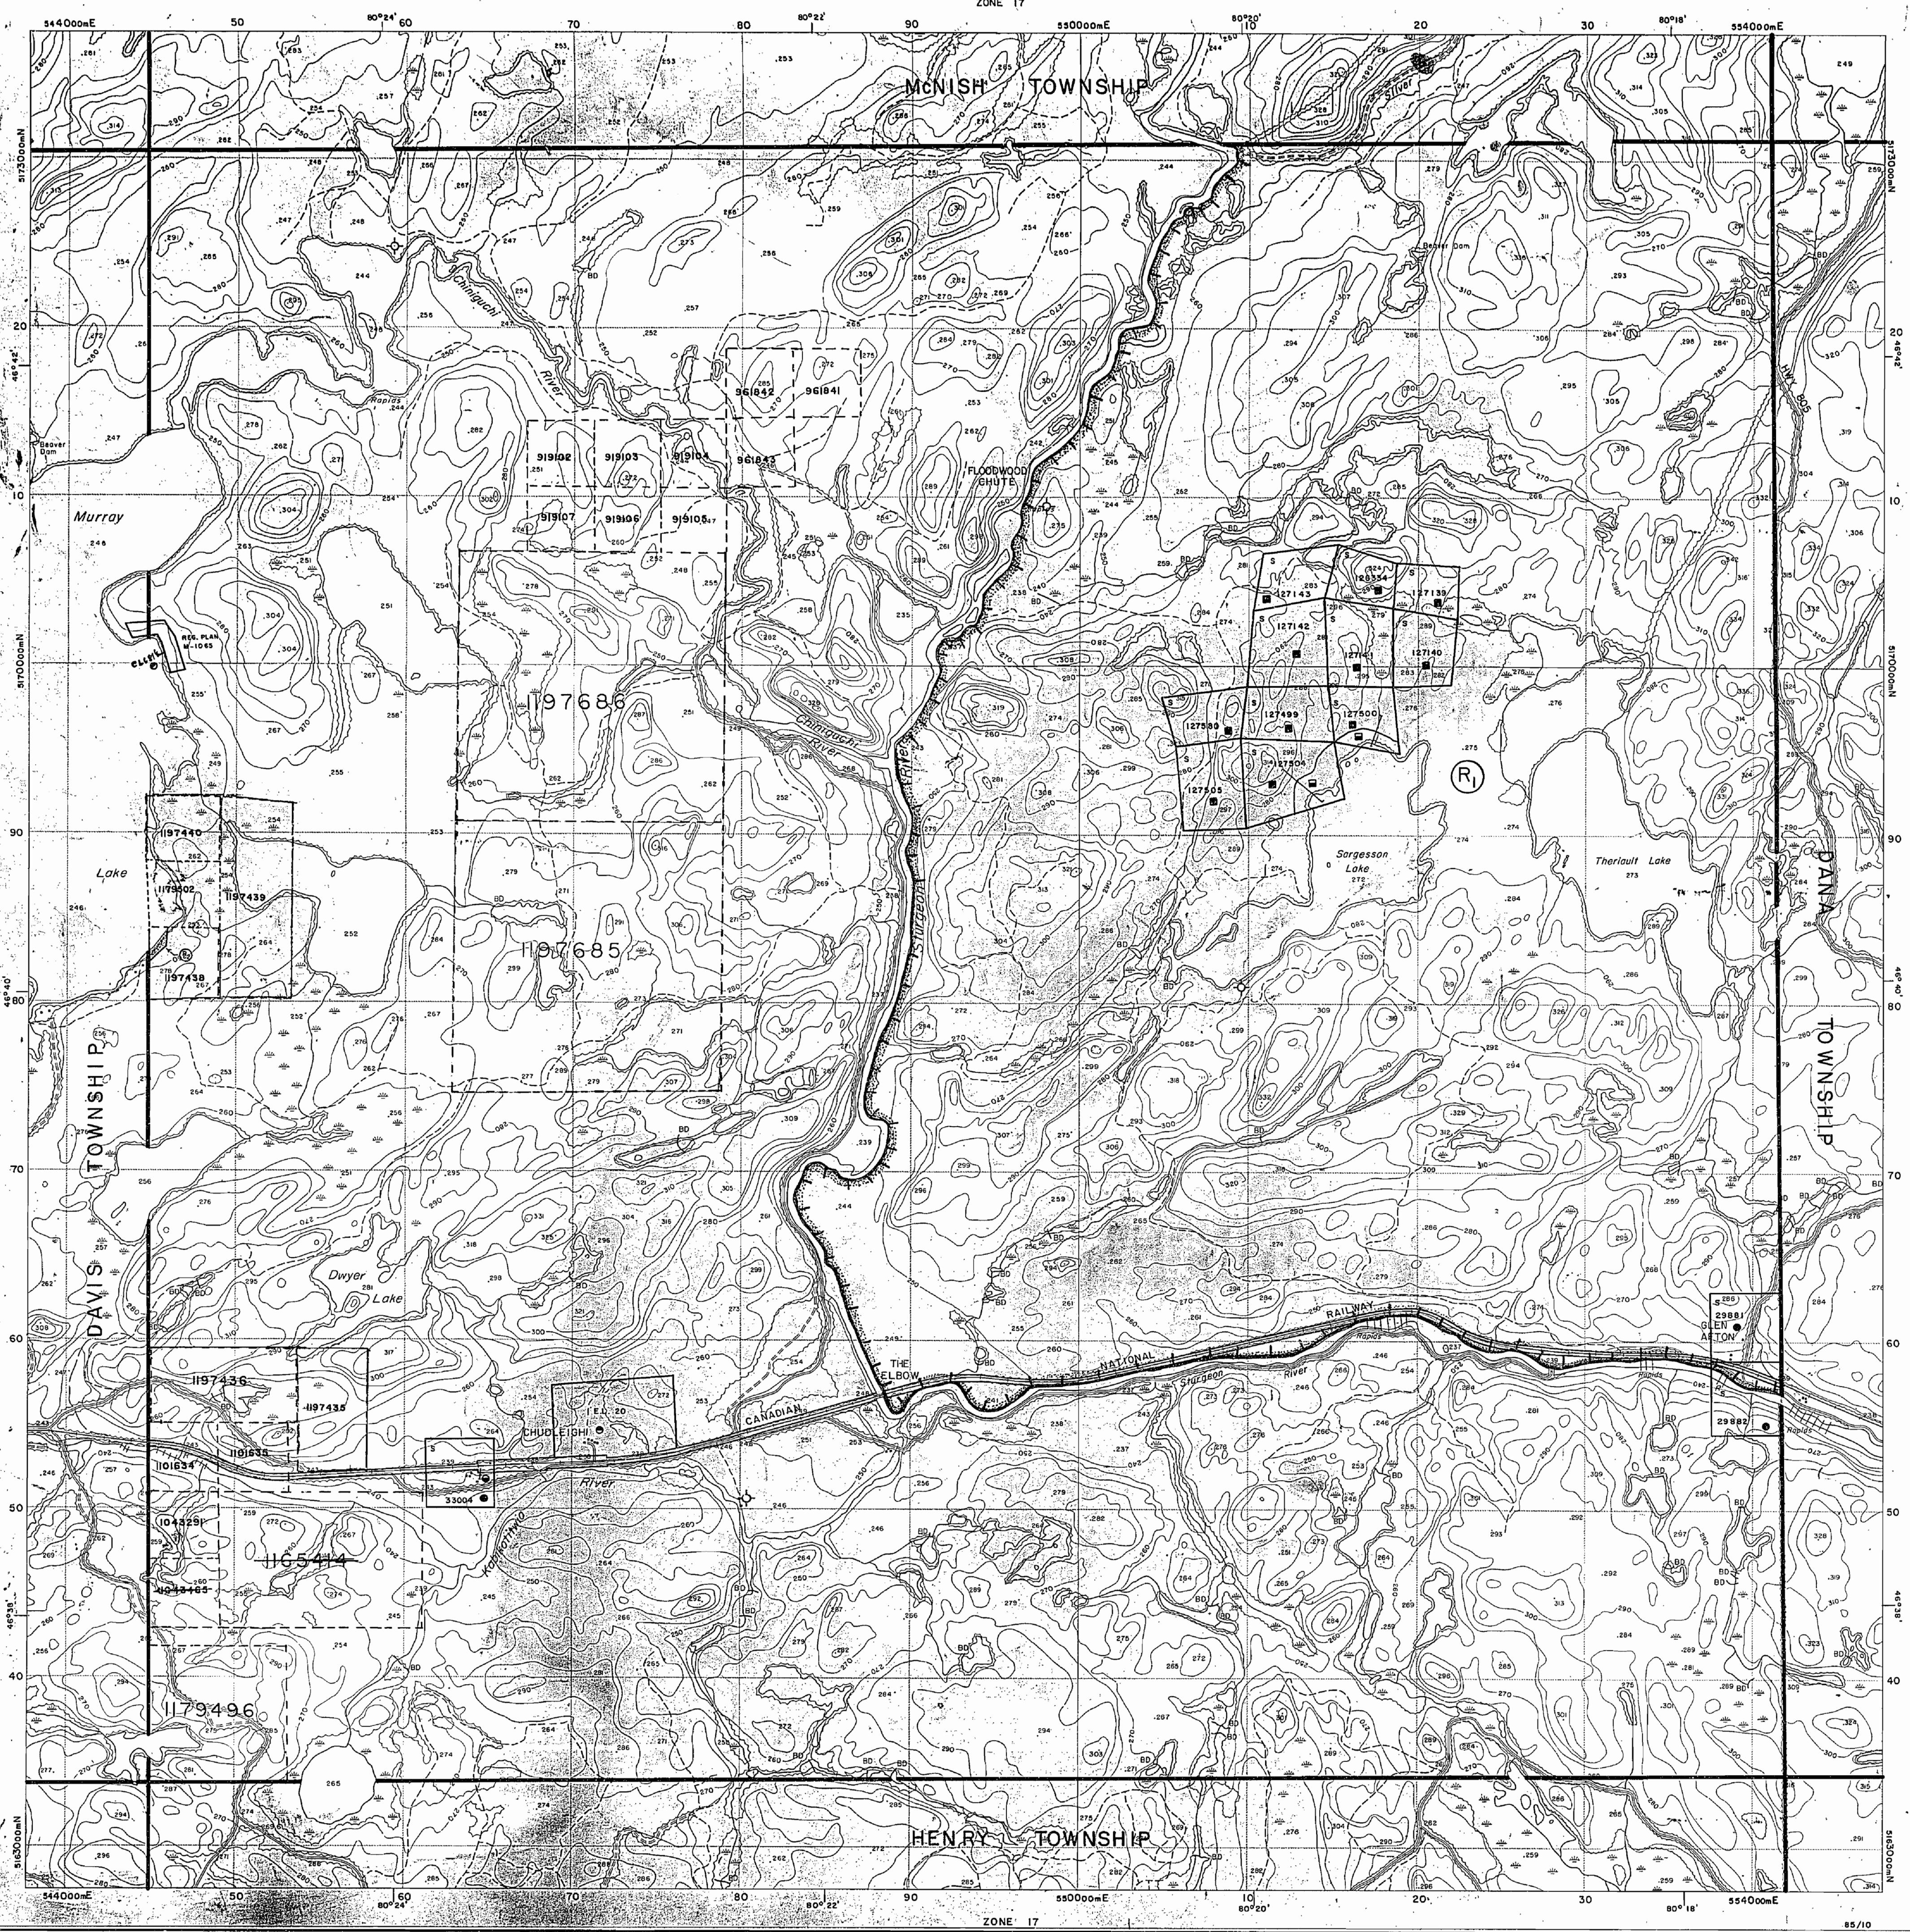

Ministry of
Natural
Resources
Ontario

Ministry of
Northern Affairs
and Mines

INDEX TO LAND DISPOSITION


PLAN

G-2907

TOWNSHIP

JANES

M.N.R. ADMINISTRATIVE DISTRICT
NORTH BAY
MINING DIVISION
SUDBURY
LAND TITLES/REGISTRY DIVISION
SUDBURY

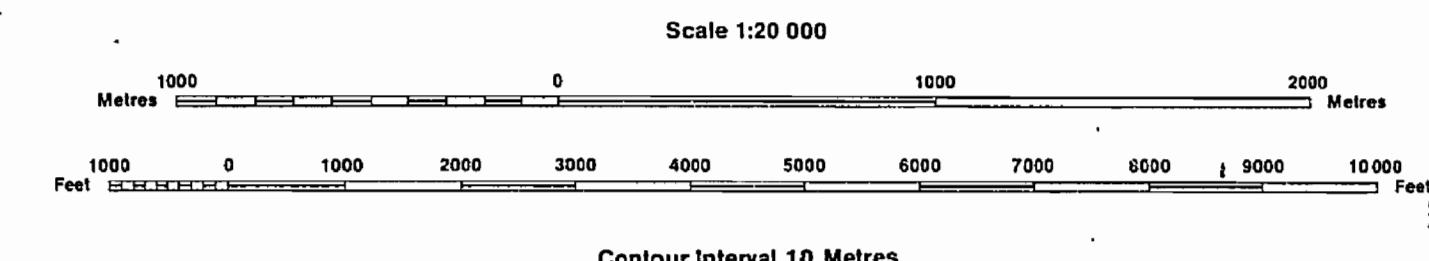

AREAS WITHDRAWN FROM DISPOSITION

MRO - Mining Rights Only
SRO - Surface Rights Only
M+S - Mining and Surface Rights

Description	Order No.	Date	Disposition	File
(1) Sec. 36/80	W.2/84	16/3/84	M+S	188540
(2) Sec. 43/70	W.94/77	6/2/77	SRO	188530

Part of order W 2/84 REOPENED by order
O-ML D/BO NER effective April 3/1990 at 7:00 AM E.S.T.

SYMBOLS

Boundary	Township, Meridian, Baseline.....
Road allowance; surveyed	shoreline.....
Lot/Concession; surveyed	unsurveyed.....
Parcel; surveyed	unsurveyed.....
Right-of-way; road	railway.....
	utility.....
Reservation
Cliff, Pit, Pile
Contour
Interpolated
Approximate
Depression
Control point (horizontal)	△
Flooded land
Mine head frame
Pipeline (above ground)
Railway; single track	double track.....
Road; highway, county, township	abandoned.....
access
trail, bush
Shoreline (original)
Transmission line
Wooded area

NOTES
Subdivision of this Township into Lots and Concessions was
annulled 29th December, 1953.

"THIS MAP SHOWS THE APPROXIMATE LOCATION OF THE BOUNDARIES OF THE AREA WHICH IS THE SUBJECT OF CURRENT LITIGATION. THE EXACT LOCATION WILL BE SHOWN FOLLOWING CONFIRMATION BY THE PARTIES TO THE ACTION"

DISPOSITION OF CROWN LANDS

Patent	Surface & Mining Rights.....
	Surface Rights Only.....
	Mining Rights Only.....
Lease	Surface & Mining Rights.....
	Surface Rights Only.....
	Mining Rights Only.....
Licence of Occupation
Order-in-Council	OC
Cancelled
Reservation
Sand & Gravel

THE INFORMATION THAT APPEARS ON THIS MAP HAS BEEN COMPILED FROM VARIOUS SOURCES, AND ACCURACY IS NOT GUARANTEED. THOSE WISHING TO STAKE A CLAIM SHOULD CONSULT WITH THE MINING RECORDER, MINISTRY OF NORTHERN DEVELOPMENT AND MINES, FOR ADDITIONAL INFORMATION ON THE STATUS OF THE LANDS SHOWN HEREON.

The disposition of land, location of lot fabric and parcel boundaries on this index was compiled for administrative purposes only.



Ministry of Natural Resources

INDEX TO LAND DISPOSITION

PLAN

G-2907

TOWNSHIP

JANES

**N.R. ADMINISTRATIVE DISTRICT
NORTH BAY
NING DIVISION
UDBURY
ND TITLES/REGISTRY DIVISION
UDBURY**

1:20 000

1000 2000 Metres

5000 6000 7000 8000 9000 10 000 Feet

Interval 10 metres

AREAS WITHDRAWN FROM DISPOSITION

RO - Mining Rights Only





PRO - Surface Rights Only

FS = Mining and Surface Rights

Description	Order No.	Date	Disposition	File
C-35/90	0-3-9/95	04/04/95	M & S	195150
-36/90	W-2-94	+6/3/94	M-S	+005440

Part of order W 2184 REOPENED by order
O-ML CH/90 NER effective April 3, 1990 at 7:00 AM EST

SYMBOLS

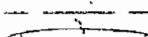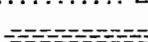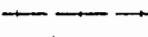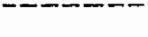Boundary	
Township, Meridian, Baseline.....	_____
Road allowance; surveyed.....	_____
shoreline.....	
Lot/Concession; surveyed.....	_____
unsurveyed	_____ - - -
Parcel; surveyed	_____
unsurveyed	-----
Right-of-way; road	=====
railway	=====
utility.....	===== . . .
Reservation	*****
Cliff, Pit, Pile	-----
Contour	----- 20 -----
Interpolated	-----
Approximate	-----
Depression.....	
Control point (horizontal)	△
Flooded land:	
Mine head frame	□
Pipeline (above ground)	-----
Railway; single track.....	=====
double track.....	===== ++ =====
abandoned:.....	===== - - -
Road; highway, county, township	=====
access	===== - - - -
trail, bush	-----
Shoreline (original).....	
Transmission line	----- . . .
Wooded area	

NOTES

DATE OF ISSUE

17 1998
PROVINCIAL RECORDING
OFFICE - SUPPLY

DISPOSITION OF CROWN LANDS.

Patent

- Surface & Mining Rights
- Surface Rights Only
- Mining Rights Only

Lease

- Surface & Mining Rights
- Surface Rights Only
- Mining Rights Only

Licence of Occupation

Order-in-Council

Cancelled

Reservation

Sand & Gravel

THE INFORMATION THAT APPEARS ON THIS MAP HAS BEEN COMPILED FROM VARIOUS SOURCES, AND ACCURACY IS NOT GUARANTEED. THOSE WISHING TO STAKE MINING CLAIMS SHOULD CONSULT WITH THE MINING RECORDER, MINISTRY OF NORTHERN DEVELOPMENT AND MINES, FOR ADDITIONAL INFORMATION ON THE STATUS OF THE LANDS SHOWN HEREON.



Ministry of
Natural
Resources
Ontario

INDEX TO LAND DISPOSITION

PLAN

G-2907


TOWNSHIP

DATE OF ISSUE

DEC 11 1997

PROVINCIAL RECORDING
OFFICE - SUDBURY

M.N.R. ADMINISTRATIVE DISTRICT
NORTH BAY
MINING DIVISION
SUDBURY
LAND TITLES/REGISTRY DIVISION
SUDBURY

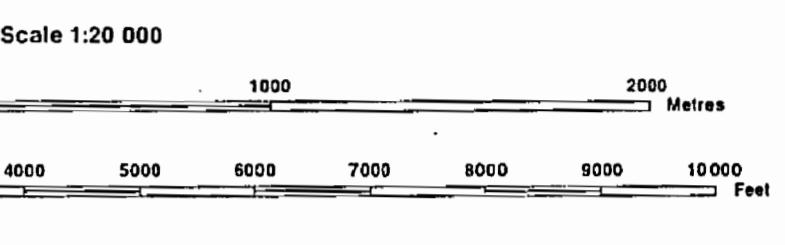

AREAS WITHDRAWN FROM DISPOSITION

MRO - Mining Rights Only
SRO - Surface Rights Only
MFS - Mining and Surface Rights

Description	Order No.	Date	Disposition	File
SEC.35/80	O-3-9/88	04/04/88	M & S	19550
Sec.43/80	W-2/84	04/04/84	M & S	19654-0
Sec.43/70	W.94/77	06/2/77	SRO	188530

Part of order W 2/84 RESPENDED by order
O-M. O/90 NER effective April 3/90 at 7:00 AM E.A.T.

SYMBOLS

- Boundary
 - Township, Meridian, Baseline
 - Road allowance; surveyed.....
 - shoreline.....
- Lot/Concession; surveyed.....
- Parcel; surveyed.....
- Right-of-way; road.....
- railway.....
- utility.....
- Reservation.....
- Cliff, Pit, Pile.....
- Contour.....
- Interpolated.....
- Approximate.....
- Depression.....
- Control point (horizontal).....
- Flooded land.....
- Mine head frame.....
- Pipeline (above ground).....
- Railway; single track.....
- double track.....
- abandoned.....
- Road; highway, county, township.....
- access.....
- trail, bush.....
- Shoreline (original).....
- Transmission line.....
- Wooded area.....

JUNE 1ST OPENINGS 1997 S.126334 ETAL


QUARRY PERMITS

DESCRIPTION	FILE NO.	ISSUE DATE	EXPIRATION DATE
-------------	----------	------------	-----------------

DISPOSITION OF CROWN LANDS

- Patent
 - Surface & Mining Rights
 - Surface Rights Only
 - Mining Rights Only
- Lease
 - Surface & Mining Rights
 - Surface Rights Only
 - Mining Rights Only
- Licence of Occupation
- Order-in-Council
- Cancelled
- Reservation
- Sand & Gravel

THE INFORMATION THAT APPEARS ON THIS MAP HAS BEEN COMPILED FROM VARIOUS SOURCES AND ACCURACY IS NOT GUARANTEED. THOSE WISHING TO STAKE MINING CLAIMS SHOULD CONSULT WITH THE RECORDING RECORDER, MINISTRY OF NORTHERN DEVELOPMENT AND MINES, FOR ADDITIONAL INFORMATION ON THE STATUS OF THE LANDS SHOWN HEREON.

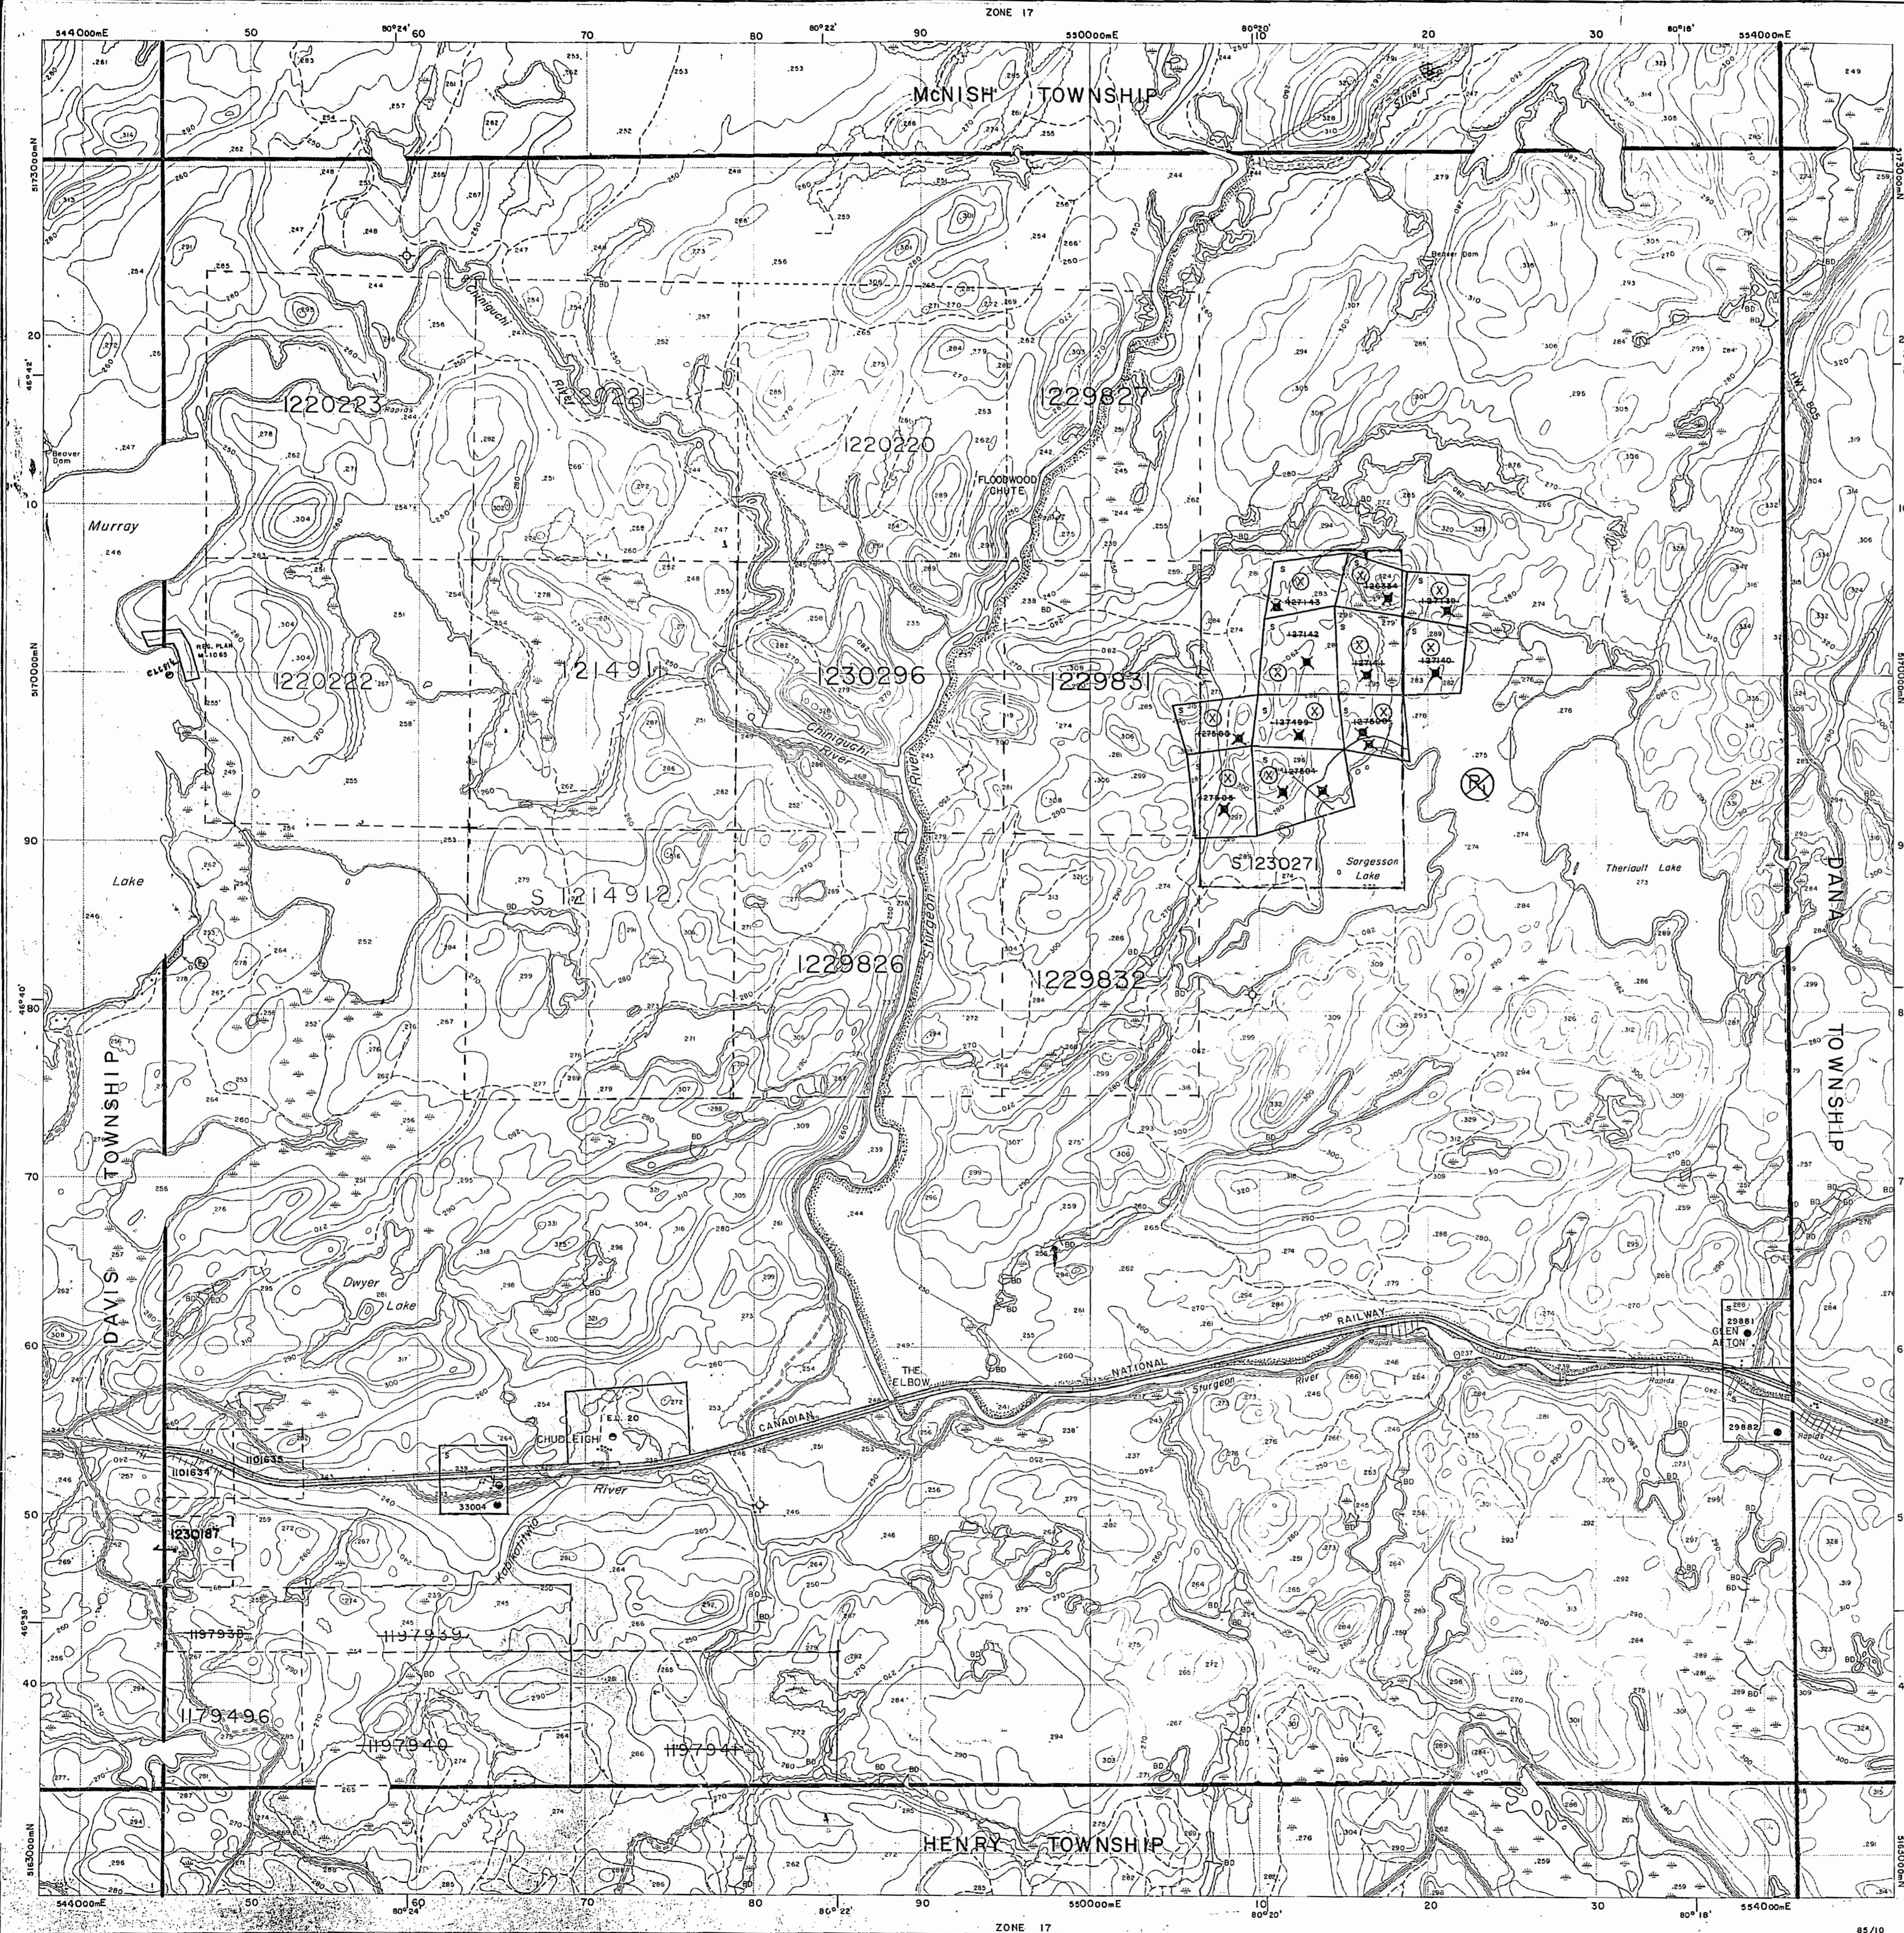

Davis Twp.

McNish Twp.

100

THE TOWNSHIP
OF
JANES

DISTRICT OF
SUDBURY

SUDBURY MINING DIVISION

SCALE : 1 INCH = 40 CHAINS


LEGEND

- PATENTED LAND
CROWN LAND SALE
LEASES
LOCATED LAND
LICENSE OF OCCUPATION
MINING RIGHTS ONLY
SURFACE RIGHTS ONLY
ROADS
IMPROVED ROADS
KING'S HIGHWAYS
RAILWAYS
POWER LINES
MARSH OR MUSKEG
MINES

NOTES

Mining Claims Accepted Under The
Provision Of Section 53 Of The
Mining Act.

400' Reserve to Dept. of Lands & Forests
Should thus ~~remain~~

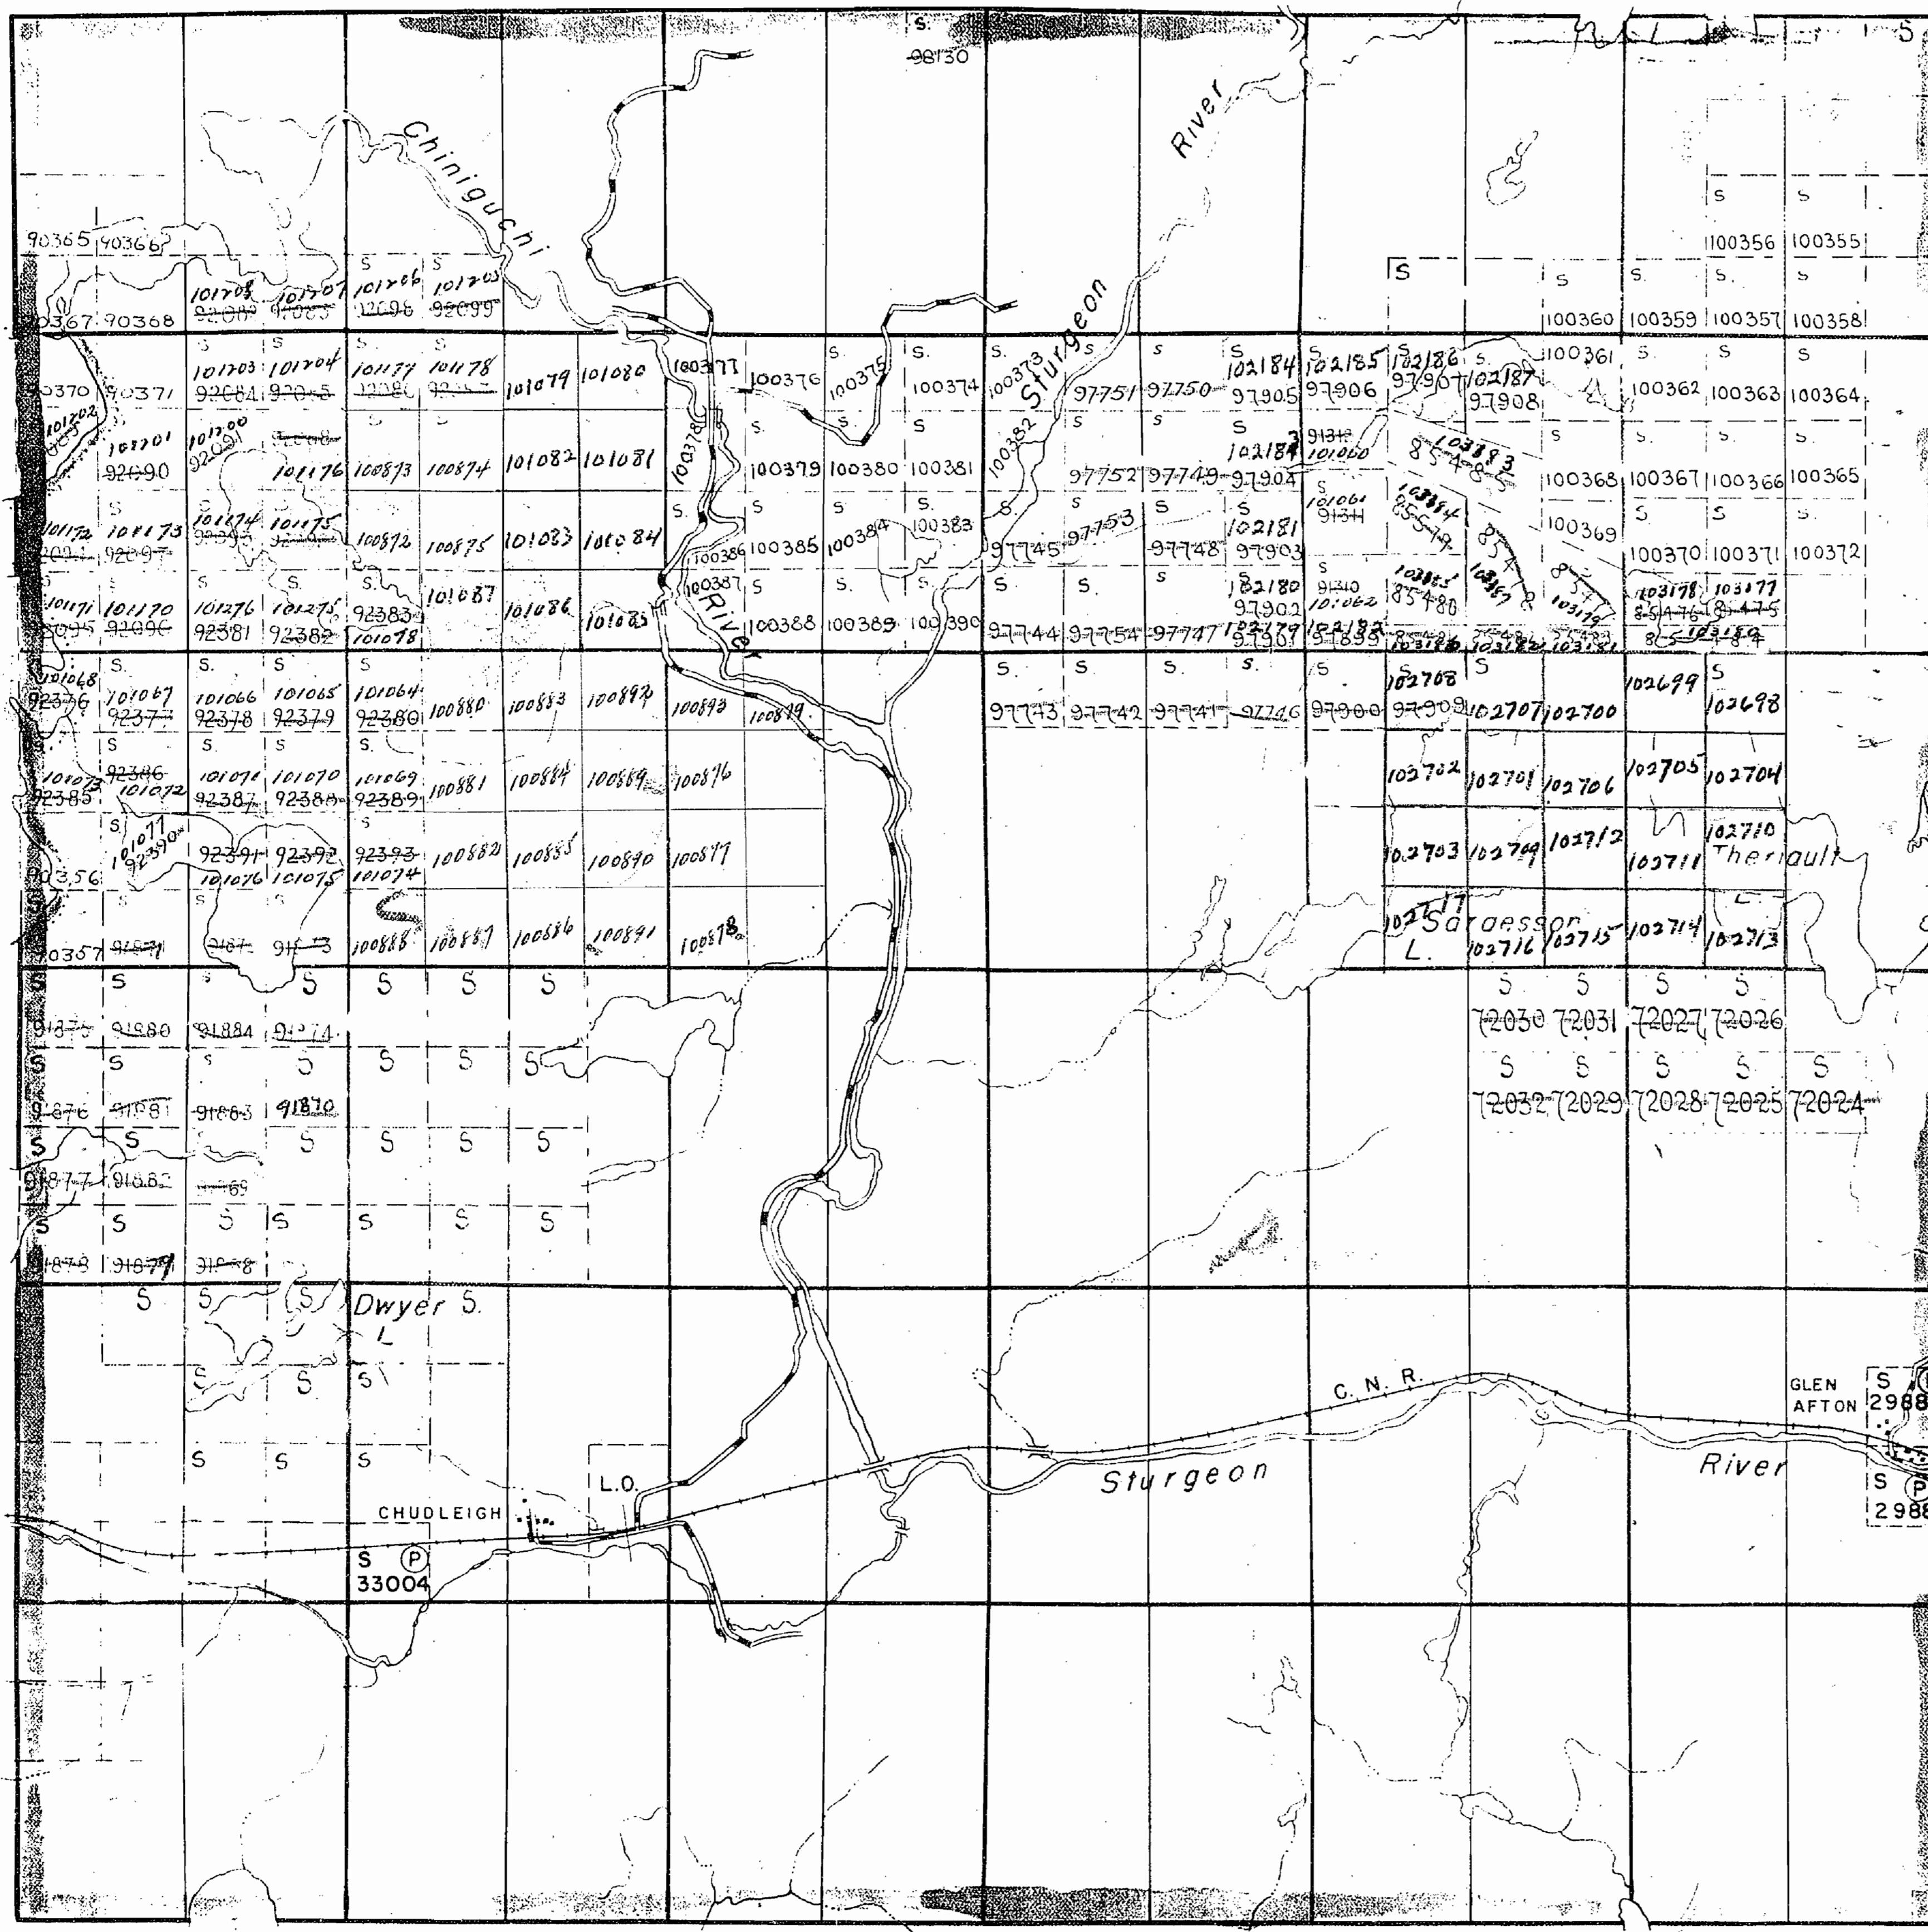


Henry Twp.

PLAN NO.- M-955

DEPARTMENT OF MINES
—ONTARIO—

955

McNish Twp.

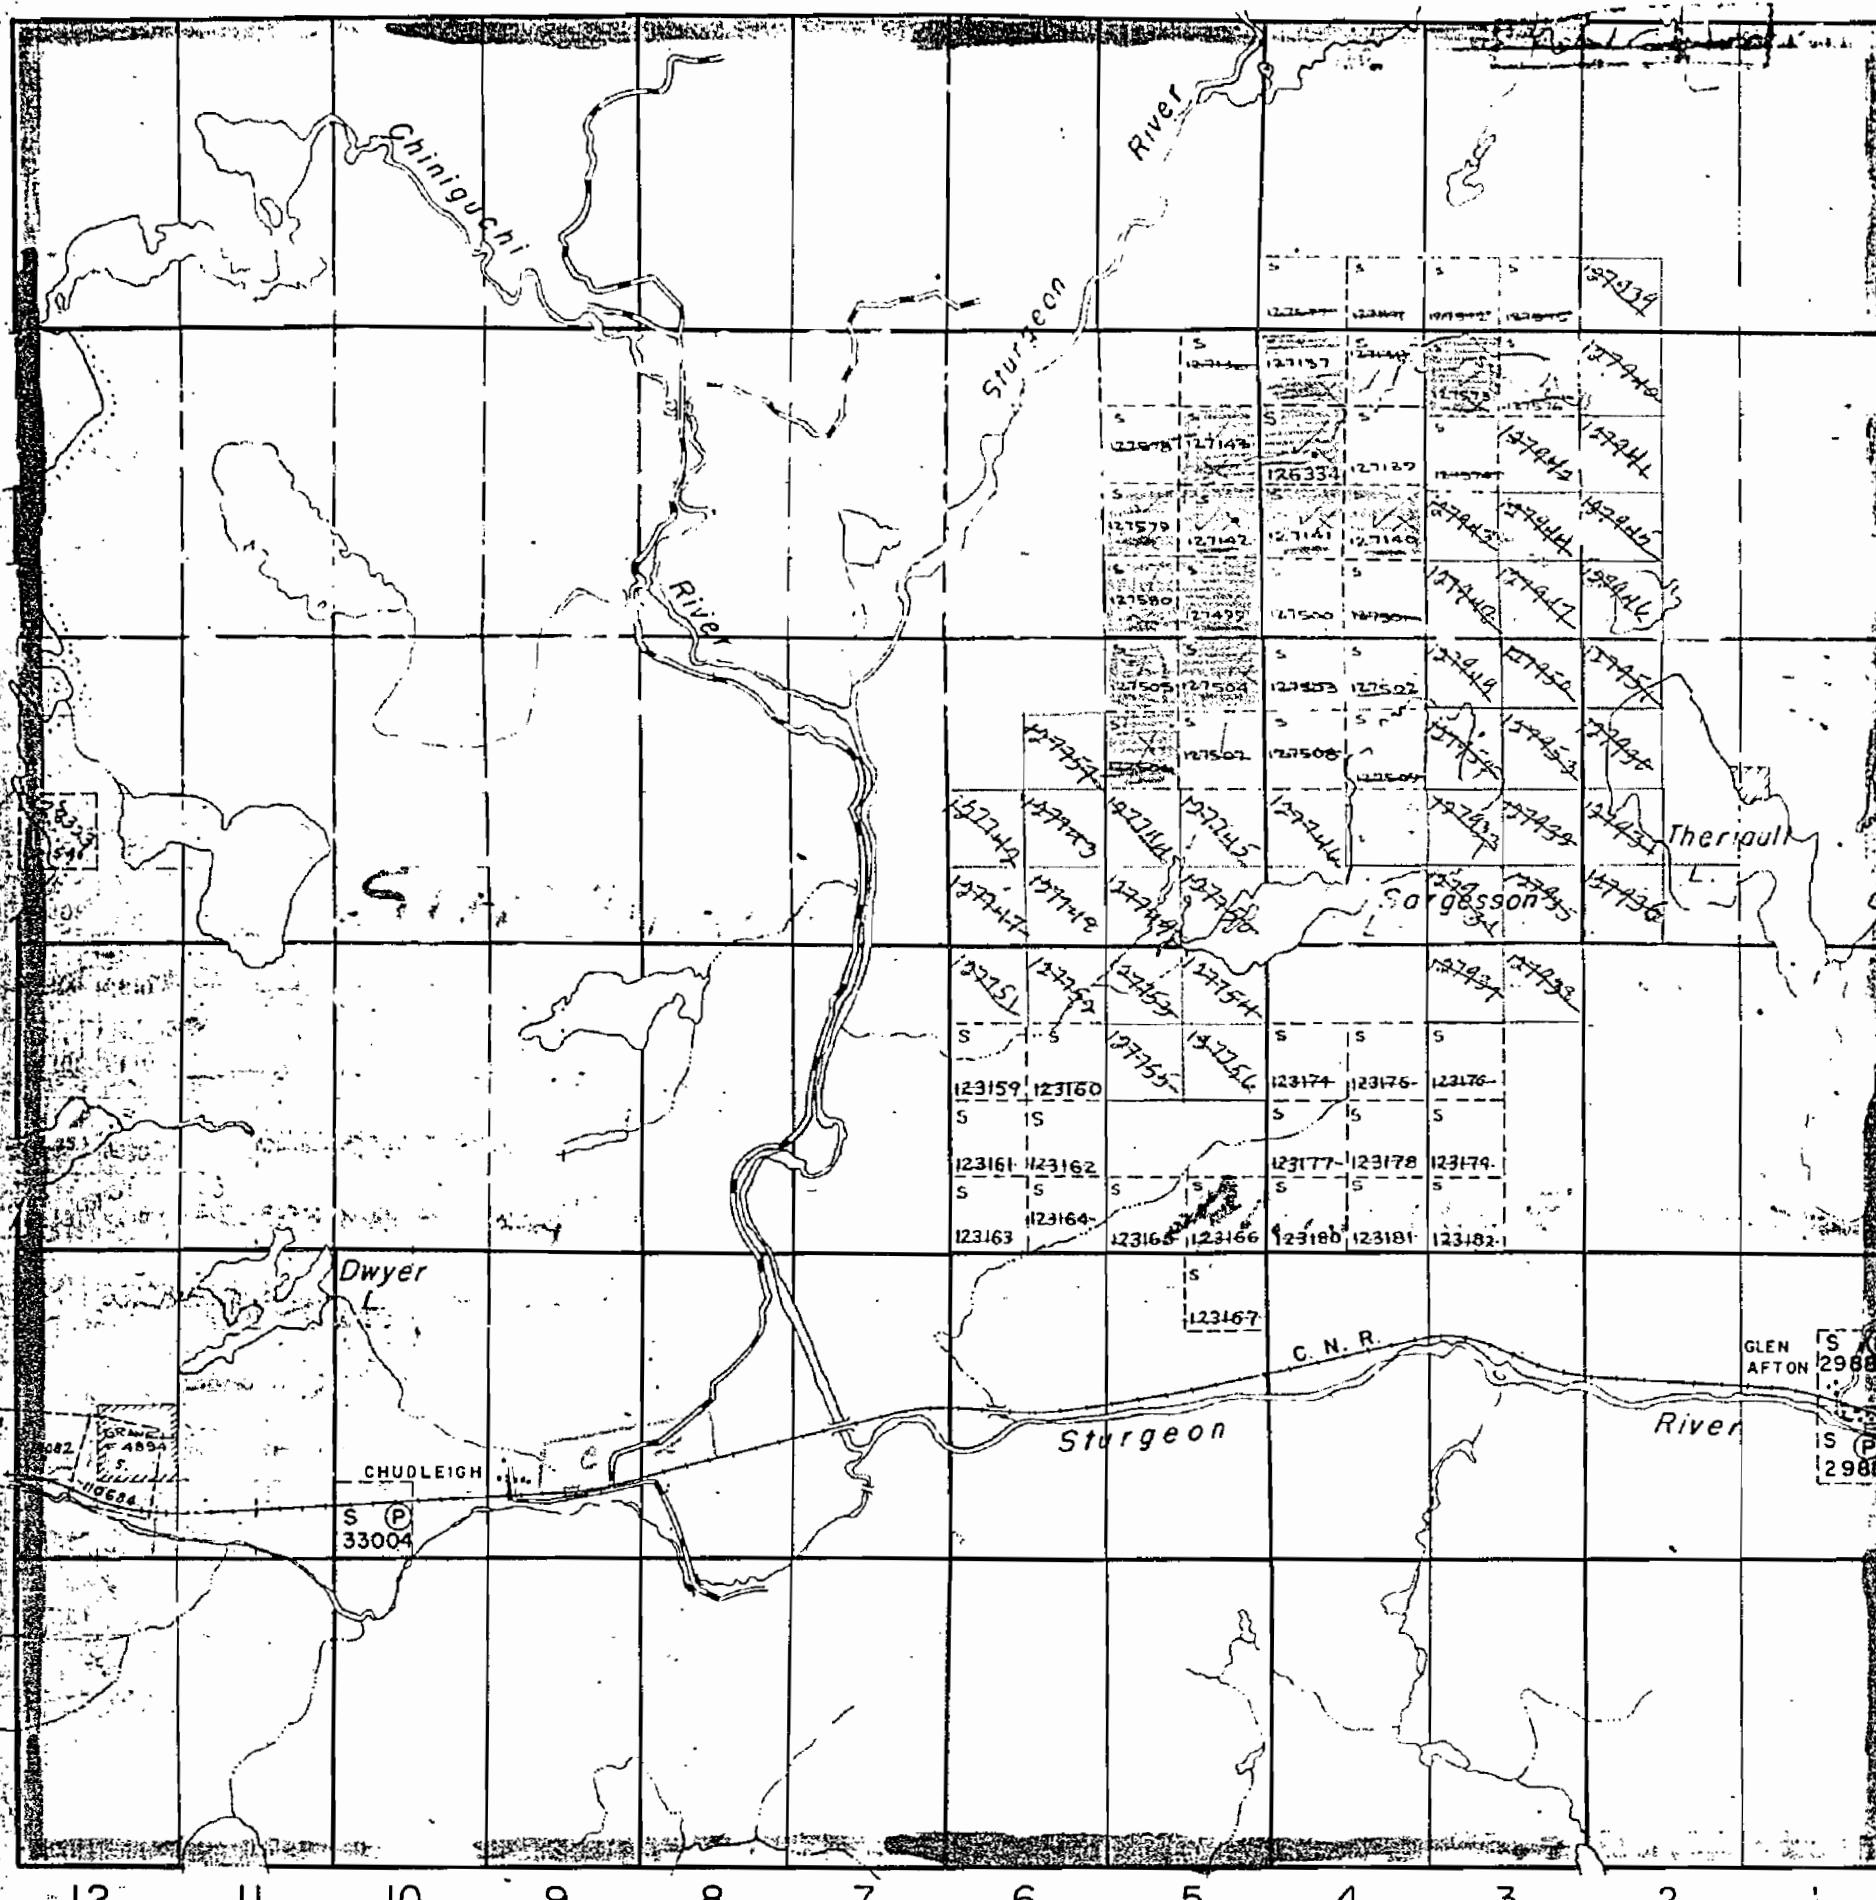

Henry Twp.

THE TOWNSHIP
OF**JANES**DISTRICT OF
SUDBURYSUDBURY
MINING DIVISION

SCALE: 1-INCH=40 CHAINS

LEGENDPATENTED LAND
CROWN LAND SALE
LEASESLOCATED LAND
LICENSE OF OCCUPATIONMINING RIGHTS ONLY
SURFACE RIGHTS ONLYROADS
IMPROVED ROADS

KING'S HIGHWAYS

RAILWAYS

POWER LINES

MARSH OR MUSKEG

MINES

(P)
C.S.(O)
Loc.(L.O.)
M.R.O.(S.R.O.)
S.R.O.NOTES

Mining Claims Accepted Under The
Provision Of Section 53 Of The
Mining Act.

400' Surface Rights Reservation around
all Lakes and Rivers

Surface Rights Only reserved to the Dept of Lands
& Forests under Sec 39 (d) Mining Act shown
thus

PLAN NO.- M-955

DEPARTMENT OF MINES
—ONTARIO—

955

McNish Twp. (M-1020)

Davis Twp. (M-748)

Henry Twp. (M-929)

THE TOWNSHIP
OF

JANES

DISTRICT OF
SUDBURY

SUDBURY
MINING DIVISION

SCALE: 1-INCH = 40 CHAINS

LEGEND

PATENTED LAND	(P)
CROWN LAND SALE	C.S.
LEASES	(L)
LOCATED LAND	LOC.
LICENSE OF OCCUPATION	L.O.
MINING RIGHTS ONLY	M.R.O.
SURFACE RIGHTS ONLY	S.R.O.
ROADS	<hr/> <hr/>
IMPROVED ROADS	<hr/> <hr/>
KING'S HIGHWAYS	<hr/> <hr/>
RAILWAYS	<hr/> <hr/>
POWER LINES	<hr/> <hr/>
MARSH OR MUSKEG	
MINES	
CANCELLED	C.

NOTES

400' Surface Rights Reservation
around all Lakes and Rivers.

Surface Rights Only reserved to the
Dept. of Lands & Forests under
Sec. 39(d) of the Mining Act shown
thus:

This Township has been Annulled
Dec 29, 1953.

RECEIVED
LIBRARY

OCT 30 1972

7.8 - 10.3 - 13.9 2.4 E.C.

Digitized by srujanika@gmail.com

BLANKET QUARRY PERMIT
#6301 COVERING PART
OF JAMES TOWNSHIP.

BLANKET QUARRY PERMIT #7151
EXPIRING 2000-07-31

COVERING PART OF JANE'S TWR.
JANE'S

JANES

PLAN NO. M.955

**ONTARIO
DEPARTMENT OF MINES
AND NORTHERN AFFAIRS**

955


JANES

SUDBURY DISTRICT

— Scale 40 chains to 1 inch —

1 Res.

200

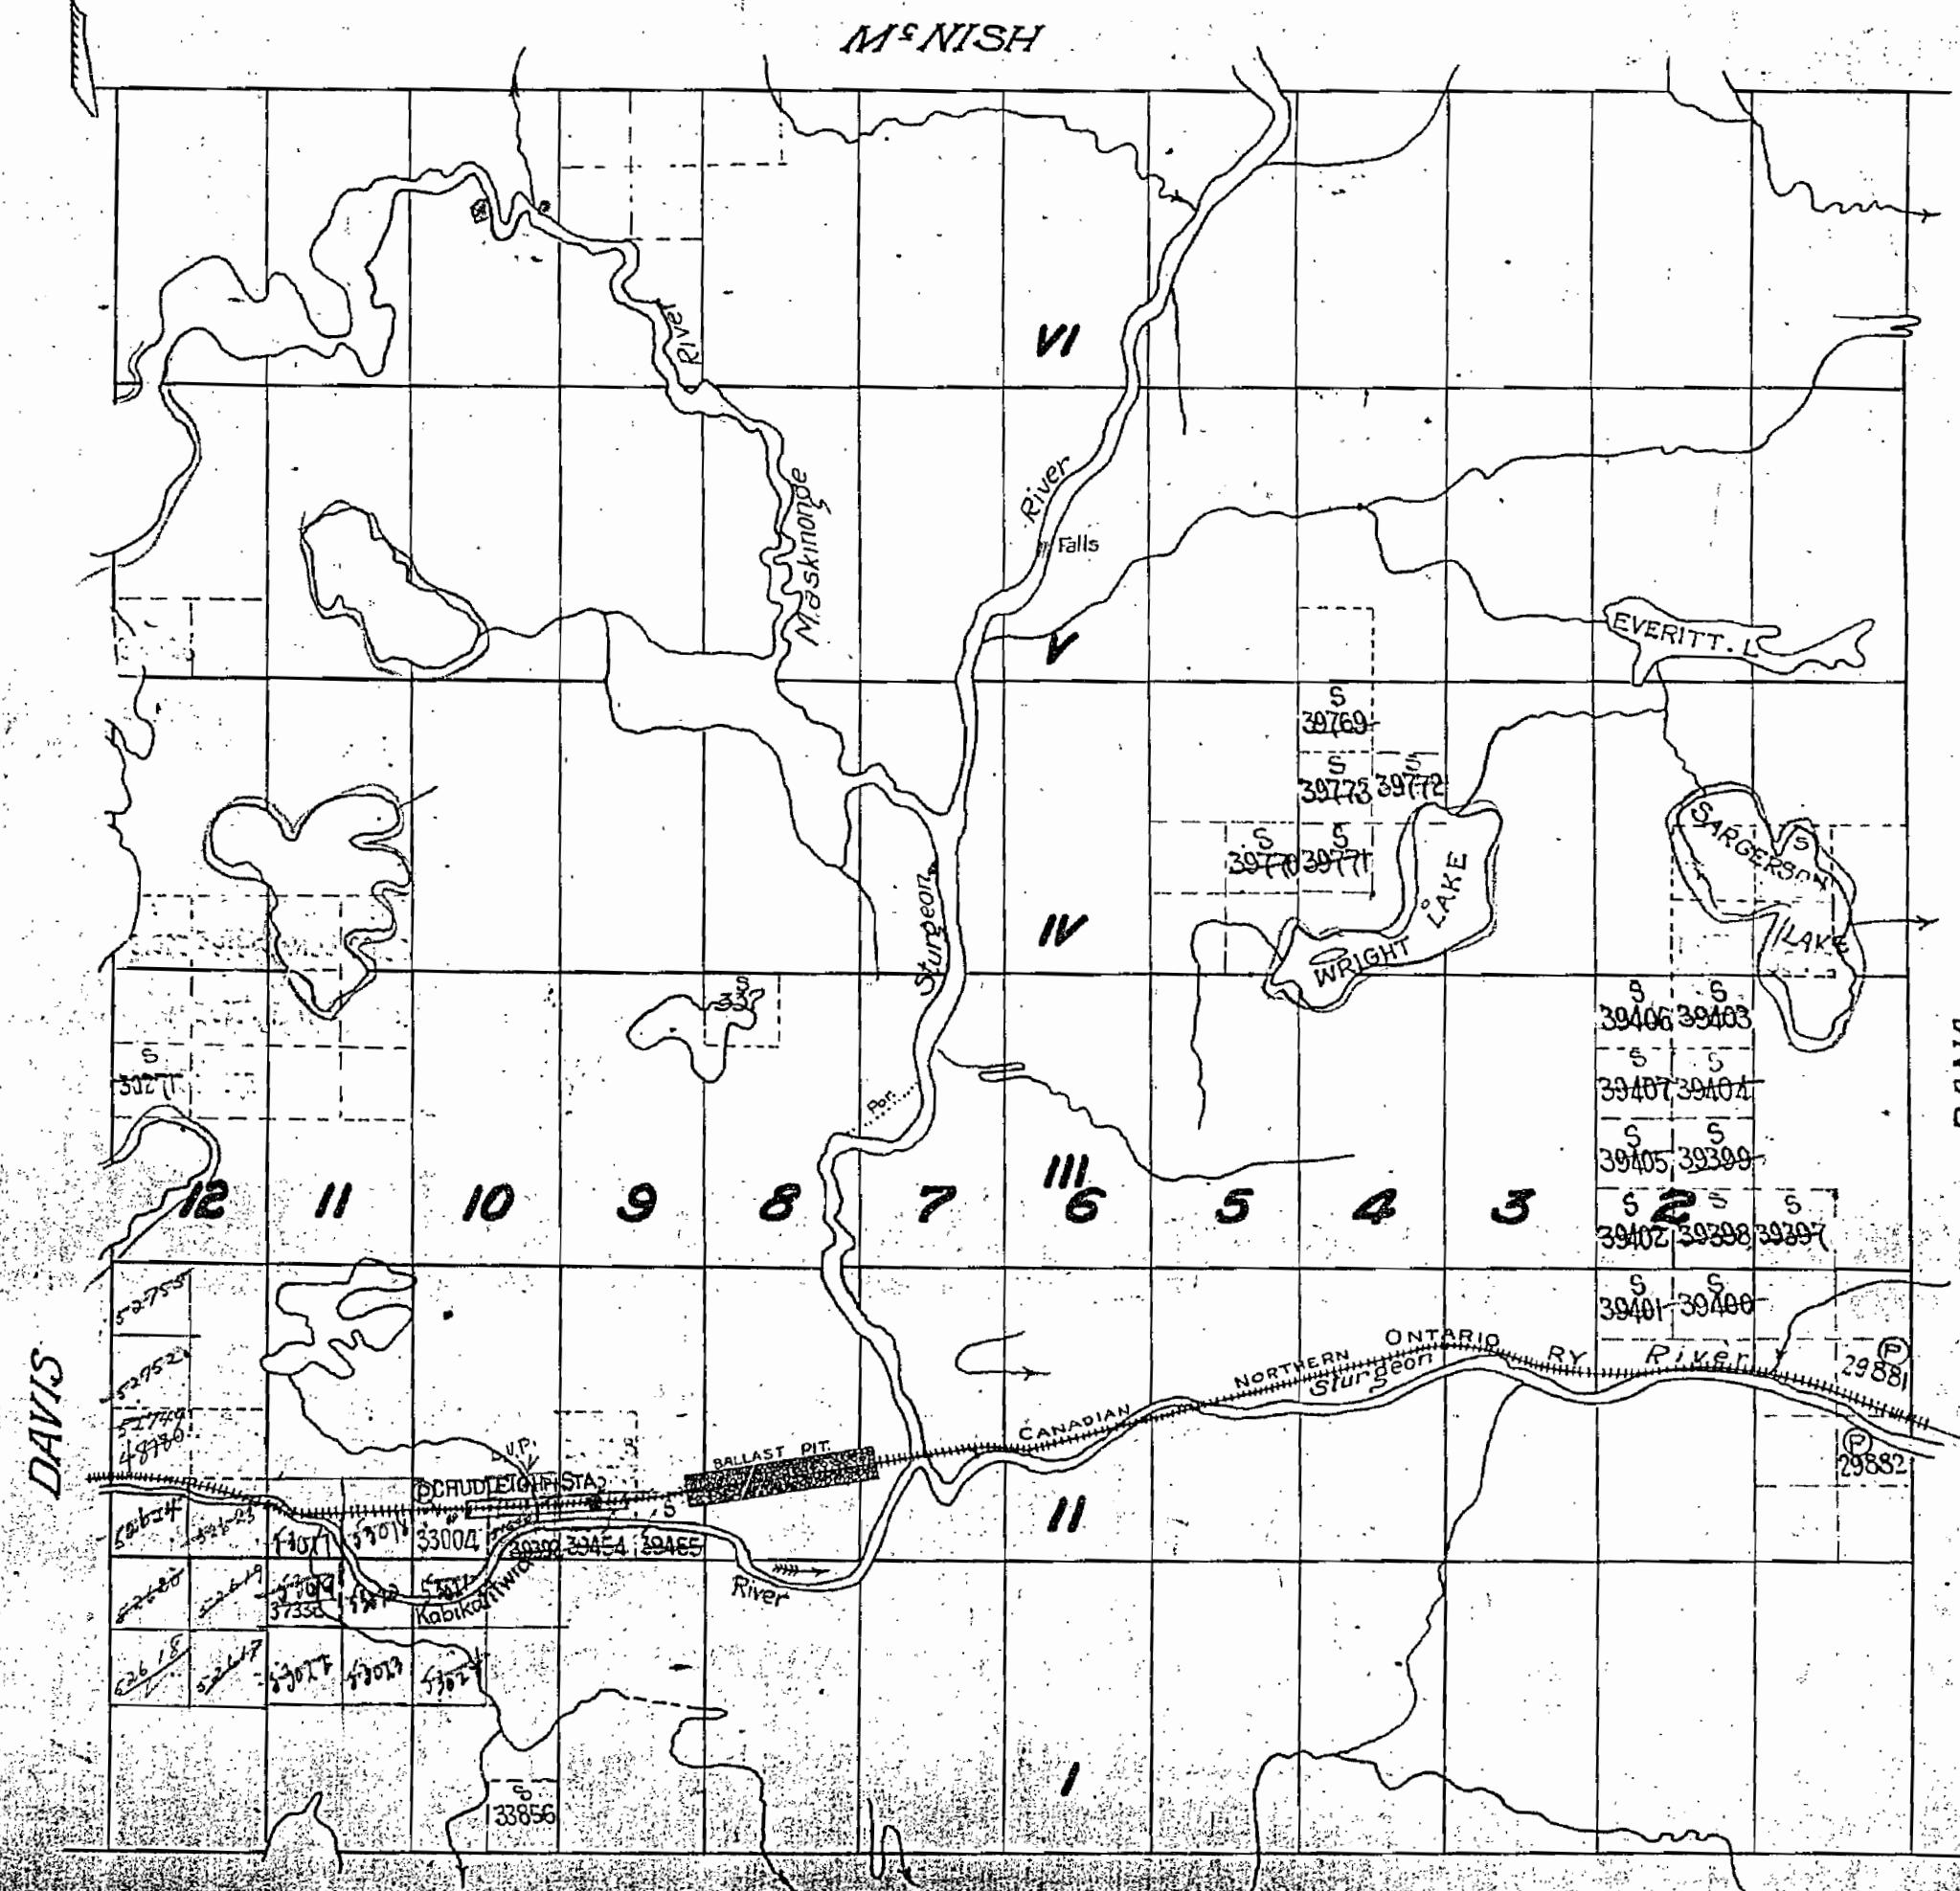


HENRY

M955

955

McNish Twp. (M-1020)

Davis Twp. (M-748)

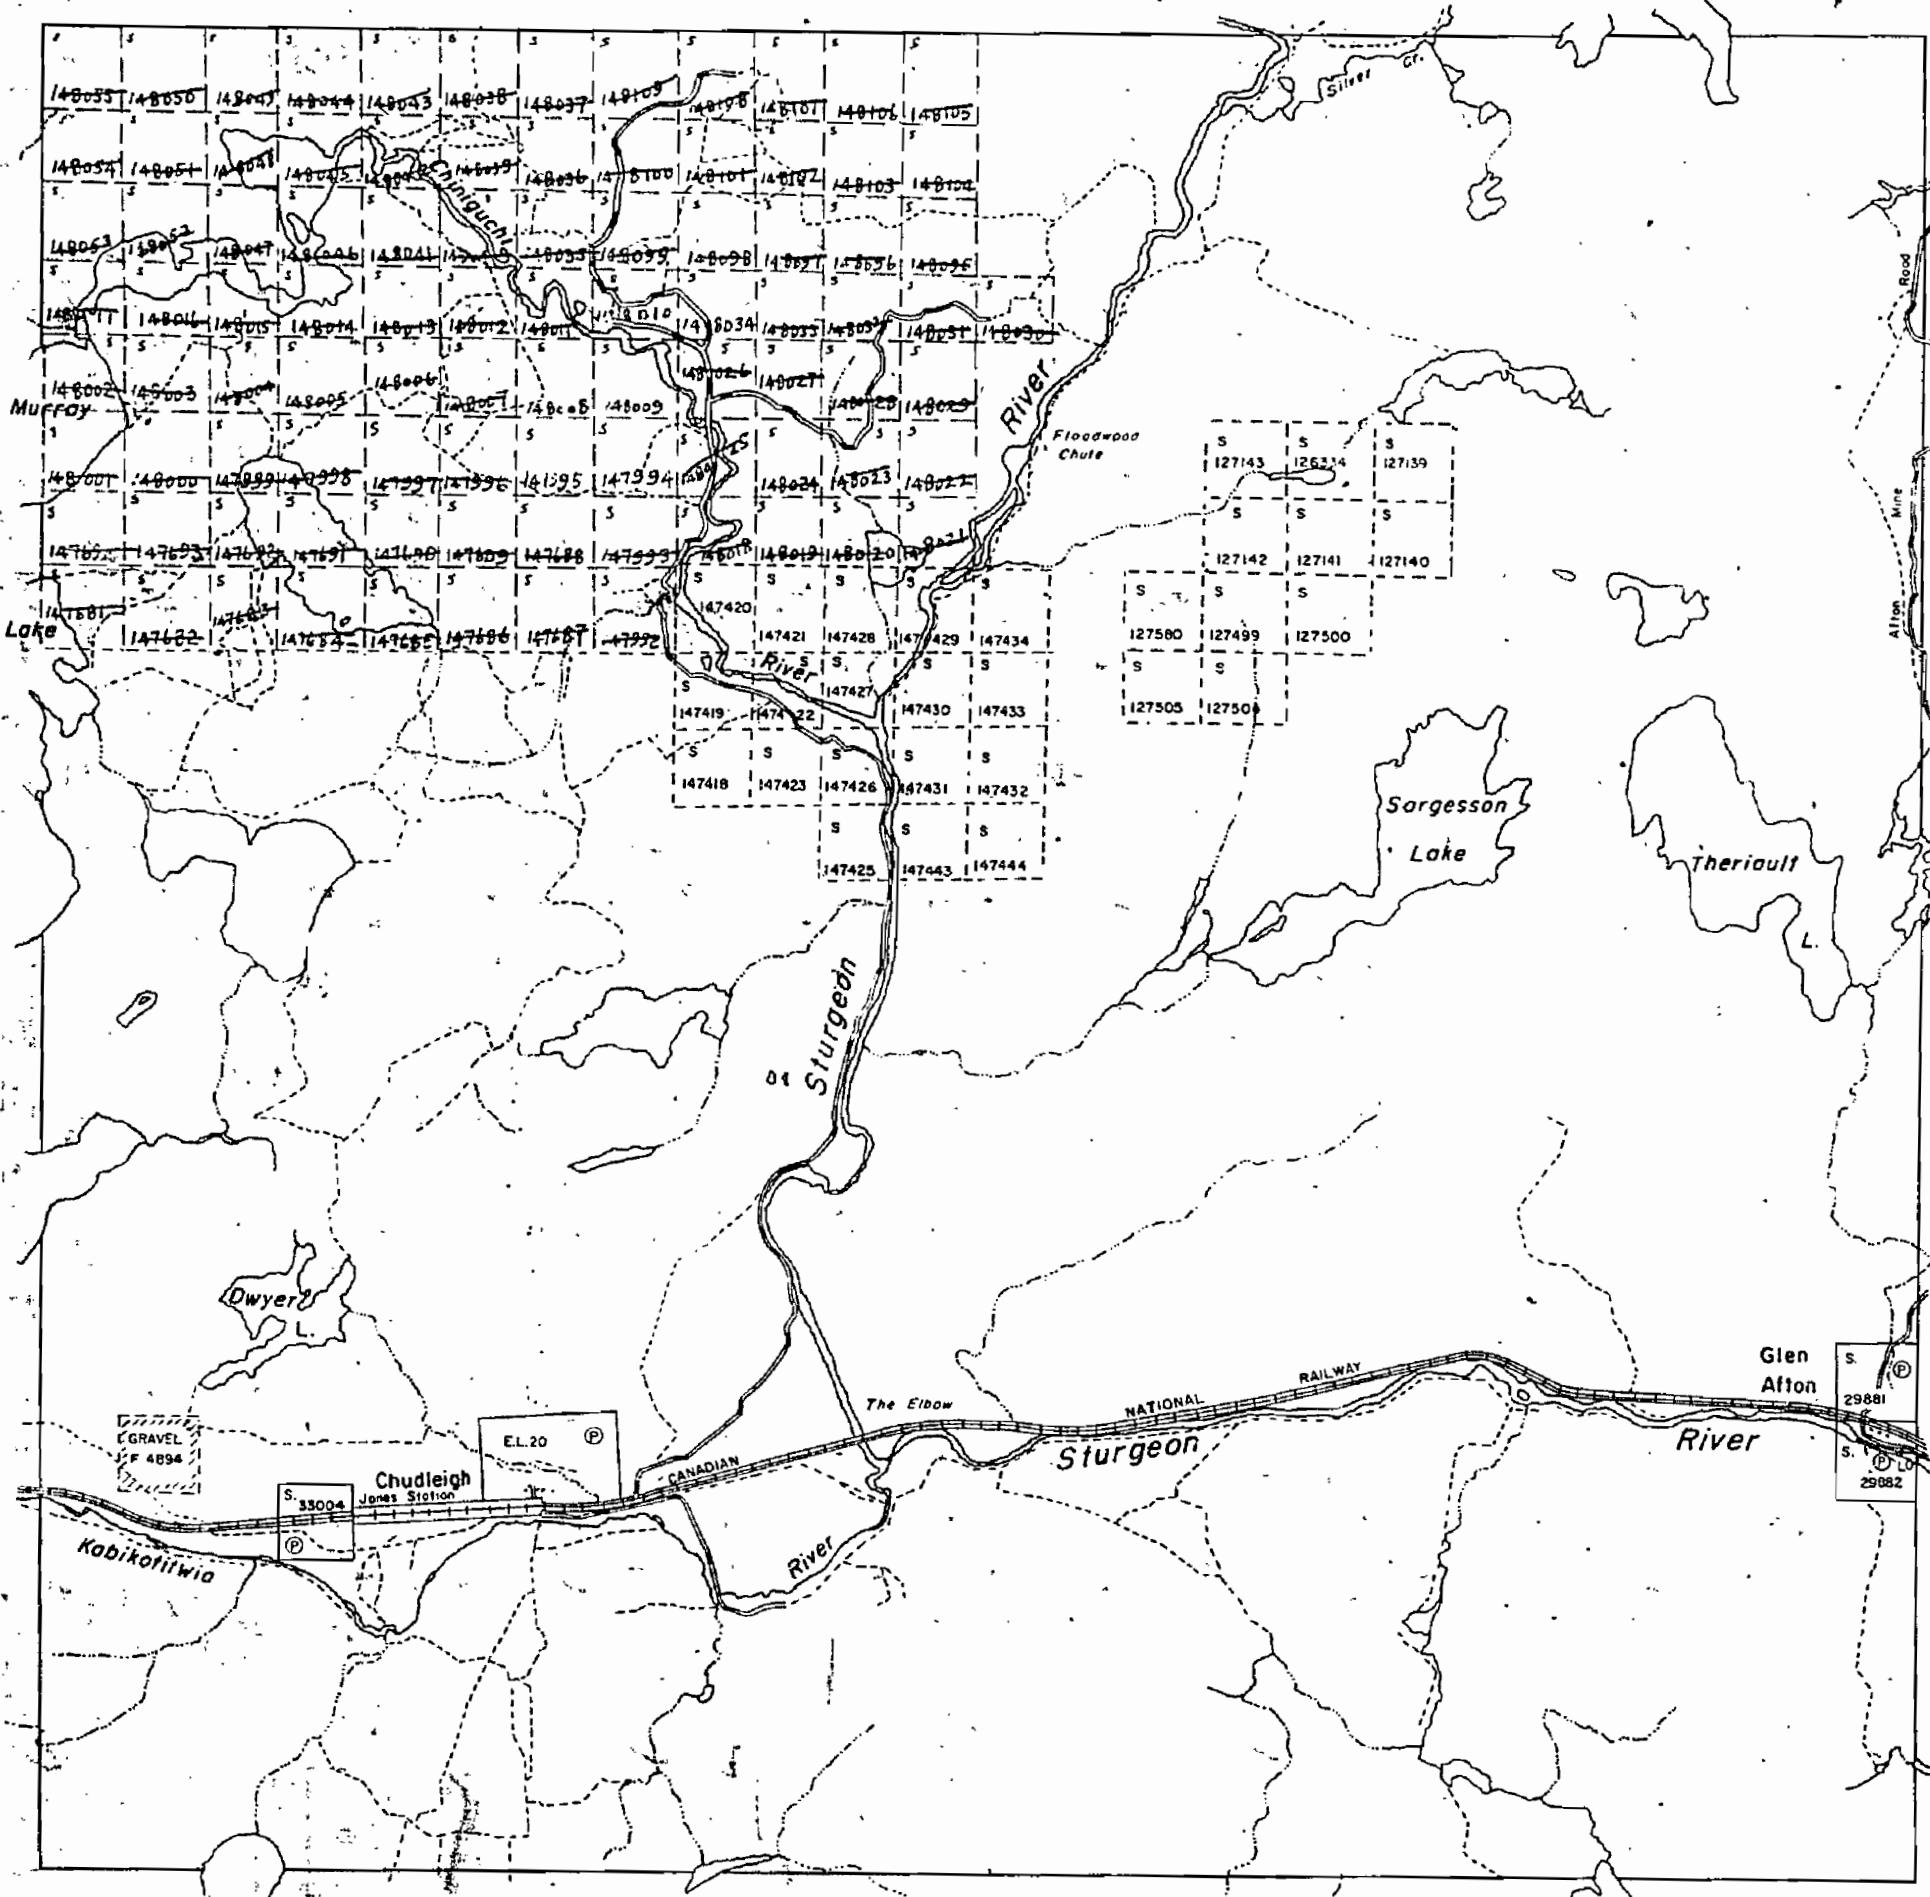

Henry Twp. (M-929)

THE TOWNSHIP
OF


JANES'

DISTRICT OF
SUDBURYSUDBURY
MINING DIVISION

SCALE: 1-INCH = 40 CHAINS

LEGEND

- (P) PATENTED LAND
- (C.S.) CROWN LAND SALE
- (L.) LEASES
- (LOC.) LOCATED LAND
- (LO.) LICENSE OF OCCUPATION
- (M.R.O.) MINING RIGHTS ONLY
- (S.R.O.) SURFACE RIGHTS ONLY
- ROADS
- IMPROVED ROADS
- KING'S HIGHWAYS
- RAILWAYS
- POWER LINES
- MARSH OR MUSKEG
- MINES
- CANCELLED

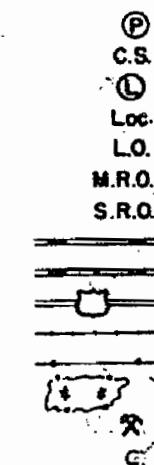

Dana Twp. (M-747)

NOTES

400' Surface Rights Reservation
around gff Lakes and Rivers.Surface Rights Only reserved to the
Dept. of Lands & Forests under
Sec. 39 (d) of the Mining Act shown
thus: This Township has been Annullled
Dec. 29, 1953.


PLAN NO. M.955

ONTARIO
DEPARTMENT OF MINES
AND NORTHERN AFFAIRS

955

McNish Twp. (M-1020

Davis Twp. (M-748)

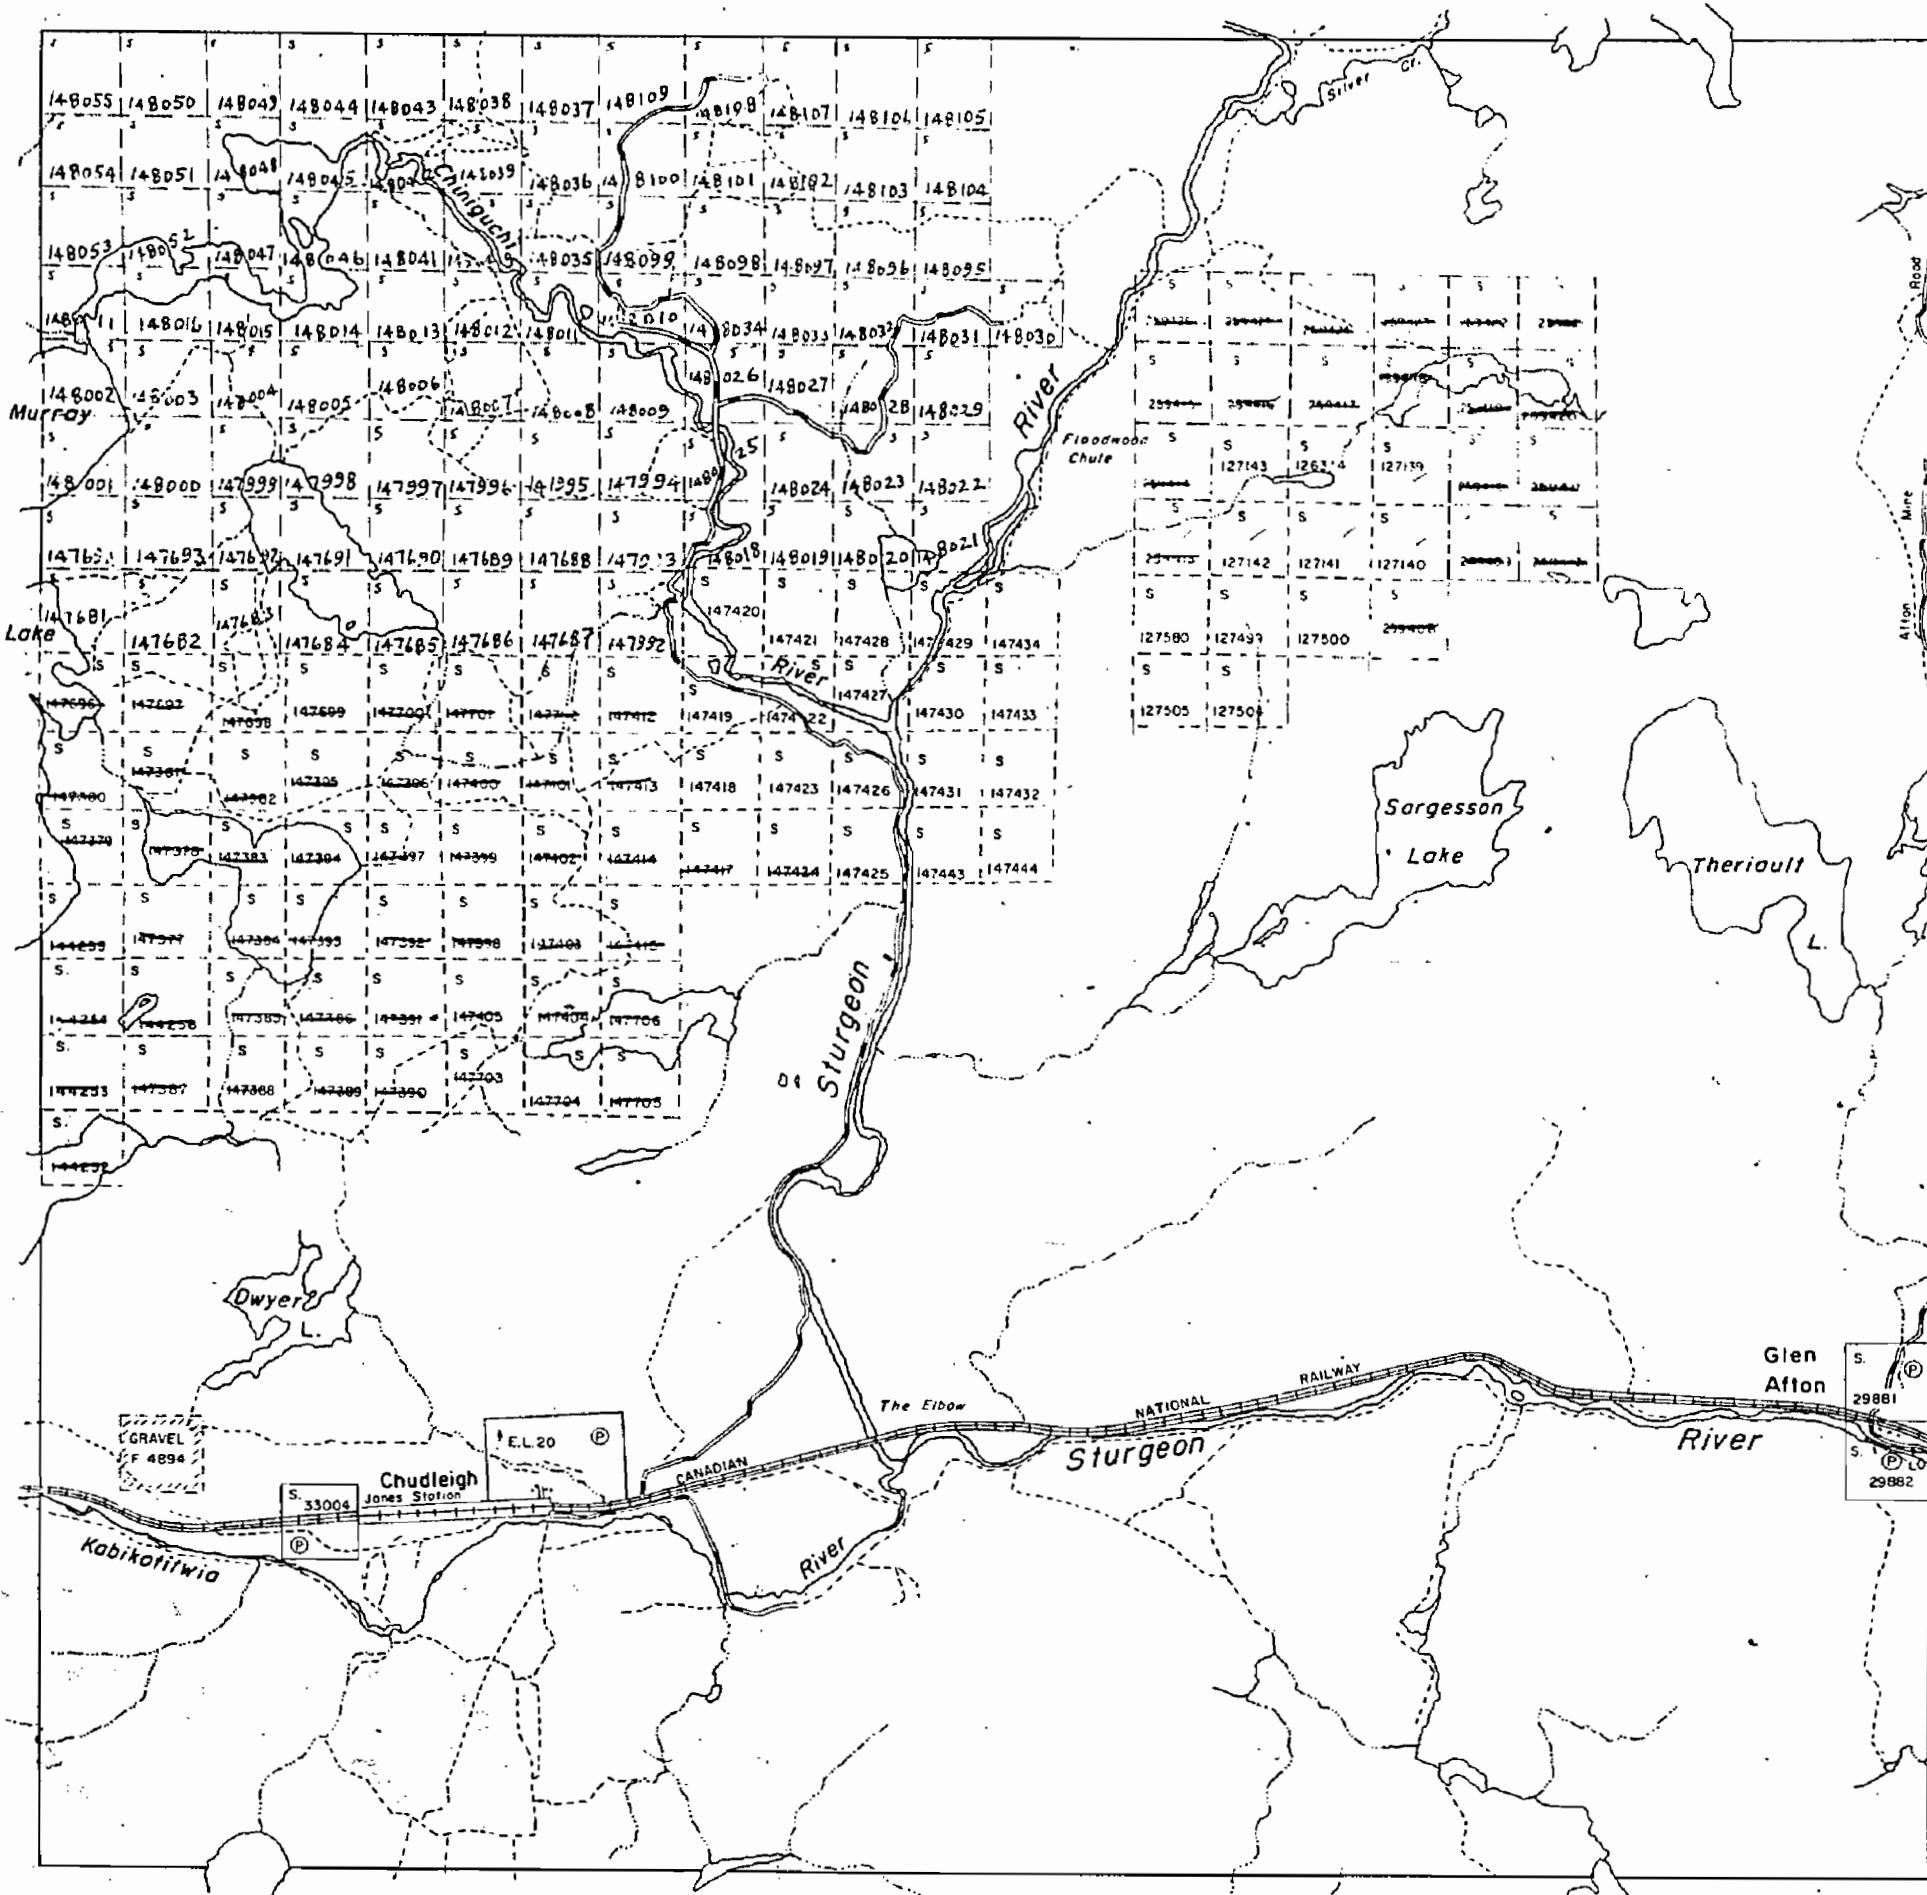

Henry Twp. (M-929)

THE TOWNSHIP
OF

JANES

DISTRICT OF
SUDBURY

SUDBURY
MINING DIVISION

SCALE: 1-INCH = 40 CHAINS

LEGEND

PATENTED LAND	(P)
CROWN LAND SALE	C.S.
LEASES	(L)
LOCATED LAND	Loc.
LICENSE OF OCCUPATION	L.O.
MINING RIGHTS ONLY	M.R.O.
SURFACE RIGHTS ONLY	S.R.O.
ROADS	
IMPROVED ROADS	
KING'S HIGHWAYS	
RAILWAYS	
POWER LINES	
MARSH OR MUSKEG	
MINES	
CANCELLED	C.

NOTES

400' Surface Rights Reservation
around all Lakes and Rivers.


Surface Rights Only reserved to the
Dept. of Lands & Forests under
Sec. 39(d) of the Mining Act shown
thus:--

This Township has been Annulled
Dec. 29, 1953.

PLAN NO. M.955

**ONTARIO
DEPARTMENT OF MINES
AND NORTHERN AFFAIRS**

McNish Twp.

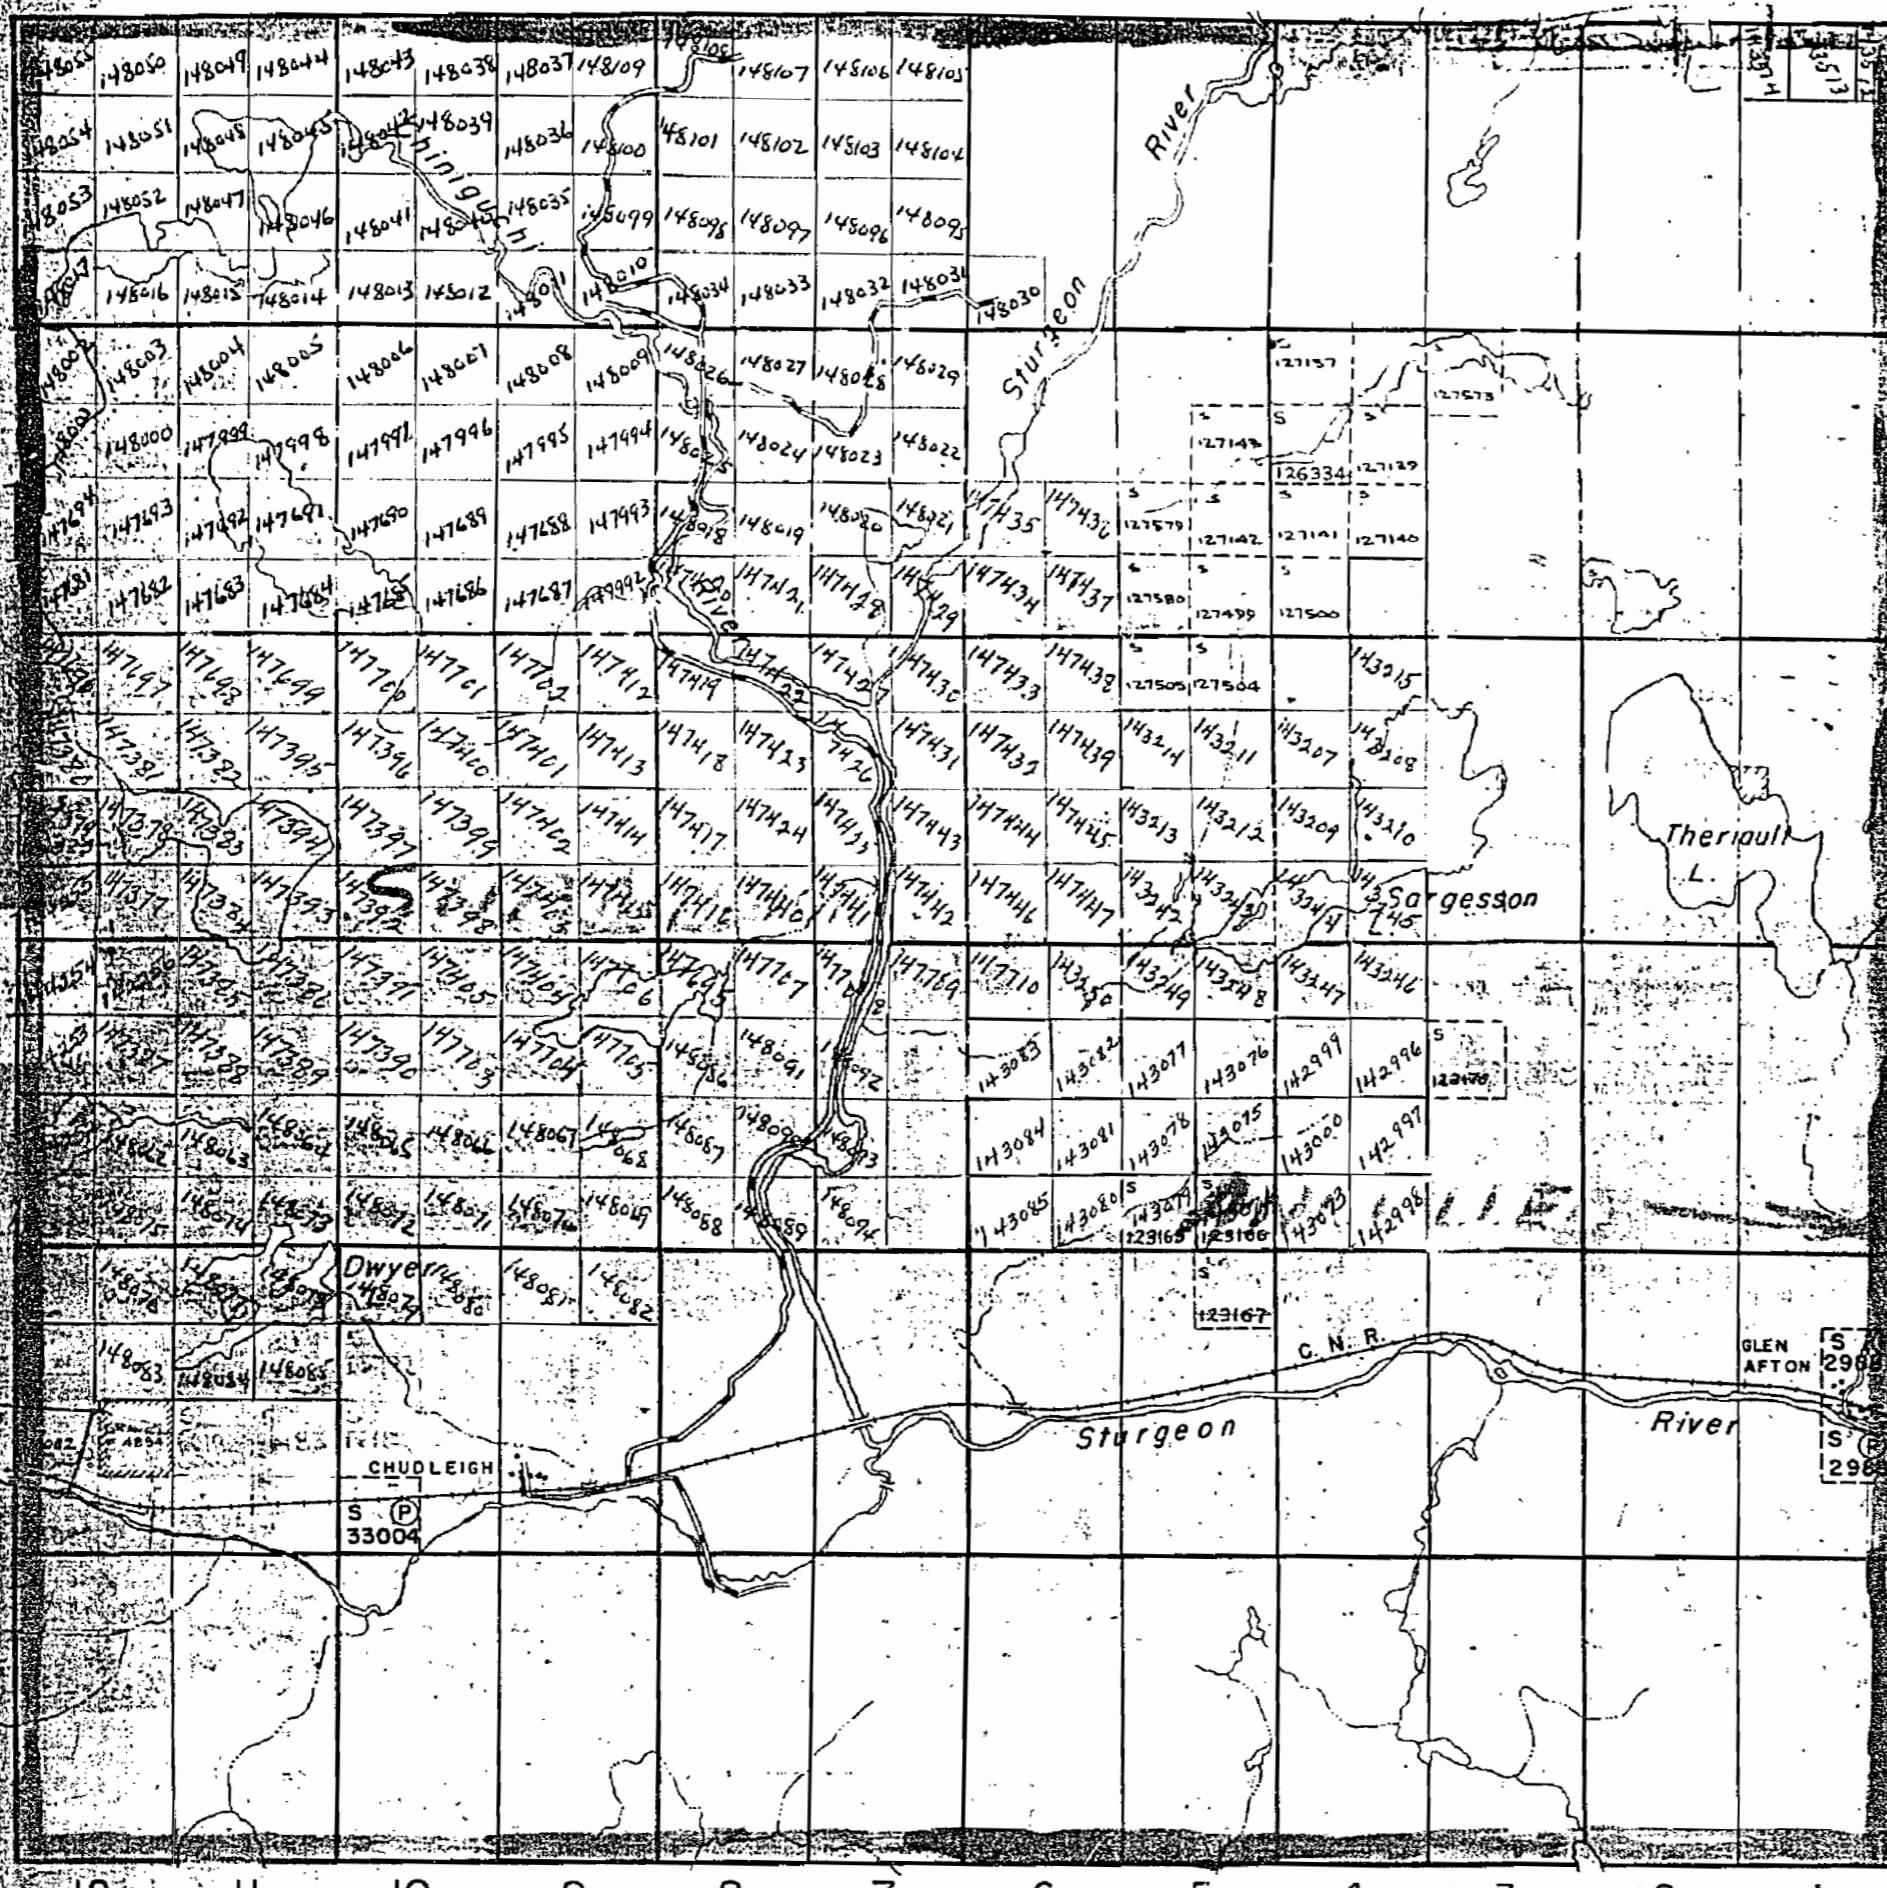


Henry Twp.

THE TOWNSHIP
OF**JANES**DISTRICT OF
SUDBURYSUDBURY
MINING DIVISION

SCALE: 1-INCH = 40 CHAINS

LEGEND

- PATENTED LAND
- CROWN LAND, SALE
- LEASES
- LOCATED LAND
- LICENSE OF OCCUPATION
- MINING RIGHTS ONLY
- SURFACE RIGHTS ONLY
- ROADS
- IMPROVED ROADS
- KING'S HIGHWAYS
- RAILWAYS
- POWER LINES
- MARSH OR MUSKEG
- MINES

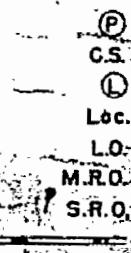NOTES

Mining Claims Accepted Under The Provision Of Section 53 Of The Mining Act.

400' Surface Rights Reservation around all Lakes and Rivers.

Surface Rights Only reserved to the Dept. of Lands & Forests under Sec 39 (d) Mining Act, shown thus:


PLAN NO.-M-955

DEPARTMENT
—ONTARIO

955

McNish Twp.

200' Res.

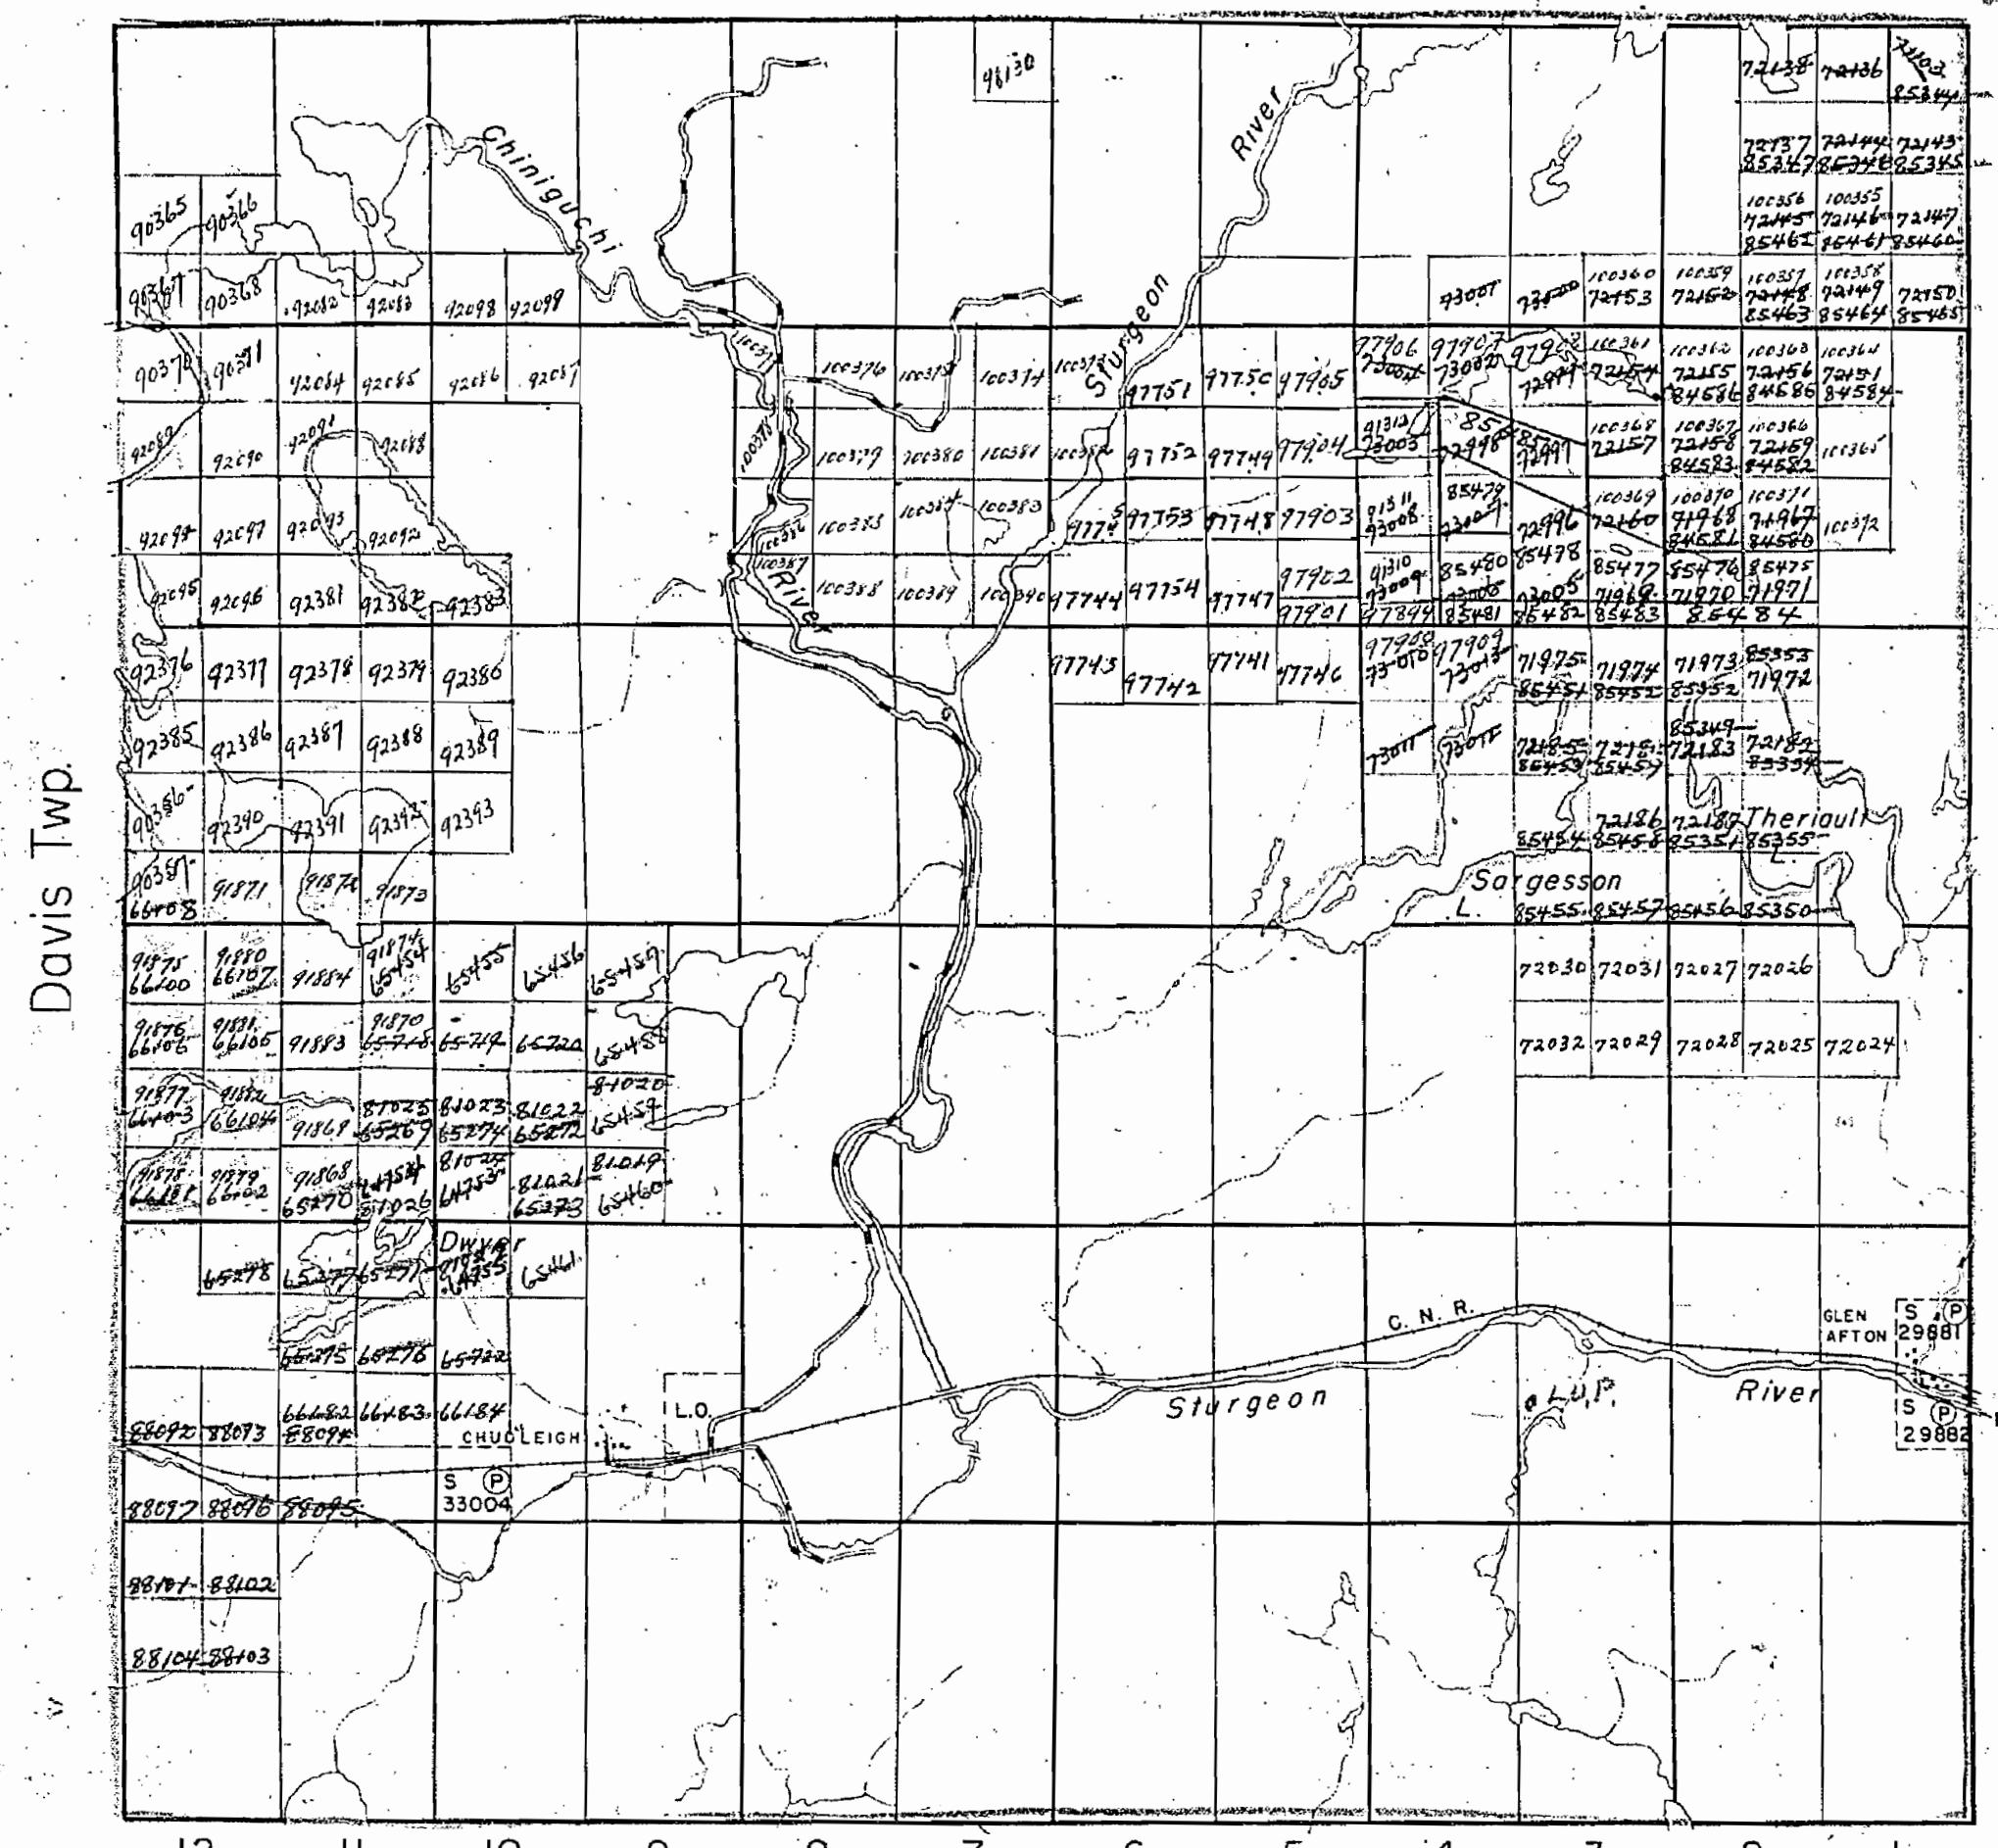

THE TOWNSHIP
OF
JANES

DISTRICT OF
SUDBURY
SUDBURY
MINING DIVISION

SCALE: 1-INCH = 40 CHAINS

LEGEND

PATENTED LAND
CROWN LAND SALE
LEASES
LOCATED LAND
LICENSE OF OCCUPATION
MINING RIGHTS ONLY
SURFACE RIGHTS ONLY
ROADS
IMPROVED ROADS
KING'S HIGHWAYS
RAILWAYS
POWER-LINES
MARSH OR MUSKEG
MINES

NOTES

Subj. To Sectional

POSTED GONE

M955

PLAN NO.-S.272


DEPARTMENT OF MINES
ONTARIO

963

38

JANES


SCALE - 40 CHAINS = ONE INCH

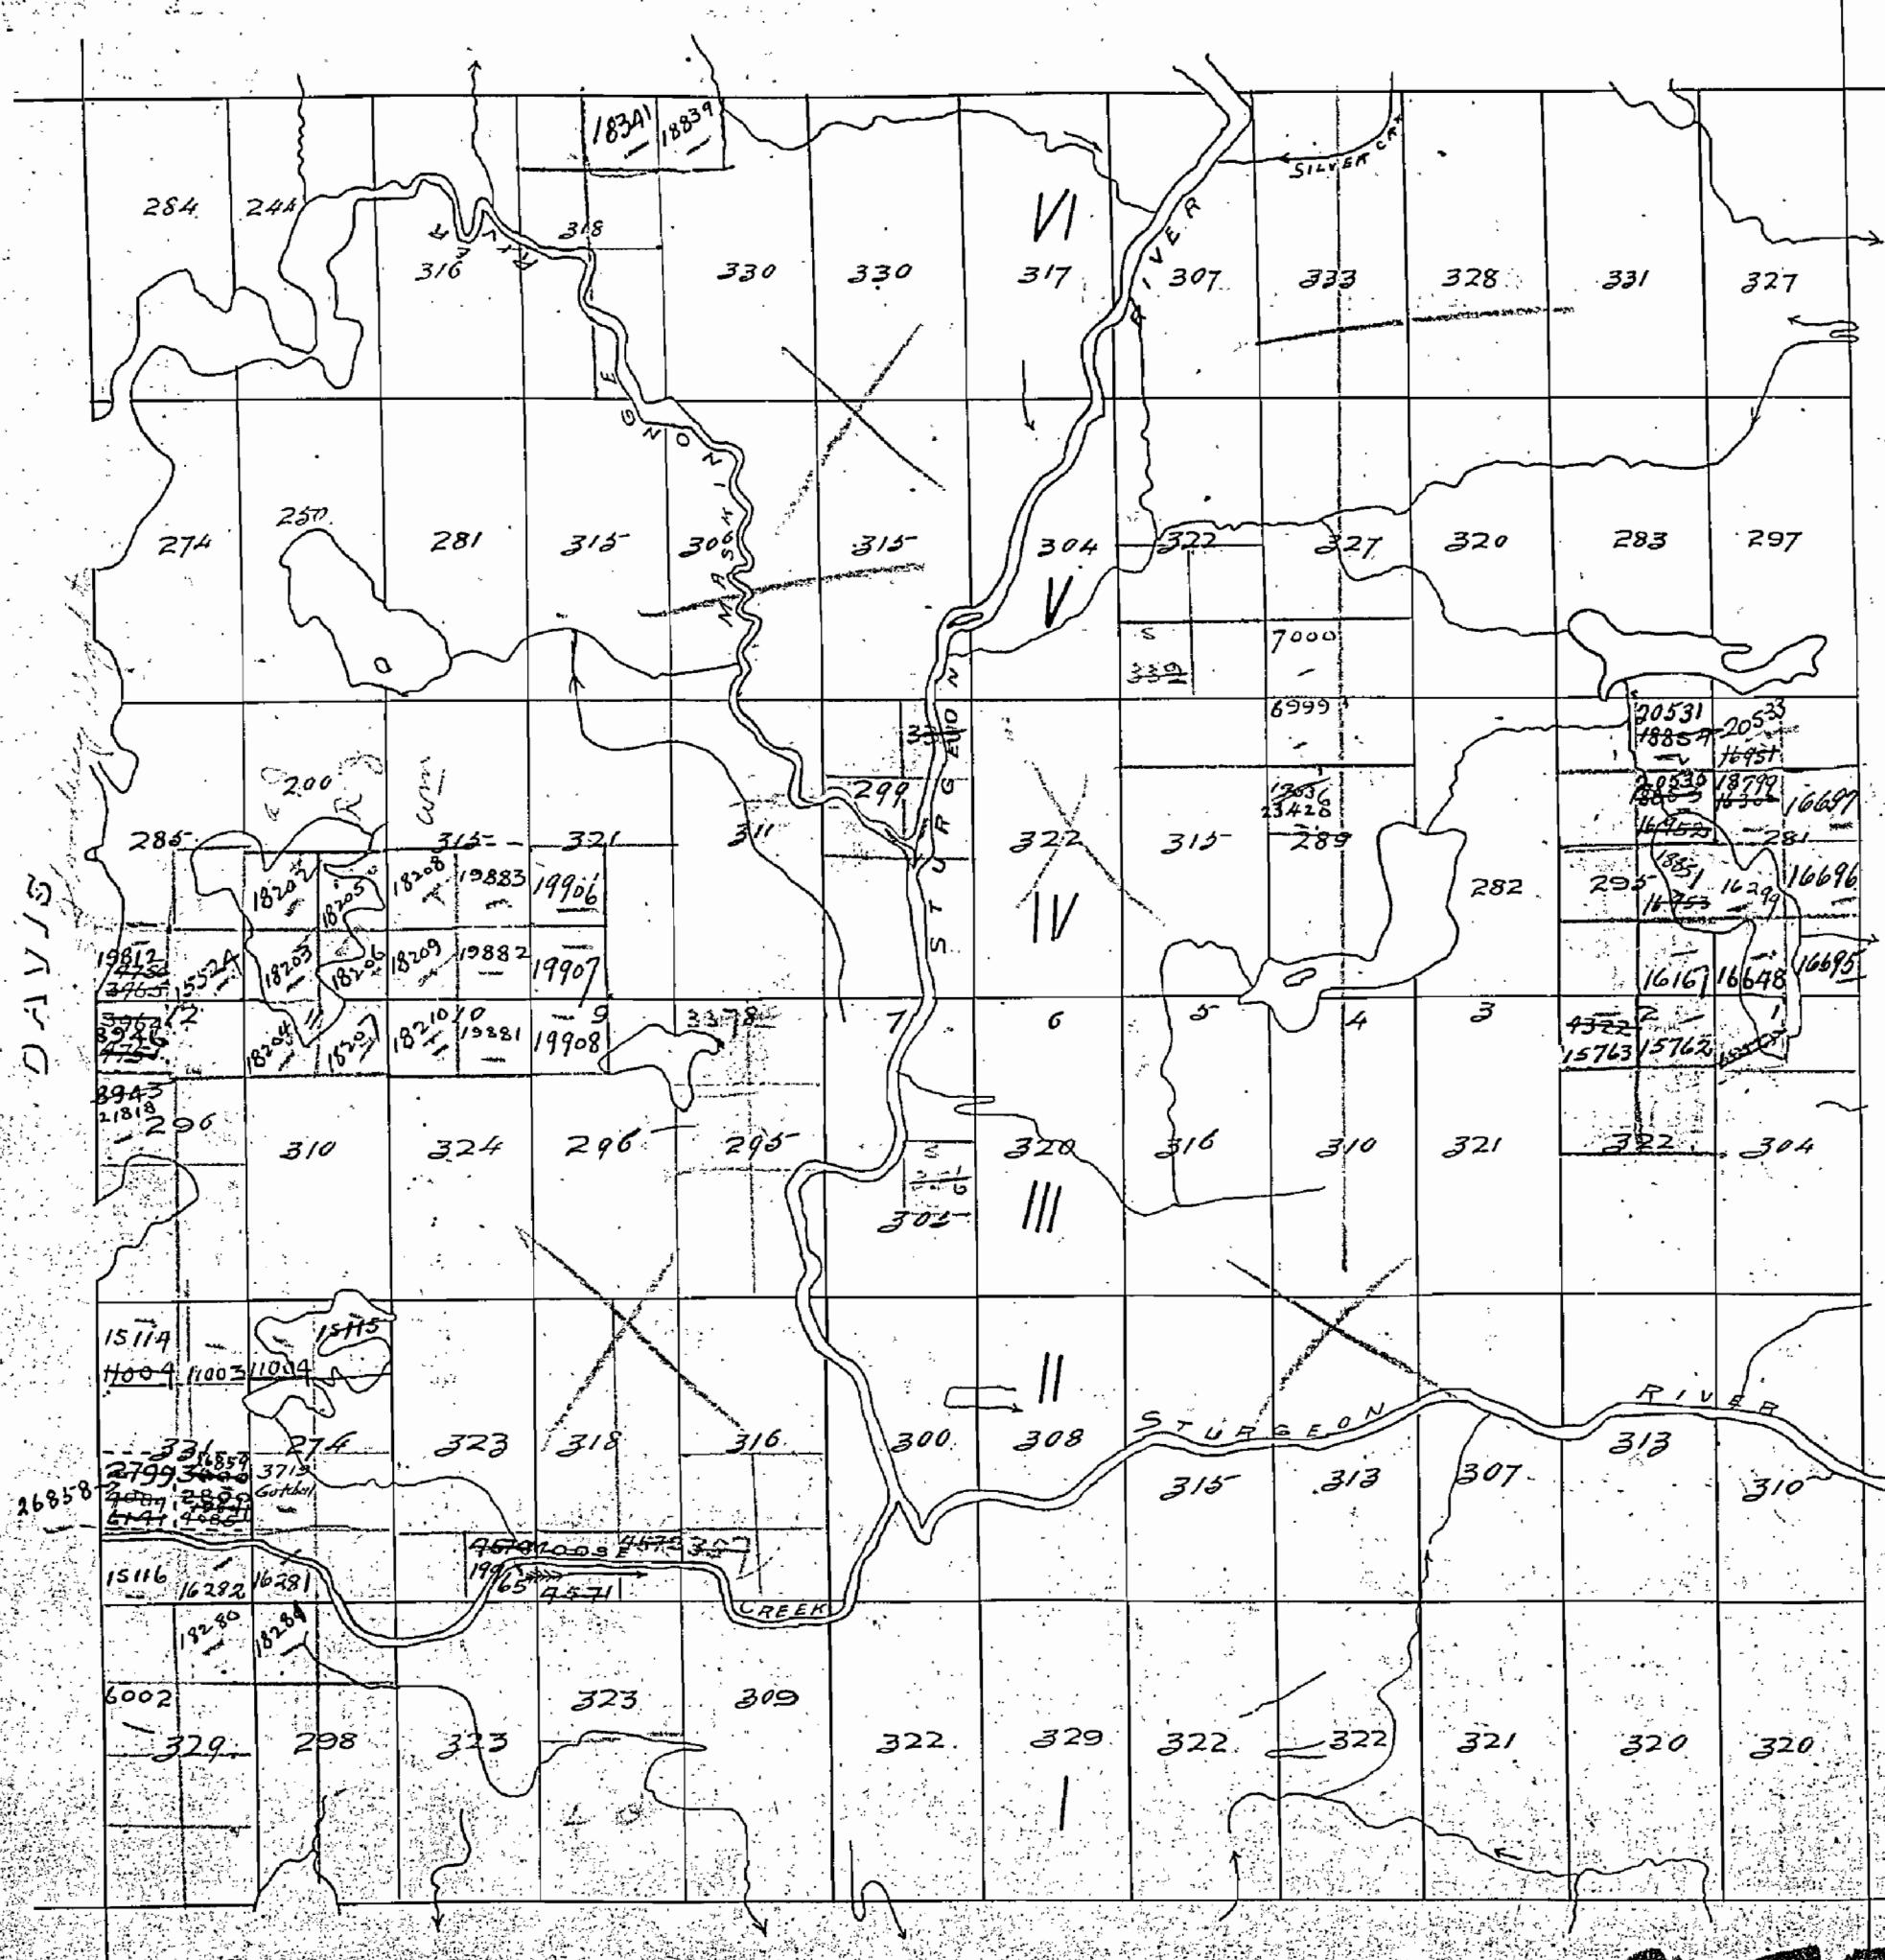

جَلَالُ الدِّينِ

m955

SEAN TAWT
G-590-25-G

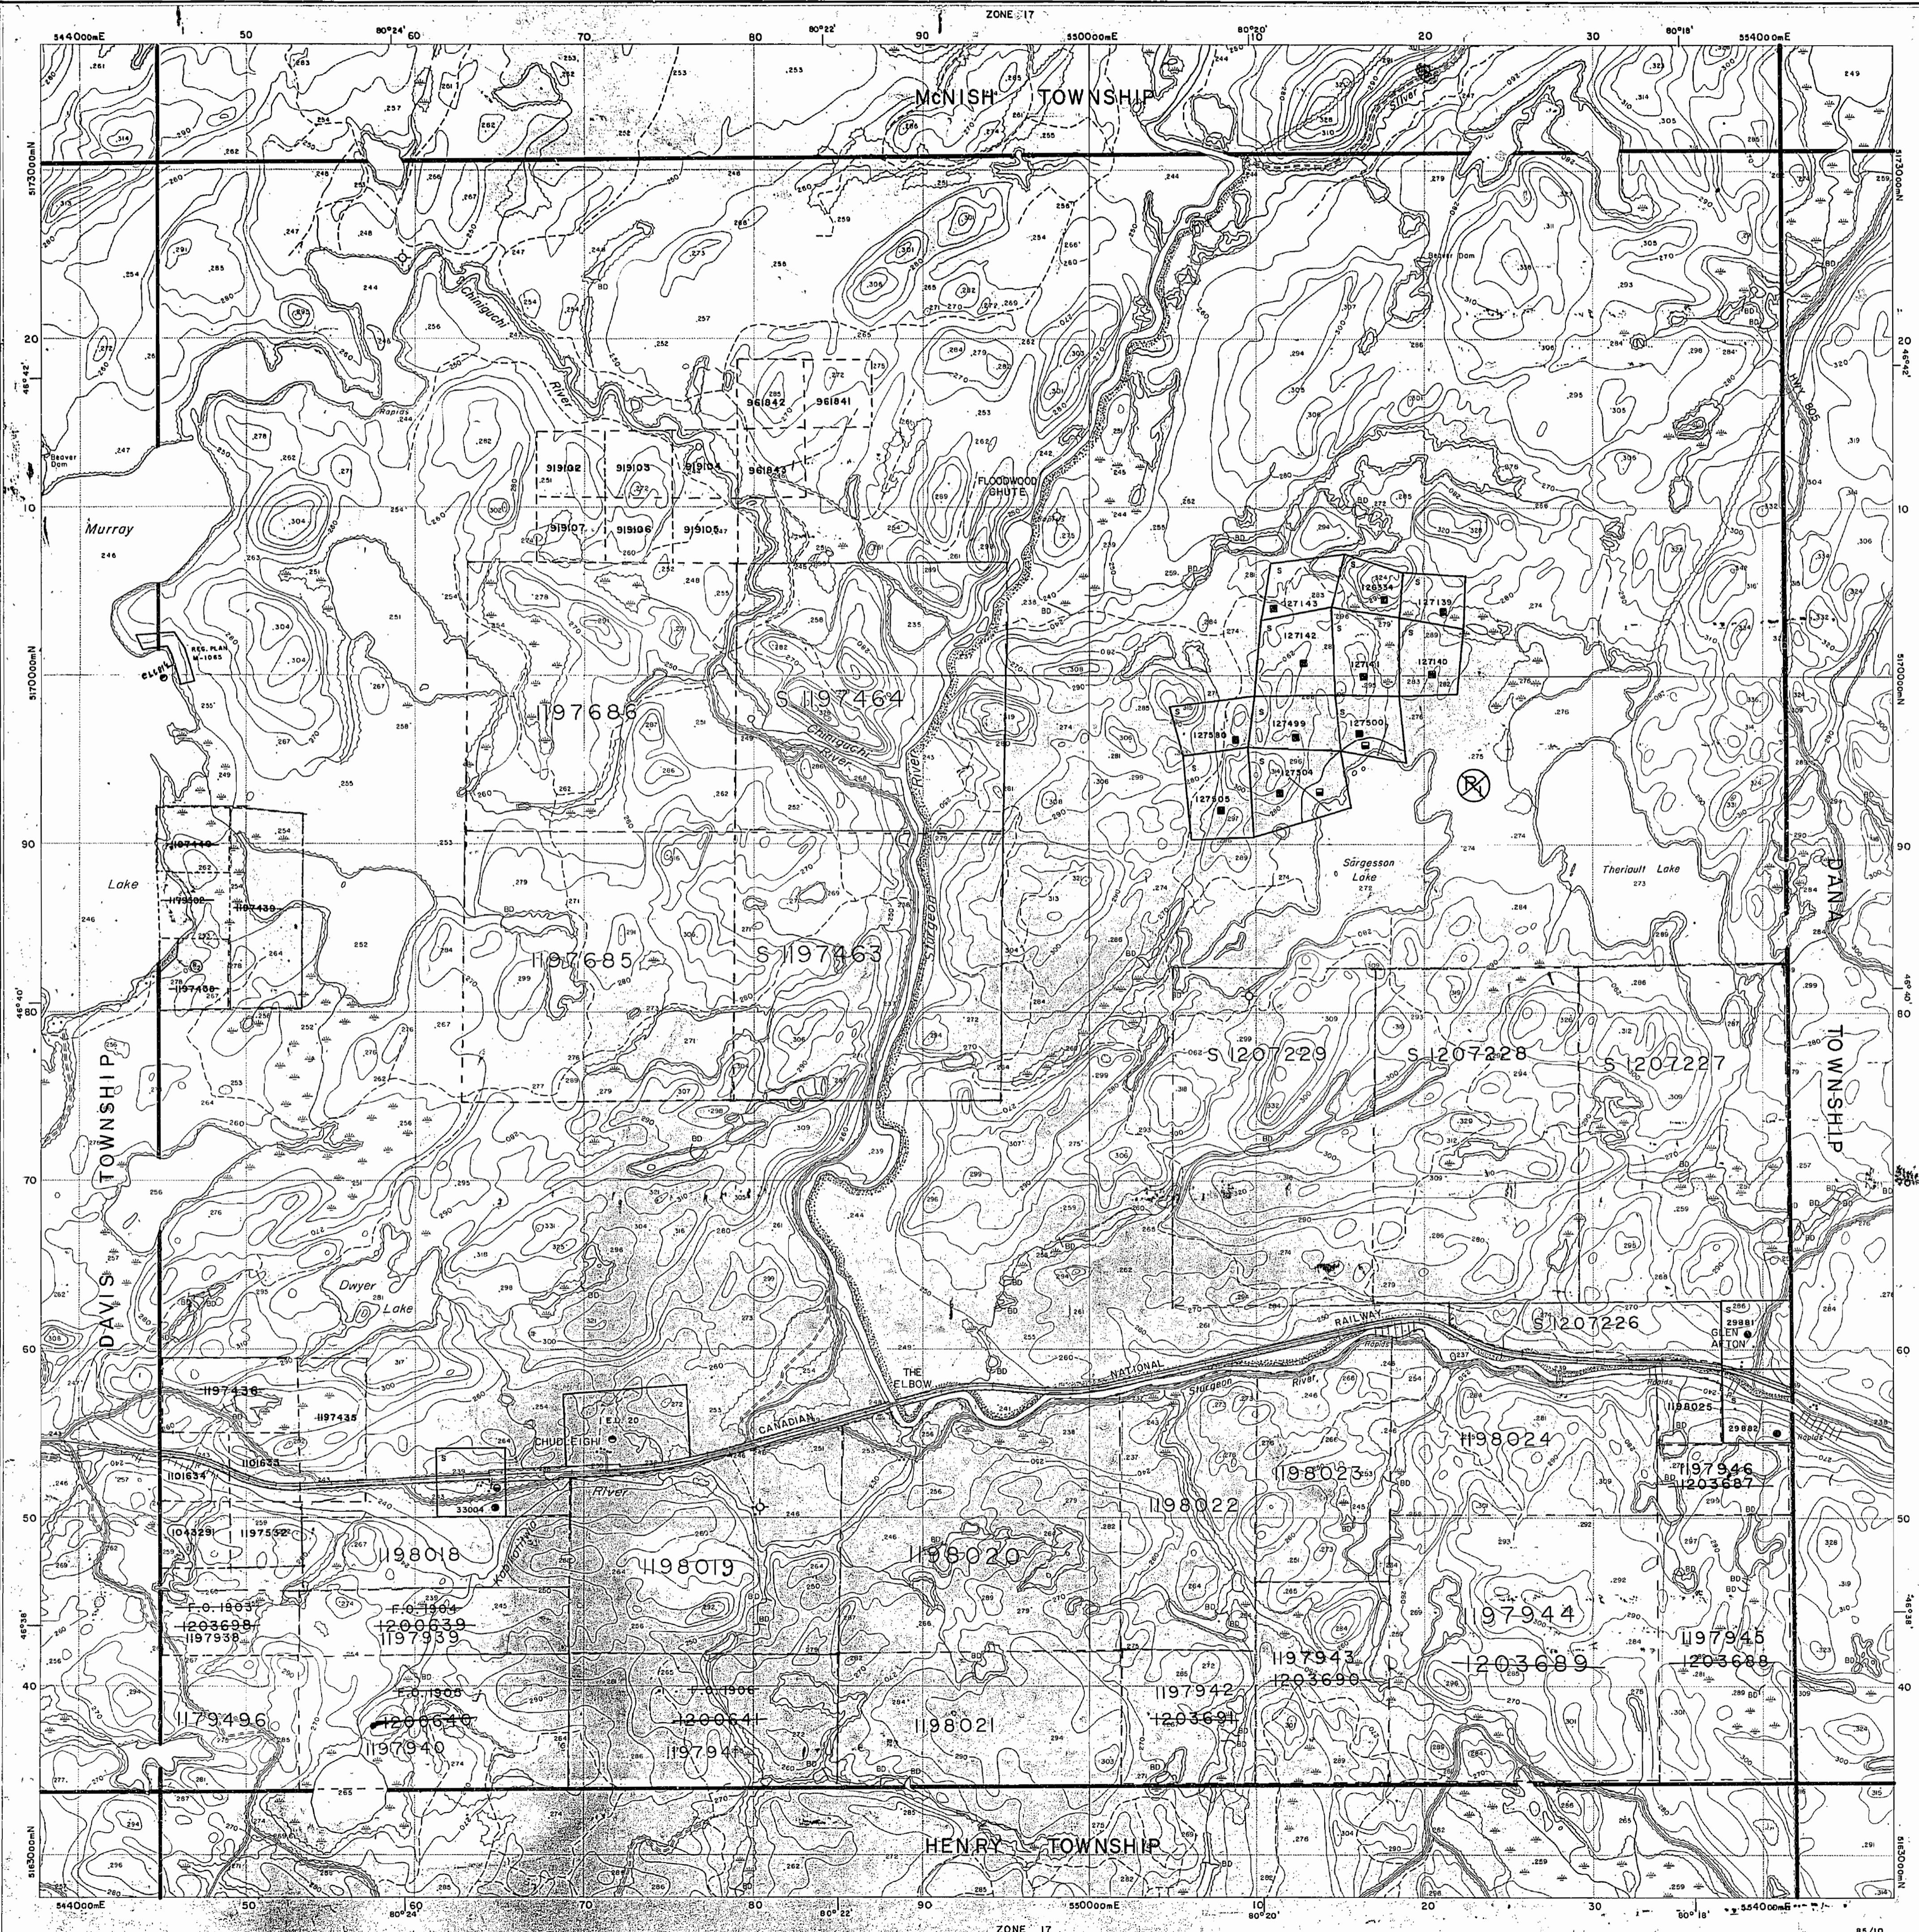

Ministry of Natural Resources

INDEX TO LAND DISPOSITION

PLAN

TOWNSH

JANES

JANES

M.N.R. ADMINISTRATIVE DISTRICT
NORTH BAY
MINING DIVISION
SUDBURY
LAND TITLES/REGISTRY DIVISION
SUDBURY

000

1000 2000 Metres

000 6000 7000 8000 9000 10000 Feet

10 Metres

AREAS WITHDRAWN FROM DISPOSITION

MRO - Mining Rights Only
SRO - Surface Rights Only

M + S - Mining and Surface Flights				
	Order No.	Date	Disposition	File
0	O-3-9/95	04/04/95	M & S	195150
D	W-2-84	16/3/84	M-B-G	18854
0	W.94/77	6/12/77	SRO	188530

part of order W 2/84 RECOPENED by order
01/90 NER effective April 3/990 at 7:00 AM E.S.T.

DATE OF ISSUE

NOTES

SYMBOLS

Boundary

Township, Meridian, Baseline.....

Road allowance; surveyed.....

shoreline.....

Lot/Concession; surveyed.....

unsurveyed

Parcel; surveyed

unsurveyed

Right-of-way; road

railway

utility

Reservation

Cliff, Pit, Pile

Contour

20

Interpolated

Approximate

Depression.....

Control point (horizontal)

Flooded land

Mine head frame

Pipeline (above ground)

Railway; single track

double track

abandoned

Road; highway, county, township

access

trail, bush

Shoreline (original)

Transmission line

Wooded area

DISPOSITION OF CROWN LANDS

Patent

- Surface & Mining Rights
- Surface Rights Only.....
- Mining Rights Only.....

Lease

- Surface & Mining Rights
- Surface Rights Only.....
- Mining Rights Only.....

Licence of Occupation

Order-in-Council..... OC


Cancelled

Reservation..... R

Sand & Gravel..... G

THE INFORMATION THAT APPEARS ON THIS MAP HAS BEEN COMPILED FROM VARIOUS SOURCES, AND ACCURACY IS NOT GUARANTEED. THOSE WISHING TO STAKE MINING CLAIMS SHOULD CONSULT WITH THE MINING RECORDER, MINISTRY OF NORTHERN DEVELOPMENT AND MINES, FOR ADDITIONAL INFORMATION ON THE STATUS OF THE LANDS SHOWN HEREON.

G-520

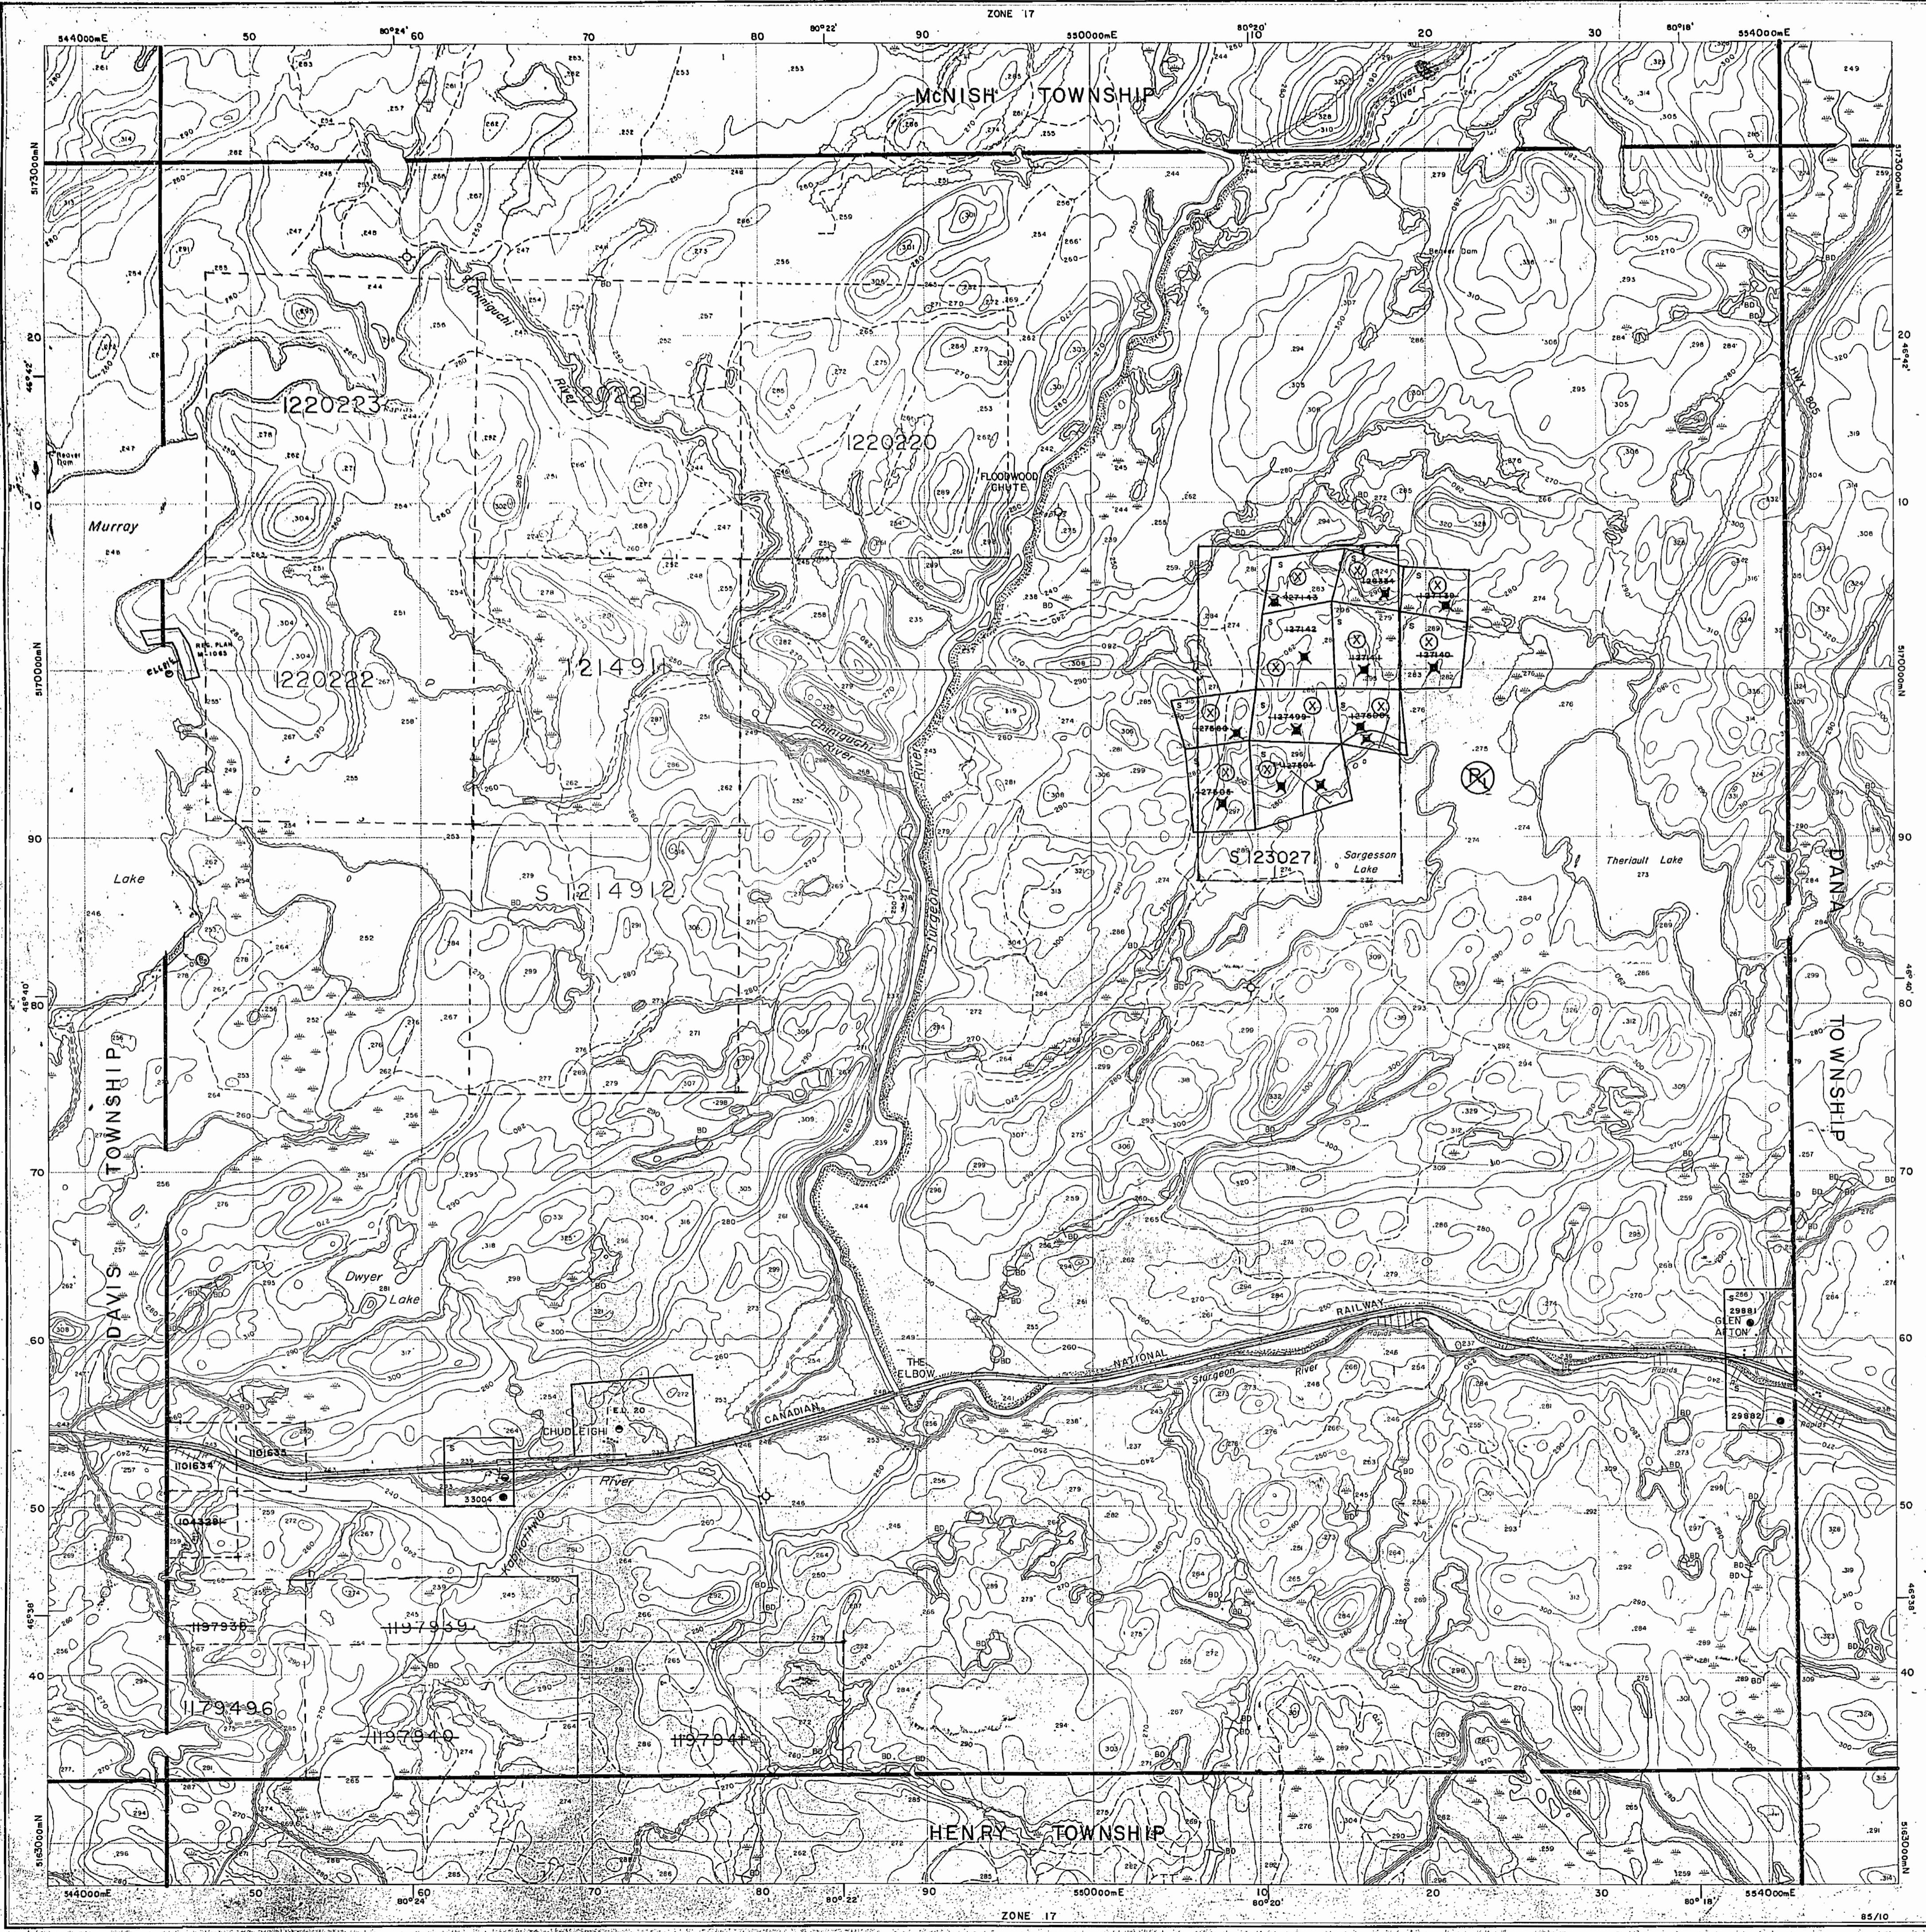

Ministry of Natural Resources
Ontario

INDEX TO LAND DISPOSITION

PLAN

G-2907

TOWNSHIP

JANES DATE OF ISSUE

OCT 03 1997

PROVINCIAL RECORDING
OFFICE - SUDBURY

M.N.R. ADMINISTRATIVE DISTRICT
NORTH BAY
MINING DIVISION
SUDBURY
LAND TITLES/REGISTRY DIVISION
SUDBURY

Scale 1:20 000
Metres 1000 0 1000 2000 Metres
Feet 1000 0 1000 2000 3000 4000 5000 6000 7000 8000 9000 10000 Feet
Contour Interval 10 Metres

AREAS WITHDRAWN FROM DISPOSITION

MRO - Mining Rights Only
SRO - Surface Rights Only
M+TS - Mining and Surface Rights

Description	Order No.	Date	Disposition	File
SEC 35/80	D-3-9/88	04/04/88	M+S	198150
Sec 36/80	W-0/84	04/04/84	M+S	198649
Sec 43/70	W-94/77	06/12/77	SRO	188530

Part of order W-2/84 RESPOND by order
O-ML O/80 NER effective April 3, 1990 at 7:00 AM E.S.T.

SYMBOLS

- Boundary
 - Township, Meridian, Baseline.....
 - Road allowance; surveyed.....
 - shoreline.....
- Lot/Concession; surveyed.....
- unsurveyed.....
- Parcel; surveyed.....
- unsurveyed.....
- Right-of-way; road.....
- railway.....
- utility.....
- Reservation.....
- Cliff, Pit, Pile.....
- Contour.....
- Interpolated.....
- Approximate.....
- Depression.....
- Control point (horizontal).....
- Flooded land.....
- Mine head frame.....
- Pipeline (above ground).....
- Railway; single track.....
- double track.....
- abandoned.....
- Road; highway, county, township.....
- * access.....
- trail, bush.....
- Shoreline (original).....
- Transmission line.....
- Wooded area.....

JUNE 1ST OPENINGS 1997 S-126334 ETAL

DISPOSITION OF CROWN LANDS

- Patent
 - Surface & Mining Rights.....
 - Surface Rights Only.....
 - Mining Rights Only.....
- Lease
 - Surface & Mining Rights.....
 - Surface Rights Only.....
 - Mining Rights Only.....
- Licence of Occupation.....
- Order-in-Council.....
- Cancelled.....
- Reservation.....
- Sand & Gravel.....

LAND USE PERMIT

QUARRY PERMITS


DESCRIPTION	FILE NO.	ISSUE DATE	EXPIRATION DATE
-------------	----------	------------	-----------------

THE INFORMATION THAT APPEARS ON THIS MAP HAS BEEN COMPILED FROM VARIOUS SOURCES AND ACCURACY IS NOT GUARANTEED. THOSE INDIVIDUALS WISHING TO STAKE MINING CLAIMS SHOULD CONSULT WITH THE MINING RECORDER, MINISTRY OF NATURAL RESOURCES, DEPARTMENT AND MINES FOR ADDITIONAL INFORMATION ON THE STATUS OF THE LANDS SHOWN HEREON.

The disposition of land, location of lot fabric and parcel boundaries on this index was compiled for administrative purposes only.

229-M 911 T 37MAN

McNish Twp.

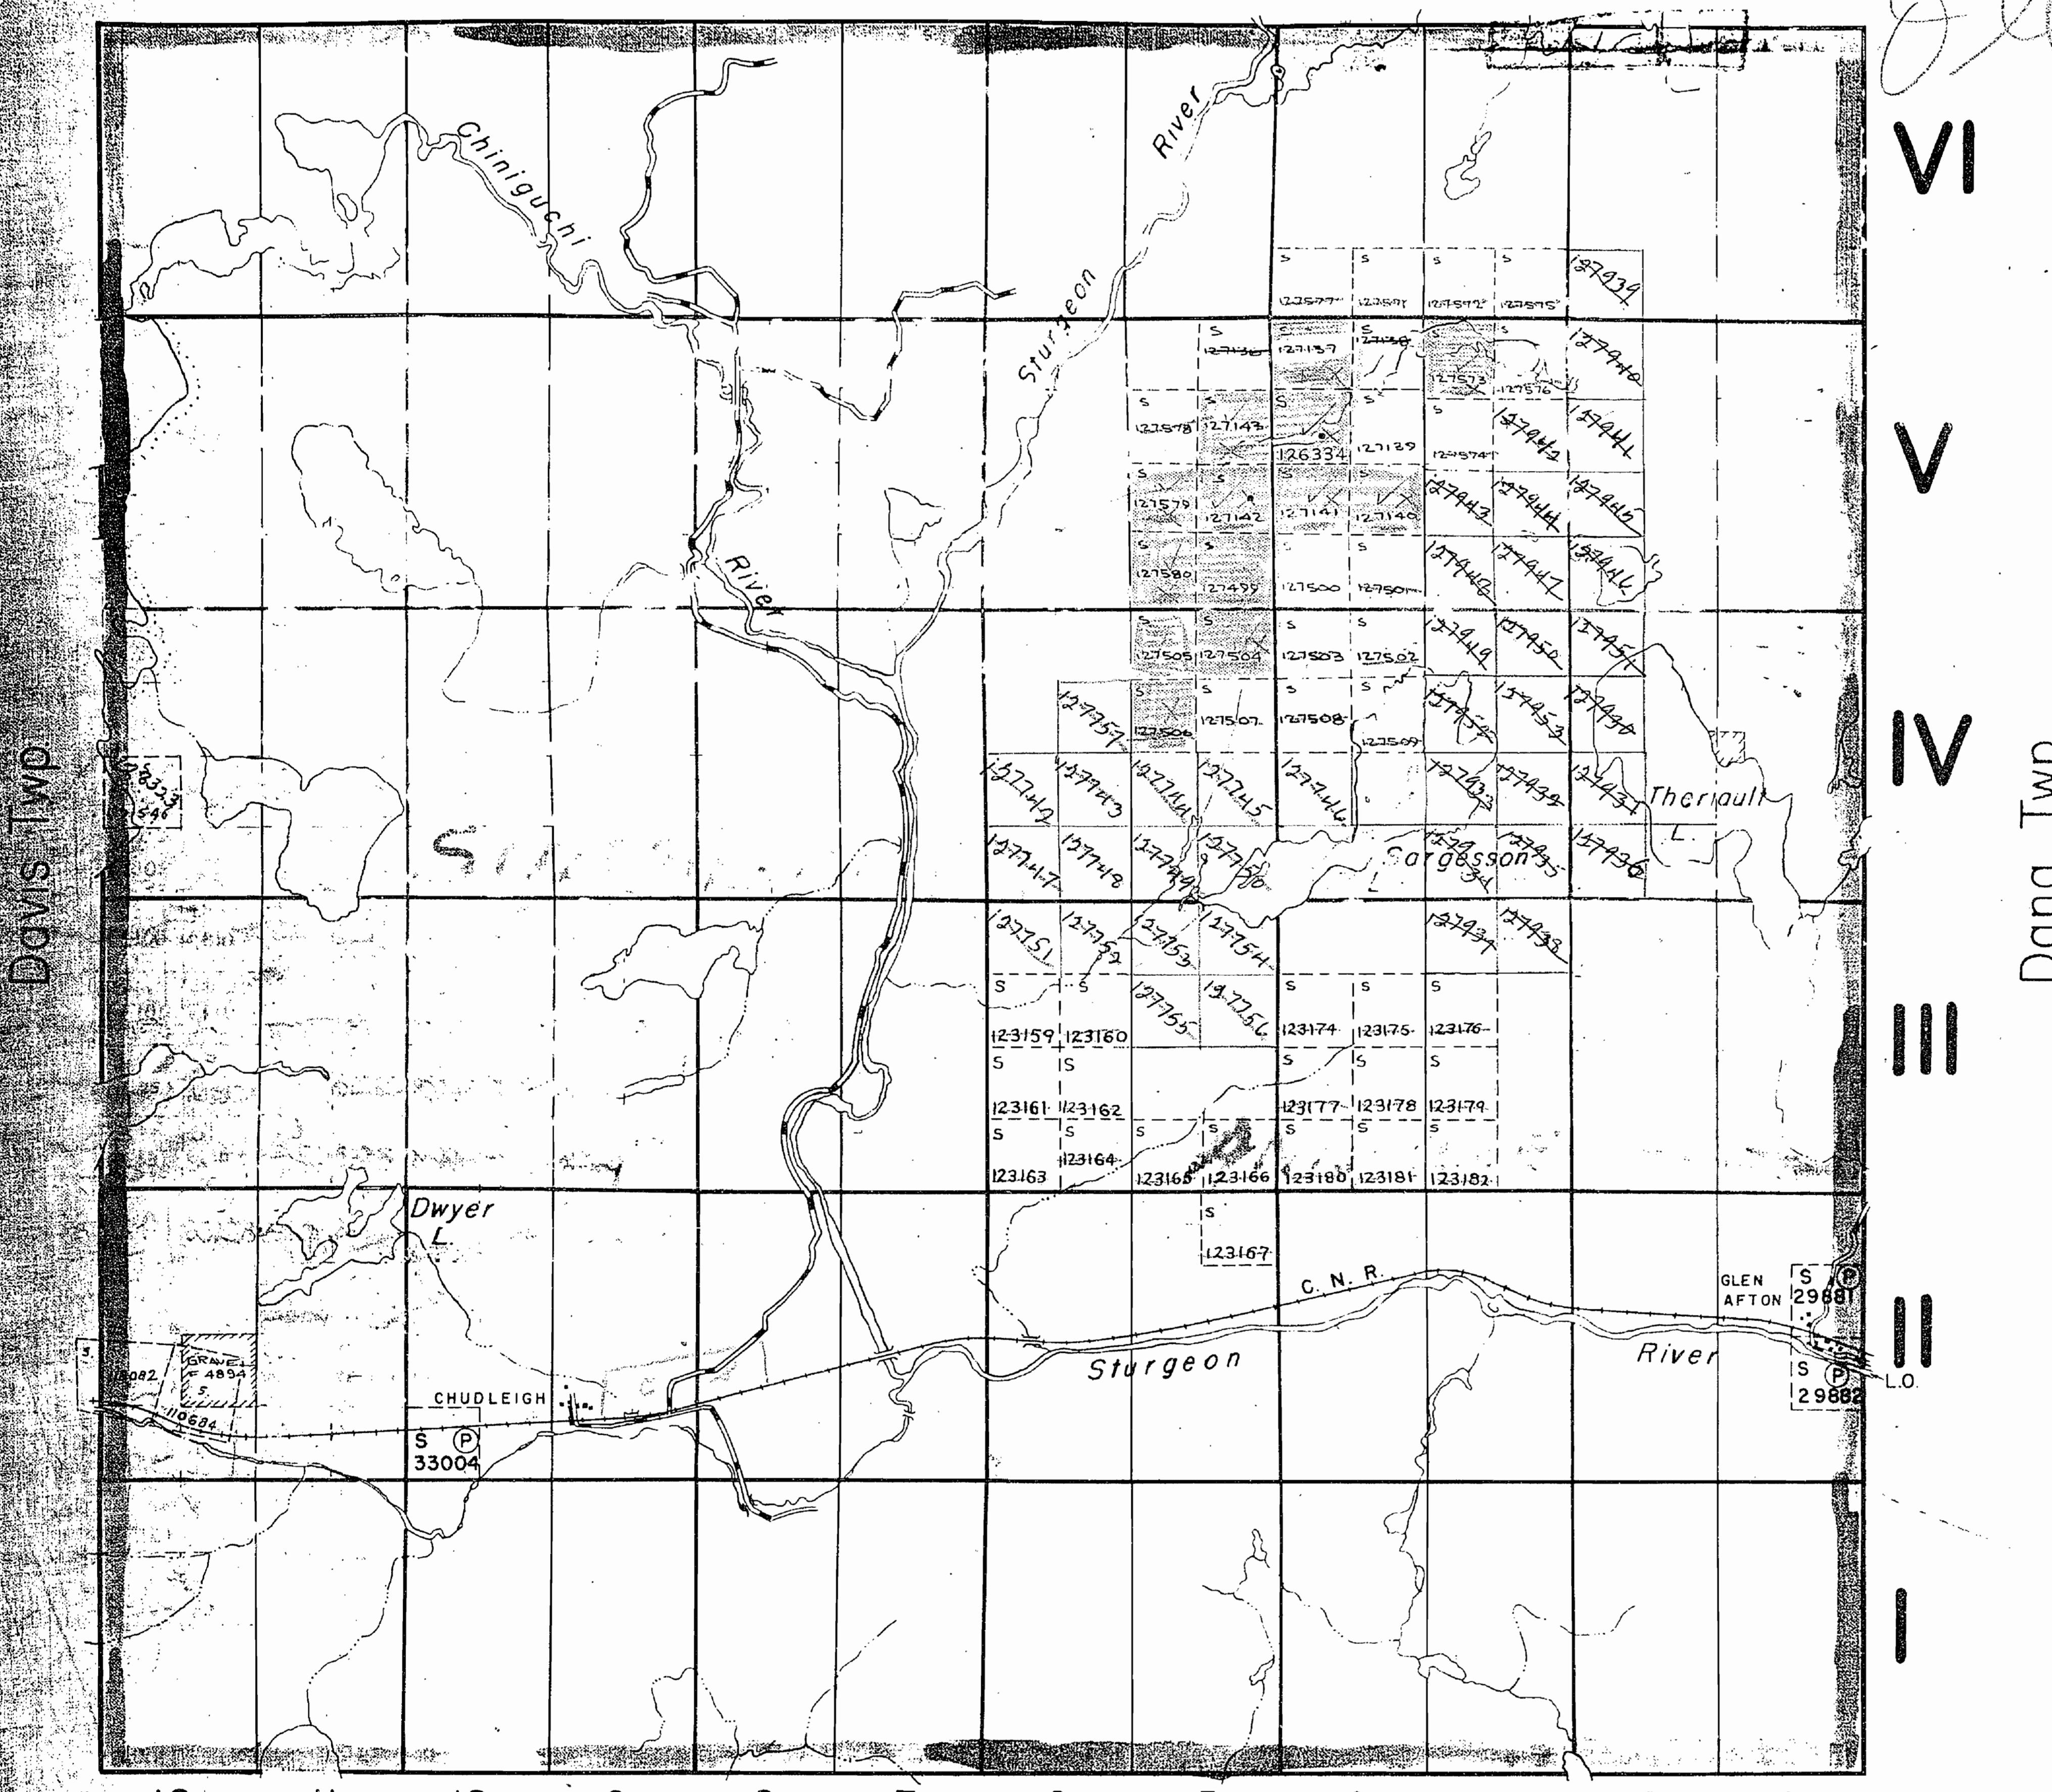

Henry Twp.

THE TOWNSHIP OF

JANES

DISTRICT OF
SUDBURY

SUDBURY MINING DIVISION

SCALE : 1-INCH = 40 CHAINS

LEGEND

PATENTED LAND	(P)
CROWN LAND SALE	C.S.
LEASES	(L)
LOCATED LAND	Loc.
LICENSE OF OCCUPATION	L.O.
MINING RIGHTS ONLY	M.R.O.
SURFACE RIGHTS ONLY	S.R.O.
ROADS	
IMPROVED ROADS	
KING'S HIGHWAYS	
RAILWAYS	
POWER LINES	
MARSH OR MUSKEG	
MINES	

NOTES

Mining Claims Accepted Under The
Provision Of Section 53 Of The
Mining Act.


400' Surface Rights Reservation around
all Lakes and Rivers

Surface Rights Only reserved to the Dept. of Lands
8 Forests under Sec 39 (d) Mining Act shown
thus ~~xxxx~~

PLAN NO.-M-955

DEPARTMENT OF MINES
—ONTARIO—

McNish Twp.

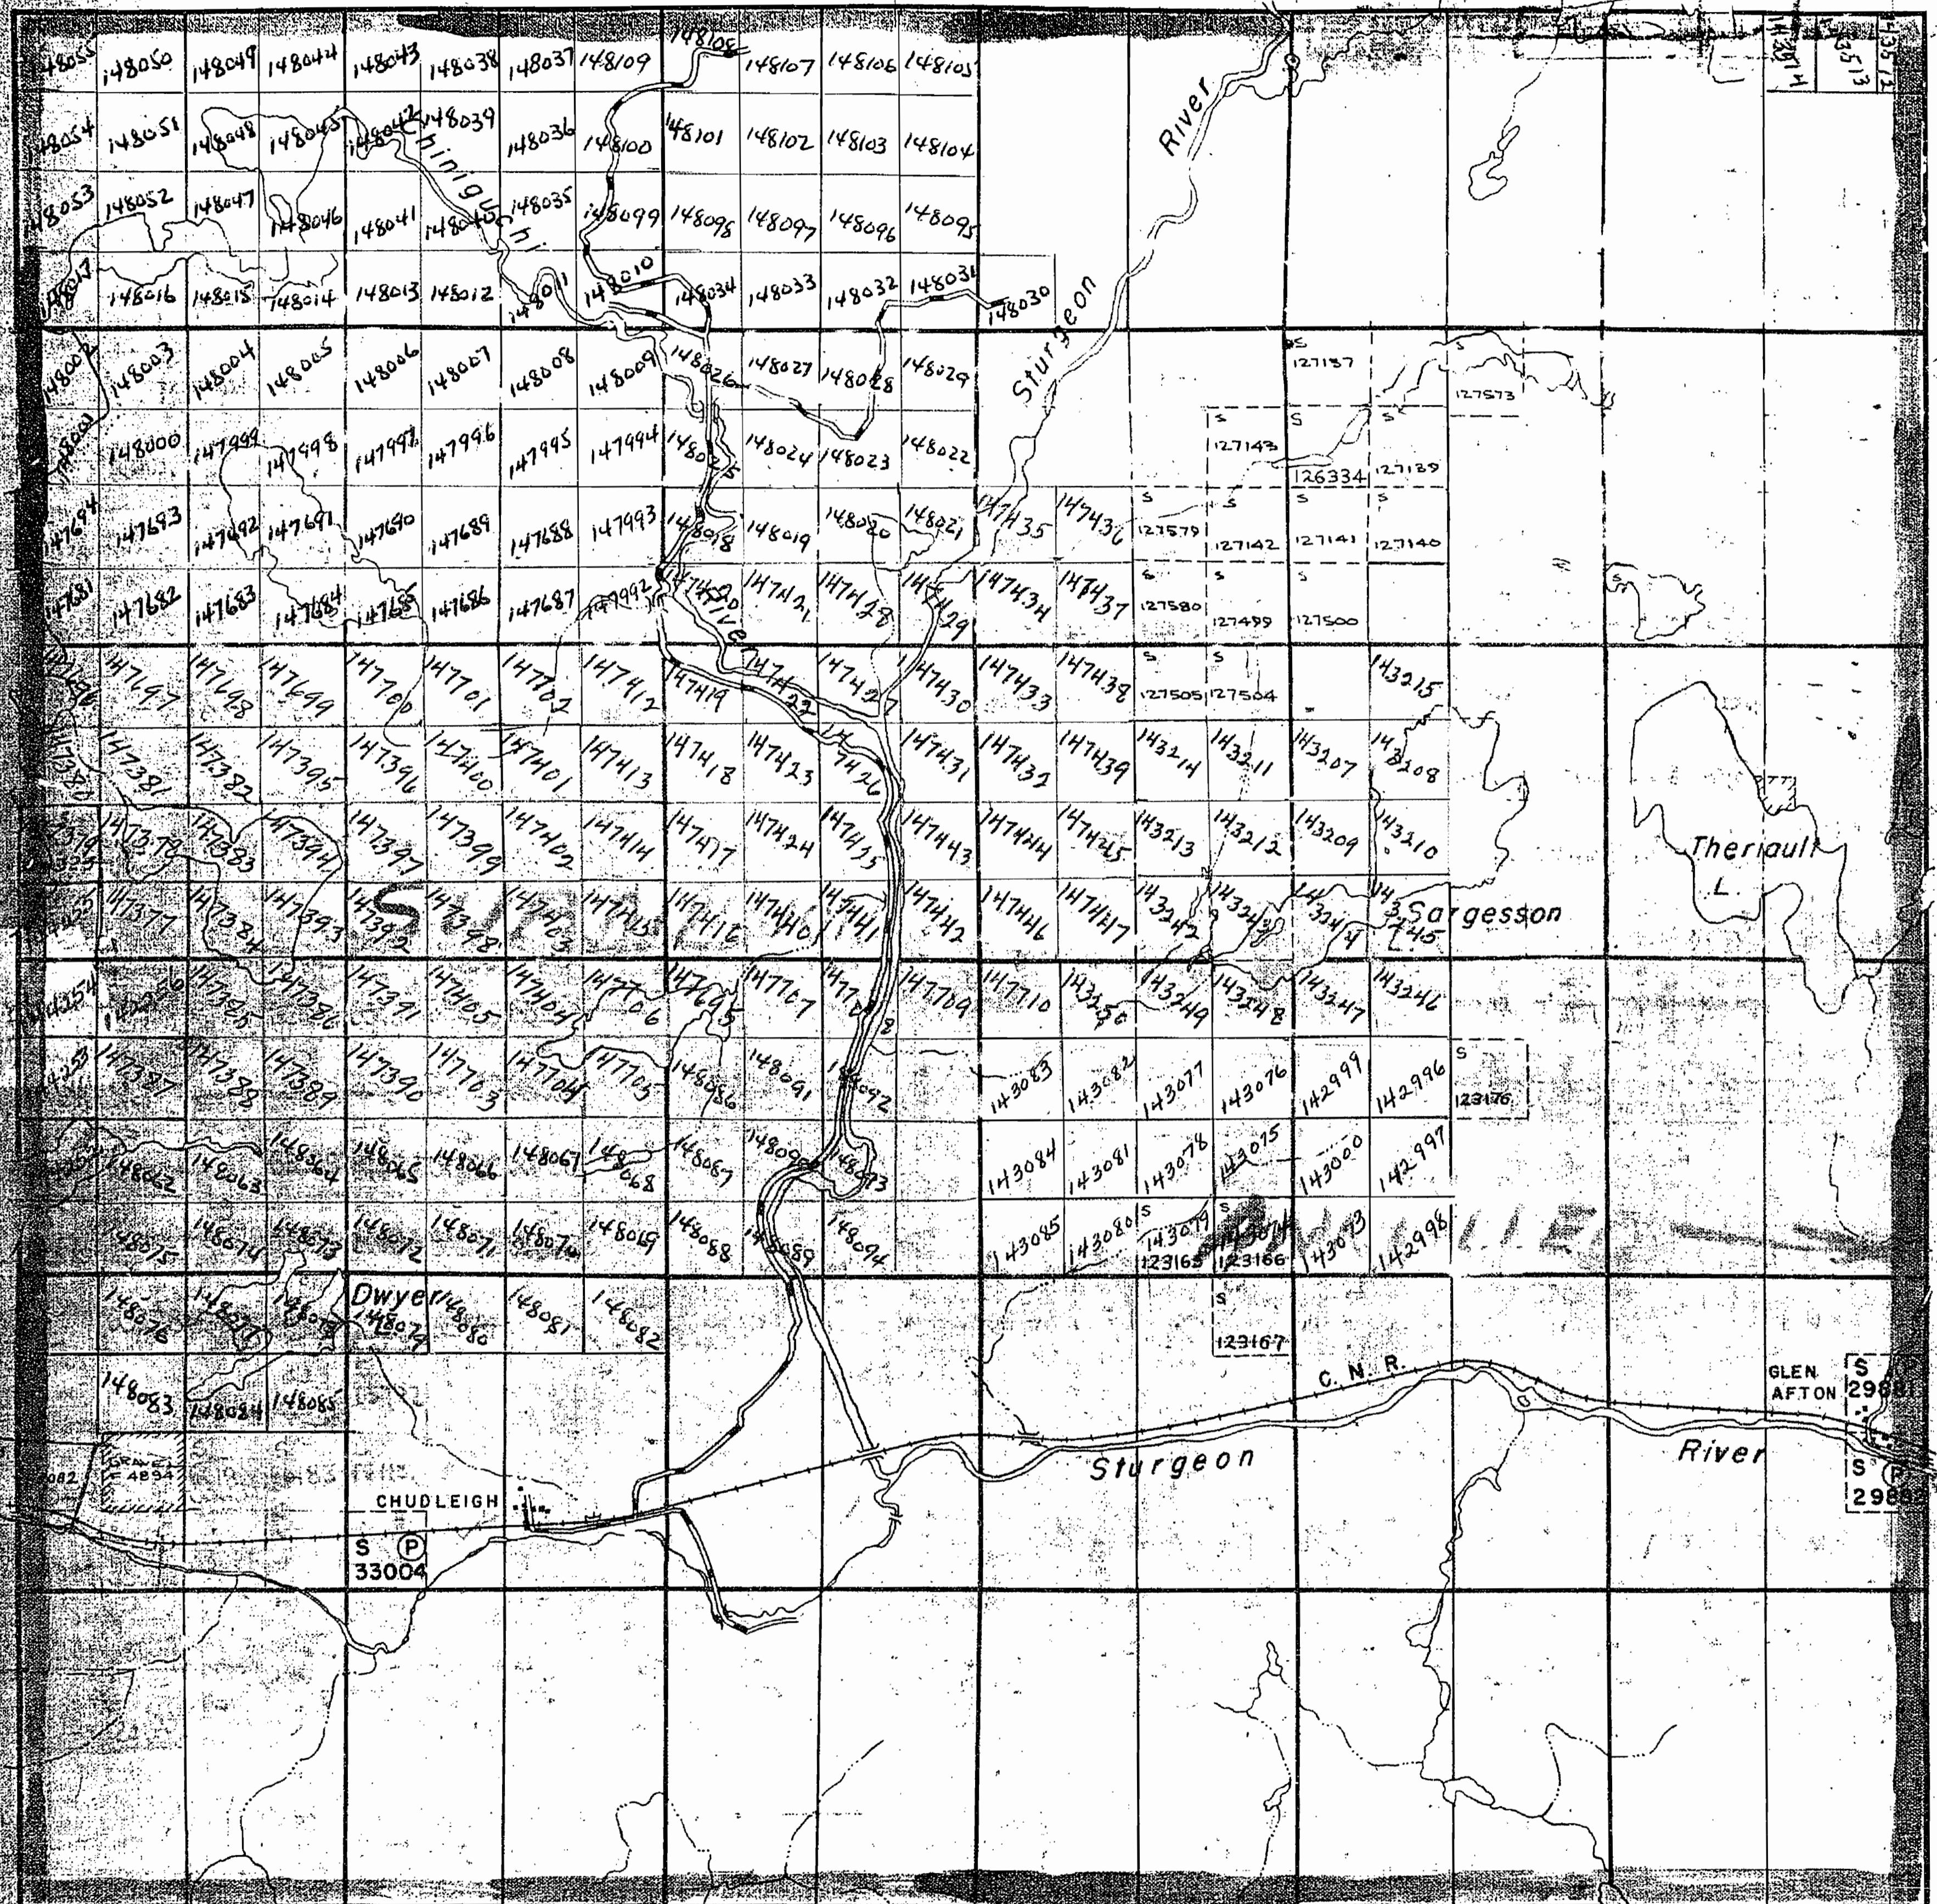

Henry Twp.

THE TOWNSHIP
OF

Old
JANES

DISTRICT OF
SUDBURY

SUDBURY
MINING DIVISION

SCALE: 1-INCH = 40 CHAINS

LEGEND

(P)	CROWN LAND SALE
(C.S.)	LEASES
(Loc.)	LOCATED LAND
(L.O.)	LICENSE OF OCCUPATION
(M.R.O.)	MINING RIGHTS ONLY
(S.R.O.)	SURFACE RIGHTS ONLY
ROADS	ROADS
IMPROVED ROADS	KING'S HIGHWAYS
RAILWAYS	RAILWAYS
POWER LINES	POWER LINES
MARSH OR MUSKEG	MARSH OR MUSKEG
MINES	MINES

NOTES

Mining Claims Accepted Under The
Provision Of Section 53 Of The
Mining Act.

400' Surface Rights Reservation around
all Lakes and Rivers.

Surface Rights Only reserved to the Dept of Lands
& Forests under Sec 39 (d) Mining Act shown
thus:

PLAN NO.- M-955

DEPARTMENT
—ONTARIO



Ministry of
Natural
Resources
Ontario

Ministry of
Northern Affairs
and Mines

INDEX TO LAND DISPOSITION


PLAN

G-2907

TOWNSHIP

JANES

M.N.R. ADMINISTRATIVE DISTRICT
NORTH BAY
MINING DIVISION
SUDBURY
LAND TITLES/REGISTRY DIVISION
SUDBURY

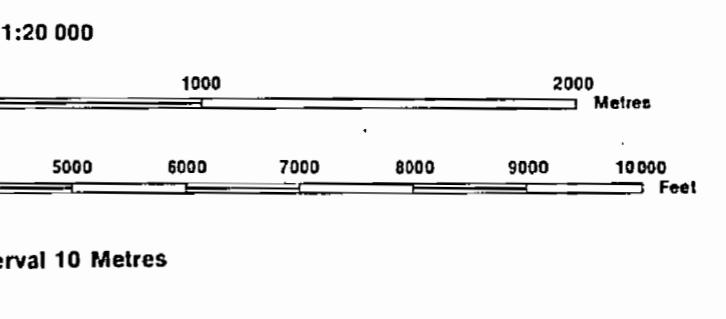

AREAS WITHDRAWN FROM DISPOSITION

MRO - Mining Rights Only
SRO - Surface Rights Only
M+S = Mining and Surface Rights

Description	Order No.	Date	Disposition	File
SEC.35/80	0-5-9/88	04/10/88	M+S	185160
Sec.35/80	W-3/84	16/3/84	M+S	185149

Part of order W 2/84 REOPENED by order
O-ML DIV/80 HER effective April 3/89 at 7:00 AM E.A.T.

DATE OF ISSUE

OCT 30 1997

PROVINCIAL RECORDING
OFFICE - SUDBURY

NOTES

Subdivision of this Township into Lots and Concessions was
annulled 29th December, 1953.

SYMBOLS

Boundary
Township, Meridian, Baseline
Road allowance; surveyed
..... shoreline
Lot/Concession; surveyed
..... unsurveyed
Parcel; surveyed
..... unsurveyed
Right-of-way; road
..... railway
..... utility
Reservation
Cliff, Pit, Pile
Contour
Interpolated
Approximate
Depression
Control point (horizontal)	△
Flooded land
Mine head frame	□
Pipeline (above ground)
Railway; single track
..... double track
..... abandoned
Road; highway, county, township
access
trail, bush
Shoreline (original)
Transmission line
Wooded area


JUNE 1ST OPENINGS 1997 S.126334 ETAL

DISPOSITION OF CROWN LANDS

Patent	Surface & Mining Rights	●
	Surface Rights Only	●
	Mining Rights Only	●
Lease	Surface & Mining Rights	■
	Surface Rights Only	■
	Mining Rights Only	■
Licence of Occupation	▼	
Order-in-Council	..OC	
Cancelled	○	
Reservation	○	
Sand & Gravel	○	

LAND USE PERMIT

THE INFORMATION THAT
APPEARS ON THIS MAP
HAS BEEN COMPILED
FROM VARIOUS SOURCES
AND ACCURACY IS NOT
GUARANTEED. THOSE
WISHING TO STAKE MIN-
ING CLAIMS SHOULD CONS-
ULT WITH THE MINING
REGISTRY, THE NORTHERN
DEVELOPMENT AND
MINING BOARD.
ADDITIONAL INFORMATION
ON THE STATUS OF THE
LANDS SHOWN HEREON.

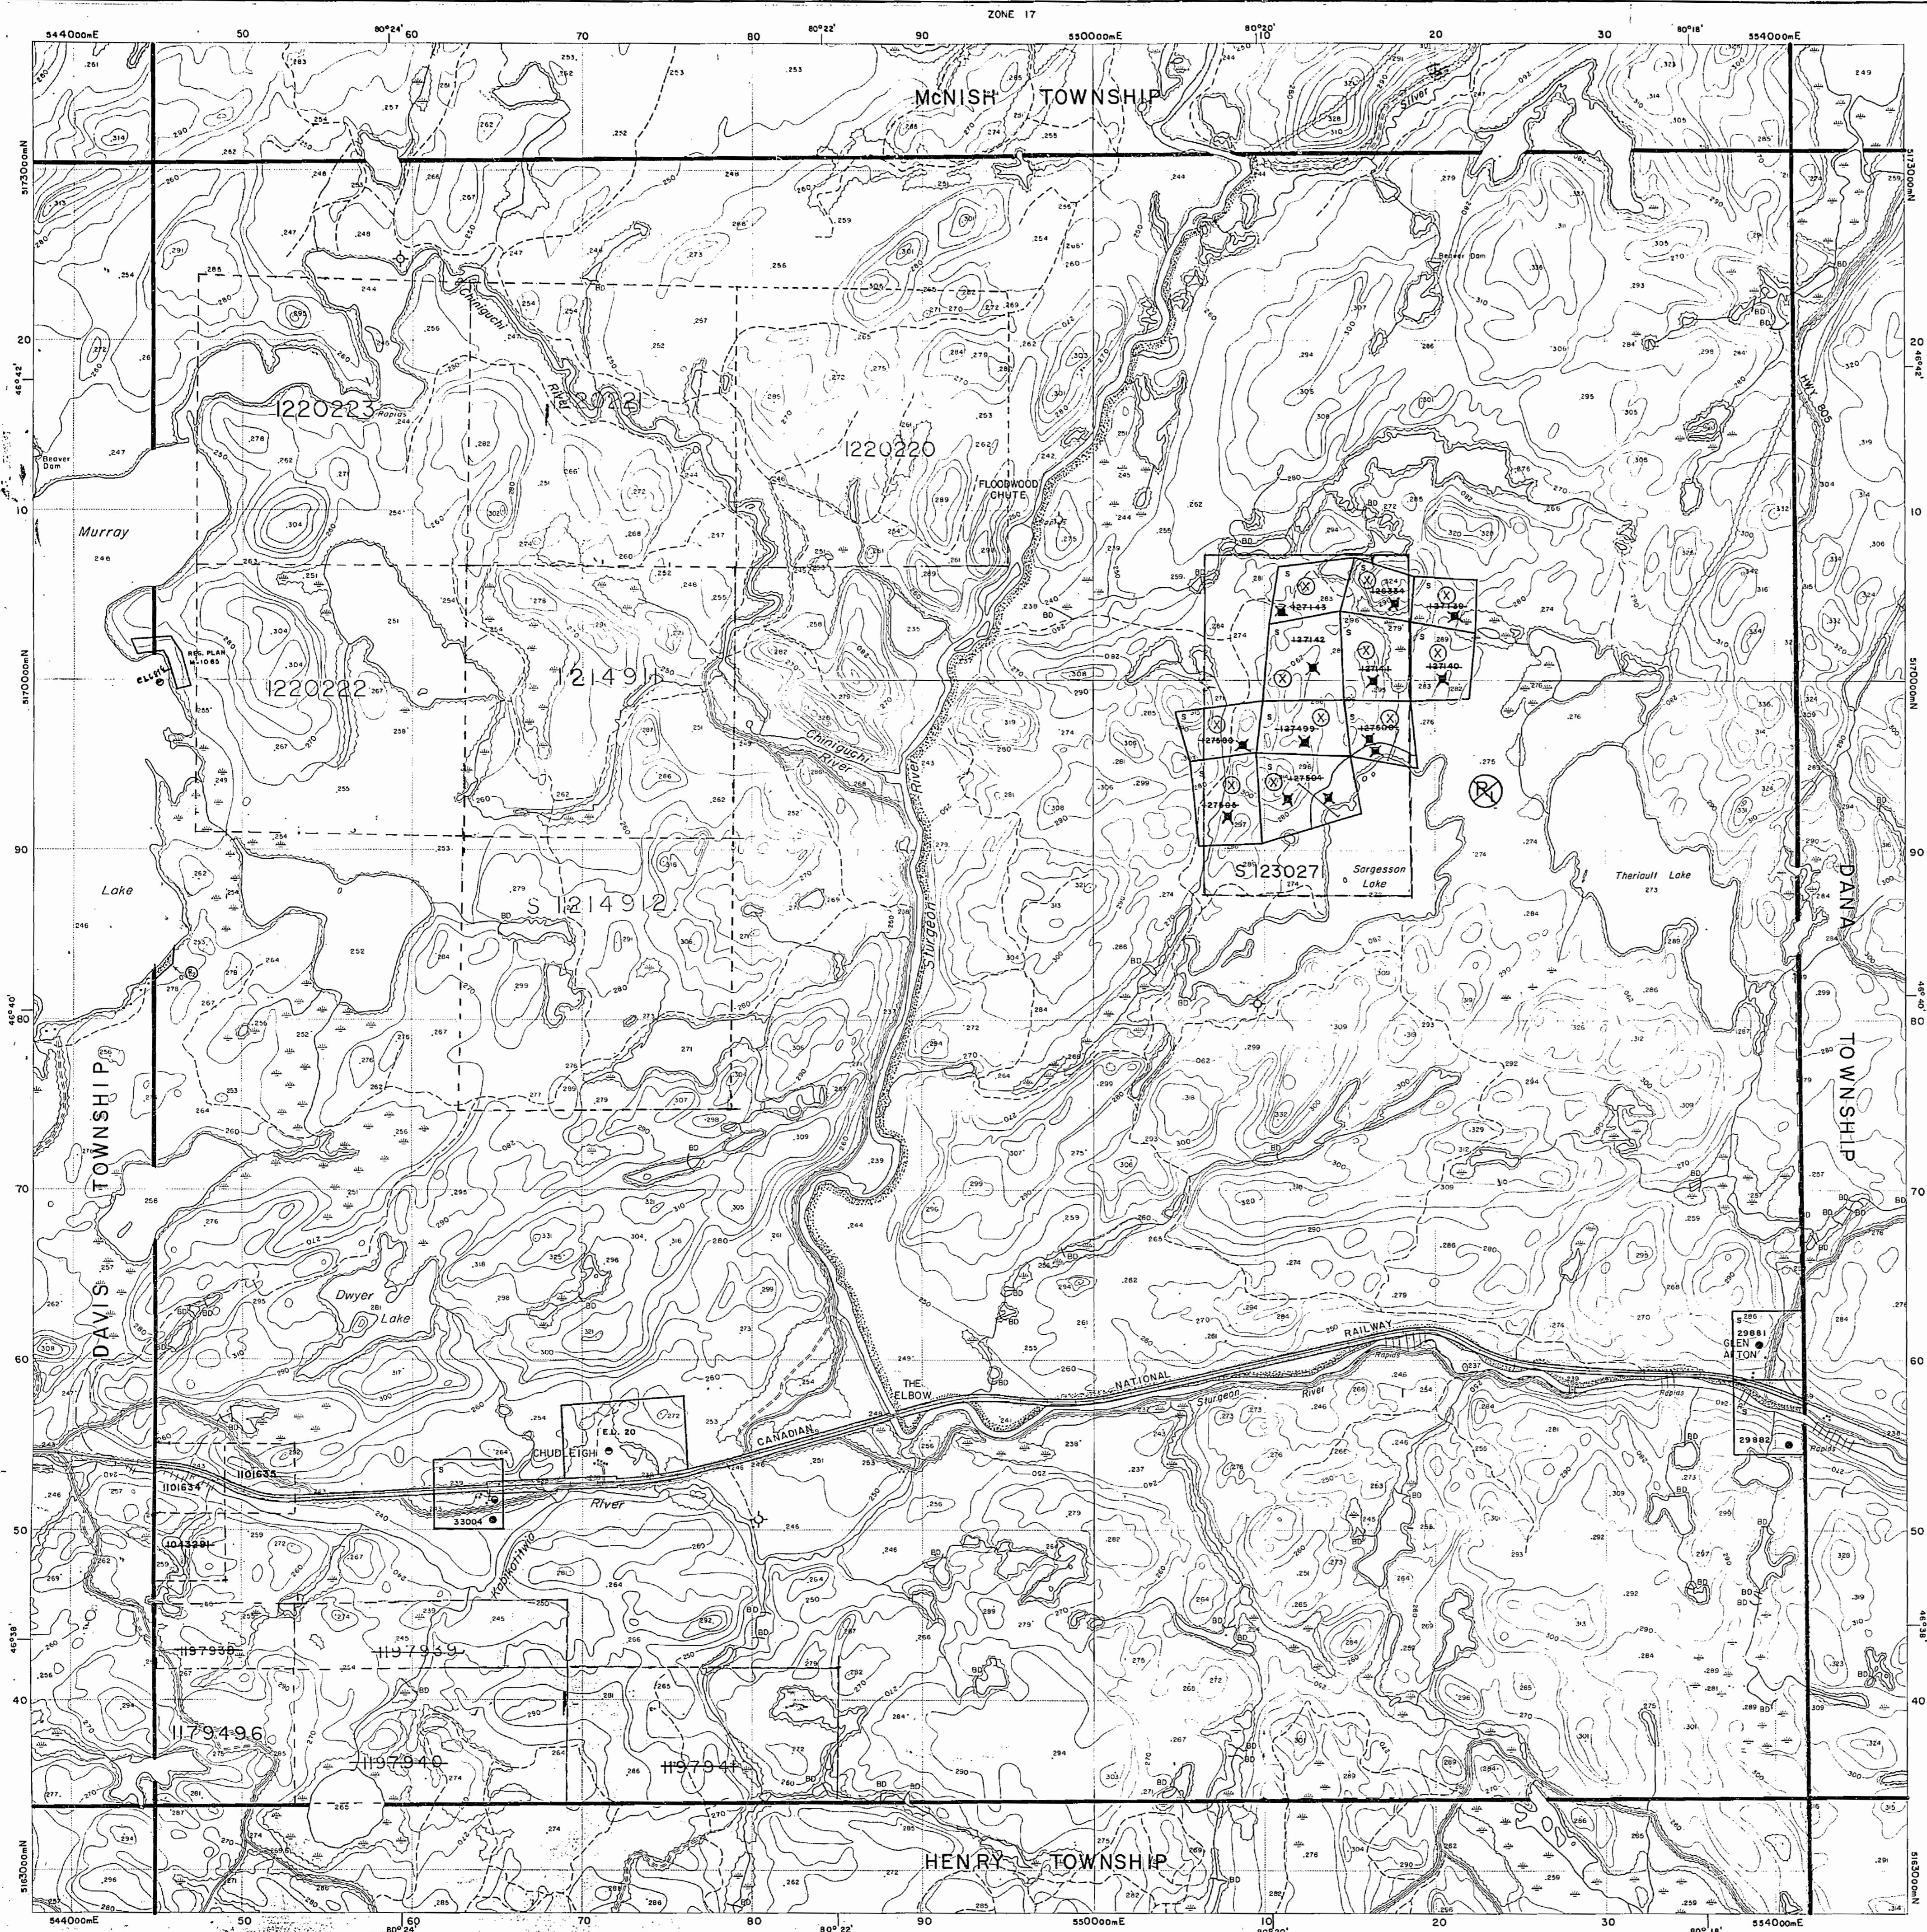

The disposition of land, location of lot fabric and parcel boundaries on this index was compiled for administrative purposes only.

THE TOWNSHIP
OF

JANES

DISTRICT OF
SUDBURY

SUDBURY
MINING DIVISION

SCALE: 1-INCH = 40 CHAINS

LEGEND

PATENTED LAND
CROWN LAND SALE

LEASES

LOCATED LAND

LICENSE OF OCCUPATION

MINING RIGHTS ONLY

SURFACE RIGHTS ONLY

ROADS

IMPROVED ROADS

KING'S HIGHWAYS

RAILWAYS

POWER LINES

MARSH OR MUSKEG

MINES

CANCELLED

(P)

C.S.

(L)

Loc.

L.O.

M.R.O.

S.R.O.

—

—

NOTES


400' Surface Rights Reservation
around all Lakes and Rivers.

Surface Rights Only reserved to the
Dept. of Lands & Forests under
Sec. 39 (d) of the Mining Act shown
thus:

This Township has been Annullled.
Dec. 29, 1953.

Davis Twp. (M-748)

Dana Twp. (M-747)

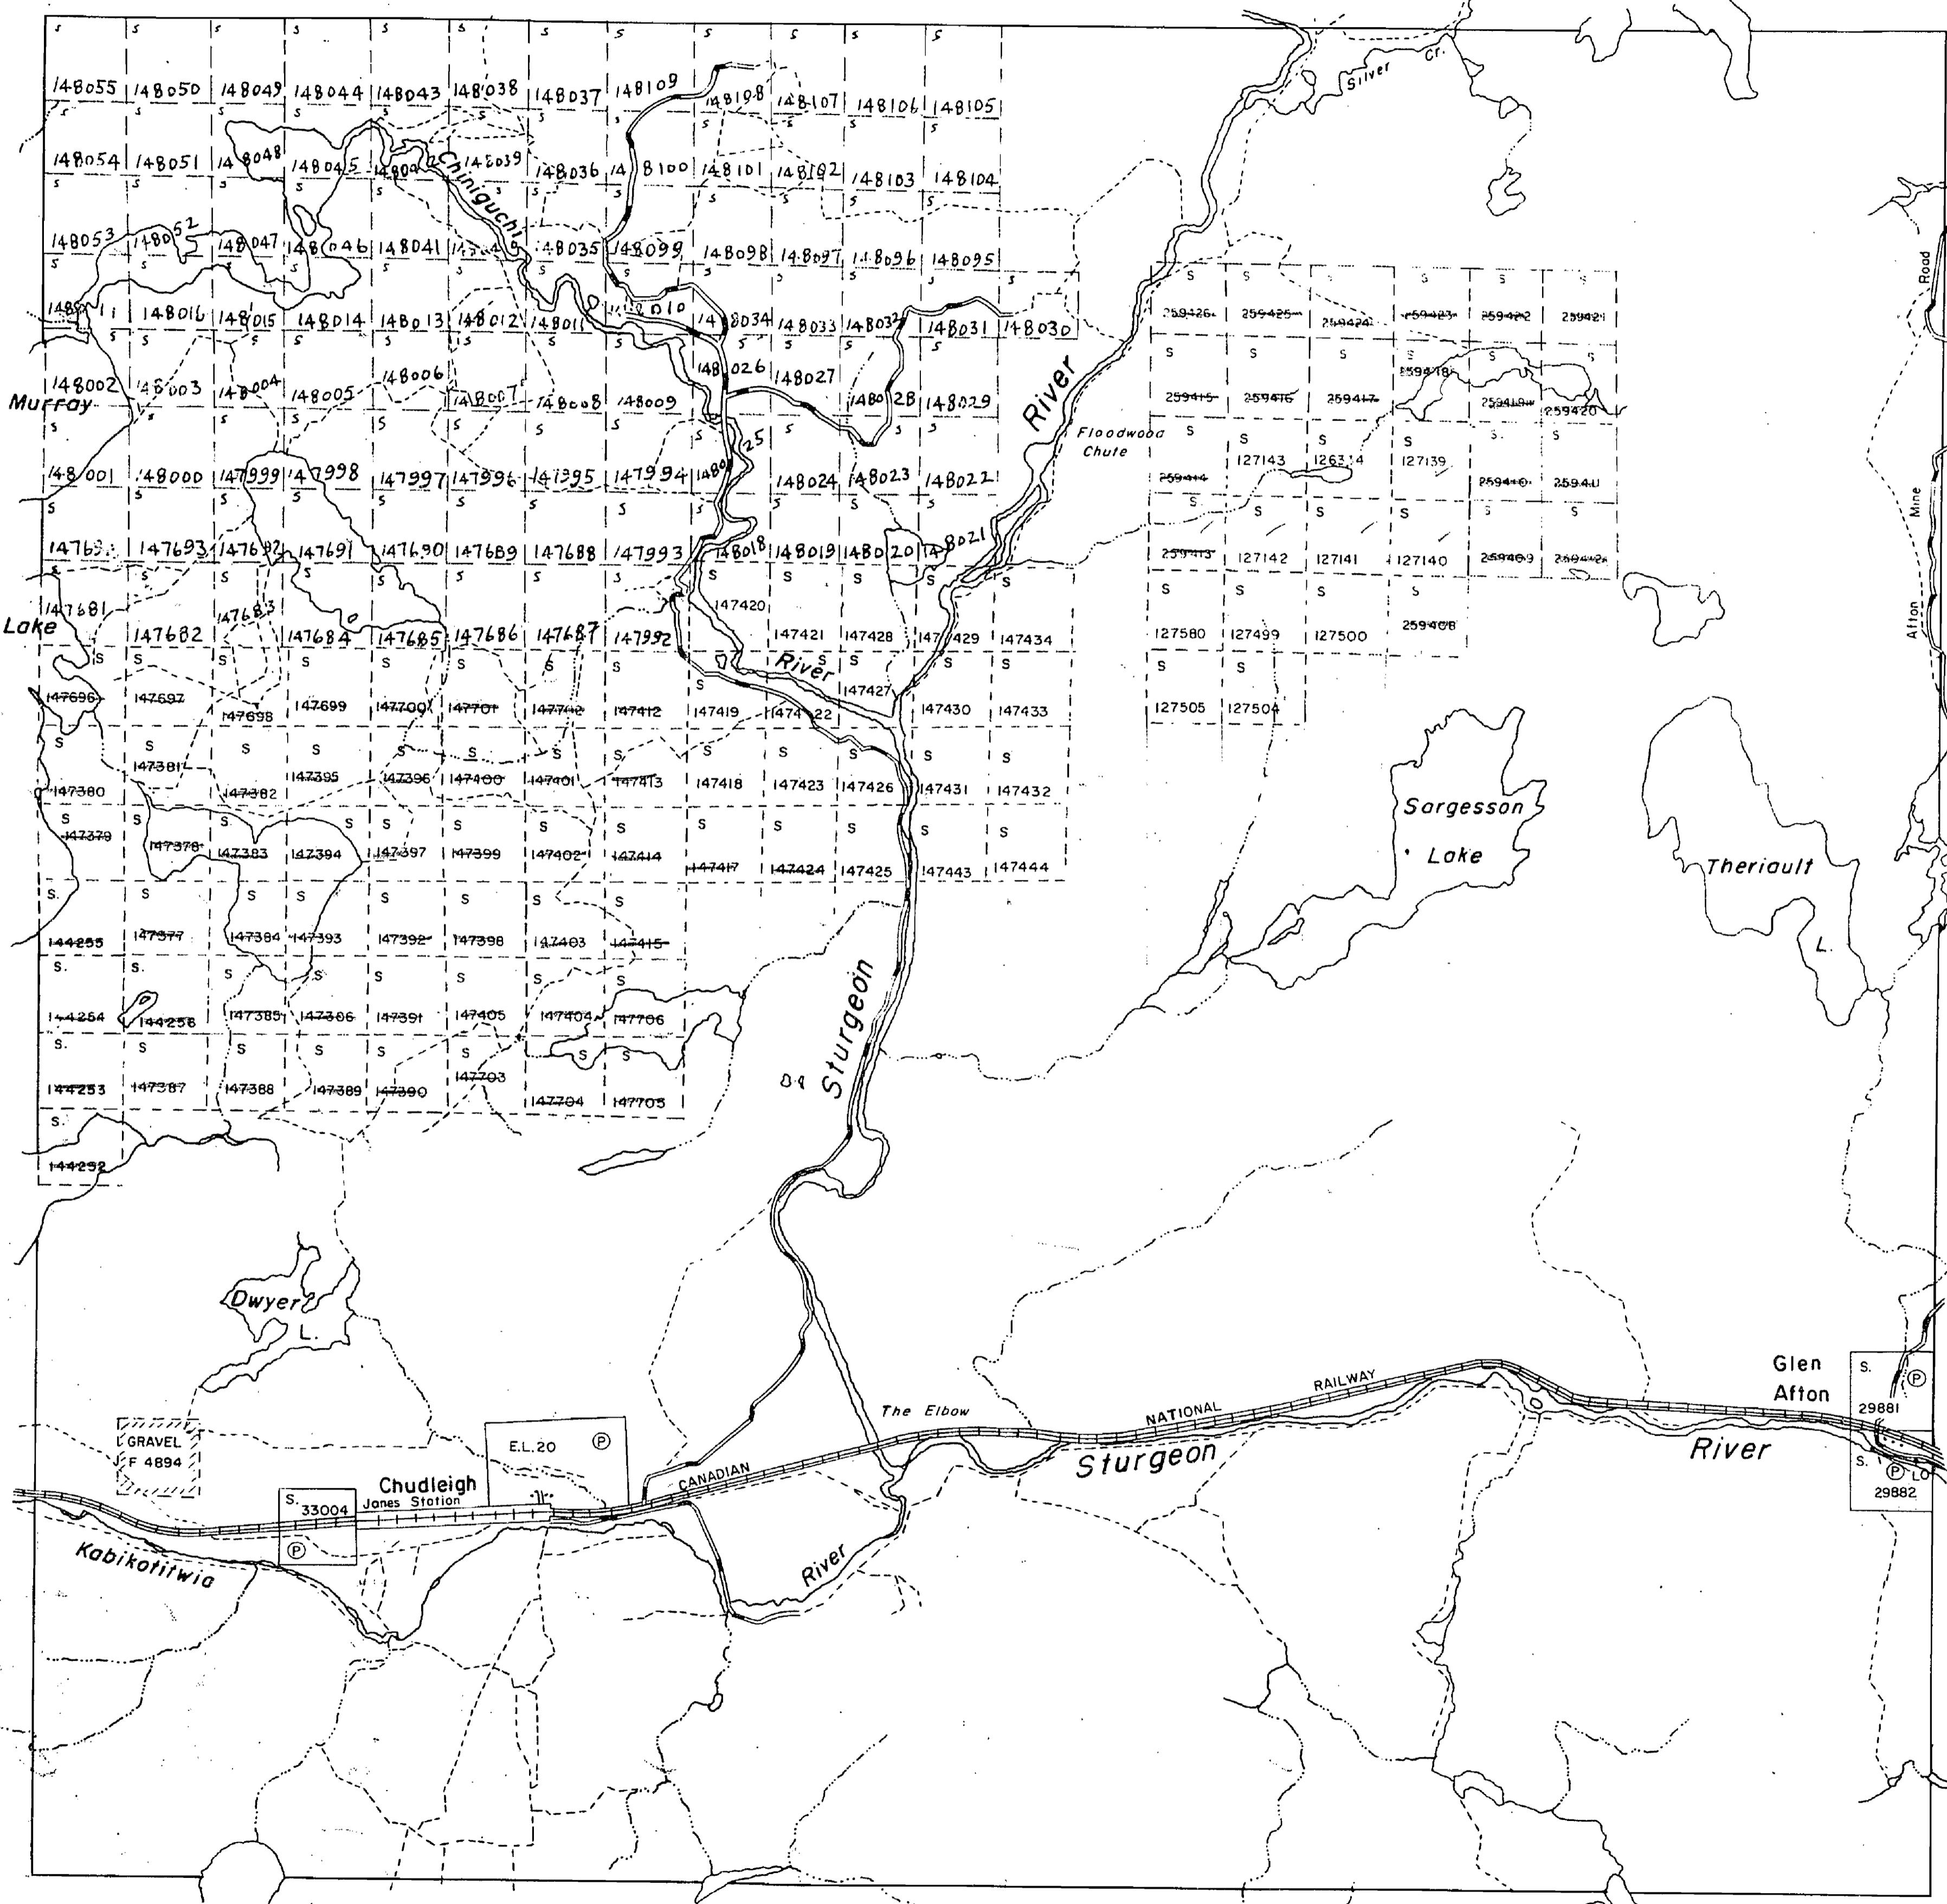


Henry Twp. (M-929)

PLAN NO. M.955

ONTARIO
DEPARTMENT OF MINES
AND NORTHERN AFFAIRS

McNish Twp. (M-1020)

Davis Twp. (M-748)

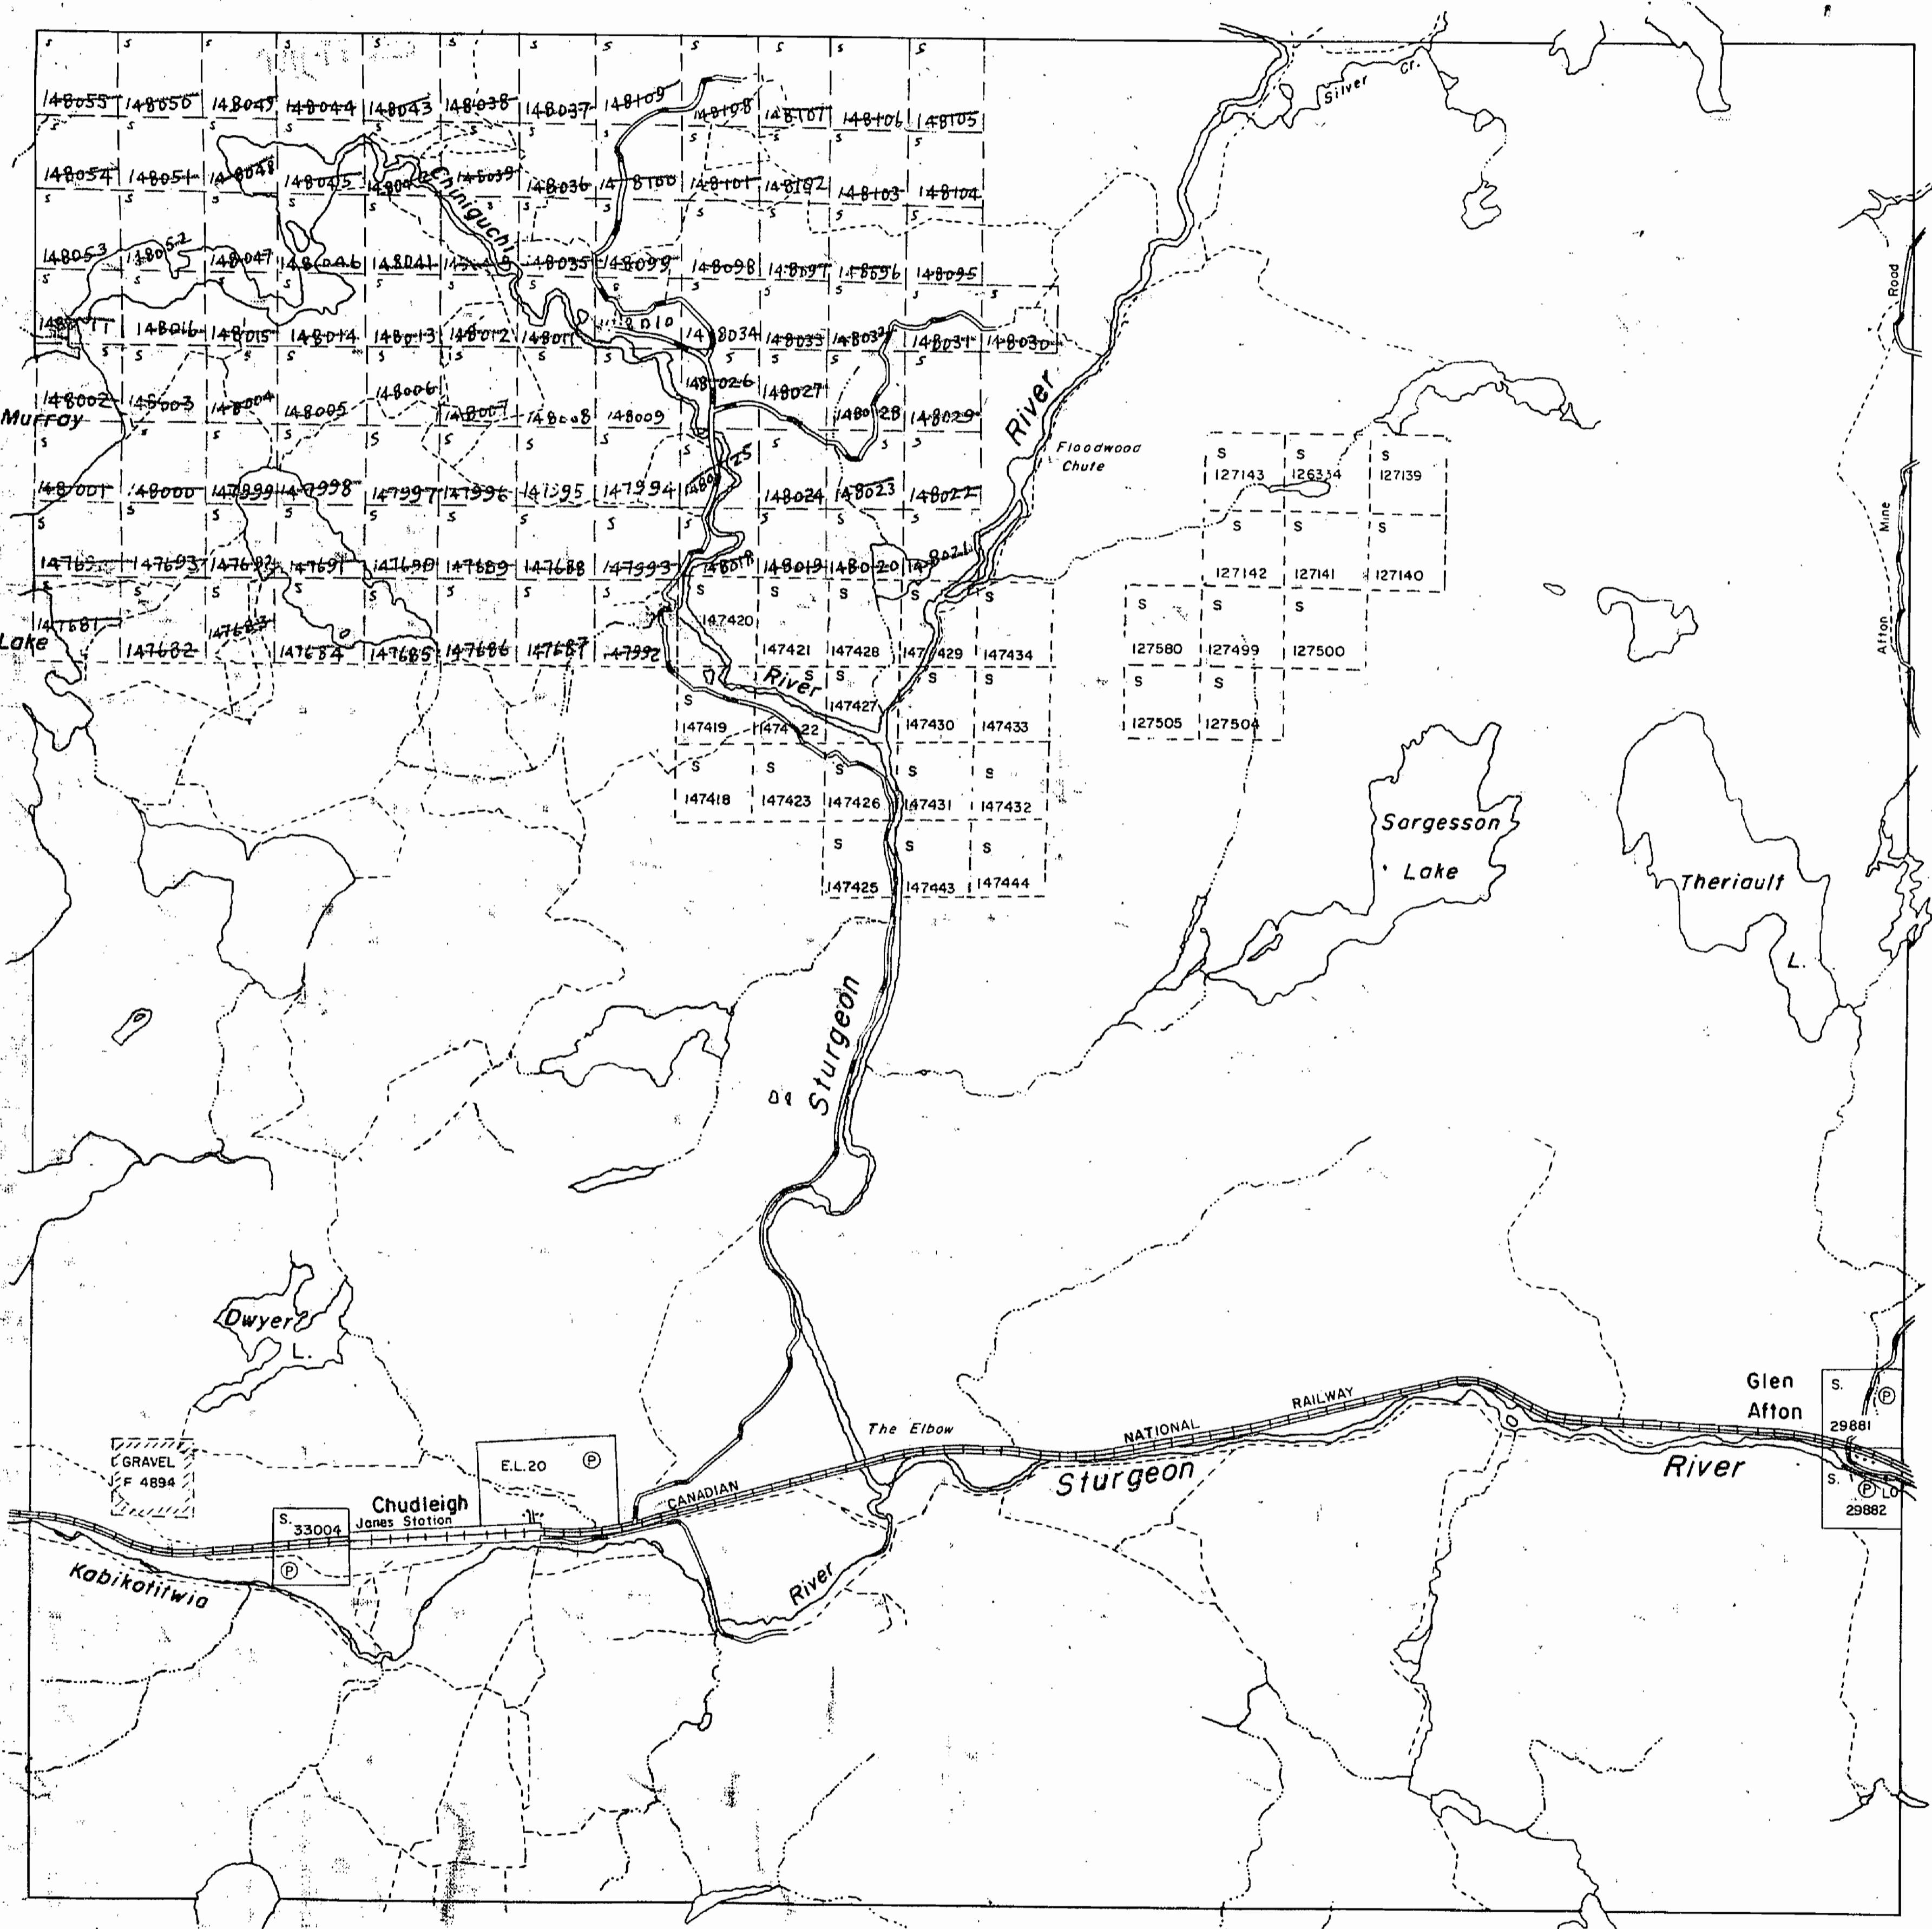

Henry Twp. (M-929)

THE TOWNSHIP OF

JANES

DISTRICT OF SUDBURY

SUDBURY MINING DIVISION

SCALE: 1-INCH = 40 CHAINS

LEGEND

- | | |
|-----------------------|--------|
| PATENTED LAND | (P) |
| CROWN LAND SALE | C.S. |
| LEASES | (L) |
| LOCATED LAND | Loc. |
| LICENSE OF OCCUPATION | L.O. |
| MINING RIGHTS ONLY | M.R.O. |
| SURFACE RIGHTS ONLY | S.R.O. |
| ROADS | |
| IMPROVED ROADS | |
| KING'S HIGHWAYS | |
| RAILWAYS | |
| POWER LINES | |
| MARSH OR MUSKEG | |
| MINES | |
| CANCELLED | C. |

NOTES

400' Surface Rights Reservation
around 67 Lakes and Rivers.

Surface Rights Only reserved to the
Dept. of Lands & Forests under
Sec. 39 (d) of the Mining Act shown
thus: ~~18xx~~

This Township has been Annulled
Dec. 29, 1953.

PLAN NO. M. 955

**ONTARIO
DEPARTMENT OF MINES
AND NORTHERN AFFAIRS**

JANES

— SUDBURY DISTRICT —


SUDBURY DISTRICT

Scale 40 chains to 1 inch

1 Rec.

200

McNISH

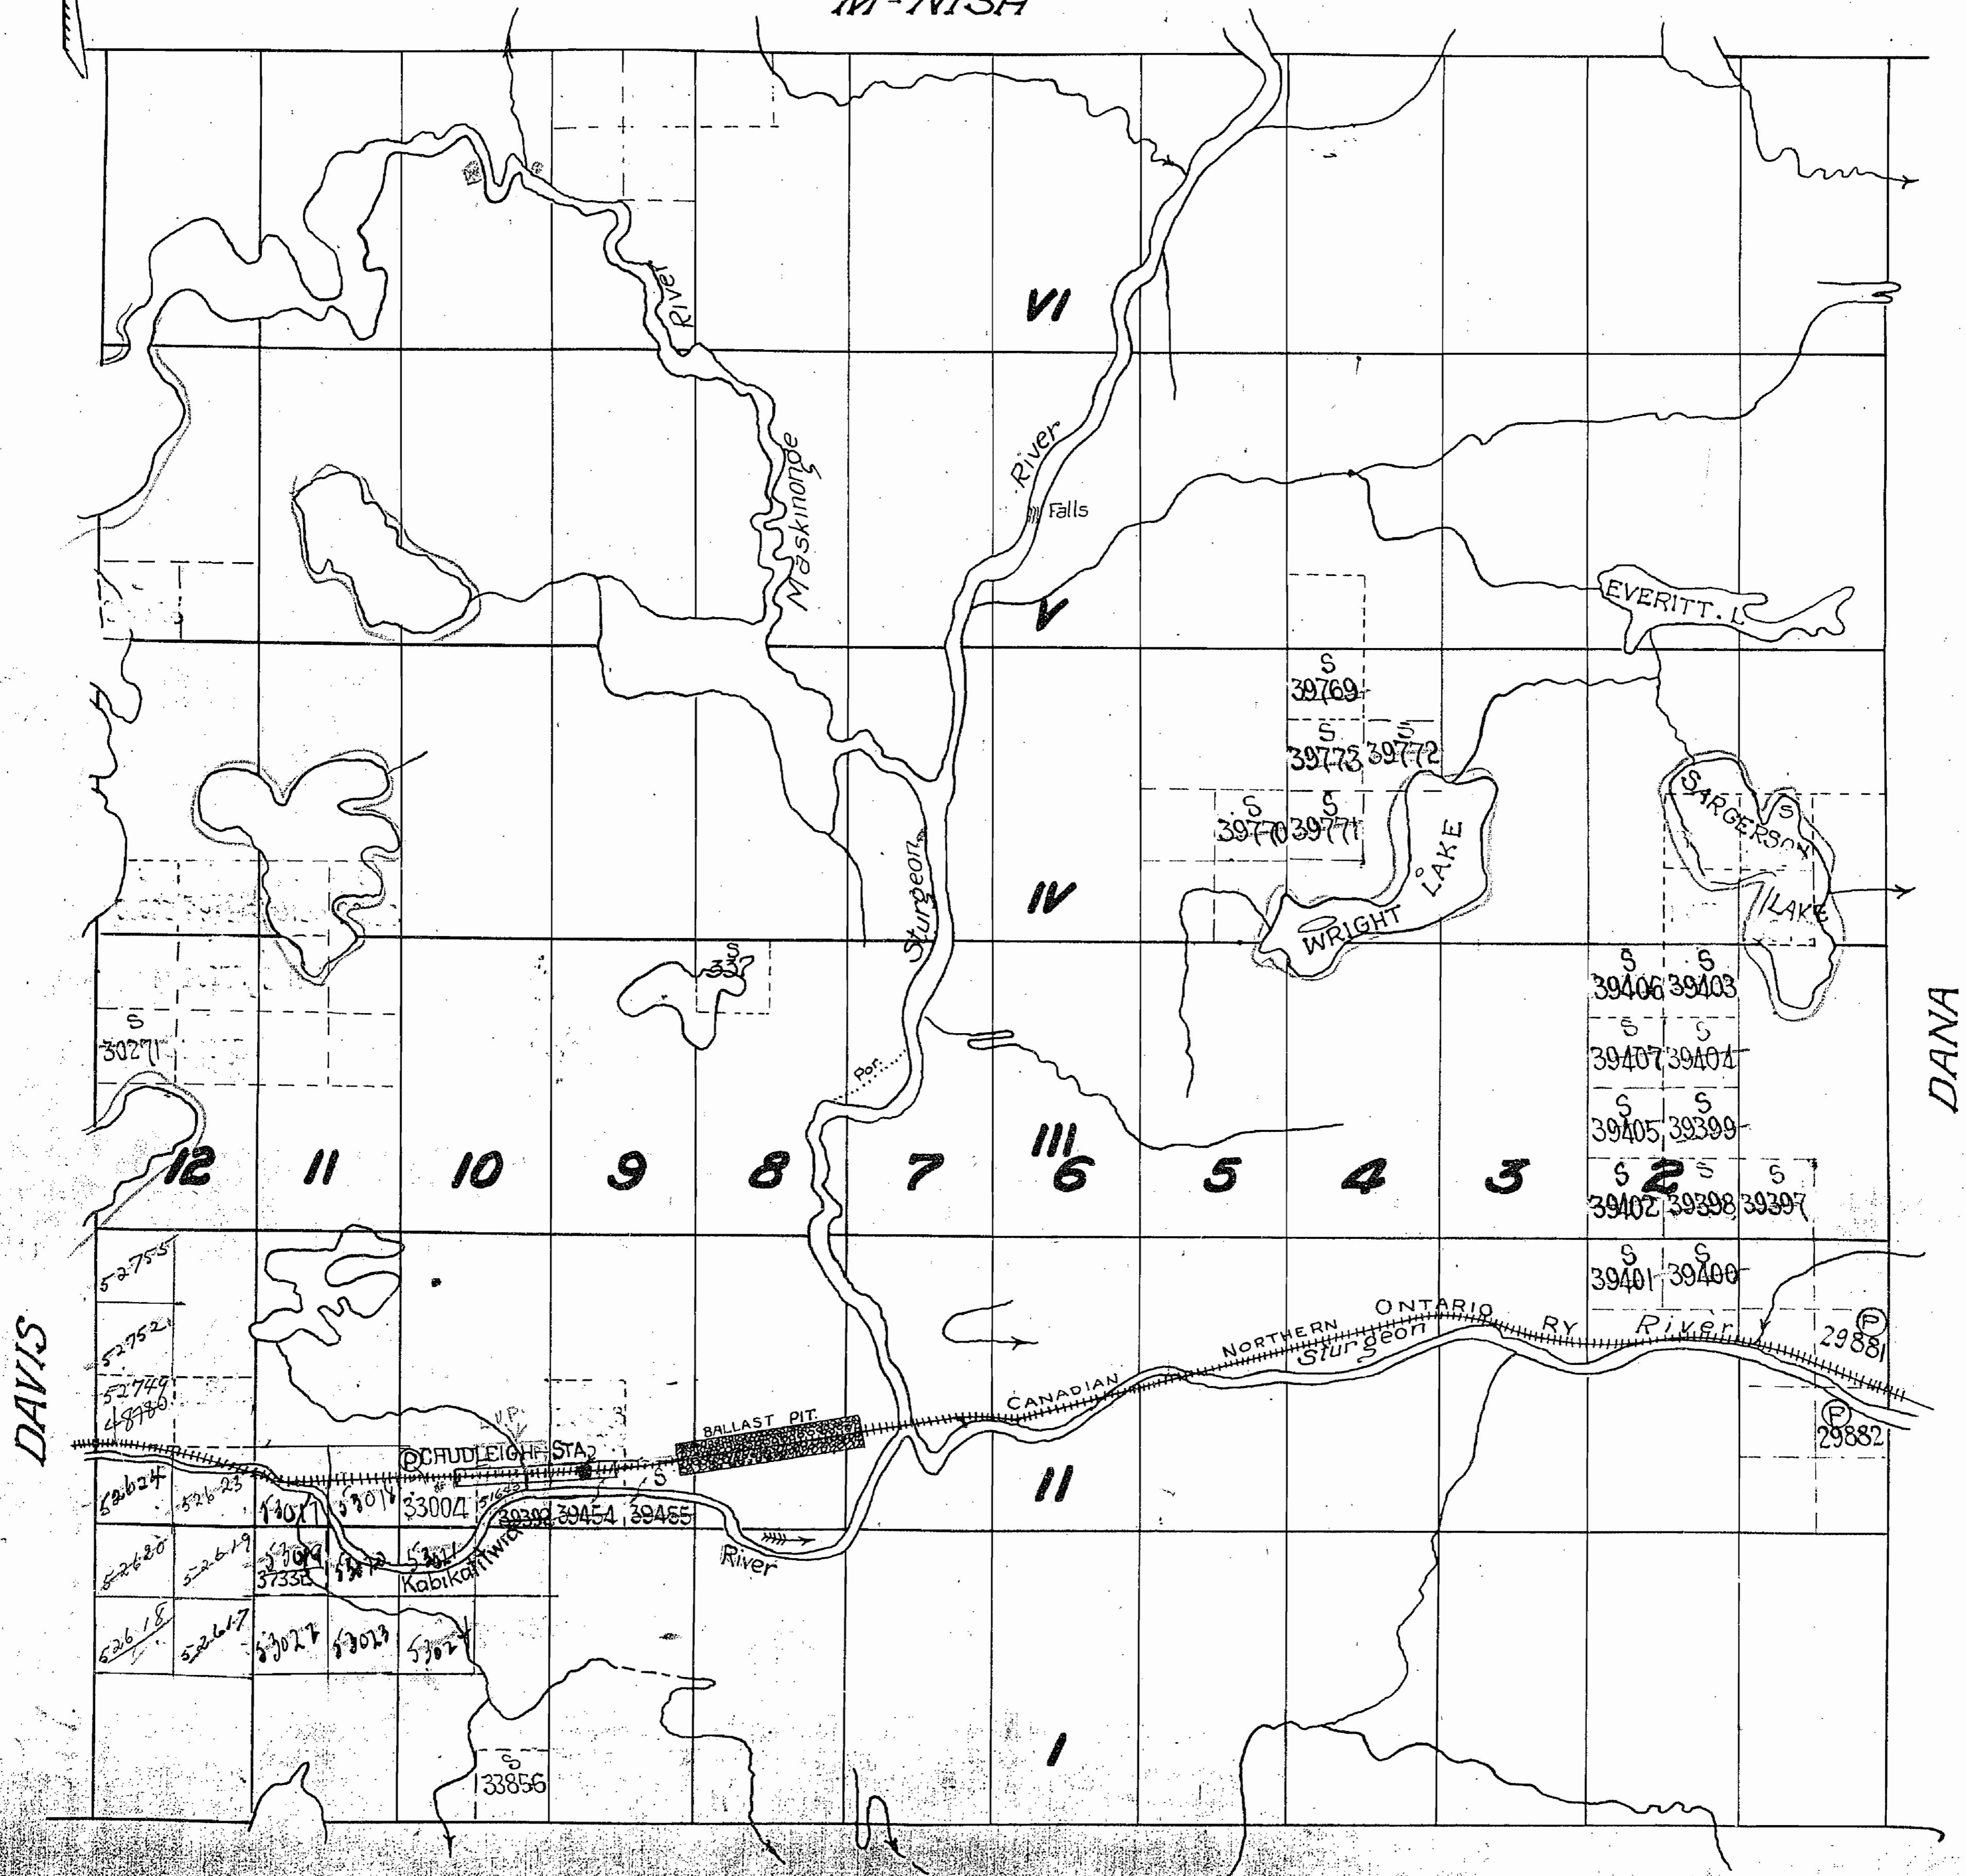


HENRY

M955

McNish Twp.

Davis Twp.

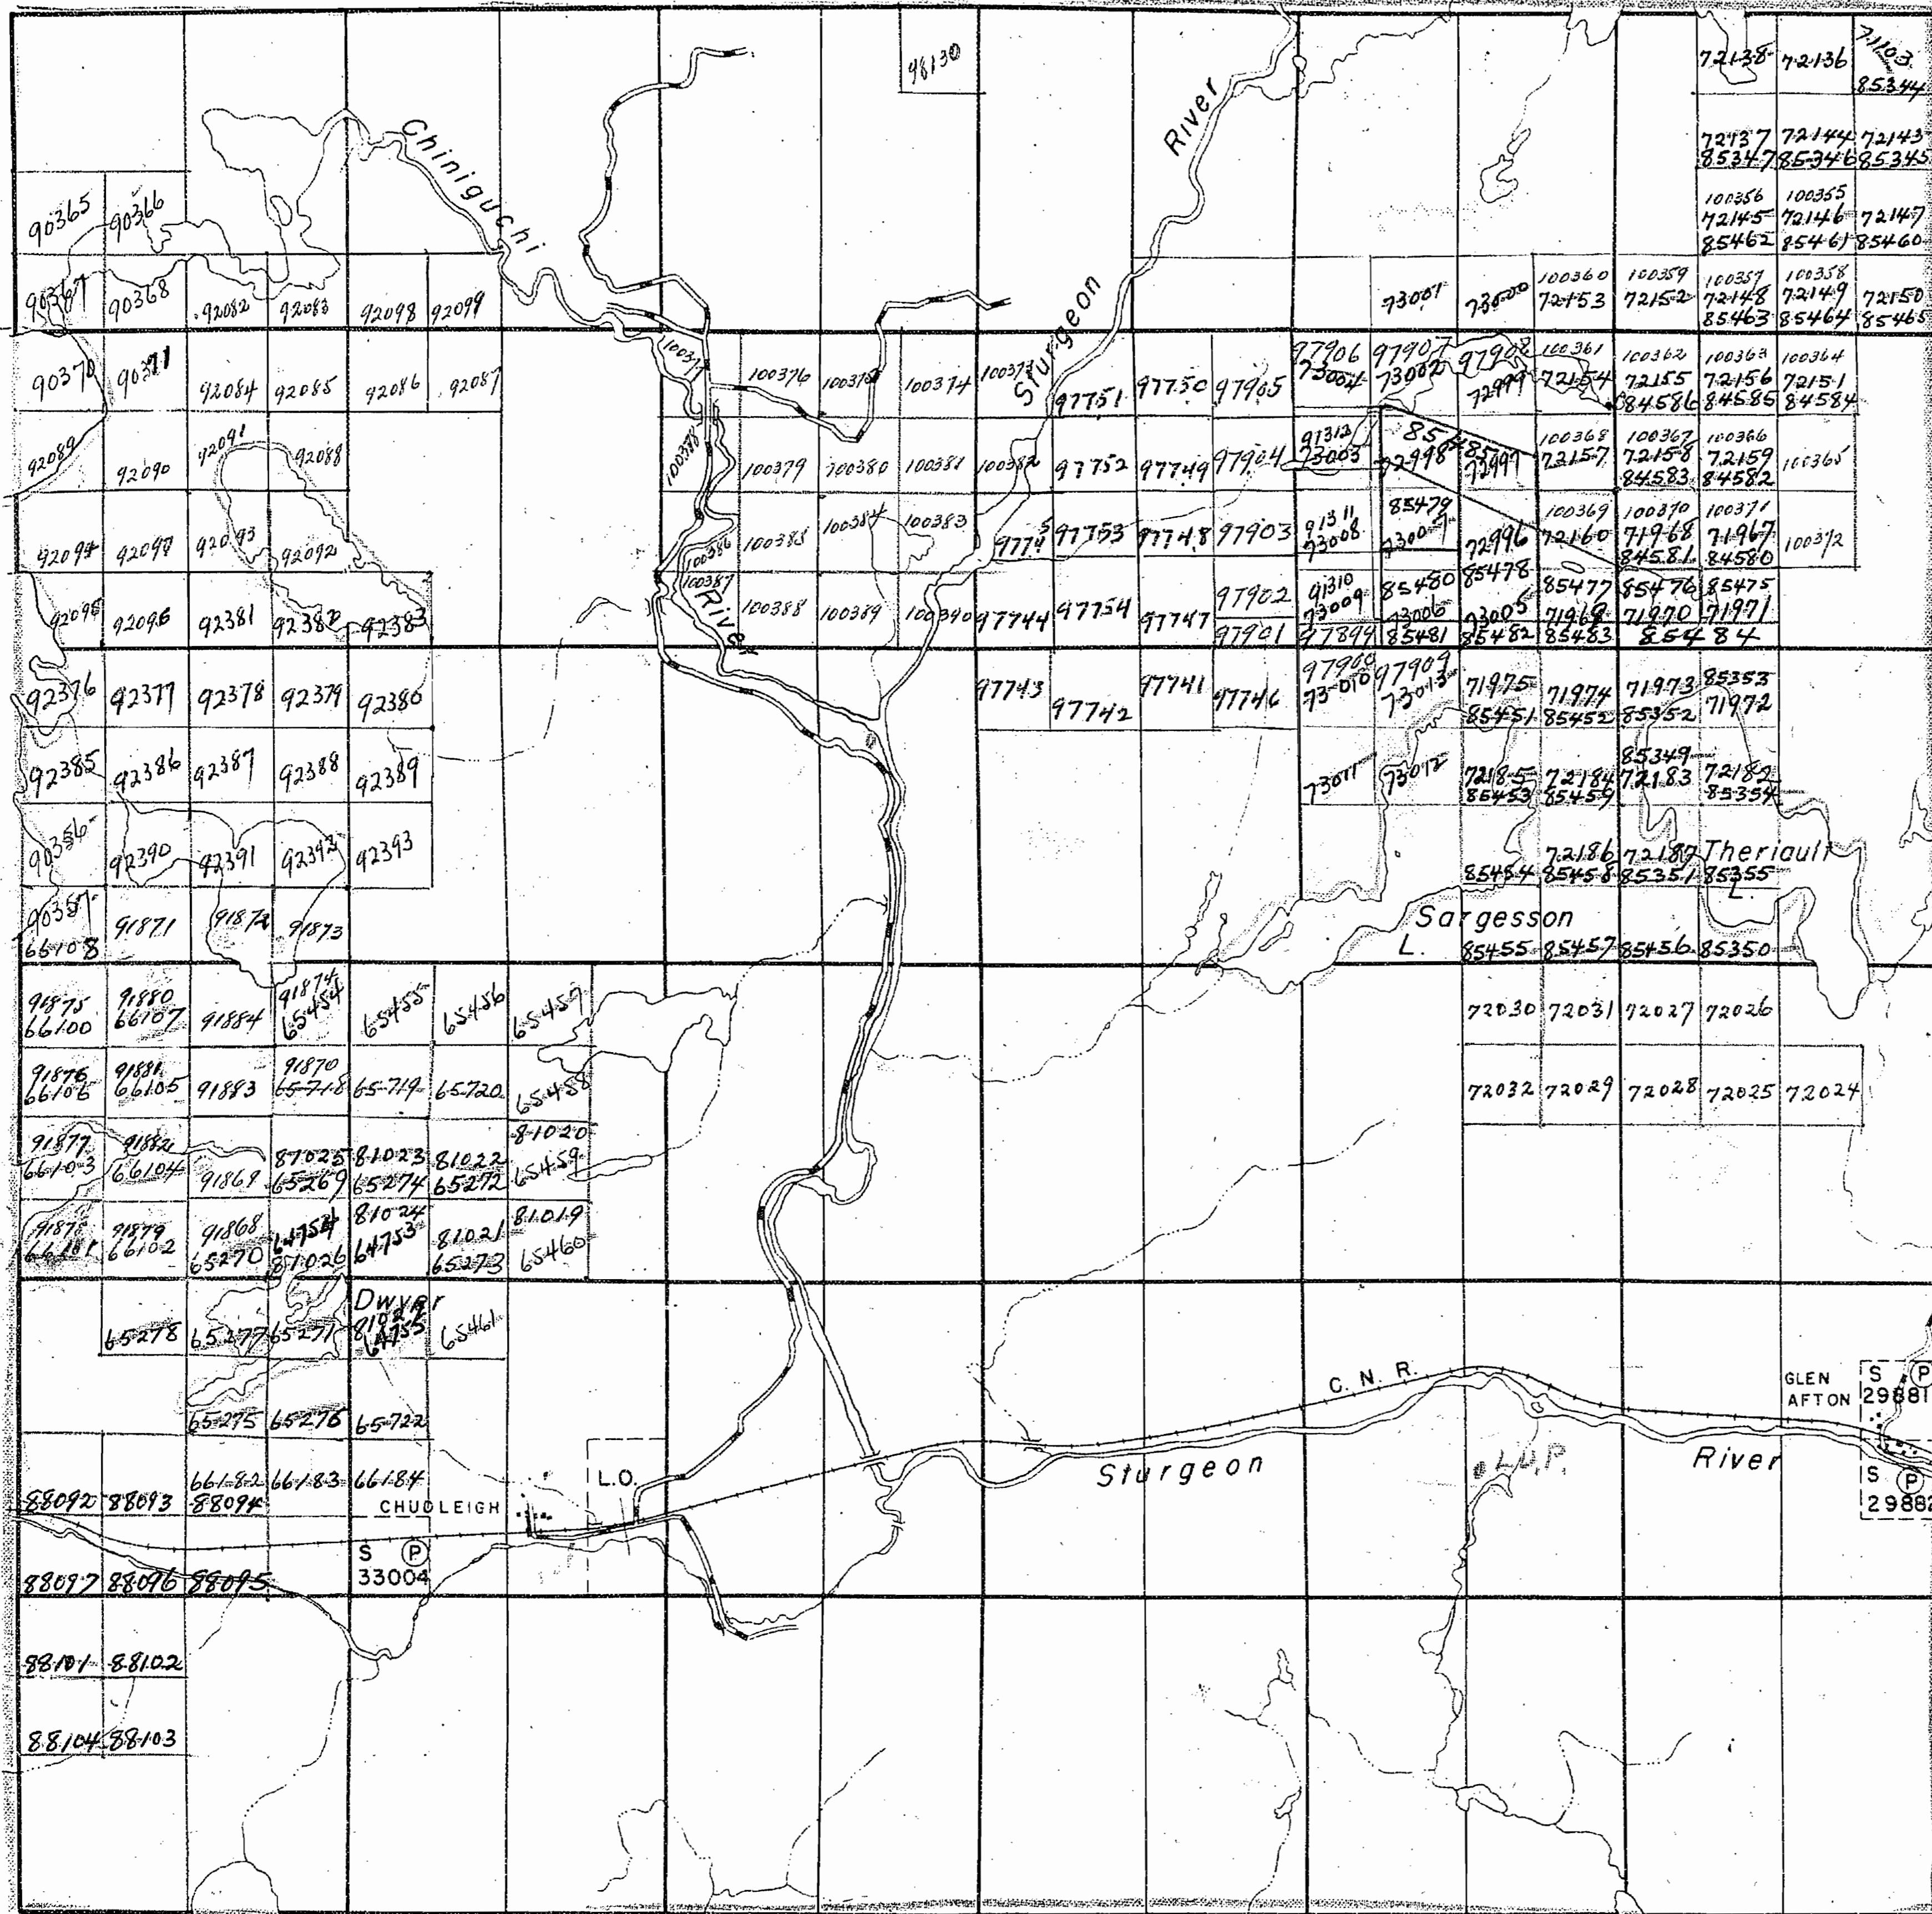

Henry Twp.

200 'Res.

THE TOWNSHIP OF

JANES

DISTRICT OF
SUDBURY

SUDBURY MINING DIVISION

SCALE : 1 INCH = 40 CHAINS

LEGEND

- PATENTED LAND
CROWN LAND SALE
LEASES
LOCATED LAND
LICENSE OF OCCUPATION
MINING RIGHTS ONLY
SURFACE RIGHTS ONLY
ROADS
IMPROVED ROADS
KING'S HIGHWAYS
RAILWAYS
POWER-LINES
MARSH OR MUSKEG
MINES

NOTES

Sub. to. Secy. to

Poste Giudice

M955

PLAN NO.-S.272.

DEPARTMENT OF MINES

—ONTARIO—

955

McNish Twp.

Top file

THE TOWNSHIP
OF

JANES

DISTRICT OF
SUDBURY

SUDSBURY
MINING DIVISION

SCALE : 1-INCH = 40 CHAINS

LEGEND


- | | |
|-----------------------|--------|
| PATENTED LAND | (P) |
| CROWN LAND SALE | C.S. |
| LEASES | (L) |
| LOCATED LAND | Loc. |
| LICENSE OF OCCUPATION | L.O. |
| MINING RIGHTS ONLY | M.R.O. |
| SURFACE RIGHTS ONLY | S.R.O. |
| ROADS | |
| IMPROVED ROADS | |
| KING'S HIGHWAYS | |
| RAILWAYS | |
| POWER LINES | |
| MARSH OR MUSKEG | |
| MINES | X X X |

NOTES

Mining Claims Accepted Under The
Provision Of Section 53 Of The
Mining Act.


400' Reserve to Dept. of Lands & Forests
shown thus _____

S.R.C. on Pt. Lots 1 & 2 Con 11
by L. & F.

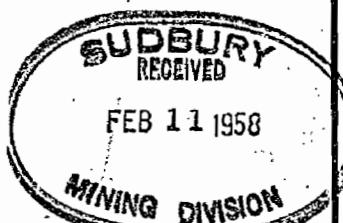

PLAN NO.- M-955

DEPARTMENT OF MINES
—ONTARIO—

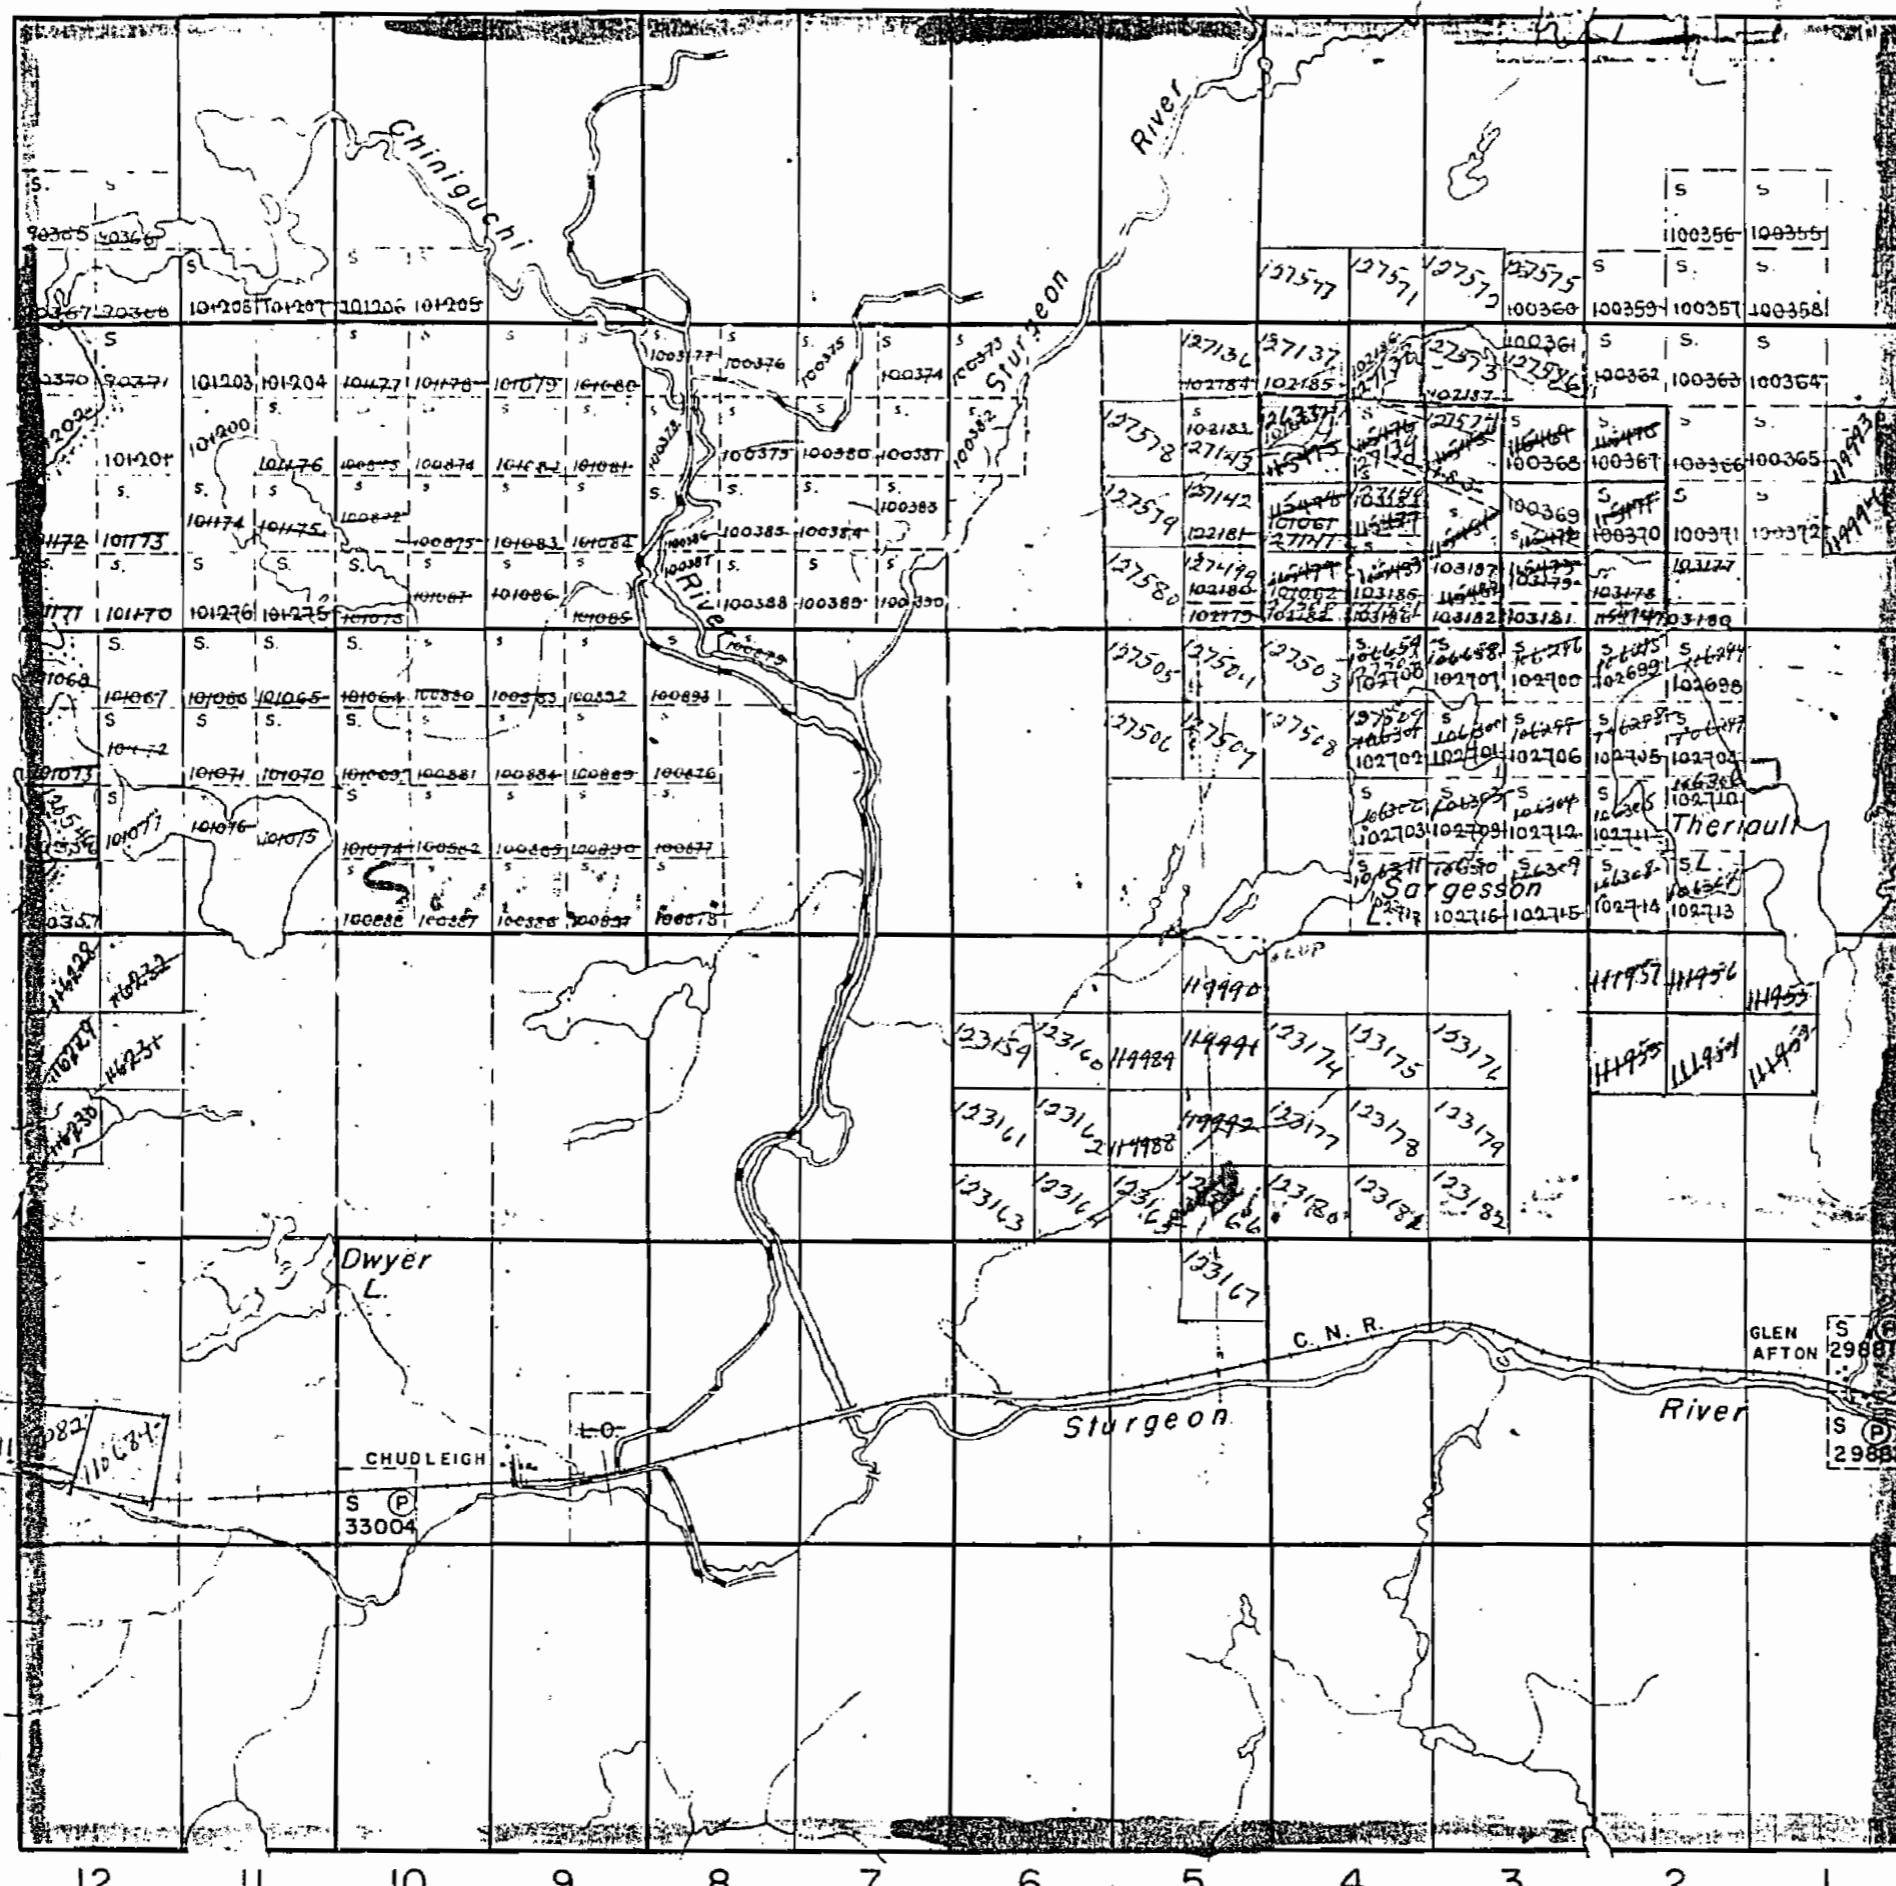


Henry Twp. .

11

955

McNish Twp.

Twp file

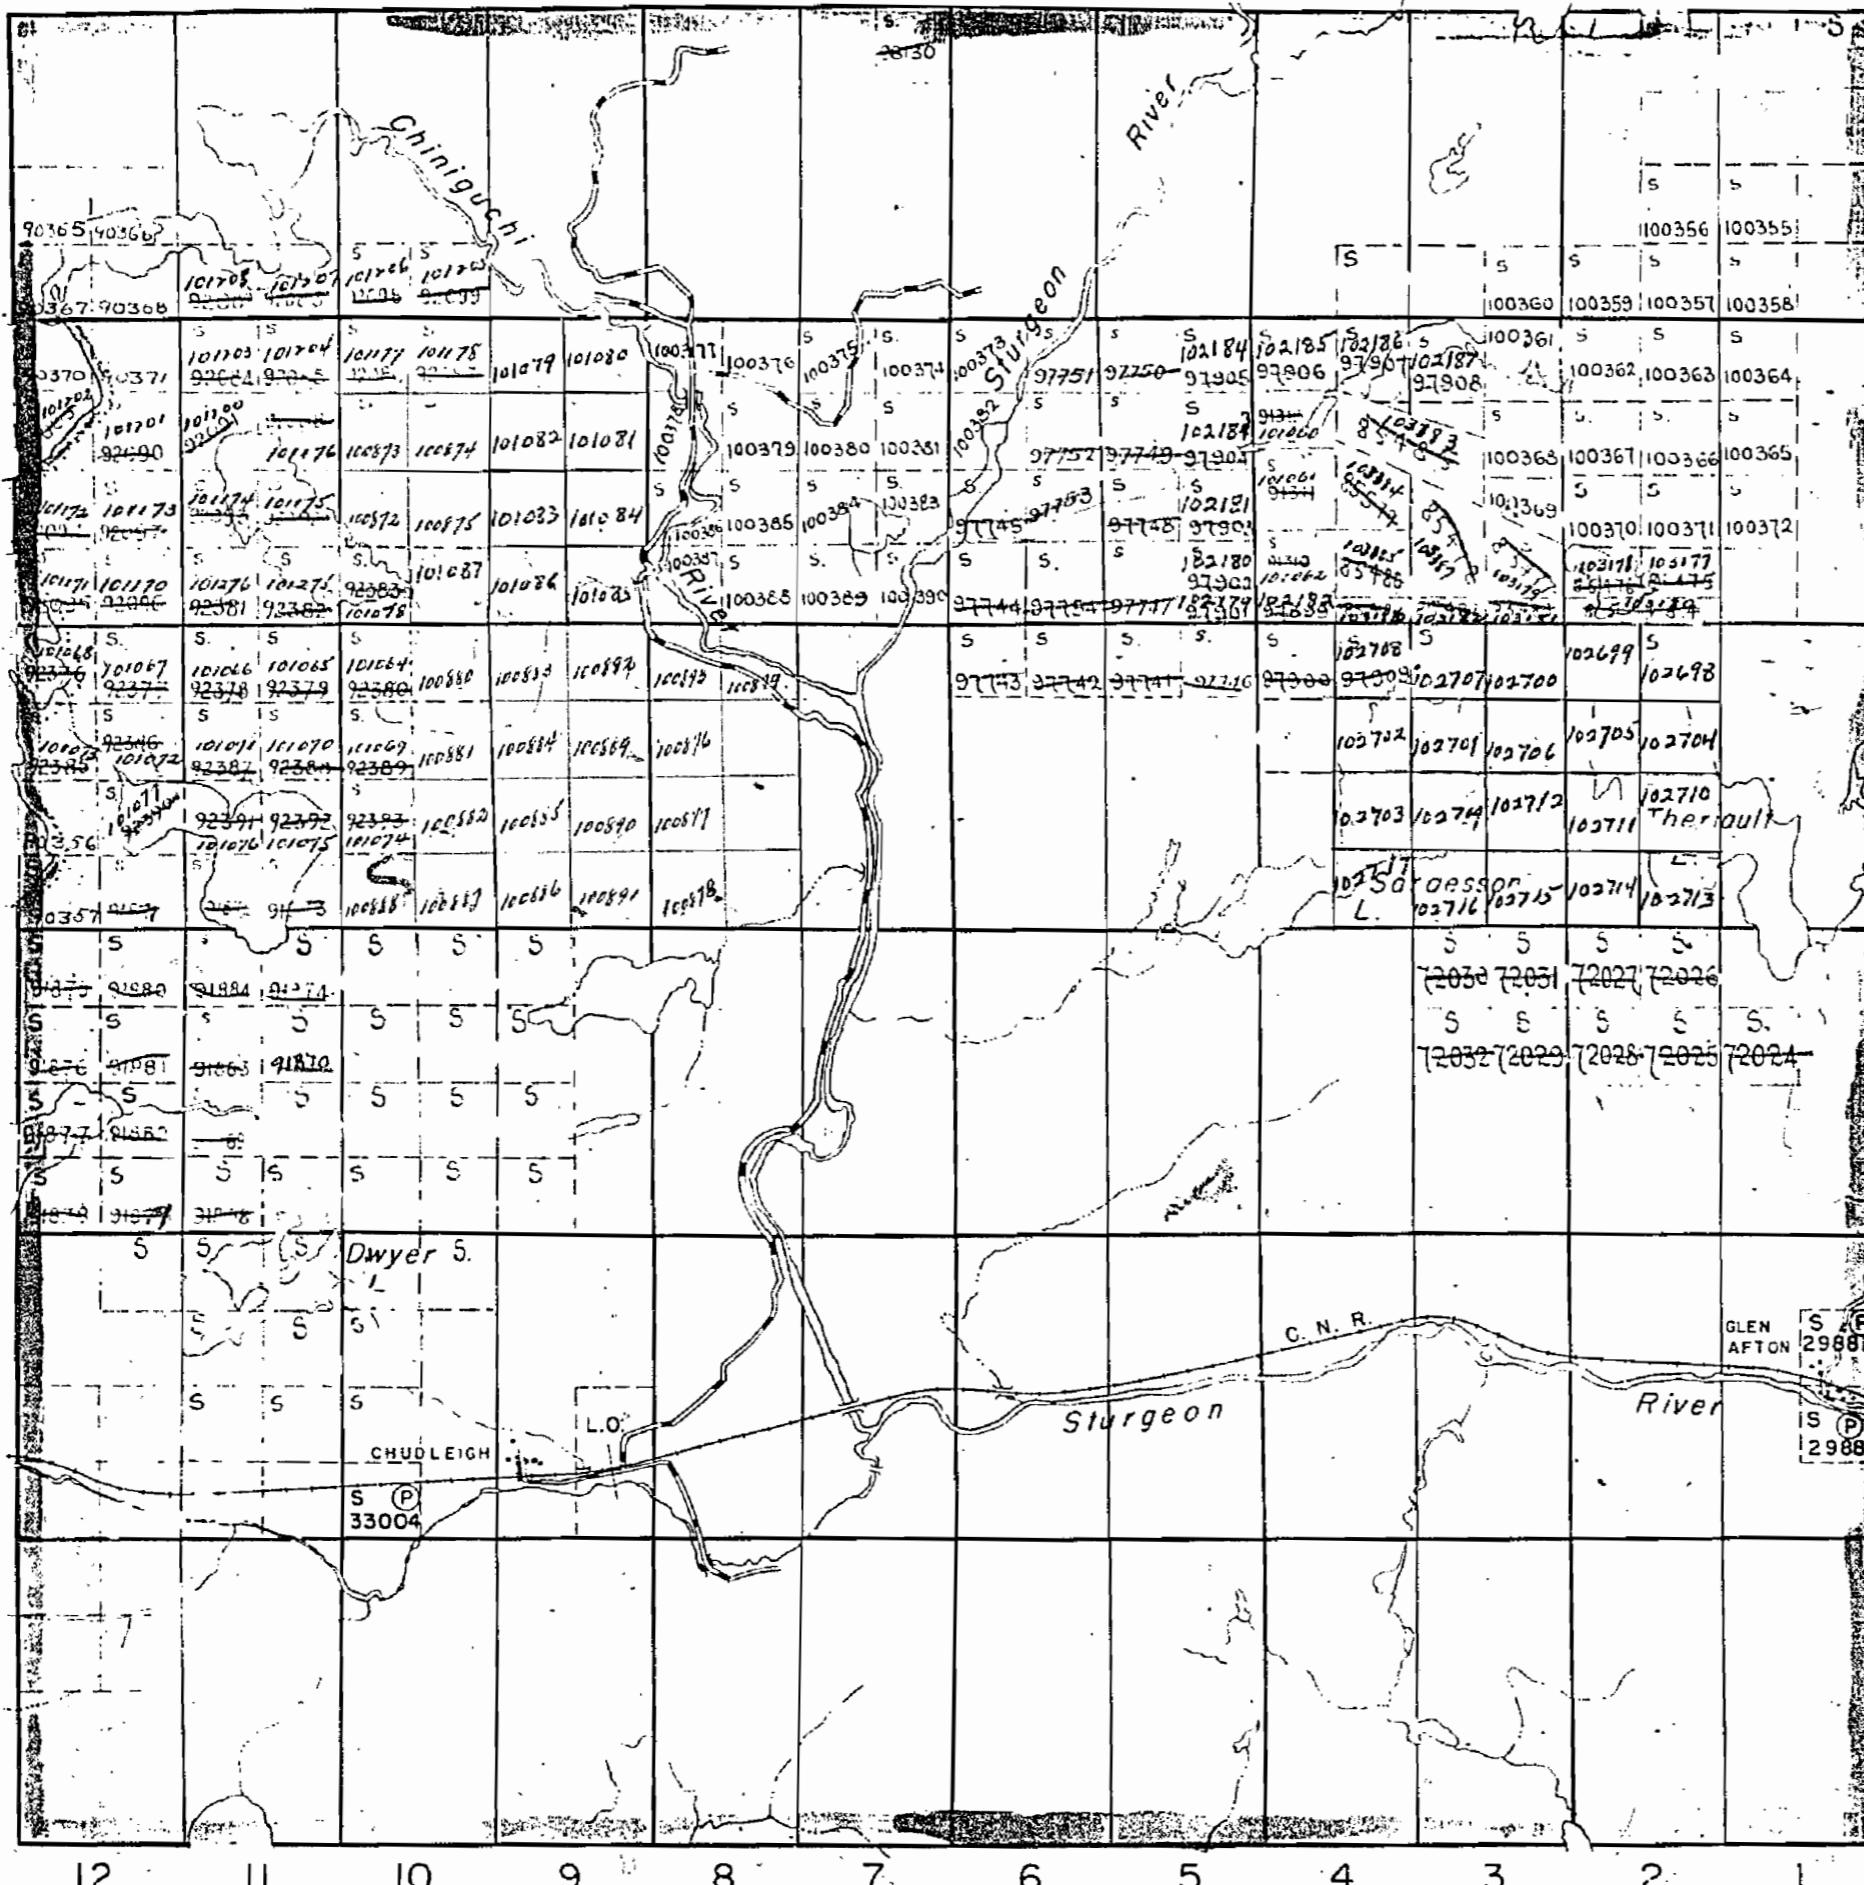Old
VI

V

IV

III

II

I

THE TOWNSHIP
OF
JANES

DISTRICT OF
SUDBURY
SUDBURY
MINING DIVISION

SCALE: 1-INCH = 40 CHAINS

LEGEND

(P)	PATENTED LAND
(CS)	CROWN LAND SALE
(L)	LEASES
(Loc.)	LOCATED LAND
(L.O.)	LICENSE OF OCCUPATION
(M.R.O.)	MINING RIGHTS ONLY
(S.P.O.)	SURFACE RIGHTS ONLY
ROADS	ROADS
IMPROVED ROADS	IMPROVED ROADS
KING'S HIGHWAYS	KING'S HIGHWAYS
RAILWAYS	RAILWAYS
POWER LINES	POWER LINES
MARSH OR MUSKEG	MARSH OR MUSKEG
MINES	MINES

NOTES


Mining Claims Accepted Under The
Provision Of Section 53 Of The
Mining Act.

400' Reserve to Dept. of Lands & Forests
shown thus

July 1st 1955 - Post Stamps

PLAN NO.- M-955

DEPARTMENT OF MINES
ONTARIO

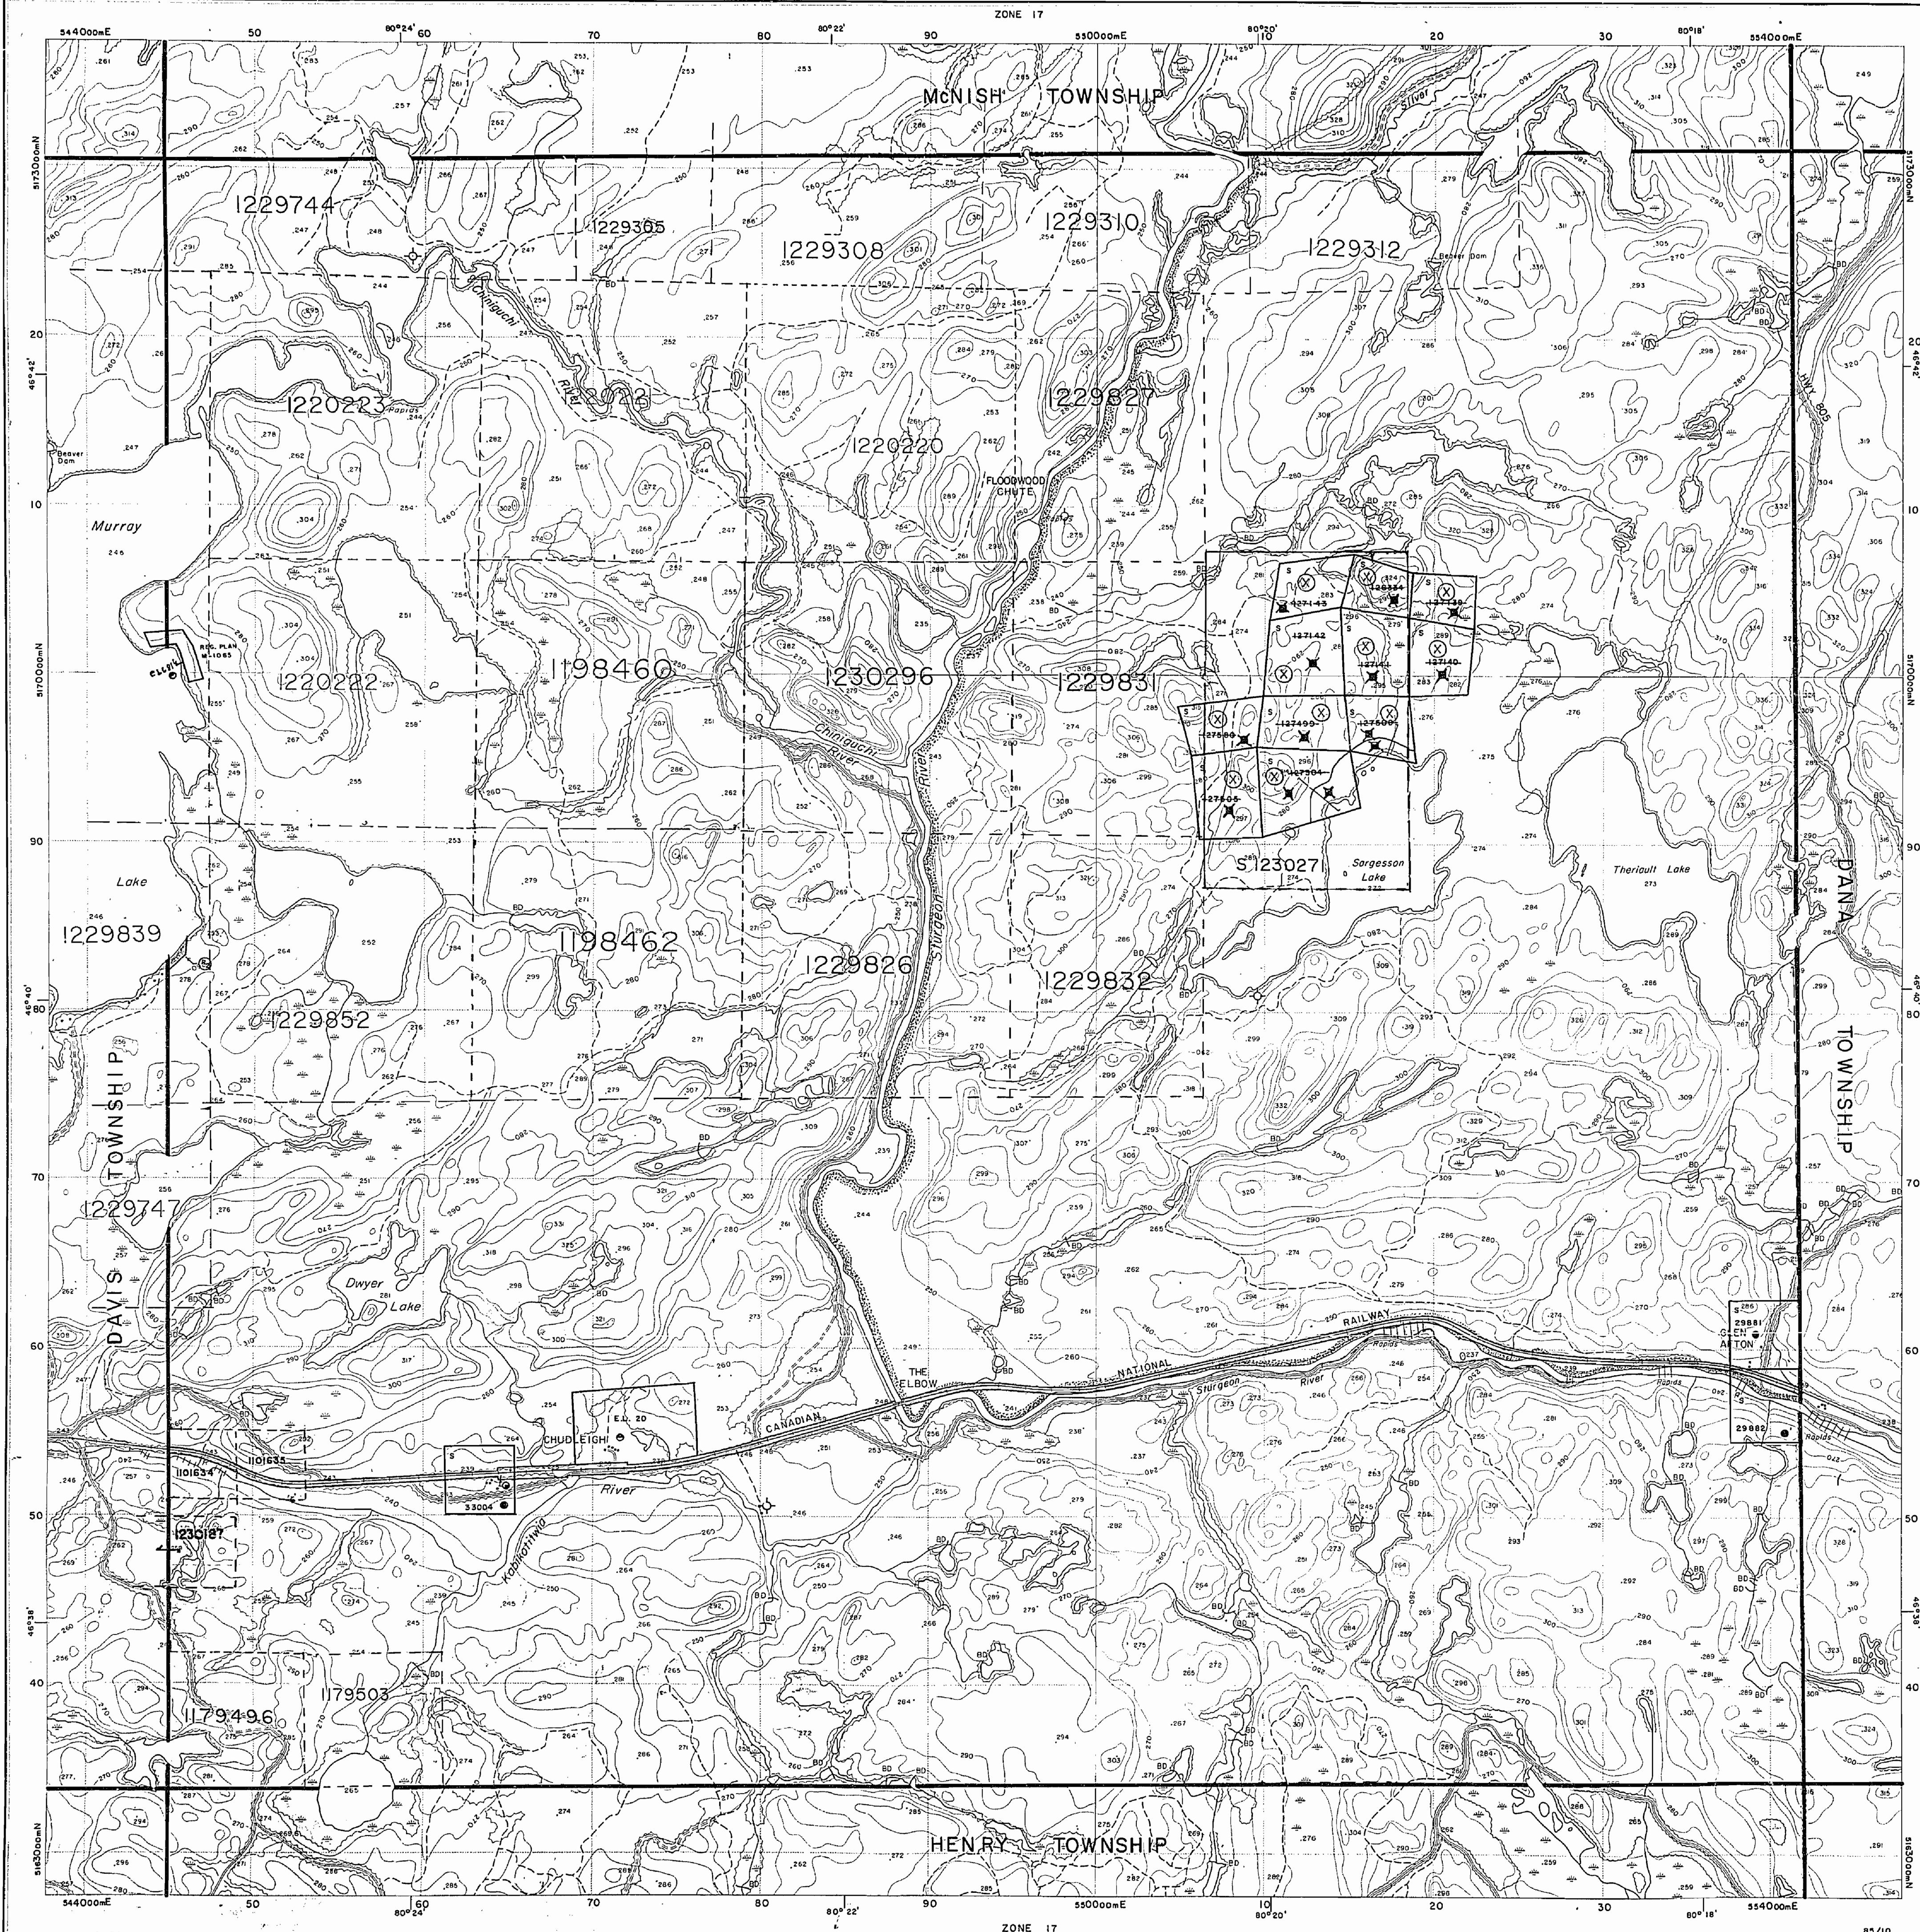

Ministry of
Natural
Resources
Ontario

Ministry of
Northern Affairs
and Mines

INDEX TO LAND DISPOSITION

PLAN

G-2907

TOWNSHIP

JANES

M.N.R. ADMINISTRATIVE DISTRICT

NORTH BAY

MINING DIVISION

SUDBURY

LAND TITLES/REGISTRY DIVISION

SUDBURY

Scale 1:20 000
Metres 1000 0 1000 2000 Metres
Feet 1000 0 1000 2000 3000 4000 5000 6000 7000 8000 9000 10000 Feet

Contour Interval 10 Metres

AREAS WITHDRAWN FROM DISPOSITION

MRO - Mining Rights Only
SRO - Surface Rights Only
M+S = Mining and Surface Rights

Description	Order No.	Date	Disposition	File
Sec. 3, 5, 7 & 9 Sec. 3, 5, 6 & 8	0-3-7/85 0-6-8/84	04/14/85 04/13/84	M + S M + S	195160 195161
Sec. 43, 70	W. 94/77	6/12/77	S RO	188530

Part of order W 2/64 REOPENED by order
O-ML O/19/90 MER effective April 3/9/90 at 7:00 AM E.S.T.

SYMBOLS

Boundary	Township, Meridian, Baseline.....
	Road allowance: surveyed.....
	unsurveyed.....
	Lot/Concession: surveyed.....
	unsurveyed.....
	Parcel: surveyed.....
	unsurveyed.....
	Right-of-way: road.....
	railway.....
	utility.....
Reservation
Cleft, Pit, Pile
Contour
Interpolated
Approximate
Depression
Control point (horizontal)	△
Flooded land
Mine head frame
Pipeline (above ground)
Railway: single track.....
double track.....
abandoned.....
Road: highway, county, township.....
access.....
trail, bush.....
Shoreline (original)
Transmission line
Wooded area.....

JUNE 1ST OPENINGS 1997 S.126334 ET AL

DISPOSITION OF CROWN LANDS

Patent	Surface & Mining Rights	●
	Surface Rights Only	□
	Mining Rights Only	○
Lease	Surface & Mining Rights	■
	Surface Rights Only	□
	Mining Rights Only	○
Licence of Occupation	▼
Order-in-Council	OC
Cancelled	◎
Reservation	○
Sand & Gravel	○

THE INFORMATION THAT
APPEARS ON THIS MAP
HAS BEEN COMPILED
FROM VARIOUS SOURCES
AND ACCURACY IS NOT
GUARANTEED. THOSE
WISHING TO STAKE MIN-
ING CLAIMS SHOULD CON-
TACT THE TITLING RECORDER,
MINISTRY OF NORTHERN DEVELOP-
MENT AND MINES, FOR ADDI-
TIONAL INFORMATION ON
THE STATUS OF THE
LANDS SHOWN HEREON.

955

JANES


SUDBURY DISTRICT

— Scale 40 chains to inch —

1 Res.

200

M^cNISH

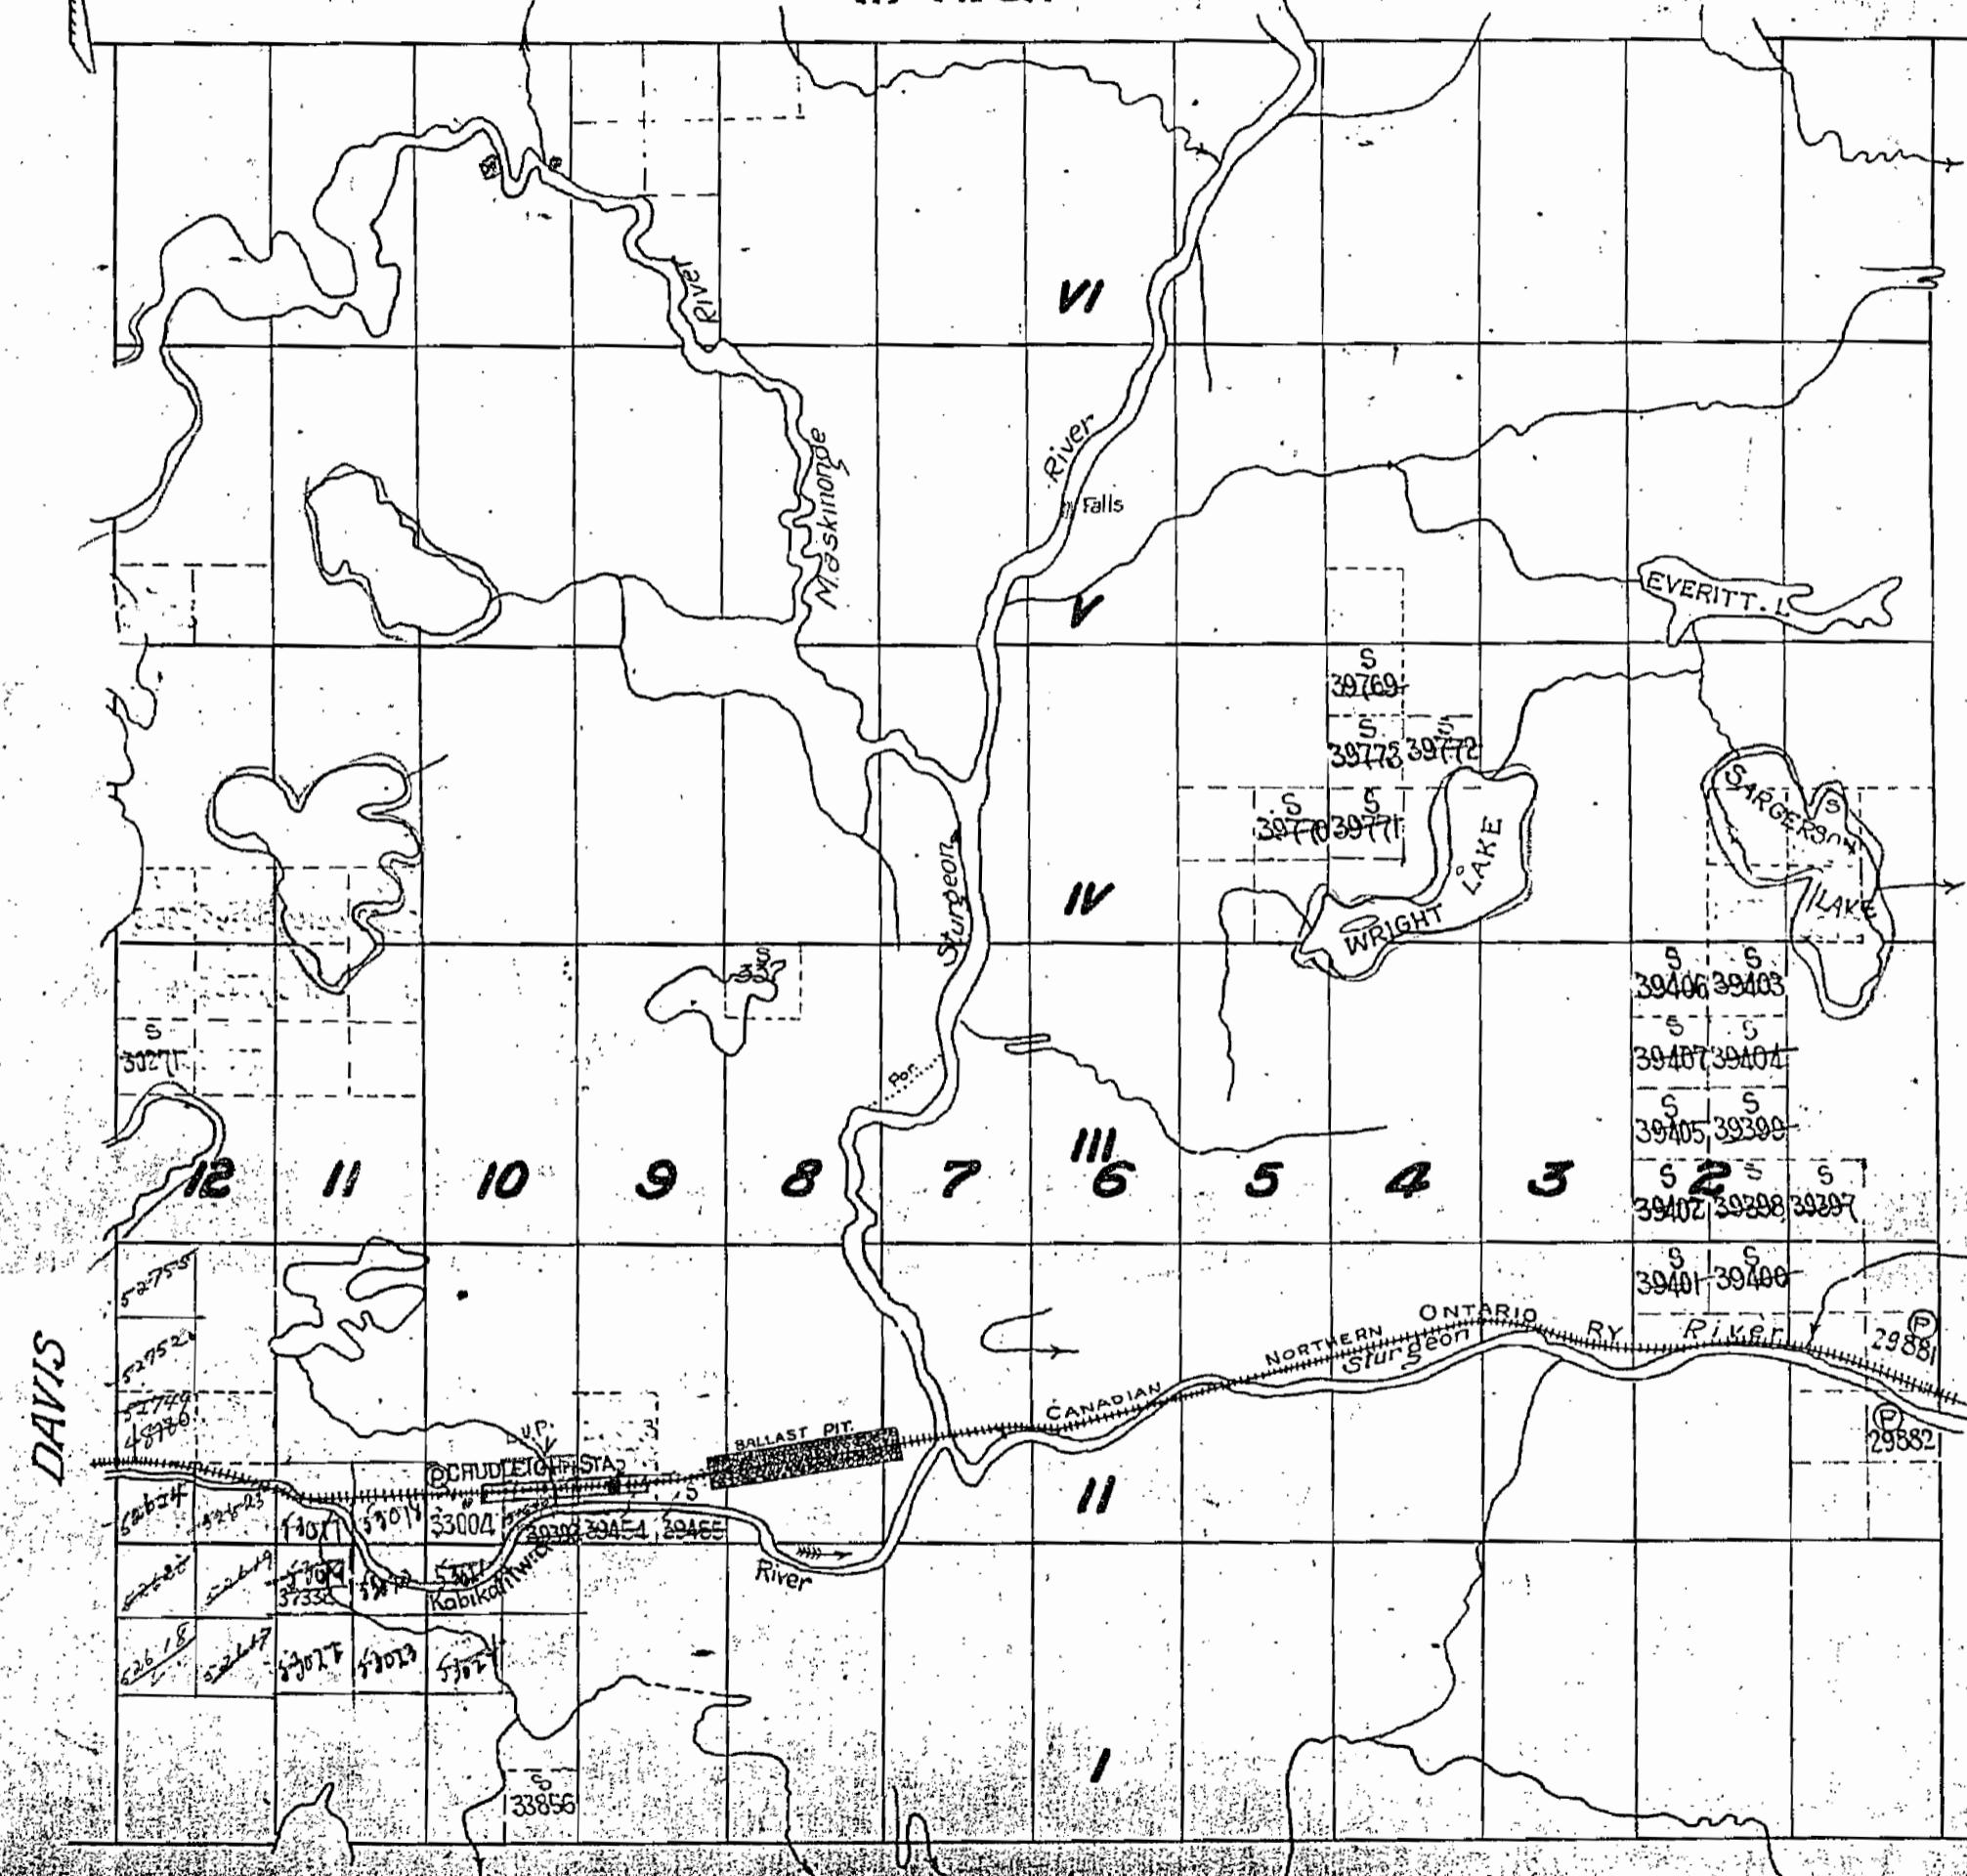

M955


11/19/1915

955

McNish Twp.

200' Twp.

Davis Twp.

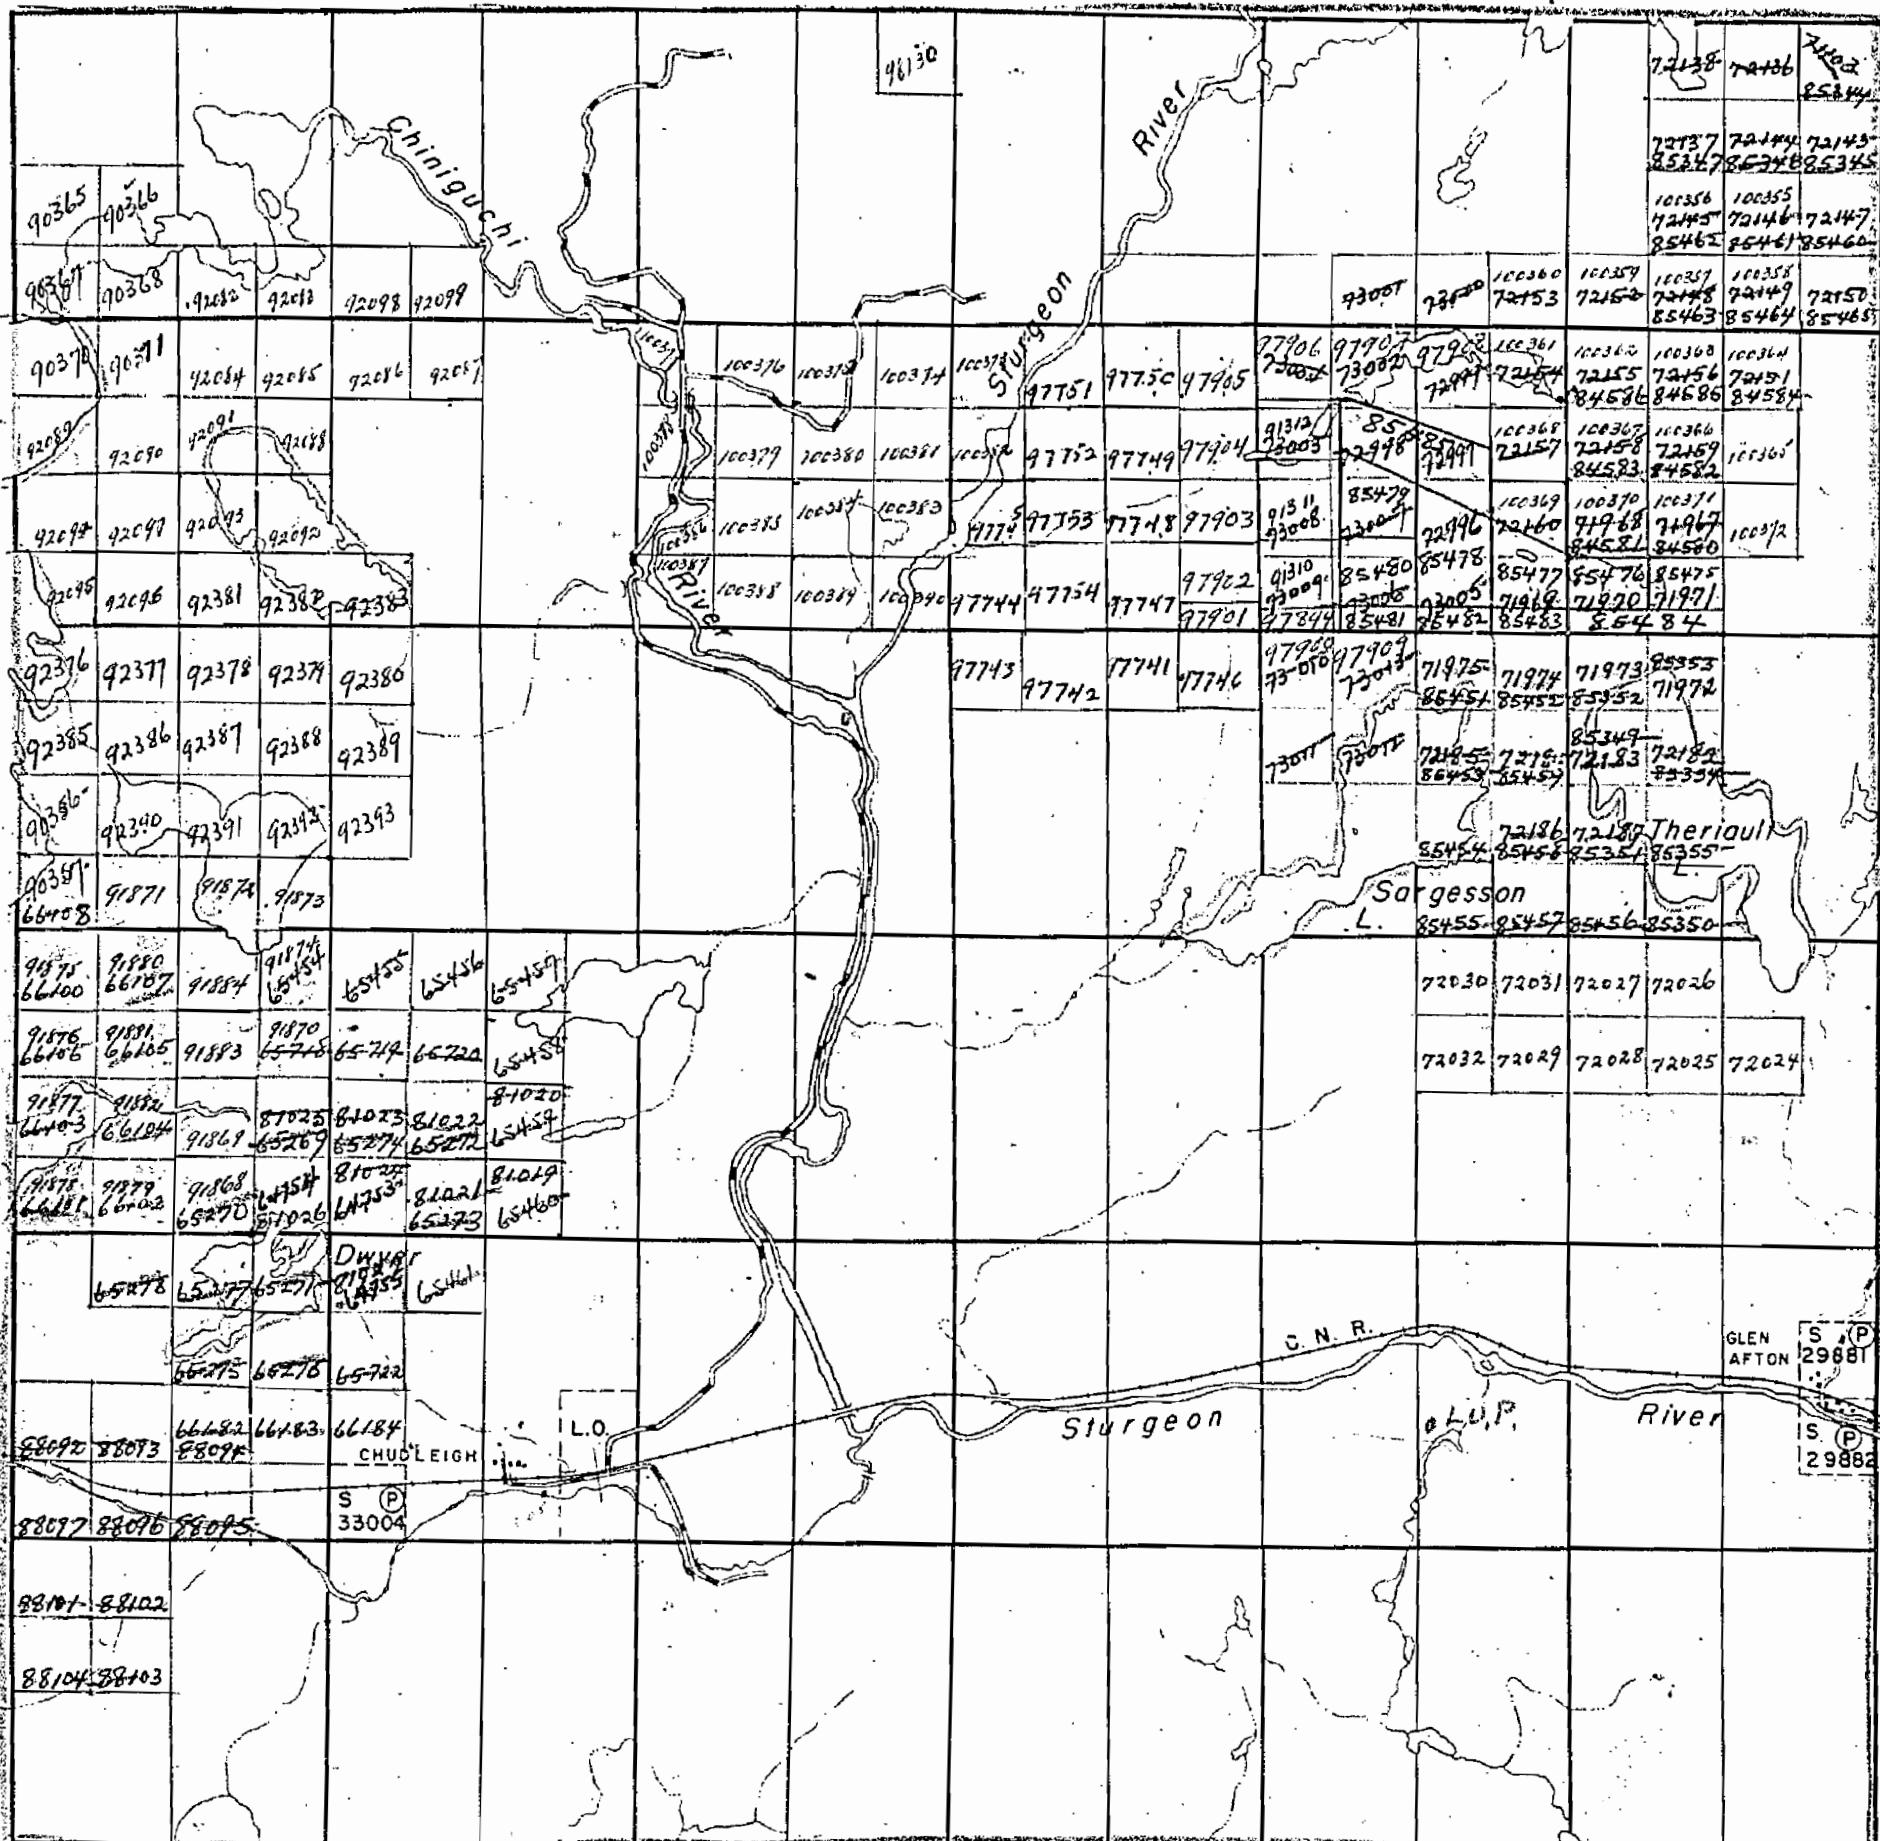

Henry Twp.

THE TOWNSHIP
OF
JANESDISTRICT OF
SUDBURY
SUDBURY
MINING DIVISION

SCALE: 1-INCH = 40 CHAINS

LEGEND

PATENTED LAND
CROWN LAND SALE
LEASES
LOCATED LAND
LICENSE OF OCCUPATION
MINING RIGHTS ONLY
SURFACE RIGHTS ONLY
ROADS
IMPROVED ROADS
KING'S HIGHWAYS
RAILWAYS
POWER-LINES
MARSH OR MUSKEG
MINES

NOTES

Subj. To Sec'd. / Jan 55


Poste Coulen

M 955

PLAN NO.-S.272

DEPARTMENT OF MINES
—ONTARIO—

McNish Twp.

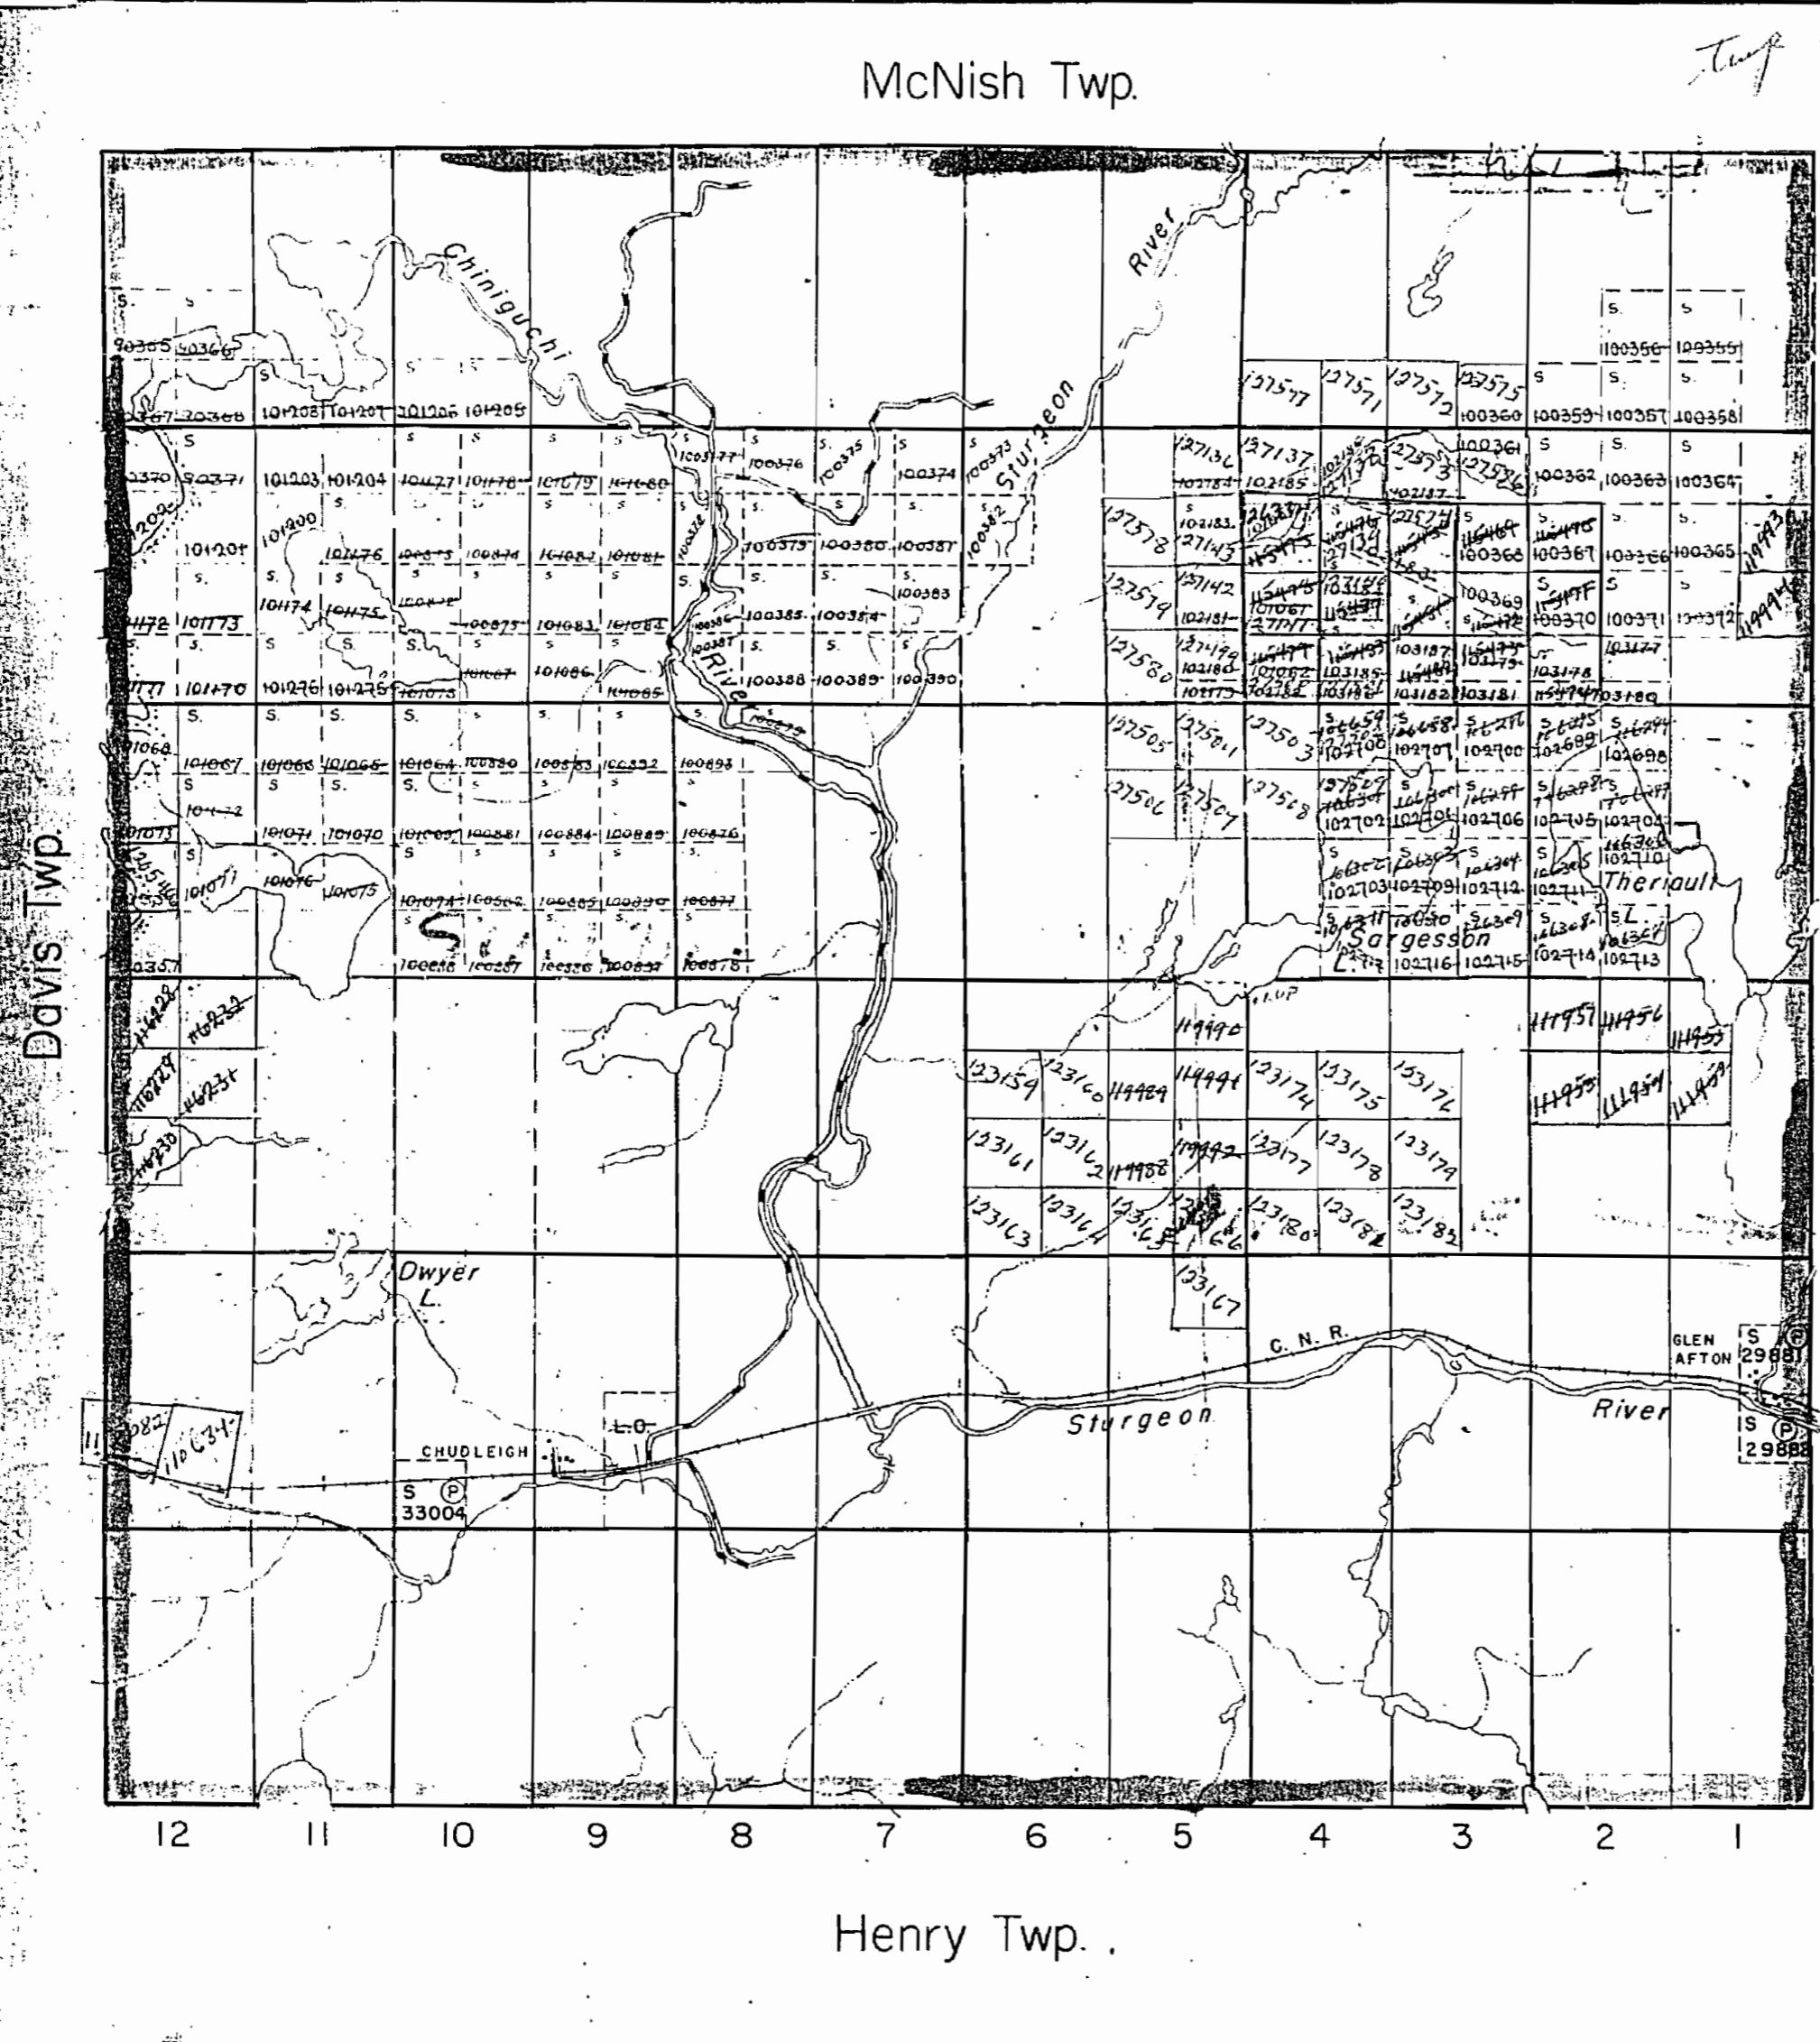

Temp file

THE TOWNSHIP
OF
JANES
DISTRICT OF
SUDBURY
SUDBURY
MINING DIVISION
SCALE: 1-INCH=40 CHAINS

LEGEND


(P)	G.S.
(L)	Loc.
(I)	L.O.
(M.R.O.)	M.R.O.
(S.R.O.)	S.R.O.

NOTES

Mining Claims Accepted Under The Provision Of Section 53 Of The Mining Act.

400' Reserve to Dept. of Lands & Forests shown thus

~~400' Res.~~
S.R.O. on Pt. Lots 1&2 Con 4
by L. & F.

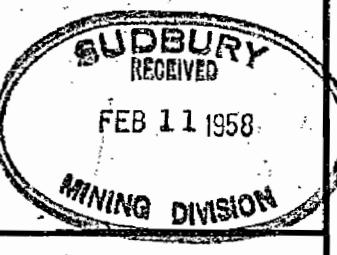

PLAN NO.- M-955


DEPARTMENT OF MINES
—ONTARIO—

955

McNish Twp.

УЧЕБНИК ПО МАТЕМАТИКЕ

DEVASTIWD

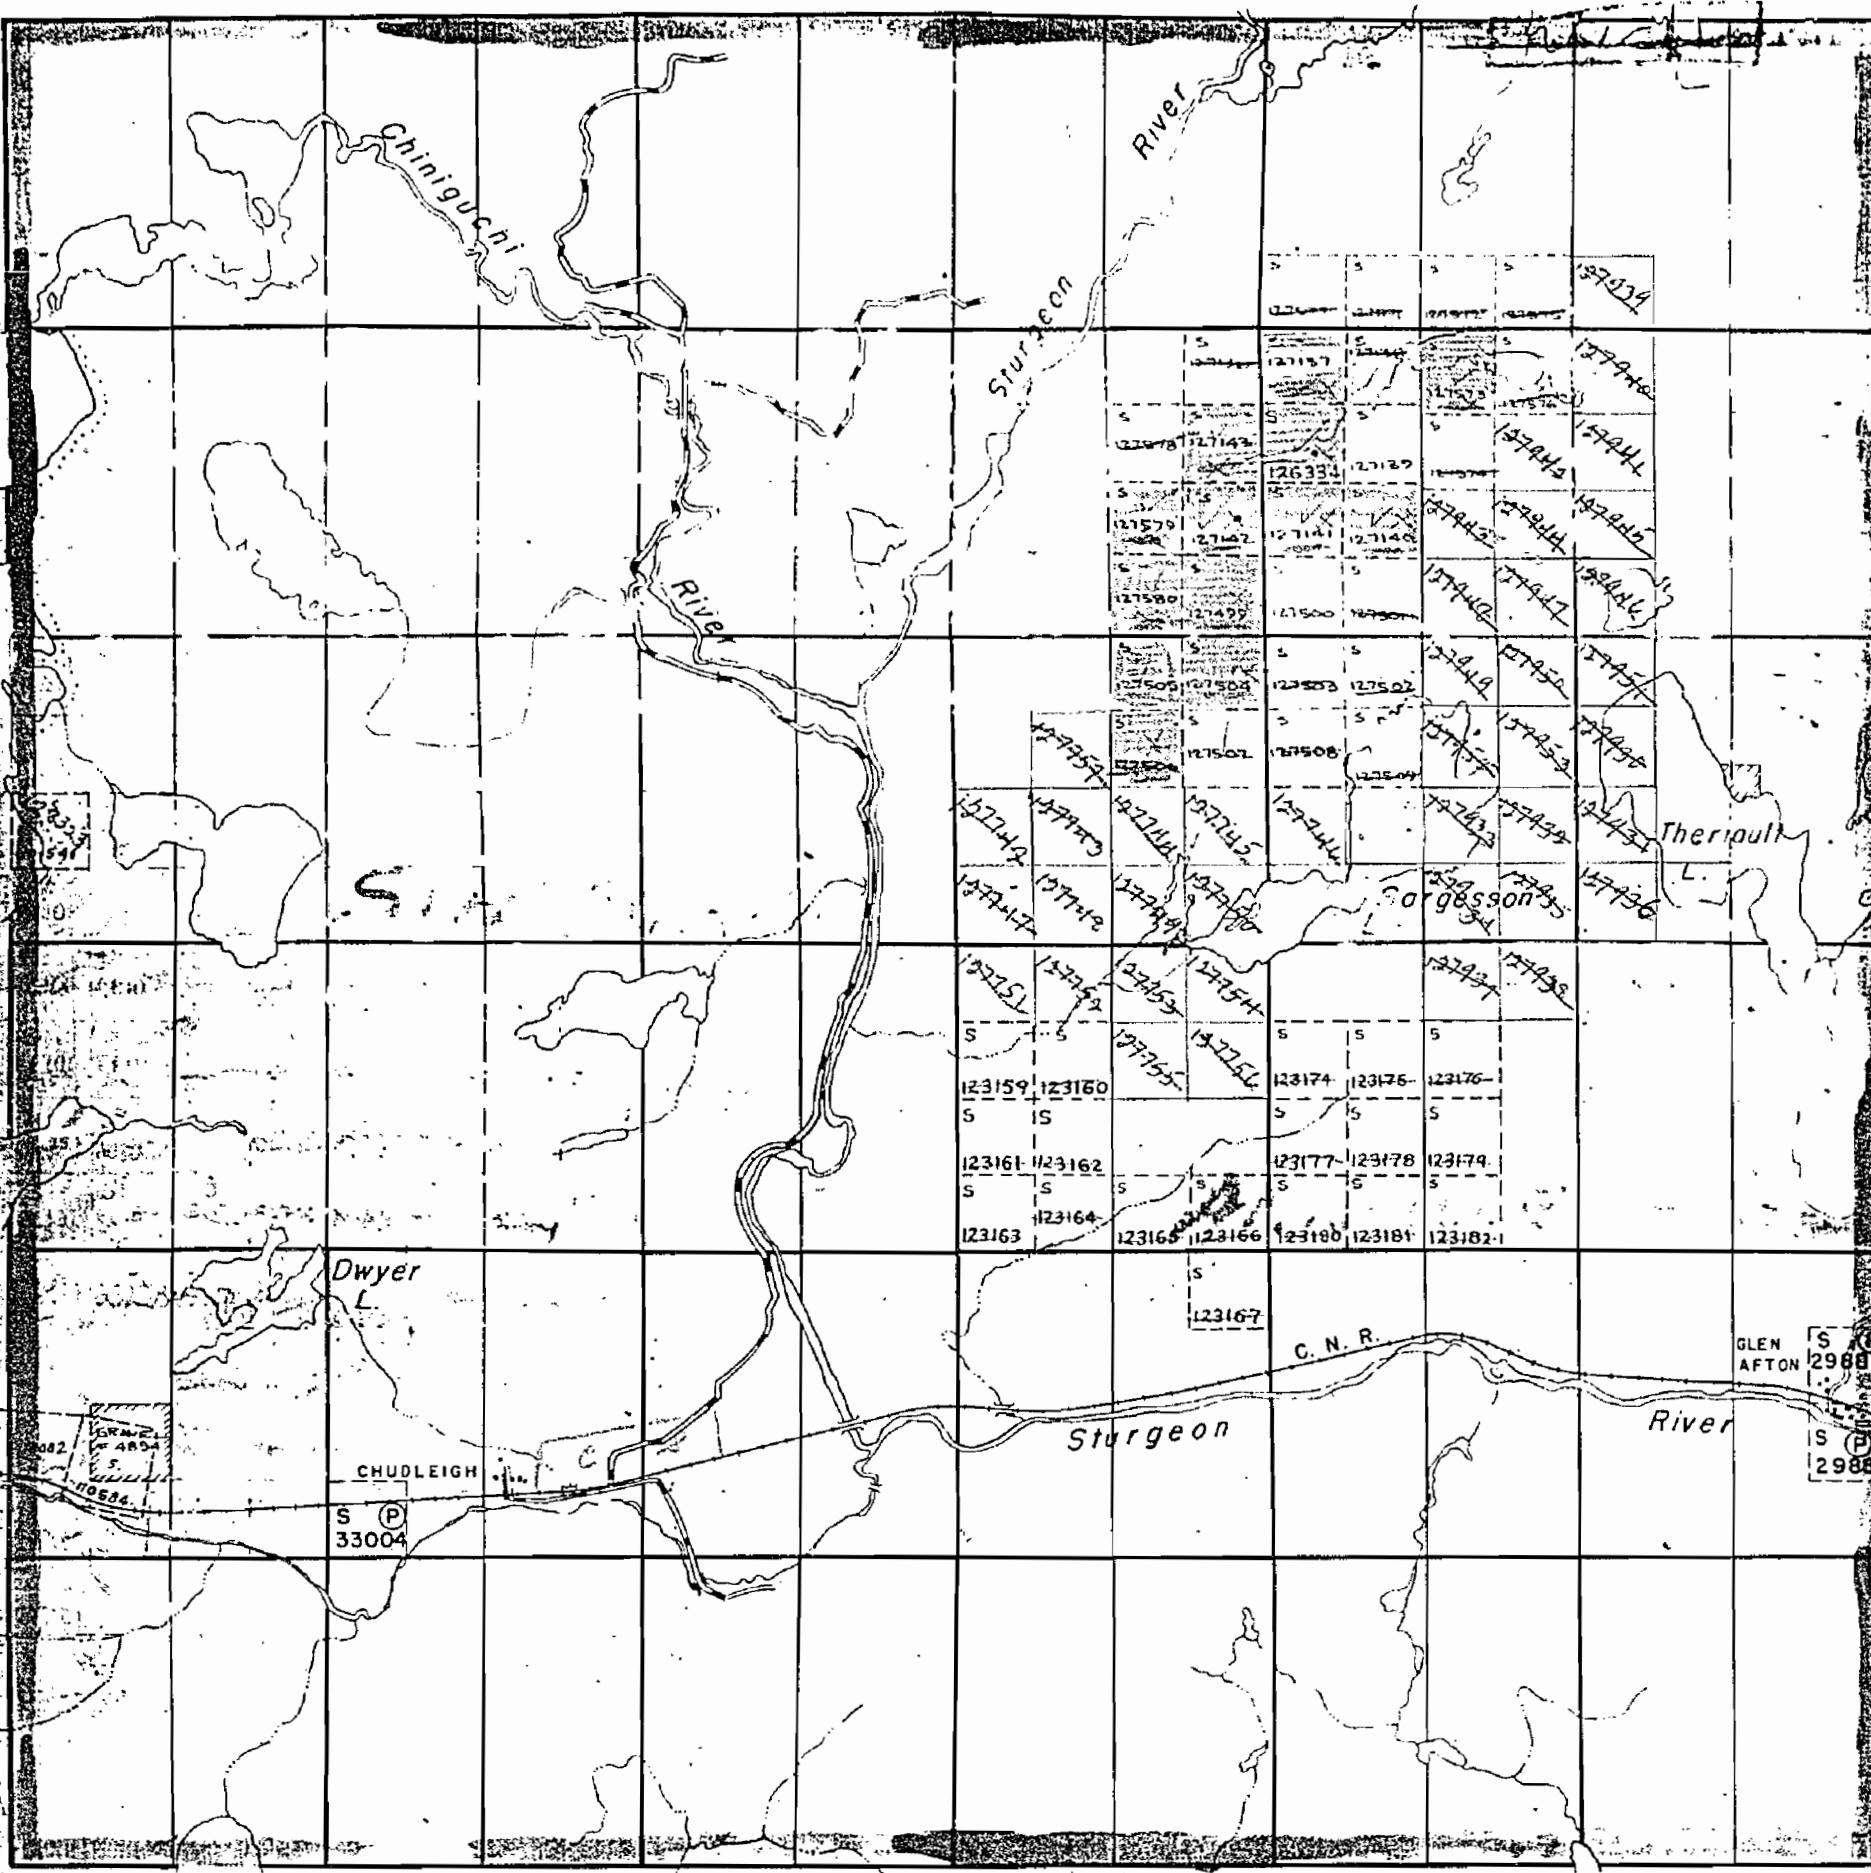

Henry Twp.

THE TOWNSHIP
OF

JANES


DISTRICT OF
SUDBURY

SUDBURY
MINING DIVISION

SCALE : 1-INCH = 40 CHAINS

LEGEND

- PATENTED LAND
CROWN LAND SALE
LEASES
LOCATED LAND
LICENSE OF OCCUPATION
MINING RIGHTS ONLY
SURFACE RIGHTS ONLY
ROADS
IMPROVED ROADS
KING'S HIGHWAYS
RAILWAYS
POWER LINES
MARSH OR MUSKEG
MINES

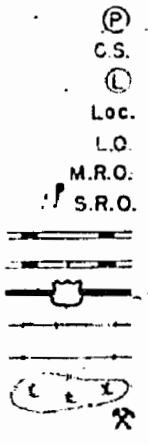

NOTES

Mining Claims Accepted Under The
Provision Of Section 53 Of The
Mining Act.

400' Surface Rights Reservation around
all Lakes and Rivers

Surface Rights Only reserved to the Dept of Lands
& Forests under Sec 39 (d) Mining Act shown
thus ~~as~~

PLAN NO.- M-955


DEPARTMENT OF MINES
—ONTARIO—

955


226

SWAN TWP

Davis Twp. (M-748)

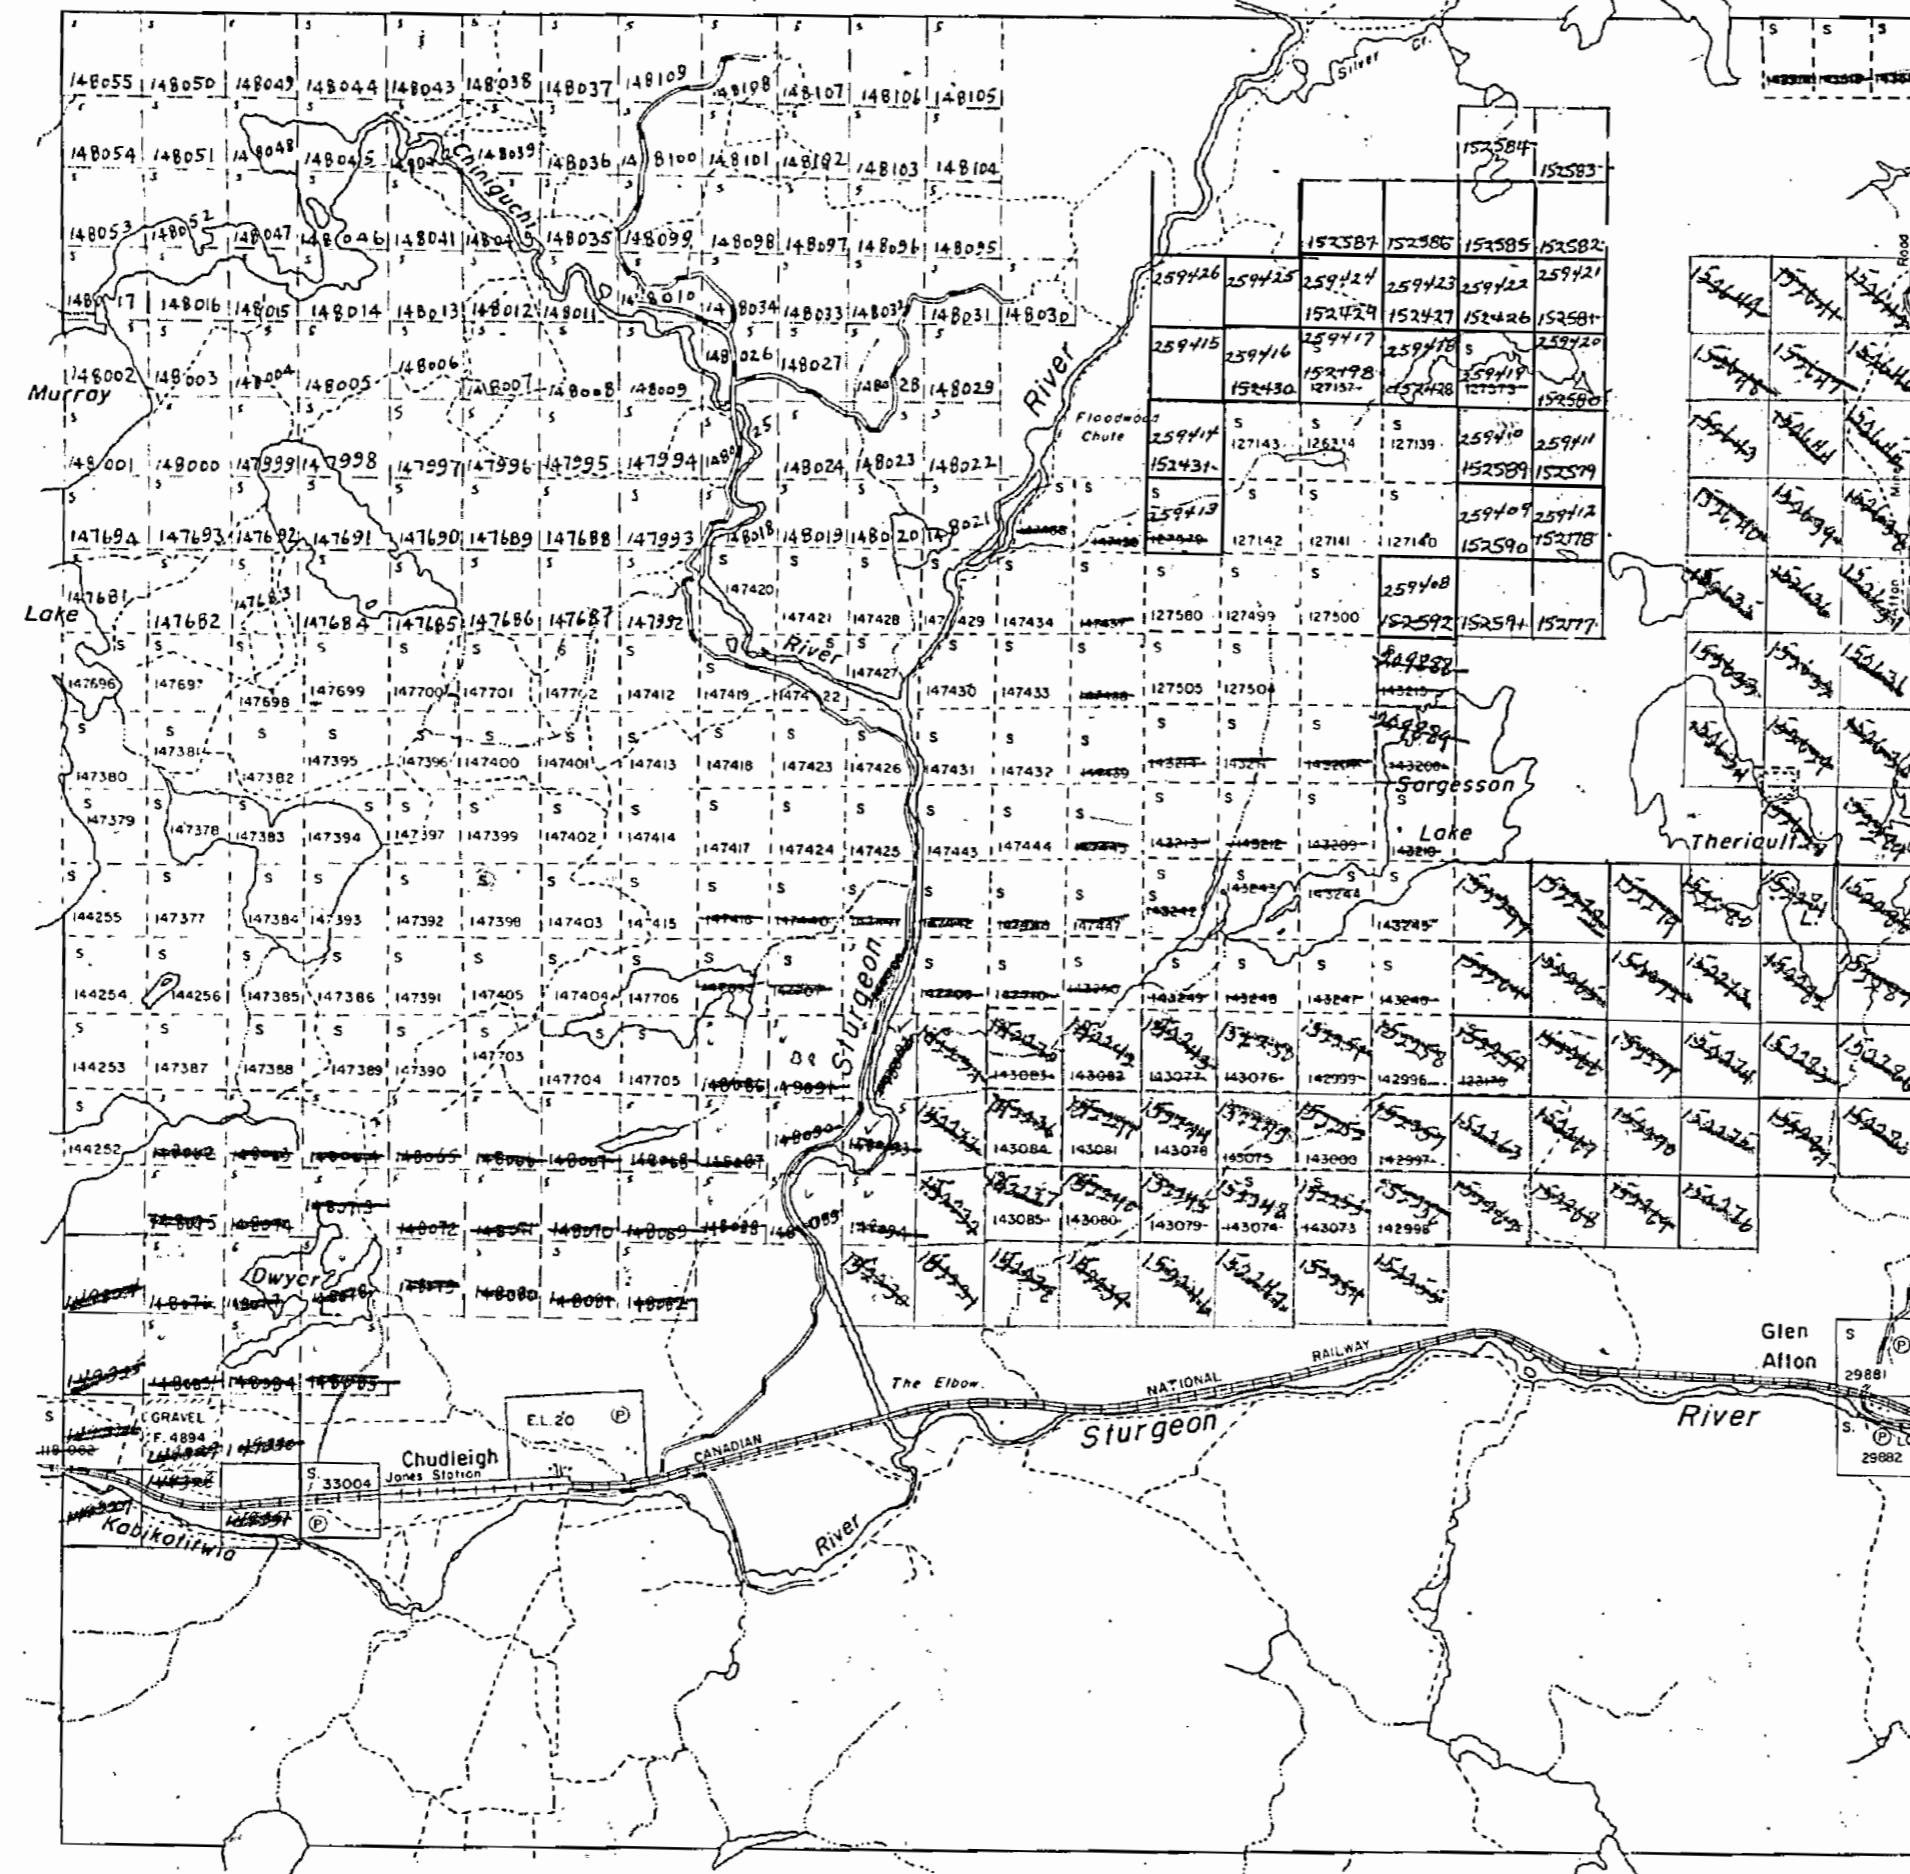


Henry Twp. (M-929)

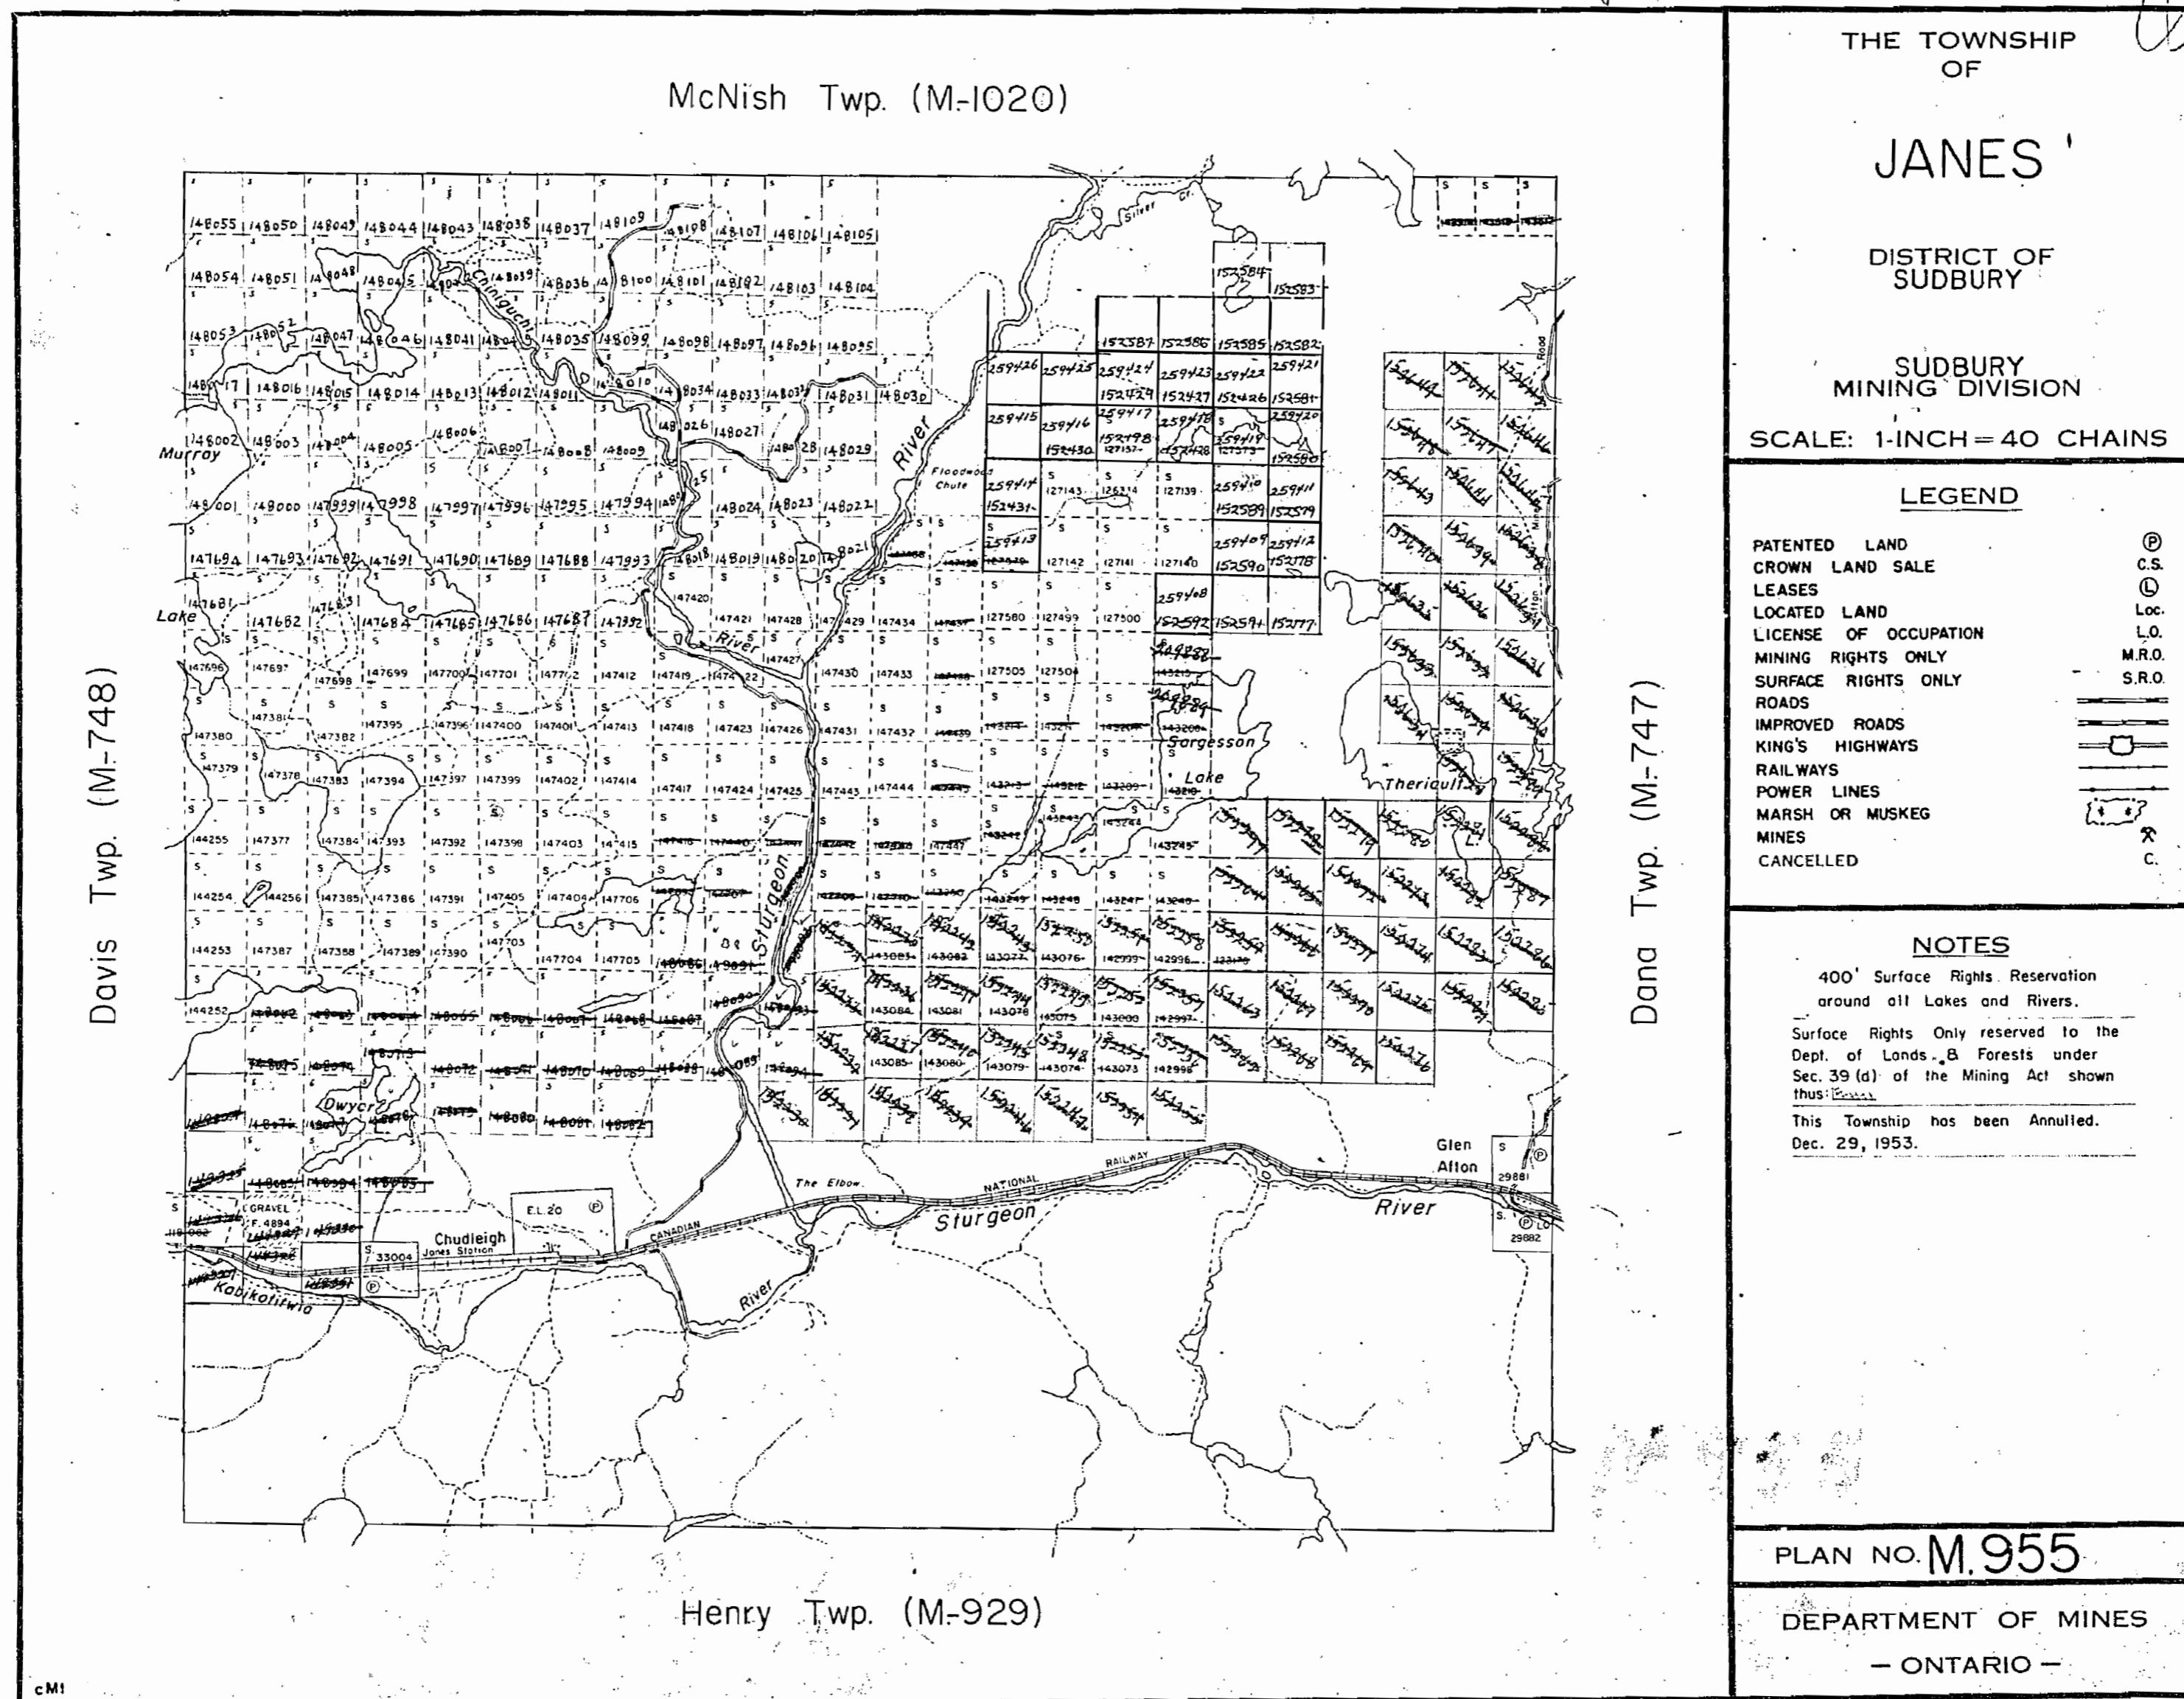

955

Davis Twp. (M-748)

McNish Twp. (M-1020)

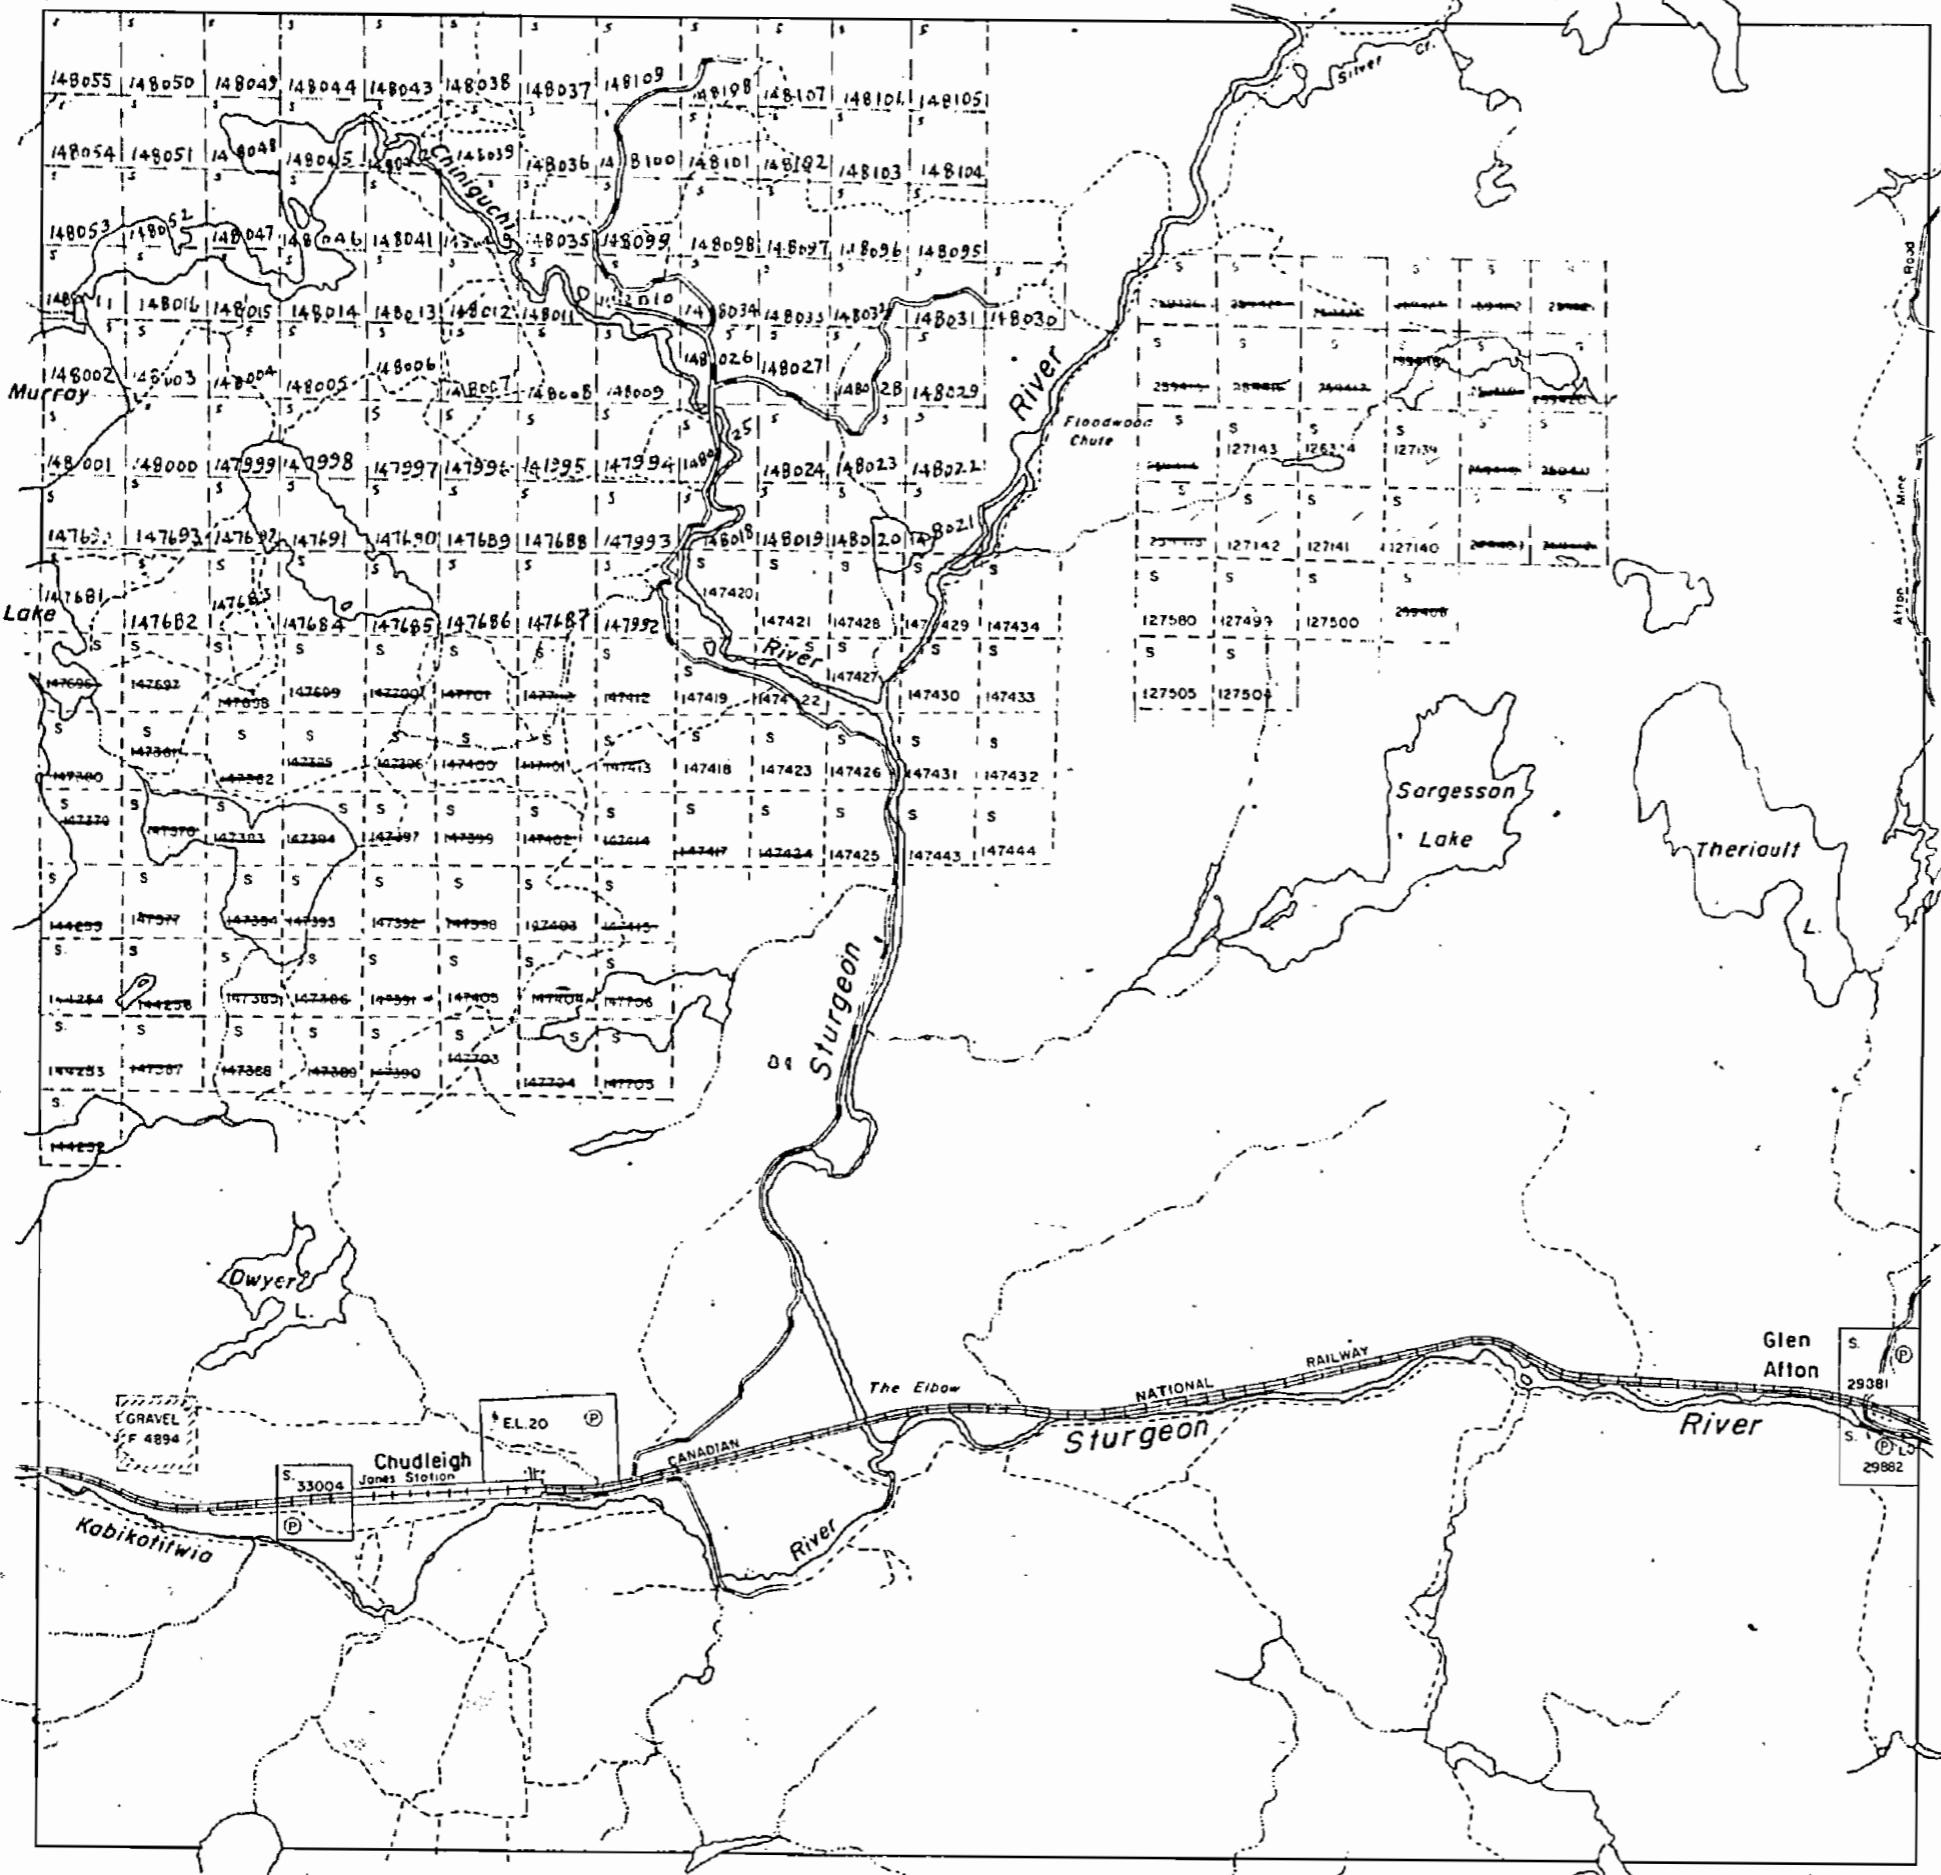

Henry Twp. (M-929)

THE TOWNSHIP
OF
JANES
DISTRICT OF
SUDBURY
SUDBURY
MINING DIVISION

SCALE: 1-INCH = 40 CHAINS

LEGEND

(P)	C.S.
(L)	Loc.
(S)	L.O.
(M.R.O.)	M.R.O.
(S.R.O.)	S.R.O.
—	ROADS
—	IMPROVED ROADS
—	KING'S HIGHWAYS
—	RAILWAYS
—	POWER LINES
—	MARSH OR MUSKEG
X	MINES
C.	CANCELLED

Dana Twp. (M-747)

NOTES

400' Surface Rights Reservation
around all Lakes and Rivers.

Surface Rights Only reserved to the
Dept. of Lands & Forests under
Sec. 39 (d) of the Mining Act shown
thus:

This Township has been Annulled.
Dec. 29, 1953.


PLAN NO. M.955

ONTARIO
DEPARTMENT OF MINES
AND NORTHERN AFFAIRS

955

McNish Twp. (M-1020)

Davis Twp. (M-748)

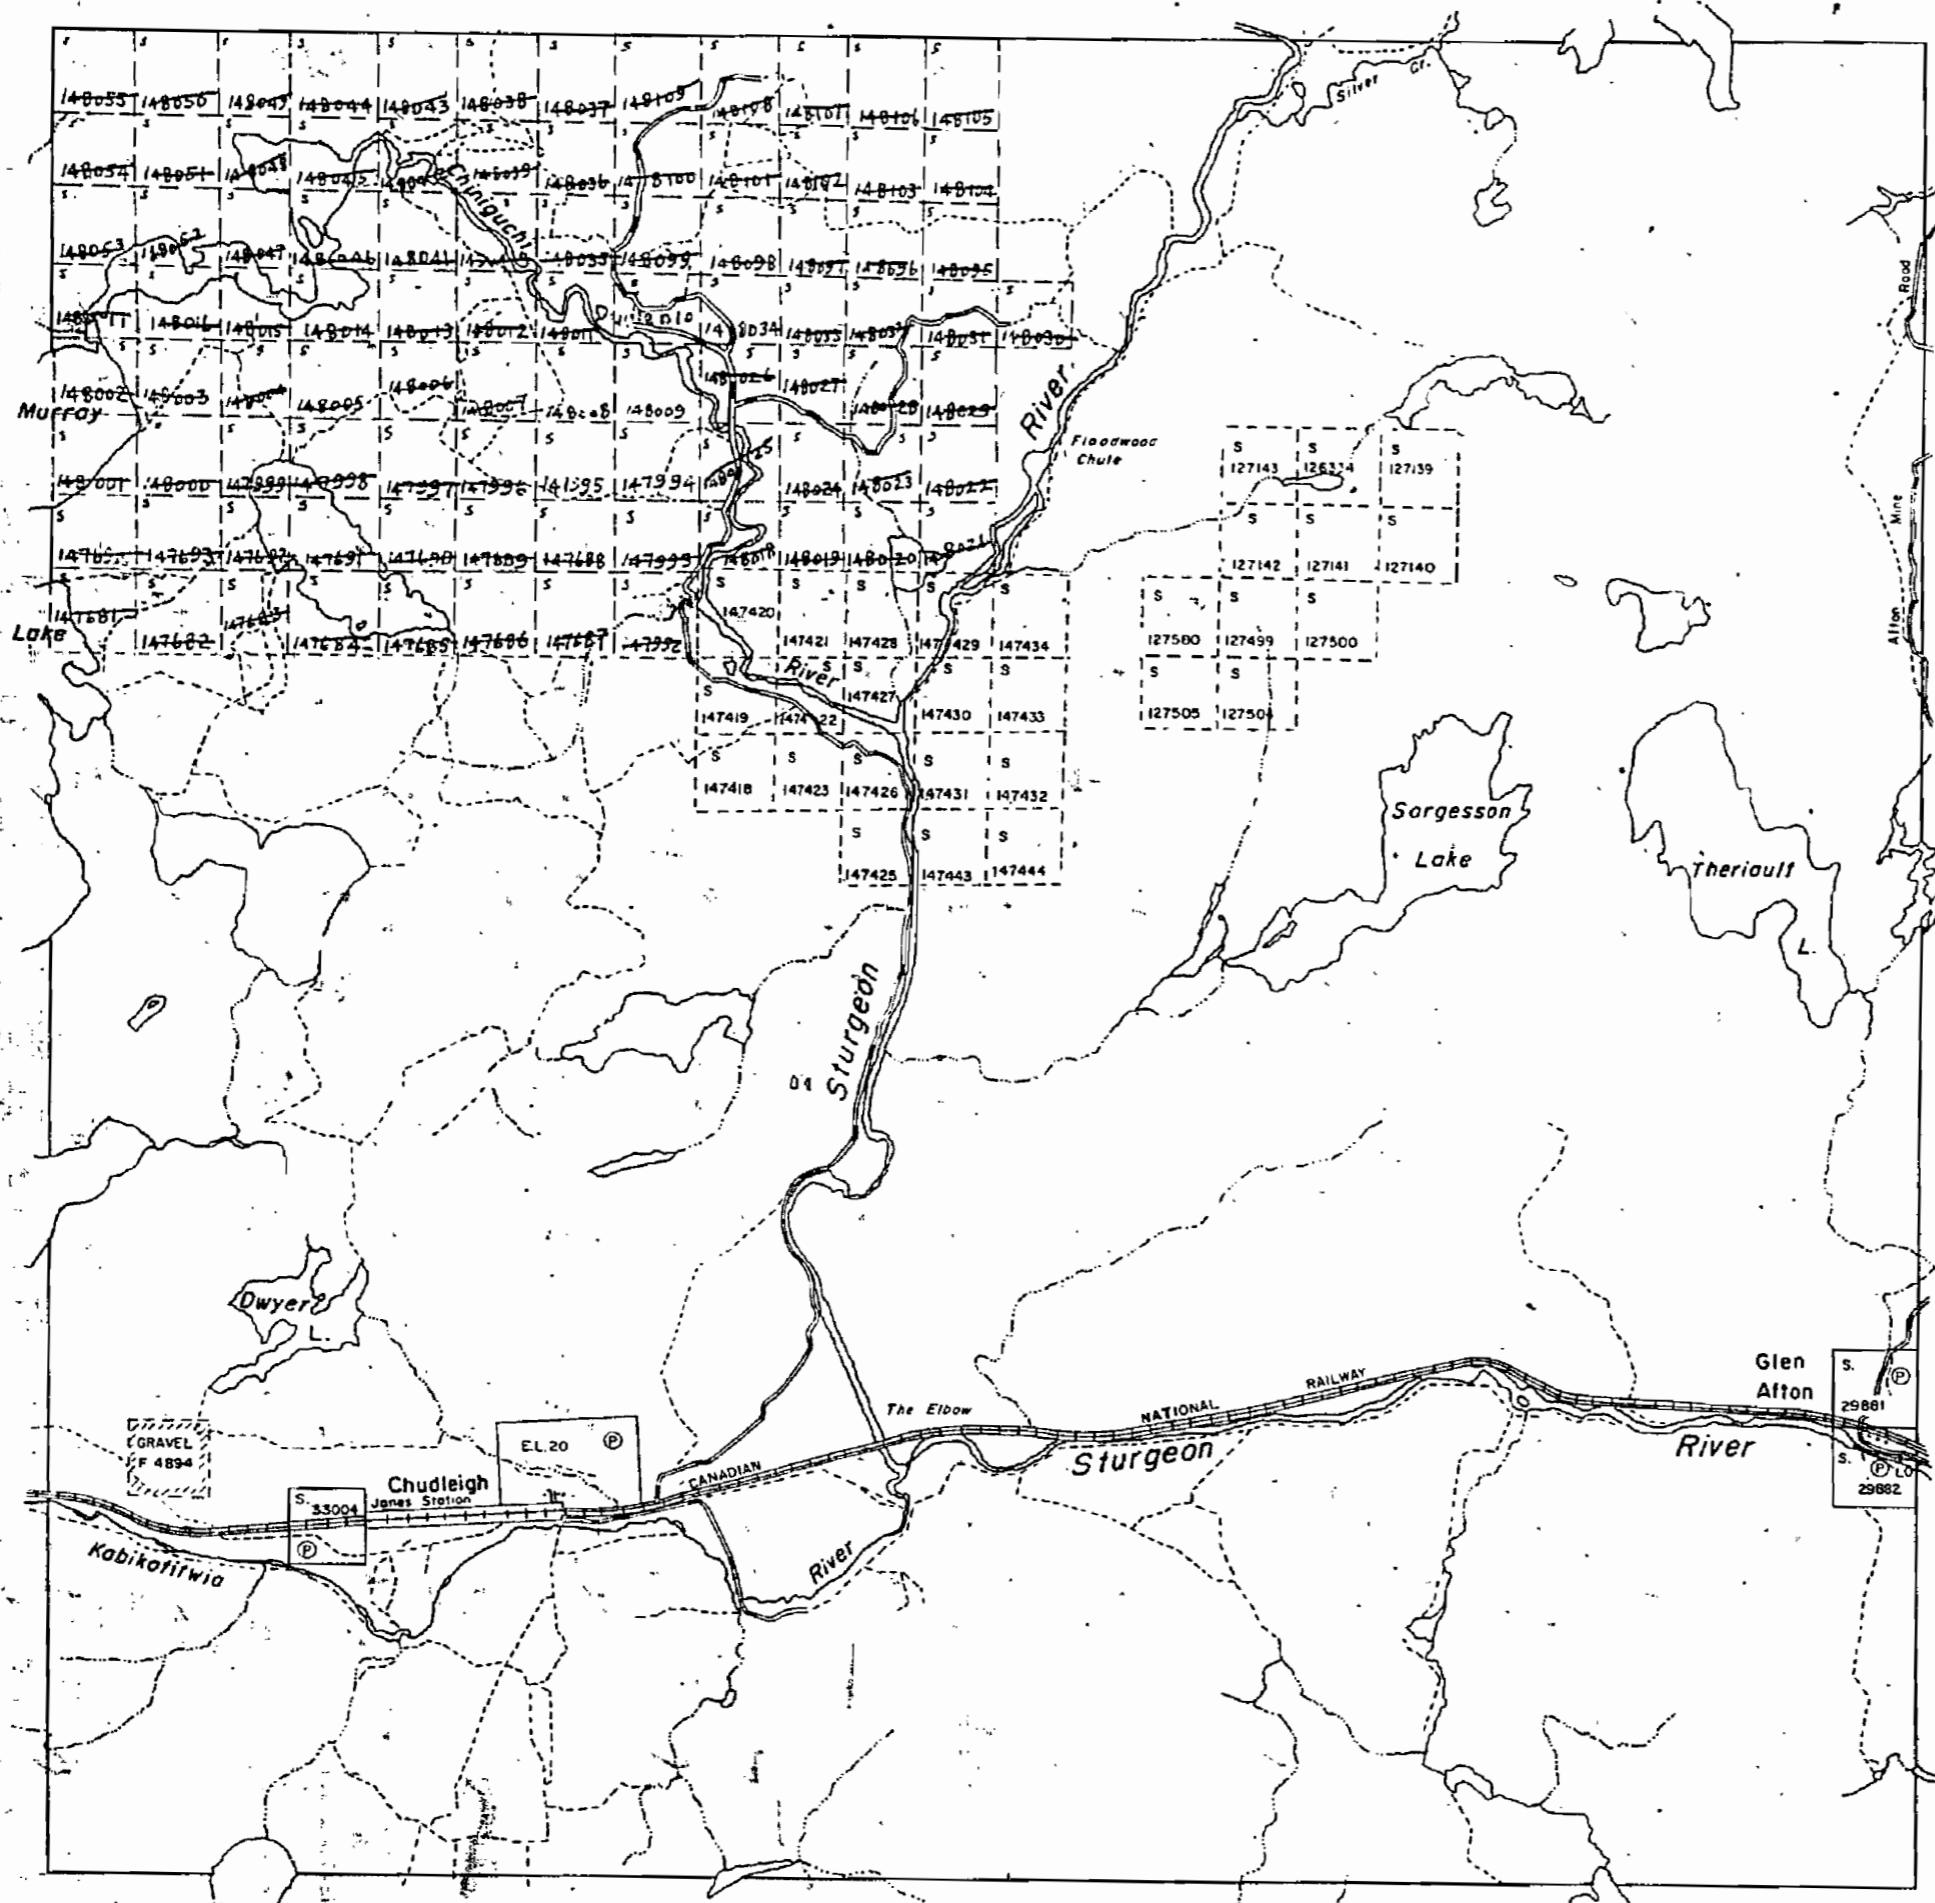

Henry Twp. (M-929)

THE TOWNSHIP OF

JANE'S

DISTRICT OF
SUDBURY

SUDSBURY
MINING DIVISION

SCALE: 1-INCH = 40 CHAINS

LEGEND

- | | |
|-----------------------|--------|
| PATENTED LAND | (P) |
| CROWN LAND SALE | C.S. |
| LEASES | (L) |
| LOCATED LAND | Loc. |
| LICENSE OF OCCUPATION | L.O. |
| MINING RIGHTS ONLY | M.R.O. |
| SURFACE RIGHTS ONLY | S.R.O. |
| ROADS | <hr/> |
| IMPROVED ROADS | <hr/> |
| KING'S HIGHWAYS | <hr/> |
| RAILWAYS | <hr/> |
| POWER LINES | <hr/> |
| MARSH OR MUSKEG | |
| MINES | |
| CANCELLED | |

NOTES

400' Surface Rights Reservation
around all Lakes and Rivers.

Surface Rights Only reserved to the
Dept. of Lands & Forests under
Sec. 39(d) of the Mining Act shown
thus: etc.


This Township has been Annulled
Dec. 29, 1953.

PLAN NO. M.955

**ONTARIO
DEPARTMENT OF MINES
AND NORTHERN AFFAIRS**

955

McNish Twp.

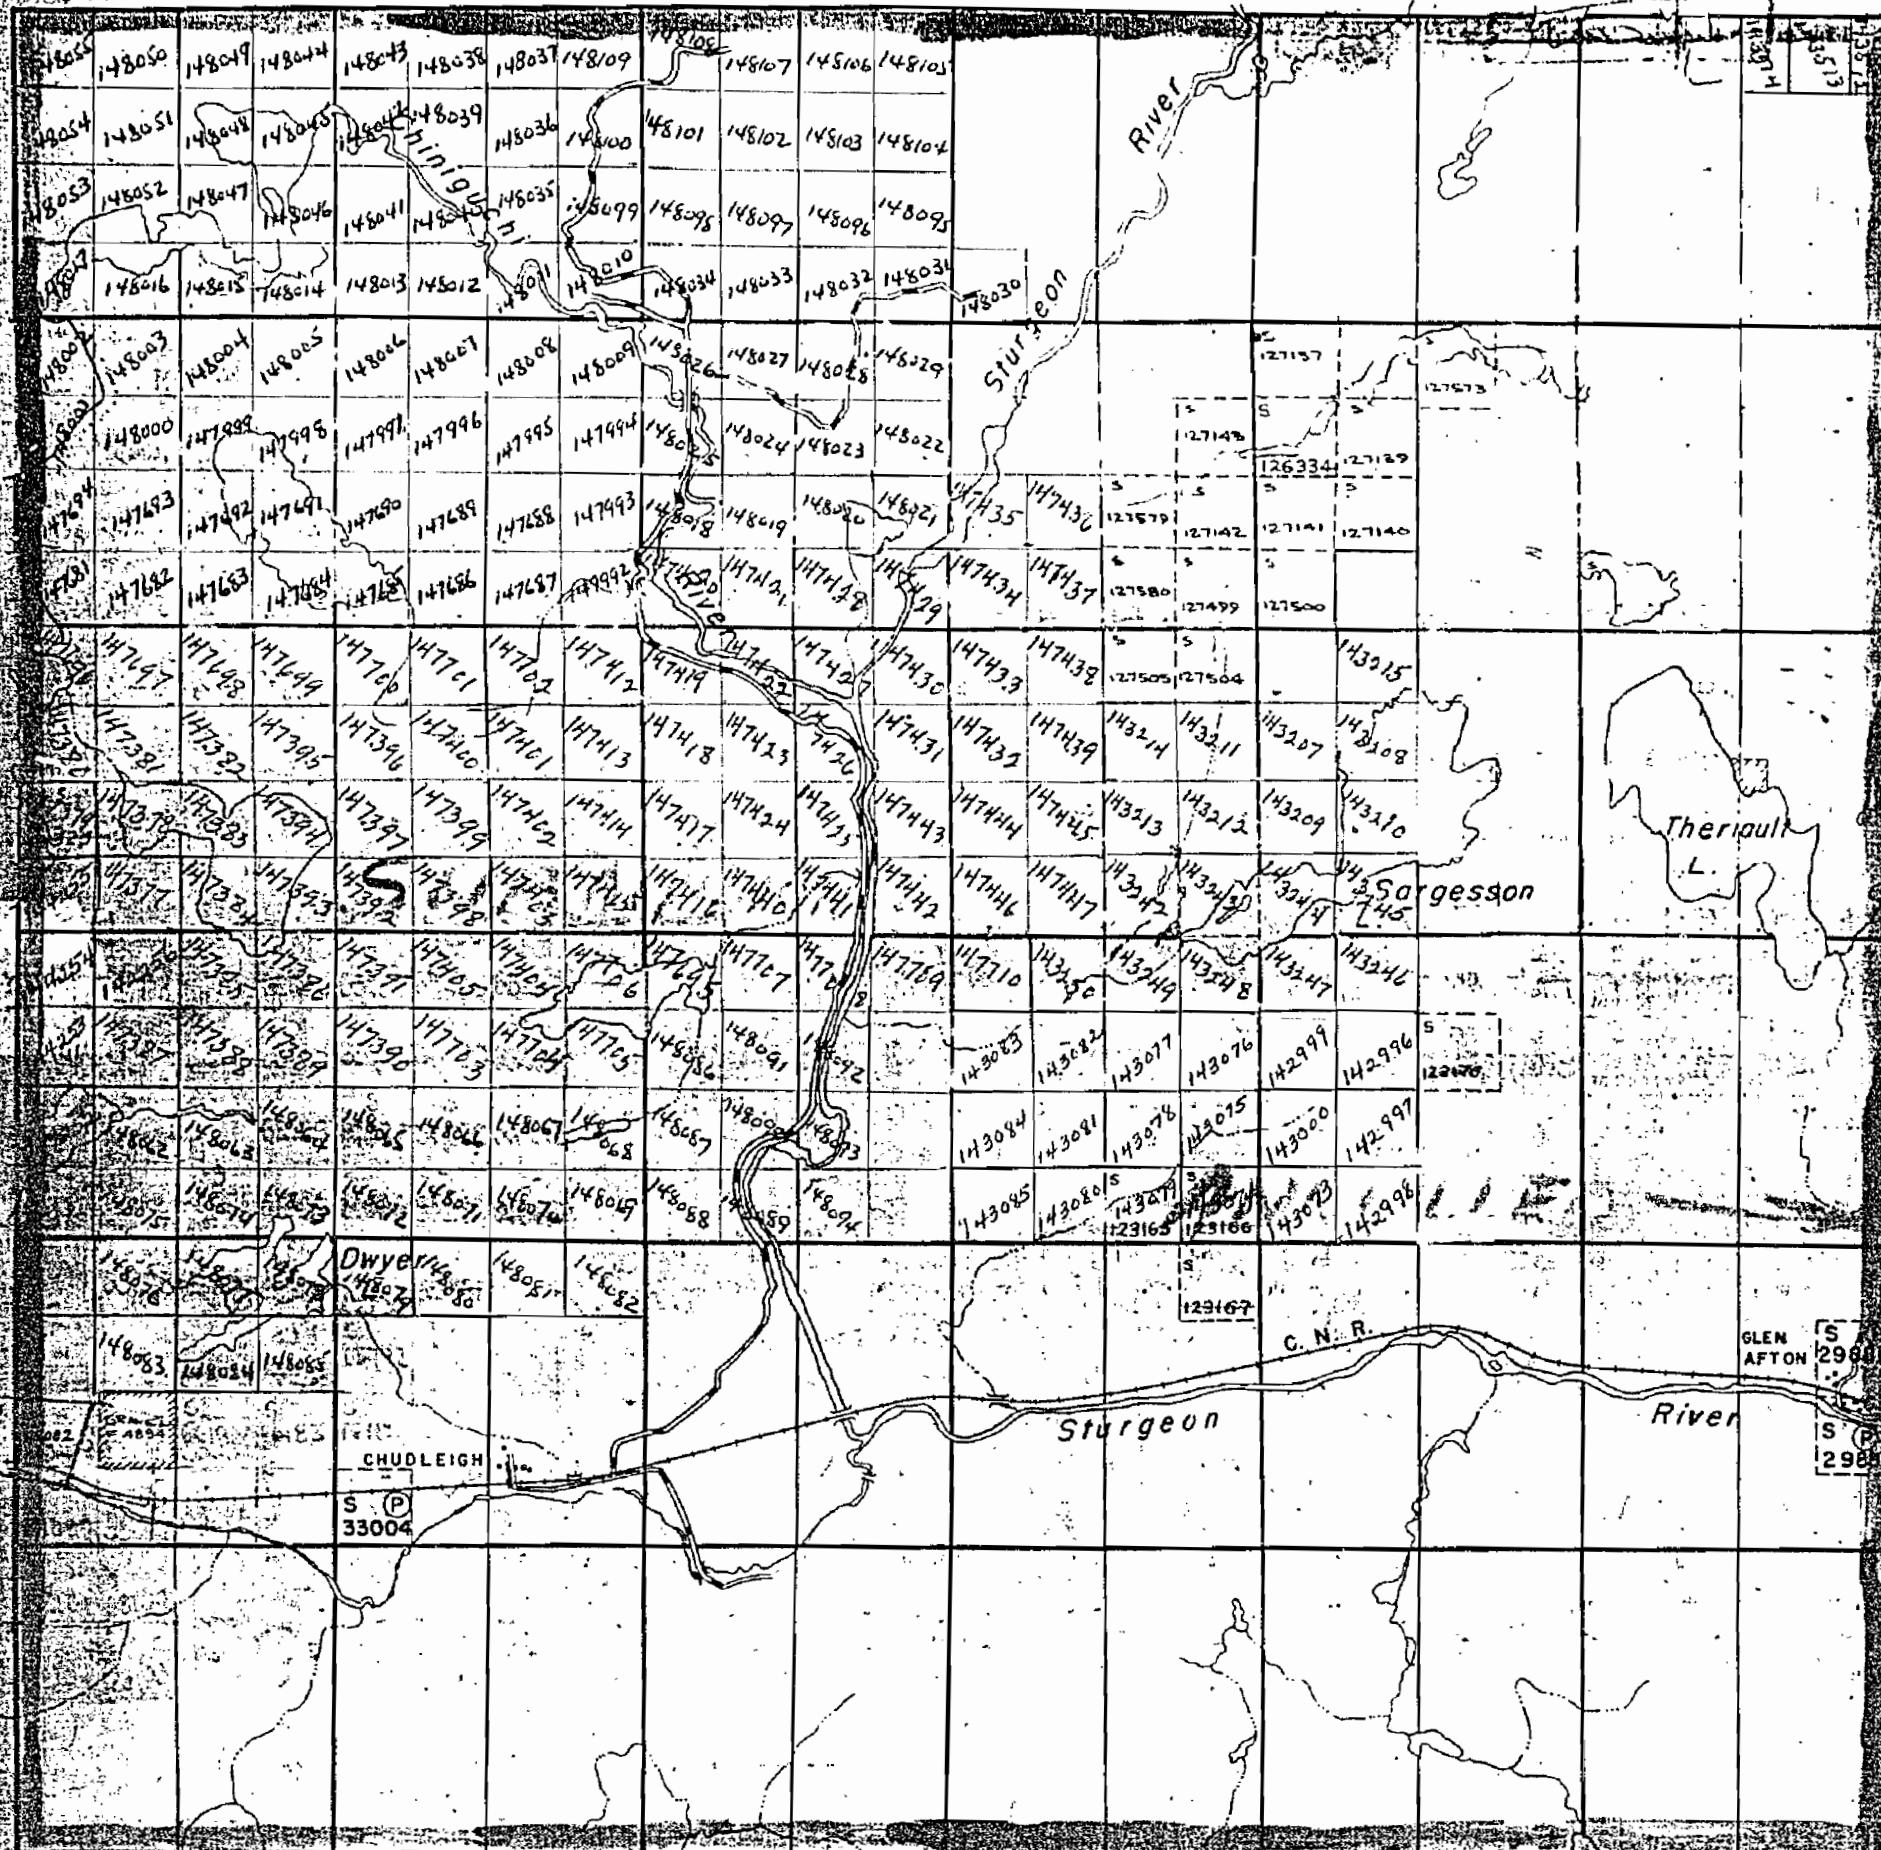

Henry Twp.

THE TOWNSHIP
OF**JANES**DISTRICT OF
SUDBURYSUDBURY
MINING DIVISION

SCALE: 1-INCH = 40 CHAINS

LEGEND

(P)	C.S.
(L)	Loc.
L.O.	M.R.O.
S.R.O.	

PATENTED LAND
GROWN LAND, SALE
LEASES
LOCATED LAND
LICENSE OF OCCUPATION
MINING RIGHTS ONLY
SURFACE RIGHTS ONLY
ROADS
IMPROVED ROADS
KING'S HIGHWAYS
RAILWAYS
POWER LINES
MARSH OR MUSKEG
MINES

NOTES

Mining Claims Accepted Under The
Provision Of Section 53 Of The
Mining Act.

400' Surface Rights Reservation around
all Lakes and Rivers.

Surface Rights Only reserved to the Dept. of Lands & Forests under Sec 39 (d) Mining Act. shown thus: LLLD


PLAN NO.-M-955

DEPARTMENT
—ONTARIO

955

McNish Twp. (M-1020)

Davis Twp. (M-748)

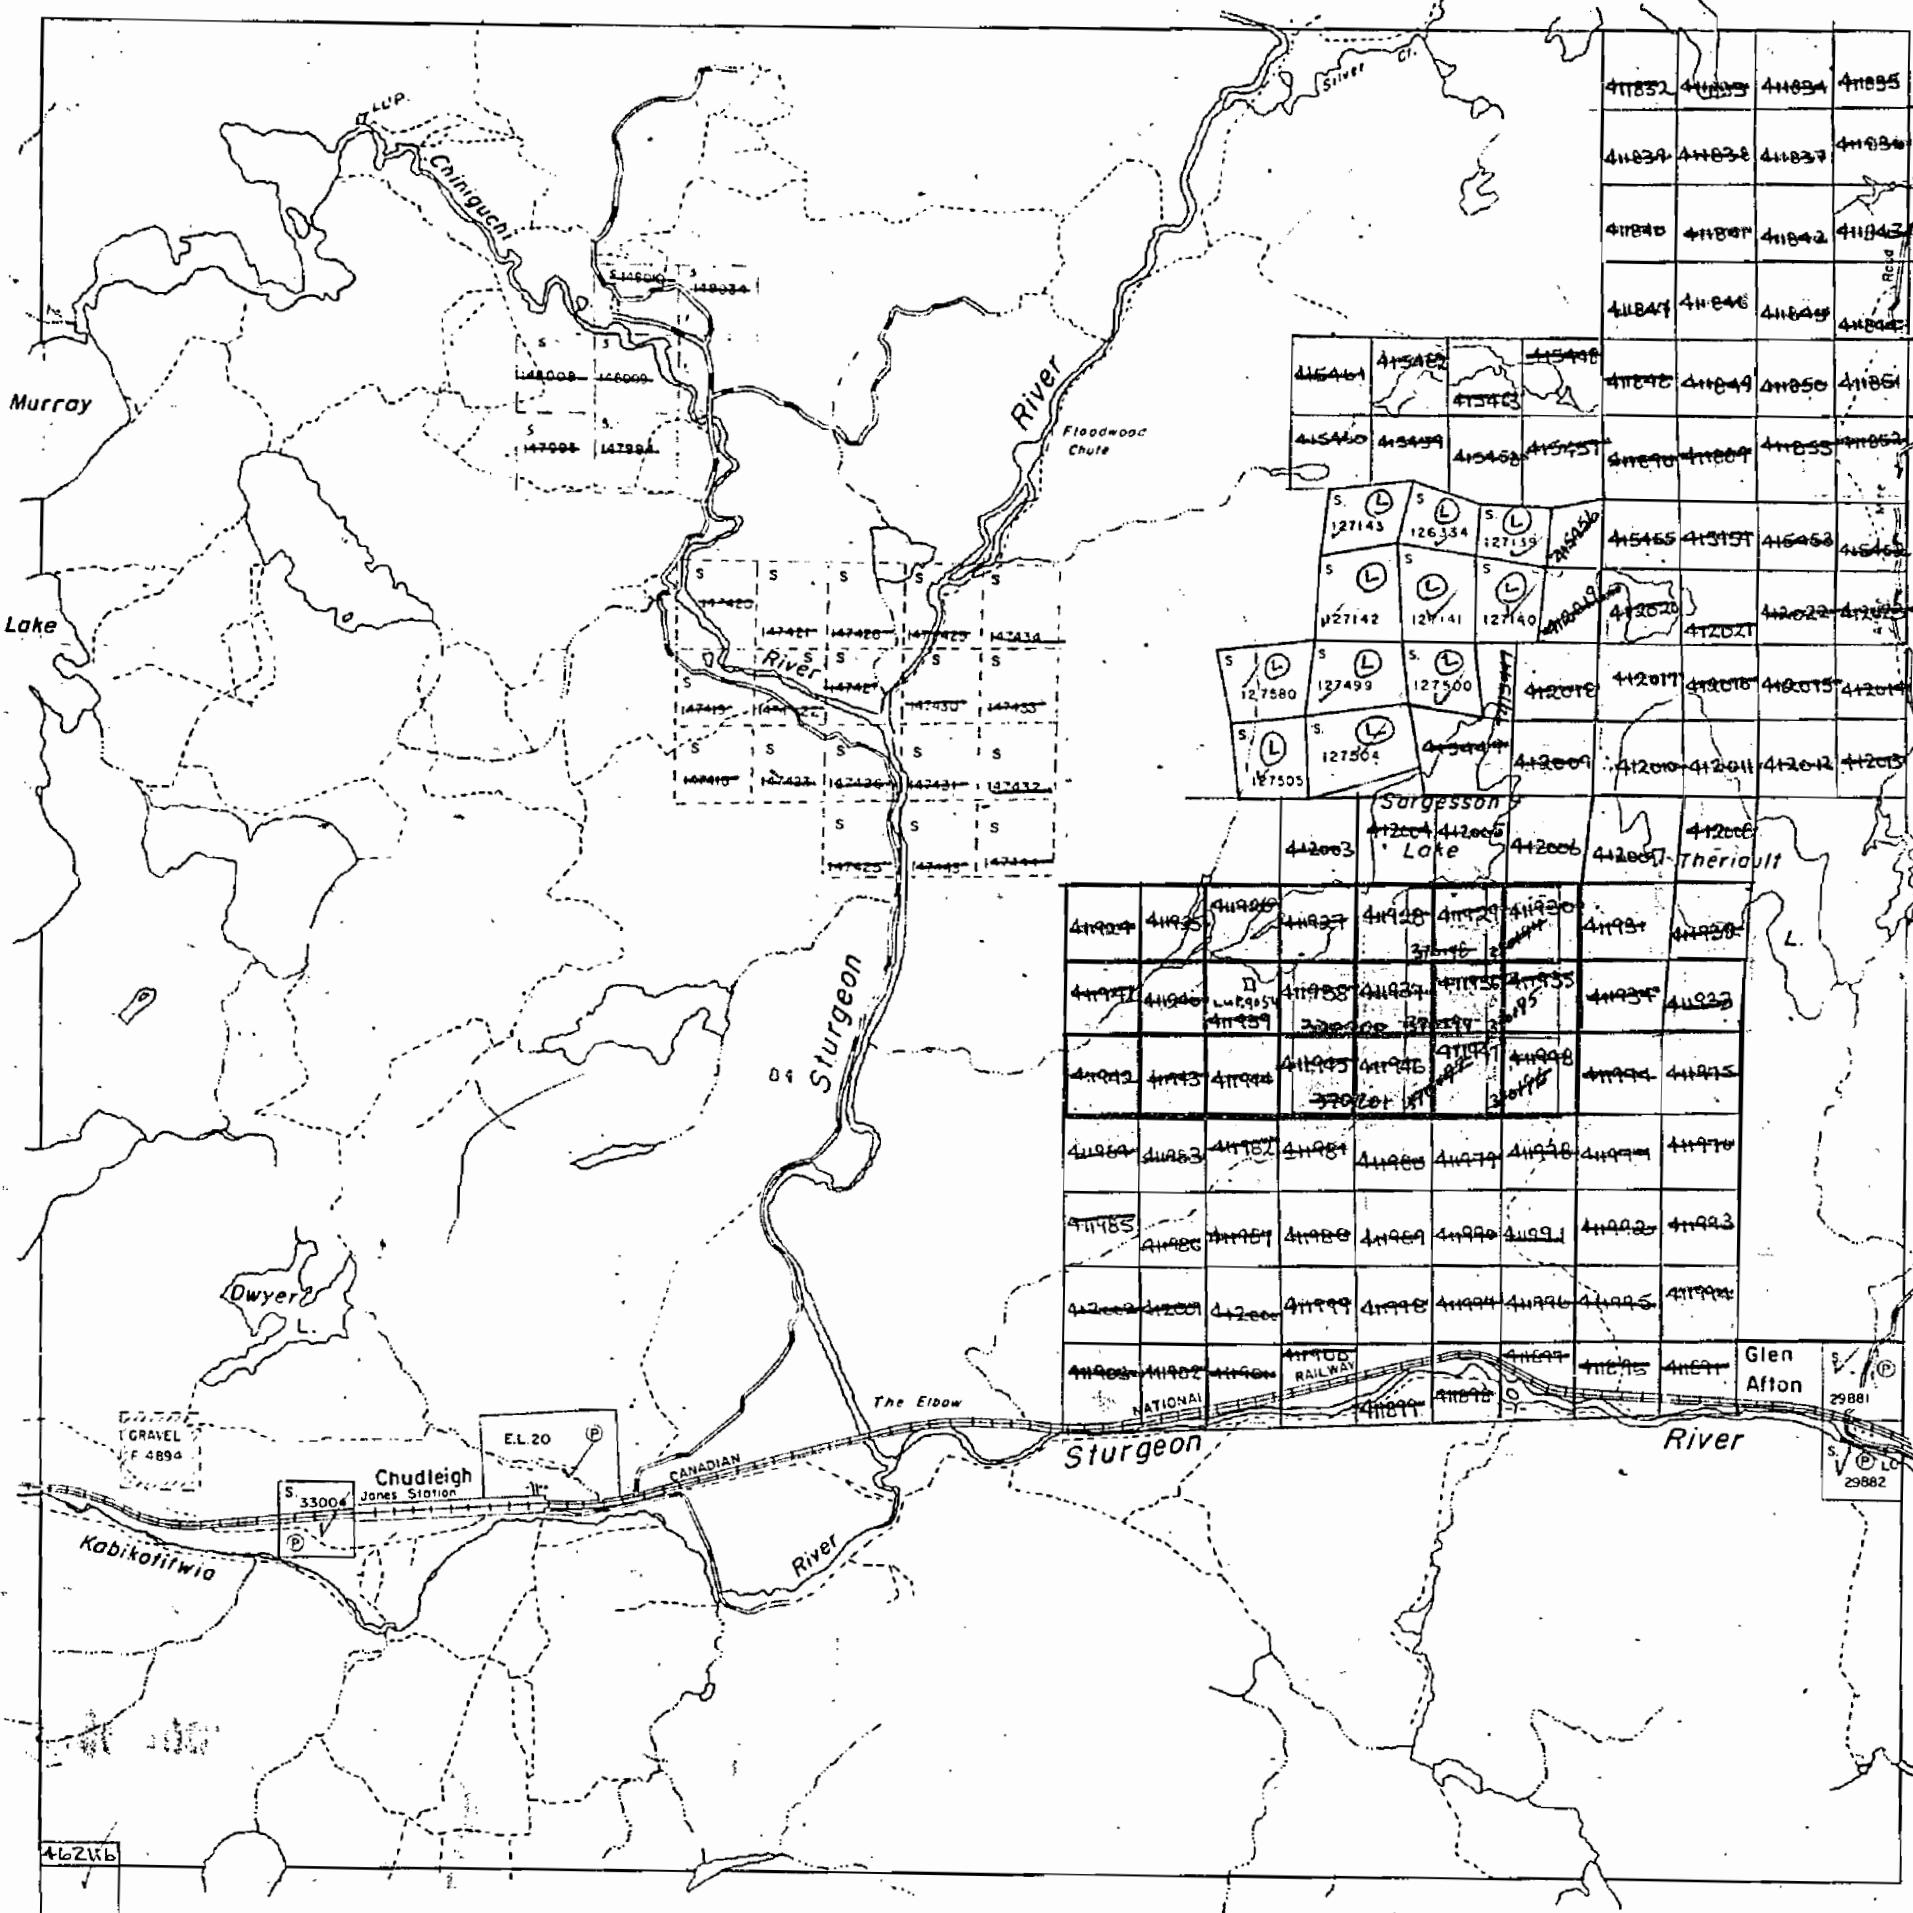

Henry Twp. (M-929)

THE TOWNSHIP
OF

JANES.

DISTRICT OF
SUDBURY

SUDBURY
MINING DIVISION

SCALE: 1-INCH = 40 CHAINS

LEGEND

- | | |
|-----------------------|-------------|
| PATENTED LAND | (P) |
| CROWN LAND SALE | C.S. |
| LEASES | (L) |
| LOCATED LAND | Loc. |
| LICENSE OF OCCUPATION | L.O. |
| MINING RIGHTS ONLY | M.R.O |
| SURFACE RIGHTS ONLY | S.R.O. |
| ROADS | <hr/> <hr/> |
| IMPROVED ROADS | <hr/> <hr/> |
| KING'S HIGHWAYS | <hr/> <hr/> |
| RAILWAYS | <hr/> <hr/> |
| POWER LINES | <hr/> <hr/> |
| MARSH OR MUSKEG | |
| MINES | |
| CANCELLED | C. |

NOTES

400' Surface Rights Reservation
around all Lakes and Rivers.

Surface Rights Only reserved to the
Dept. of Lands & Forests under
Sec. 39(d) of the Mining Act shown
thus:

This Township has been Annulled
Dec 29 1953.

BLANKET QUARRY PERMIT
#6301 COVERING PART
OF JAMES TOWNSHIP.
BLANKET QUARRY PERMIT #7151
COVERING PART OF JAMES TWP.


COVERING PART OF
JANES

PLAN NO. M 955

**ONTARIO
DEPARTMENT OF MINES
AND NORTHERN AFFAIRS**

McNish Twp. (M-1020)

Davis Twp. (M-748)

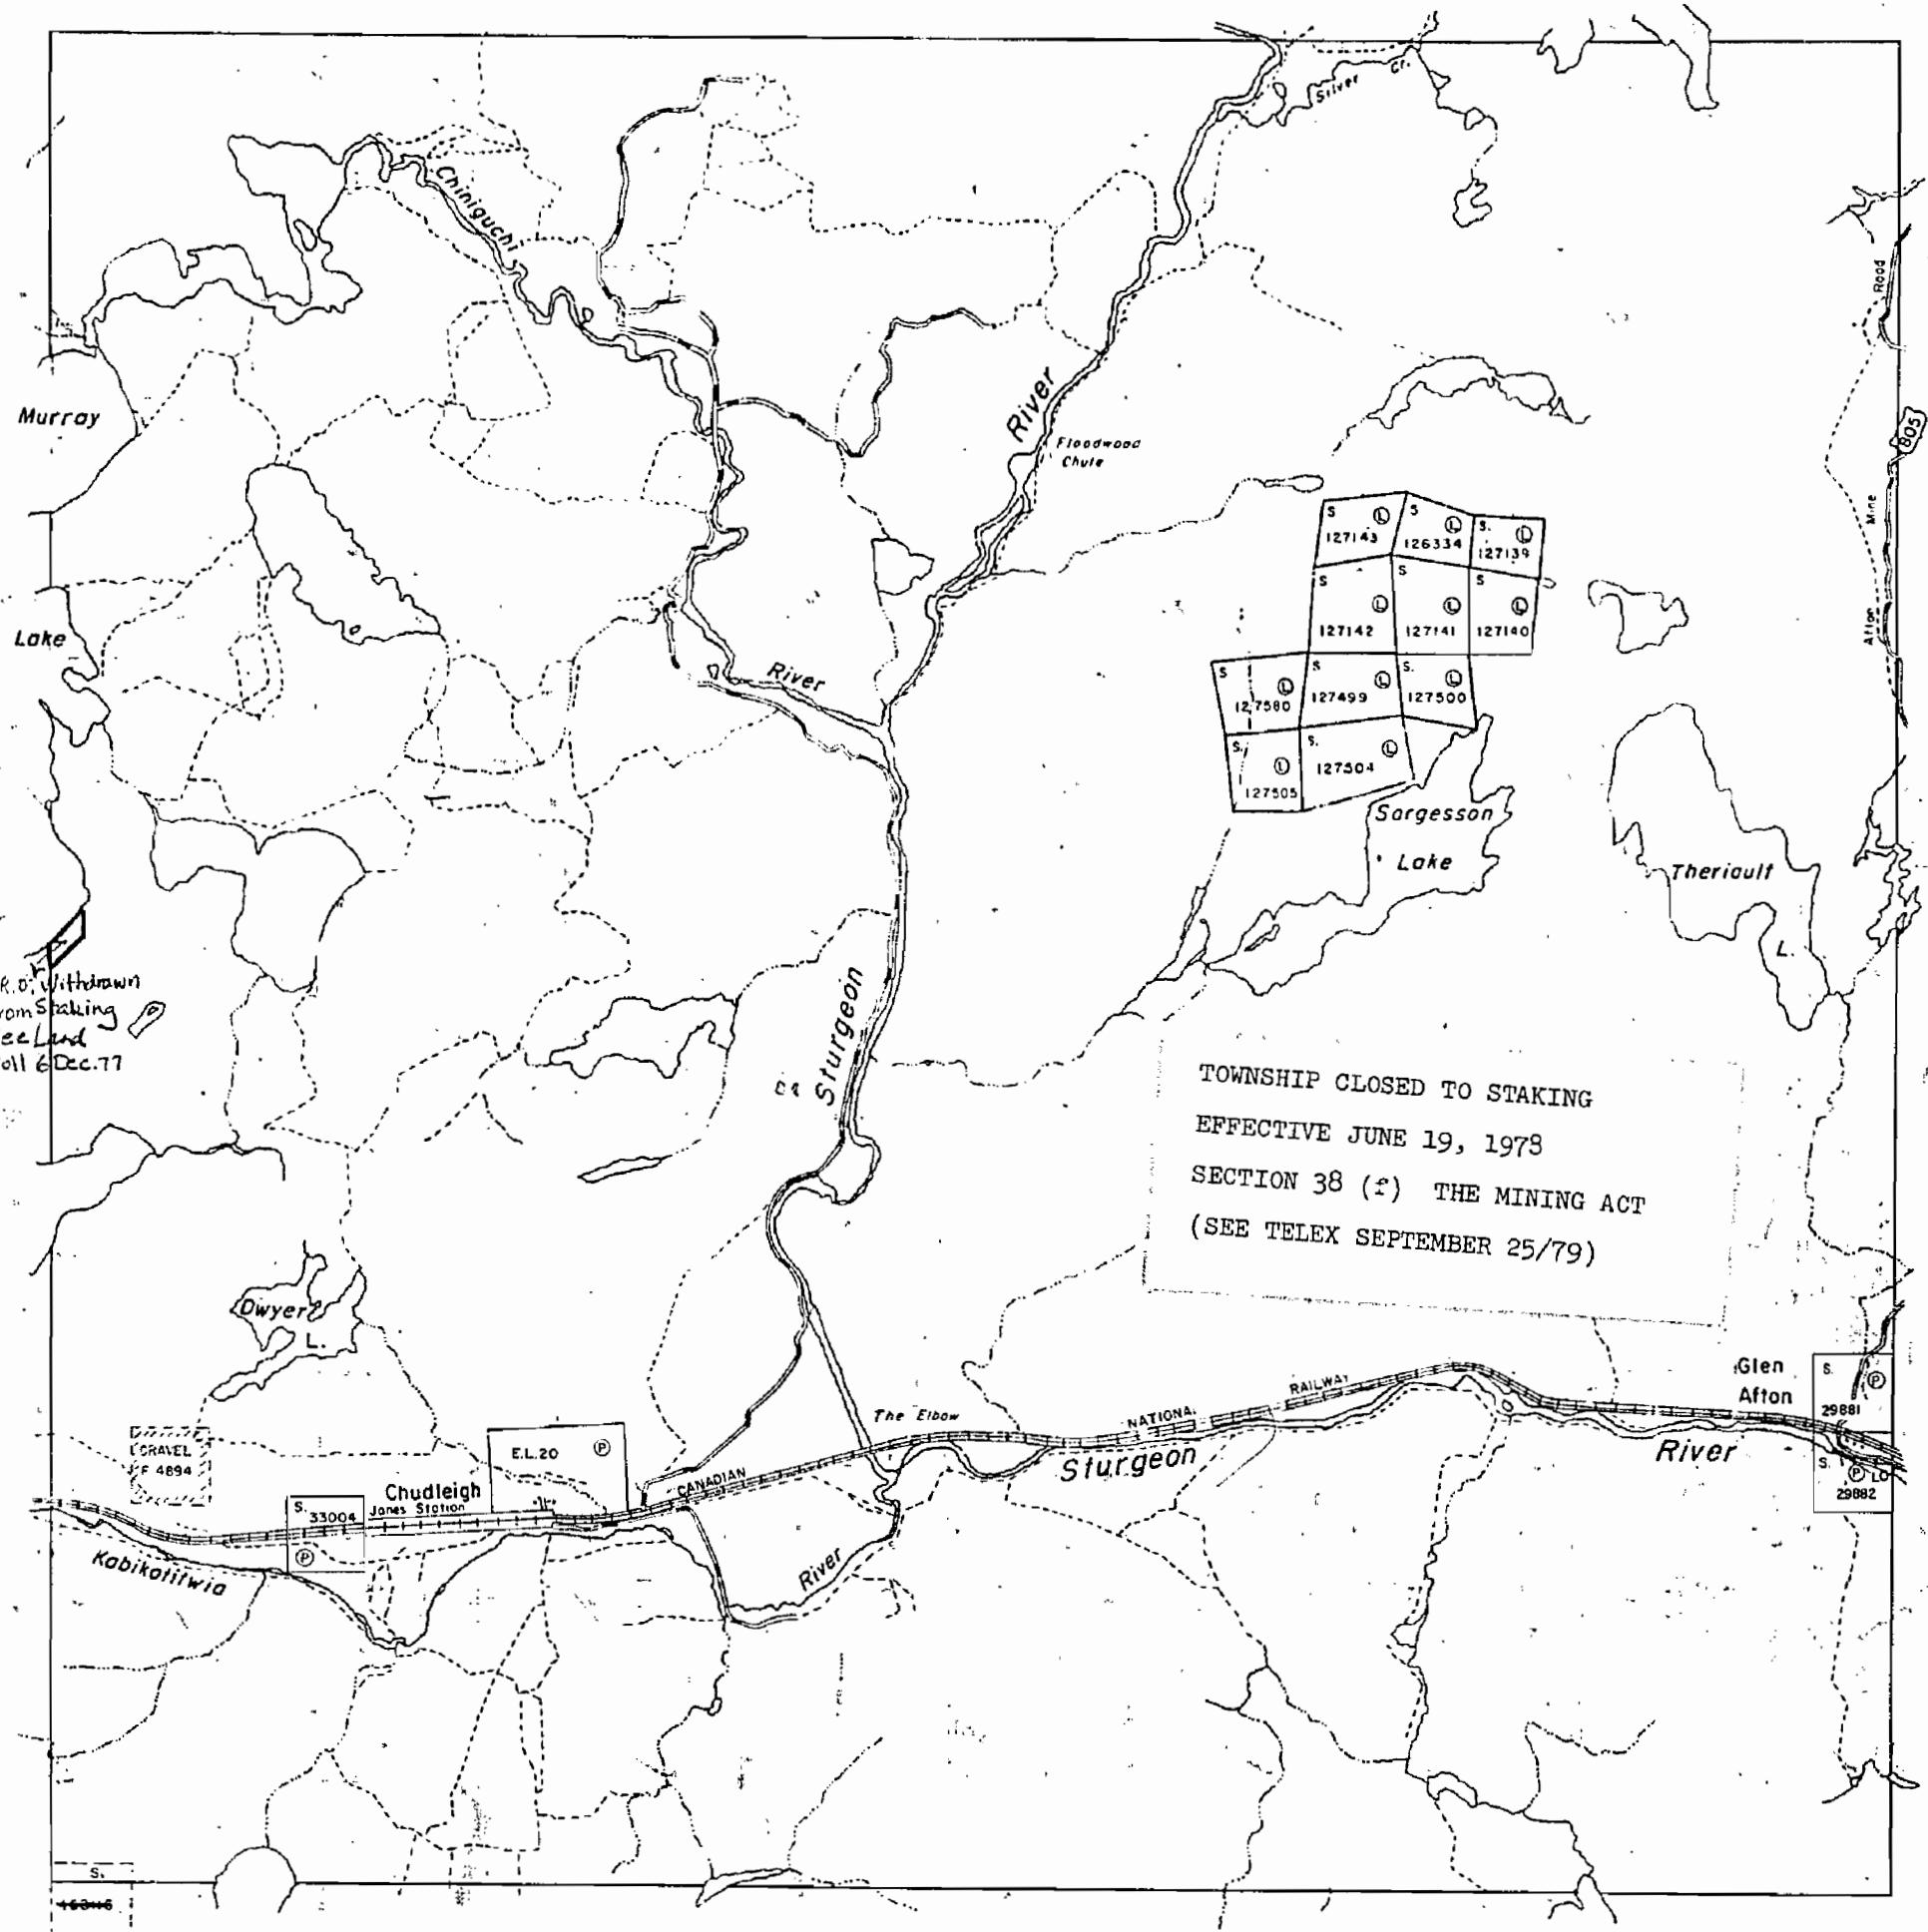

THE TOWNSHIP
OF
JANES

DISTRICT OF
SUDBURY

SUDBURY
MINING DIVISION

SCALE: 1-INCH = 40 CHAINS

LEGEND

P	CROWN LAND SALE
C.S.	LEASES
L	LOCATED LAND
L.O.	LICENSE OF OCCUPATION
M.R.O.	MINING RIGHTS ONLY
S.R.O.	SURFACE RIGHTS ONLY
ROADS	ROADS
IMPROVED ROADS	IMPROVED ROADS
KING'S HIGHWAYS	KING'S HIGHWAYS
RAILWAYS	RAILWAYS
POWER LINES	POWER LINES
MARSH OR MUSKEG	MARSH OR MUSKEG
MINES	MINES
CANCELLED	CANCELLED

NOTES

400' Surface Rights Reservation
around all Lakes and Rivers.

Surface Rights Only reserved to the
Dept. of Lands & Forests under
Sec. 39 (d) of the Mining Act shown
thus: PARAL

This Township has been Annullled
Dec. 29, 1953.

~~BLANKET QUARRY PERMIT #10892
COVERS PART OF JANES TWP.~~

DATE OF ISSUE
AUG 3 - 1976

~~BLANKET QUARRY PERMIT #10892
COVERS PART OF JANES TWP.~~

JANES

PLAN NO. M.955

ONTARIO


MINISTRY OF NATURAL RESOURCES

SURVEYS AND MAPPING BRANCH

OFFICE USE ONLY

McNish Twp. (M-1020)

Davis Twp. (M-748)

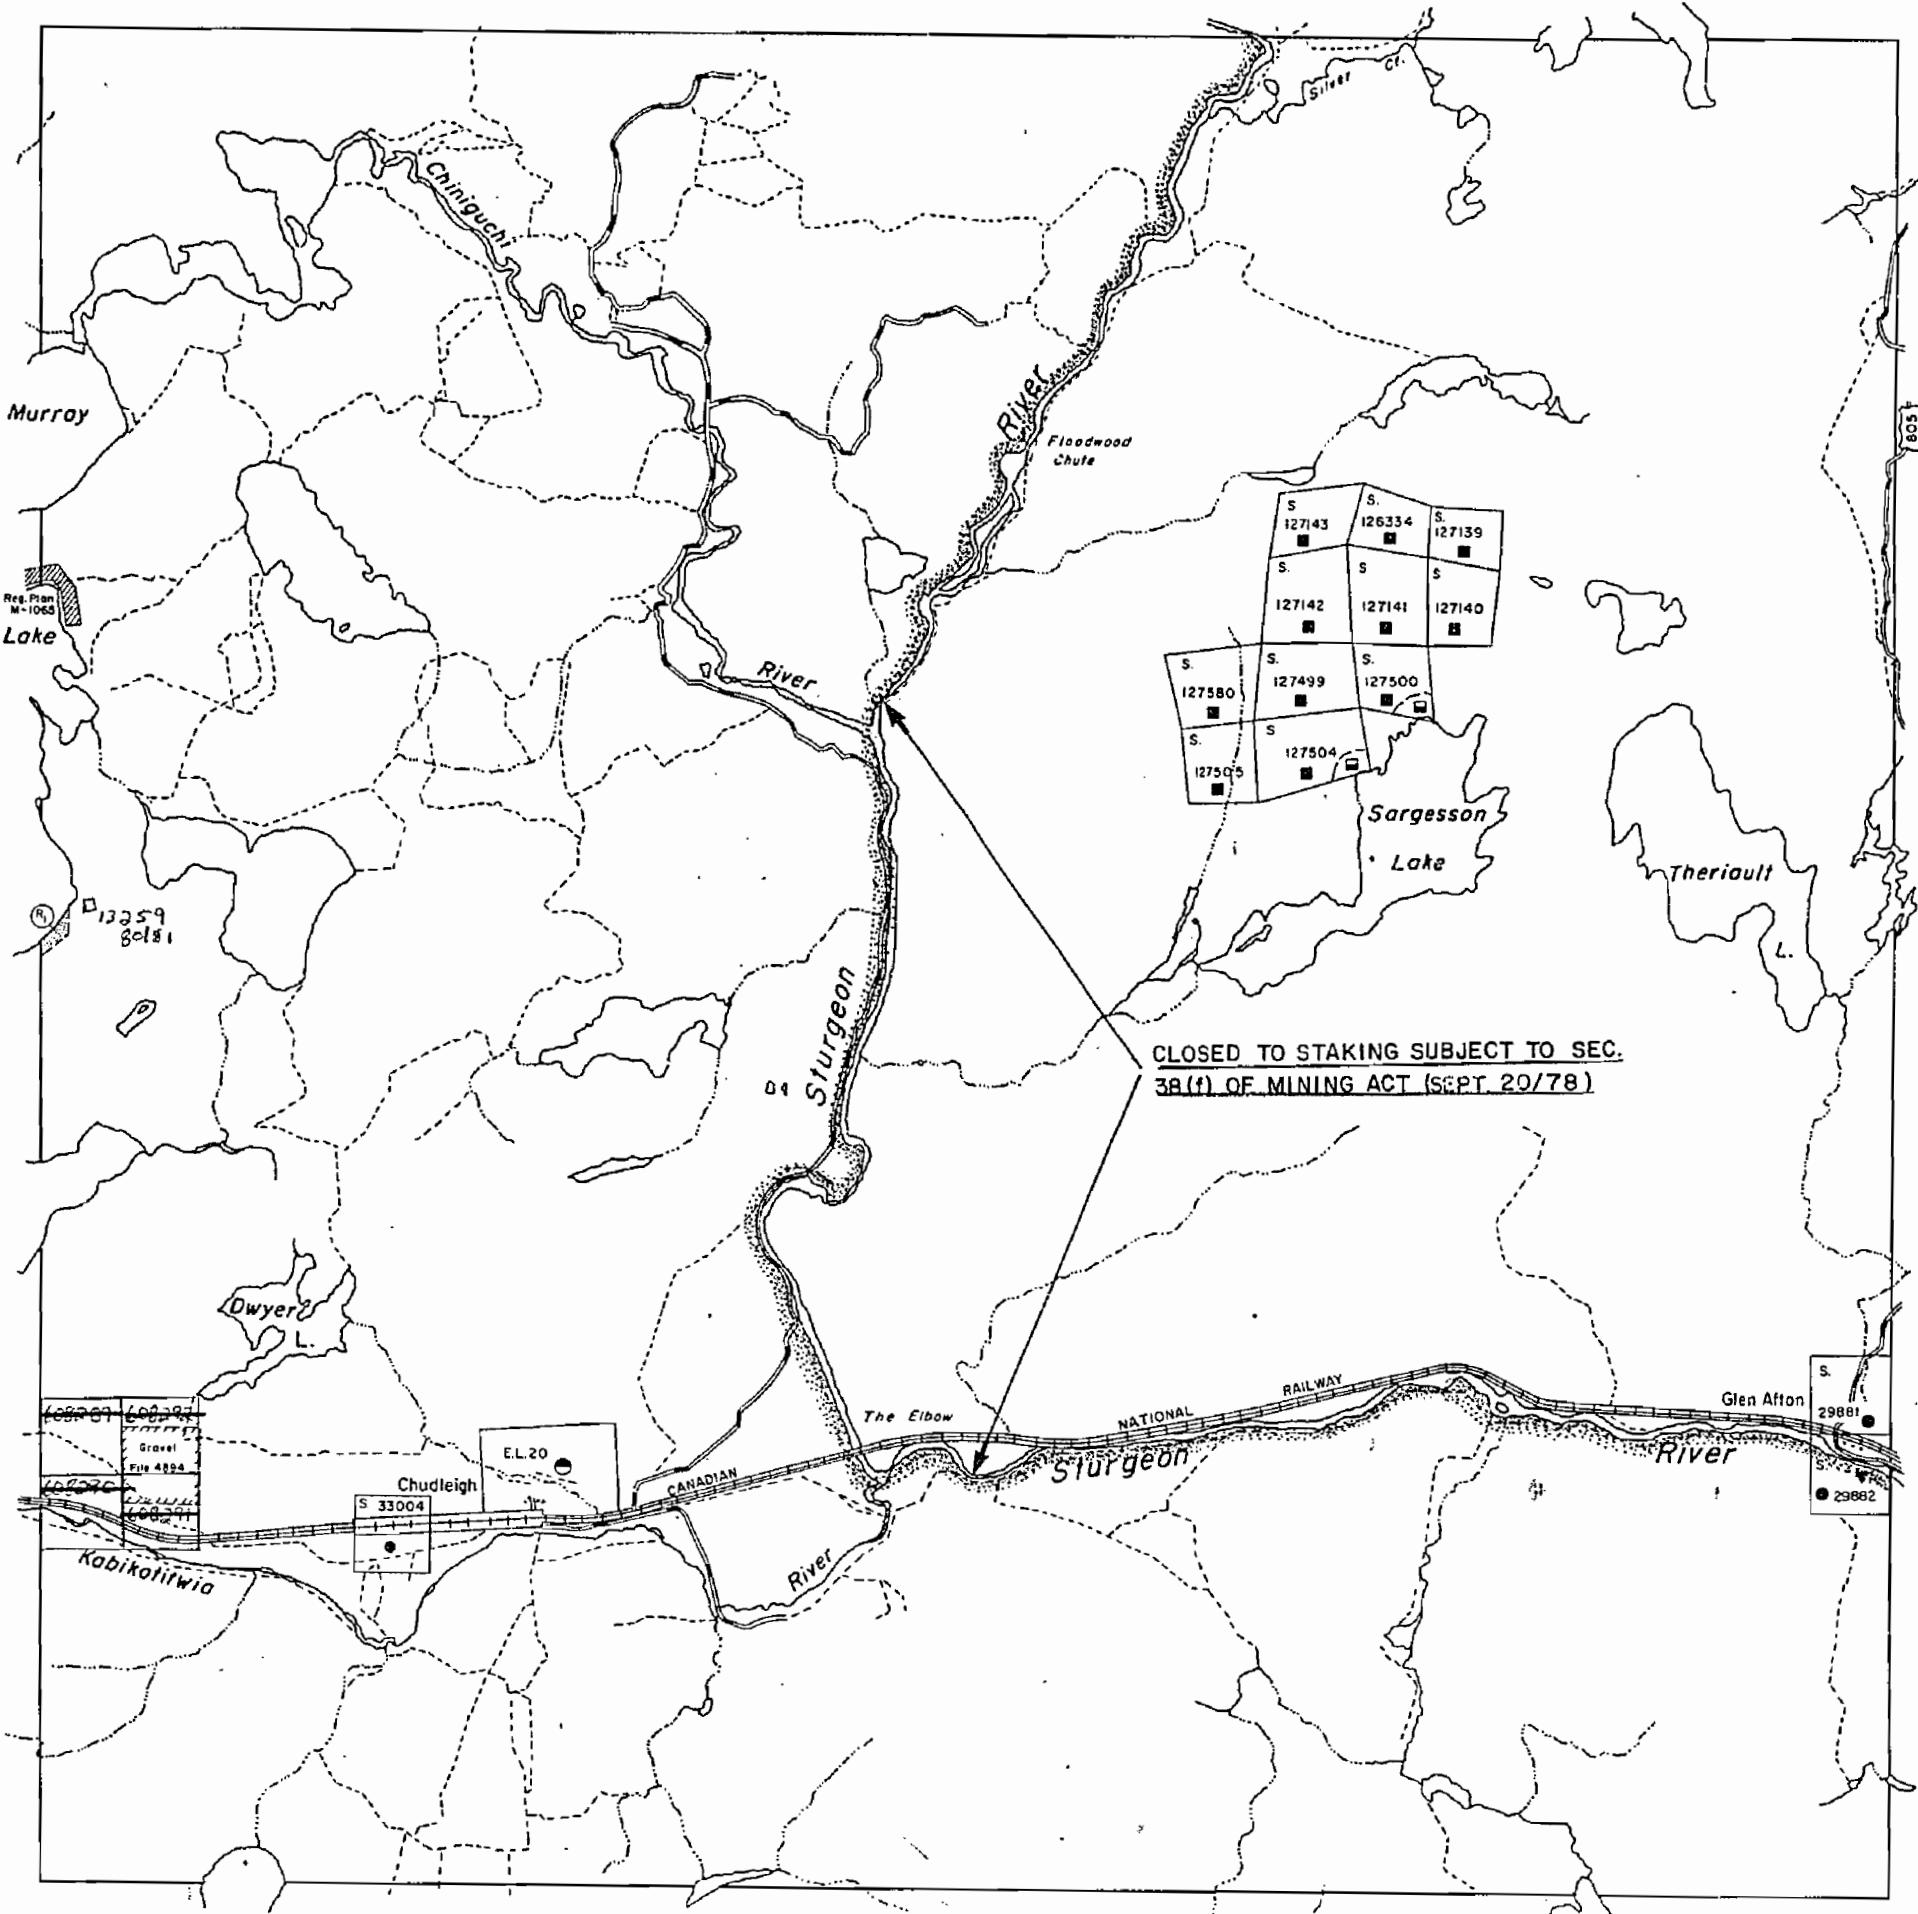

Henry Twp. (M-929)

JANES

THE TOWNSHIP
OF

JANES

DISTRICT OF
SUDBURY

SUDBURY
MINING DIVISION

SCALE: 1-INCH = 40 CHAINS

DISPOSITION OF CROWN LANDS

- | | | |
|---------|---------------------------|---|
| PATENT, | SURFACE AND MINING RIGHTS | ● |
| " , | SURFACE RIGHTS ONLY | ○ |
| " , | MINING RIGHTS ONLY | □ |
| LEASE, | SURFACE AND MINING RIGHTS | ■ |
| " , | SURFACE RIGHTS ONLY | □ |
| " , | MINING RIGHTS ONLY | □ |
| LICENCE | OF OCCUPATION | ▼ |

- | | |
|-----------------|---|
| ROADS | — |
| IMPROVED ROADS | — |
| KING'S HIGHWAYS | — |
| RAILWAYS | — |
| POWER LINES | — |
| MARSH OR MUSKEG | — |
| MINES | — |
| CANCELLED | — |

NOTES


400' surface rights reservation along the shores of all lakes and rivers.

Subdivision of this township into lots and concessions was annulled 29 Dec., 1953.

Areas withdrawn from staking under Section 43 of the Mining Act (R.S.O. 1970).

Order No.	File	Date	Disposition
(1)	494/77	188530	S.R. SURFACE RIGHTS M.R. MINING RIGHTS

BLANKET QUARRY PERMIT
COVERS PART OF JANES TWP.

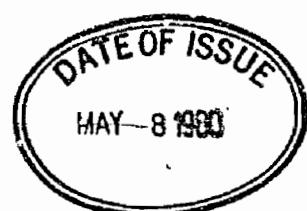


PLAN NO. M.955

ONTARIO
MINISTRY OF NATURAL RESOURCES
SURVEYS AND MAPPING BRANCH

963

J A N E S

SCALE - 40 CHAINS = ONE INCH

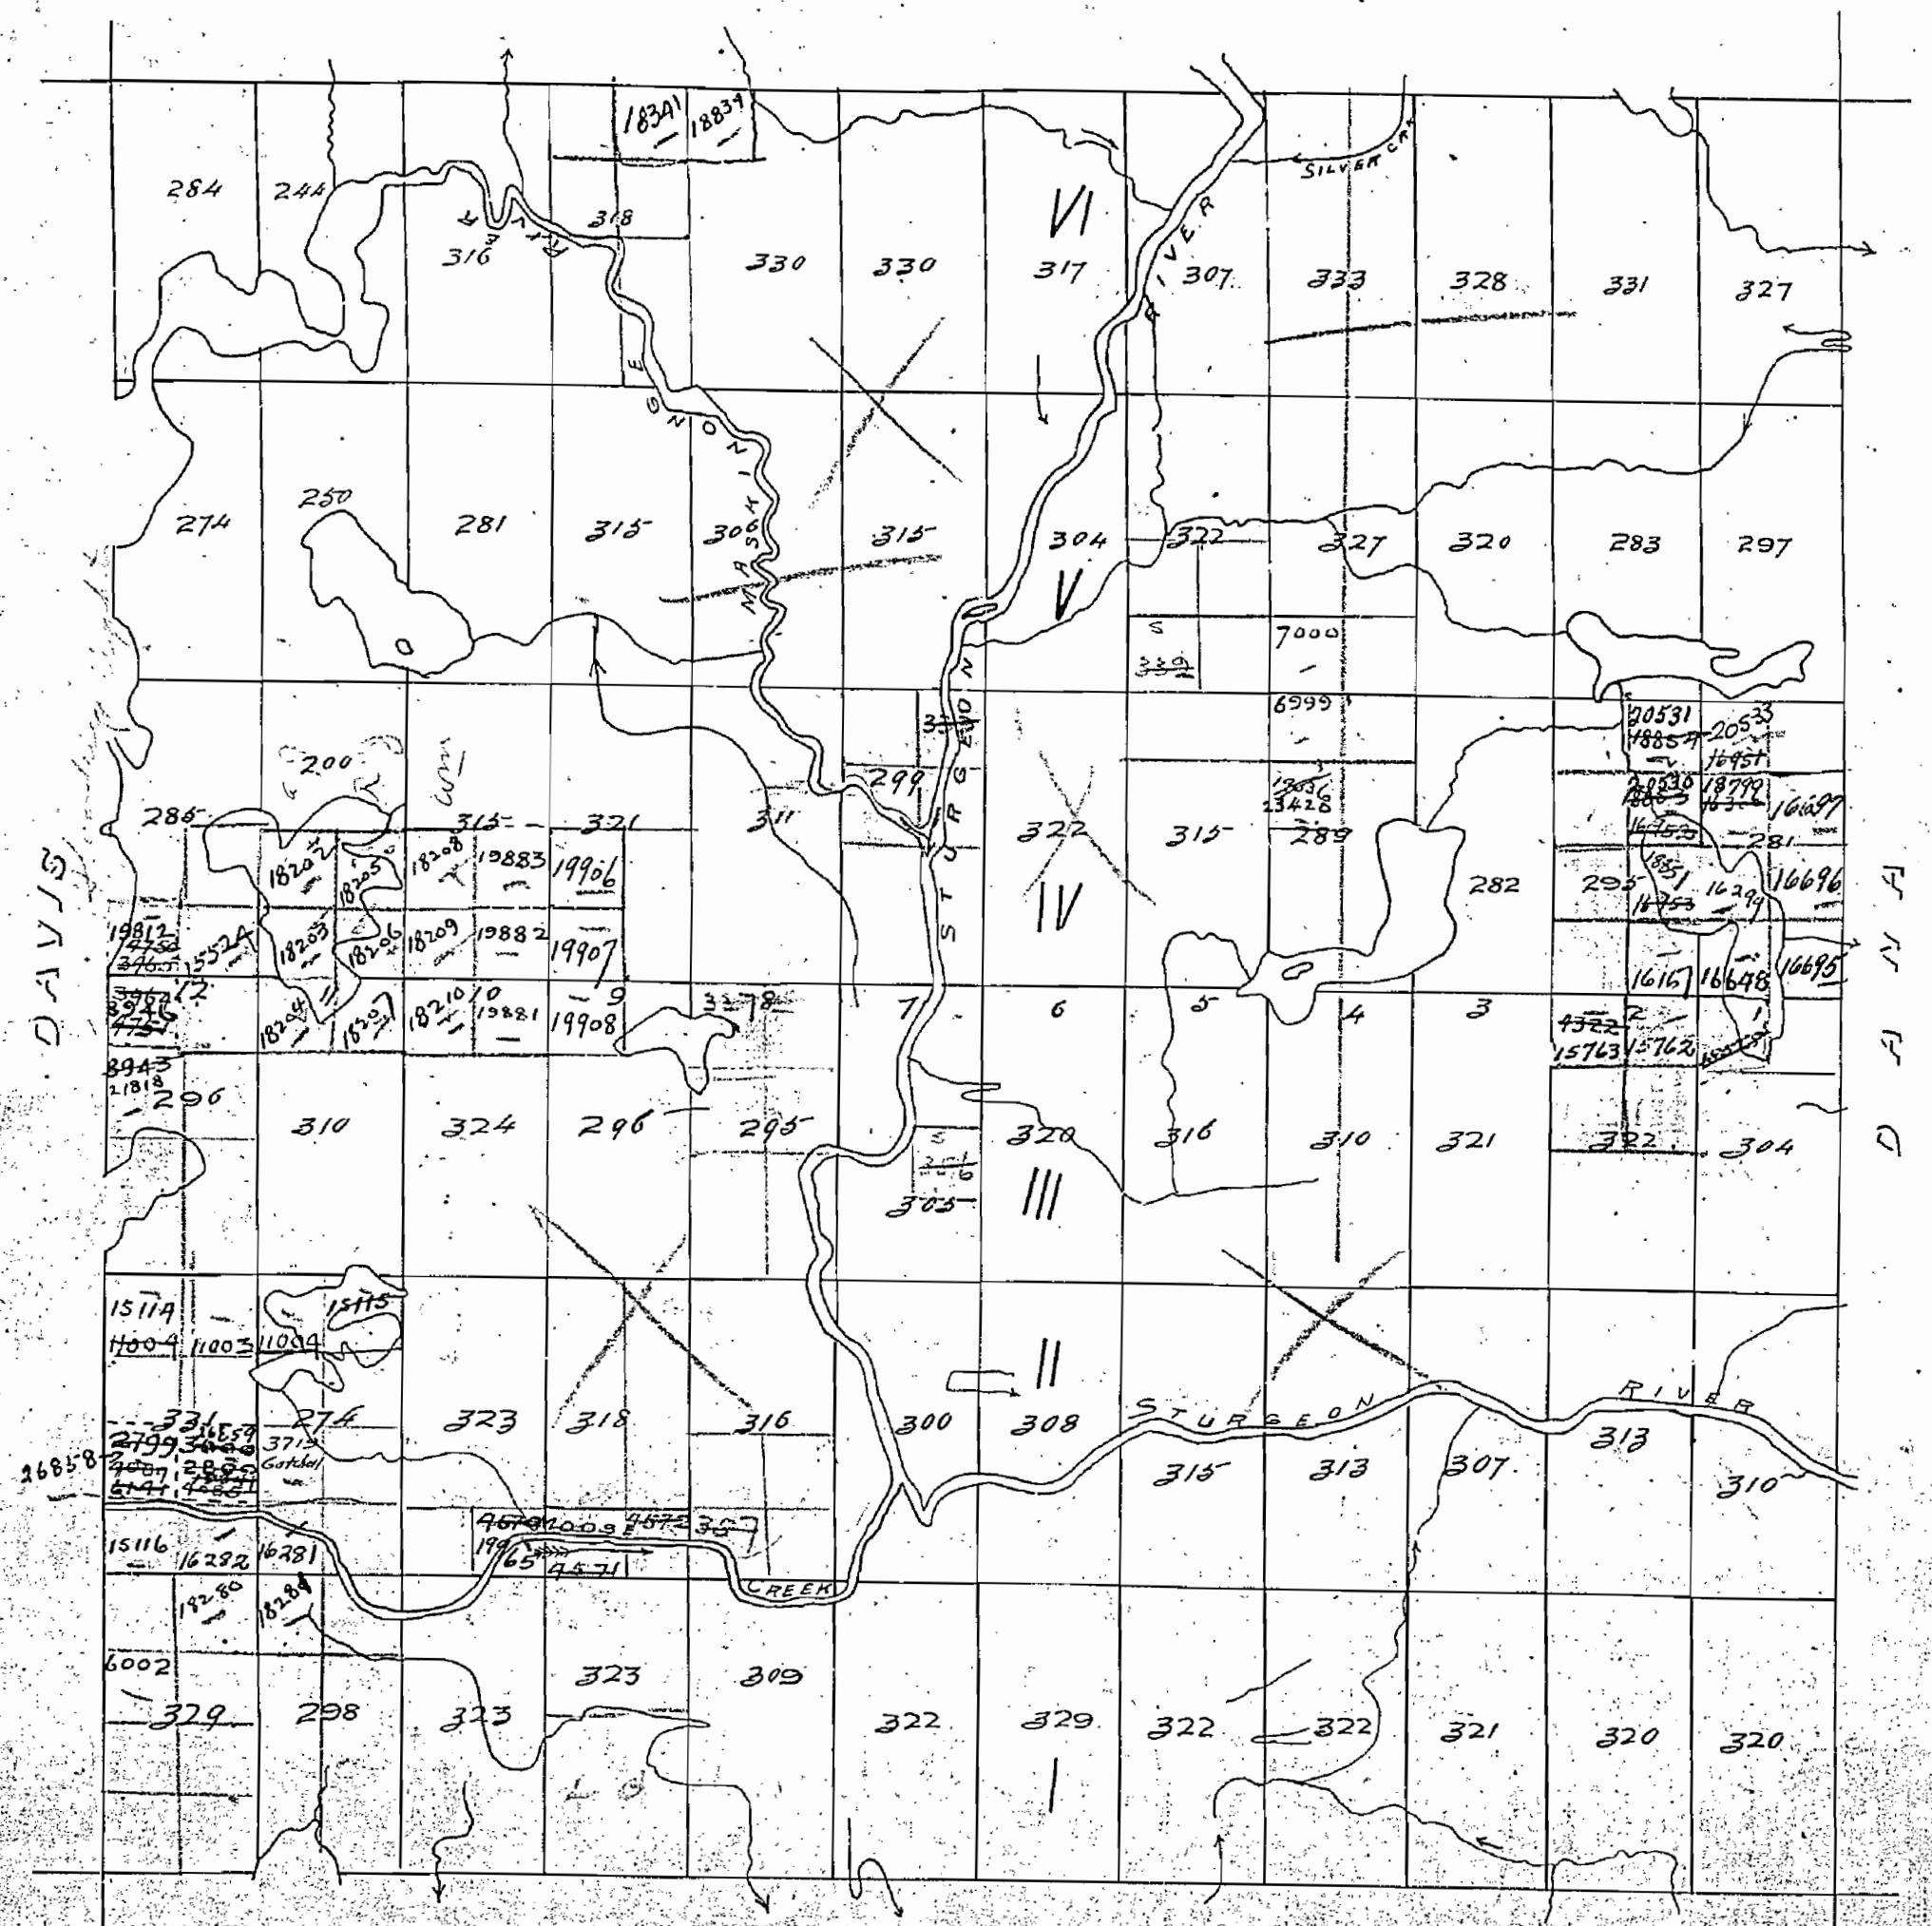


m955

* Oct/83

McNish Twp. (M-1020)

Davis Twp. (M-748)

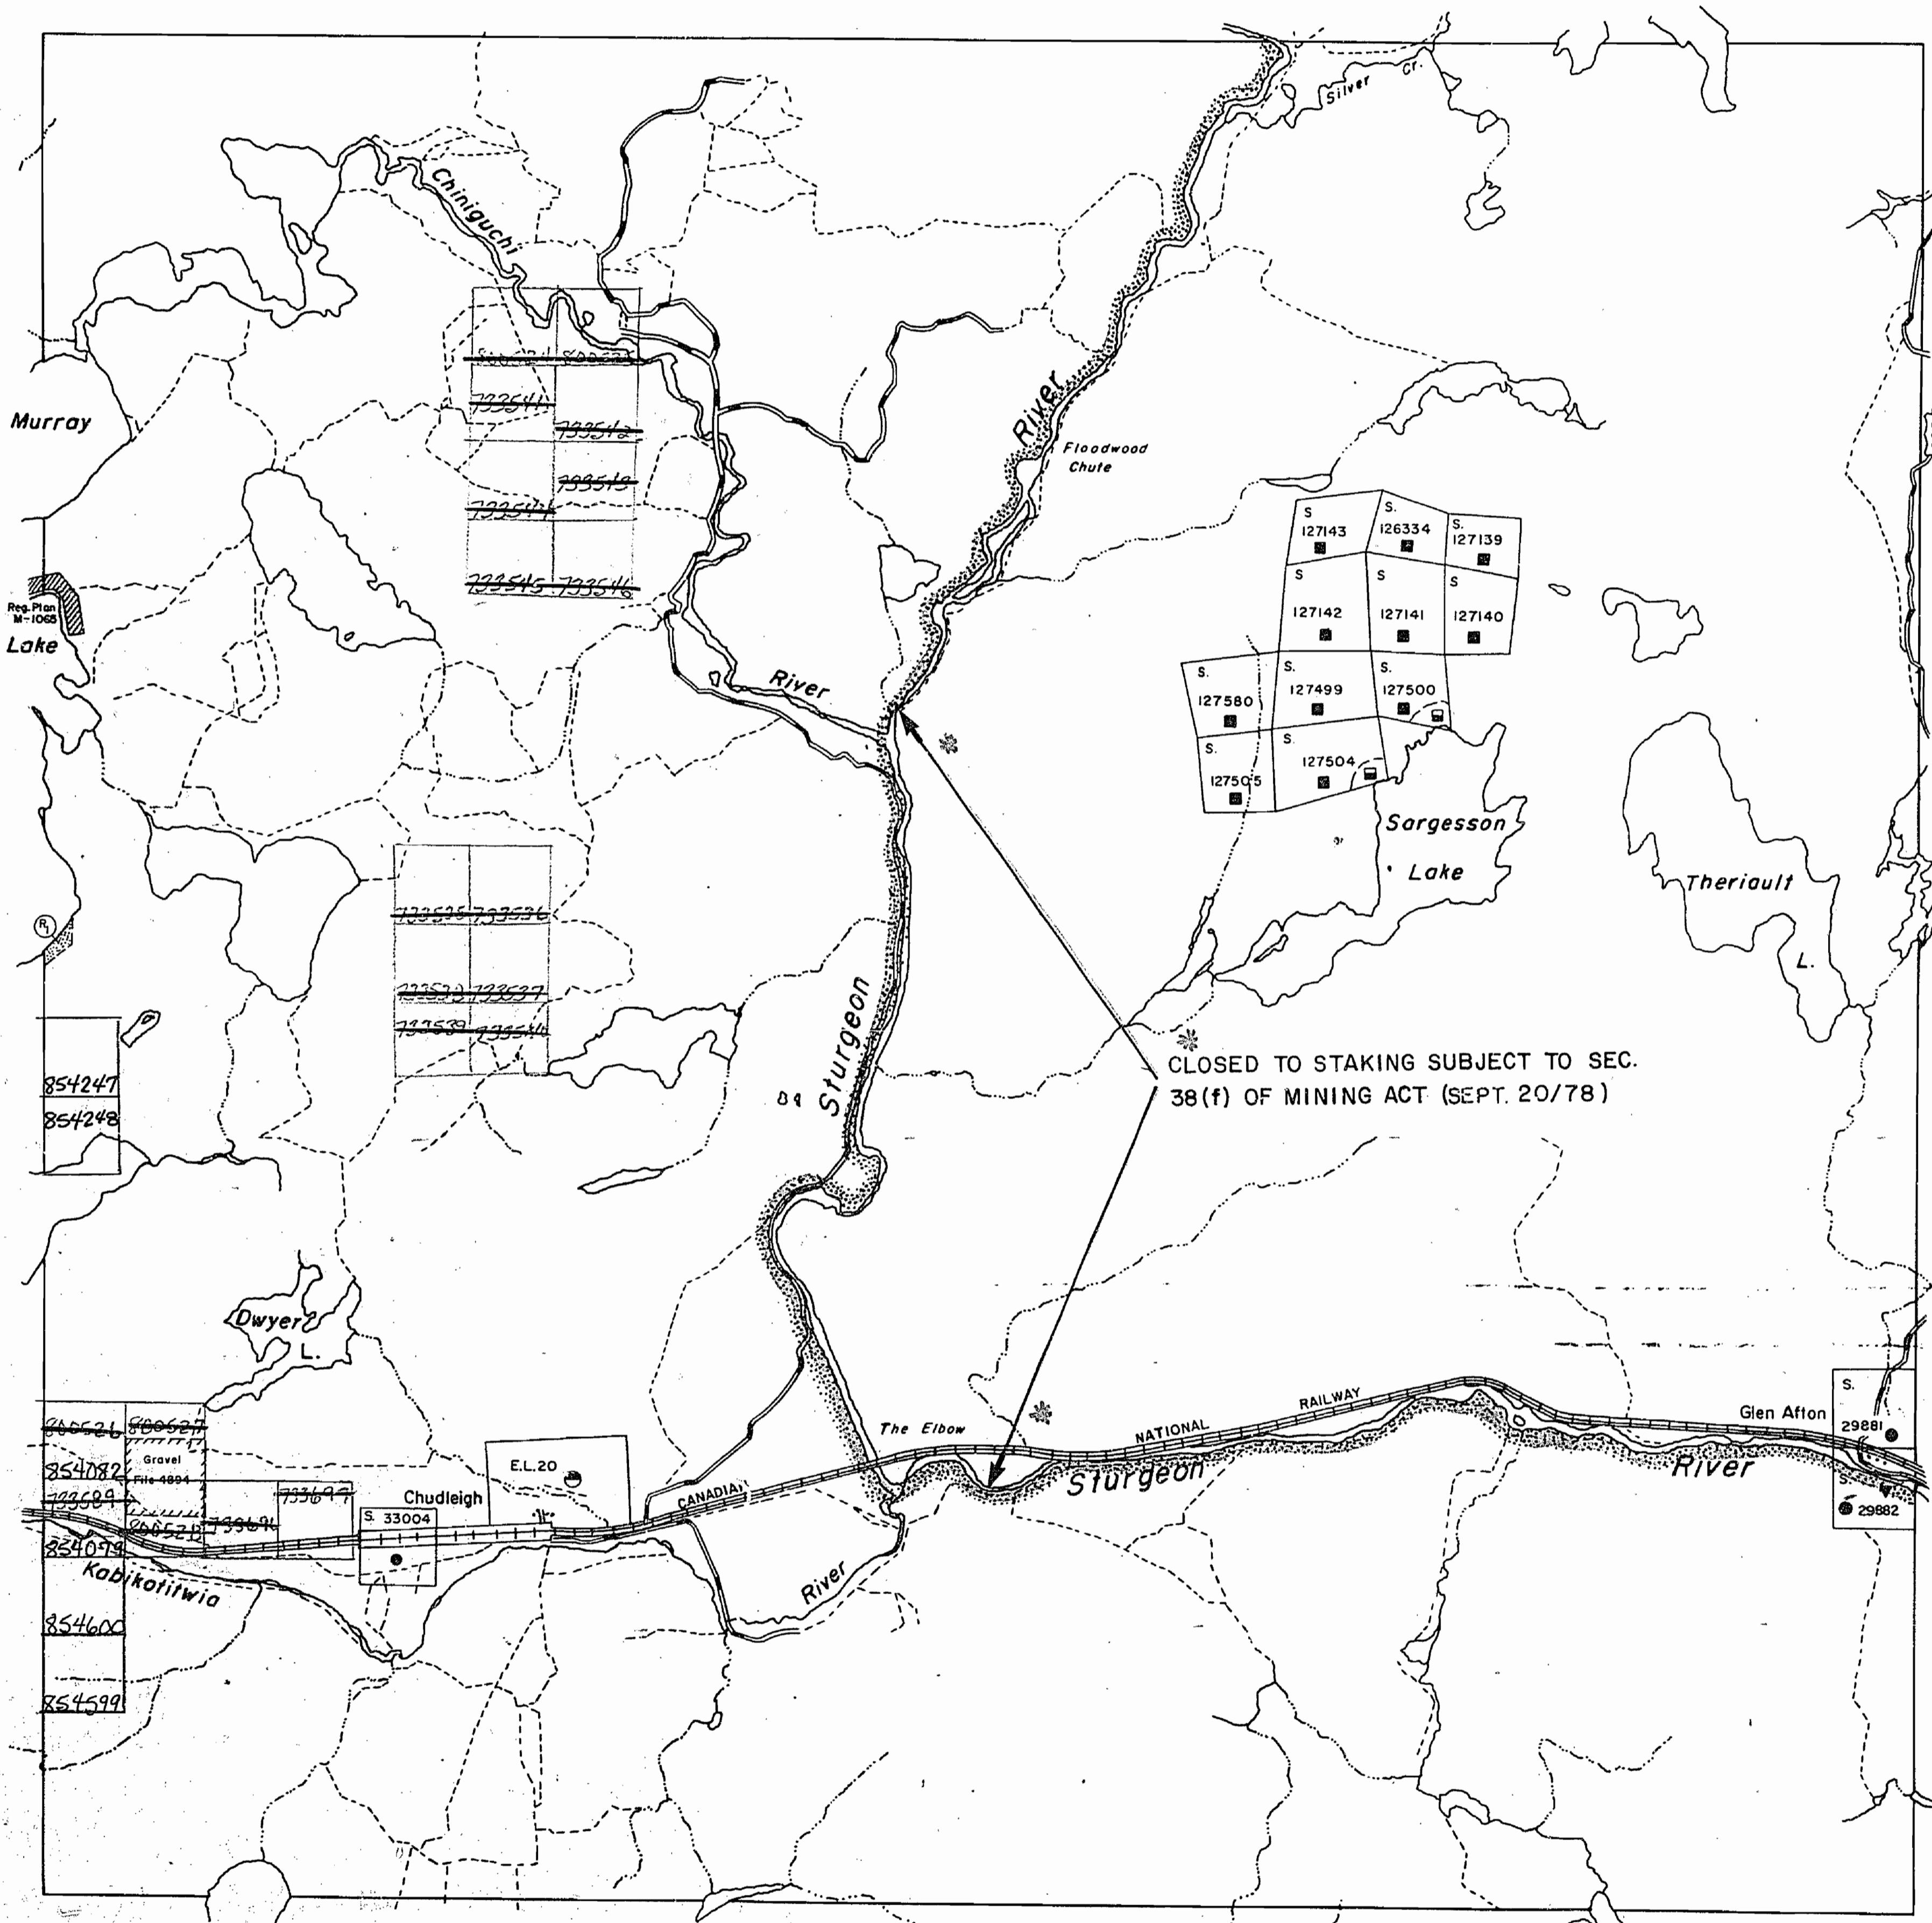

Henry Twp. (M-929)

THE TOWNSHIP
OF

JANES


DISTRICT OF
SUDBURY

SUDBURY MINING DIVISION

SCALE: 1-INCH = 40 CHAINS

DISPOSITION OF CROWN LANDS

- PATENT, SURFACE AND MINING RIGHTS ----- ●
- " , SURFACE RIGHTS ONLY ----- ○
- " , MINING RIGHTS ONLY ----- ◻
- LEASE, SURFACE AND MINING RIGHTS ----- ■
- " , SURFACE RIGHTS ONLY ----- □
- " , MINING RIGHTS ONLY ----- ▨
- LICENCE OF OCCUPATION ----- ▼

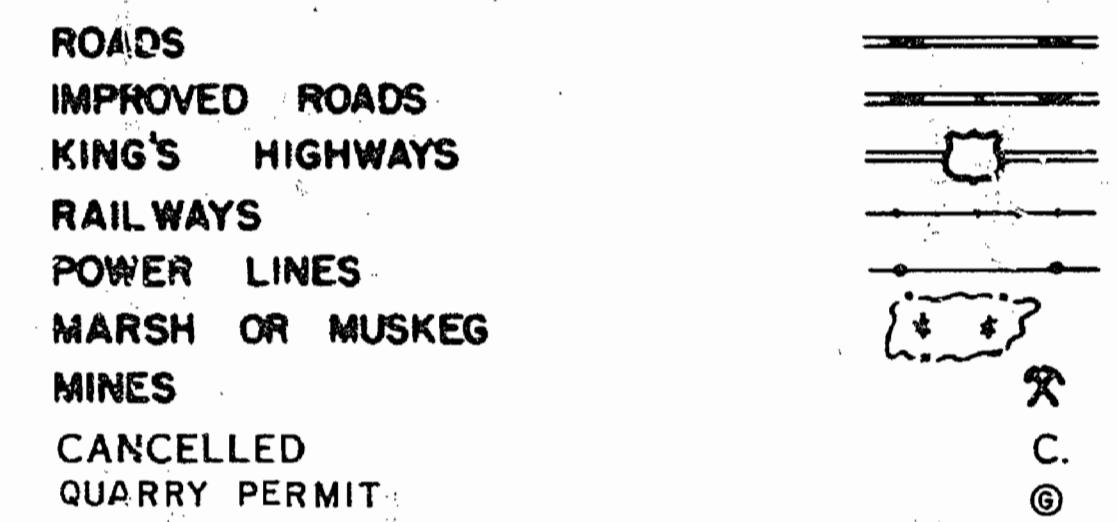

NOTES

400' surface rights reservation along the shores of all lakes and rivers.

Subdivision of this township into Lots and Concessions was annulled 29 Dec., 1953.

Areas withdrawn from staking under Section 43 of the Mining Act (R.S.O. 1970).

Order No.	File	Date	Disposition
			S.R. SURFACE RIGHTS M.R. MINING RIGHTS

(R) W.94/77 188530 6/12/77 S.R.

* IN SERVICE 1983 10 01 - VM.

* CLOSED TO STAKING EFFECTIVE MARCH 16, 1984. SECTION 36 OF THE MINING ACT

JANES

PLAN NO. M.955

ONTARIO

MINISTRY OF NATURAL RESOURCES
SURVEYS AND MAPPING BRANCH