

AREAS WITHDRAWN FROM DISPOSITION

M.R.O. - MINING RIGHTS ONLY
 S.R.O. - SURFACE RIGHTS ONLY
 M.+S. - MINING AND SURFACE RIGHTS

Description	Order No.	Date	Disposition	File
W.43/79 NR. 16/8/79	S.R.O.	33749		


Surface Rights Withdrawn under Sec. 36,
 The Mining Act R.S.O. 1980, ORDER NO. W-01/91/CNT
 (Tran - under Pipeline Right of Way and Luffer
 Zone particularly 40.25 meters or 132 ft, on
 either side of centre line of right of way)

ST. JOHN TOWNSHIP

MANN TOWNSHIP

AURORA TOWNSHIP

Mc CART TOWNSHIP

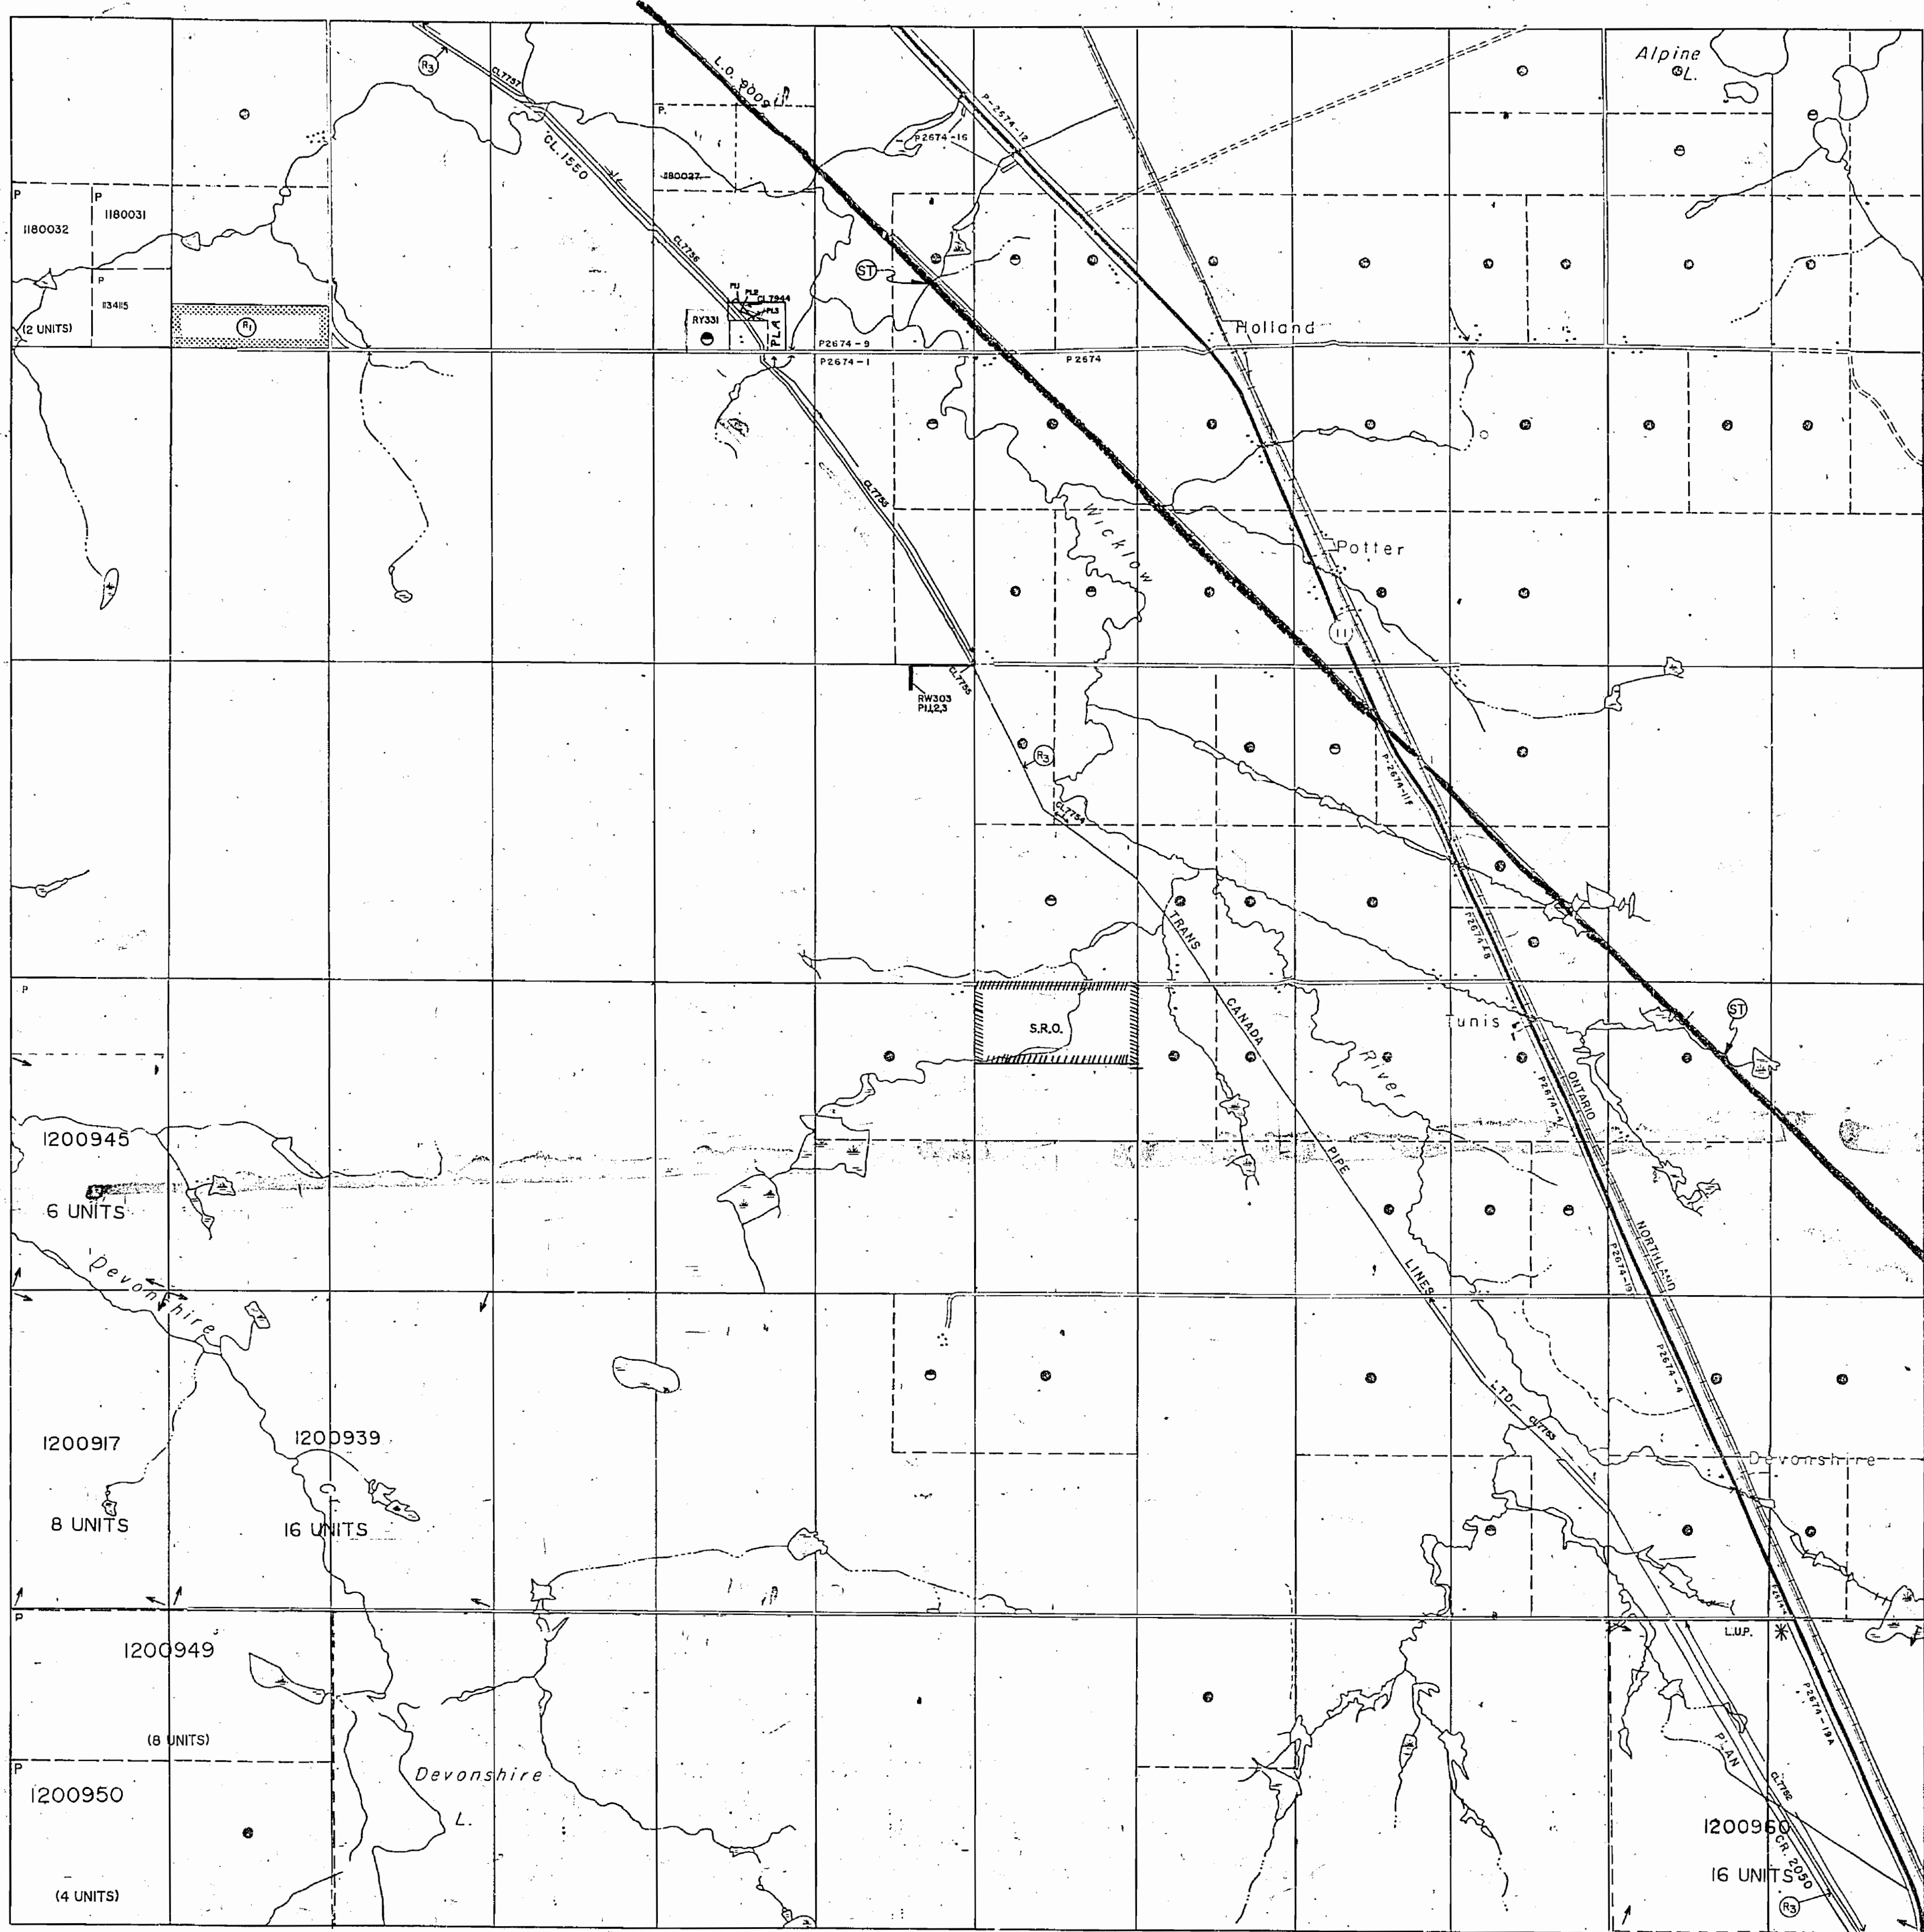


LEGEND

- HIGHWAY AND ROUTE No.
- OTHER ROADS
- TRAILS
- SURVEYED LINES
- TOWNSHIPS, BASE LINES, ETC.
- LOTS, MINING CLAIMS, PARCELS, ETC.
- UNSURVEYED LINES
- LOT LINES
- PARCEL BOUNDARY
- MINING CLAIMS ETC.
- RAILWAY AND RIGHT OF WAY
- UTILITY LINES
- NON PERENNIAL STREAM
- FLOODING OR FLOODING RIGHTS
- SUBDIVISION OR COMPOSITE PLAN
- RESERVATIONS
- ORIGINAL SHORELINE
- MARSH OR MUSKEG
- MINES
- TRAVERSE MONUMENT

DISPOSITION OF CROWN LANDS

TYPE OF DOCUMENT	SYMBOL
PATENT, SURFACE & MINING RIGHTS	
" SURFACE RIGHTS ONLY	
" MINING RIGHTS ONLY	
LEASE, SURFACE & MINING RIGHTS	
" SURFACE RIGHTS ONLY	
" MINING RIGHTS ONLY	
LICENCE OF OCCUPATION	
ORDER-IN-COUNCIL	
RESERVATION	
CANCELLED	
SAND & GRAVEL	
LUP (LAND USE PERMIT)	

NOTE: MINING RIGHTS IN PARCELS PATENTED PRIOR TO MAY 1,
 1913, VESTED IN ORIGINAL PATENTEE BY THE PUBLIC
 LANDS ACT, R.S.O. 1970, CHAP. 380, SEC. 62, SUBSEC. 1.

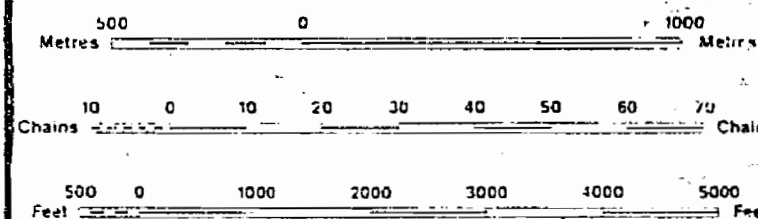

SCALE 1:20 000

R₂ - AGRICULTURAL PERMIT
 ST - SNOWMOBILE TRAIL
 NOTICE RECEIVED 92-DEC-09

DATE OF ISSUE

APR 27 1998
 PROVINCIAL RECORDING
 OFFICE - SUDBURY

THE INFORMATION THAT
 APPEARS ON THIS MAP
 HAS BEEN COMPILED
 FROM VARIOUS SOURCES,
 AND ACCURACY IS NOT
 GUARANTEED. THOSE
 WISHING TO STAKE MIN-
 ING CLAIMS SHOULD CON-
 SULT WITH THE MINING
 RECORDER, MINISTRY OF
 NORTHERN DEVELOP-
 MENT AND MINES, FOR AD-
 DITIONAL INFORMATION
 ON THE STATUS OF THE
 LANDS SHOWN HEREON.

TOWNSHIP

NEWMARKET

M.N.R. ADMINISTRATIVE DISTRICT

COCHRANE

MINING DIVISION

PORCUPINE

LAND TITLES / REGISTRY DIVISION

COCHRANE

Ministry of Natural Resources
 Ontario
 Ministry of Northern Development and Mines

Date: SEPTEMBER 1986
 Number: 38
 Checked: J. N. Nov. 20/86
 38 / 23.10.87

G-3548

557

St. John Twp.

THE TOWNSHIP
OF
NEWMARKET

DISTRICT OF
COCHRANE
PORCUPINE
MINING DIVISION

SCALE 1-INCH=40 CHAINS

LEGEND

PATENTED LAND (P)
CROWN LAND SALE (CS)
LEASES (L)
LOCATED LAND (Loc)
LICENSE OF OCCUPATION (L.O.)
ROADS
IMPROVED ROADS
RAILWAYS
POWER LINES
MARSH OR MUSKEG

NOTES

M.R.O. Mineral Rights Only

Surface rights reserved on all lands staked
B patented after 21 May 1945 - See O.C.
25 April 1945


By regulations passed previously, sale or
other disposition of land in this Township
has been limited to S.R.O. only effective
May 2, 1950.

400' Surface Rights Reservation around
all Lakes and Rivers

MINING RECORDER
RECEIVED
NOV 9 1962

PLANNING - M-557

DEPARTMENT OF MINES
— ONTARIO —

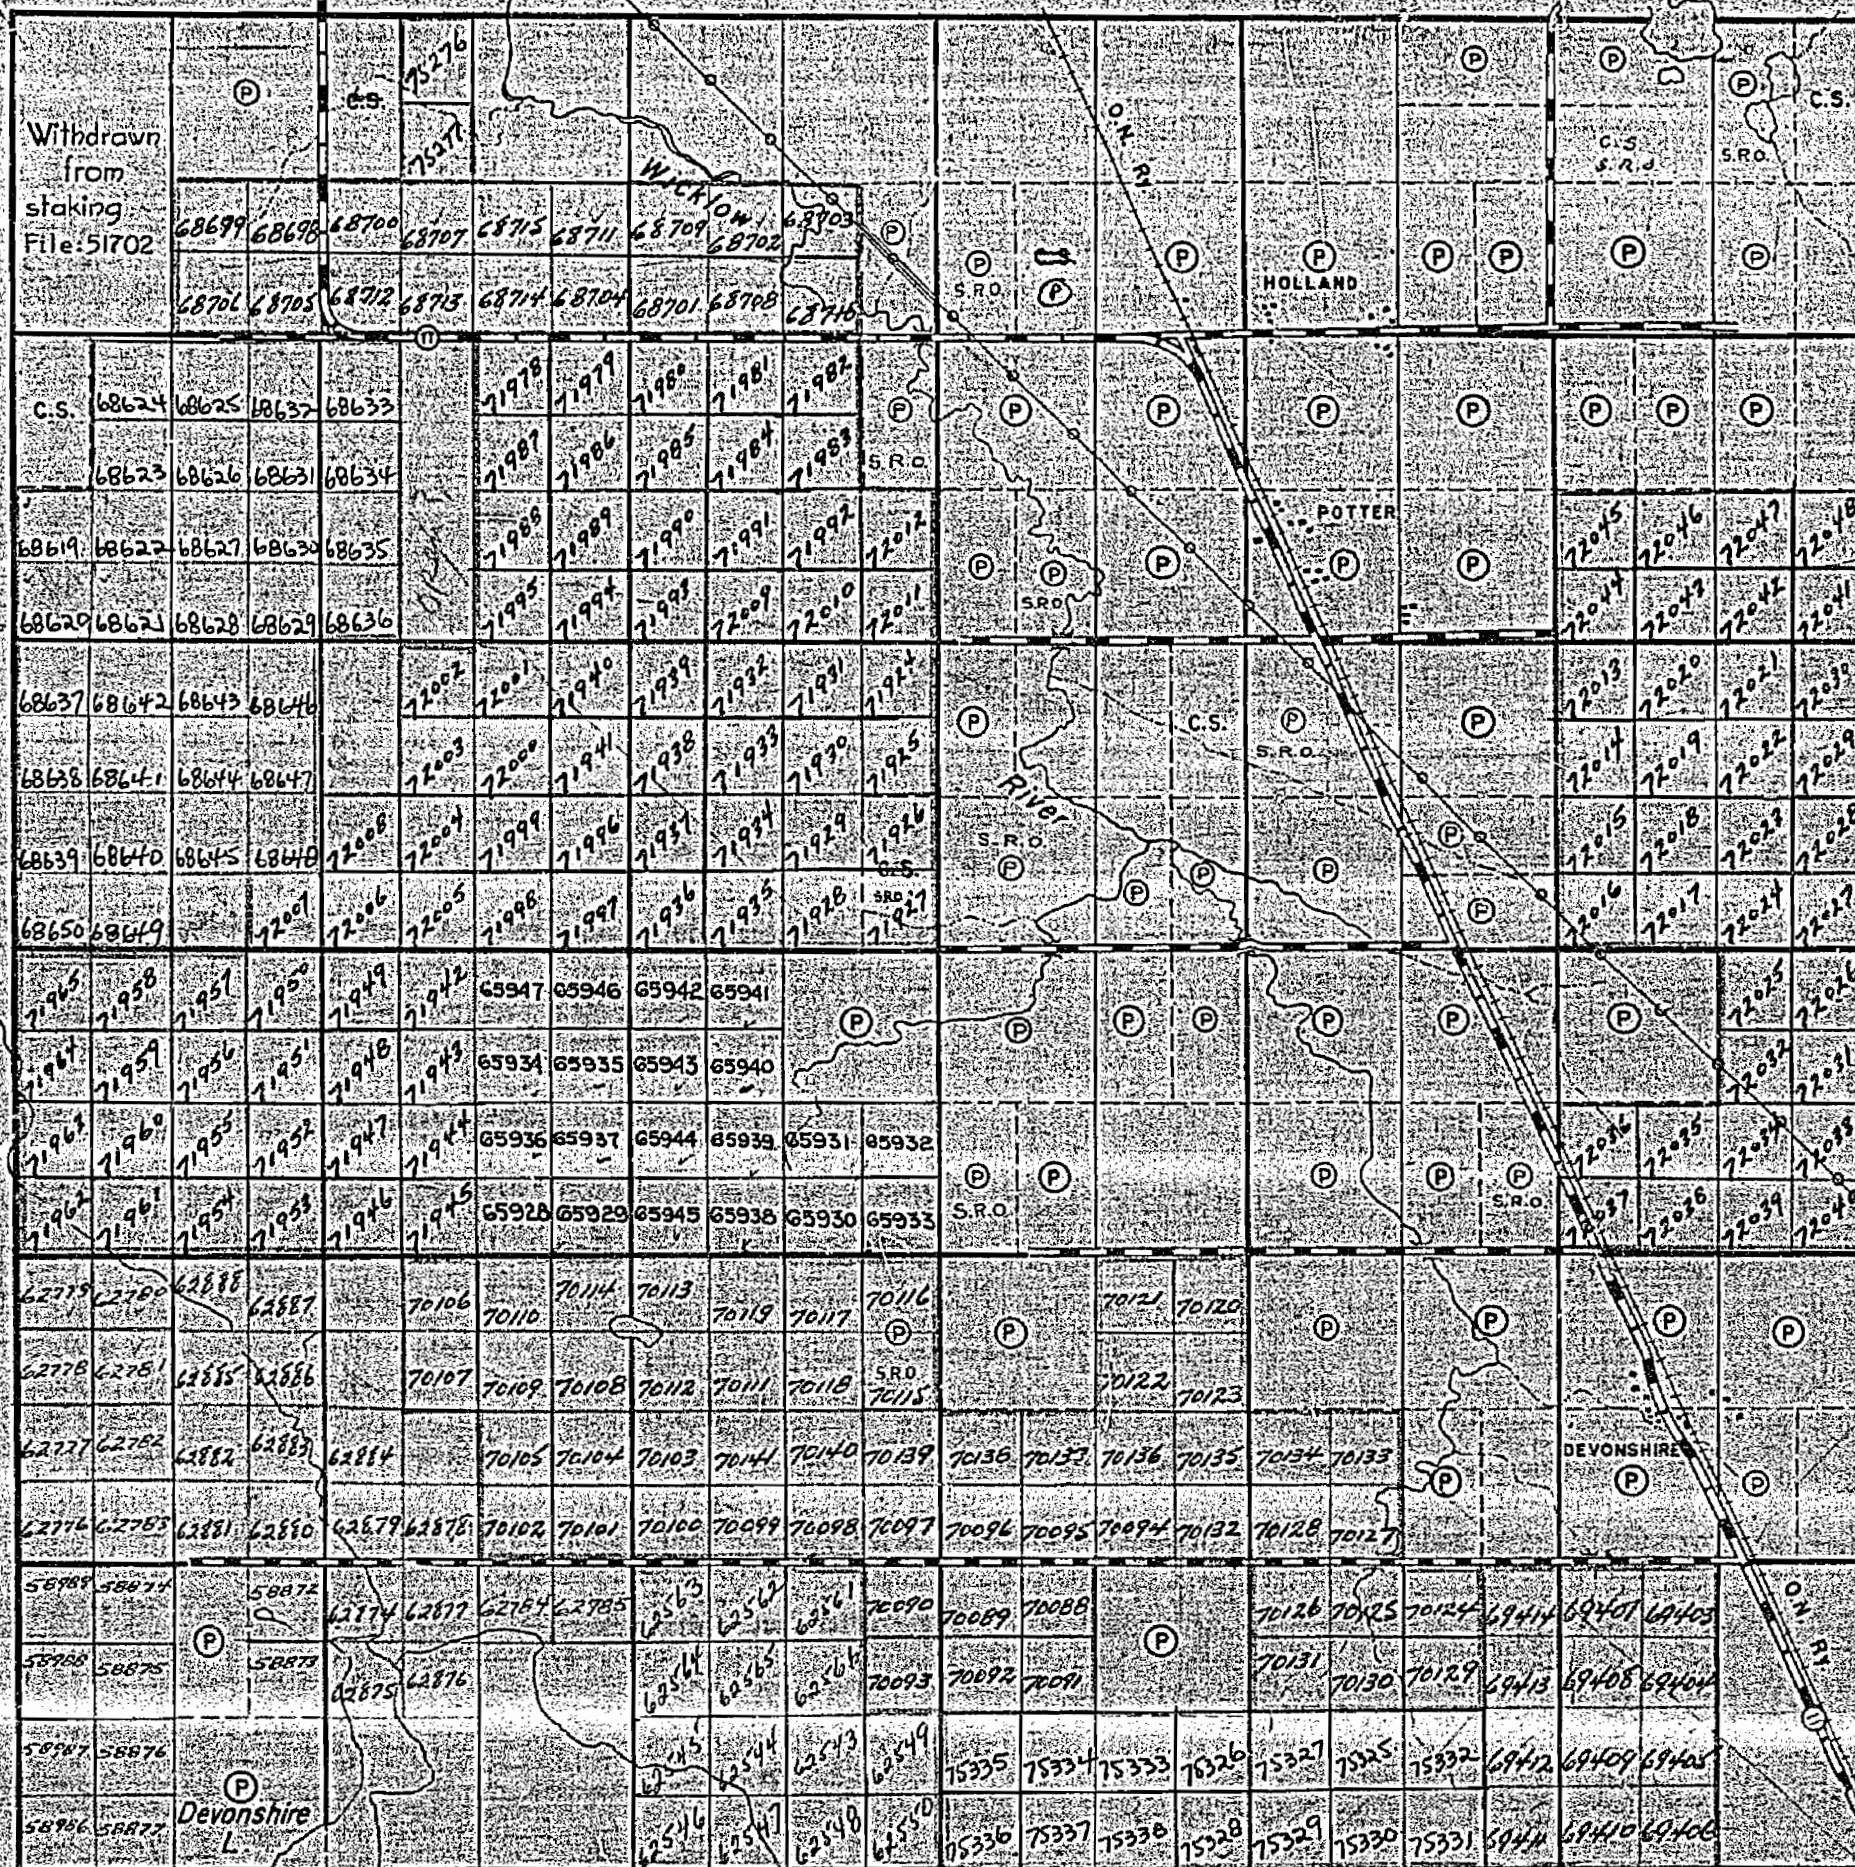

Mc Cart Twp.

MRO

VI

V

IV

III


II

I

Aurora Twp.

Proposed
Alders

St. John Twp.

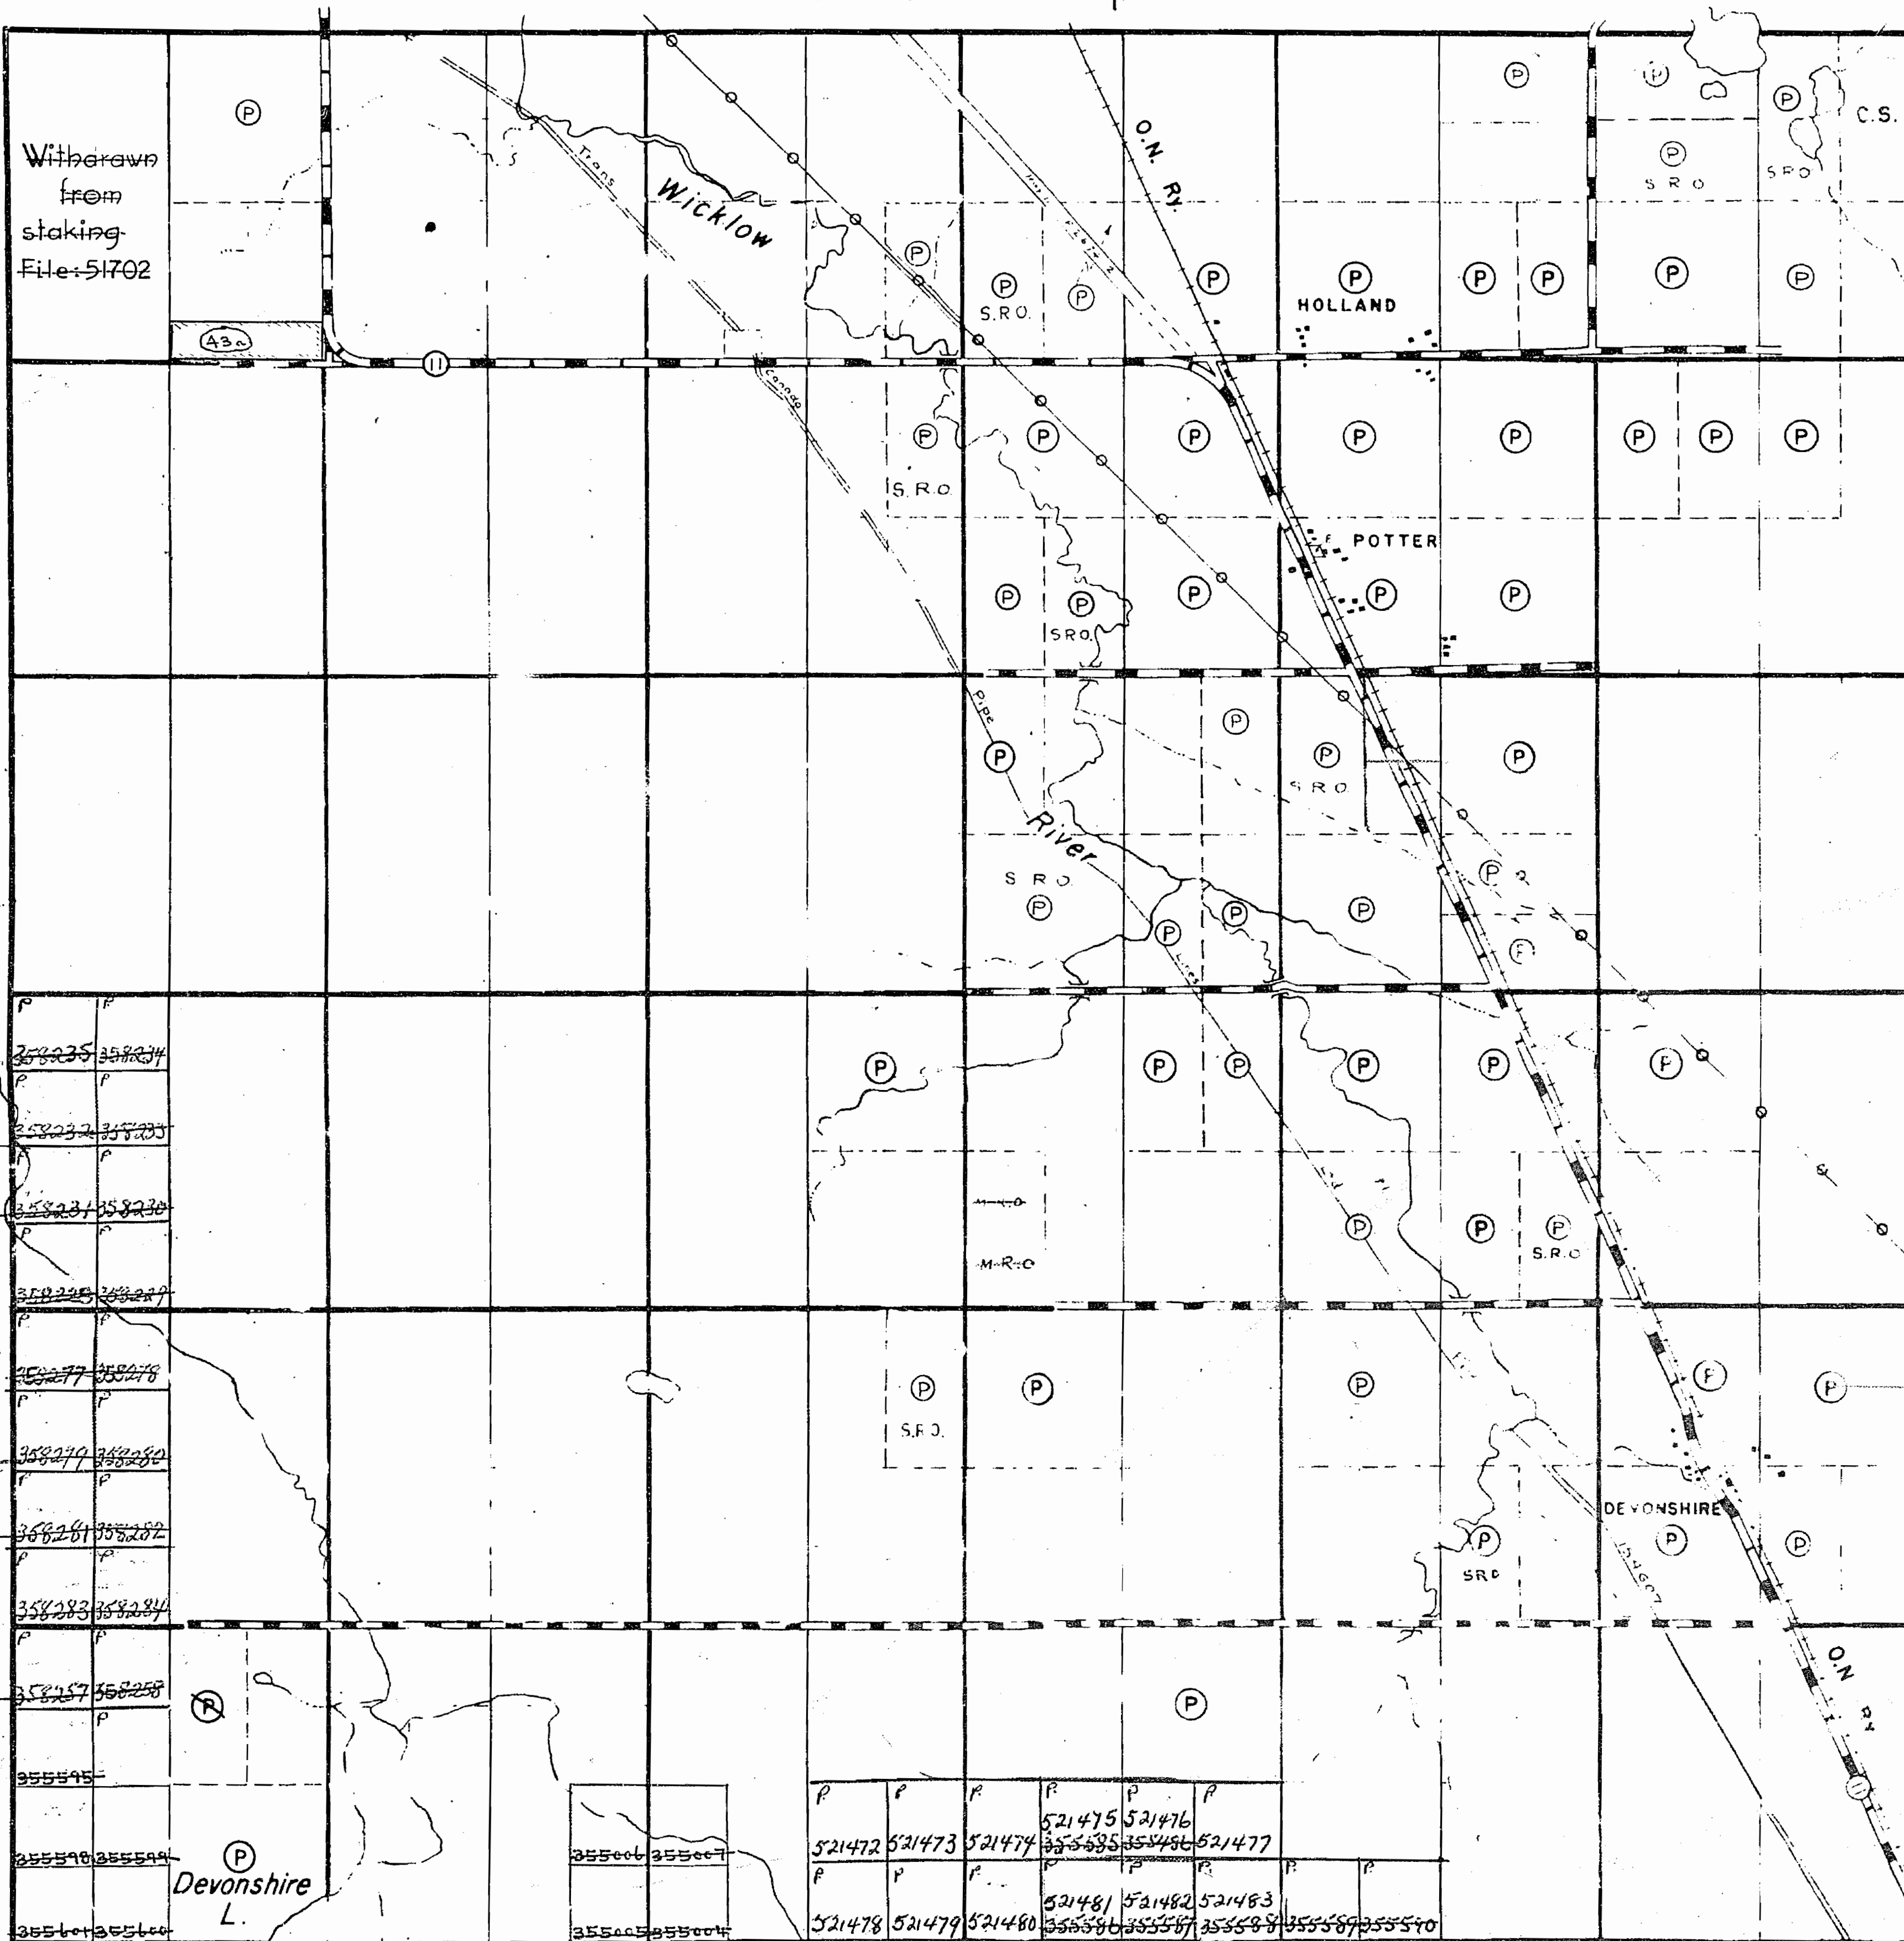

Mann Twp.

VI

V

IV

III

II

I

Aurora Twp.


THE TOWNSHIP OF OF NEWMARKET

DISTRICT OF
COCHRANE
PORCUPINE
MINING DIVISION

SCALE 1-INCH = 40 CHAINS

LEGEND


PATENTED LAND
CROWN LAND SALE
LEASES
LOCATED LAND
LICENSE OF OCCUPATION
ROADS
IMPROVED ROADS
RAILWAYS
POWER LINES
MARSH OR MUSKEG

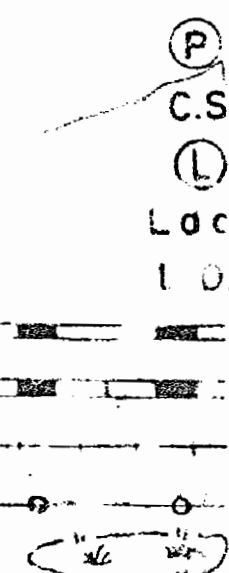

NOTES

M.R.O. Mineral Rights Only


43a S.R.O. withdrawn Aug. 16/79
Waste disposal site.
400' Surface Rights Reservation around
all Lakes and Rivers

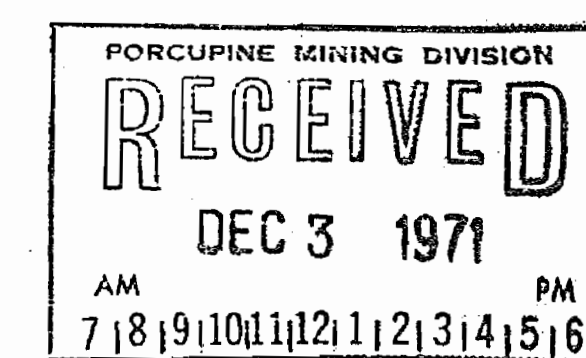

PLAN NO M-557

ONTARIO
DEPARTMENT OF MINES
AND NORTHERN AFFAIRS

St. John Twp.

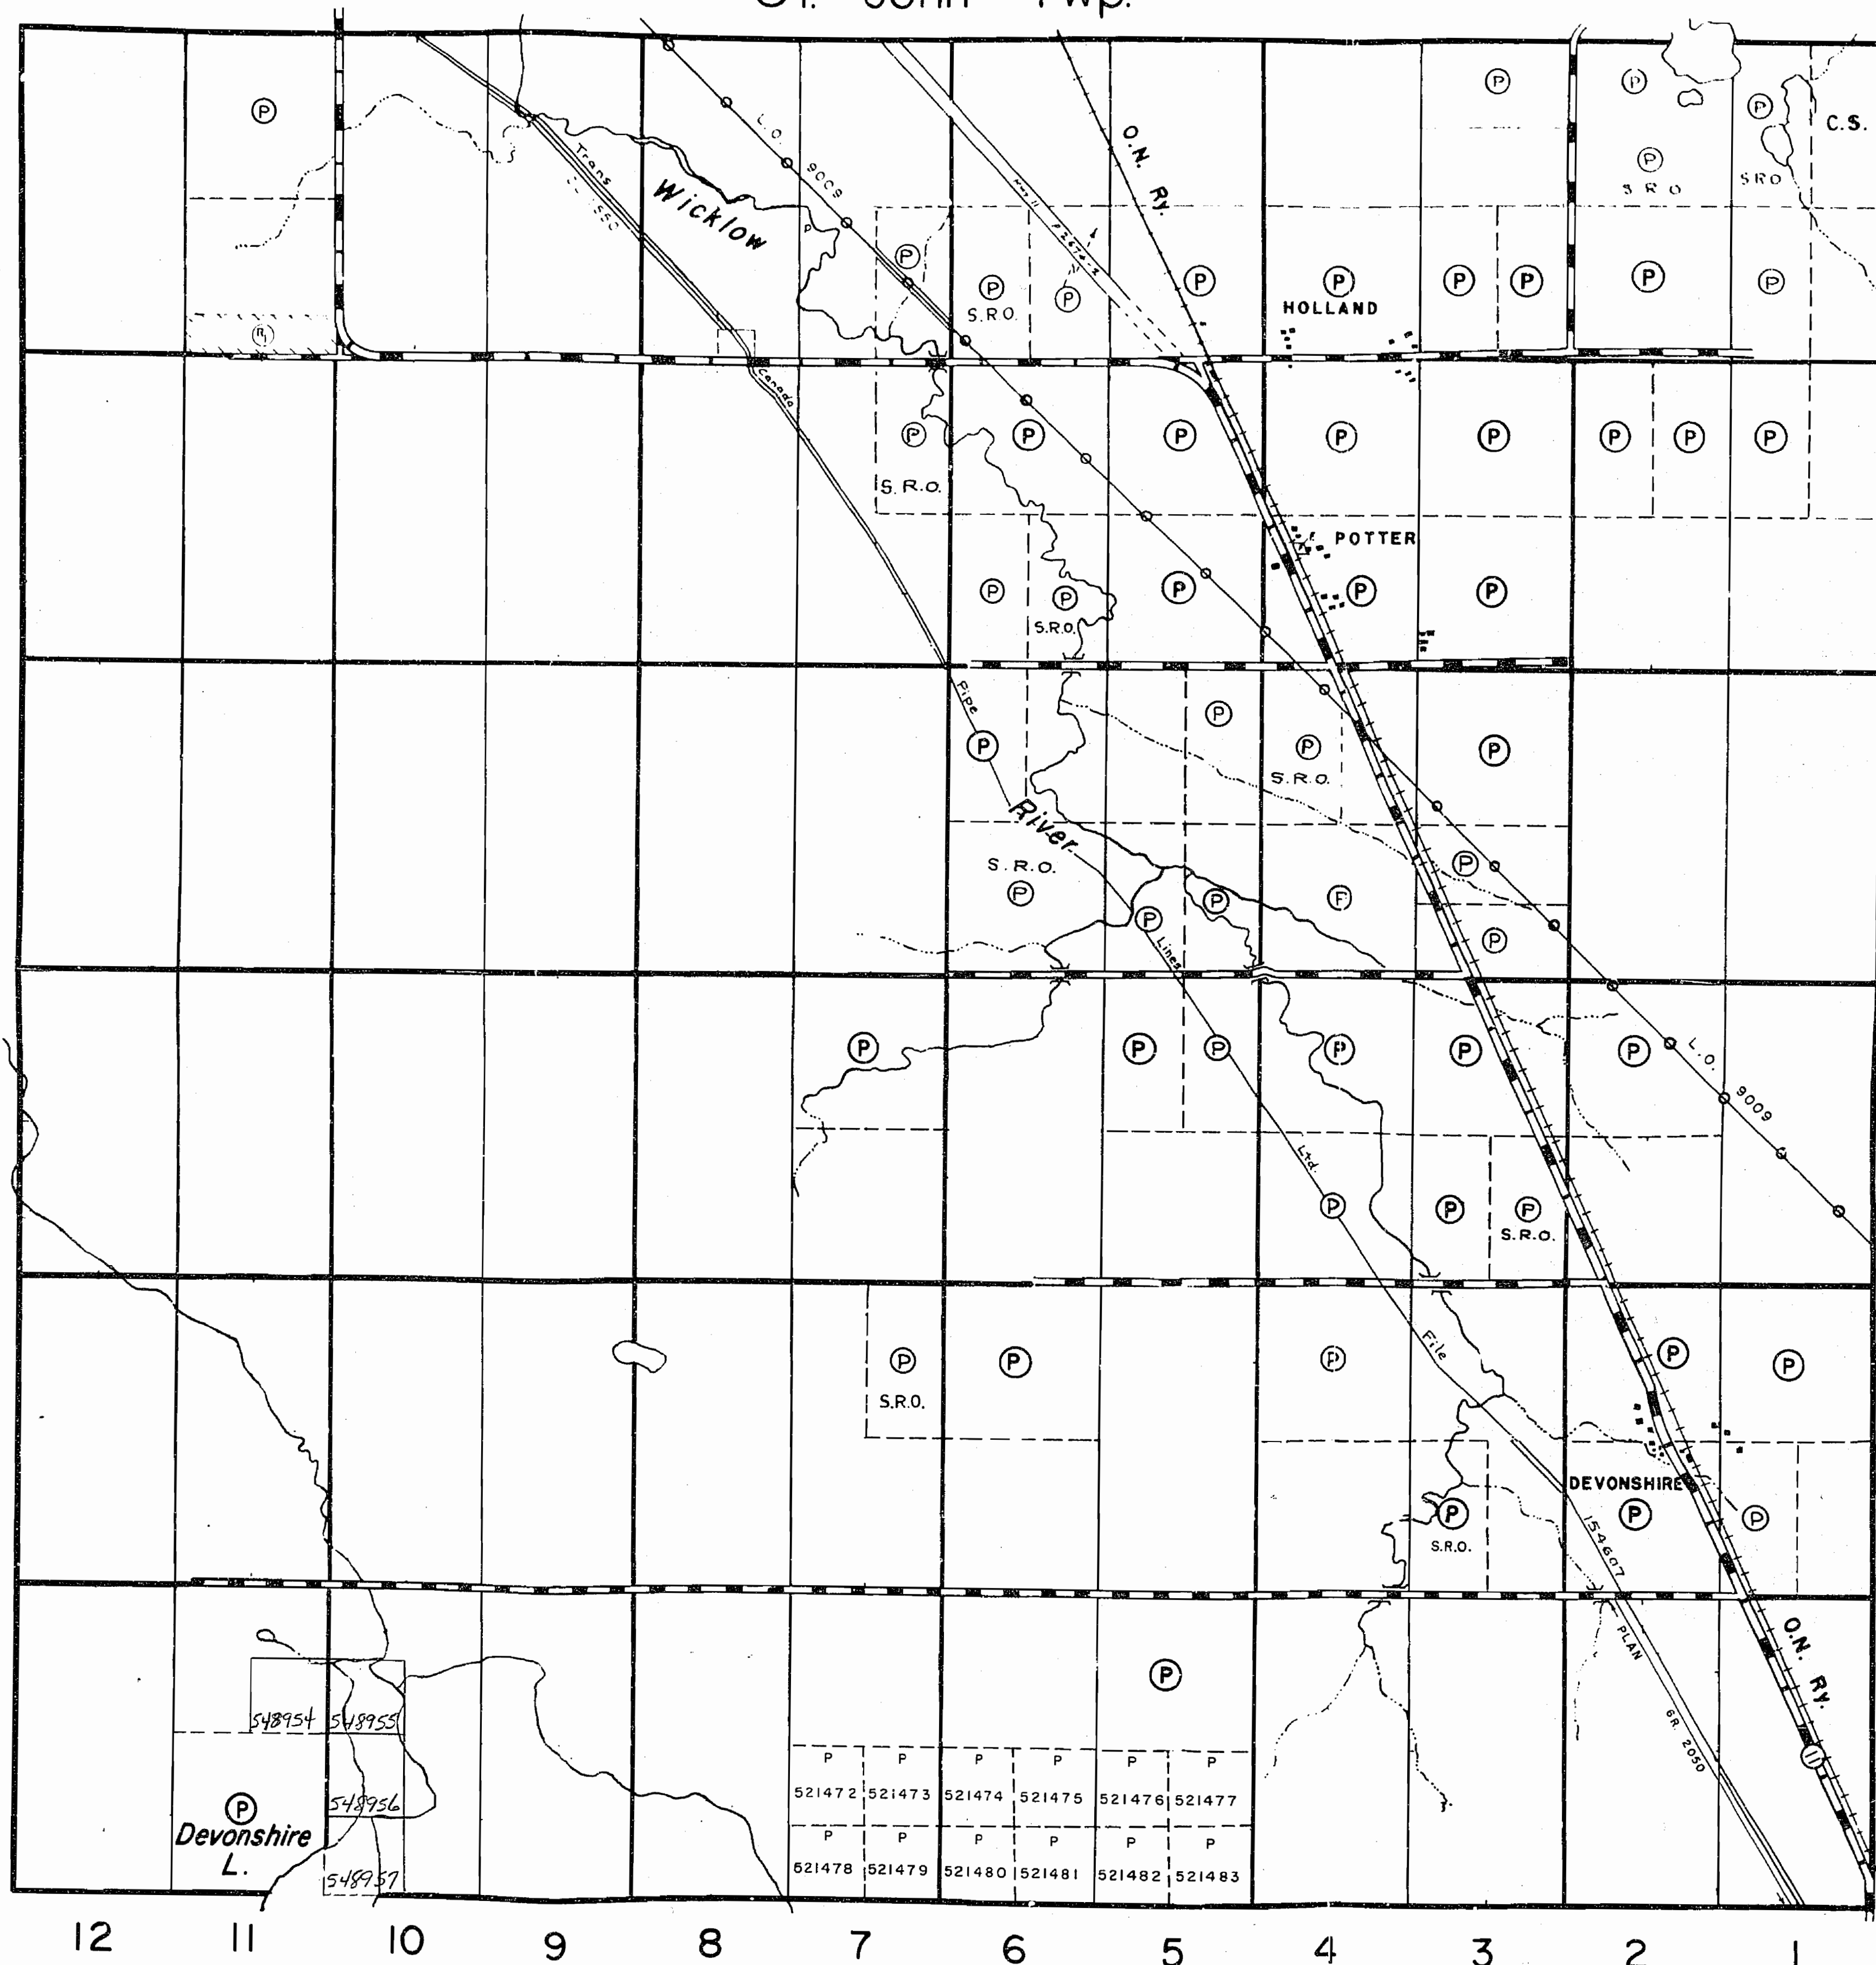

THE TOWNSHIP OF OF NEWMARKET

DISTRICT OF
COCHRANE

PORCUPINE
MINING DIVISION

SCALE: 1-INCH= 40 CHAINS

LEGEND

PATENTED LAND	(P)
CROWN LAND SALE	C.S.
LEASES	(L)
LOCATED LAND	Loc.
LICENSE OF OCCUPATION	L.O.
ROADS	—
IMPROVED ROADS	- - -
RAILWAYS	+ + +
POWER LINES	o o o
MARSH OR MUSKEG	wavy line

NOTES

M.R.O. : Mineral Rights Only

Areas withdrawn from staking under Section
43 of the Mining Act (R.S.O. 1970).

Order No.	File	Date	Disposition
W. 43/79 NR.	33749	16/8/79	S.R.O. Dump

400' Surface Rights Reservation around
all Lakes and Rivers.

John M. M.

Received Oct. 15/79

PLAN NO. - M-557

ONTARIO
MINISTRY OF NATURAL RESOURCES
SURVEYS AND MAPPING BRANCH

Mc Cart Twp.

Mann Twp.

VI

V

IV

III

II


I

Aurora Twp.

100

Mc Cart Twp.

Mann Twp.

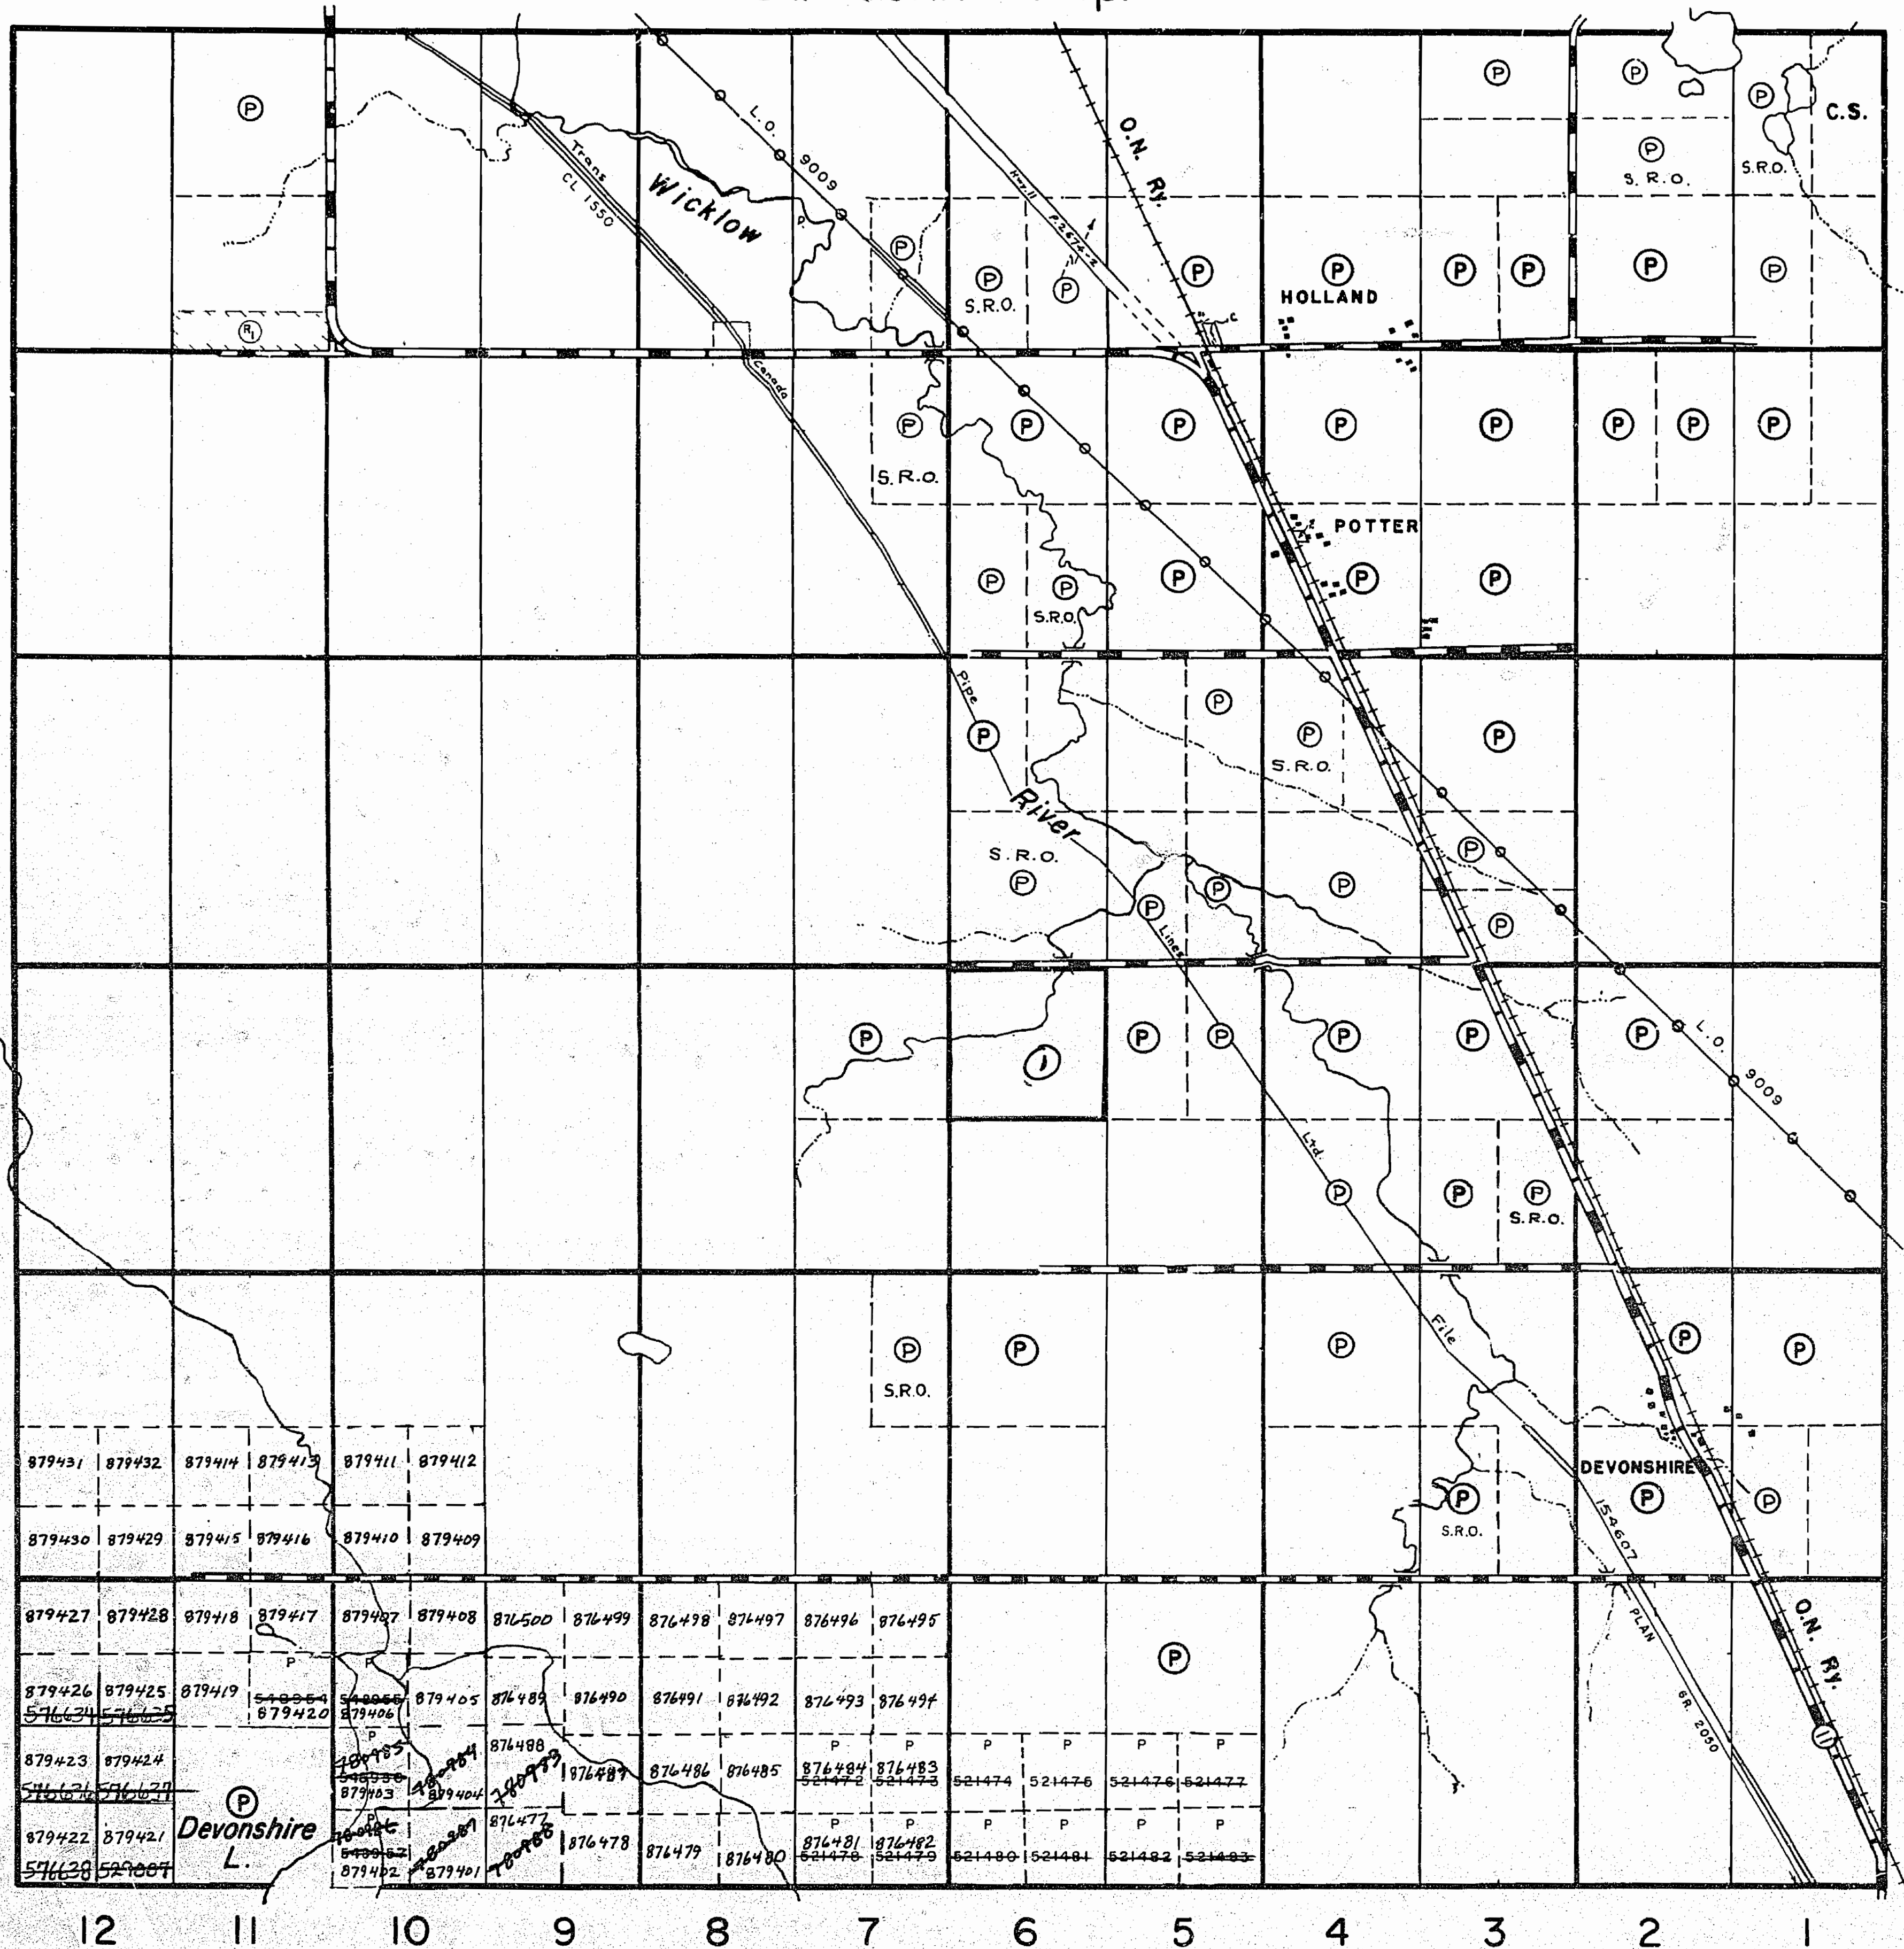


THE TOWNSHIP
OF
NEWMARKET

DISTRICT OF
COCHRANE

PORCUPINE
MINING DIVISION

SCALE: 1-INCH= 40 CHAINS

LEGEND

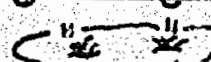PATENTED LAND	(P)
CROWN LAND SALE	C.S.
LEASES	(L)
LOCATED LAND	Loc.
LICENSE OF OCCUPATION	L.O.
ROADS	
IMPROVED ROADS	
RAILWAYS	
POWER LINES	
MARSH OR MUSKEG	

NOTES

M.R.O. : Mineral Rights Only

Areas withdrawn from staking under Section 43 of the Mining Act (R.S.O. 1970).

Order No.	File	Date	Disposition
(R) W. 43/79 NR.	33749	16/8/79	S.R.O.
① Bone Fide Appl.			

400' Surface Rights Reservation around
all Lakes and Rivers.

Removed from active date
Oct 18/87. JF.

Received May 8/80

PLAN N^o. - M-557

ONTARIO
MINISTRY OF NATURAL RESOURCES


SURVEYS AND MAPPING BRANCH

M.R.O. — MINING RIGHTS ONLY
S.R.O. — SURFACE RIGHTS ONLY
M. + S. — MINING AND SURFACE RIGHTS

Description	Order No.	Date	Disposition	File
(A)	W. 43/79 NR.	16/8/79	S.R.O.	33749

Surface Rights Withdrawn under Sec. 36,
The Mining Act R.S.O. 1980, ORDER NO. W-CI/91/ONT
(Traverse Pipeline Right of Way and Euffer
Zone particularly 40.25 meters or 132 ft. on
either side of centre line of right of way)

MANN TOWNSHIP

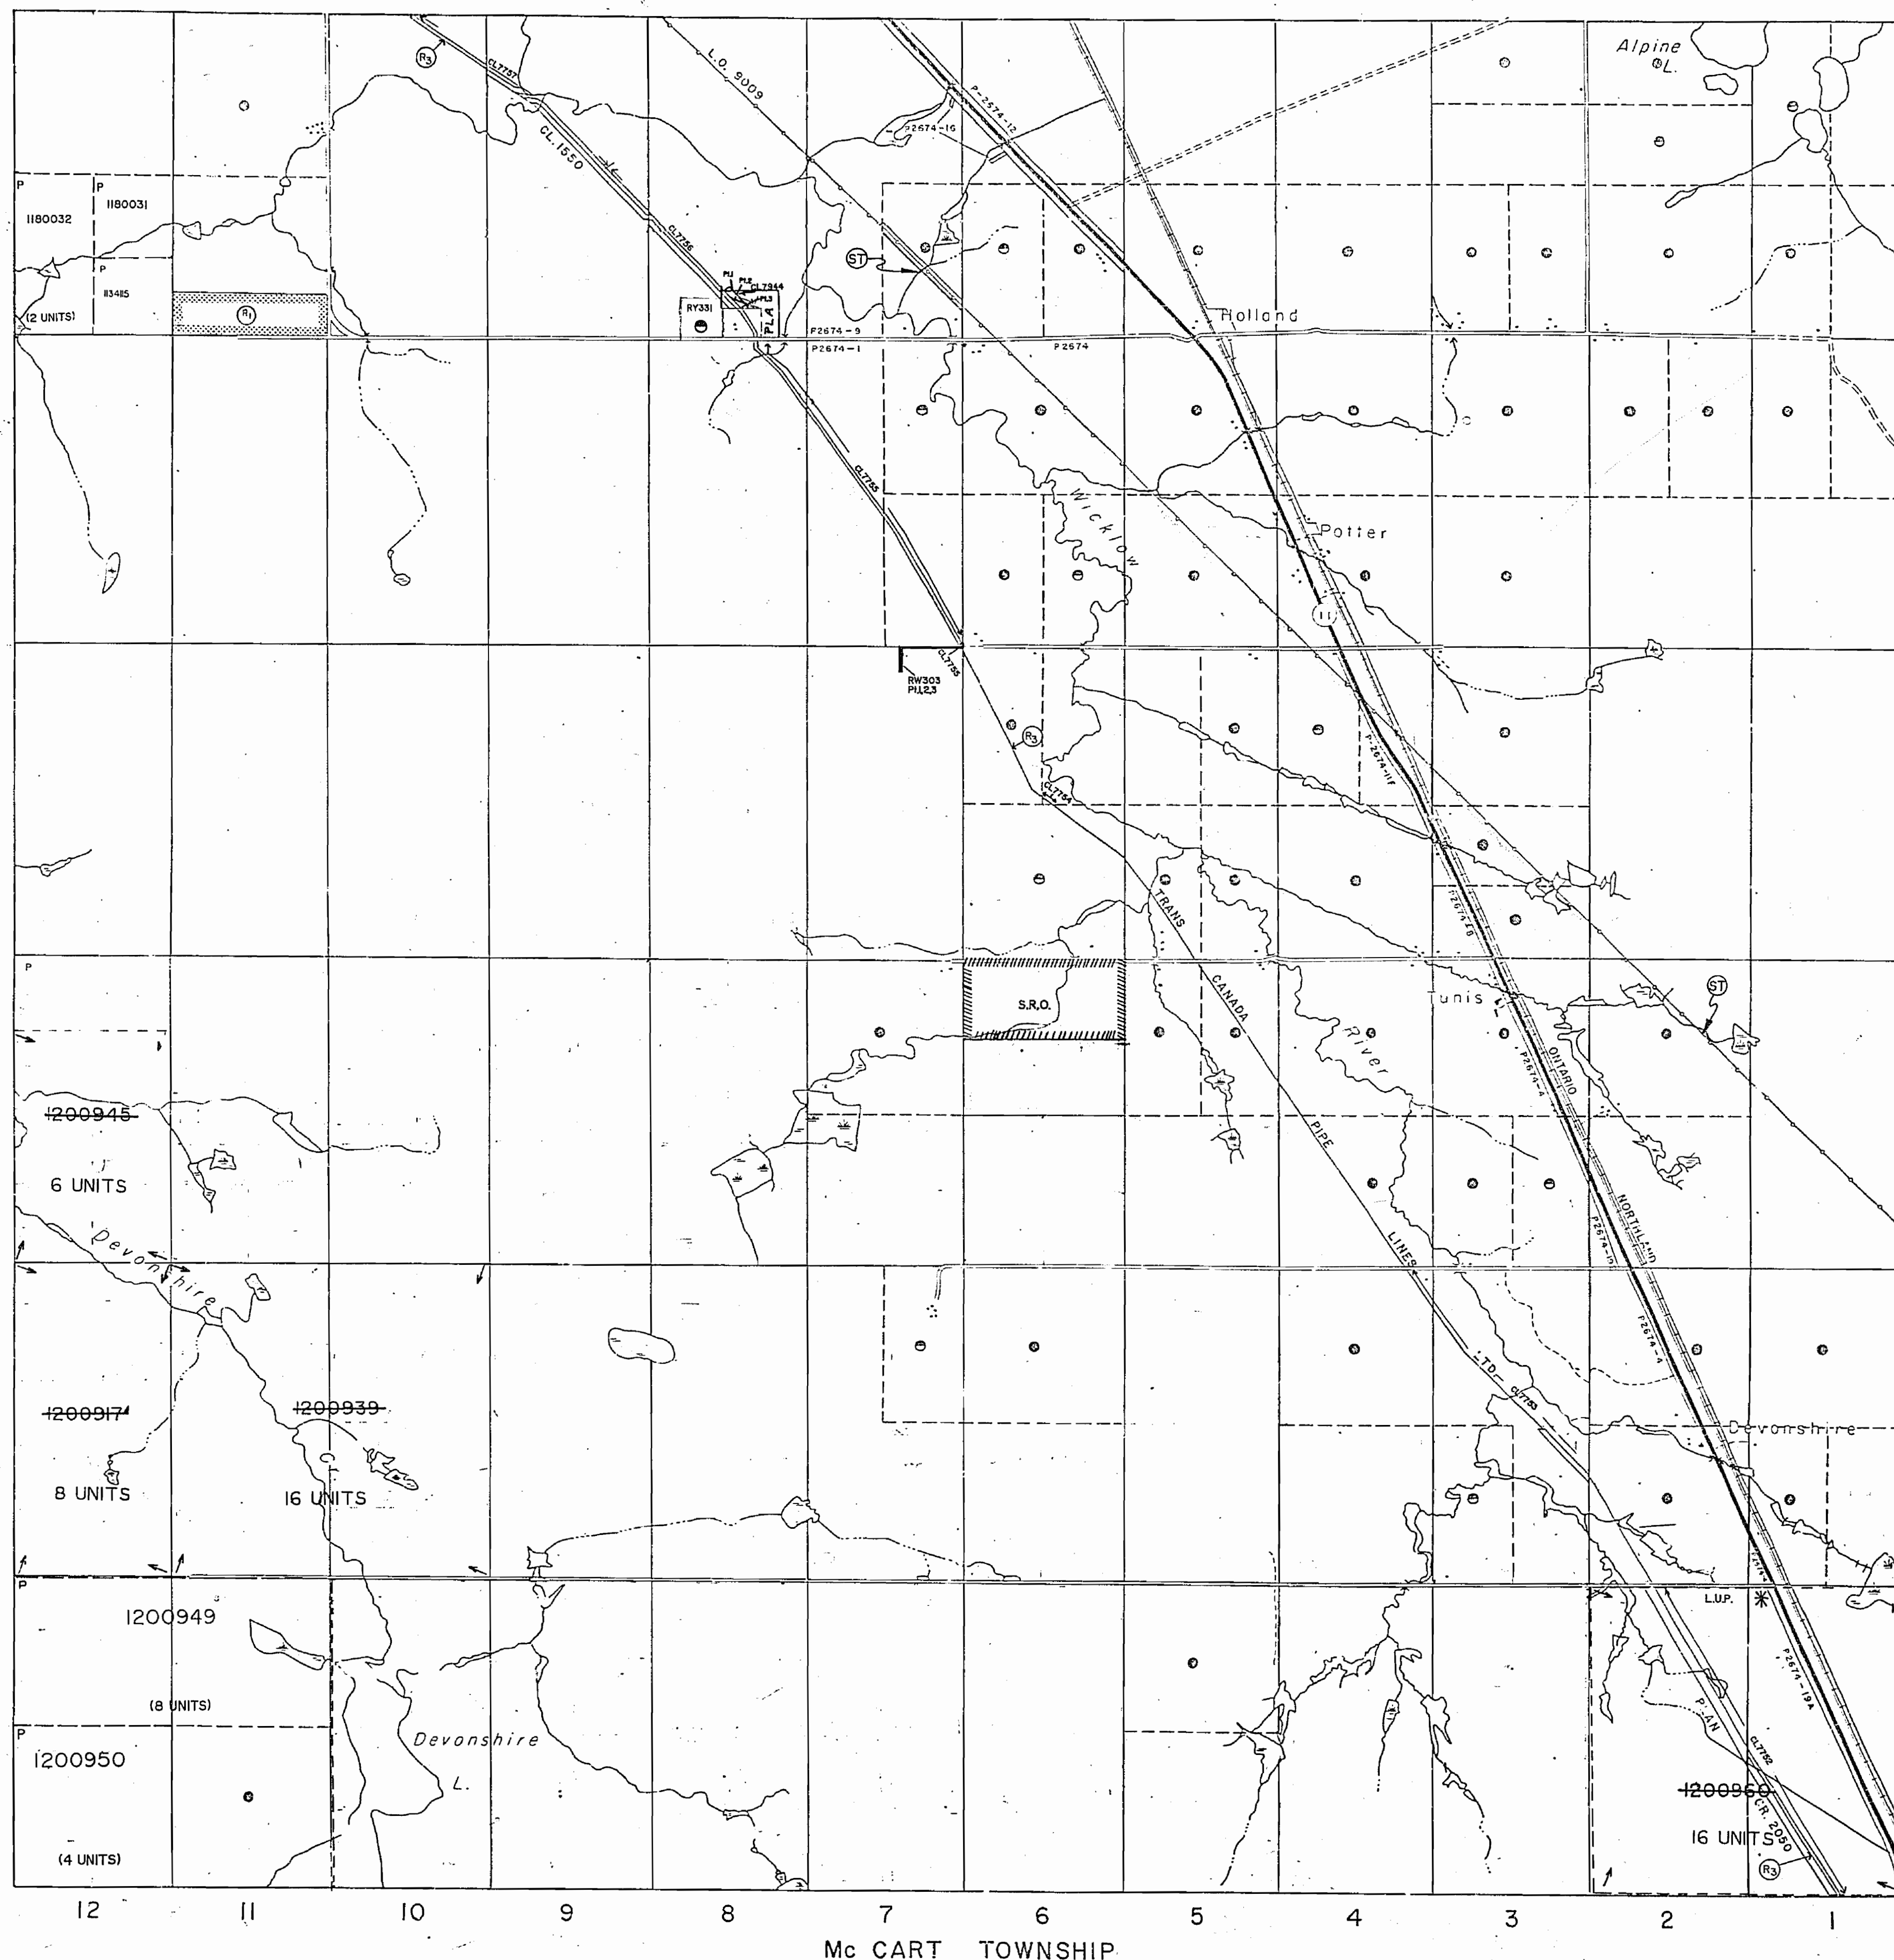

THE INFORMATION THAT APPEARS ON THIS MAP HAS BEEN COMPILED FROM VARIOUS SOURCES, AND ACCURACY IS NOT GUARANTEED. THOSE WISHING TO STATE MINING CLAIMS SHOULD CONSULT WITH THE MINING RECORDER, MINISTRY OF NORTHERN DEVELOPMENT AND MINES, FOR ADDITIONAL INFORMATION ON THE STATUS OF THE LANDS SHOWN HEREON.

HIGHWAY AND ROUTE No.

OTHER ROADS

TRAILS

SURVEYED LINES

TOWNSHIPS, BASE LINES, ETC.

LOTS, MINING CLAIMS, PARCELS, ETC.

UNSURVEYED LINES

LOT LINES

PARCEL BOUNDARY

MINING CLAIMS ETC.

RAILWAY AND RIGHT OF WAY

UTILITY LINES

NON PERENNIAL STREAM

FLOODING OR FLOODING RIGHTS

SUBDIVISION OR COMPOSITE PLAN

RESERVATIONS

ORIGINAL SHORELINE

MARSH OR MUSKIE

MINES

TRAVERSE MONUMENT

<u>TYPE OF DOCUMENT</u>	<u>SYMBOL</u>
PATENT, SURFACE & MINING RIGHTS	Ⓢ
" SURFACE RIGHTS ONLY	Ⓢ
" MINING RIGHTS ONLY	Ⓢ
LEASE, SURFACE & MINING RIGHTS	Ⓢ
" SURFACE RIGHTS ONLY	Ⓢ
" MINING RIGHTS ONLY	Ⓢ
LICENCE OF OCCUPATION	Ⓢ
ORDER IN COUNCIL	Ⓢ
RESERVATION	Ⓢ
CANCELLED	Ⓢ
SAND & GRAVEL	Ⓢ
LUP (LAND USE PERMIT)	Ⓢ

NOTE: MINING RIGHTS IN ORIGINALS PATENTED PRIOR TO MAY 1, 1913, VESTED IN PERSONAL PATENTEE BY THE MINING ACT, R.S.O. 1970, CHAP. 380, SEC. 43, SUSPENSE

Three horizontal measurement scales are shown, each with a ruler-like appearance and numerical markings. The top scale is labeled 'Metres' and ranges from 0 to 1000, with major markings every 100 units. The middle scale is labeled 'Chains' and ranges from 0 to 70, with major markings every 10 units. The bottom scale is labeled 'Feet' and ranges from 0 to 5000, with major markings every 1000 units.

SCALE 1:20 000

R₂-AGRICULTURAL PERMIT

ST SNOWMOBILE TRAIL
NOTICE RECEIVED 92-DEC-09

TOWNSHIP

NEWMARKET


M.N.R. ADMINISTRATIVE DISTRICT

COCHRANE

MINING DIVISION

PORCUPINE

LAND TITLES / REGISTRY DIVISION
COCHRANE

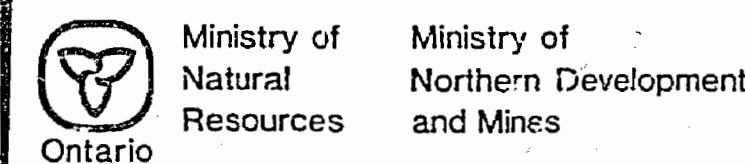

Date SEPTEMBER 1986

checked L.N. Nov. 20/87
2B 1B 1A/87


Number
G-3548

557

St. John Twp.

Mann Twp.

Mc Cart Twp.

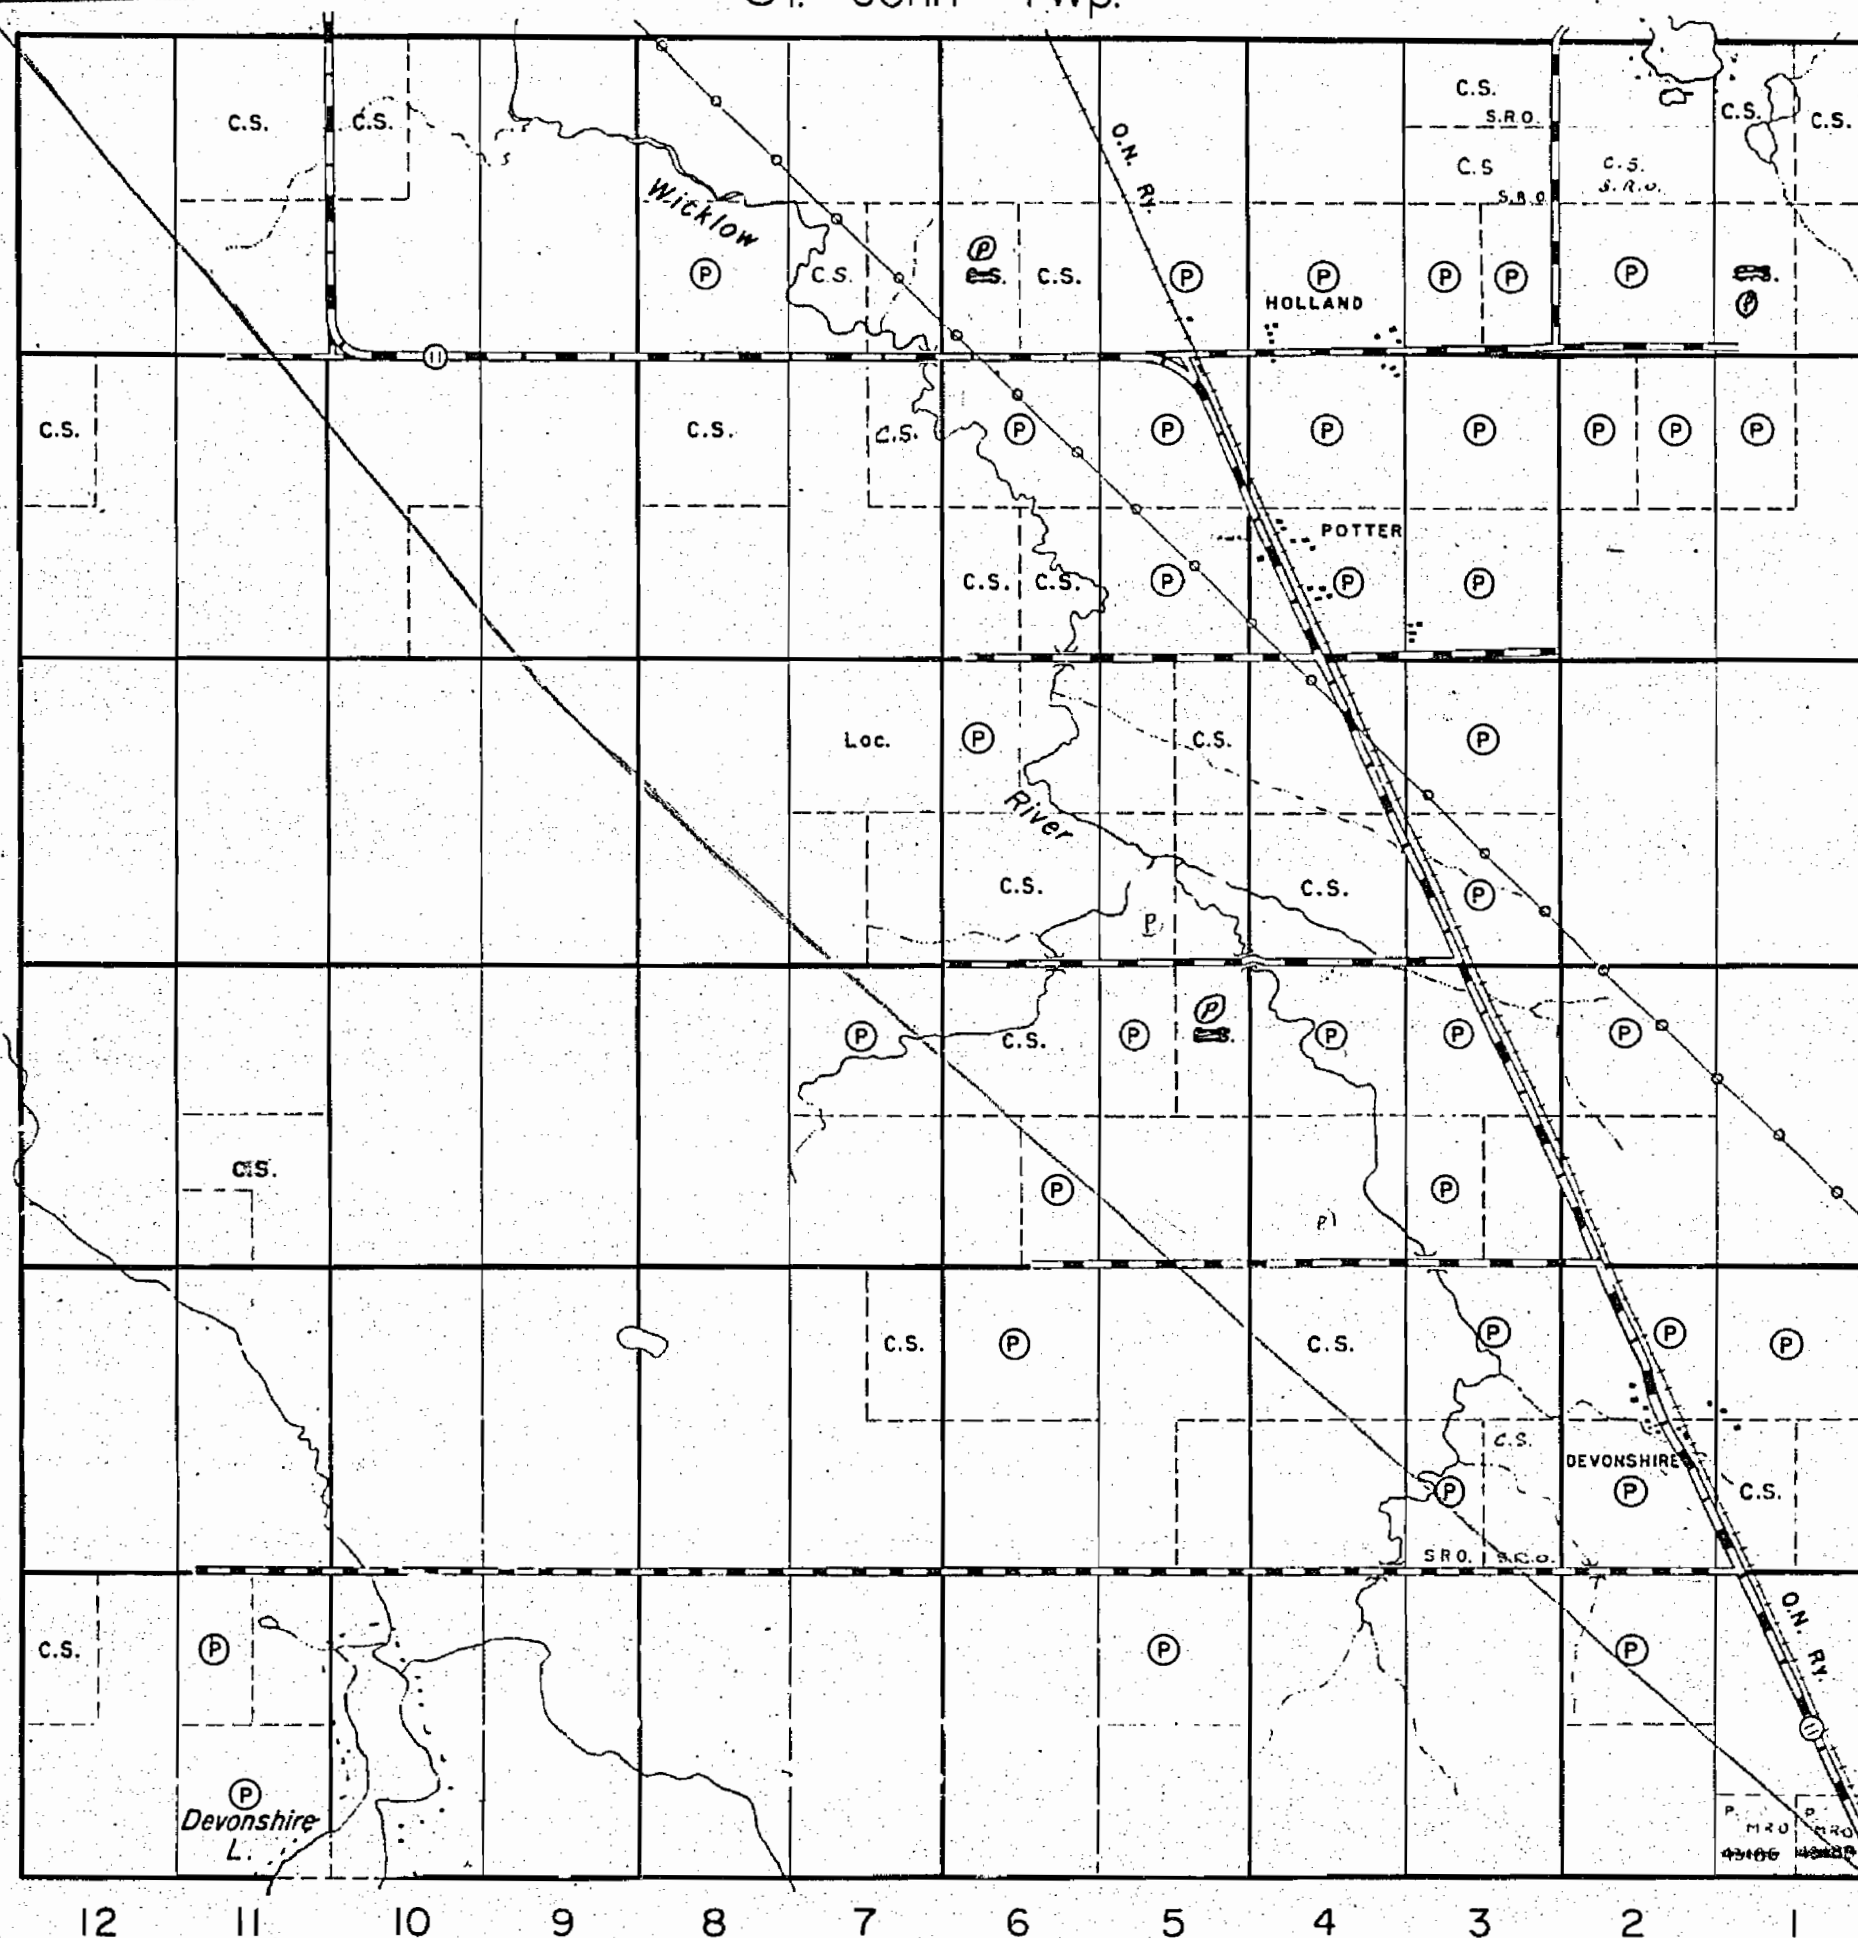

THE TOWNSHIP OF NEWMARKET

DISTRICT OF
COCHRANEPORCUPINE
MINING DIVISION

SCALE: 1-INCH = 40 CHAINS

LEGEND

PATENTED LAND	(P)
CROWN LAND SALE	C.S.
LEASES	(L)
LOCATED LAND	Loc.
LICENSE OF OCCUPATION	L.O.
ROADS	—
IMPROVED ROADS	—
RAILWAYS	—
POWER LINES	—
MARSH OR MUSKEG	—

NOTES

M.R.O. : Mineral Rights Only

Surface rights reserved on all lands staked
B patented after 21 May 1945 — See O.C.
25 April 1945:

By regulations passed previously, sale or
other disposition of land in this Township
has been limited to S.R.O. only: effective
May 2, 1950.

400' Rsvd. to Jcp. 9-1-1-F.
shown for

Proposed
Natural Gas
Line


PLAN NO. - M-557

DEPARTMENT OF MINES
— ONTARIO —

557

St. John Twp.

Mann Twp.

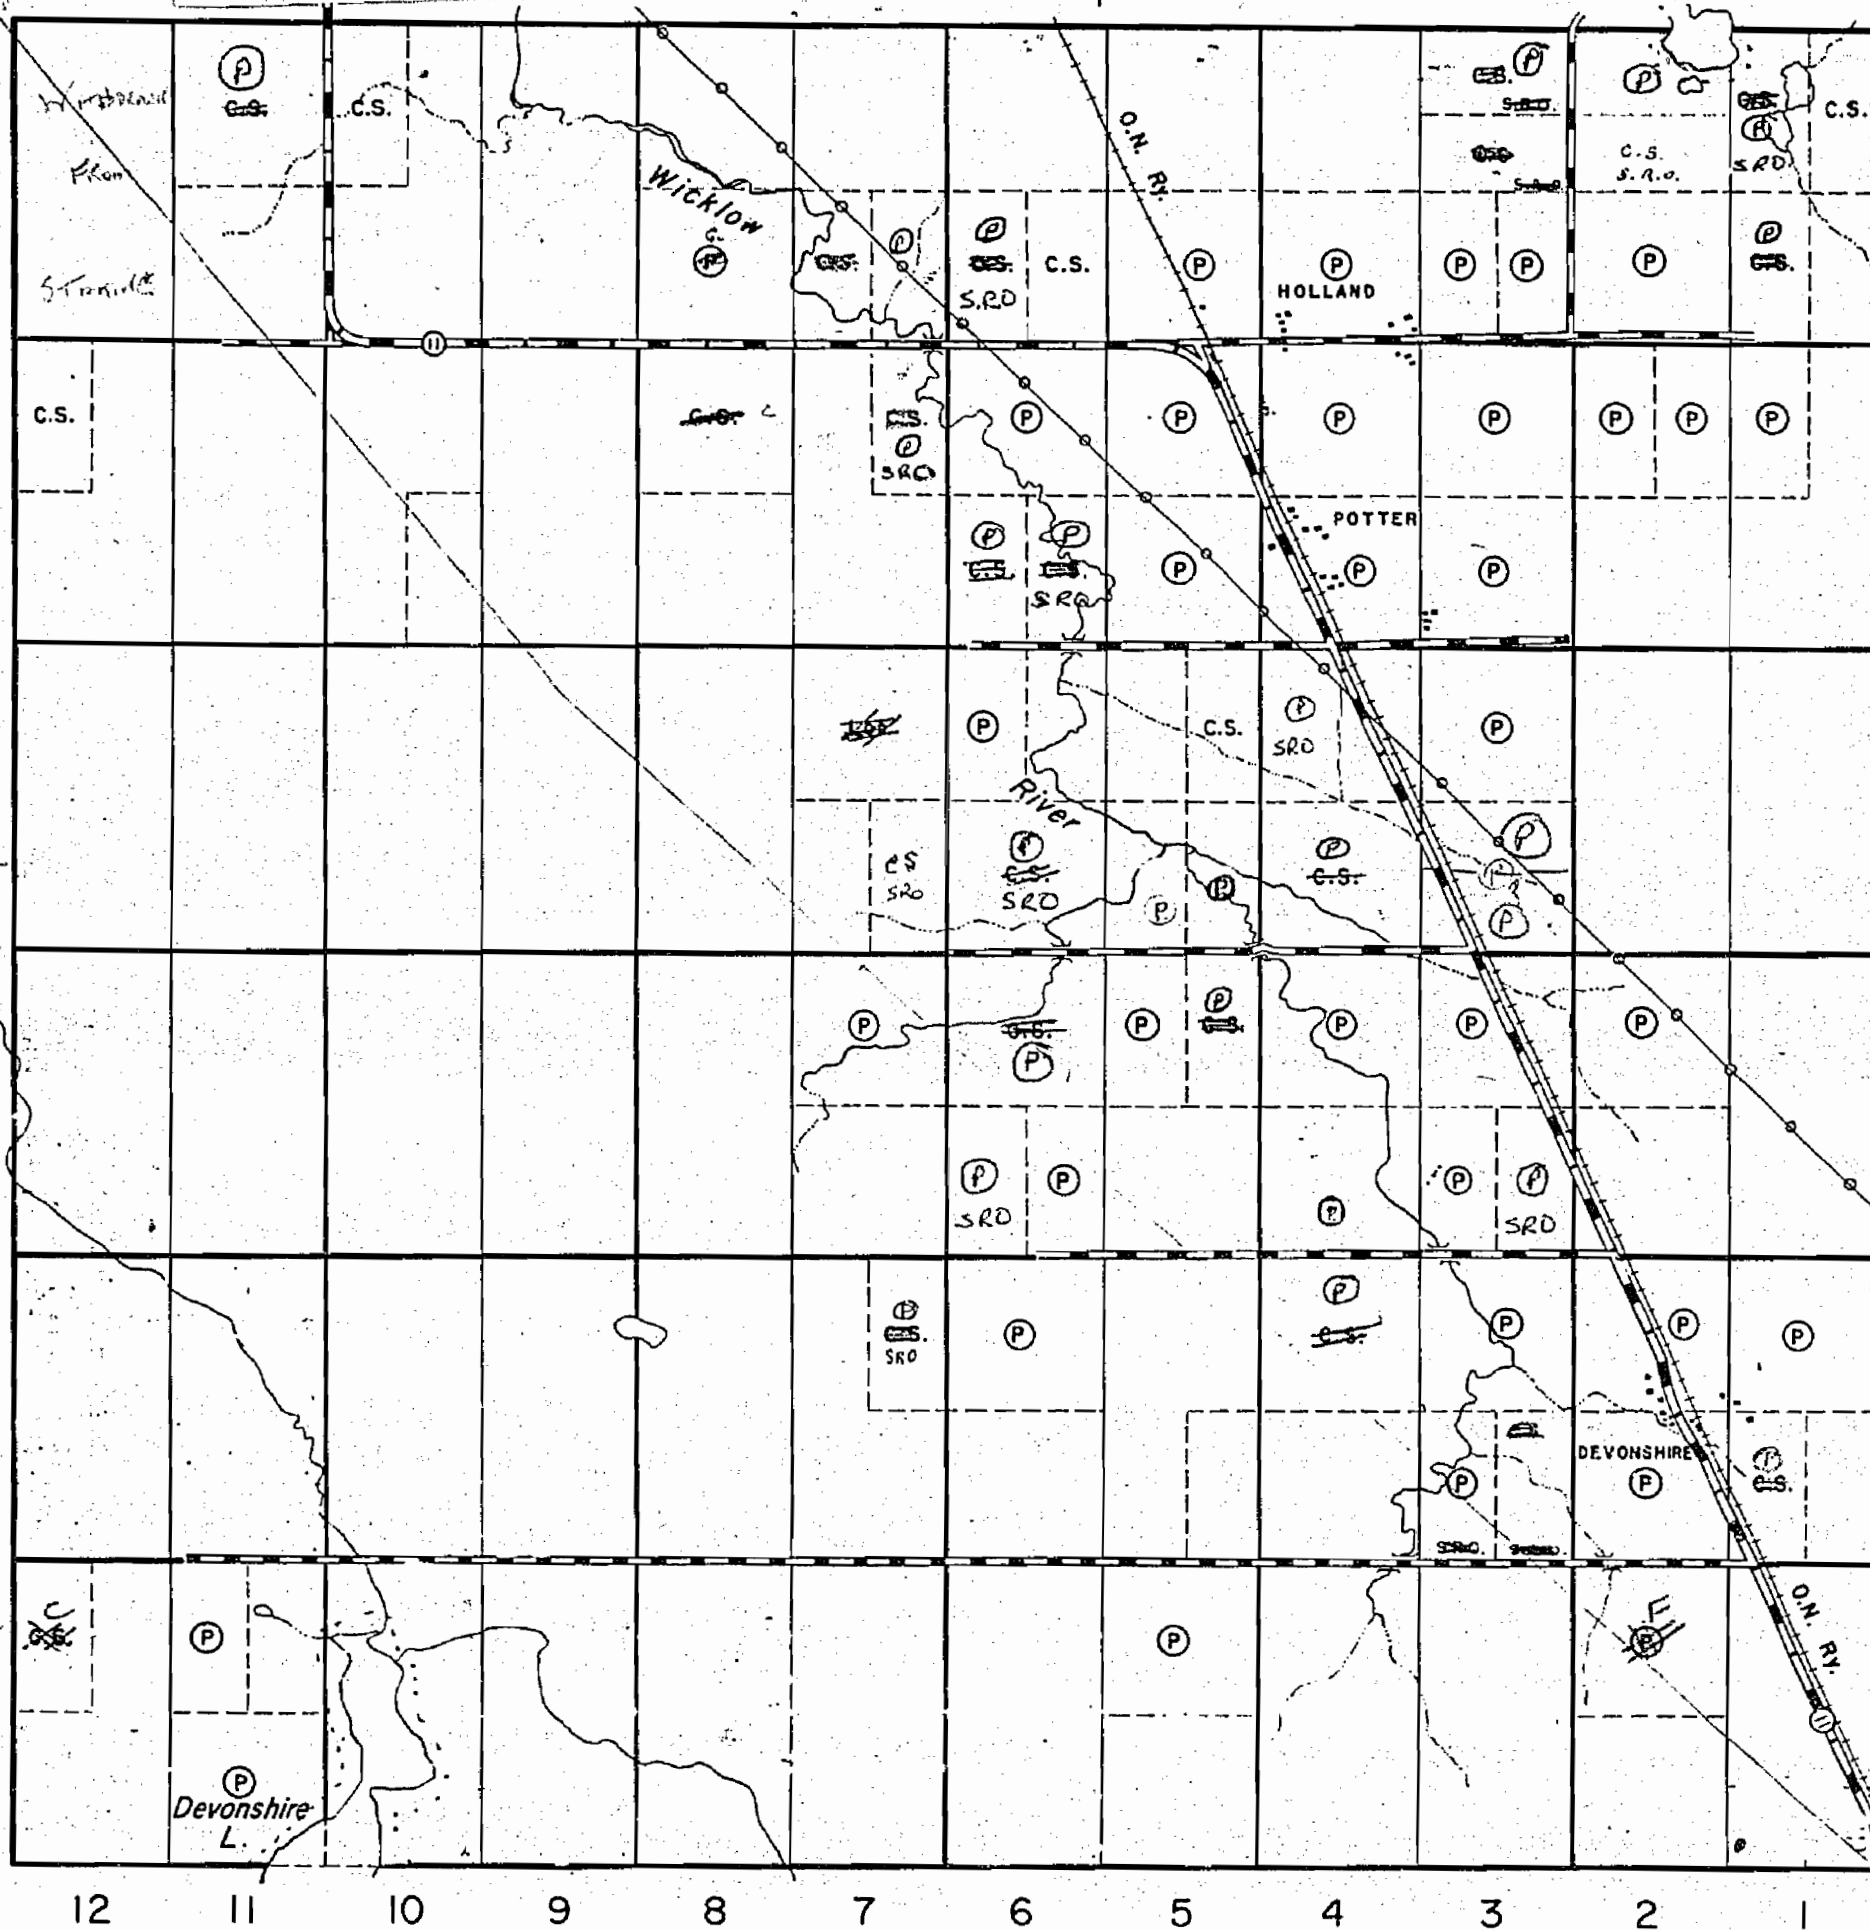

Mc Cart Twp.

THE TOWNSHIP
OF
NEWMARKET

DISTRICT OF
COCHRANEPORCUPINE
MINING DIVISION

SCALE: 1-INCH = 40 CHAINS

LEGEND

PATENTED LAND	(P)
CROWN LAND SALE	C.S.
LEASES	(L)
LOCATED LAND	Loc.
LICENSE OF OCCUPATION	L.O.
ROADS	—
IMPROVED ROADS	—
RAILWAYS	—
POWER LINES	—
MARSH OR MUSKEG	—

NOTES

M.R.O. : Mineral Rights Only

Surface rights reserved on all lands staked
& patented after 21 May 1945 — See O.C.
25 April 1945:

By regulations passed previously, sale or
other disposition of land in this Township
has been limited to S.R.O. only: effective
May 2, 1950.


400' Rsvd. to Deps. of L. & F.
known as: —

PLAN NO. - M-557

DEPARTMENT OF MINES
— ONTARIO —

St. John Twp.

Marr Twp.

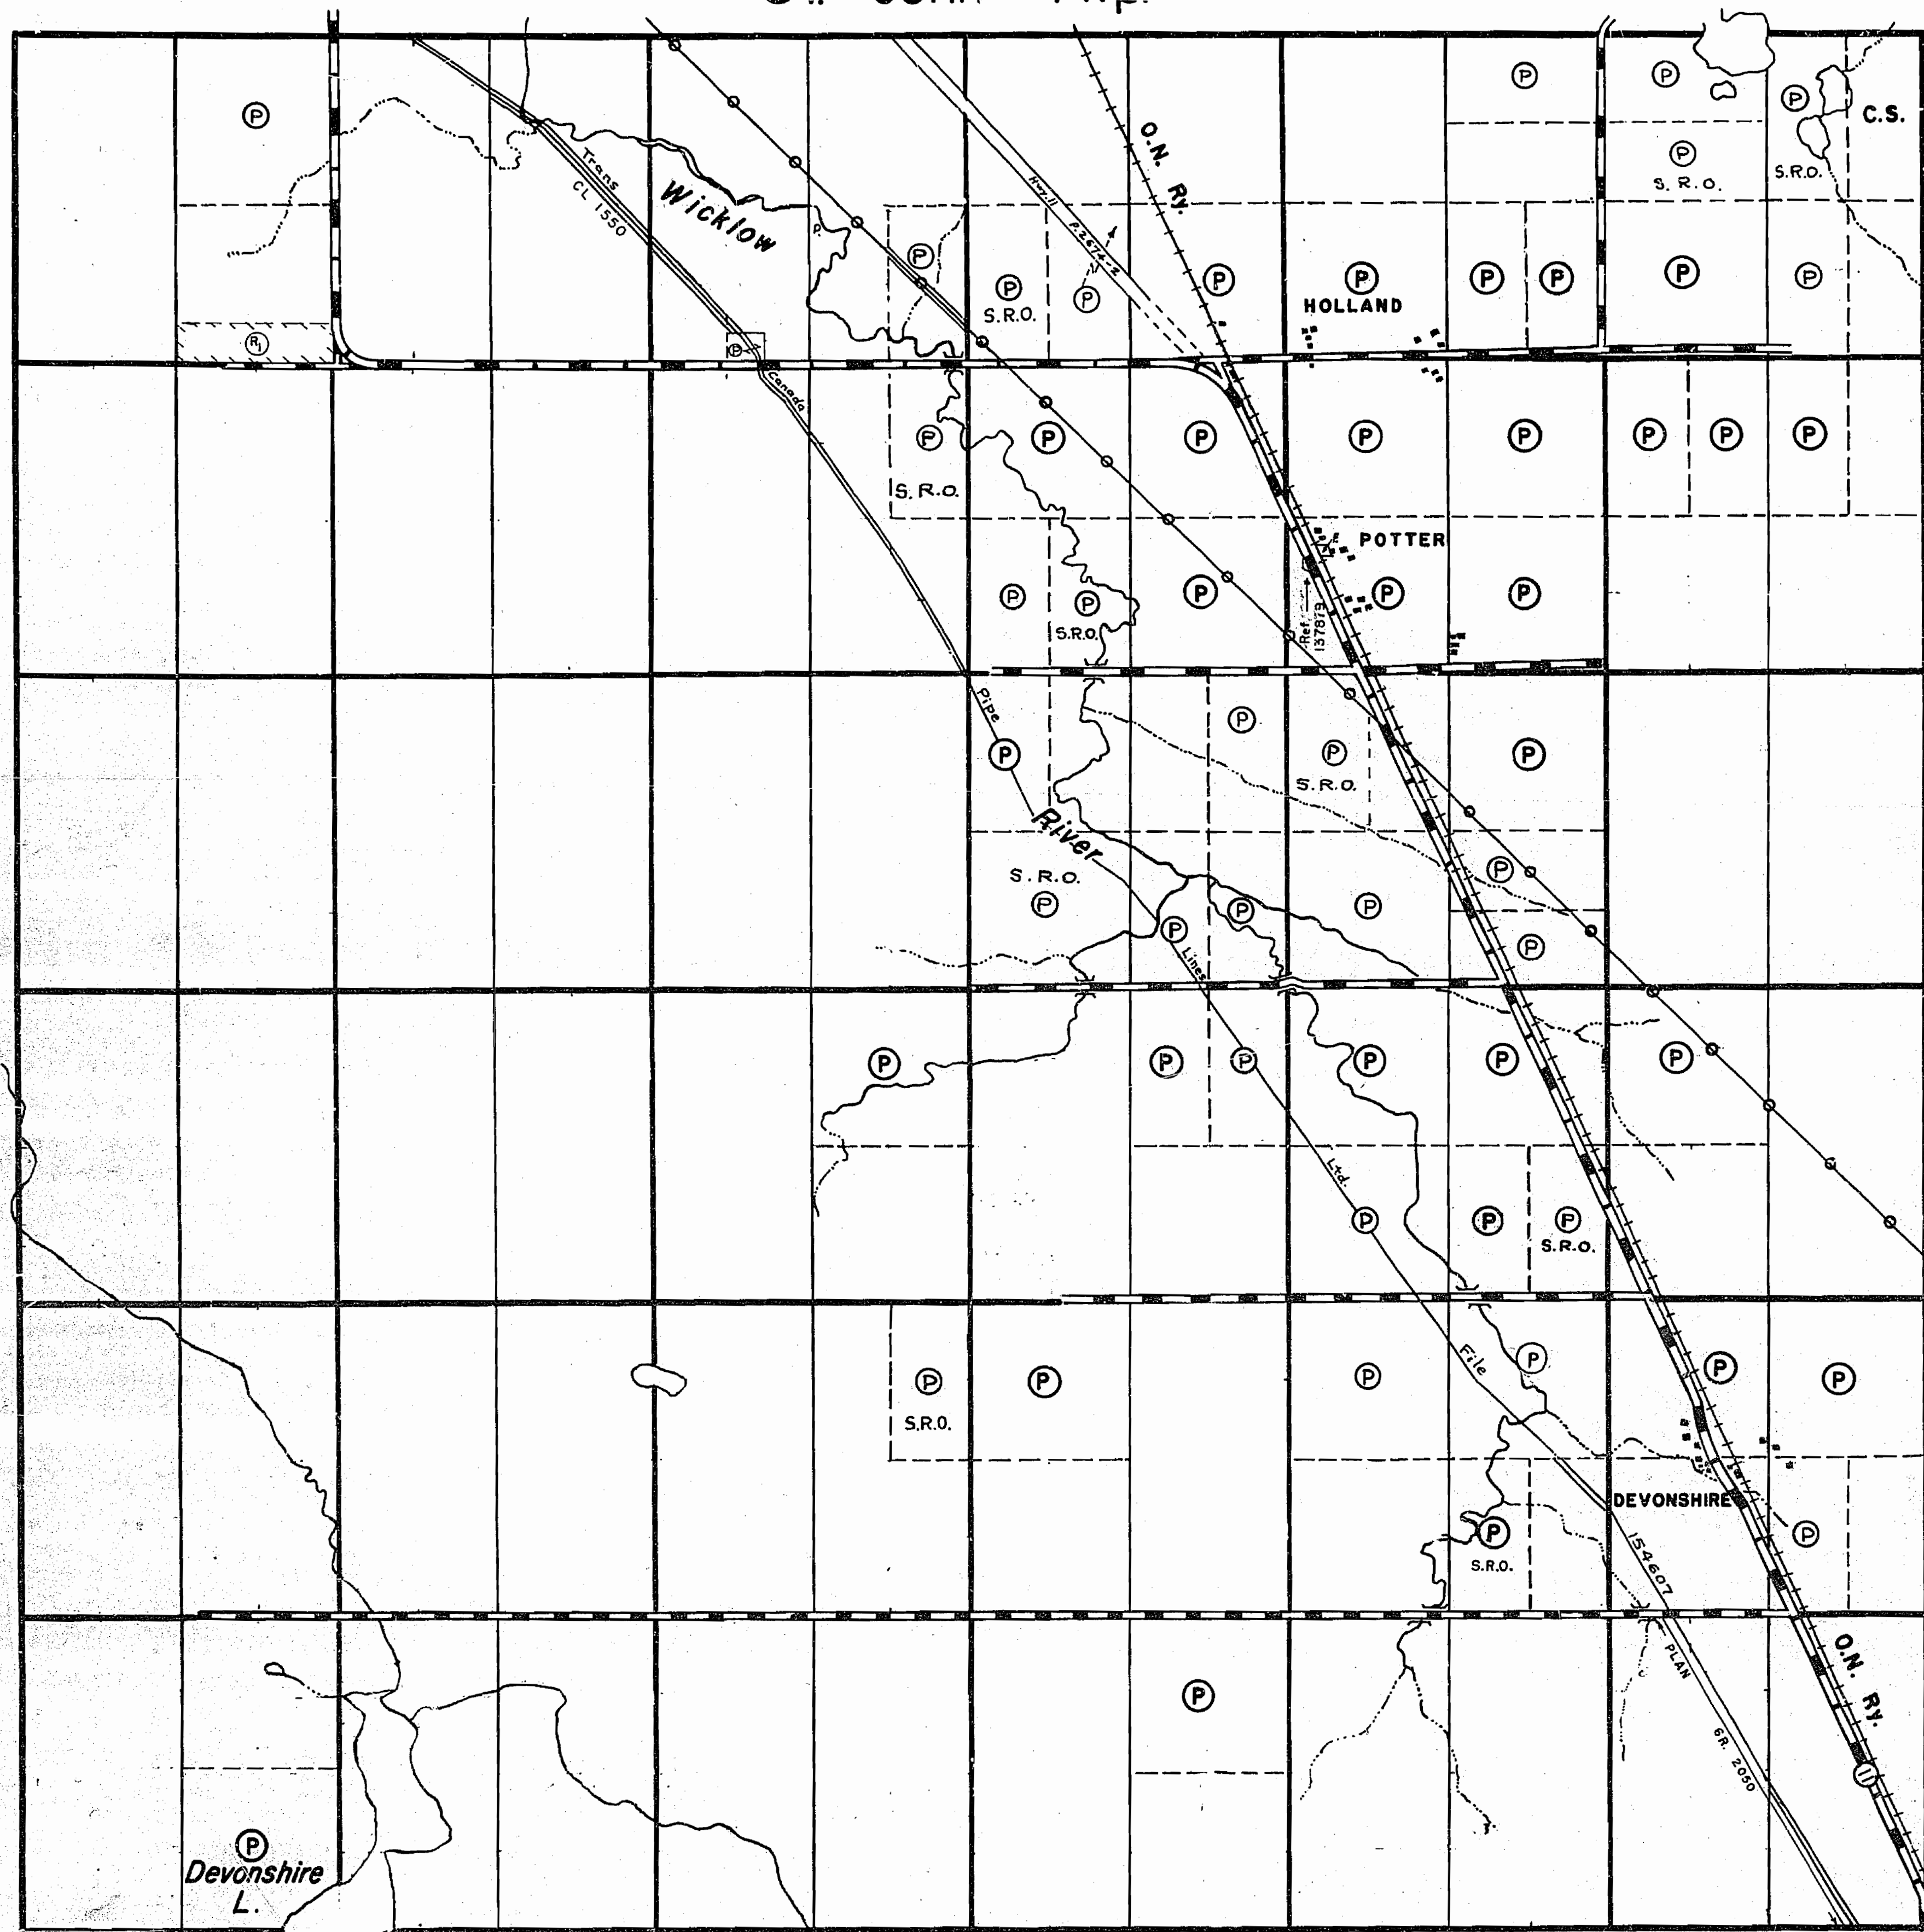

12 11 10 9 8 7 6 5 4 3 2 1

Mc Cart Twp.

THE TOWNSHIP OF NEWMARKET

DISTRICT OF
COCHRANE

PORCUPINE
MINING DIVISION

SCALE: 1-INCH= 40 CHAINS

LEGEND

PATENTED LAND	(P)
CROWN LAND SALE	C.S.
LEASES	(L)
LOCATED LAND	Loc.
LICENSE OF OCCUPATION	L.O.
ROADS	—
IMPROVED ROADS	—
RAILWAYS	—
POWER LINES	—
MARSH OR MUSKEG	—

NOTES

M.R.O. : Mineral Rights Only

Areas withdrawn from staking under Section
43 of the Mining Act (R.S.O. 1970).

Order No.	File	Date	Disposition
(N) W. 43/79 NR.	33749	16/8/79	S.R.O.

400' Surface Rights Reservation around
all Lakes and Rivers.

PLAN NO. - M-557

ONTARIO
MINISTRY OF NATURAL RESOURCES

AREAS WITHDRAWN FROM DISPOSITION

M.R.O. - MINING RIGHTS ONLY
S.R.O. - SURFACE RIGHTS ONLY
M.+S. - MINING AND SURFACE RIGHTS

Description Order No. Date Disposition File
W.33/79 NR. 16/8/79 S.R.O. 33749


Surface Rights Withdrawn under Sec. 36,
The Mining Act R.S.O. 1980, ORDER NO. W-01/91/ONT
(Tran - side Pipeline Right of Way and Luffer
Zone particularly 40.25 meters or 132 ft on
either side of centre line of right of way)

LUP APPLICATION DATED JAN-18-94: CANCELLED - MARCH 3/95

ST. JOHN TOWNSHIP

MANN TOWNSHIP

AURORA TOWNSHIP

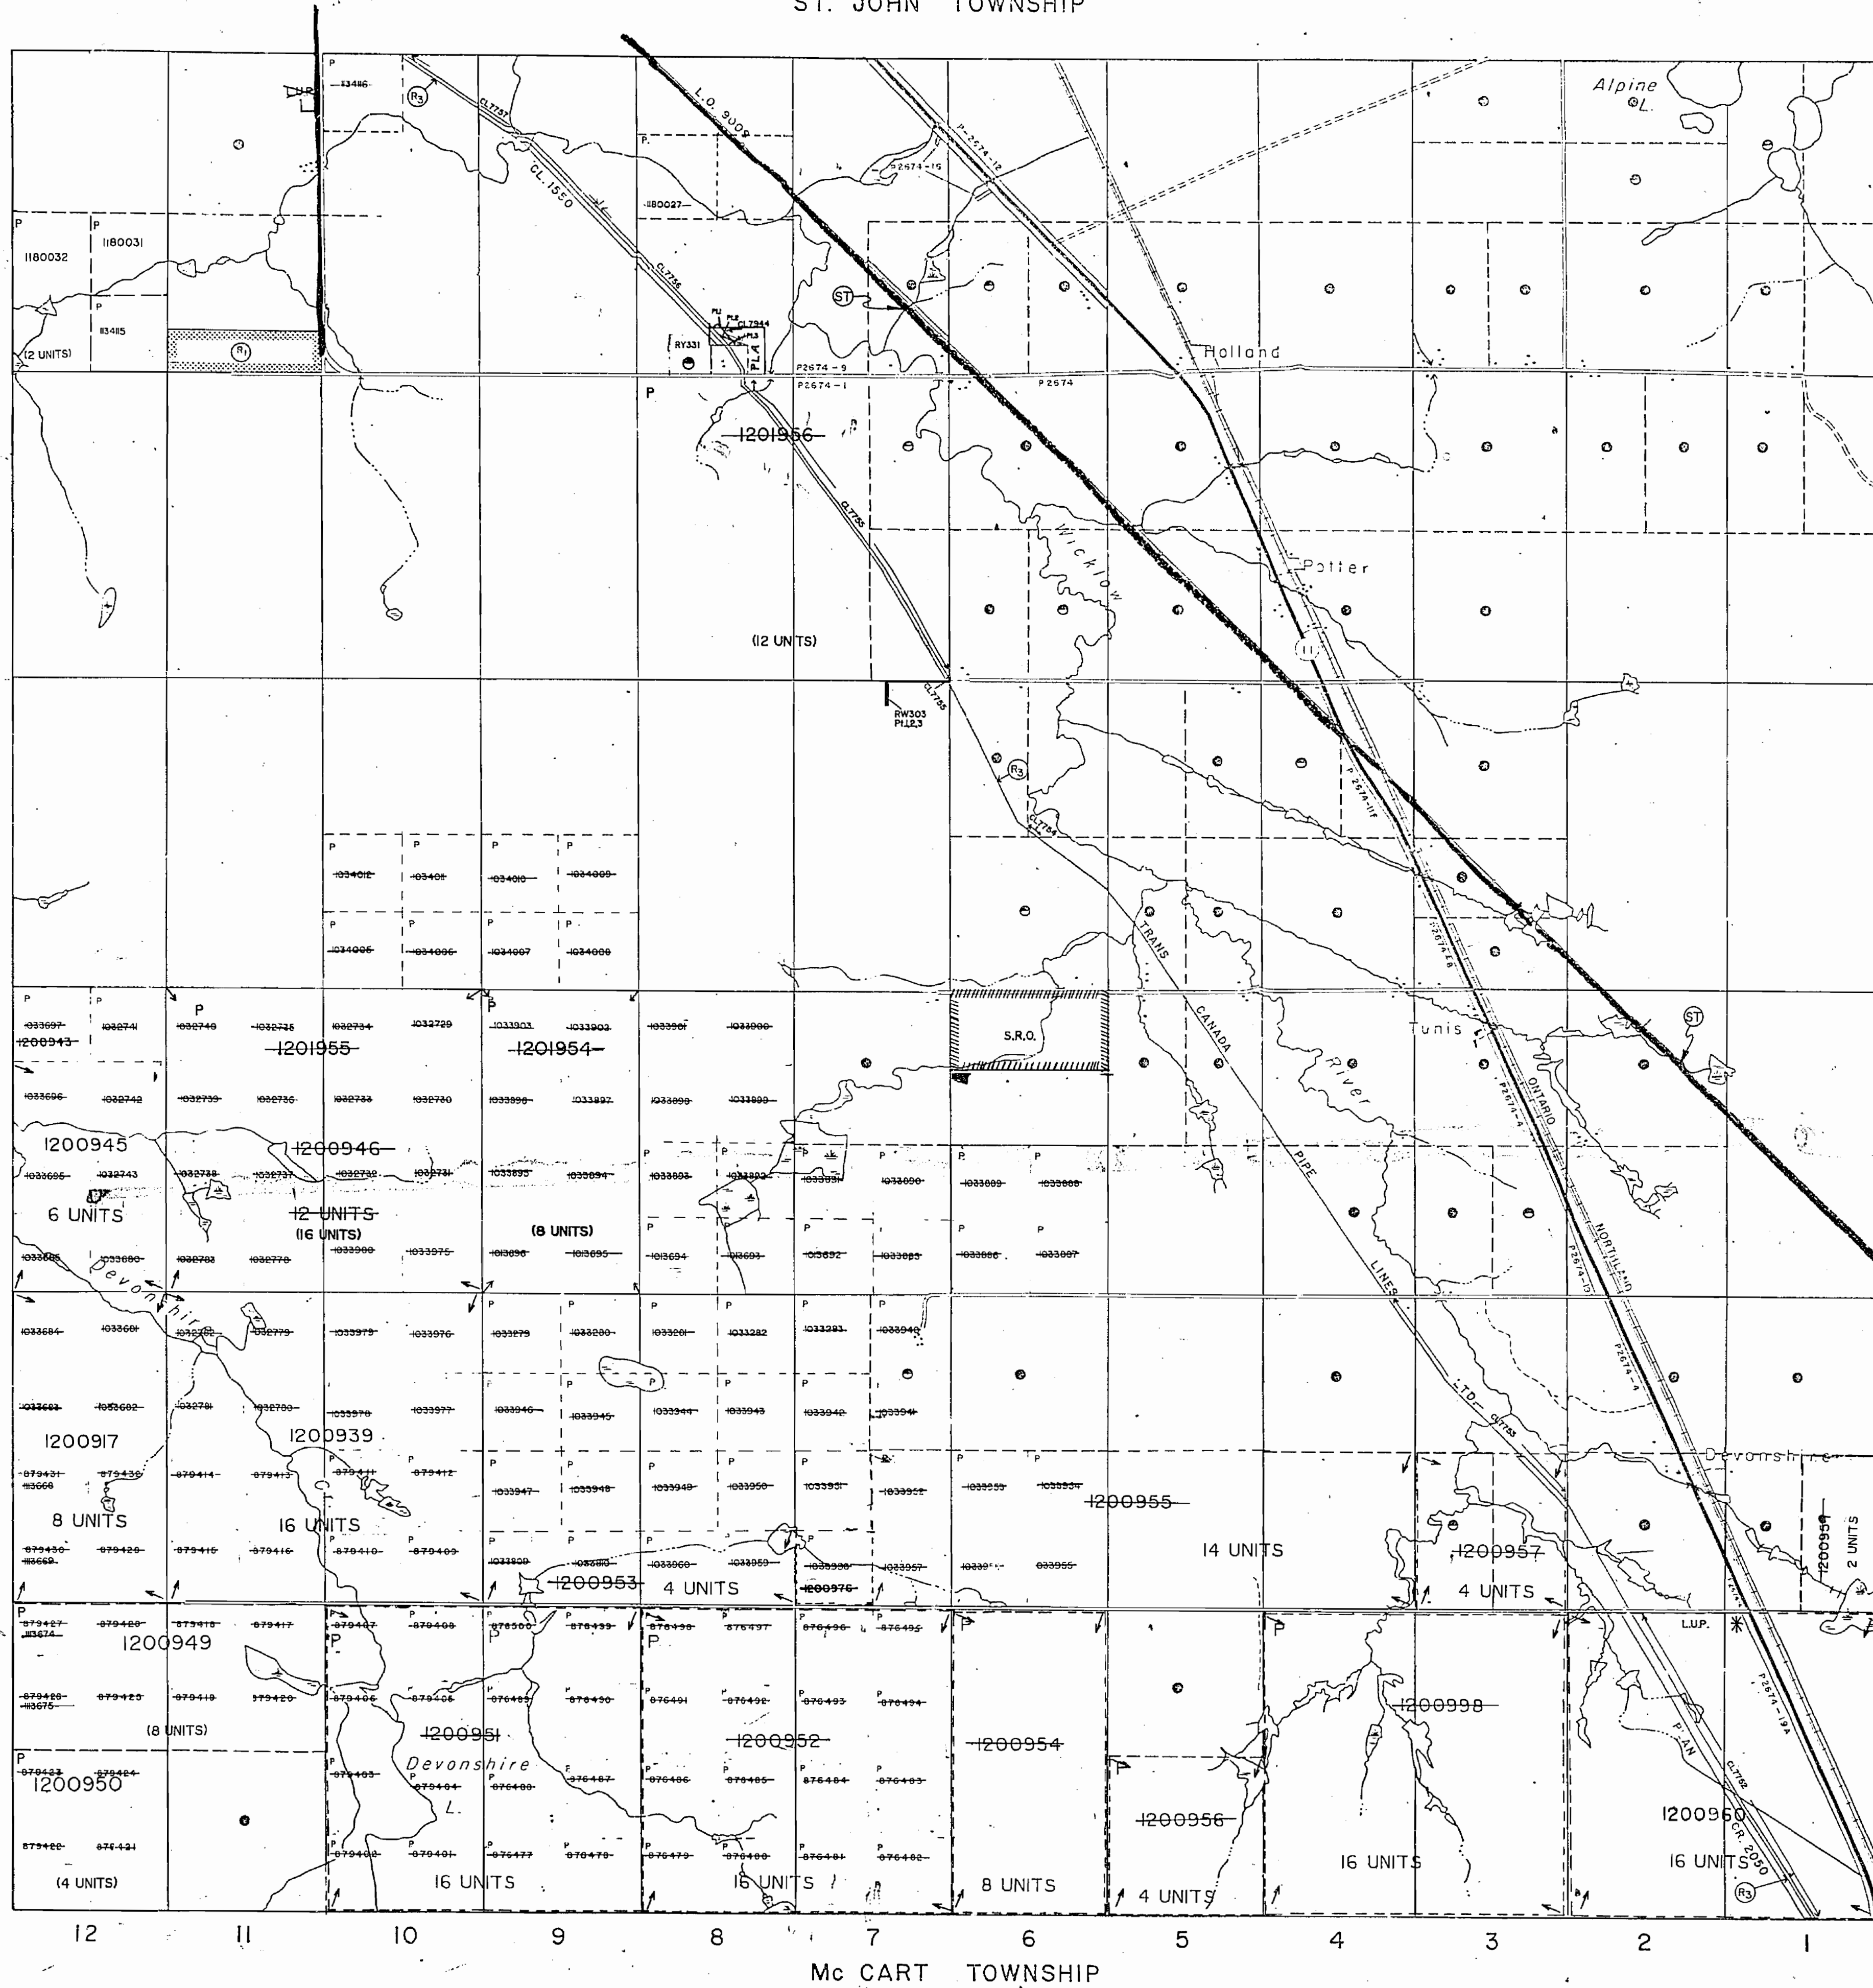

LEGEND

HIGHWAY AND ROUTE No
OTHER ROADS
TRAILS
SURVEYED LINES
TOWNSHIPS, BASE LINES, ETC.
LOTS, MINING CLAIMS, PARCELS, ETC.
UNSURVEYED LINES
LOT LINES
PARCEL BOUNDARY
MINING CLAIMS ETC.
RAILWAY AND RIGHT OF WAY
UTILITY LINES
NON PERENNIAL STREAM
FLOODING OR FLOODING RIGHTS
SUBDIVISION OR COMPOSITE PLAN
RESERVATIONS
ORIGINAL SHORELINE
MARSH OR MUSKEG
MINES
TRAVERSE MONUMENT

DISPOSITION OF CROWN LANDS

TYPE OF DOCUMENT	SYMBOL
PATENT, SURFACE & MINING RIGHTS	○
" SURFACE RIGHTS ONLY	○
" MINING RIGHTS ONLY	○
LEASE, SURFACE & MINING RIGHTS	○
" SURFACE RIGHTS ONLY	○
" MINING RIGHTS ONLY	○
LICENCE OF OCCUPATION	○
ORDER IN COUNCIL	○
RESERVATION	○
CANCELLED	○
SAND & GRAVEL	○
LUP (LAND USE PERMIT)	○

NOTE: MINING RIGHTS IN PARCELS PATENTED PRIOR TO MAY 1, 1913, VESTED IN ORIGINAL PATENTEE BY THE PUBLIC LANDS ACT, R.S.O. 1970, CHAP. 380, SEC. 63, SUBSEC. 1.

Metres 0 1000
Chains 0 10 20 30 40 50 60 70 80 90 100
Feet 0 1000 2000 3000 4000 5000

SCALE 1:20 000

R₂ - AGRICULTURAL PERMIT

ST SNOWMOBILE TRAIL
NOTICE RECEIVED 92-DEC-09

DATE OF ISSUE

MAY 20 1998
PROVINCIAL RECORDING
OFFICE - SUDBURY

TOWNSHIP

NEWMARKET

M.N.R. ADMINISTRATIVE DISTRICT

COCHRANE

MINING DIVISION

PORCUPINE

LAND TITLES / REGISTRY DIVISION

COCHRANE

Ministry of Natural Resources
Ontario
Ministry of Northern Development and Mines

Date SEPTEMBER 1986

checked J. M. Nov. 20/86
28 / 10 / 87

Number
G-3548

THE INFORMATION THAT
APPEARS ON THIS MAP
HAS BEEN COMPILED
FROM VARIOUS SOURCES,
AND ACCURACY IS NOT
GUARANTEED. THOSE
WISHING TO STAKE
MINING CLAIMS SHOULD
CONSULT WITH THE MINING
RECORDER, MINISTRY OF
NORTHERN DEVELOPMENT
AND MINES, FOR ADDITIONAL
INFORMATION ON THE STATUS OF THE
LANDS SHOWN HEREON.

557

St. John Twp.

THE TOWNSHIP
OF
NEWMARKET

DISTRICT OF
COCHRANE
PORCUPINE
MINING DIVISION
SCALE 1-INCH=40 CHAINS

LEGEND

PATENTED LAND (P)
CROWN LAND SALE (C.S.)
LEASES (L)
LOCATED LAND (Loc)
LICENSE OF OCCUPATION (L.O.)
ROADS
IMPROVED ROADS
RAILWAYS
POWER LINES
MARSH OR MUSKEG

NOTES

M.R.O. Mineral Rights Only
Surface rights reserved on all lands staked & patented after 21 May 1945 - See O.C. 25 April 1945.
By regulations passed previously, sale or other disposition of land in this Township has been limited to S.R.O. only, effective May 2, 1950.
400' Surface Rights Reservation around all Lakes and Rivers.

MINING RECORDER
RECEIVED
NOV 9 1962


PLAN NO. - M-557

DEPARTMENT OF MINES
— ONTARIO —

Mann Twp.

Aurora Twp.

Mc Cart Twp.

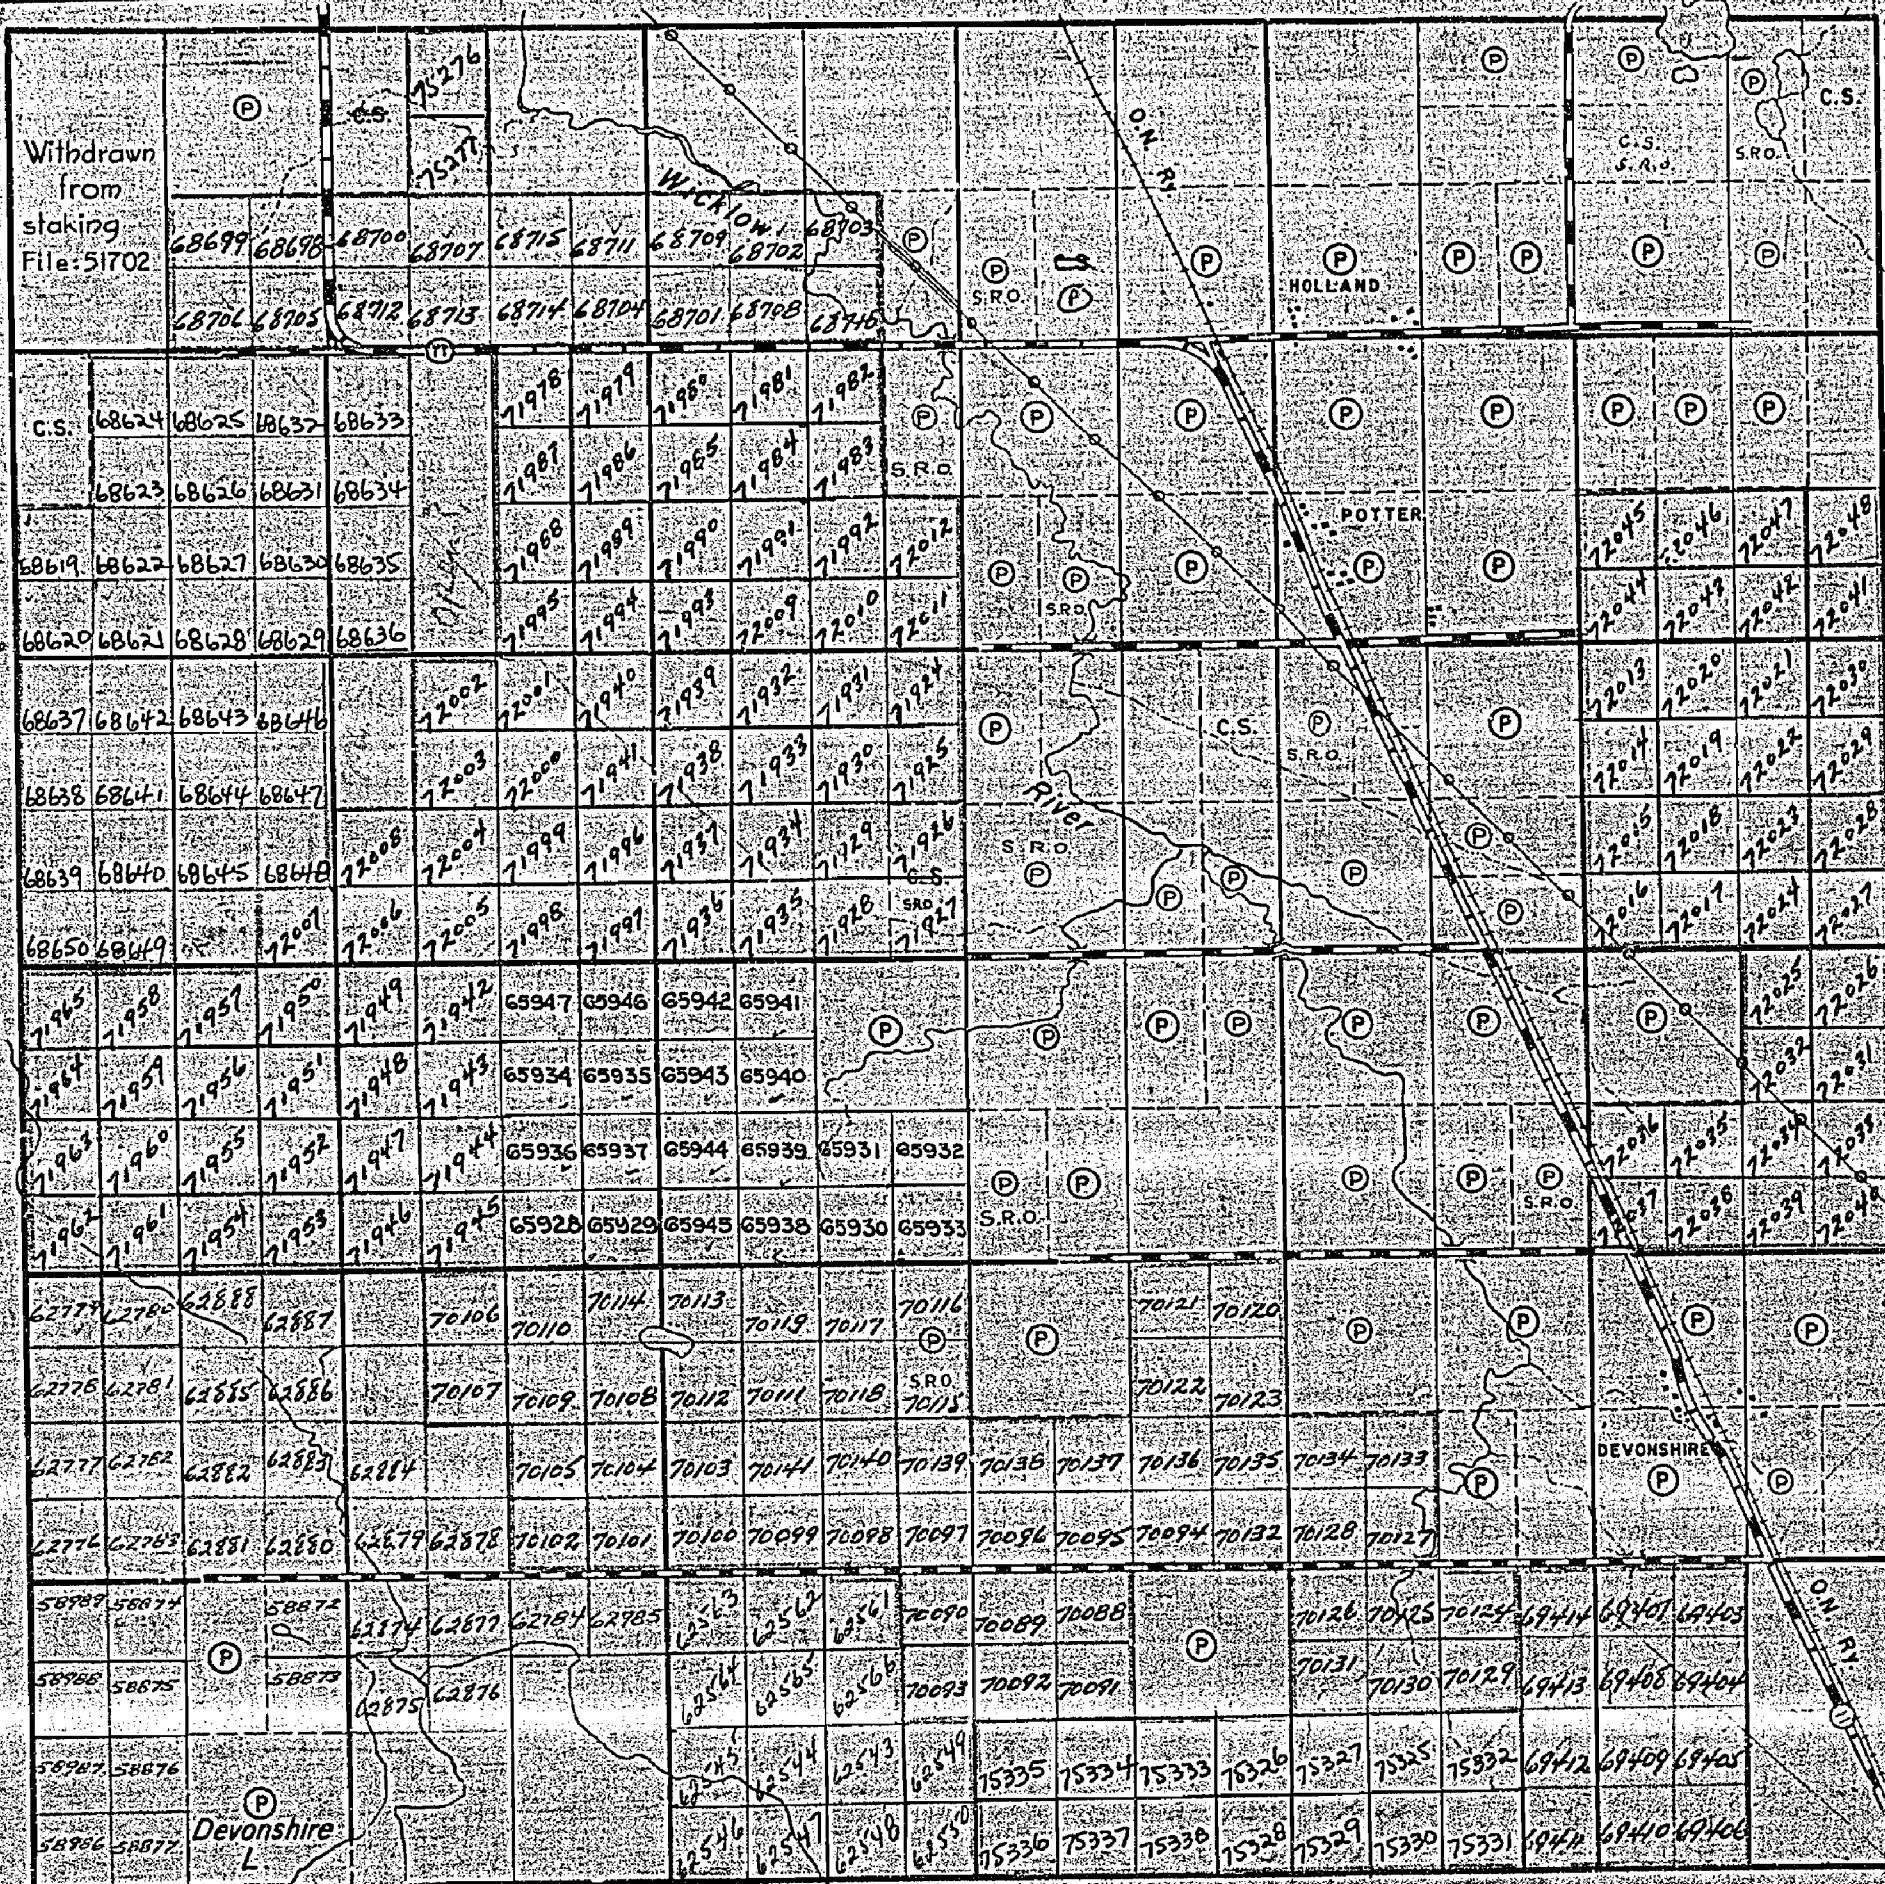

Proposed
A.P.E. line

St. John Twp.

Viann Twp.

Mc Gart Twp.

NEWMARKE

DISTRICT OF
COCHRANE

PORCUPINE
MINING DIVISION

SCALE: 1-INCH=40 CHAINS

LEGEND

PATENTED LAND
CROWN LAND SALE
LEASES
LOCATED LAND
LICENSE OF OCCUPATION
ROADS
IMPROVED ROADS
RAILWAYS
POWER LINES
MARSH OR MUSKEG

NOTES

M.R.O. Mineral Rights Only

~~Surface rights reserved on oil lands staked~~
~~on patented oil form 21 May 1946 - Sec O.C.~~
~~25 April 1945: 51-13-013011~~

By regulations passed previously, sale or other disposition of land in this Township has been limited to S.R.O. only, effective May 2, 1980.

400 Surface Rights Reservation around
all Lakes and Rivers.

RECORDED

SEP 25 1964

RECEIPT No.


PLAN NO. - M-557

DEPARTMENT OF MINES
= ONTARIO =

557

St. John Twp.

Mann Twp.

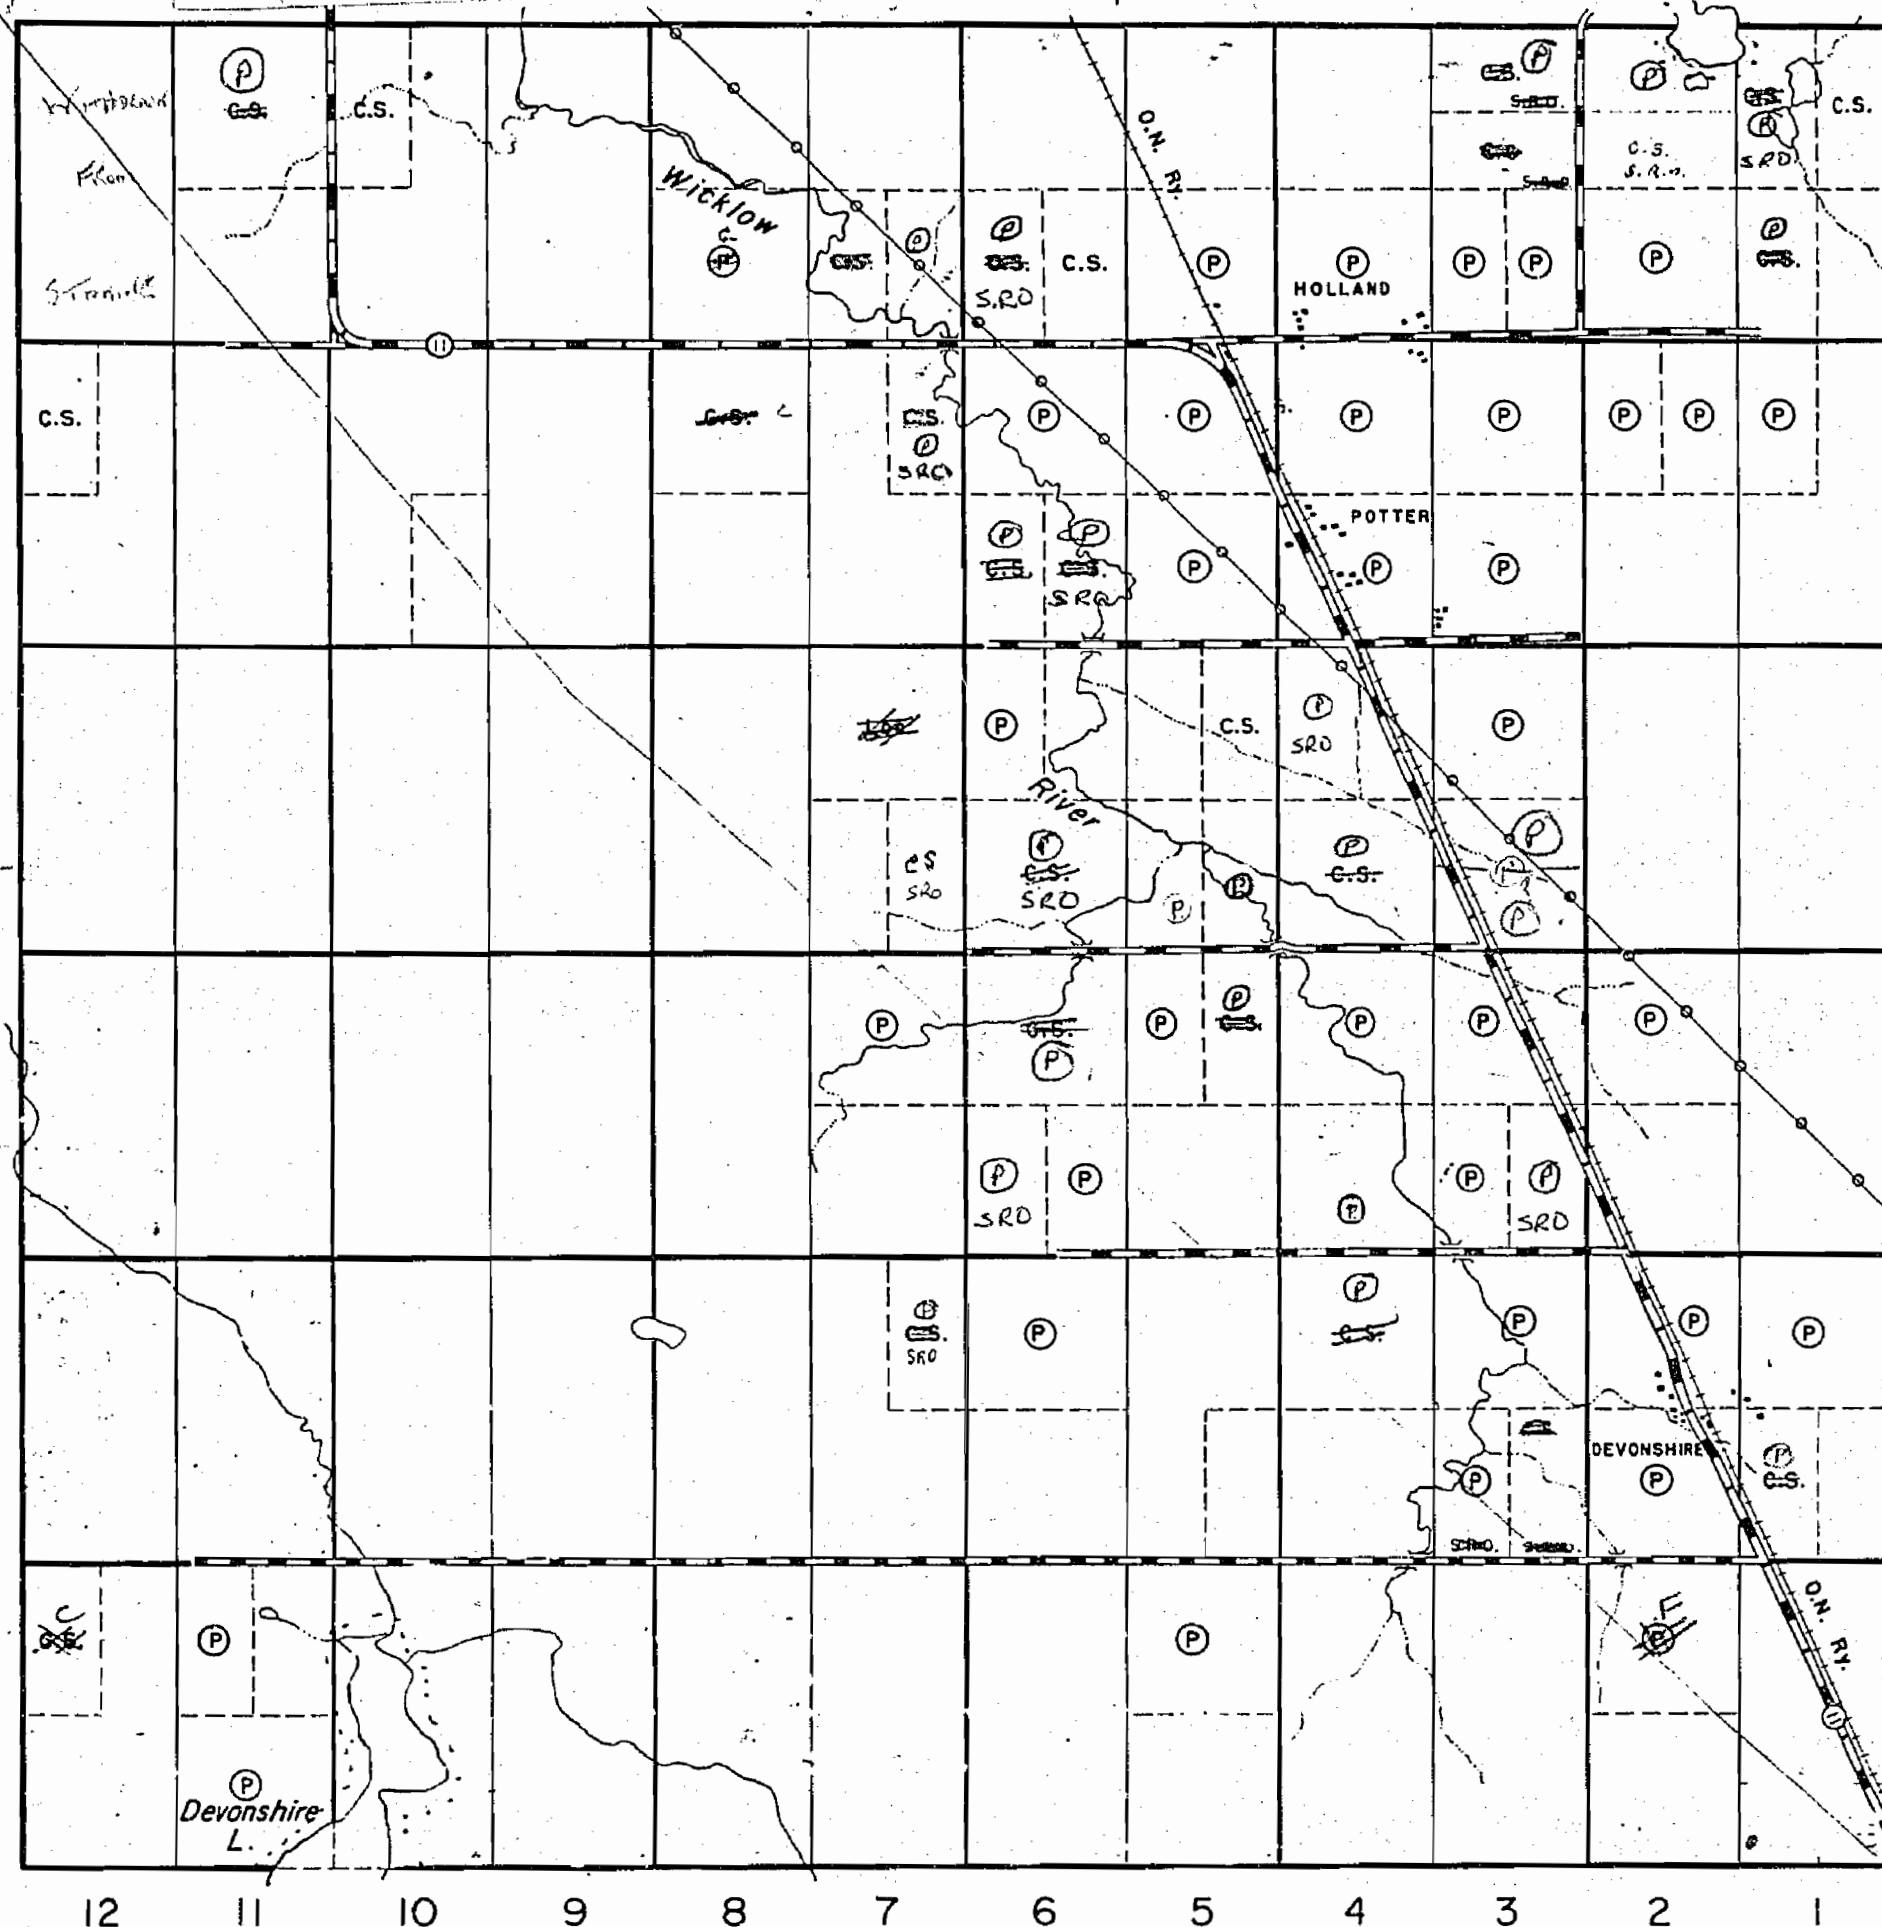

Mc Cart Twp.

THE TOWNSHIP
OF
NEWMARKET

DISTRICT OF
COCHRANEPORCUPINE
MINING DIVISION

SCALE: 1-INCH = 40 CHAINS

LEGEND

PATENTED LAND	(P)
CROWN LAND SALE	C.S.
LEASES	(L)
LOCATED LAND	Loc.
LICENSE OF OCCUPATION	L.O.
ROADS	—
IMPROVED ROADS	—
RAILWAYS	—
POWER LINES	—
MARSH OR MUSKEG	—

NOTES

M.R.O. : Mineral Rights Only

Surface rights reserved on all lands staked
& patented after 21 May 1945 — See O.C.
25 April 1945:

By regulations passed previously, sale or
other disposition of land in this Township
has been limited to S.R.O. only: effective
May 2, 1950.

400' Rsvd. to Dep. of L. & F.
shown here: —

PLAN NO. - M-557


DEPARTMENT OF MINES
— ONTARIO —

557

St. John Twp.

Mann Twp.

Mc Cart Twp.

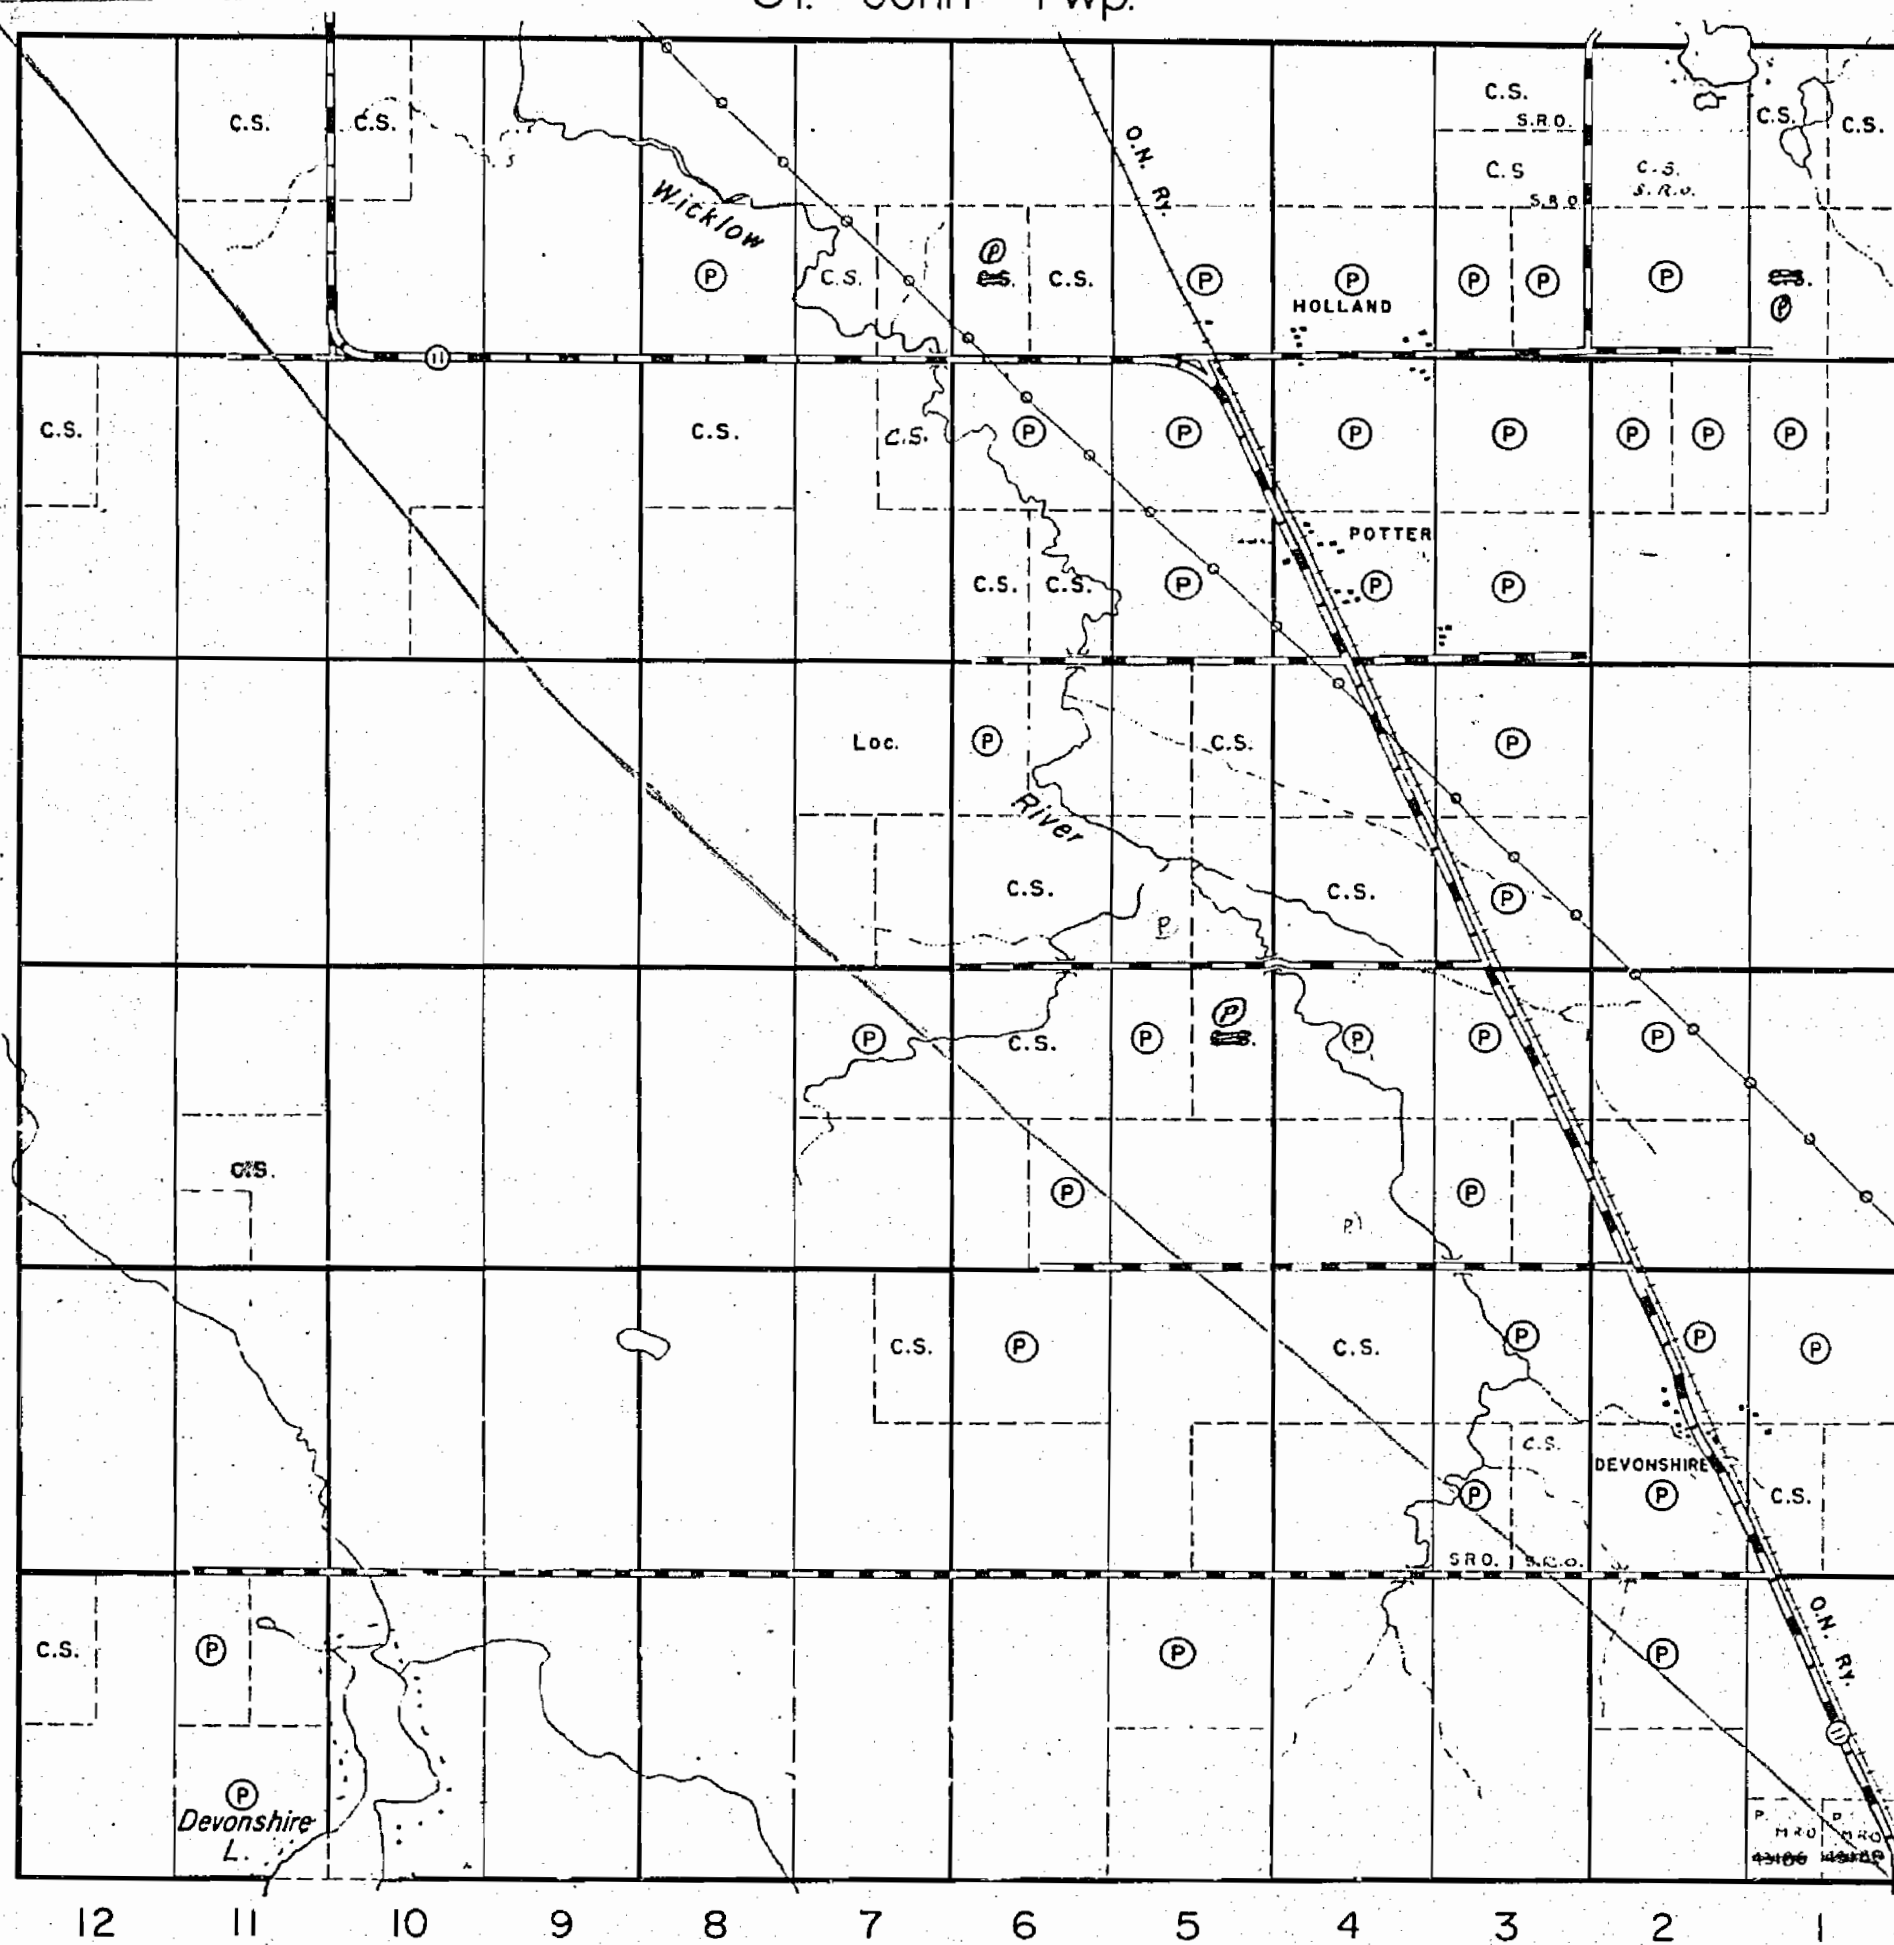THE TOWNSHIP
OF**NEWMARKET**DISTRICT OF
COCHRANEPORCUPINE
MINING DIVISION

SCALE: 1-INCH = 40 CHAINS

LEGEND

PATENTED LAND	(P)
CROWN LAND SALE	C.S.
LEASES	(L)
LOCATED LAND	Loc.
LICENSE OF OCCUPATION	L.O.
ROADS	—
IMPROVED ROADS	- - -
RAILWAYS	—+—+—+—
POWER LINES	—•—•—•—
MARSH OR MUSKEG	~~~~~

NOTES

M.R.O. : Mineral Rights Only

Surface rights reserved on all lands staked
& patented after 21 May 1945 — See O.C.
25 April 1945:By regulations passed previously, sale or
other disposition of land in this Township
has been limited to S.R.O. only; effective
May 2, 1950.400' Rsvd. to Dept. of L.R.F.
shown here

PLAN NO. — M-557


DEPARTMENT OF MINES
— ONTARIO —

557

St. John Twp.

Mann Twp.

Mc Cart Twp.

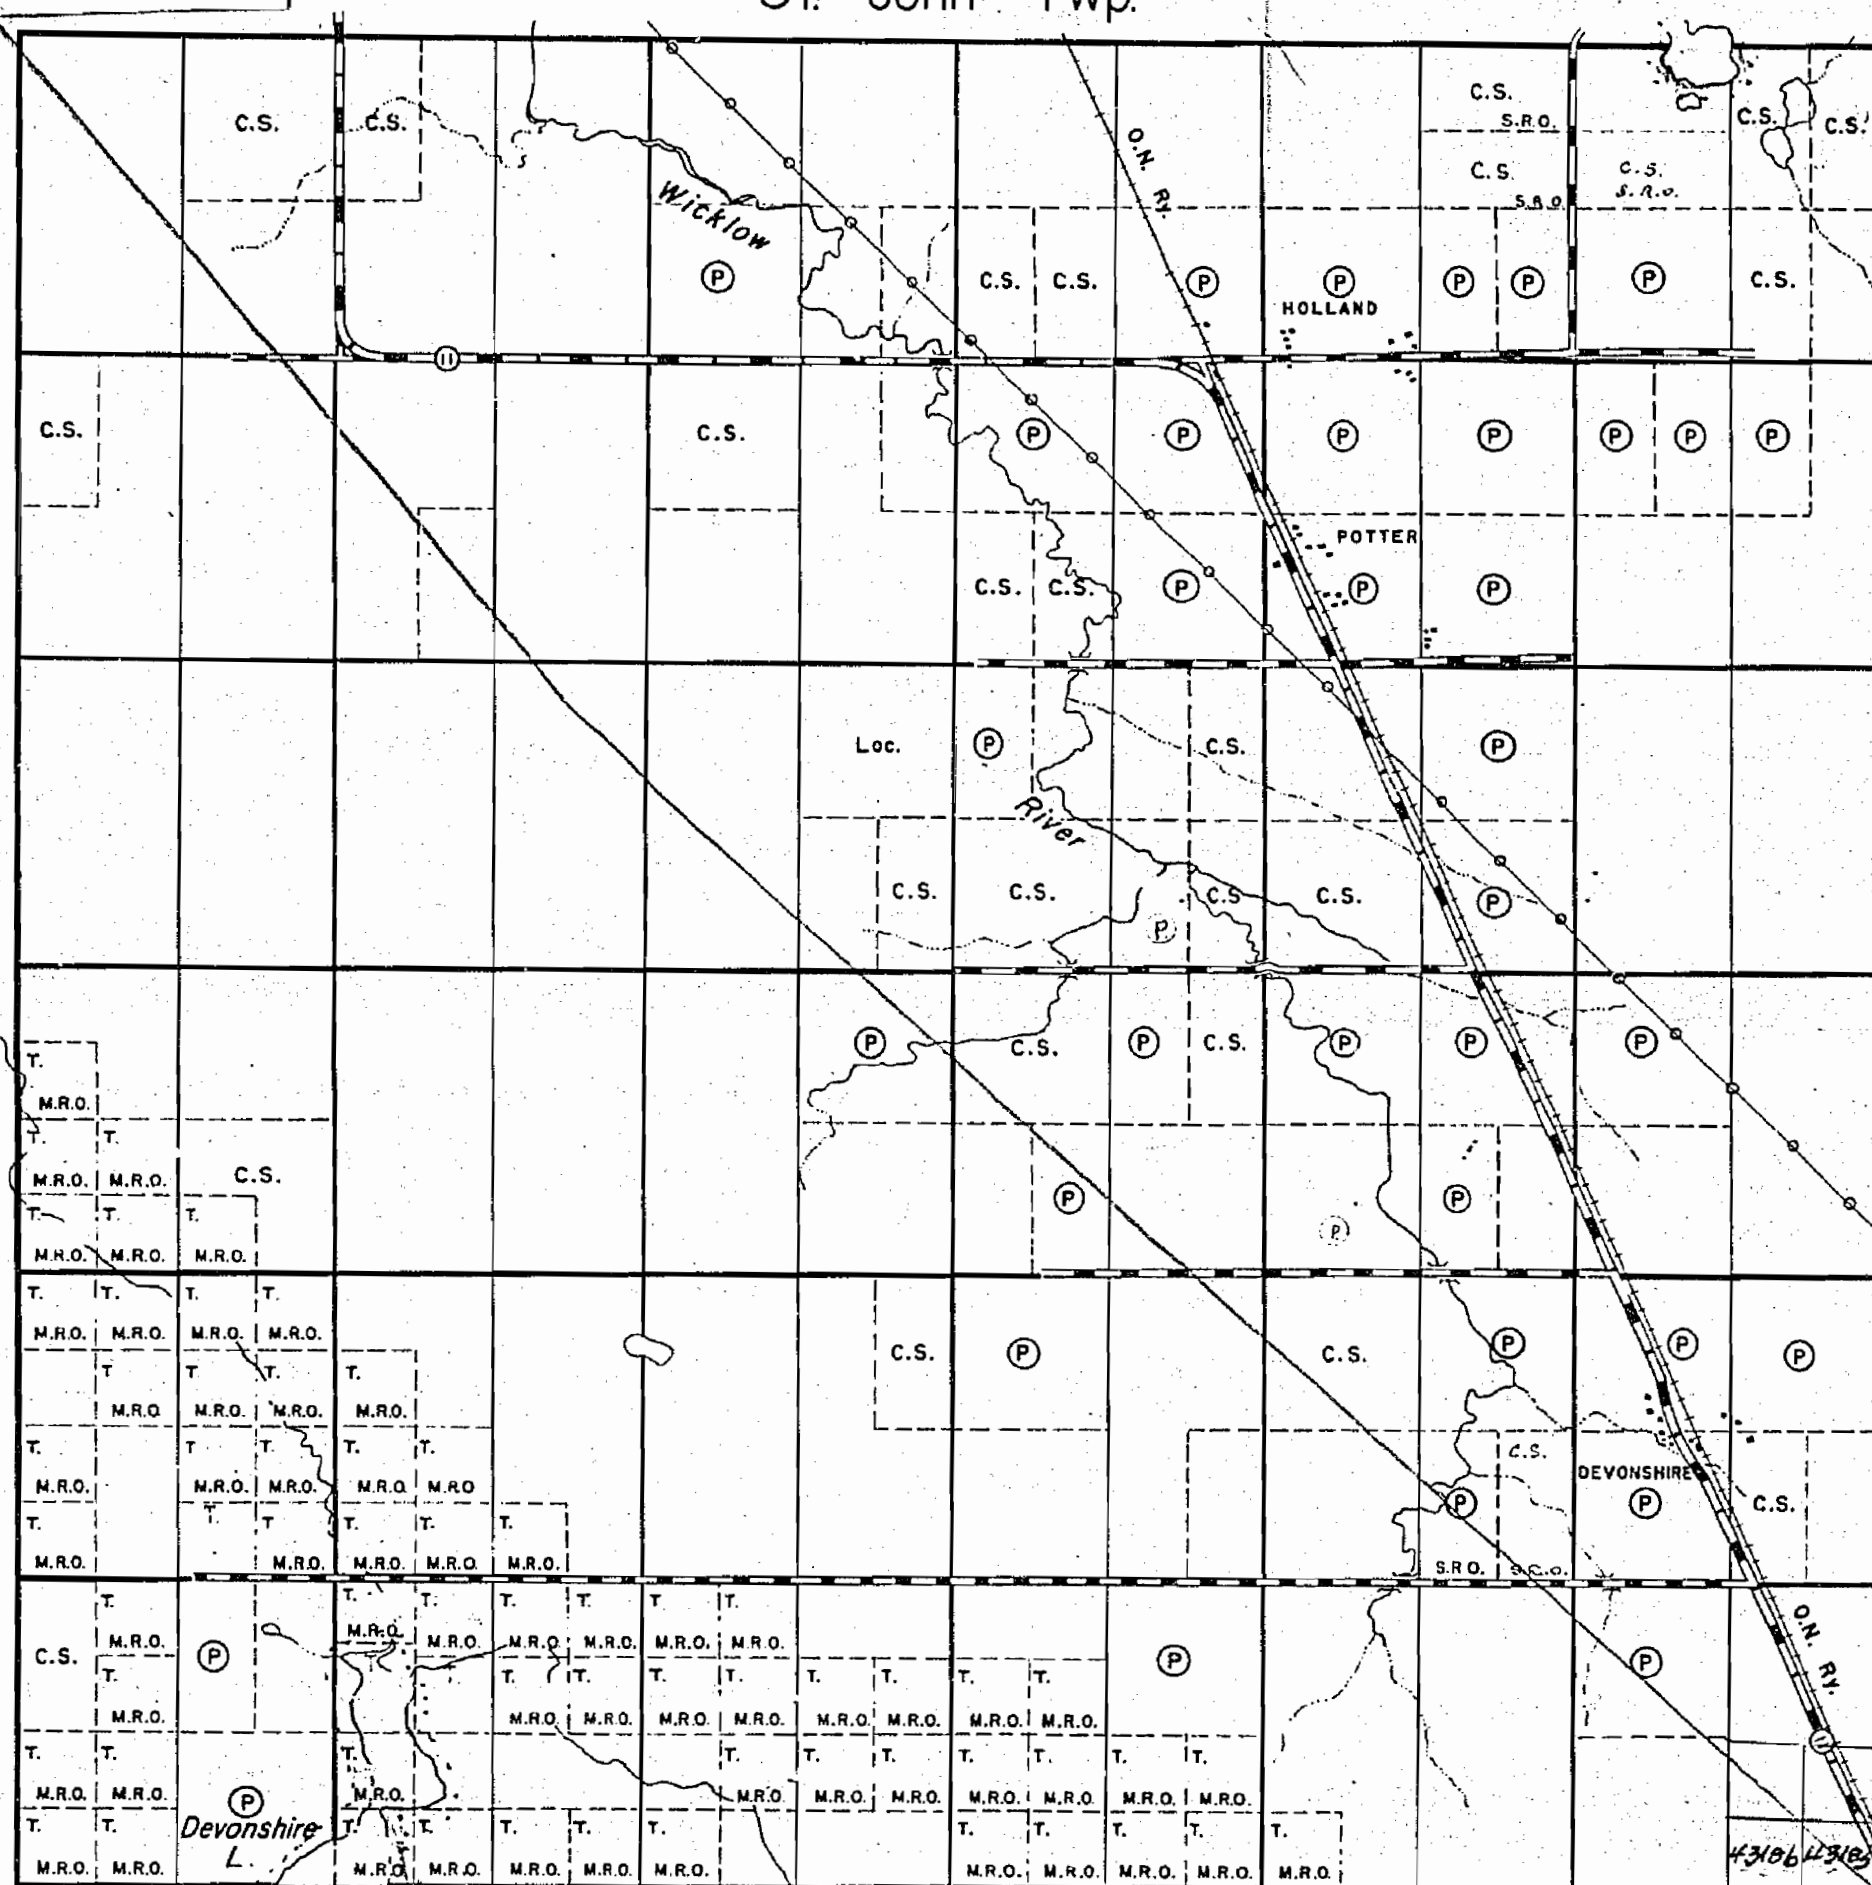

THE TOWNSHIP OF NEWMARKET

DISTRICT OF
COCHRANEPORCUPINE
MINING DIVISION

SCALE: 1-INCH = 40 CHAINS

LEGEND

PATENTED LAND	(P)
CROWN LAND SALE	C.S.
LEASES	(L)
LOCATED LAND	Loc.
LICENSE OF OCCUPATION	L.O.
ROADS	—
IMPROVED ROADS	—
RAILWAYS	—
POWER LINES	—
MARSH OR MUSKEG	—

NOTES

M.R.O. : Mineral Rights Only

Surface rights reserved on all lands staked
B patented after 21 May 1945 — See O.C.
25 April 1945:

By regulations passed previously, sale or
other disposition of land in this Township
has been limited to S.R.O. only: effective
May 2, 1950.

400' Rsvd. to Dep. of L. & F.
shown here

*Improved
National
Cave*

PLAN NO. — M-557

DEPARTMENT OF MINES



— ONTARIO —

NEWMARKET TWP

TEMISKAMING MINING DIVISION.
DISTRICT OF COCHRANE.

Scale: 40 chains to an inch.

ST. JOHN TWP.

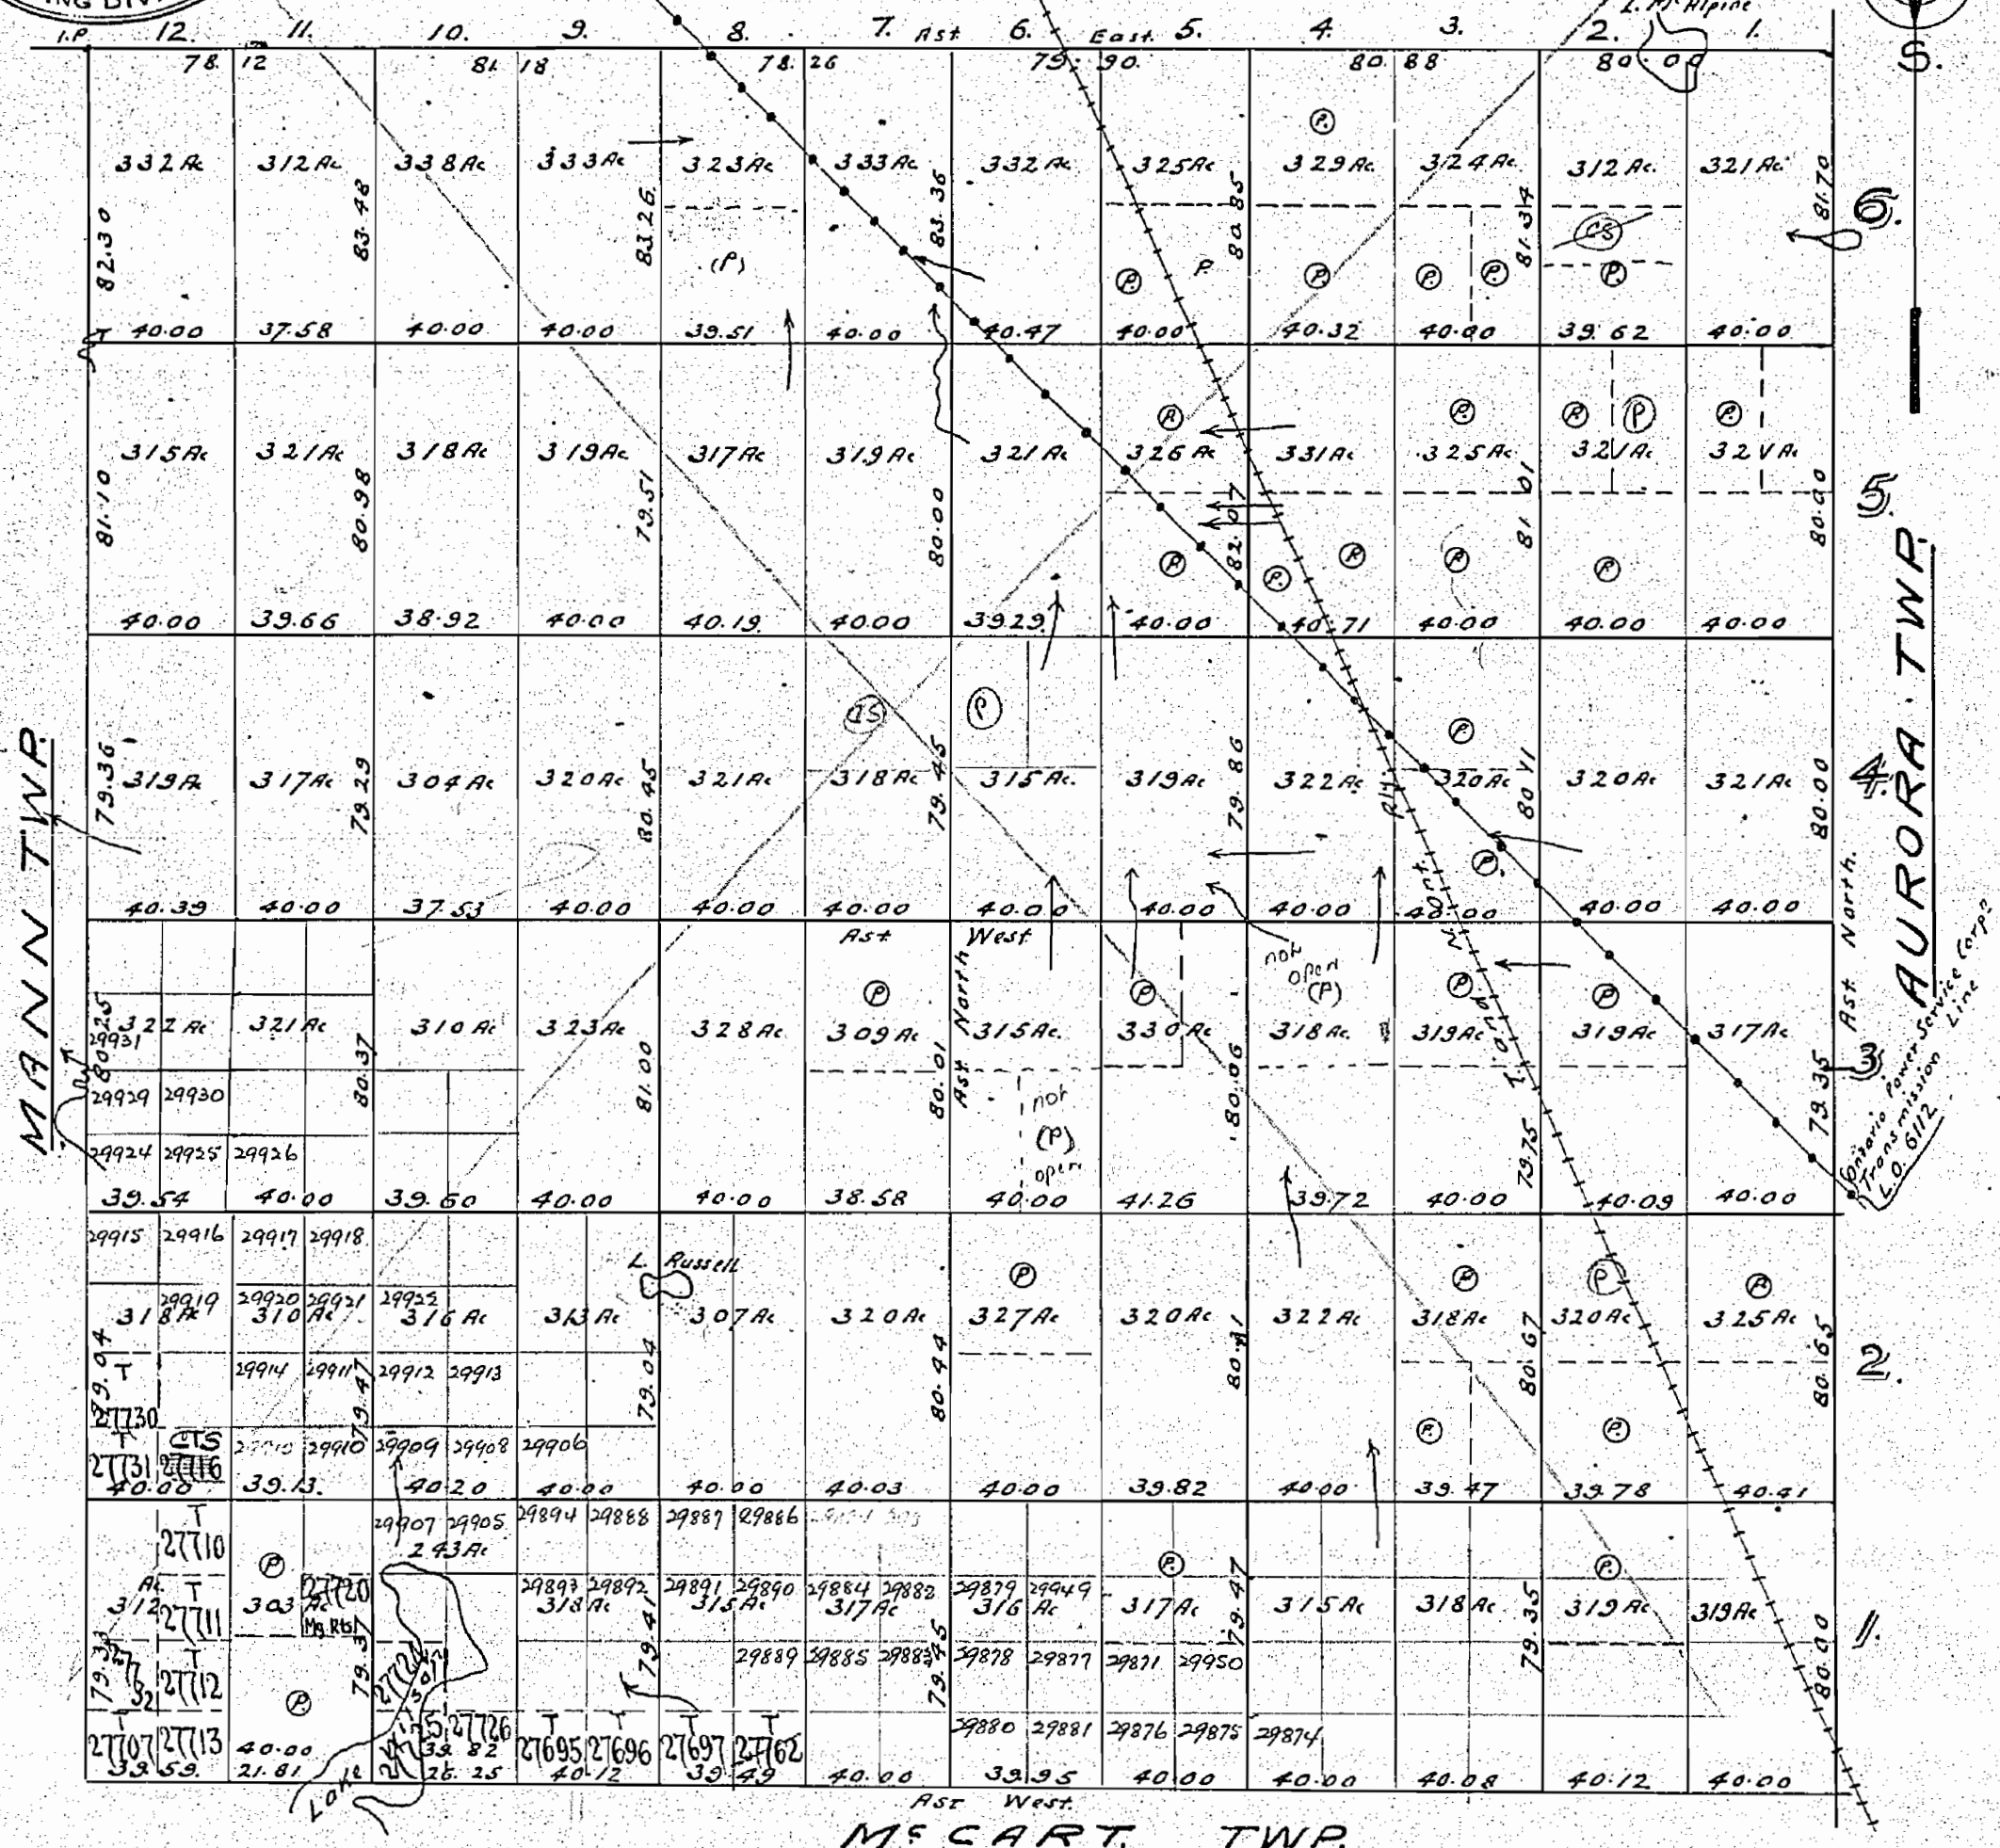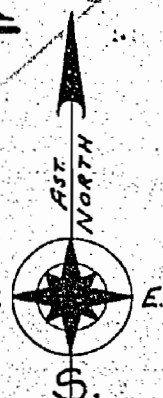

NOTE: All lands staked & Potented under The Mining Act after 21st May 1945 shall reserve the Surface Rights. See O in C 25th April 1945.

New Fresh 9 Nov 50

NEWMARKET

M557

By U.S. Code. O.L.S.

Dec. 20th. 1905.

Nipissing District.


now Timiskaming.

Scale: 40 chains = 1 in.

No. 1

ST. JOHN

Base line by O.L.S. Galbraith in 1904 E. Ast.

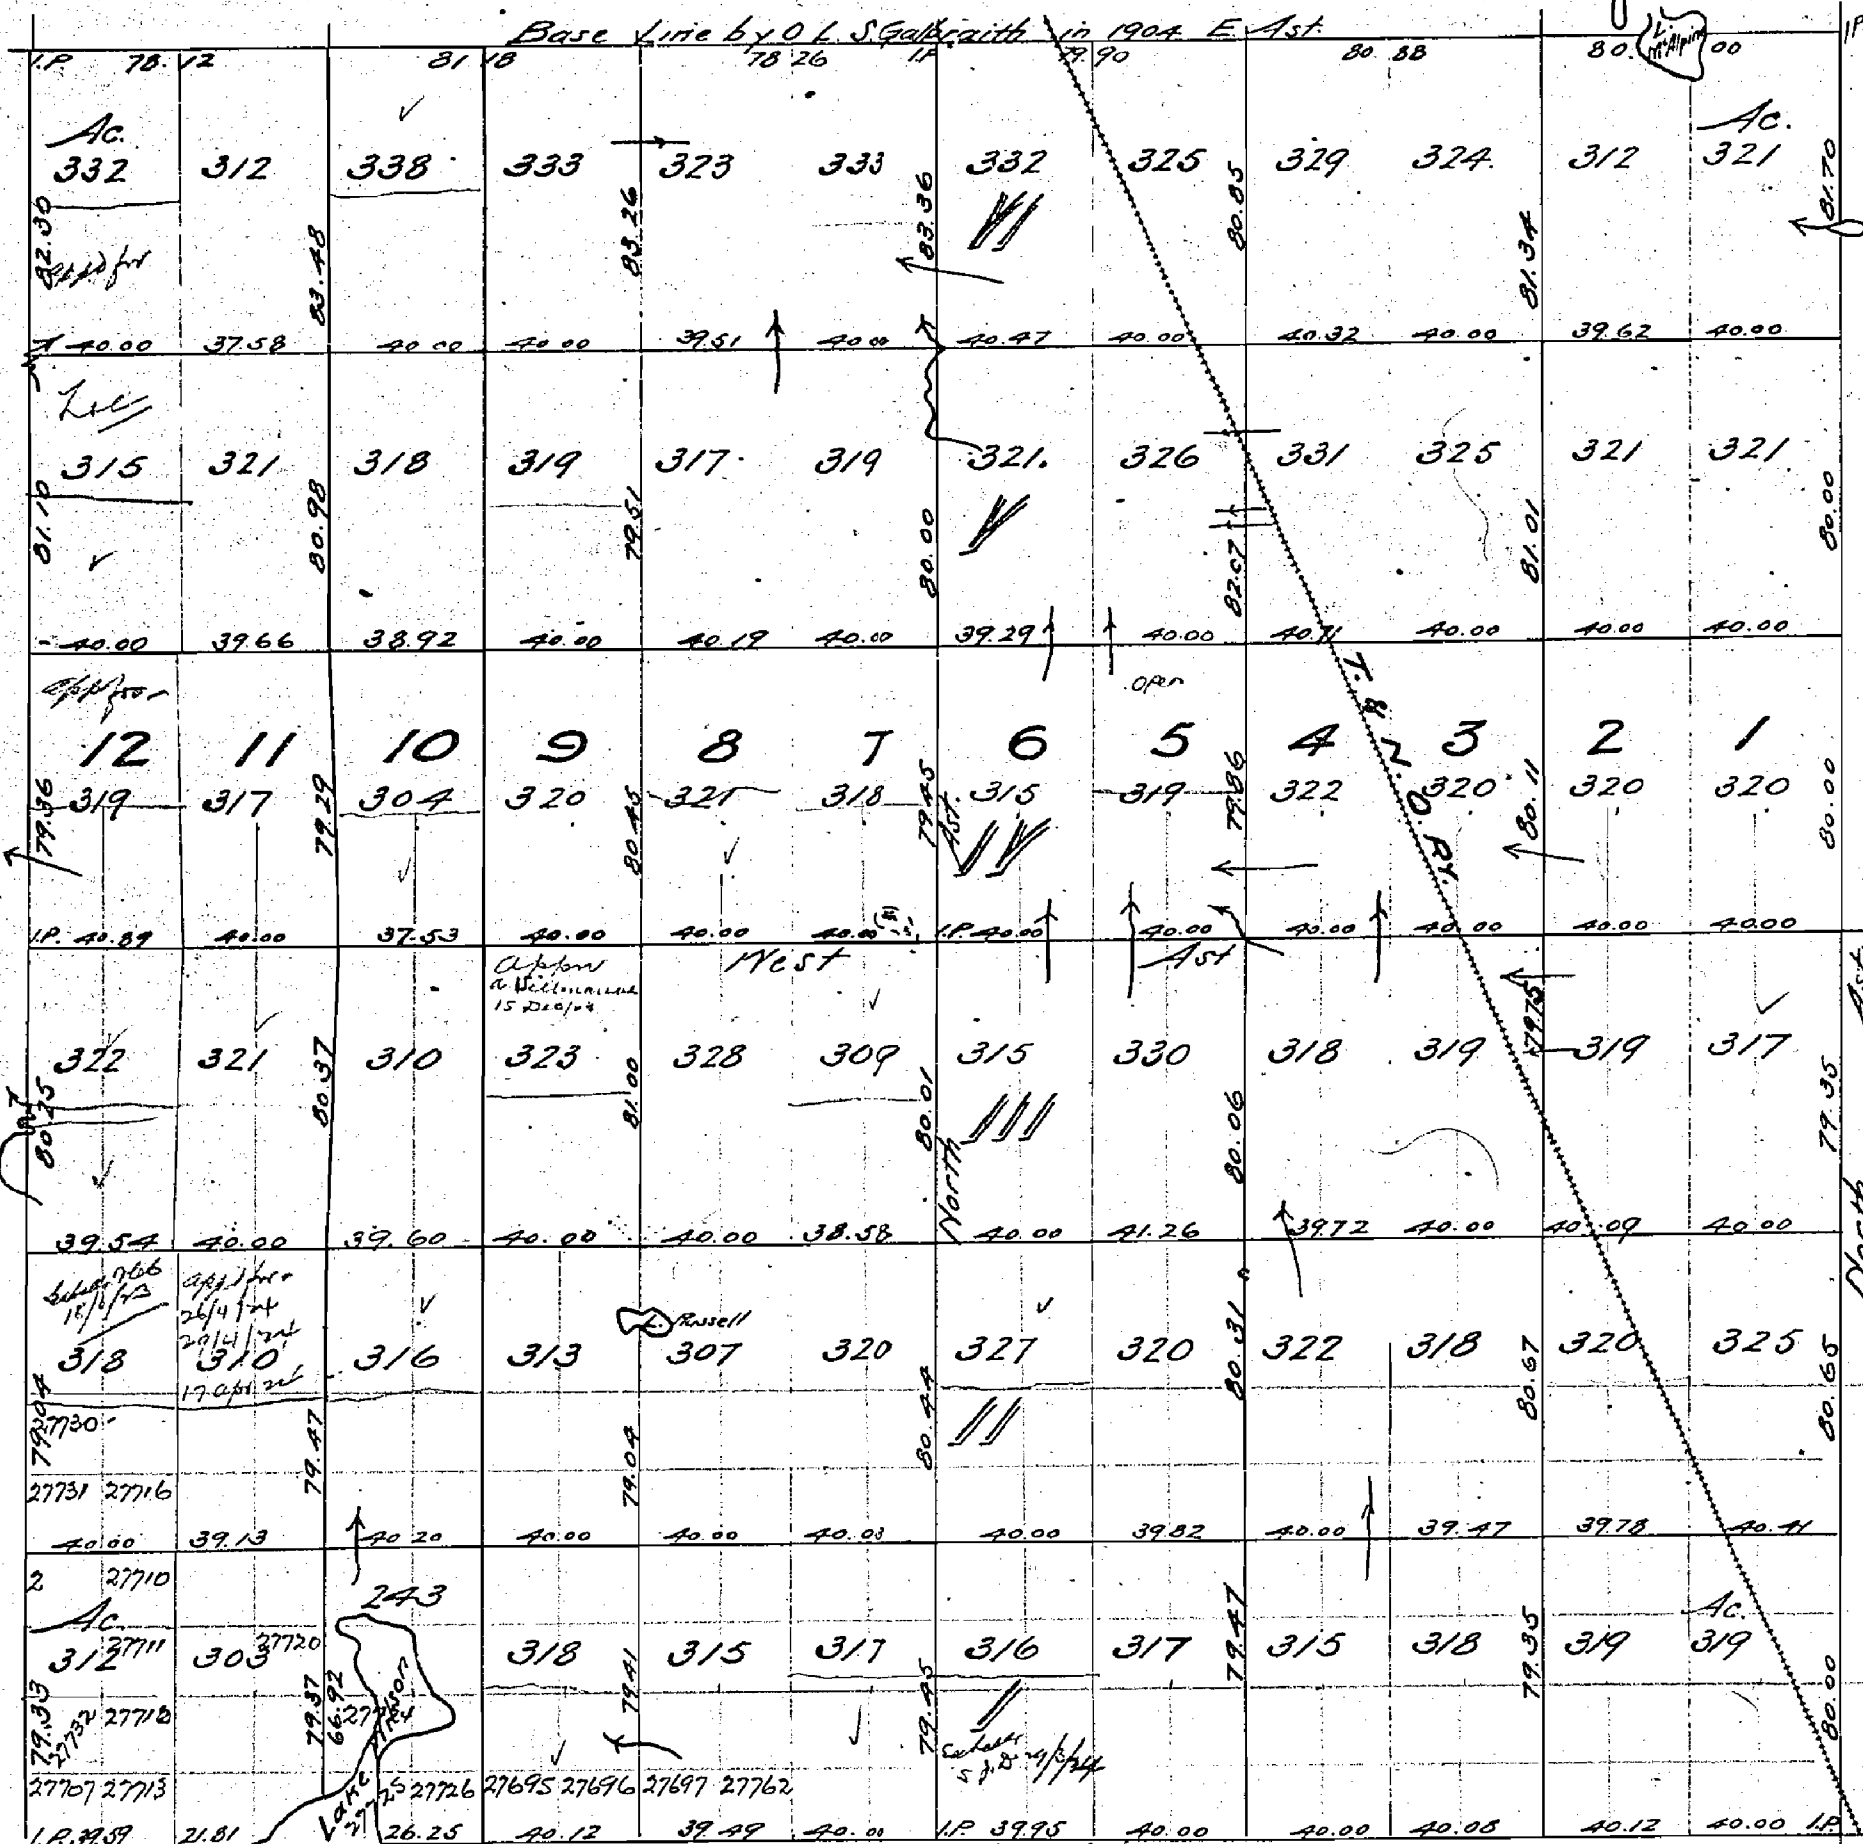


White C.L.S. before returning claim

McCart

557

St. John Twp.

Mann Twp.

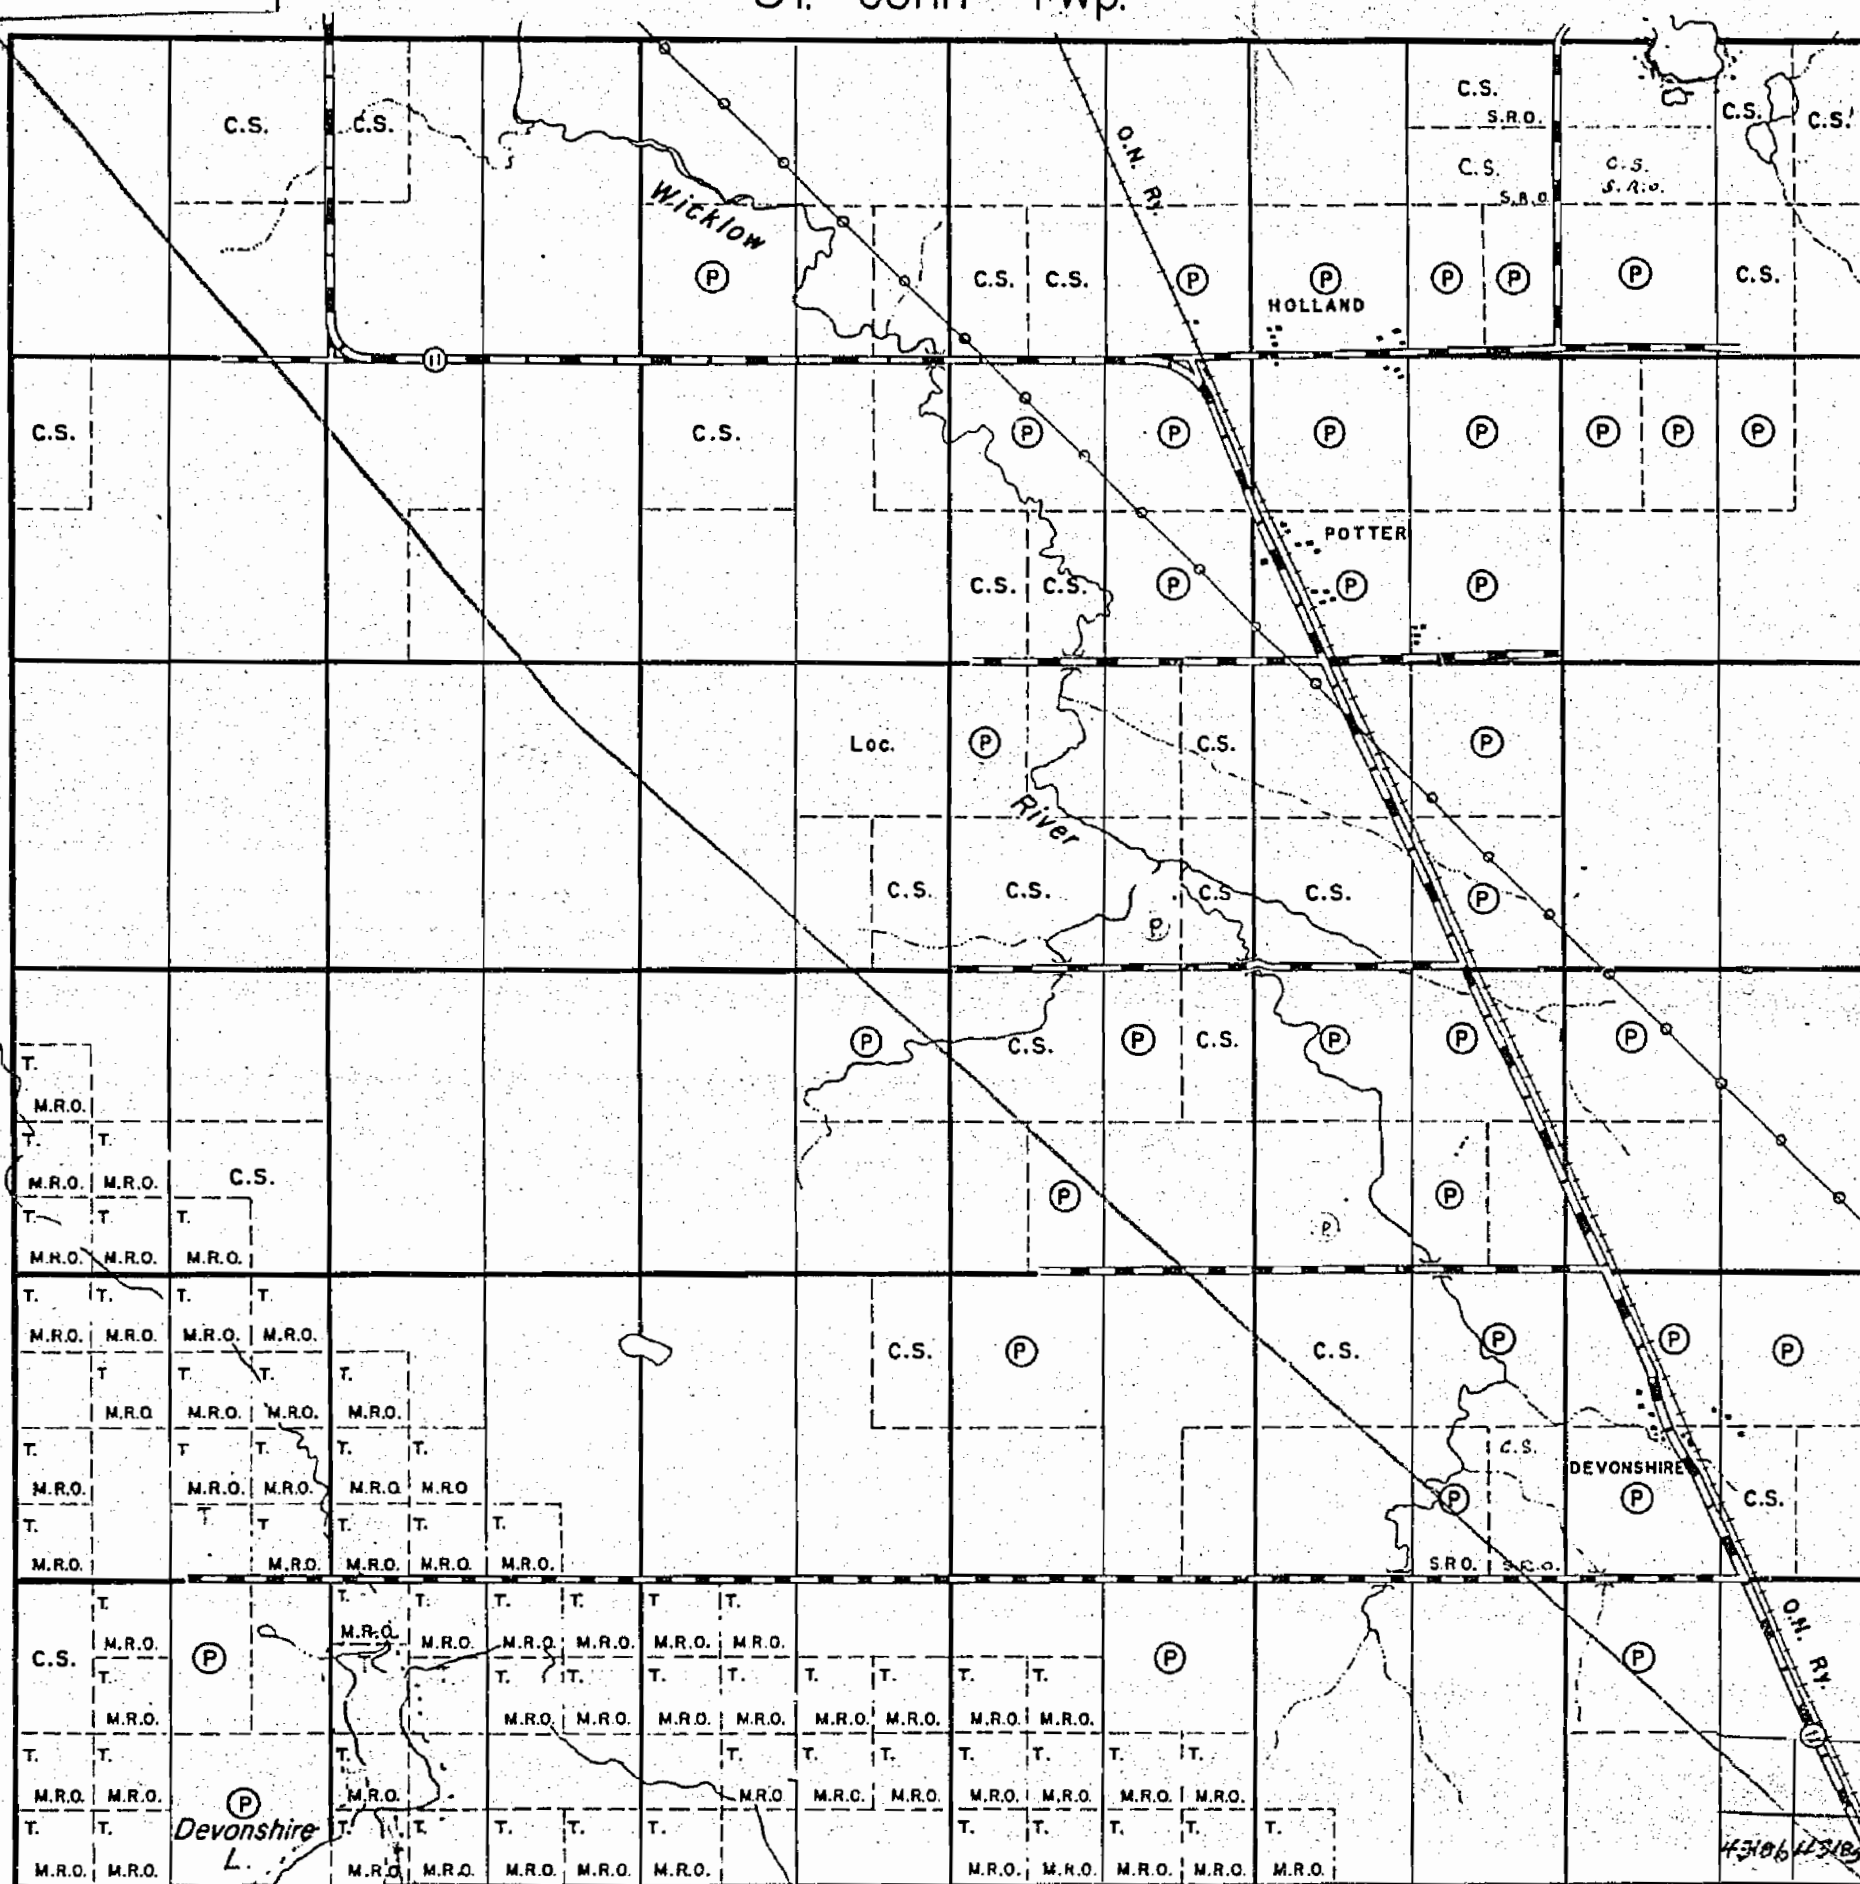

THE TOWNSHIP OF NEWMARKET

DISTRICT OF
COCHRANEPORCUPINE
MINING DIVISION

SCALE: 1-INCH = 40 CHAINS

LEGEND

PATENTED LAND	(P)
CROWN LAND SALE	C.S.
LEASES	(L)
LOCATED LAND	Loc.
LICENSE OF OCCUPATION	L.O.
ROADS	—
IMPROVED ROADS	—
RAILWAYS	—
POWER LINES	—
MARSH OR MUSKEG	—

NOTES

M.R.O. : Mineral Rights Only

Surface rights reserved on all lands staked
& patented after 21 May 1945 — See O.C.
25 April 1945:

By regulations passed previously, sale or
other disposition of land in this Township
has been limited to S.R.O. only: effective
May 2, 1950.

400' Rsvd. to Jeps. of L. & F.
north line

Increased
Natural Gas
Pine

PLAN NO. - M-557

DEPARTMENT OF MINES
— ONTARIO —