TRIM LINE


DAGLE TP. M.1379

WAGG TP. M.1378

OTTER TWP. - M.1325

JACKSON TP. M.1614

GOULD TWP. - M.455

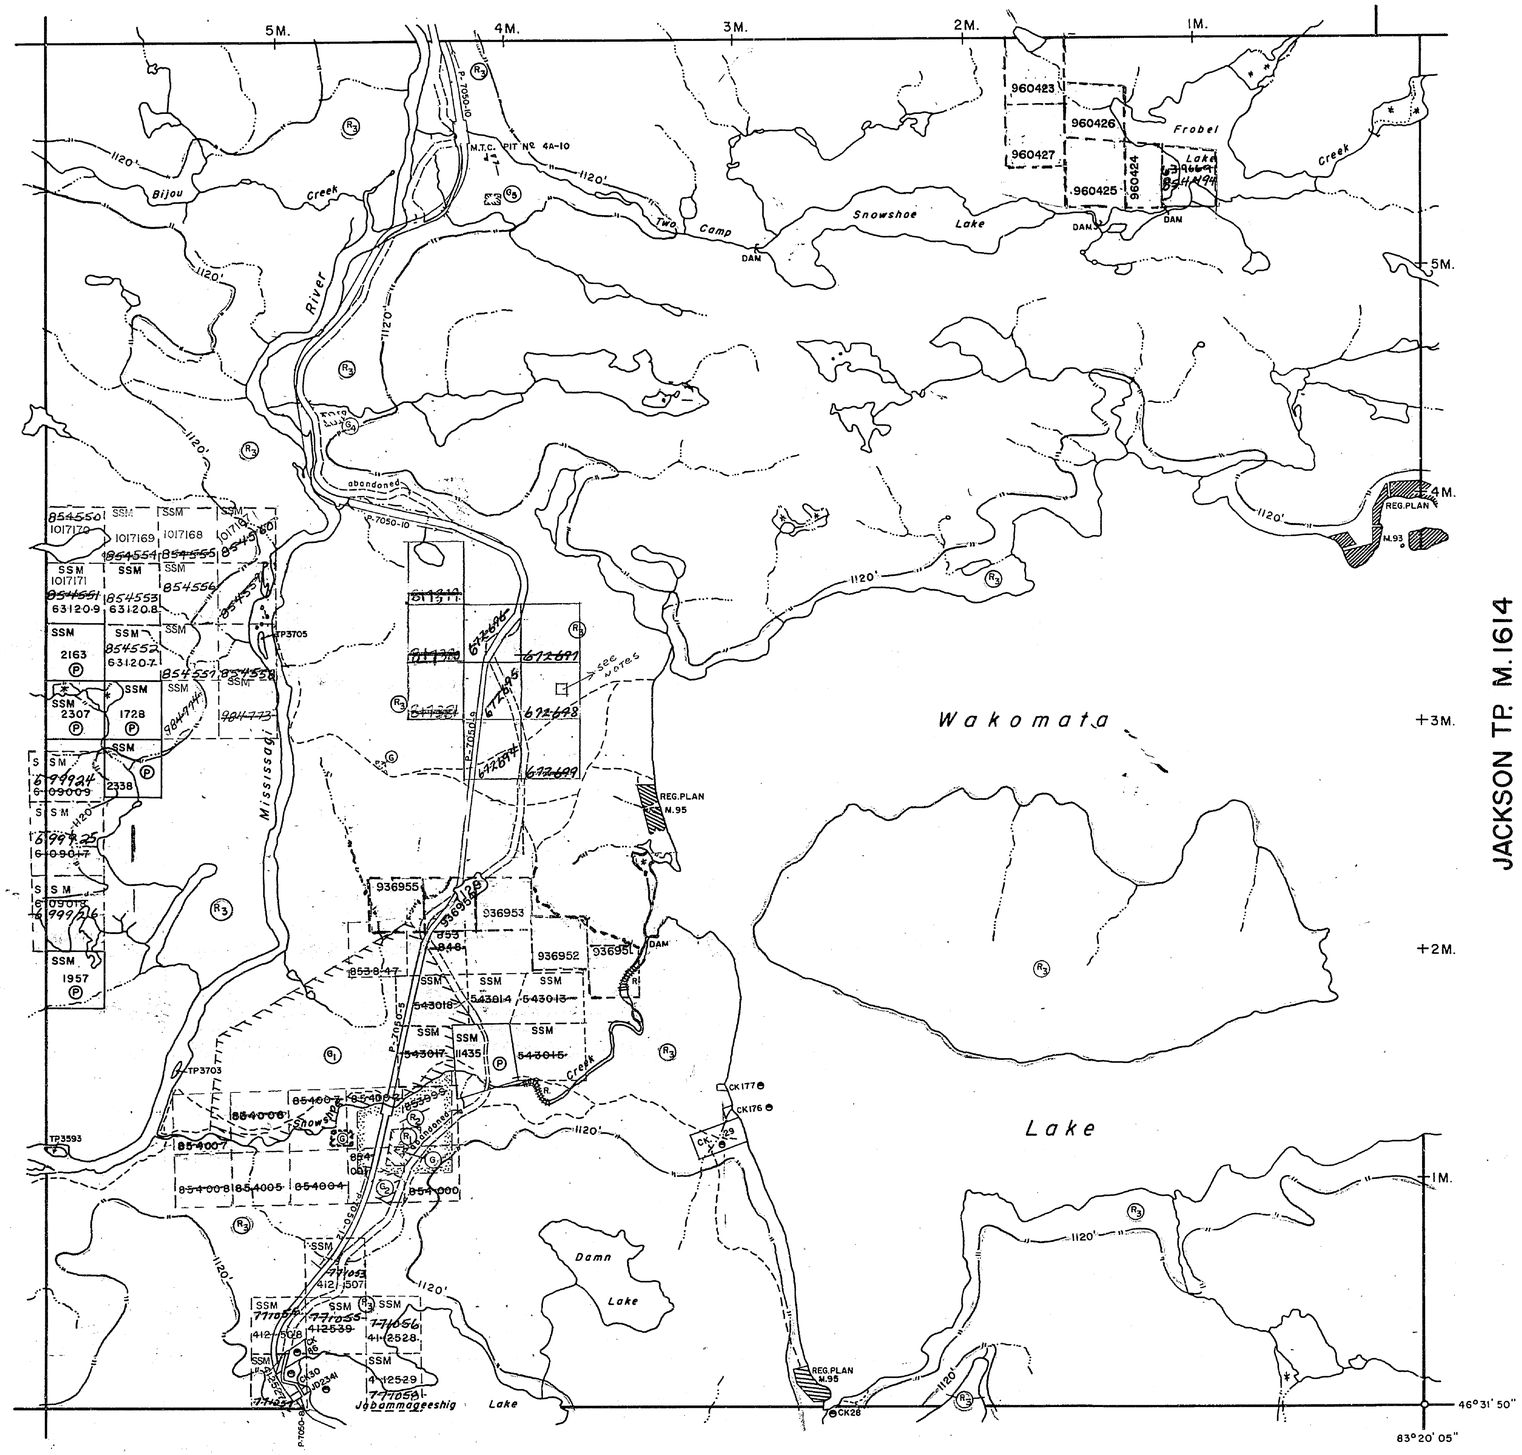

THE TOWNSHIP

CASSON

(Tp. 188)

DISTRICT OF
ALGOMA

SAULT STE. MARIE
MINING DIVISION

SCALE: 1-INCH = 40 CHAINS

LEGEND

PATENTED LAND	(P)
CROWN LAND SALE	C.S.
LEASES	(L)
LOCATED LAND	Loc.
LICENSE OF OCCUPATION	L.O.
MINING RIGHTS ONLY	M.R.O.
SURFACE RIGHTS ONLY	S.R.O.
ROADS	
IMPROVED ROADS	
KING'S HIGHWAYS	
RAILWAYS	
POWER LINES	
MARSH OR MUSKEG	
MINES	
CANCELLED	C.

NOTE - Quarry permit for this rock has been issued. Any claims staked will be subject to the O.P. #00458.

NOTES

400' surface rights reservation along the shores of all lakes and rivers.

Summer resort locations patented for surface rights only shown thus (P)

Flooding rights

-on Mississagi River reserved to contour 903' W.P.L.A. Nº 35 F. 5937 vol.4

OTHER AREAS WITHDRAWN FROM STAKING

S.R. - SURFACE RIGHTS M.R.-MINING RIGHTS

	Section	Order Nº	Date	Disposition	File
(R1)	Sec. 43 (R.S.O. '70)	W.7/79 SR	13/6/79	S.R.	
(R2)	Sec. 43 (R.S.O. '70)	W.6/79 SR	1/2/80	S.R.	
(R3)	Sec. 43 (R.S.O. '70)	W.10/80	30/7/80	S.R.	188505
	(Flooding to contour elevation 1120')				

SAND and GRAVEL

(G)	GRAVEL LOCATION
(G1)	M.T.C. PIT Nº 1587
(G2)	M.T.C. PIT Nº 1333
(G4)	M.T.C. PIT Nº 4A-11
(G5)	M.N.R. GRAVEL RESERVE Nº 4A-4

PLAN NO. ~~M.1615~~

ONTARIO
MINISTRY OF NATURAL RESOURCES
SURVEYS AND MAPPING BRANCH

SAULT STE. MARIE MINING DIV. RECEIVED MAR 8 1983 A.M. P.M.

applied by Co. 3266 August 1980

G.3266

b.k.

M.1615 TWP. 188 CASSON

Ministry of Natural Resources
Ontario

Ministry of Northern Development and Mines

INDEX TO LAND DISPOSITION

PLAN
G-3266

TOWNSHIP
CASSON

M.N.R. ADMINISTRATIVE DISTRICT
BLIND RIVER

MINING DIVISION
SAULT STE. MARIE

LAND TITLES/REGISTRY DIVISION
ALGOMA

Scale 1:20 000

1000 Metres 0 1000 2000 Metres

1000 Feet 0 1000 2000 3000 4000 5000 6000 7000 8000 9000 10000 Feet

Contour Interval 10 Metres

SYMBOLS

- Boundary
- Township, Meridian, Baseline
- Road allowance; surveyed
- shoreline
- Lot/Concession; surveyed
- unsurveyed
- Parcel; surveyed
- unsurveyed
- Right-of-way; road
- railway
- utility
- Reservation
- Cliff, Pit, Pile
- Contour (20)
- Interpolated
- Approximate
- Depression
- Control point (horizontal)
- Flooded land
- Mine head frame
- Pipeline (above ground)
- Railway; single track
- double track
- abandoned
- Road; highway, county, township
- access
- trail, bush
- Shoreline (original)
- Transmission line
- Wooded area

AREAS WITHDRAWN FROM DISPOSITION

MRO - Mining Rights Only
SRO - Surface Rights Only
M & S - Mining and Surface Rights

Description	Order No.	Date	Disposition	File
SEC. 36(R.S.O. 1980)	W6/75BR	13/6/79	SRO	
SEC. 36(R.S.O. 1980)	W6/79BR	1/2/80	SRO	
SEC. 36(R.S.O. 1980)	W10/80	30/7/80	SRO	188505

(FLOODING TO CONTOUR ELEVATION 1120')

DISPOSITION OF CROWN LANDS

Patent
- Surface & Mining Rights
- Surface Rights Only
- Mining Rights Only

Lease
- Surface & Mining Rights
- Surface Rights Only
- Mining Rights Only

- Licence of Occupation
- Order-in-Council (OC)
- Cancelled
- Reservation (R)
- Sand & Gravel (S)

NOTES

FLOODING RIGHTS ON MISSISSAGI RIVER RESERVED TO CONTOUR 903' W.P.L.A. Nº 35 FILE 5937 vol. 4

THE INFORMATION THAT APPEARS ON THIS MAP HAS BEEN COMPILED FROM VARIOUS SOURCES, AND ACCURACY IS NOT GUARANTEED. THOSE WISHING TO STAKE MINING CLAIMS SHOULD CONSULT WITH THE MINING RECORDER, MINISTRY OF NORTHERN DEVELOPMENT AND MINES, FOR ADDITIONAL INFORMATION ON THE STATUS OF THE LANDS SHOWN HEREON.

RECEIVED
NOV 25 1988
A.M. P.M.

Map base and land disposition drafting by Surveys and Mapping Branch, Ministry of Natural Resources.

The disposition of land, location of lot fabric and parcel boundaries on this index was compiled for administrative purposes only.

G-3566



Ministry of Natural Resources
Ontario

Ministry of Northern Development and Mines

INDEX TO LAND DISPOSITION

PLAN
G-3266

TOWNSHIP
CASSON

DATE OF ISSUE
JUN 04 1998
PROVINCIAL RECORDING OFFICE - SUDBURY

M.N.R. ADMINISTRATIVE DISTRICT
BLIND RIVER

MINING DIVISION
SAULT STE. MARIE

LAND TITLES/REGISTRY DIVISION
ALGOMA

Scale 1:20 000

Metres 1000 0 1000 2000 Metres

Feet 1000 0 1000 2000 3000 4000 5000 6000 7000 8000 9000 10000

Contour Interval 10 Metres

SYMBOLS

Boundary
- Township, Meridian, Baseline
- Road allowance; surveyed / shoreline
- Lot/Concession; surveyed / unsurveyed
- Parcel; surveyed / unsurveyed
- Right-of-way; road / railway / utility
- Reservation
- Cliff, Pile
- Contour — 20 — ; Interpolated; Approximate; Depression
- Control point (horizontal) △
- Flooded land
- Mine head frame
- Pipeline (above ground)
- Railway; single track / double track / abandoned
- Road; highway, county, township / access / trail, bush
- Shoreline (original)
- Transmission line
- Wooded area

AREAS WITHDRAWN FROM DISPOSITION

MRO - Mining Rights Only
SRO - Surface Rights Only
M & S - Mining and Surface Rights

Description	Order No.	Date	Disposition	File
(M) SEC. 36(R.S.O. 1980)	W6/7978	13/6/79	SRO	
(M) SEC. 36(R.S.O. 1980)	W6/7978	1/2/80	SRO	
(M) SEC. 36(R.S.O. 1980)	W10/80	30/7/80	SRO	186505

(FLOODING TO CONTOUR ELEVATION 1120')

NOTES

FLOODING RIGHTS ON MISSISSAGI RIVER RESERVED TO CONTOUR 903'
W.P.L.A. Nº 35 FILE 5937 vol. 4

DISPOSITION OF CROWN LANDS

Patent
- Surface & Mining Rights
- Surface Rights Only
- Mining Rights Only

Lease
- Surface & Mining Rights
- Surface Rights Only
- Mining Rights Only

- Licence of Occupation
- Order-in-Council OC
- Cancelled
- Reservation (R)
- Sand & Gravel (S)

The 1980 Magnetic Bearing
Approx. 7°W
Annual Change
Increasing 0'

THE INFORMATION THAT APPEARS ON THIS MAP HAS BEEN COMPILED FROM VARIOUS SOURCES, AND ACCURACY IS NOT GUARANTEED. THOSE WISHING TO STAKE MINING CLAIMS SHOULD CONSULT WITH THE MINING RECORDER, MINISTRY OF NORTHERN DEVELOPMENT AND MINES, FOR ADDITIONAL INFORMATION ON THE STATUS OF THE LANDS SHOWN HEREON.

RECEIVED
JUN 25 1998
MINING LANDS SECTION

Mapping and land disposition drafting by Surveys and Mapping Branch, Ministry of Natural Resources

The disposition of land, location of lot fabric and parcel boundaries on this index was compiled for administrative purposes only.

CA20201 N022 SWT

G-3256

Ministry of Natural Resources
Ministry of Northern Development and Mines
Ontario

INDEX TO LAND DISPOSITION

PLAN
G-3256

TOWNSHIP
CASSON

M.N.R. ADMINISTRATIVE DISTRICT
BLIND RIVER

MINING DIVISION
SAULT STE. MARIE

LAND TITLES/REGISTRY DIVISION
ALGOMA

Scale 1:20 000

1000 0 1000 Metres
3000 0 1000 2000 3000 4000 5000 6000 7000 8000 9000 10000 Feet

Contour Interval 10 Metres

SYMBOLS

Boundary
- Township, Meridian, Baseline
- Road allowance; surveyed
- shoreline
- Lot/Concession; surveyed
- unsurveyed
- Parcel; surveyed
- unsurveyed
- Right-of-way; road
- railway
- utility
- Reservation
- Cliff, Pile
- Contour
- Interpolated
- Approximate
- Depression
- Control point (horizontal)
- Flooded land
- Mine head frame
- Pipeline (above ground)
- Railway; single track
- double track
- abandoned
- Road; highway, county, township
- access
- trail, bush
- Shoreline (original)
- Transmission line
- Wooded

AREAS WITHDRAWN FROM DISPOSITION

MRO - Mining Rights Only
SRO - Surface Rights Only
M & S - Mining and Surface Rights

Description	Order No.	Date	Disposition	File
SEC. 36(R.S.O. 1960)	W6/7988	13/6/79	SRO	
SEC. 36(R.S.O. 1980)	W6/7988	1/2/80	SRO	
SEC. 36(R.S.O. 1980)	W10/80	30/7/80	SRO	168505

(FLOODING TO CONTOUR ELEVATION 1120')

NOTES

FLOODING RIGHTS ON MISSISSAGI RIVER RESERVED TO CONTOUR 90
W.P.L.A. Nº 35 FILE 5937 vol.4

DISPOSITION OF CROWN LANDS

Patent
- Surface & Mining Rights
- Surface Rights Only
- Mining Rights Only

Lease
- Surface & Mining Rights
- Surface Rights Only
- Mining Rights Only

- Licence of Occupation
- Order-in-Council
- Cancelled
- Reservation
- Sand & Gravel

THE INFORMATION THAT APPEARS ON THIS MAP HAS BEEN COMPILED FROM VARIOUS SOURCES, AND ACCURACY IS NOT GUAHANTEED. THOSE WISHING TO STAKE MINING CLAIMS SHOULD CONSULT WITH THE MINING RECORDER, MINISTRY OF NORTHERN DEVELOPMENT AND MINES, FOR ADDITIONAL INFORMATION ON THE STATUS OF THE LANDS SHOWN HEREON.

The 1980 Magnetic Bearing
Approx. 7.5° W, Annual Change
Decreasing 2'

NOV 25 1980
MINISTRY OF NATURAL RESOURCES

Mapping and land disposition drafting by Surveys and Mapping Branch, Ministry of Natural Resources, 1980

The disposition of land, location of lot fabric and parcel boundaries on this index was compiled for administrative purposes only.

G-3256
SMT M2252

TRIM LINE

DAGLE TP. M.1379

wagg tp. M.1378

OTTER TWP. - M.1325

JACKSON TP. M.1614

GOULD TWP. - M.455

THE TOWNSHIP

CASSON

(Tp. 188)

DISTRICT OF
ALGOMA

SAULT STE. MARIE
MINING DIVISION

SCALE: 1-INCH = 40 CHAINS

LEGEND

PATENTED LAND	Ⓟ
CROWN LAND SALE	C.S.
LEASES	Ⓛ
LOCATED LAND	Loc.
LICENSE OF OCCUPATION	L.O.
MINING RIGHTS ONLY	M.R.O.
SURFACE RIGHTS ONLY	S.R.O.
ROADS	
IMPROVED ROADS	
KING'S HIGHWAYS	
RAILWAYS	
POWER LINES	
MARSH OR MUSKEG	
MINES	
CANCELLED	C.

NOTES

400' surface rights reservation along the shores of all lakes and rivers.

Summer resort locations patented for surface rights only shown thus Ⓟ

Flooding rights

–on Mississagi River reserved to contour 903'
W.P.L.A. N° 35 F. 5937 vol.4

OTHER AREAS WITHDRAWN FROM STAKING

S.R. – SURFACE RIGHTS M.R.–MINING RIGHTS

	Section	Order N°	Date	Disposition	File
(R1)	Sec. 43 (R.S.O.'70)	W.1/79 BR	13/6/79	S.R.	
(R2)	Sec. 43 (R.S.O.'70)	W.6/79 BR	1/2/80	S.R.	
(R3)	Sec. 43 (R.S.O.'70) (Flooding to contour elevation 1120')	W.10/80	30/7/80	S.R.	188505

SAND and GRAVEL

- (G) GRAVEL LOCATION
- (G1) M.T.C. PIT N° 1567
- (G2) M.T.C. PIT N° 1333
- (G3) M.T.C. PIT N° 4A-11
- (G4) M.N.R. GRAVEL RESERVE N° 4A-4

PLAN NO. M.1615

ONTARIO
MINISTRY OF NATURAL RESOURCES
SURVEYS AND MAPPING BRANCH


DATE OF ISSUE
NOV 10 19..

SAULT STE. MARIE MINING DIV. RECEIVED
MAR 8 1983

G.3266

TRIM LINE

G-3266

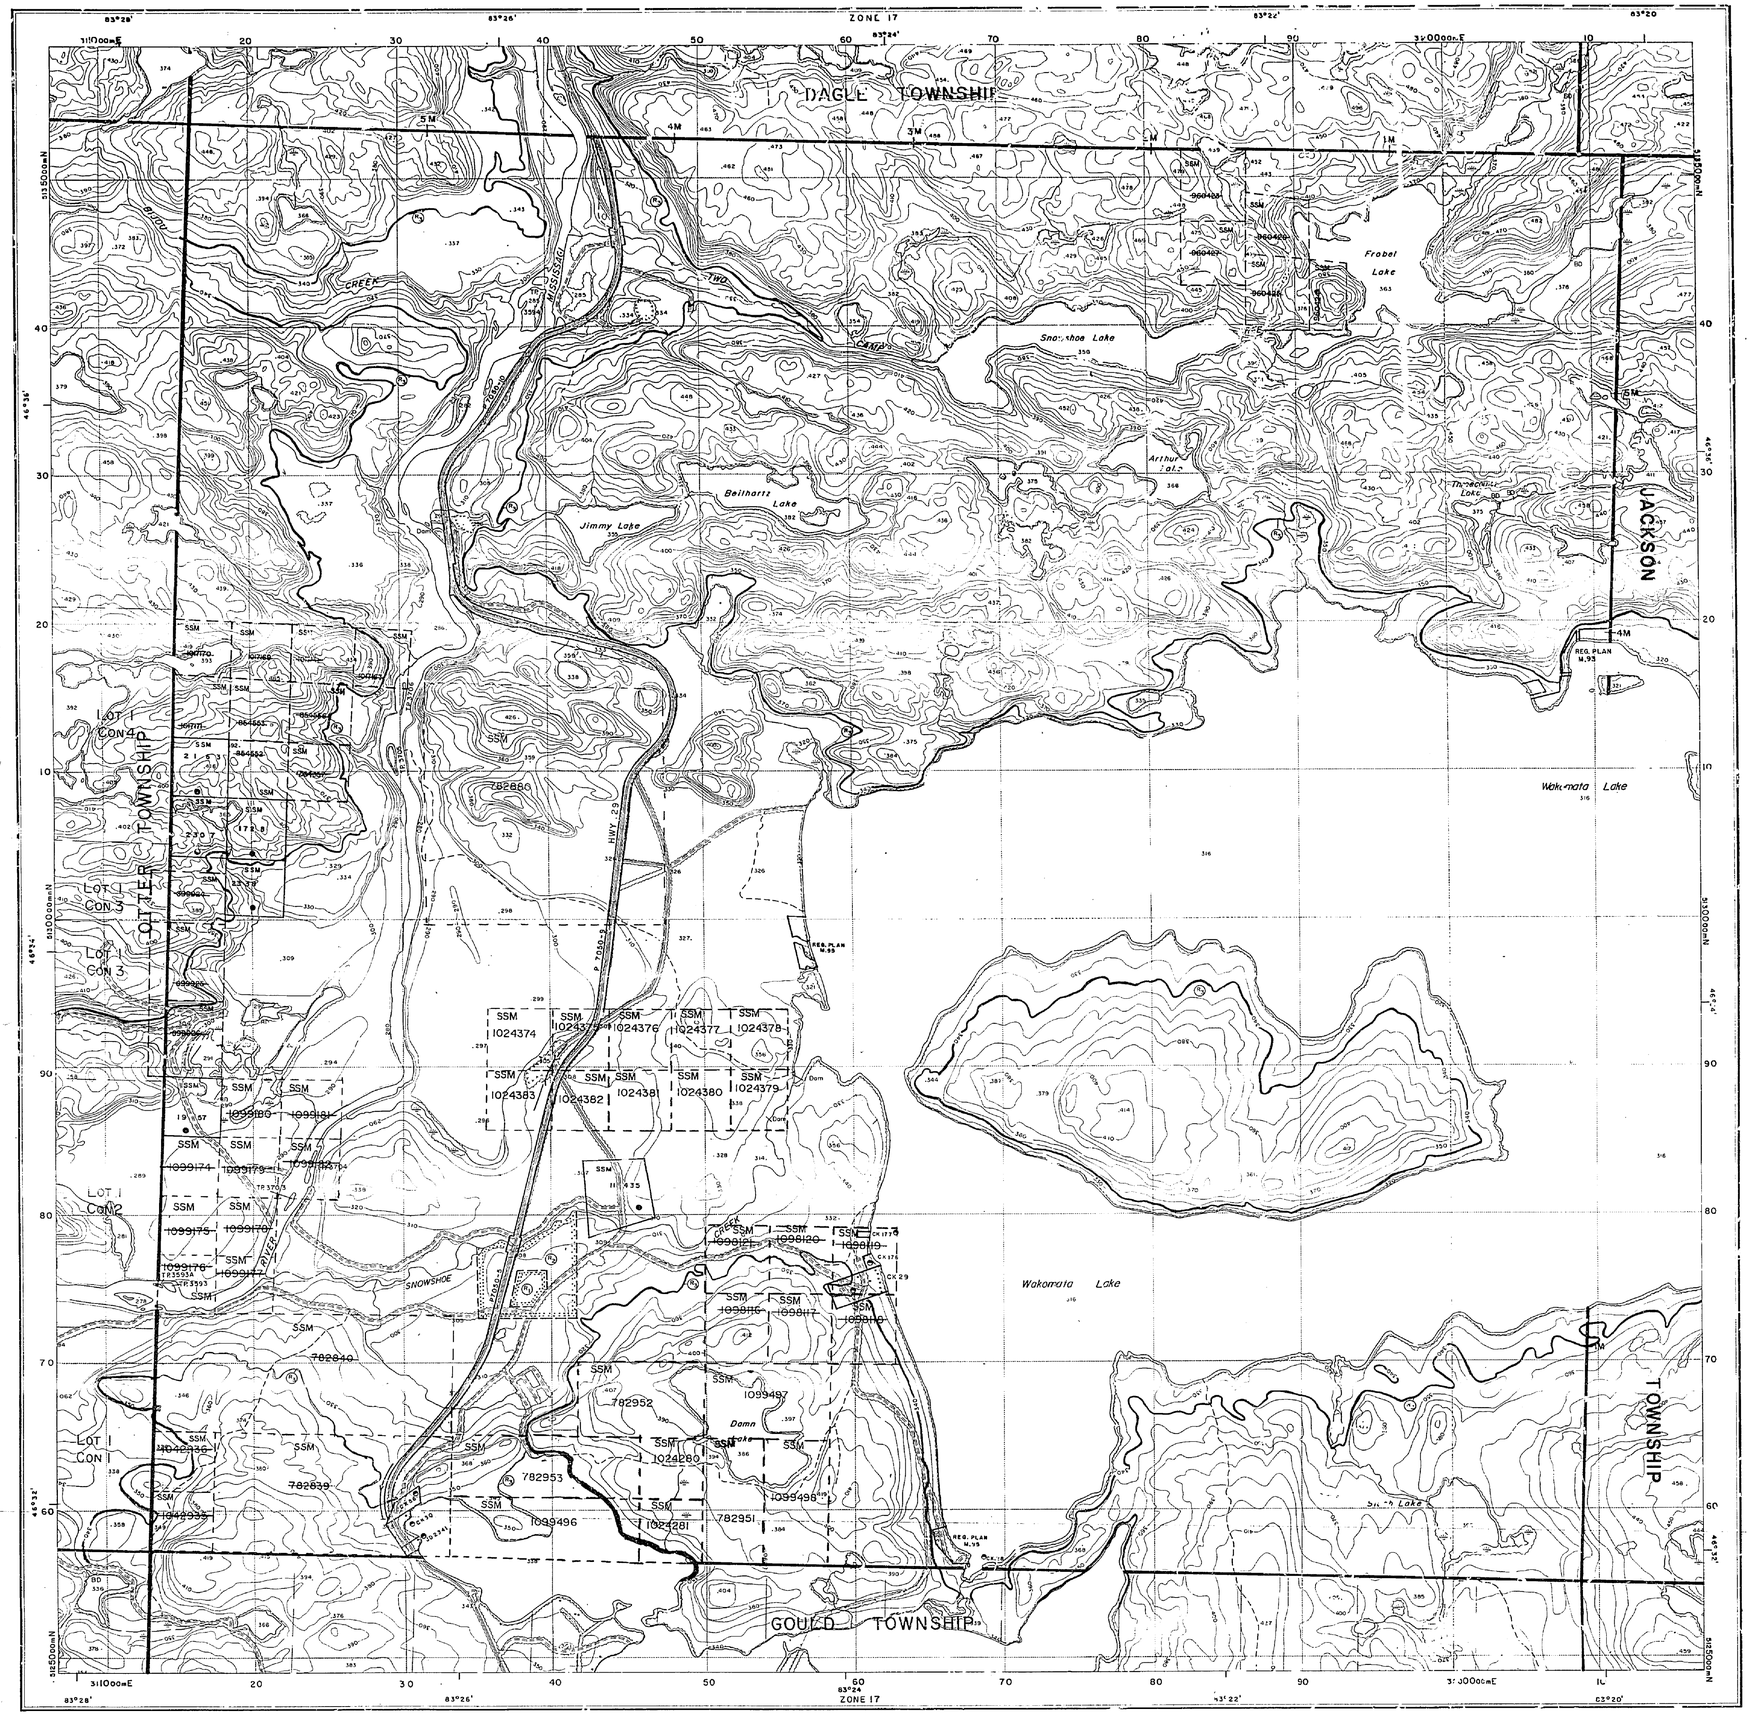

INDEX TO LAND DISPOSITION

PLAN

G-3266

TOWNSHIP

CASSON

M.N.R. ADMINISTRATIVE DISTRICT

BLIND RIVER

MINING DIVISION

SAULT STE. MARIE

LAND TITLES/REGISTRY DIVISION

ALGOMA

Scale 1:20 000

Metres 1000 0 1000 2000 Metres

Feet 1000 0 1000 2000 3000 4000 5000 6000 7000 8000 9000 10000 Feet

Contour Interval 10 Metres

SYMBOLS

- Boundary
- Township, Meridian, Baseline
- Road allowance; surveyed
  - shoreline
- Lot/Concession; surveyed
  - unsurveyed
- Parcel; surveyed
  - unsurveyed
- Right-of-way; road
  - railway
  - utility
- Reservation
- Cliff, Pit, Pile
- Contour — 20 —
- Interpolated
- Approximate
- Depression
- Control point (horizontal) △
- Flooded land
- Mine head frame
- Pipeline (above ground)
- Railway; single track
  - double track
  - abandoned
- Road; highway, county, township
  - access
  - trail, bush
- Shoreline (original)
- Transmission line
- Wooded area

AREAS WITHDRAWN FROM DISPOSITION

MRO - Mining Rights Only
SRO - Surface Rights Only
M & S - Mining and Surface Rights

	Description	Order No.	Date	Disposition	File
(M)	SEC. 35(R.S.O. 1980)	W9/79BR	13/6/79	SRO	
(S)	SEC. 35(R.S.O. 1980)	W6/79BR	1/2/80	SRO	
(S)	SEC. 35(R.S.O. 1980)	W10/80	30/7/80	SRO	188505

(FLOODING TO CONTOUR ELEVATION 1120')

DISPOSITION OF CROWN LANDS

Patent
- Surface & Mining Rights ●
- Surface Rights Only ◓
- Mining Rights Only ◒

Lease
- Surface & Mining Rights ▣
- Surface Rights Only ◨
- Mining Rights Only ◧

- Licence of Occupation ▼
- Order-in-Council OC
- Cancelled ⊗
- Reservation Ⓡ
- Sand & Gravel Ⓢ

NOTES

FLOODING RIGHTS ON MISSISSAGI RIVER RESERVED TO CONTOUR 903'
W.P.L.A. Nº 35 FILE 5937 vol.4

THE INFORMATION THAT APPEARS ON THIS MAP HAS BEEN COMPILED FROM VARIOUS SOURCES, AND ACCURACY IS NOT GUARANTEED. THOSE WISHING TO STAKE MINING CLAIMS SHOULD CONSULT WITH THE MINING RECORDER, MINISTRY OF NORTHERN DEVELOPMENT AND MINES, FOR ADDITIONAL INFORMATION ON THE STATUS OF THE LANDS SHOWN HEREON.

Ministry of Natural Resources — Ontario

Ministry of Northern Development and Mines

Map base and land disposition drafting by Surveys and Mapping Branch, Ministry of [illegible]

The disposition of land, location of lot fabric and parcel boundaries on this index was compiled for administrative purposes only.

3-3566

CASSON TWP. NO 232

Ministry of Natural Resources
Ontario

Ministry of Northern Development and Mines

INDEX TO LAND DISPOSITION

PLAN
G-3266

TOWNSHIP
CASSON

M.N.R. ADMINISTRATIVE DISTRICT
BLIND RIVER

MINING DIVISION
SAULT STE. MARIE

LAND TITLES/REGISTRY DIVISION
ALGOMA

Scale 1:20 000

Metres 0 1000 2000 Metres

Feet 0 1000 2000 3000 4000 5000 6000 7000 8000 9000 10000 Feet

Contour Interval 10 Metres

SYMBOLS

- Boundary
- Township, Meridian, Baseline
- Road allowance; surveyed
  - shoreline
- Lot/Concession; surveyed
  - unsurveyed
- Parcel; surveyed
  - unsurveyed
- Right-of-way; road
  - railway
  - utility
- Reservation
- Cliff, Pile
- Contour
  - interpolated
  - approximate
  - depression
- Control point (horizontal)
- Flooded land
- Mine head frame
- Pipeline (above ground)
- Railway; single track
  - double track
  - abandoned
- Road; highway, county, township
  - access
  - trail, bush
- Shoreline (original)
- Transmission line
- Wooded area

AREAS WITHDRAWN FROM DISPOSITION

MRO - Mining Rights Only
SRO - Surface Rights Only
M & S - Mining and Surface Rights

Description	Order No.	Date	Disposition	File
(W) SEC. 36(R.S.O. 1980)	W6/79BR	13/6/79	SRO	
(W) SEC. 36(R.S.O. 1980)	W6/79BR	1/2/80	SRO	
(W) SEC. 16(R.S.O. 1980)	W10/80	30/7/80	SRO	188505

(FLOODING TO CONTOUR ELEVATION 1 20')

DISPOSITION OF CROWN LANDS

- Patent
  - Surface & Mining Rights
  - Surface Rights Only
  - Mining Rights Only
- Lease
  - Surface & Mining Rights
  - Surface Rights Only
  - Mining Rights Only
- Licence of Occupation
- Order-in-Council (OC)
- Cancelled
- Reservation (R)
- Sand & Gravel (S)

The 1980 Magnetic Bearing
Approximately Annual Change
Increasing

NOTES

FLOODING RIGHTS ON MISSISSAGI RIVER RESERVED TO CONTOUR 903'
W.P.L.A. Nº 35 FILE 5937 vol.4

DATE OF ISSUE
SEP 08 1980
PROVINCIAL RECORDING OFFICE - SUDBURY

THE INFORMATION THAT APPEARS ON THIS MAP HAS BEEN COMPILED FROM VARIOUS SOURCES, AND ACCURACY IS NOT GUARANTEED. THOSE WISHING TO STAKE MINING CLAIMS SHOULD CONSULT WITH THE MINING RECORDER, MINISTRY OF NORTHERN DEVELOPMENT AND MINES, FOR ADDITIONAL INFORMATION ON THE STATUS OF THE LANDS SHOWN HEREON.

Mapping and land disposition drafting by Surveys and Mapping Branch

The disposition of land, location of lot fabric and parcel boundaries on this index was compiled for administrative purposes only.

3-3566

1516

OFFICE MAP

PLAN OF TWP. 188. (CASSON)

SAULT STE. MARIE MINING DIVISION.


DISTRICT OF ALGOMA.

M.164

Scale, 40 chains to an inch.

TWP. 1.F

OFFICE MAP

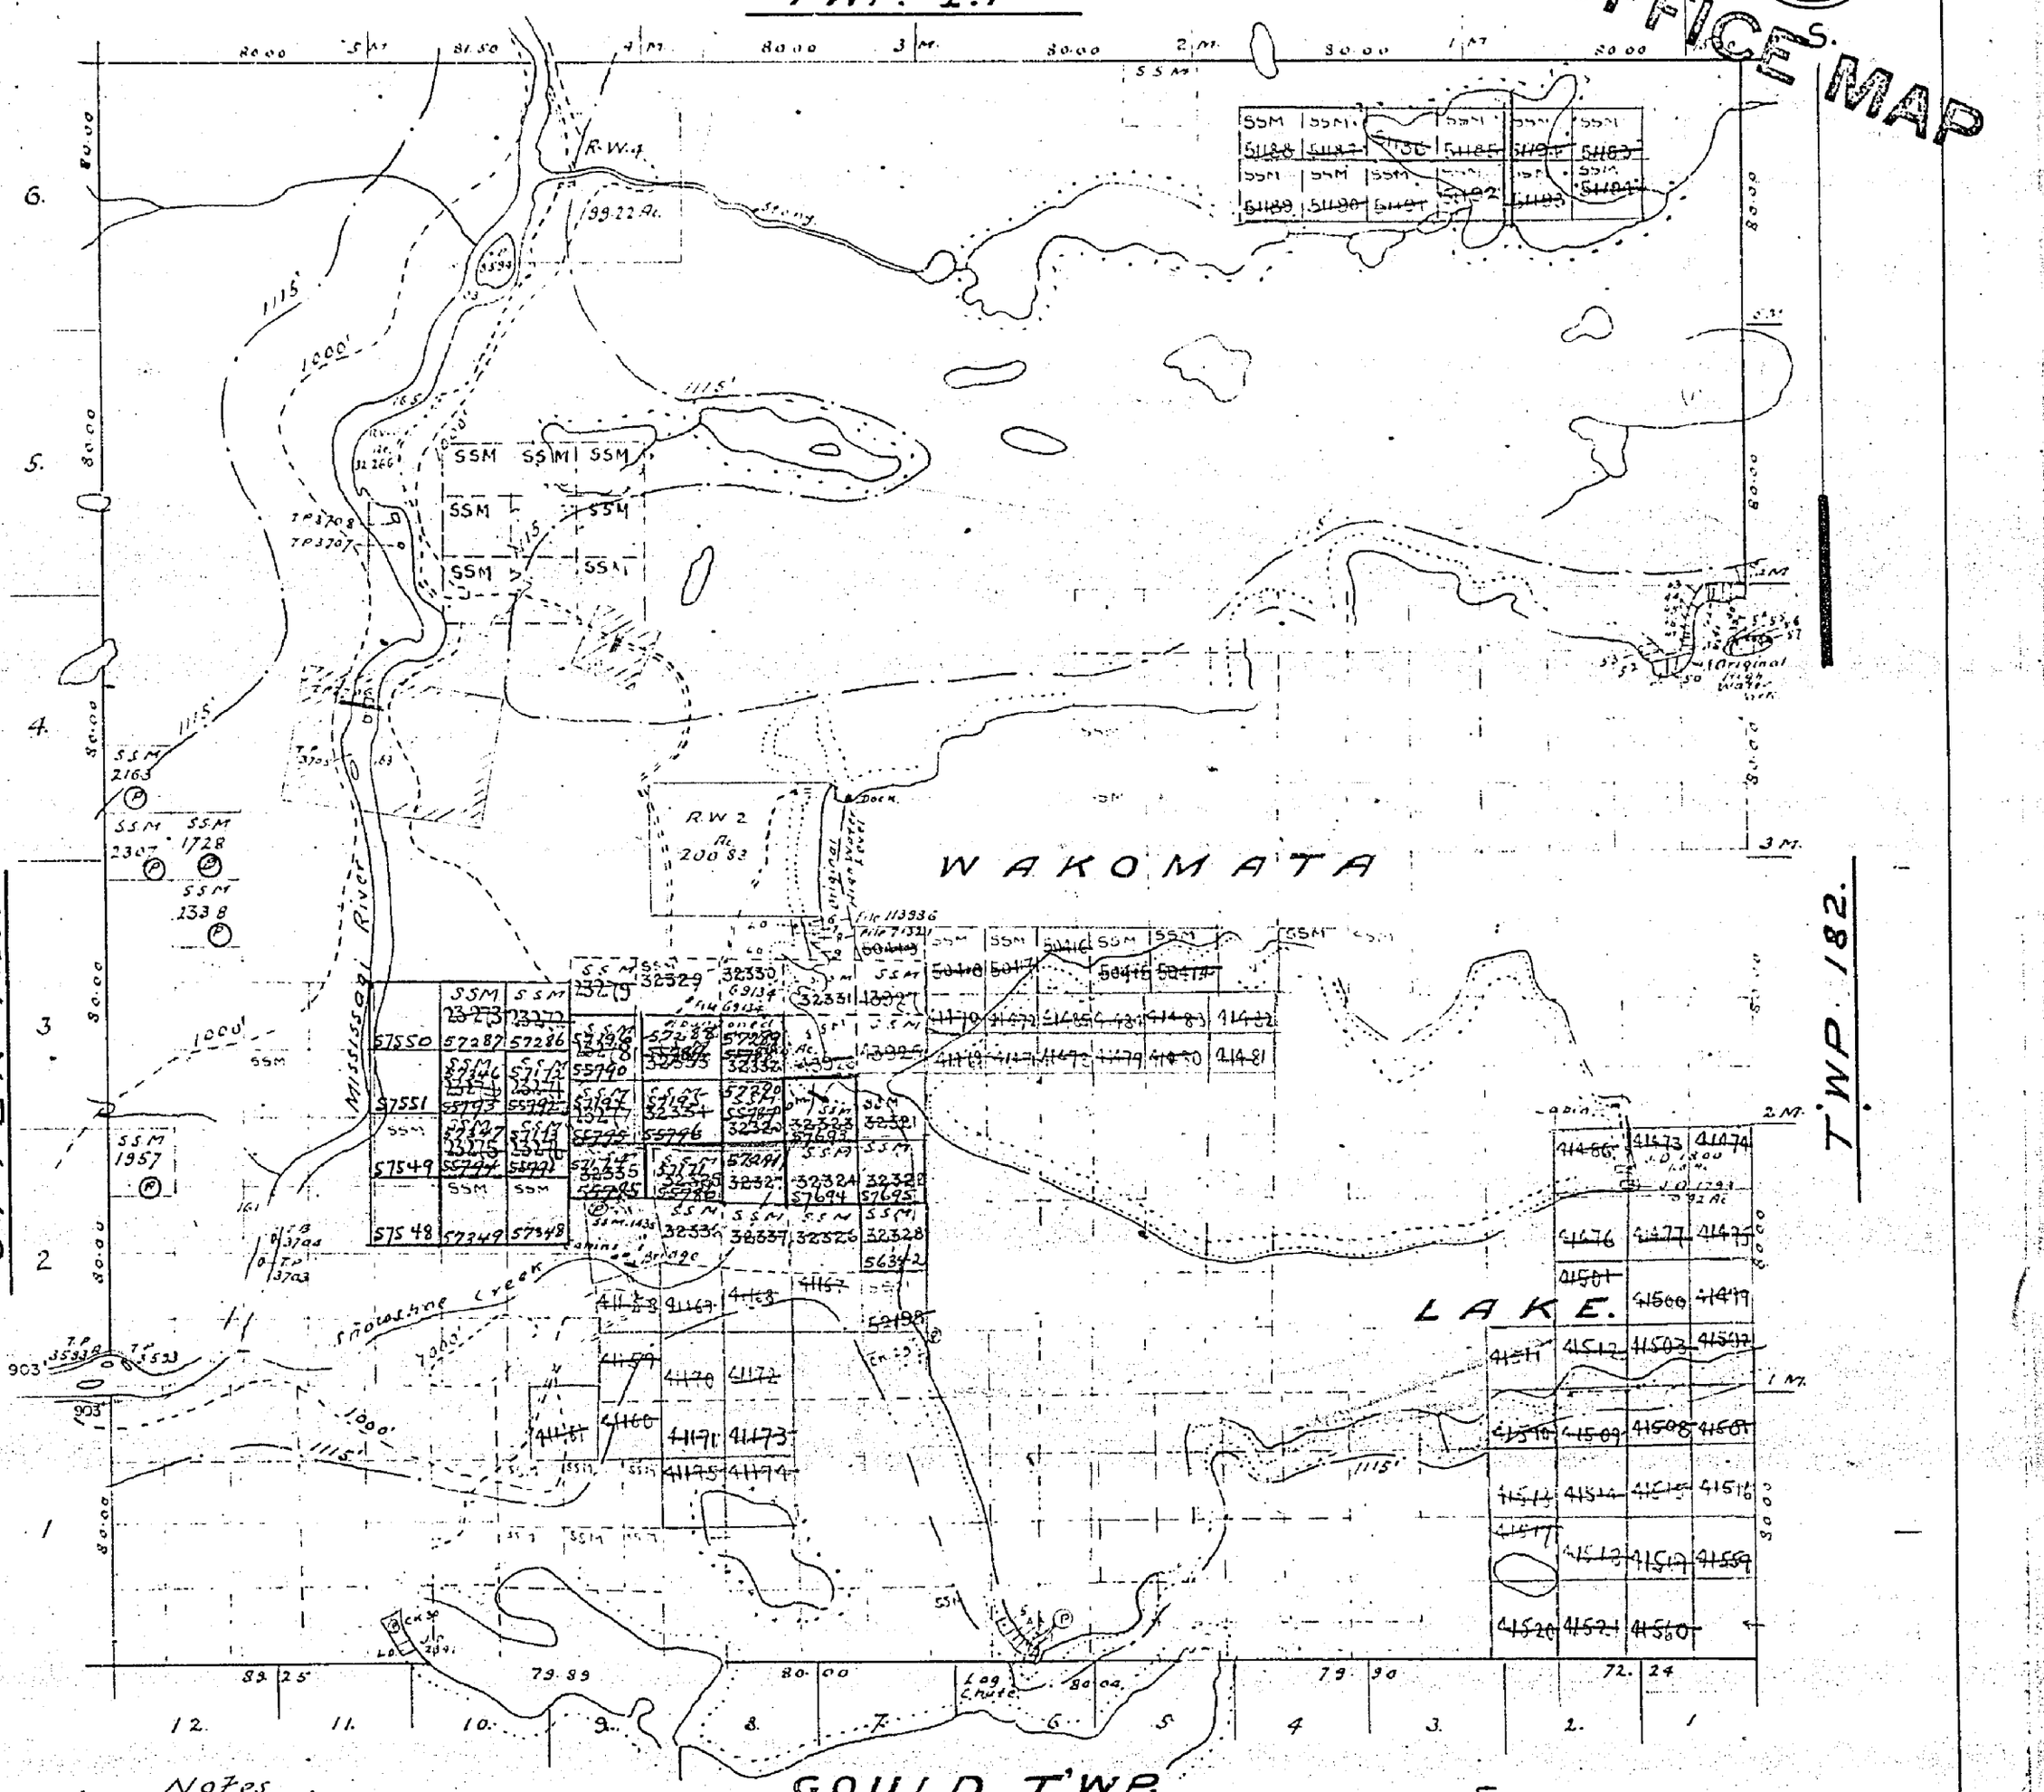

Notes.

Railways shewn
Paved Highways
Gravel
Highway Route No.1
Other Roads
Trails & Paths.
Telephone & Telegraph Lines
Electric Power Lines
Non-perennial Streams
Surface reservations 400' Radius by Dept. of L.S.F. shewn

Bridges
Buildings
Swamps.
Areas marked P are Patented
" " L " Leased
" " LO " held under Licence-of-Occupation
Areas with drawn from staking.
Flooding rights to H.E.P.C. to Contour 1115 shewn ——— 1115. ———
To 1120 G.S.C. File 5937

TOWNSHIP 188 N.-M. 1-881

DAGLE TP. M.1379

wagg tp. M.1378

OTTER TWP. - M.1325

JACKSON TP. M.1614

GOULD TWP. - M.455

THE TOWNSHIP

CASSON

(Tp. 188)

DISTRICT OF
ALGOMA

SAULT STE. MARIE
MINING DIVISION

SCALE: 1-INCH = 40 CHAINS

LEGEND

PATENTED LAND	(P)
CROWN LAND SALE	C.S.
LEASES	(L)
LOCATED LAND	Loc.
LICENSE OF OCCUPATION	L.O.
MINING RIGHTS ONLY	M.R.O.
SURFACE RIGHTS ONLY	S.R.O.
ROADS	
IMPROVED ROADS	
KING'S HIGHWAYS	
RAILWAYS	
POWER LINES	
MARSH OR MUSKEG	
MINES	
CANCELLED	C.

Note - Quarry Permit for This Block has been issued. Any claims staked will be subject to this O.P. #20958.

NOTES

400' surface rights reservation along the shores of all lakes and rivers.

Summer resort locations patented for surface rights only shown thus (P)

Flooding rights

- on Mississagi River reserved to contour 903' W.P.L.A. Nº 35 F 5937 vol.4

OTHER AREAS WITHDRAWN FROM STAKING

S.R. - SURFACE RIGHTS M.R.-MINING RIGHTS

	Section	Order Nº	Date	Disposition	File
R1	Sec. 42 (R.S.O.'70)	W.11/79 BR	13/6/79	S.R.	
R2	Sec. 43 (R.S.O.'70)	W.6/79 BR	1/2/80	S.R.	
R3	Sec. 43 (R.S.O.'70)	W.10/80	30/7/80	S.R.	188505
	(Flooding to contour elevation 1120')				

SAND and GRAVEL

- G GRAVEL LOCATION
- G1 M.T.C. PIT Nº 1587
- G2 M.T.C. PIT Nº 1333
- G3 M.T.C. PIT Nº 4A-II
- G4 M.N.R. GRAVEL RESERVE Nº 4A-4

PLAN NO. M.1615

ONTARIO
MINISTRY OF NATURAL RESOURCES
SURVEYS AND MAPPING BRANCH

DATE OF ISSUE
JUL 21 1995
SAULT STE MARIE
MINING RECORDER'S OFFICE

SAULT STE. MARIE
MINING DIV.
RECEIVED
MAR 8 1983
A.M. 7 8 9 10 11 12 1 2 3 4 5 6 P.M.

G.3266

Clai M

Clai M 188

10 8 6 4 2 1 2 4 6 8 10

1516

PLAN OF TWP. 188. (CASSON)

SAULT STE. MARIE MINING DIVISION.

DISTRICT OF ALGOMA.

Scale, 40 chains to an inch.

M. 1614

TWP. 1.F

Axis North.

W E S.

OTTER T'WP.

T'WP 182.

WAKOMATA LAKE.

GOULD T'WP.

R.W.4 199.22 Ac.

R.W.2 Ac. 200.83

Mississagi River

Snowshoe Creek

Stony

Cabin

Bridge

Log Chute

Dock

Original Indian Water Mark

Notes.

Railways shewn
Paved Highways
Gravel
Highway Route No.
Other Roads
Trails & Paths
Telephone & Telegraph Lines
Electric Power Lines
Non-perennial Streams
Surface reservations 400 chains by Dept. of L. & F. shewn

Bridges
Buildings
Swamps
Areas marked P are Patented
L Leased
LO held under Licence-of-Occupation
Areas with datum from staking.
Flooding rights to H.E.P.C. to Contour 1115 shewn thus to 1120 G.S.C. File 5937

1516


PLAN OF TWP. 188. (CASSON)

SAULT STE. MARIE MINING DIVISION.

DISTRICT OF ALGOMA.

Scale, 40 chains to an inch. M.16

TWP. 1.F

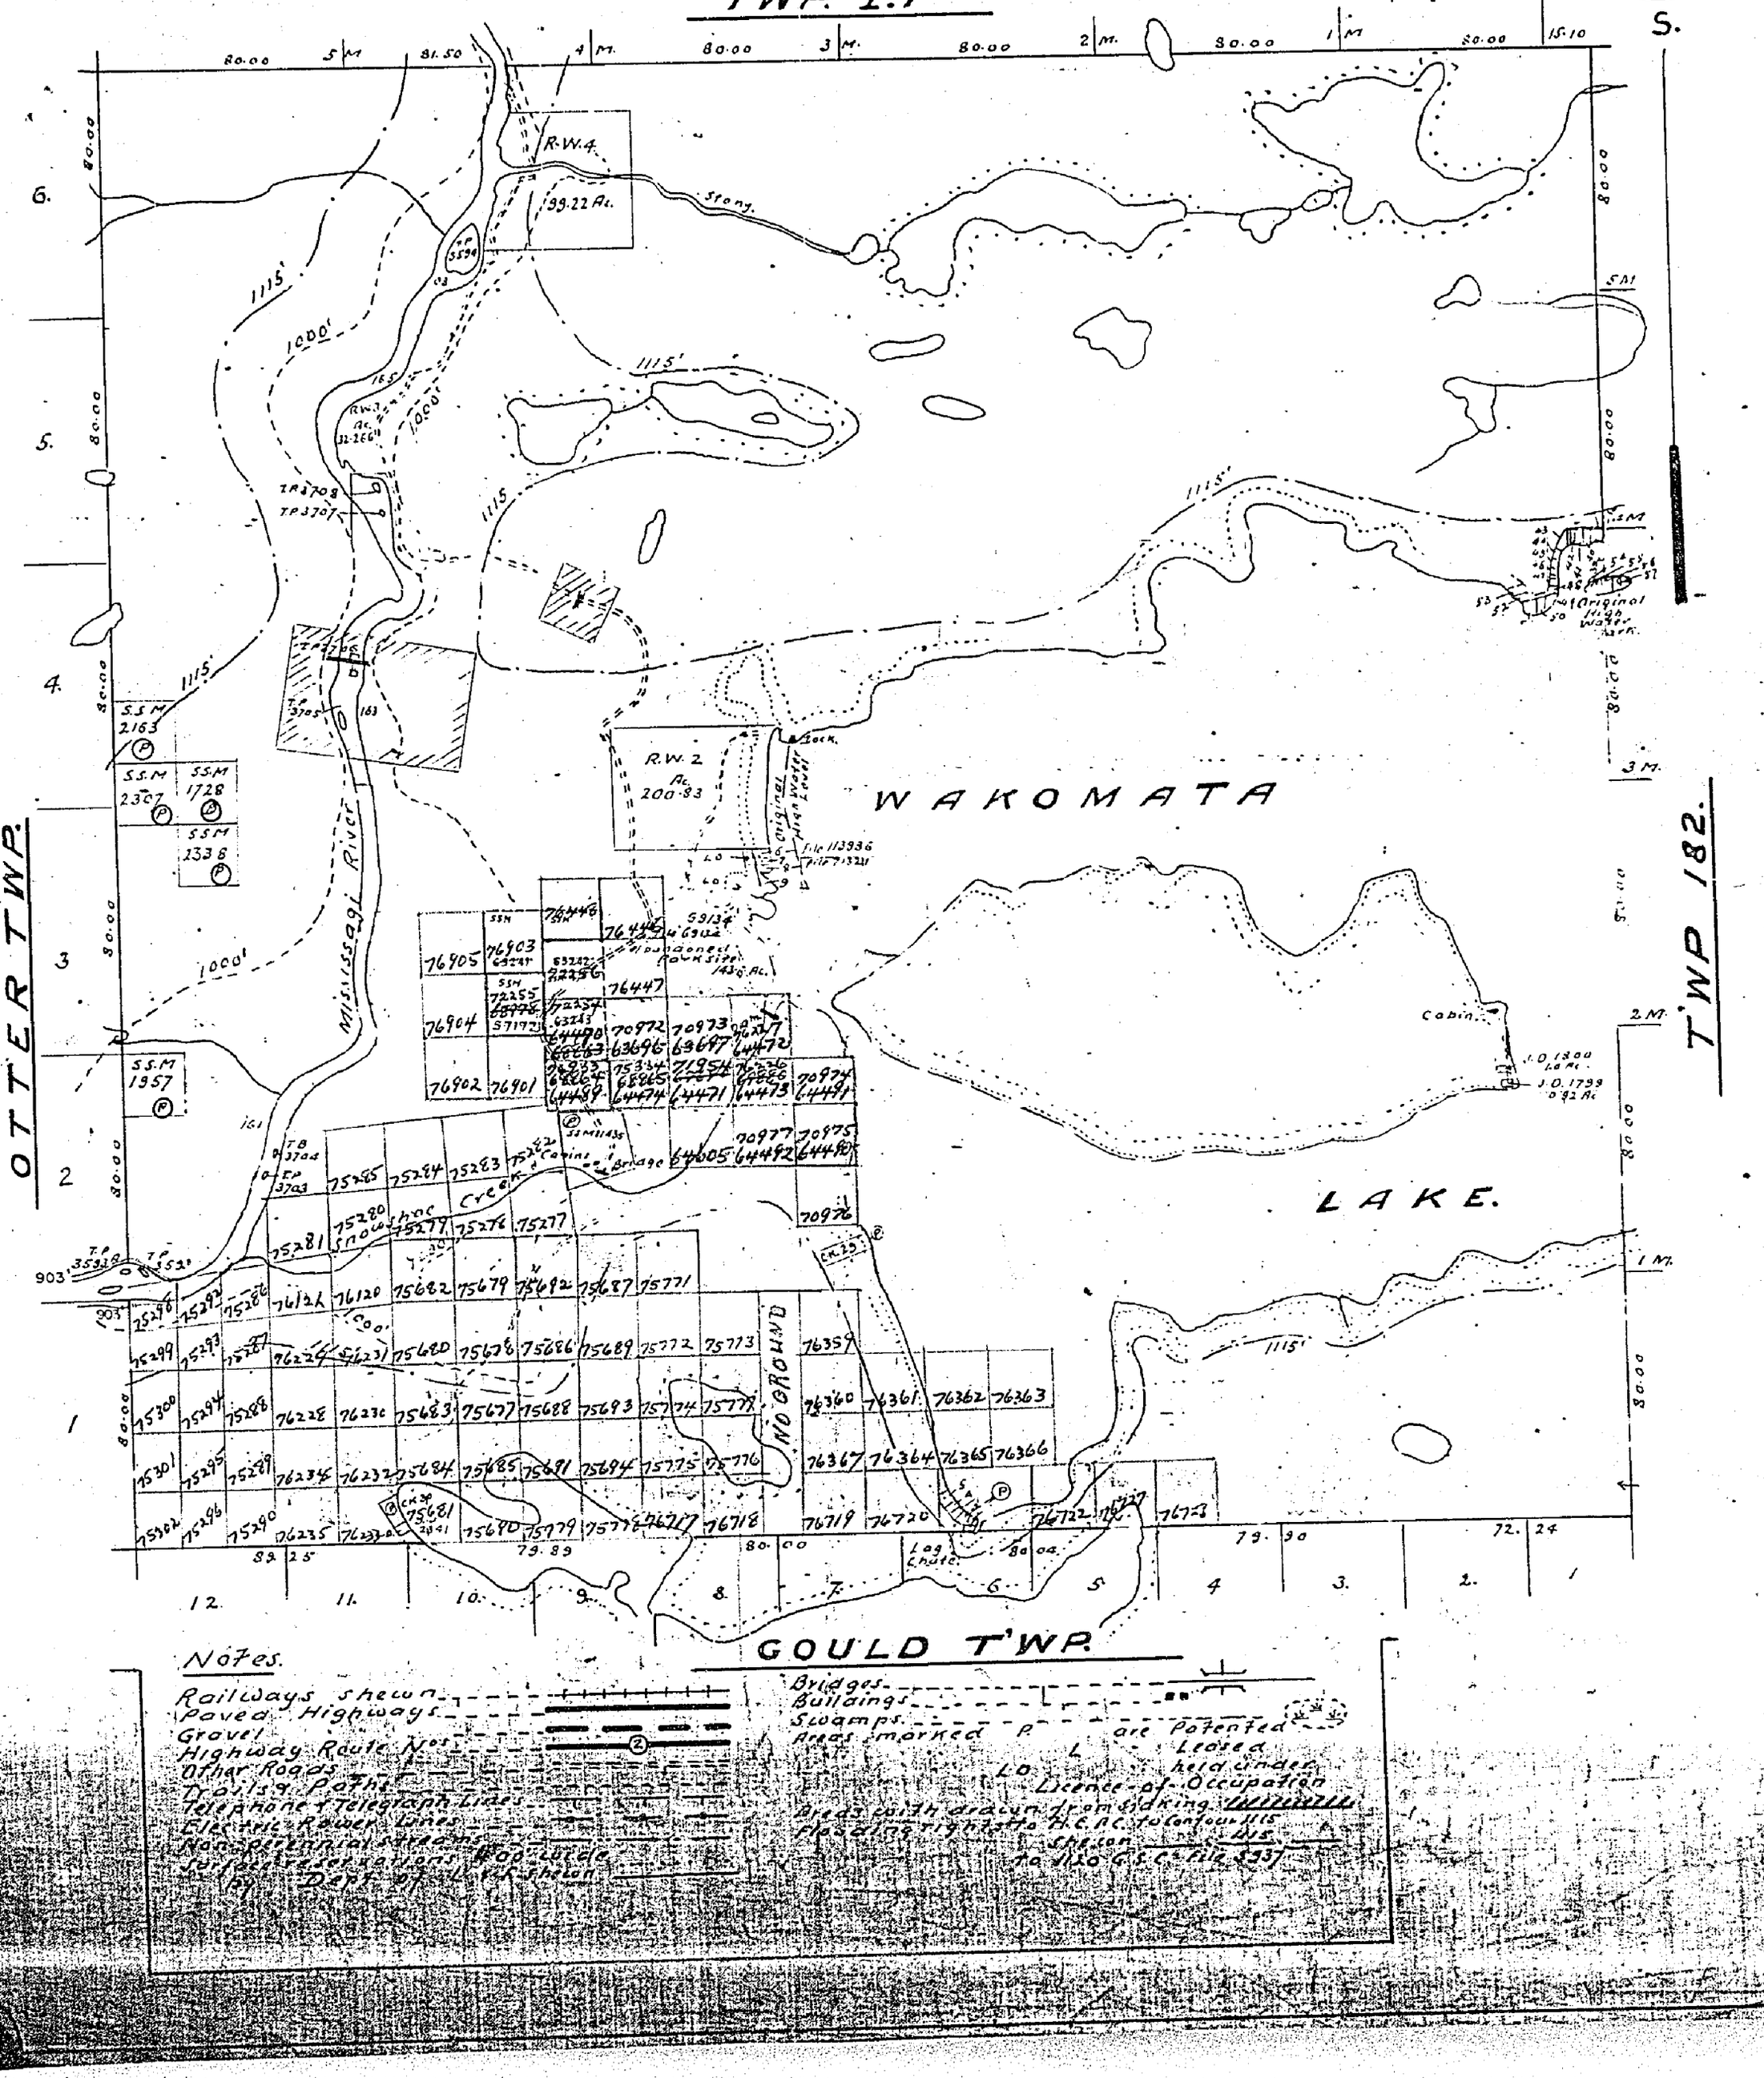
Astr. North.
W.
E
S.
80.00
5 M.
81.50
4 M.
80.00
3 M.
80.00
2 M.
80.00
1 M.
80.00
15.10
R.W.4.
199.22 Ac.
Strony.
1115'
1000'
165'
R.W.3.
Ac. 32.26
TP 3708
TP 3707
TP 3705
163
R.W.2
Ac. 200.83
Lock.
WAKOMATA
LAKE.
Cabin
Original High Water Mark
Mississagi River
Creek
Bridge
Log Chute

1516

PLAN OF TWP. 188. (CASSON)

SAULT STE. MARIE MINING DIVISION.

DISTRICT OF ALGOMA.

Scale, 40 chains to an inch.

M.1615

TWP. 1.F

OTTER T'WP.

T'WP 182.

GOULD T'WP.

WAKOMATA LAKE.


Stony

Mississagi River

No Ground

R.W.4

99.22 Ac.



Abandoned Rock Siding 145.6 Ac.

Cabins

Log Chute

Dock.

Original High Water Mark.

Notes.

Railways shewn

Paved Highways

Gravel

Highway Route Nos.

Other Roads

Telephone & Telegraph Lines

Electric Power Lines

Bridges

Buildings

Swamps

Areas marked P are Patented Leased Lo. Licence of Occupation held under



TOWNSHIP 188

W.1615

1516

PLAN OF TWP. 188. (CASSON)


SAULT STE. MARIE MINING DIVISION.

DISTRICT OF ALGOMA.

Scale, 40 chains to an inch.

M. 1615

TWP. 1.F

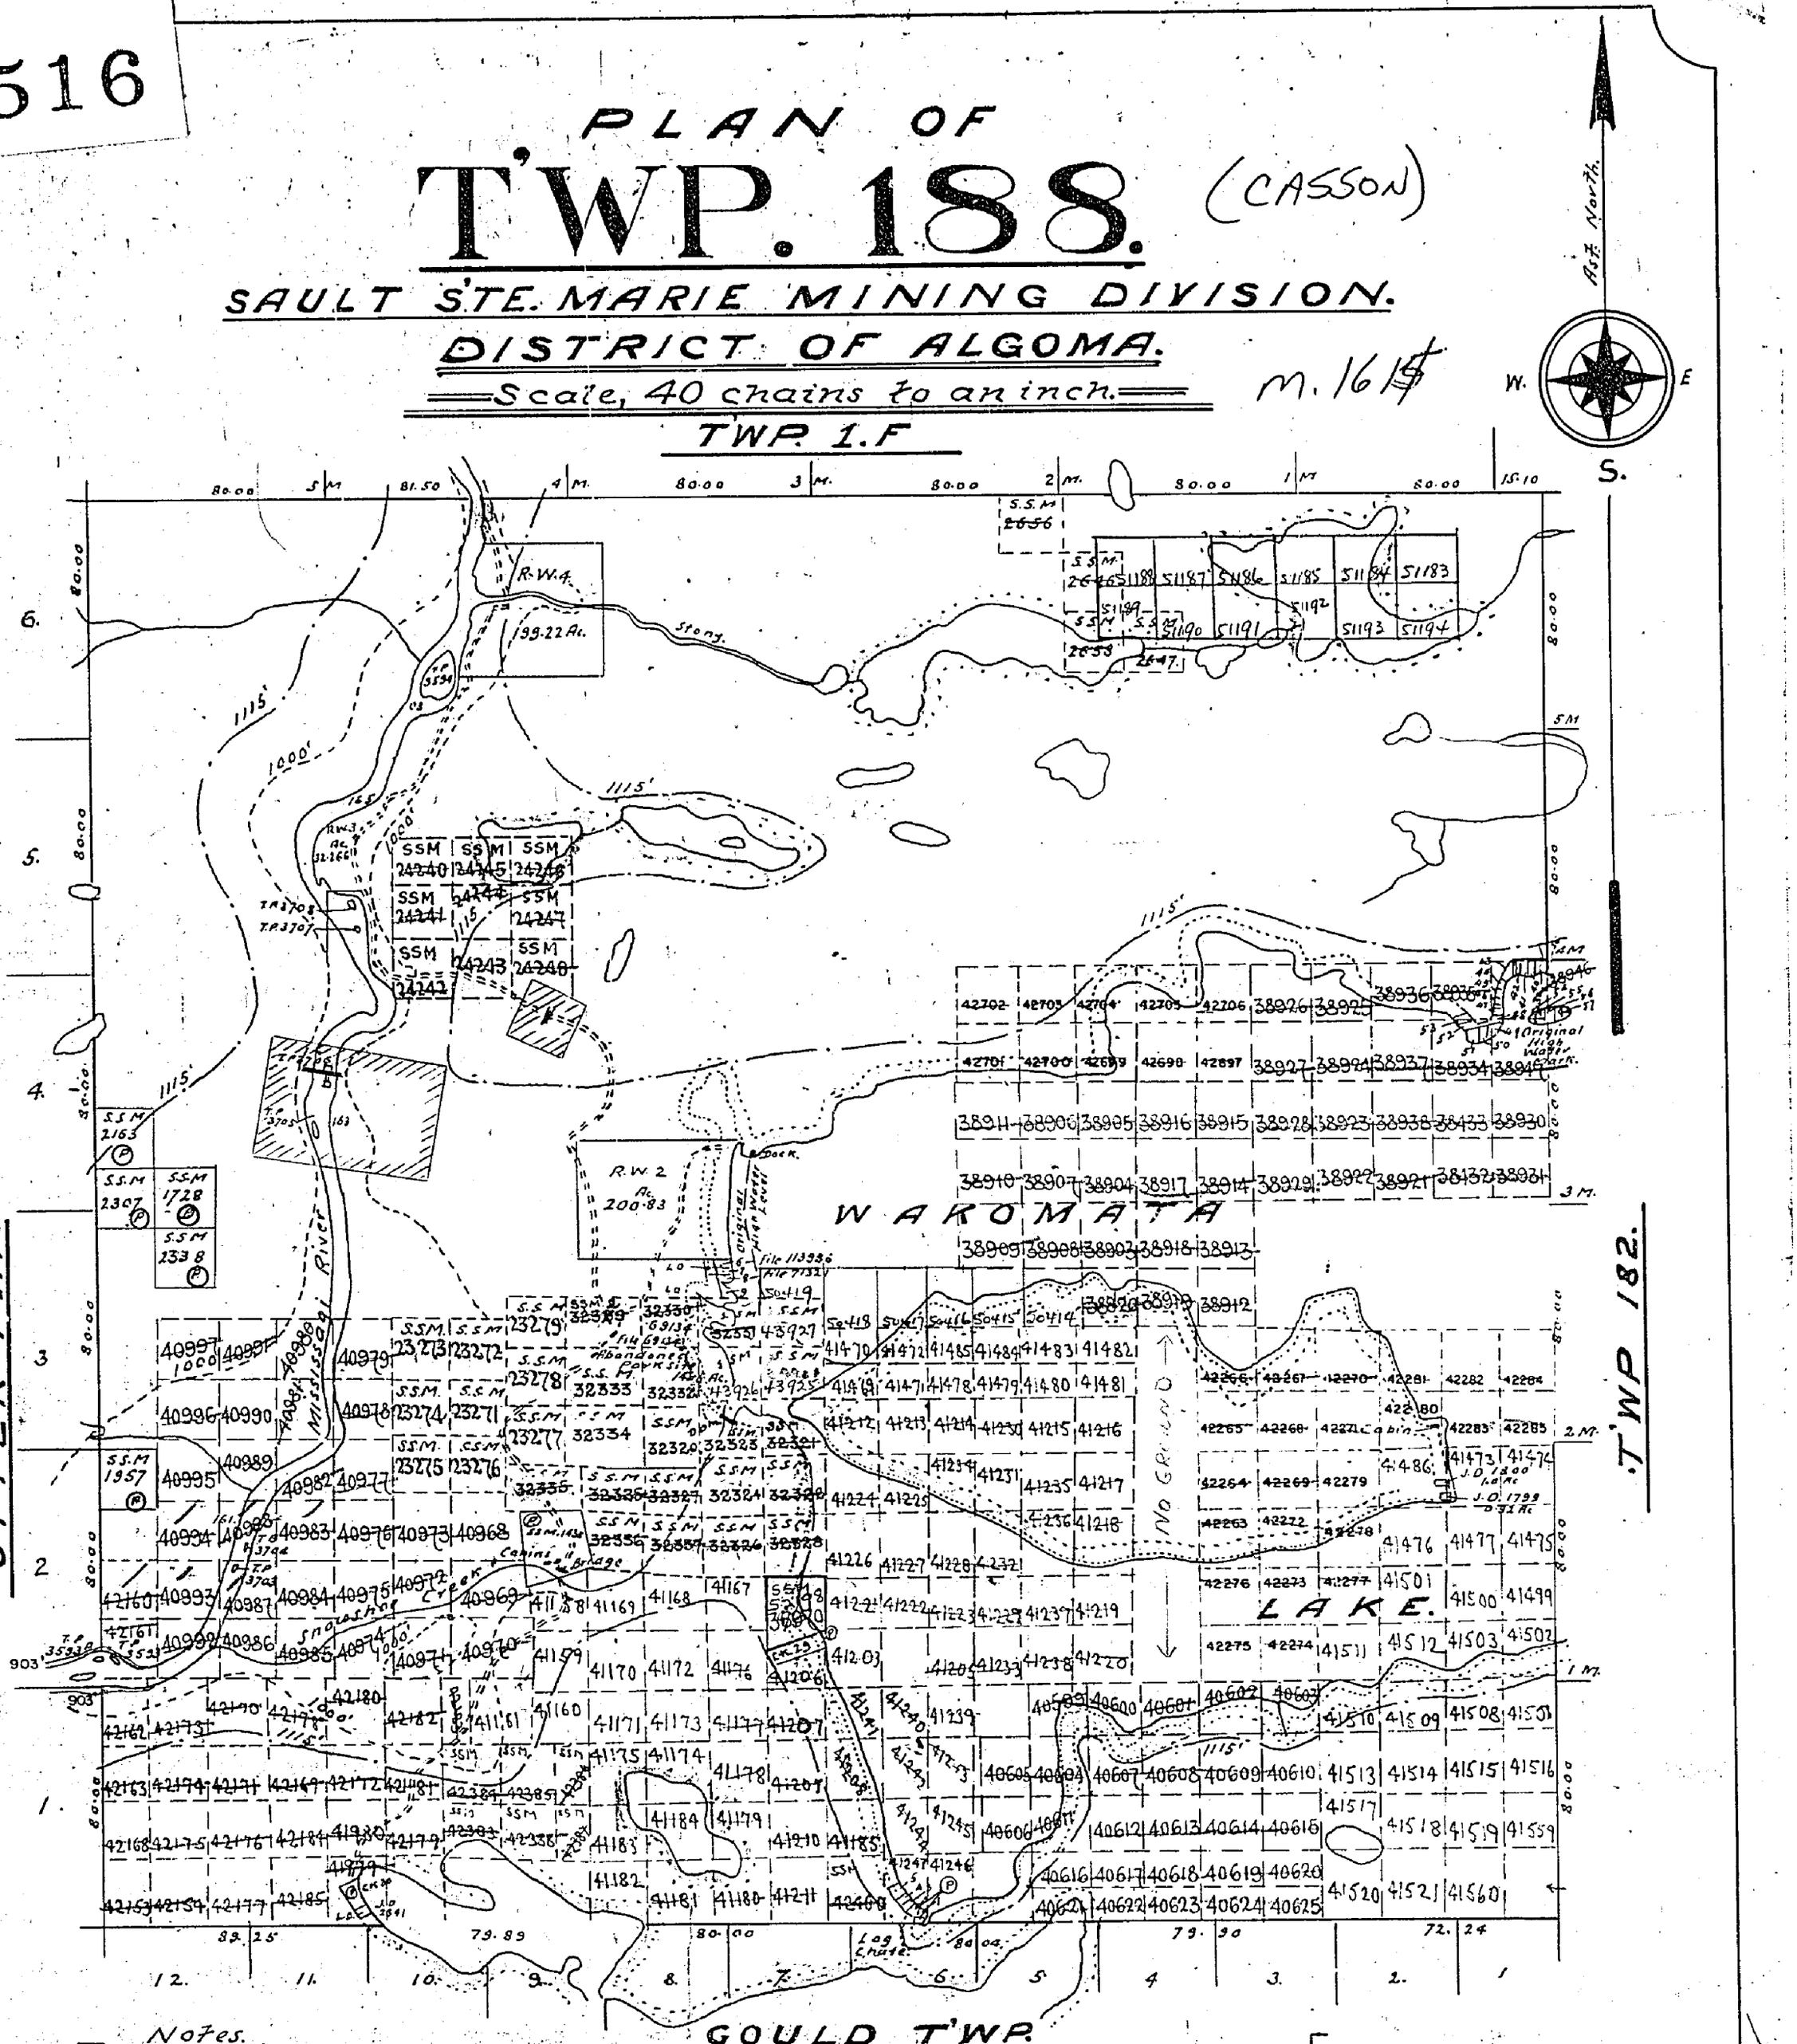

1615

PLAN OF TWP. 188. (CASSON)


SAULT STE. MARIE MINING DIVISION.

DISTRICT OF ALGOMA.

Scale, 40 chains to an inch.

M. 1615

TWP. 1.F

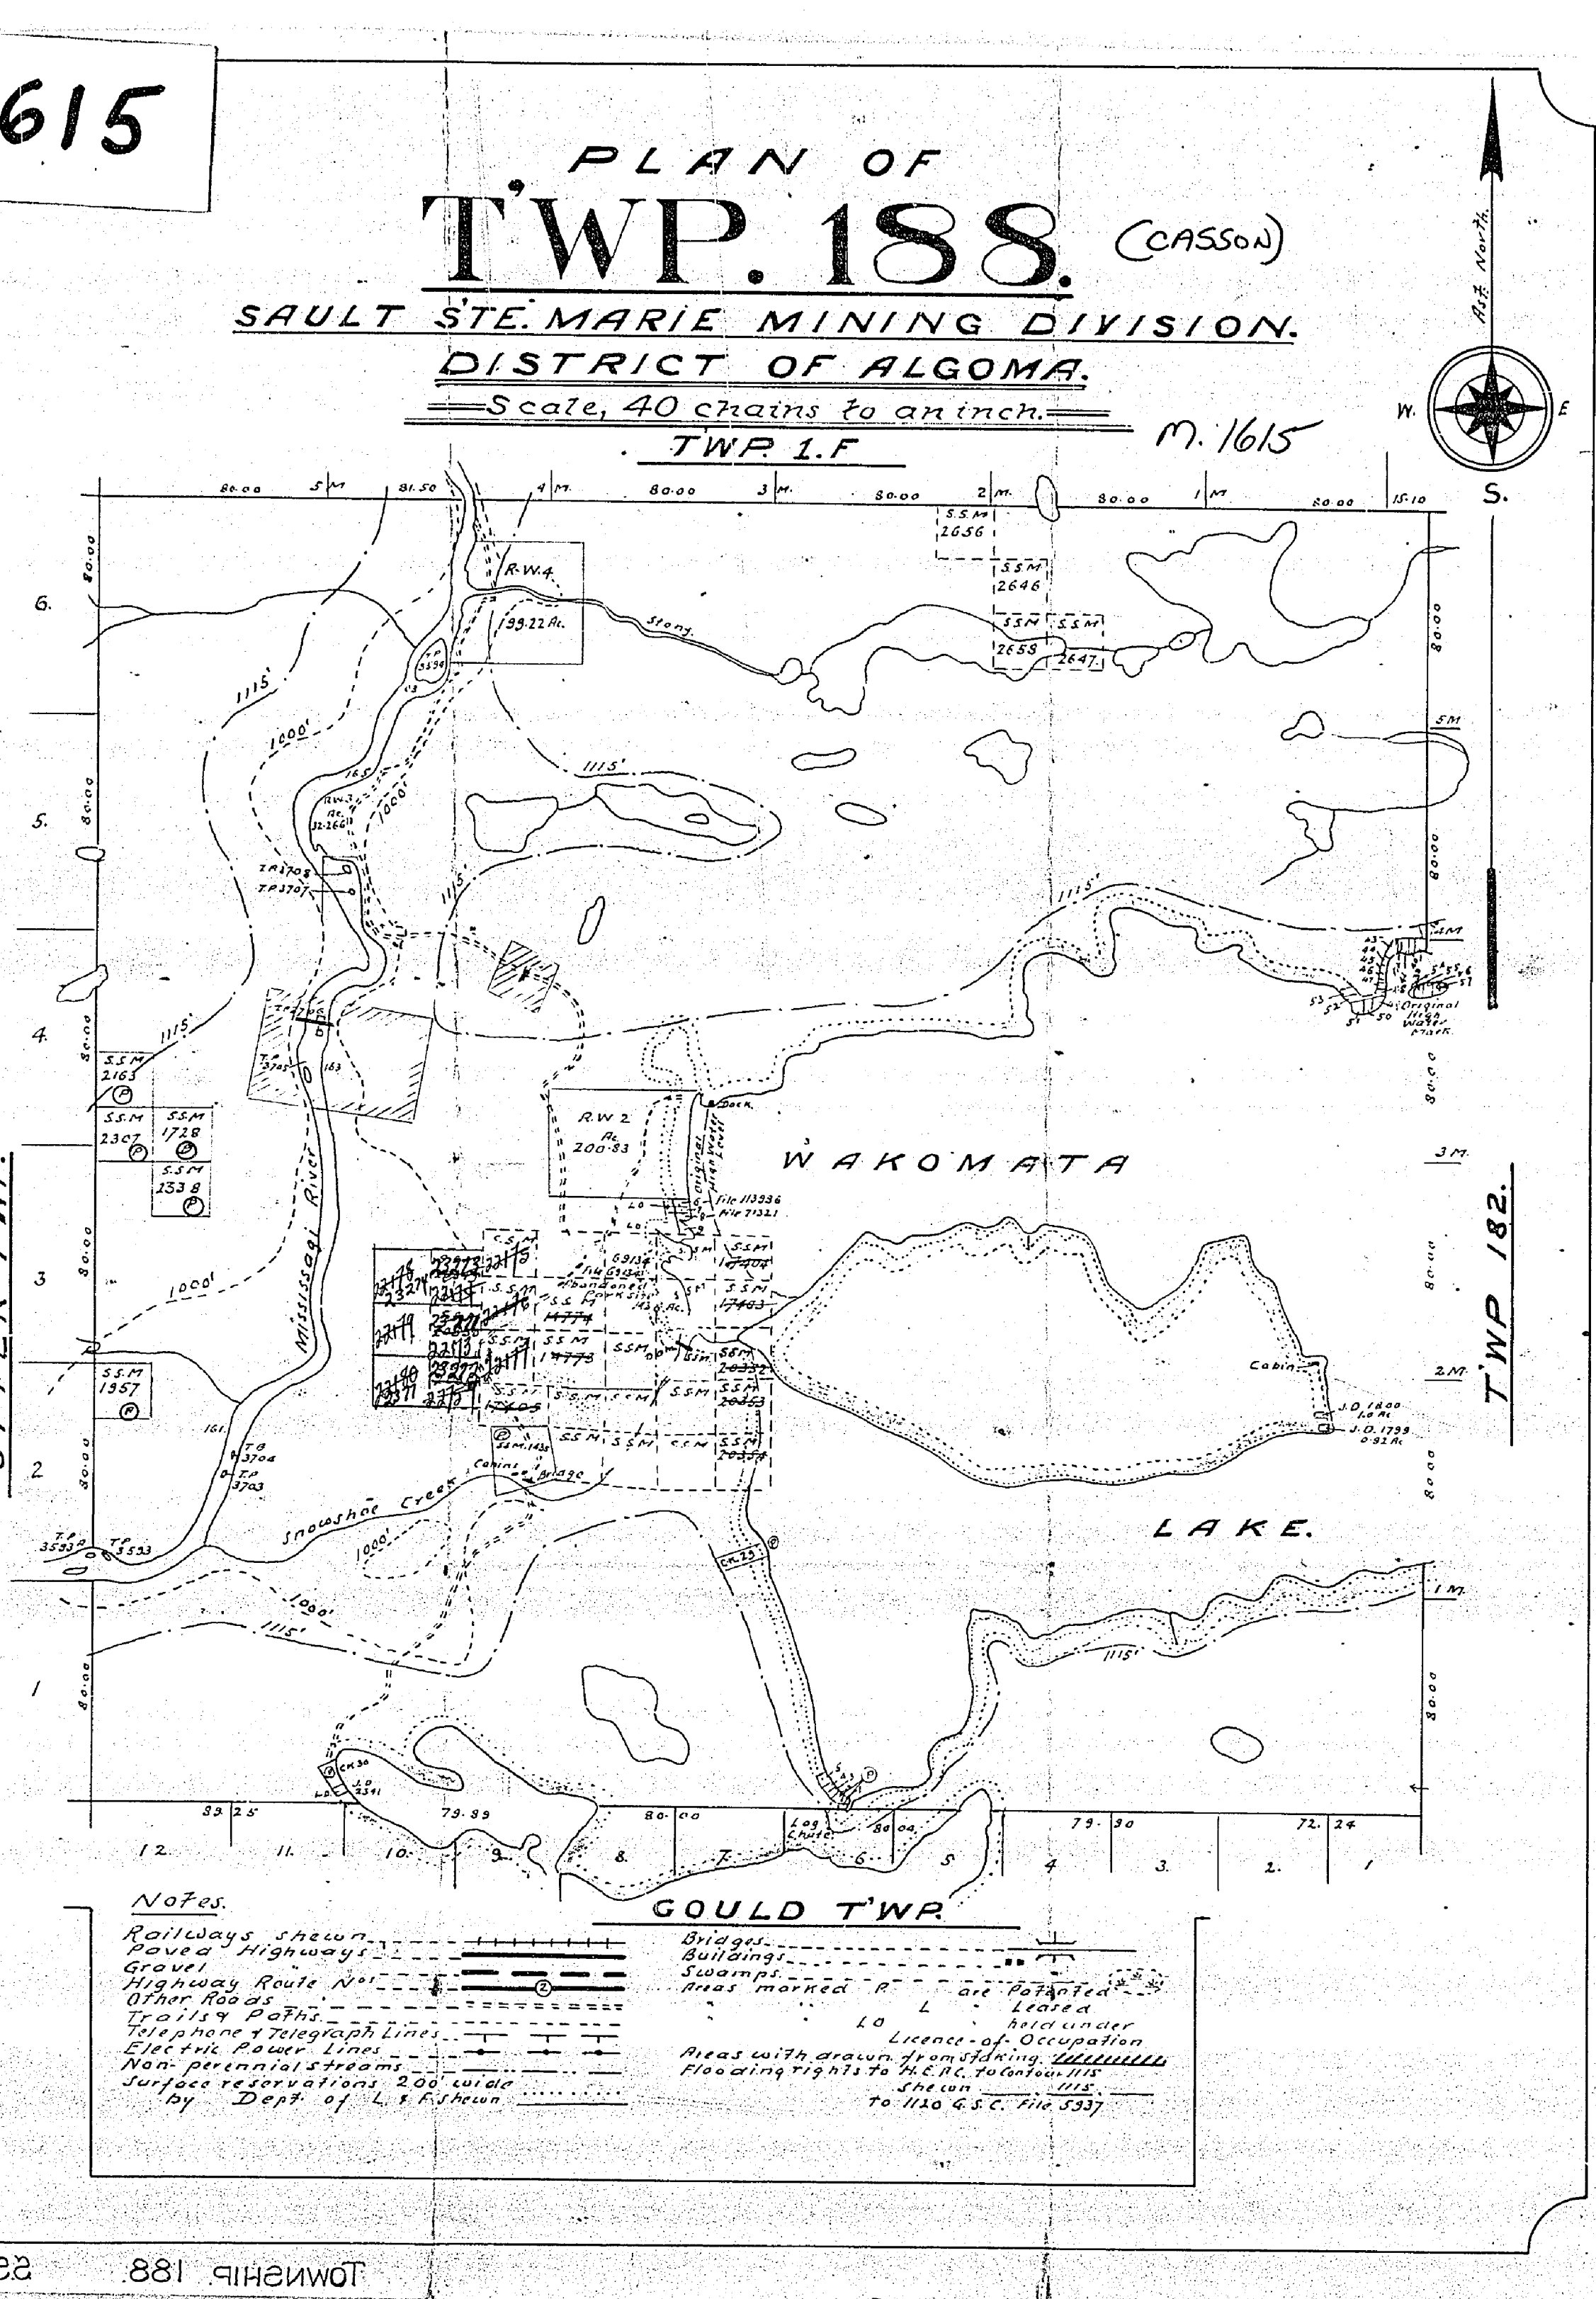

Notes.

Railways shewn
Paved Highways
Gravel
Highway Route Nos. (2)
Other Roads
Trails & Paths
Telephone & Telegraph Lines
Electric Power Lines
Non-perennial streams
Surface reservations 2.00 wide by Dept. of L. & F. shewn

Bridges
Buildings
Swamps
Areas marked P are Patented
" " L - Leased
" " LO - held under Licence-of-Occupation
Areas with drawn from staking.
Flooding rights to H.E.P.C. to Contour 1115 shewn 1115 to 1120 G.S.C. File 5937

TOWNSHIP 188. SSM.365.

1615

OFFICE MAP

PLAN OF TWP. 188.

(CASSON)


SAULT STE. MARIE MINING DIVISION.

DISTRICT OF ALGOMA.

Scale, 40 chains to an inch.

M. 1615

TWP. 1.F

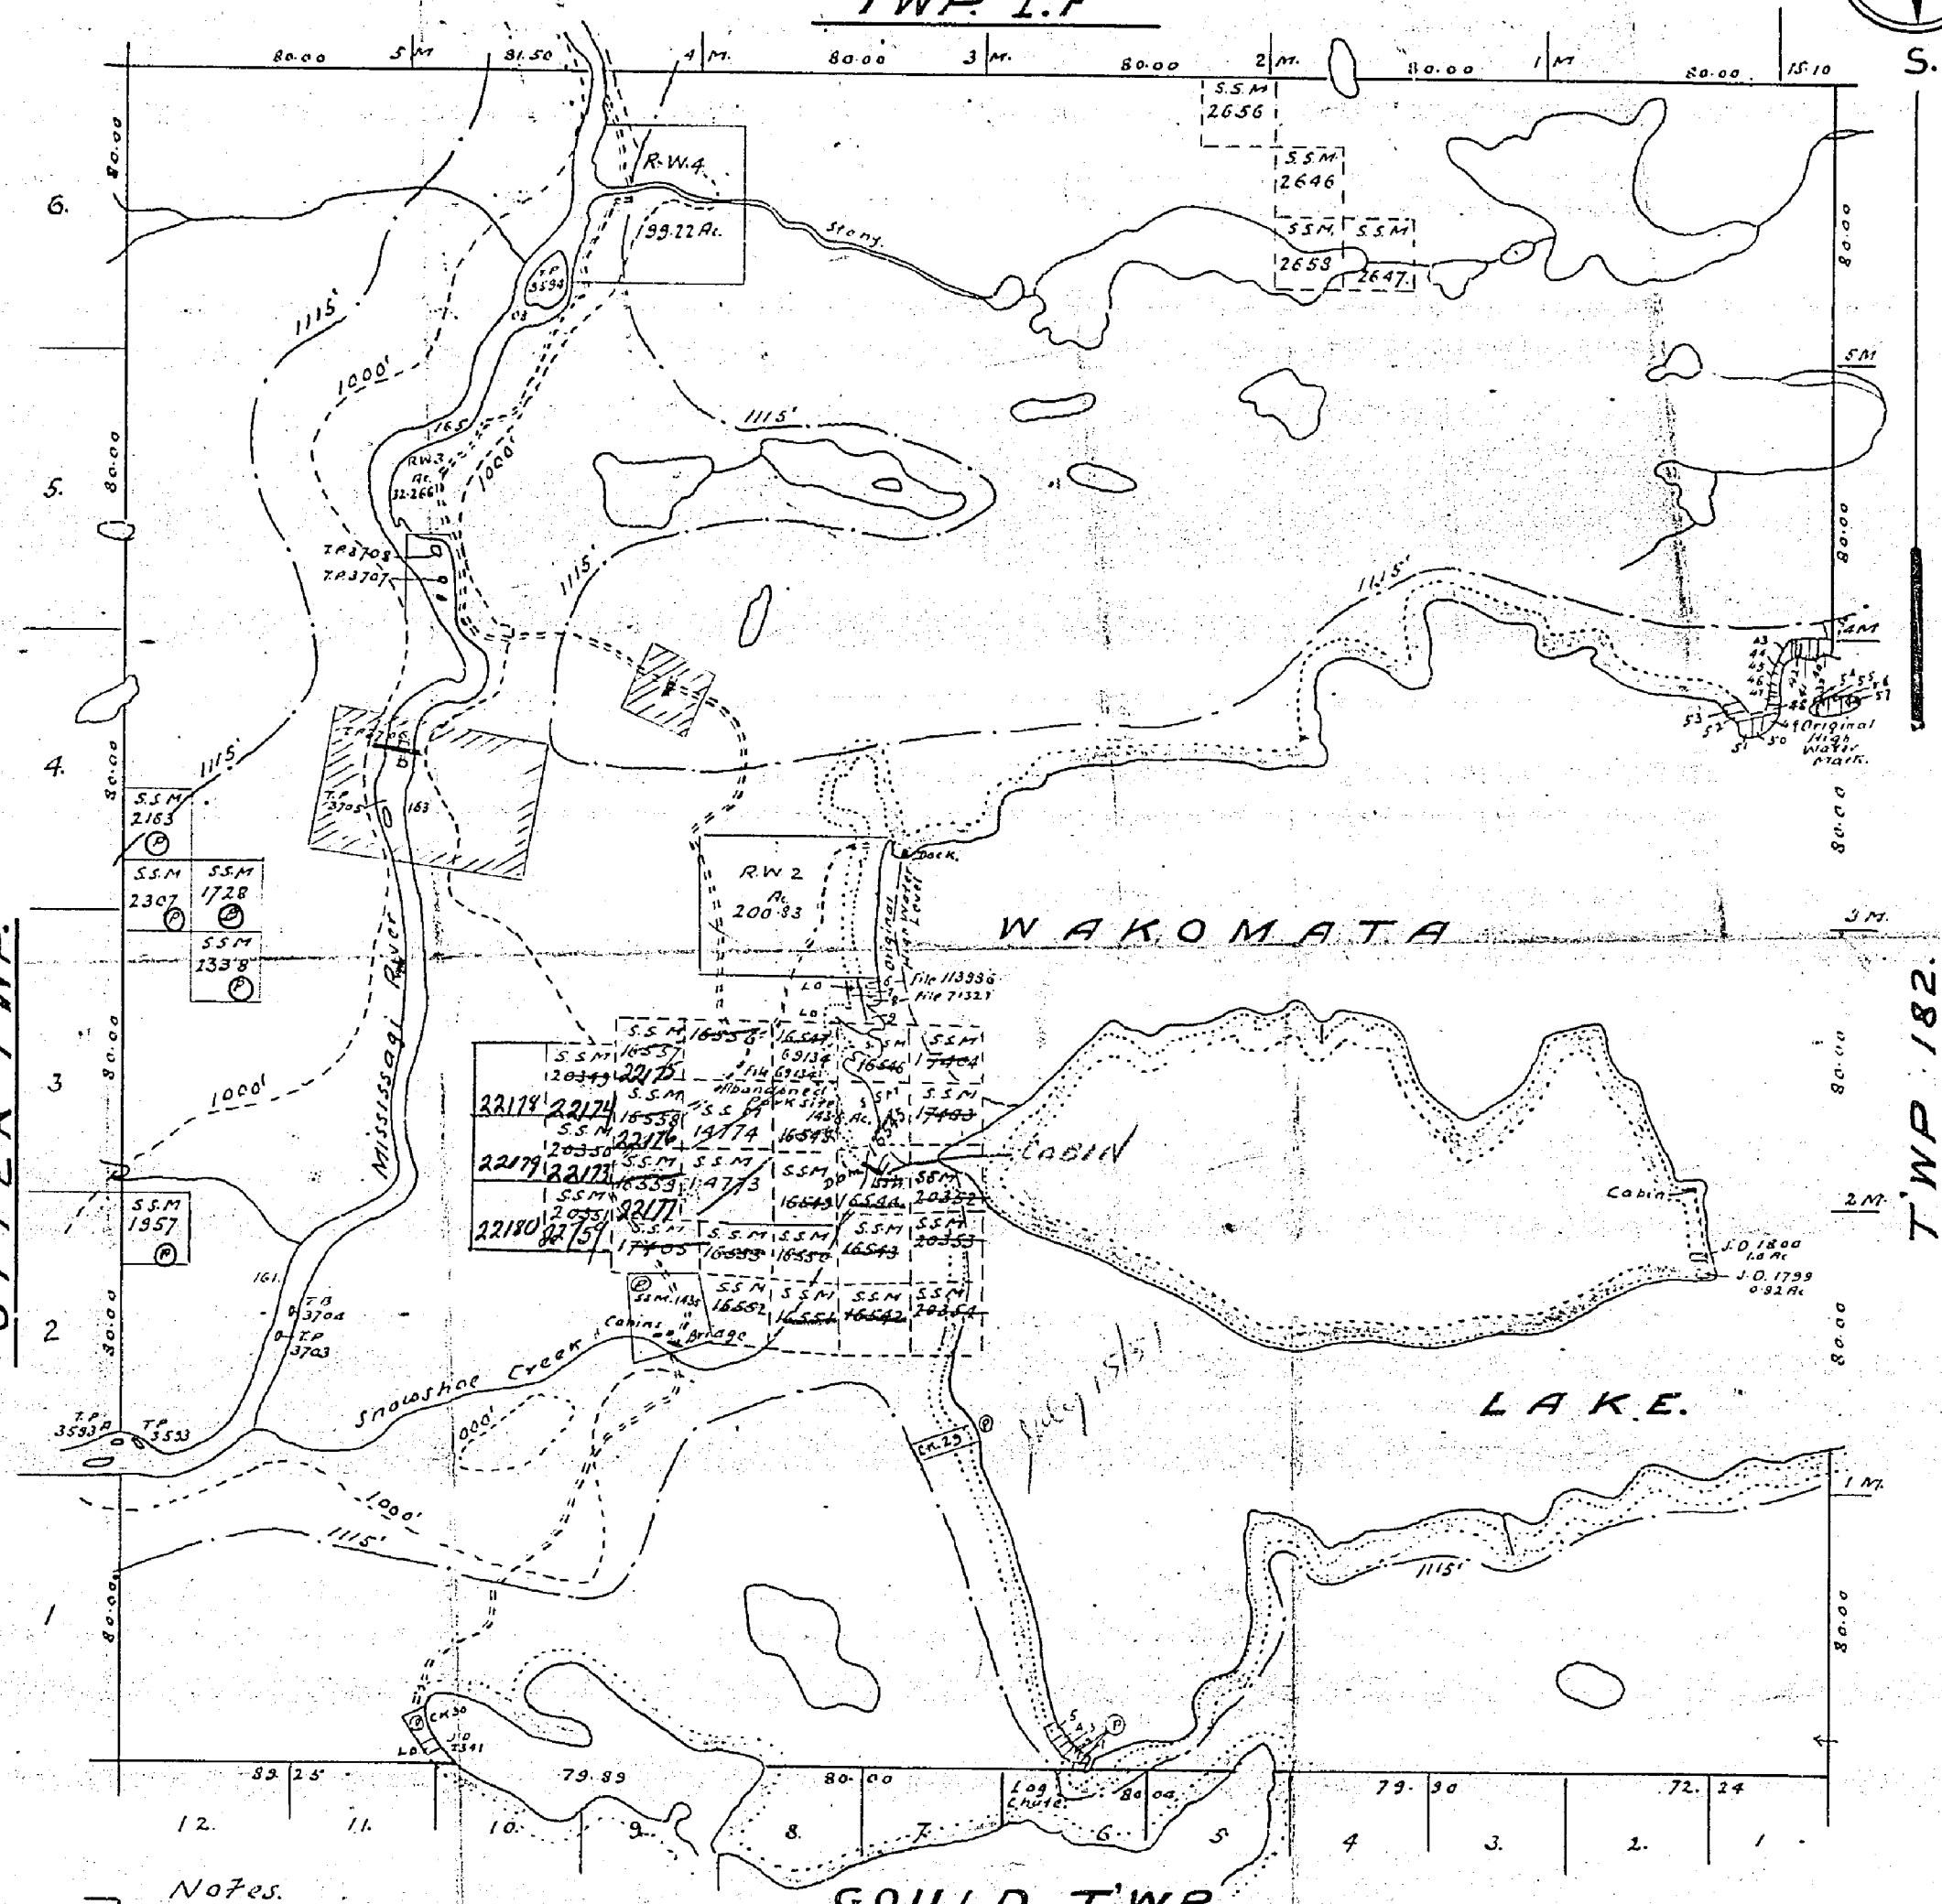

Notes.

Railways shewn
Paved Highways
Gravel "
Highway Route No's (2)
Other Roads
Trails & Paths
Telephone & Telegraph Lines
Electric Power Lines
Non-perennial Streams
Surface reservations 200' wide by Dept. of L & F shewn

Bridges
Buildings
Swamps
Areas marked P are Patented
" " L " Leased
" " LO " held under Licence of Occupation
Areas with drawn from staking.
Flooding rights to H.E.P.C. to contour 1115 shewn 1115 to 1120 G.S.C. file 5937

GOULD T'WP.

TOWNSHIP 188 SSM 365.

1615

TOWNSHIP 188

DISTRICT OF ALGOMA (CASSON)

Scale 40. Chains 1 Inch.

M.1615

AST. N.

TOWNSHIP 1F

TOWNSHIP 182

OTTER

Wakomata.

Lake

Stony River

Snowshoe Creek

Mississagi

R.W.4 199.22 Ac.

R.W.2 200.83 Ac.

SSM 2650 SSM 2646 SSM 2658 SSM 2647 SSM 2163 SSM 1708 SSM 2638 SSM 15634 SSM 15633 SSM 15632 SSM 16556 SSM 16547 SSM 16546 SSM 16558 SSM 16549 SSM 16514 SSM 16553 SSM 16550 SSM 16543 SSM 16552 SSM 16551 SSM 16542 SSM 15640 SSM 15647 SSM 15648

Reserve Flooding Rights to H.E.P.C. of Ontario to Contour 1120 G.S.C. File 5937. —1000'—
Area liable to flooding shewn thus —1000'—

North & East boundaries surveyed by T.J. Patten P.L.S. 1890.
South boundary surveyed by O. Beatty P.L.S. 1885.
West boundary surveyed by A.G. Cavan P.L.S. 1886.
South boundary re-surveyed by J.S. Dobie O.L.S. 1933.
Flooded lands surveyed by E.M. MacQuarrie O.L.S. 1928 to contour 113'9. Area 284·7 Ac. shown thus
for the Mississagi River Improvement Co. Ltd. File 2138 & O. 2084.
Mississagi River surveyed by T.J. Patten O.L.S. 1922.
Road surveyed by C.F. Bush O.L.S. 1930 under instructions from the Dept. of Lands & Forests shown thus
Public Camps & Park Sites R.W.1, R.W.2, R.W.3 R.W.4 surveyed by R.W. Code O.L.S. 1939 under instructions from the Dept. of Lands & Forests dated Aug 8th 1939 R.W.1 to R.W.4 inclusive are originally known as Park or Camp reservations Nos 23, 24, 25 & 28 respectively and referred to in file 113936.
Subdivisions showing lots 1 to 5, 6 to 10, 39 to 57 inclusive, surveyed by J.S. Dobie O.L.S. 1939 under instructions from the Dept. of Lands & Forests
Lakes & Rivers from aerial survey Ontario Forestry Branch, Dept. of Lands & Forests 1928.

GOULD

Surface reservations 200' wide by Dept of L. & F. shewn hereon thus

Parcels marked P are Patented.
" L " Leased.
" Lo " License of Occupation.

Department of Surveys.
Parliament Buildings.
Toronto, Ontario, Canada.

188

1615

TOWNSHIP 188

DISTRICT OF ALGOMA (CASSON)

Scale 40 Chains 1 Inch M. 1615

TOWNSHIP 1F

TOWNSHIP 182

OTTER

Wakomata Lake

Stony River

Snowshoe Creek

Miss/Ssag River

R.W.1 200.83 Ac.

R.W.2 200.83 Ac.

R.W.3 32.206 Ac.

R.W.4 198.22 Ac.

Abandoned Mine Site See File 69134

Original High Water Mark

Dock

Cabin

Trail

Creek

Lot

Ck 29

Ck 30

J.D. 1000

J.D. 1115

1000'

1115'

SSM 2650, SSM 2646, SSM 2658, SSM 2647, SSM 2163, SSM 1728, SSM 2338, SSM 1957, SSM 16556, 16547, 16557, 20349, 16546, 17404, 16558, 14774, 16548, 17403, 20350, 16559, 14773, 16549, 16544, 20352, 17405, 16553, 16550, 16543, 20355, 16552, 16551, 16542, 20354

I, II, III, IV, V, VI

1. 2. 3. 4. 5. 6. 7. 8. 9. 10. 11. 12.

N 89.53 W 72.24 — N 89.43 W 79.90 — S 89.33 W 80.00 — N 89.57 W 79.85 — S 89.32 W 85.25

North & East boundaries surveyed by T.J. Patton P.L.S. 1890.
South boundary surveyed by A Beatty P.L.S. 1885.
West boundary surveyed by A.G. Cavana P.L.S. 1886.
South boundary re-surveyed by J.S. Dobie O.L.S. 1933.
Flooded lands surveyed by E.M. MacQuarrie O.L.S. 1928 to contour 1131.9. Area 284.7 Ac. shown thus .....
for the Mississagi River Improvement Co. Ltd. File 2136 L.O. 2084.
Mississagi River surveyed by T.J. Patton O.L.S. 1922.
Road surveyed by C.F. Bush O.L.S. 1930 under instructions from the Dept. of Lands & Forests shown thus .....
Public Camp & Park Sites R.W.1, R.W.2, R.W.3 R.W.4 surveyed by R.W. Code O.L.S. 1939 under instructions
from the Dept. of Lands & Forests dated Aug 8th 1939 R.W.1 to R.W.4 inclusive are originally known as
Park or Camp. Reservations Nos 23, 24, 25 & 28 respectively and referred to in file 113986.
Subdivisions showing 9 lots 1 to 5, 6 to 10, 39 to 57 inclusive, surveyed by J.S. Dobie O.L.S. 1939
under instructions from the Dept. of Lands & Forests
Lakes & Rivers from aerial survey Ontario Forestry Branch, Dept. of Lands & Forests 1928.

GOULD

Surface reservations 200' wide by Dept of L. & F. shown hereon thus .....

Parcels marked P are Patented.
L Leased.
L.O. License of Occupation.

Reserve Flooding Rights to H.E.P.C. of Ontario to Contour 1120 G.S.C. File 5937. — 1000' —

FLOODING RIGHTS TO H.E.P.C. 1115' — — —

Area Withdrawn From Staking Shown Thus .....

Department of Surveys.
Parliament Buildings.
Toronto, Ontario, Canada.

1615

TOWNSHIP 188

DISTRICT OF ALGOMA (CASSON)

M. 1615

Scale — 40 Chains = 1 Inch

TOWNSHIP 182

TOWNSHIP 1F

OTTER

PARK OR CAMP RESERVE No. 28 FILE - 113966

PARK OR CAMP RESERVE No. 25 FILE - 113966

PARK OR CAMP RESERVE No. 24. FILE - 113966

PARK OR CAMP RESERVE No. 23 Reservoir Dam site FILE - 113986

Cemetery

Stony Cr.

Mississagi River

Snowshoe Creek

Wahomata Lake

Dock

Old Dock

Log Chute

Reservoir Dam site

Concession I

II

III

IV

V

VI

1 2 3 4 5 6 7 8 9 10 11 12

80.00 West Astronomical

80.00

80.00 North

80.00 East

89.35

72.16

T. & L. Bdys by P.L.S. T. J. Patten 1890.
S Bdy " P.L.S. D. Beatty 1885
W " P.L.S. A. G. Cavana 1886.
Flooded lands by O.L.S. E. M. MacQuarrie Jan 4th 1928 to Contour 113'5 shown thus ▬▬ Area 284.7 Acres
Traverse of Mississagi River by O.L.S. T. J. Patten 1922

Road shown thus ═══ surveyed by O.L.S. C.E. Bush 1930
Other Lakes and Rivers from Aerial Survey

GOULD

Department of Surveys
Parliament Buildings
Toronto, Ontario, Canada


1615

TOWNSHIP 188

DISTRICT OF ALGOMA (CASSON)

Scale 40 Chains 1 Inch. M. 1615

TOWNSHIP I F

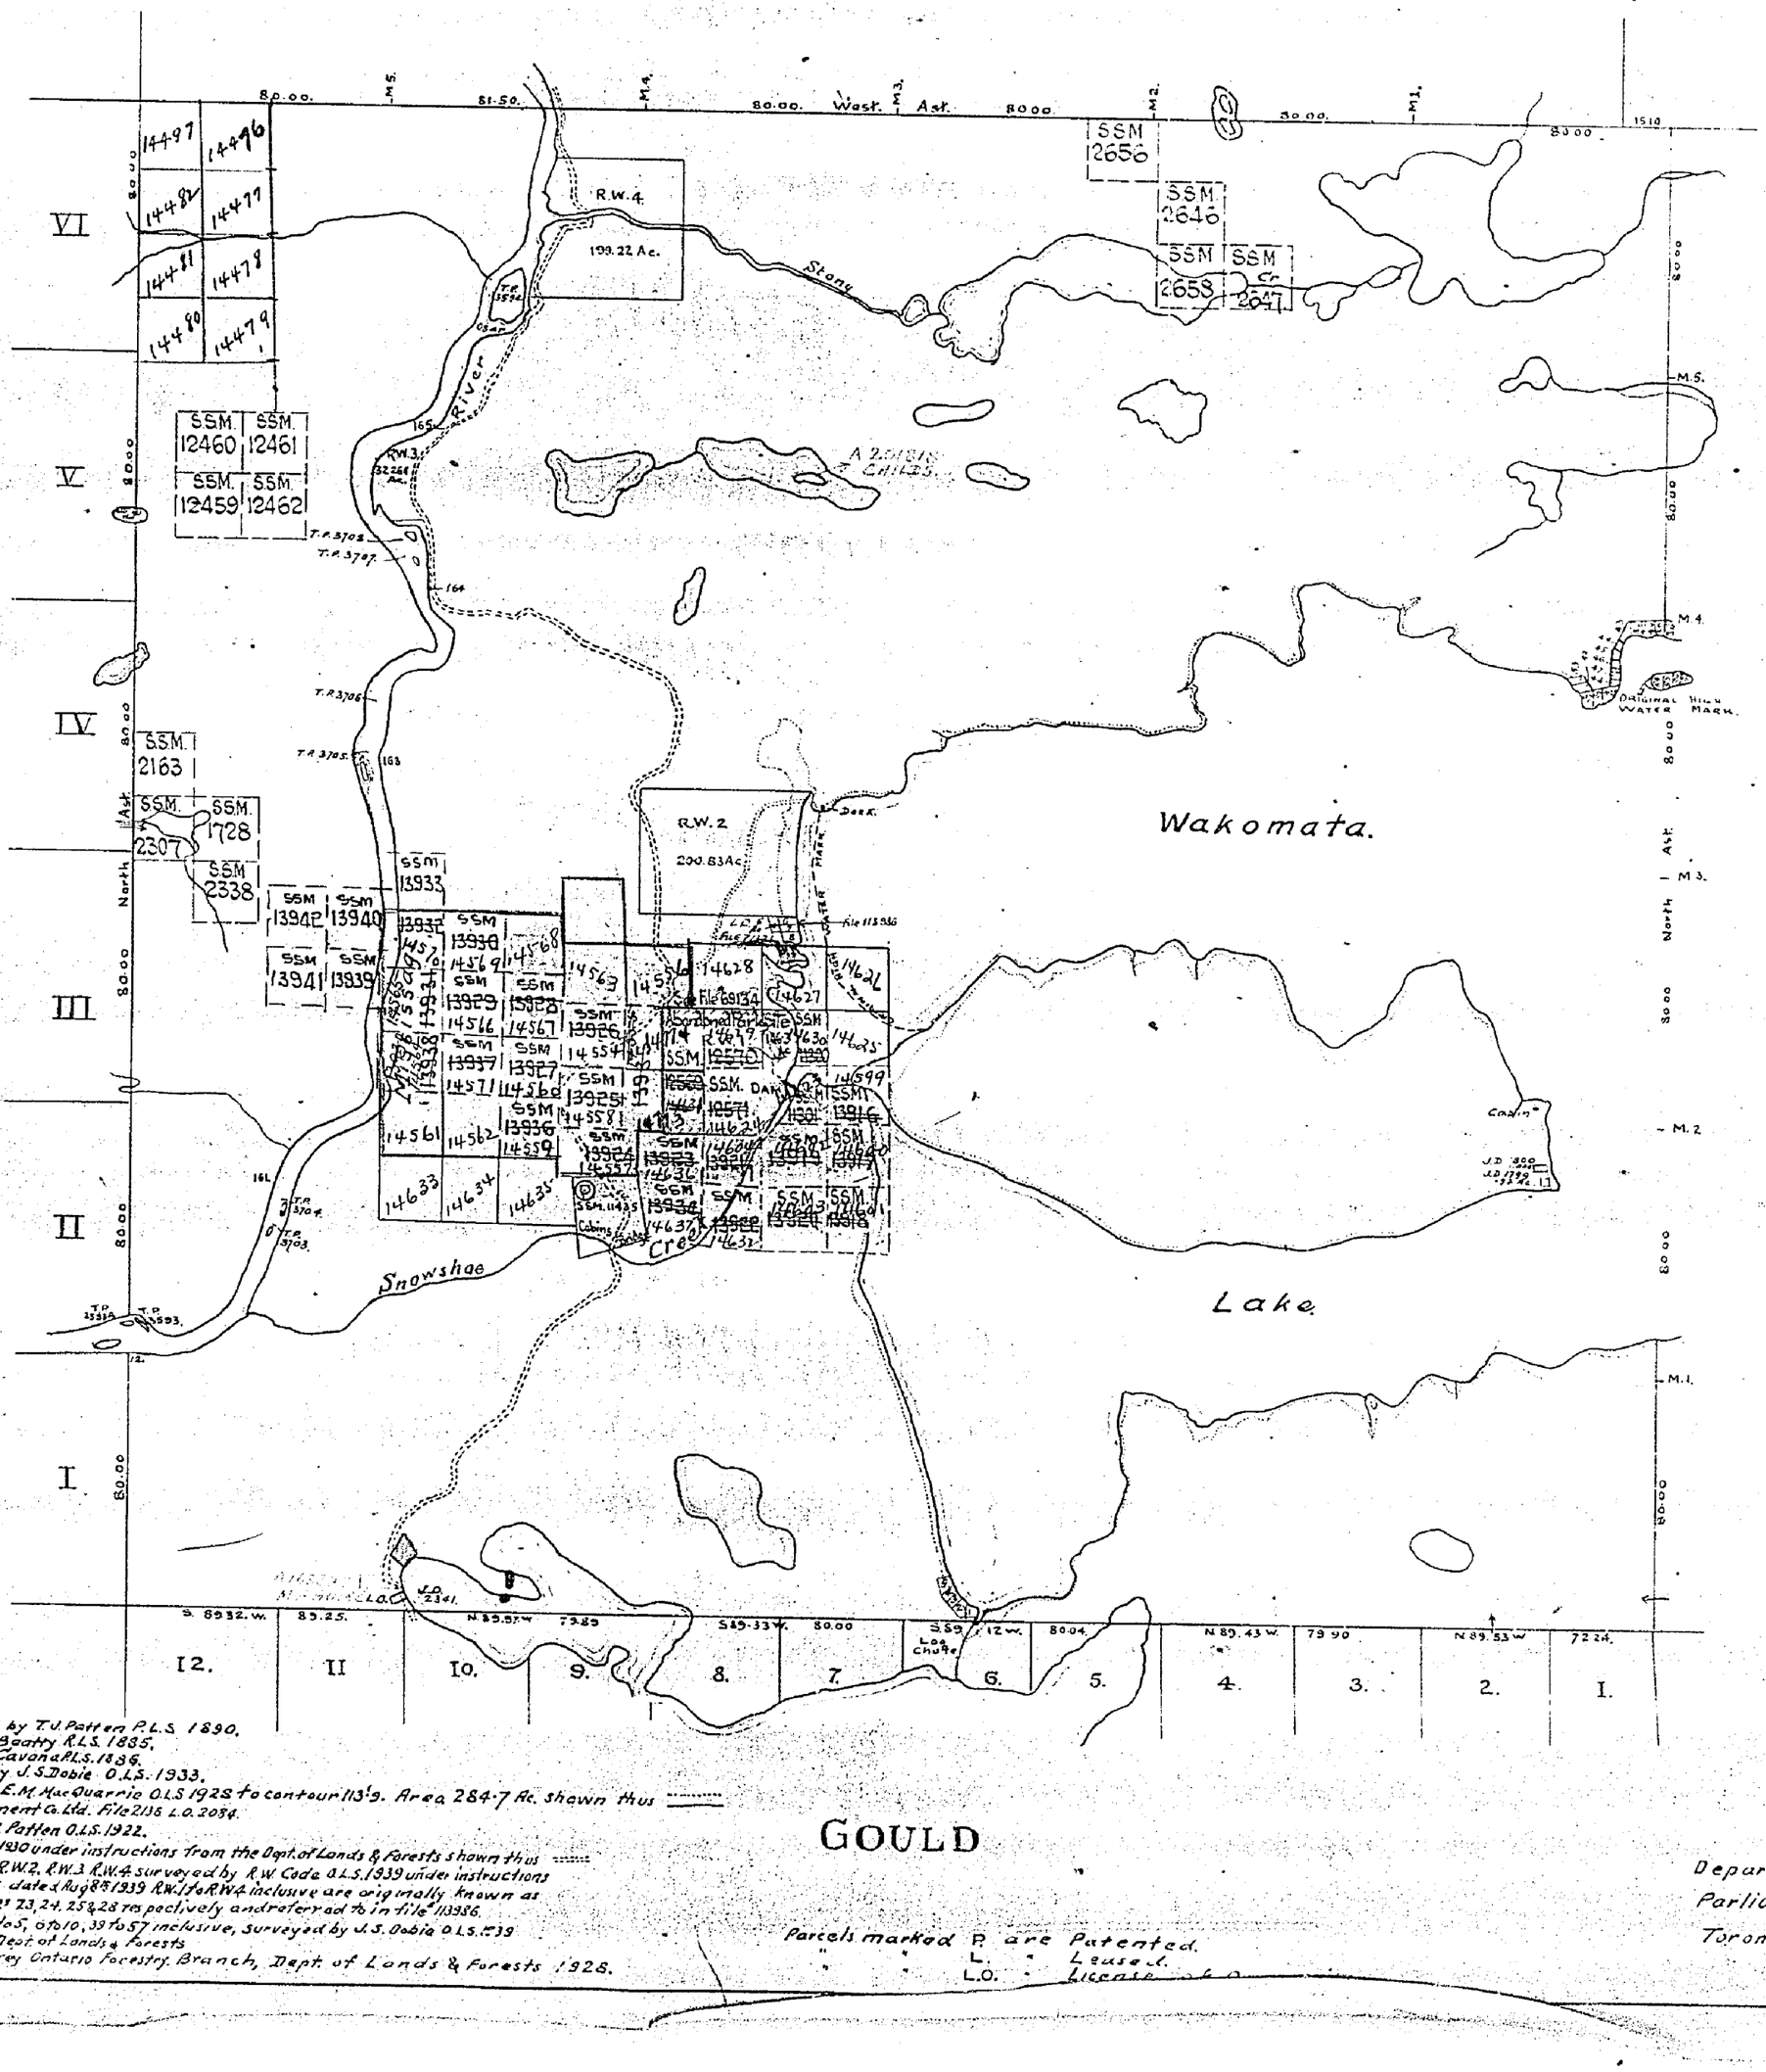

1615


DAGLE TP. M.1379

WAGG TP. M.1378

OTTER TWP. - M.1325

JACKSON TWP. M.1614

GOULD TWP. - M.455

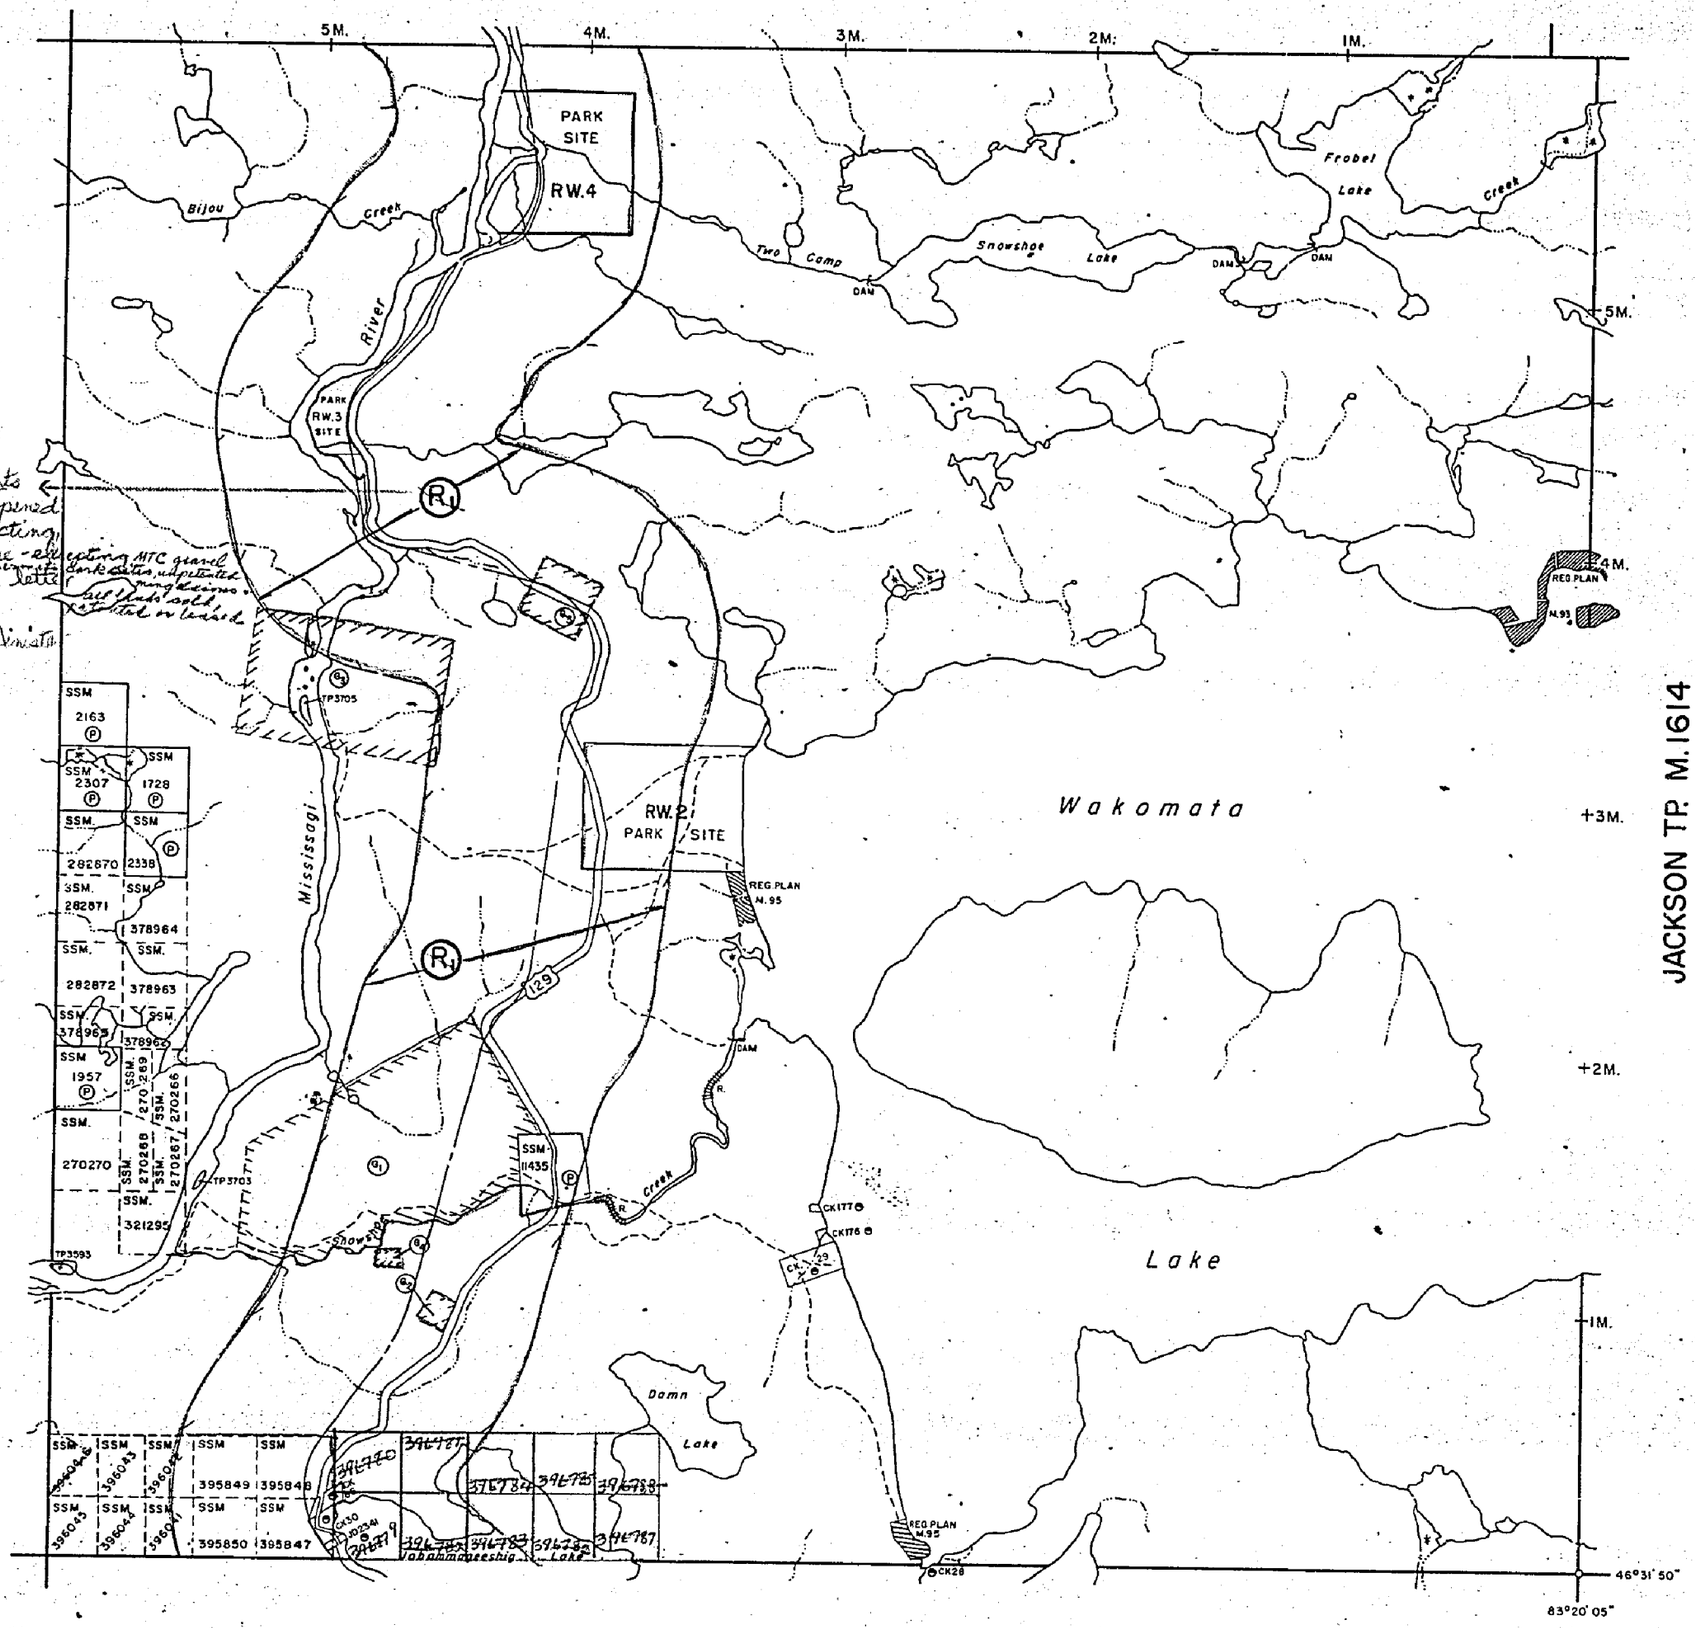

Surface Rights only are re-opened for prospecting, sale or lease - excepting MTC gravel pits, quarry permits, mining claims, subject to Sec. 43 - M.A. letter
July 5/71
Deputy Minister

THE TOWNSHIP

CASSON

(Tp. 188)

DISTRICT OF
ALGOMA

SAULT STE. MARIE
MINING DIVISION

SCALE: 1-INCH = 40 CHAINS

LEGEND

PATENTED LAND	(P)
CROWN LAND SALE	C.S.
LEASES	(L)
LOCATED LAND	Loc.
LICENSE OF OCCUPATION	L.O.
MINING RIGHTS ONLY	M.R.O.
SURFACE RIGHTS ONLY	S.R.O.
ROADS	
IMPROVED ROADS	
KING'S HIGHWAYS	
RAILWAYS	
POWER LINES	
MARSH OR MUSKEG	
MINES	
CANCELLED	C.

NOTES

400' surface rights reservation along the shores of all lakes and rivers.

Summer resort locations patented for surface rights only shown thus (P)

Flooding rights

- on Mississagi River reserved to contour 903' W.P.L.A. Nº 35 F. 5937 vol.4

OTHER AREAS WITHDRAWN FROM STAKING

S.R. - SURFACE RIGHTS M.R.-MINING RIGHTS

Section	Order Nº.	Date	Disposition	File
(R) 43 (R.S.O. 1970)	W-56/70	29/12/70	S.R.	156507

DATE OF ISSUE
OCT 7 1975

SAND & GRAVEL

(Q1) M.T.C. PIT Nº 1587
(Q2) M.T.C. PIT Nº 1333
(Q3) GRAVEL File 5937 vol.3
(Q4) GRAVEL File: 156507

PLAN NO. M.1615

ONTARIO
MINISTRY OF NATURAL RESOURCES
SURVEYS AND MAPPING BRANCH

b.k.

1615


TWP. IF - M.1379

TWP. IE - M.1378

TWP. 182 - M.1614

OTTER TWP. - M.1325

GOULD TWP. - M.455

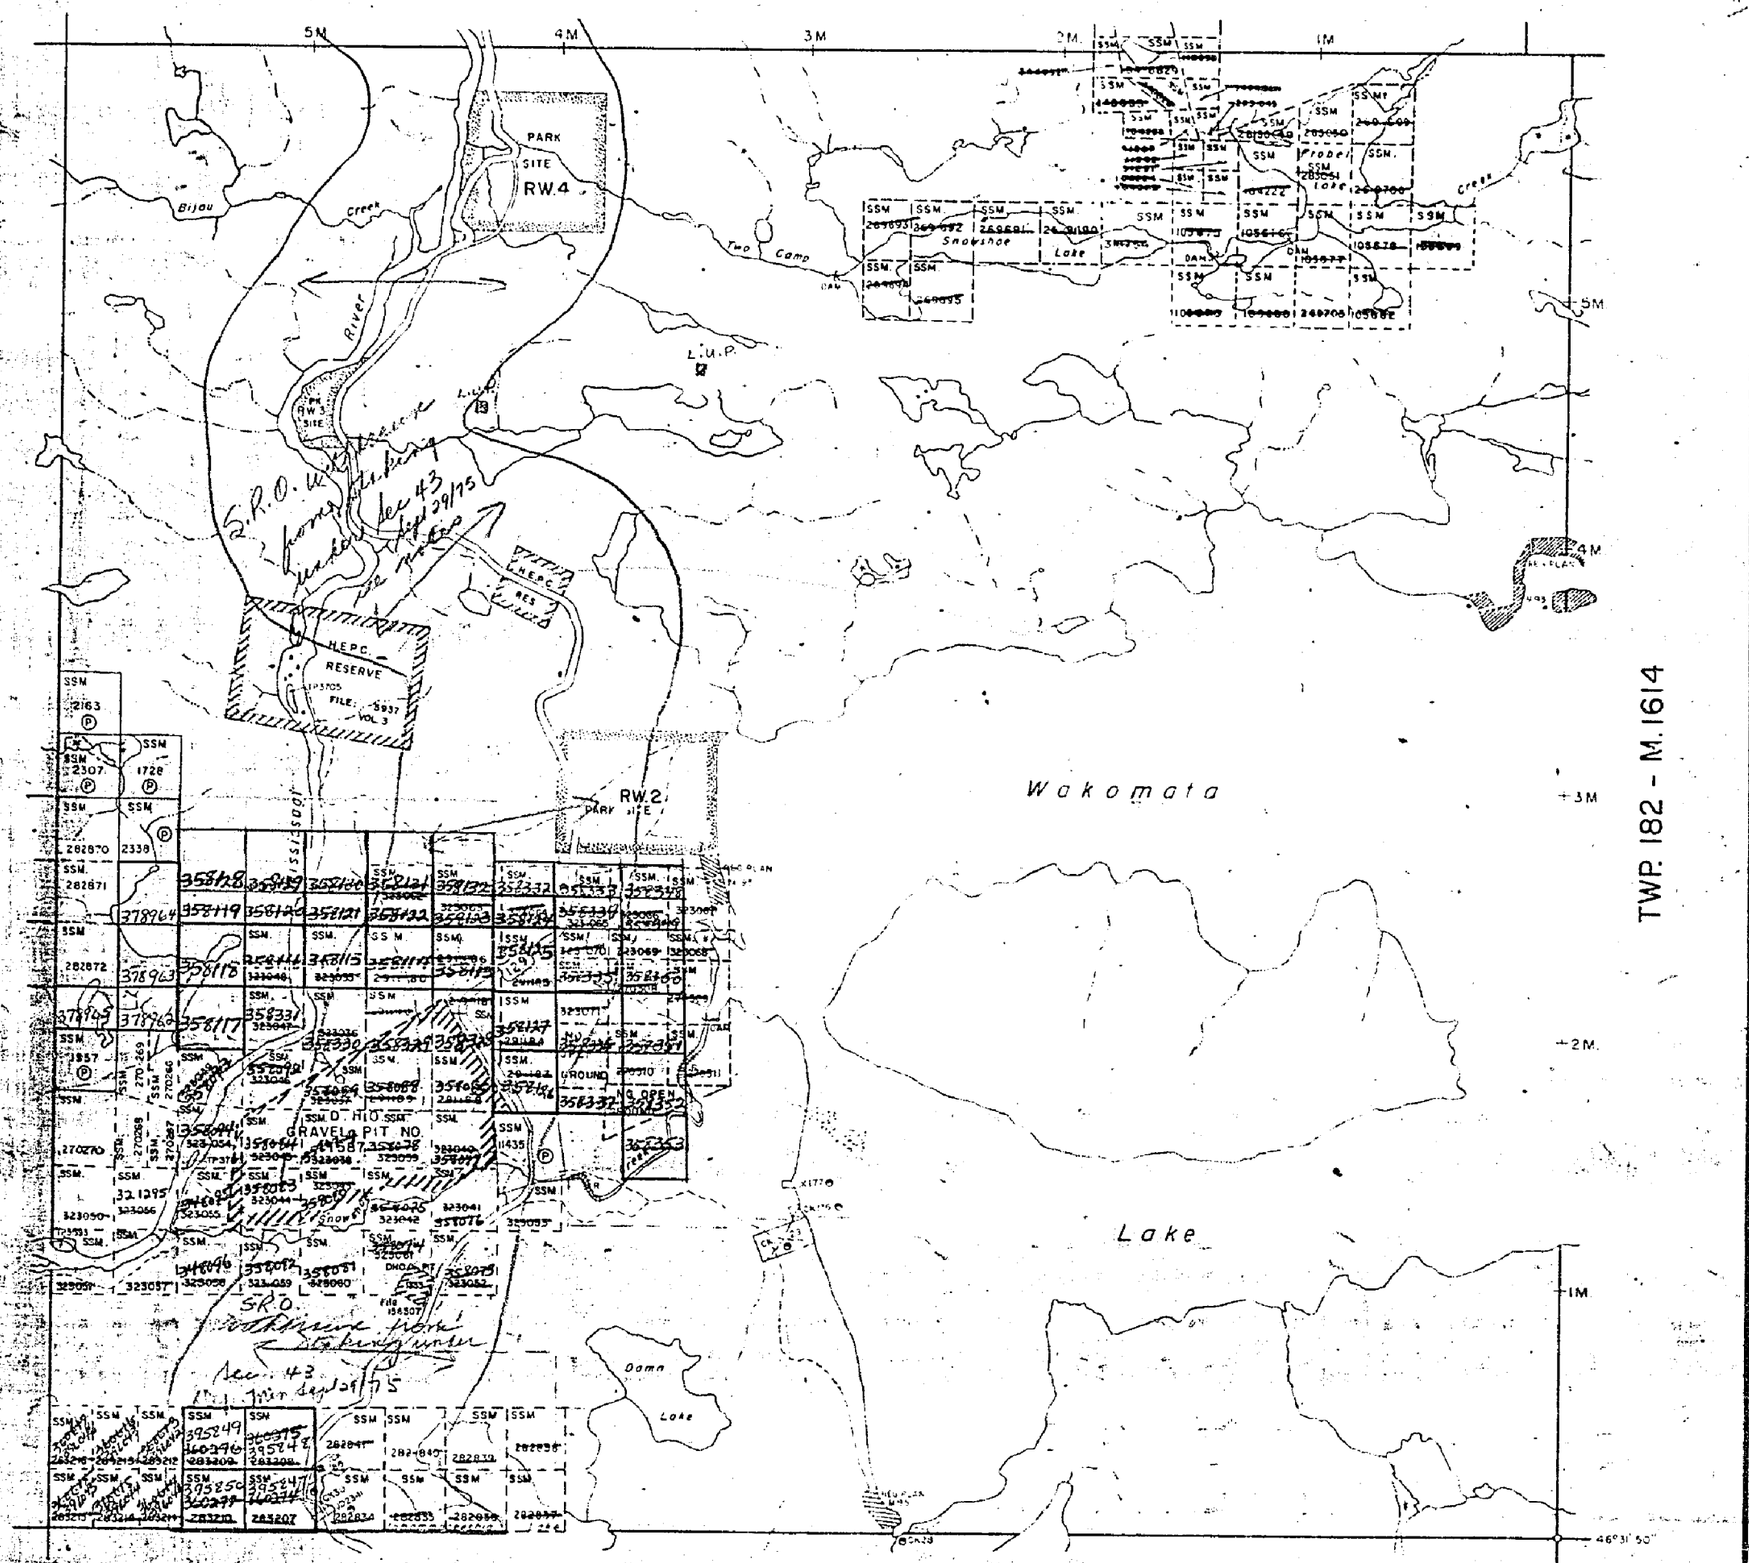

THE TOWNSHIP

188

(CASSON)

DISTRICT OF ALGOMA

SAULT STE. MARIE MINING DIVISION

SCALE: 1-INCH = 40 CHAINS

LEGEND

PATENTED LAND	P
CROWN LAND SALE	C.S.
LEASES	L
LOCATED LAND	Loc.
LICENSE OF OCCUPATION	L.O.
MINING RIGHTS ONLY	M.R.O.
SURFACE RIGHTS ONLY	S.R.O.
ROADS	
IMPROVED ROADS	
KING'S HIGHWAYS	
RAILWAYS	
POWER LINES	
MARSH OR MUSKEG	
MINES	
CANCELLED	C

NOTES

400' surface rights reservation around all lakes and rivers.

Summer resort locations patented for surface rights only shown thus

Flooding rights

- on Mississagi River reserved to contour 903' W.P.L.A. No. 35. File: 5937, Vol.4
- on Wakomata Lake to contour 1115' File: 2136, Vol. 182

AREA OUTLINED IN RED IS WITHDRAWN FROM PROSPECTING, STAKING OUT, SALE OR LEASE under Sec 43 of M.A. excepting and reserving therefrom all MTC Gravel Pits, quarry permits, park sites, unpatented mining claims & other lands patented, sold, leased or otherwise alienated from the Crown, letter Dep. Minister - Sept 9/75.

PLAN NO. M.1615

ONTARIO
DEPARTMENT OF MINES
AND NORTHERN AFFAIRS

1615

TWP. IF - M.1379

TWP. IE - M.1378

OTTER TWP - M.1325

TWP. 182 - M.1614

GOULD TWP. - M.455

SEWAGE LAGOON
(SEE LANDROLL FILE)

THE TOWNSHIP

188
CASSON

DISTRICT OF
ALGOMA

SAULT STE. MARIE
MINING DIVISION

SCALE: 1-INCH = 40 CHAINS

LEGEND

PATENTED LAND	(P)
CROWN LAND SALE	C.S
LEASES	(L)
LOCATED LAND	Loc.
LICENSE OF OCCUPATION	L.O.
MINING RIGHTS ONLY	M.R.O.
SURFACE RIGHTS ONLY	S.R.O.
ROADS	
IMPROVED ROADS	
KING'S HIGHWAYS	
RAILWAYS	
POWER LINES	
MARSH OR MUSKEG	
MINES	
CANCELLED	C.

NOTES

400' surface rights reservation around all lakes and rivers.

Summer resort locations patented for surface rights only shown thus (P).

Flooding rights

- on Mississagi River reserved to contour 903' W.P.L.A. No. 33. File: 5937, Vol.4
- on Wakomata Lake to contour 1115' File: 2136, Vol. 182

PLAN NO. M.1615

ONTARIO
DEPARTMENT OF MINES
AND NORTHERN AFFAIRS

1615

TWP. 1F - M.1379

TWP. 1E - M.1378

OTTER TWP. - M.1325

TWP. 182 - M.1614

GOULD TWP. - M.455

THE TOWNSHIP

188

CASSON

DISTRICT OF
ALGOMA

SAULT STE. MARIE
MINING DIVISION

SCALE: 1-INCH = 40 CHAINS

LEGEND

PATENTED LAND	Ⓟ
CROWN LAND SALE	C.S
LEASES	Ⓛ
LOCATED LAND	Loc.
LICENSE OF OCCUPATION	L.O.
MINING RIGHTS ONLY	M.R.O.
SURFACE RIGHTS ONLY	S.R.O.
ROADS	
IMPROVED ROADS	
KING'S HIGHWAYS	
RAILWAYS	
POWER LINES	
MARSH OR MUSKEG	
MINES	
CANCELLED	C

NOTES

400' surface rights reservation around all lakes and rivers

Summer resort locations patented for surface rights only shown thus ◓

Flooding rights

- on Mississagi River reserved to contour 903' W.P.L.A. No. 35. File: 5937, Vol.4
- on Wakomata Lake to contour 1115' File: 2136, Vol. 182

PLAN NO. M.1615

DEPARTMENT OF MINES

— ONTARIO —

1615


TOWNSHIP 188

DISTRICT OF ALGOMA (CASSOW)

Scale 40. Chains 1 Inch.

M.1615

TOWNSHIP 1 F

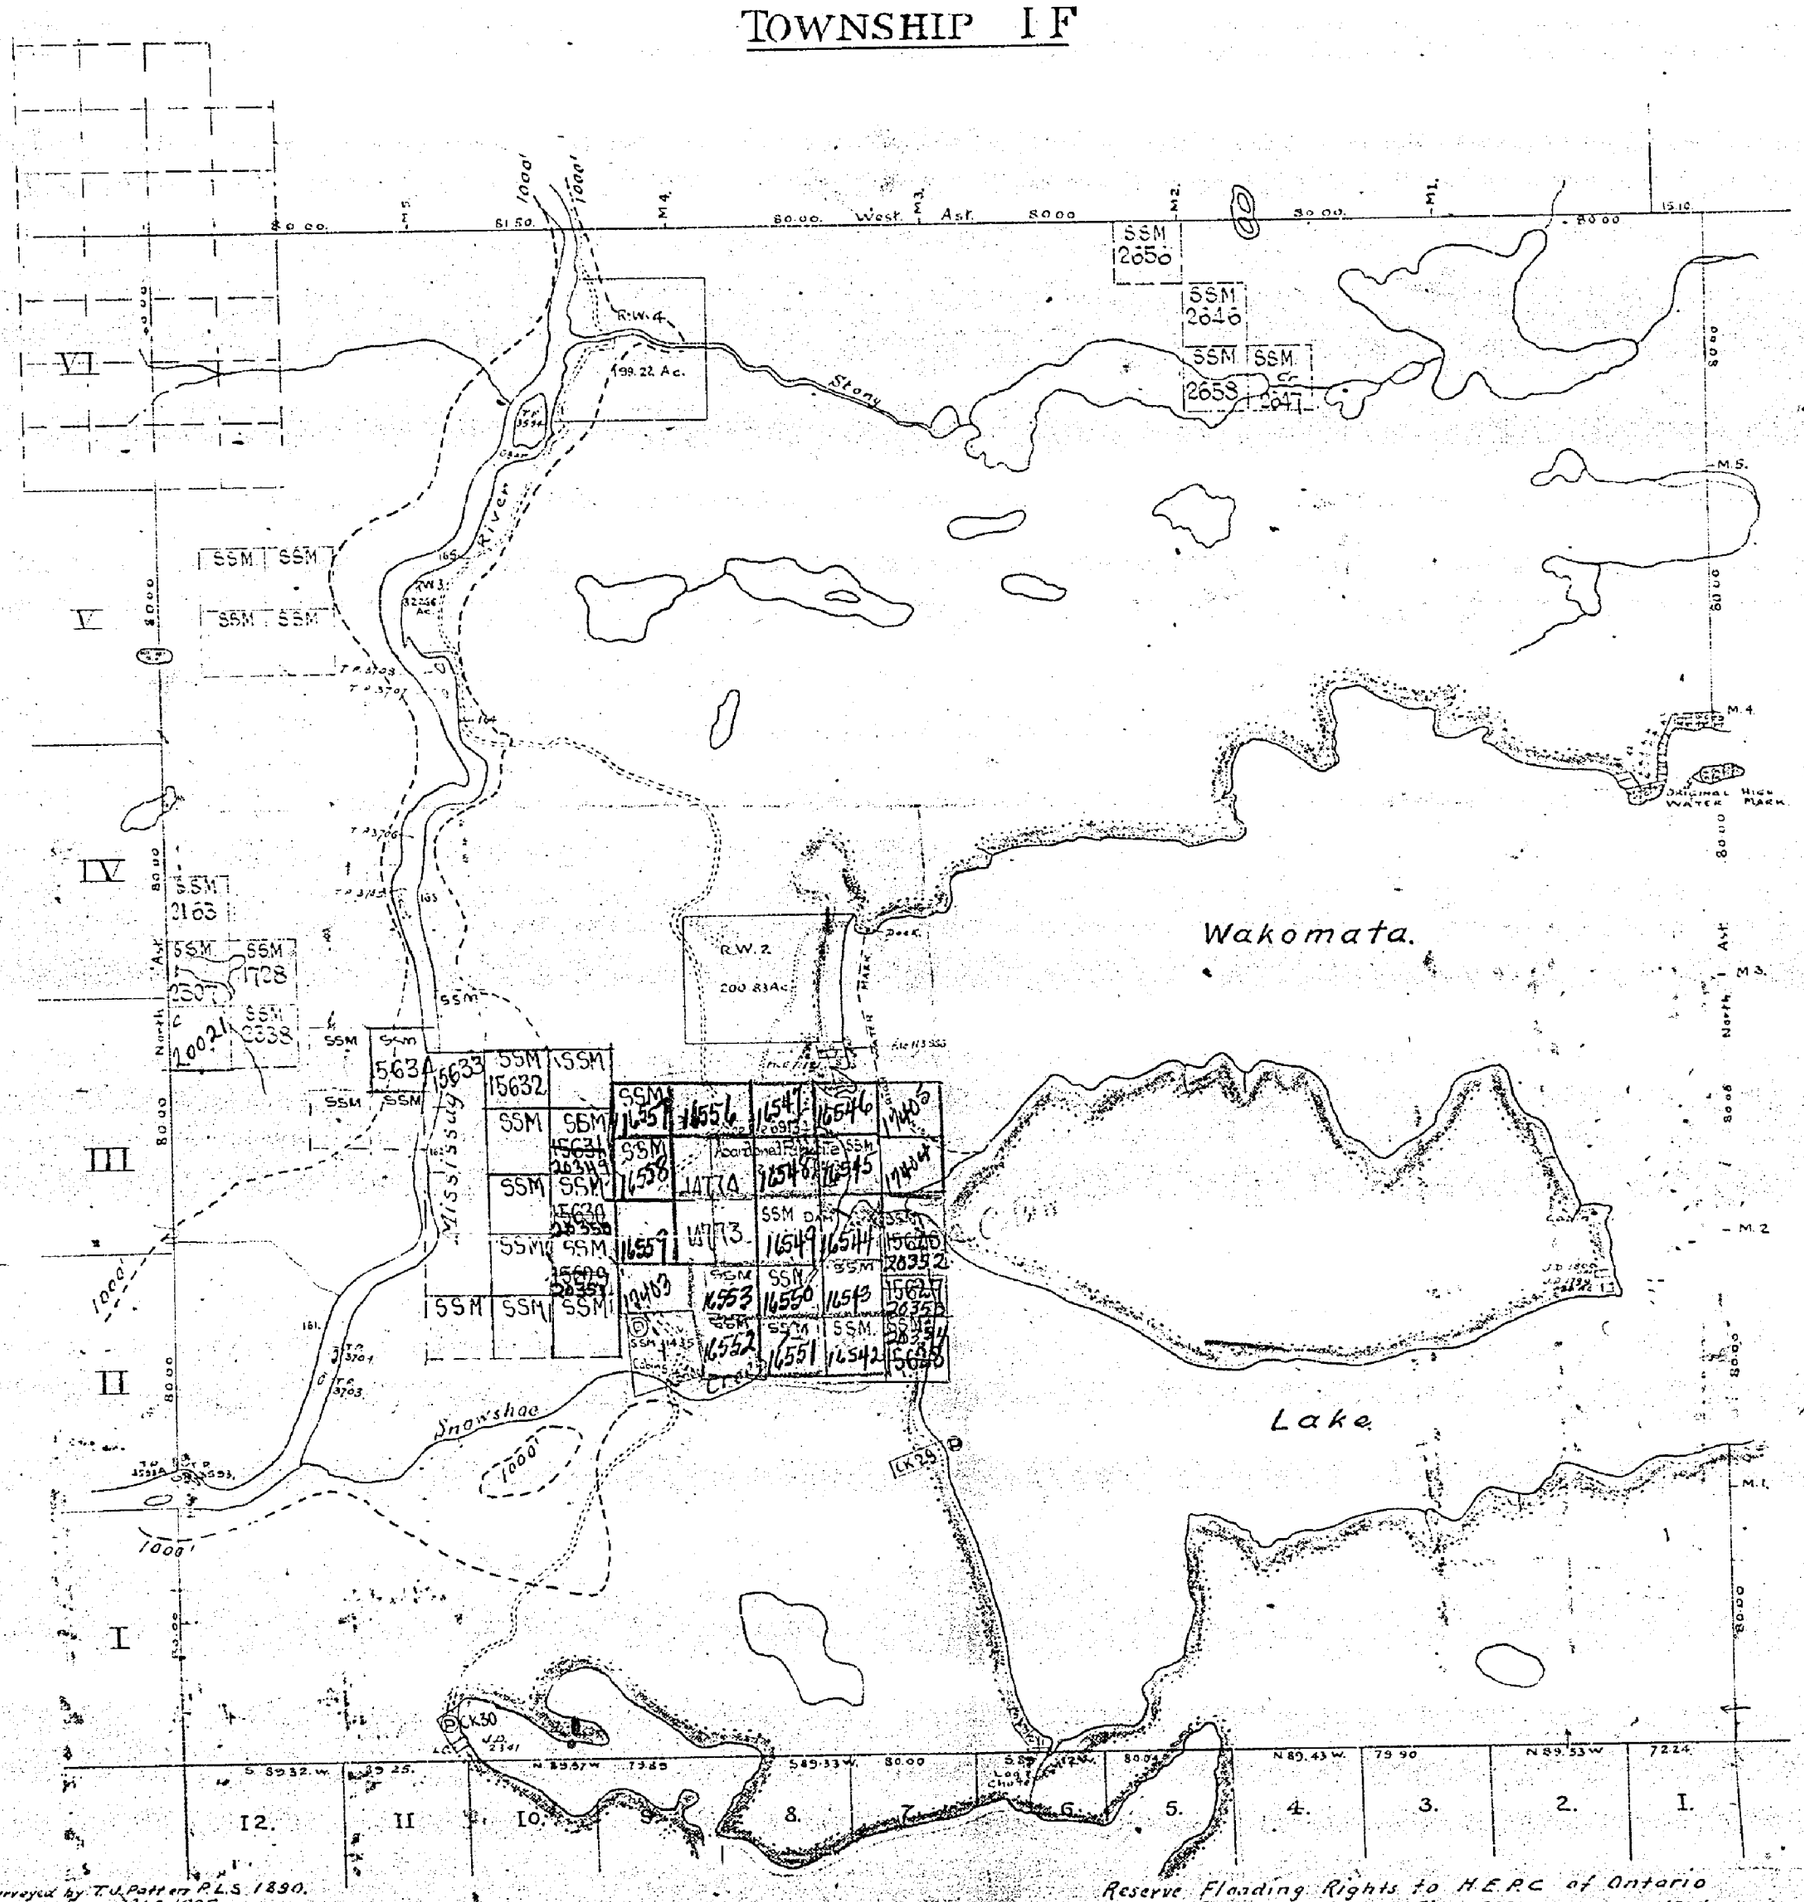

1615


TMB 188 22W 382

TOWNSHIP 188

DISTRICT OF ALGOMA (CASSON)

Scale 40 Chains 1 Inch M. 1615

TOWNSHIP 1 F

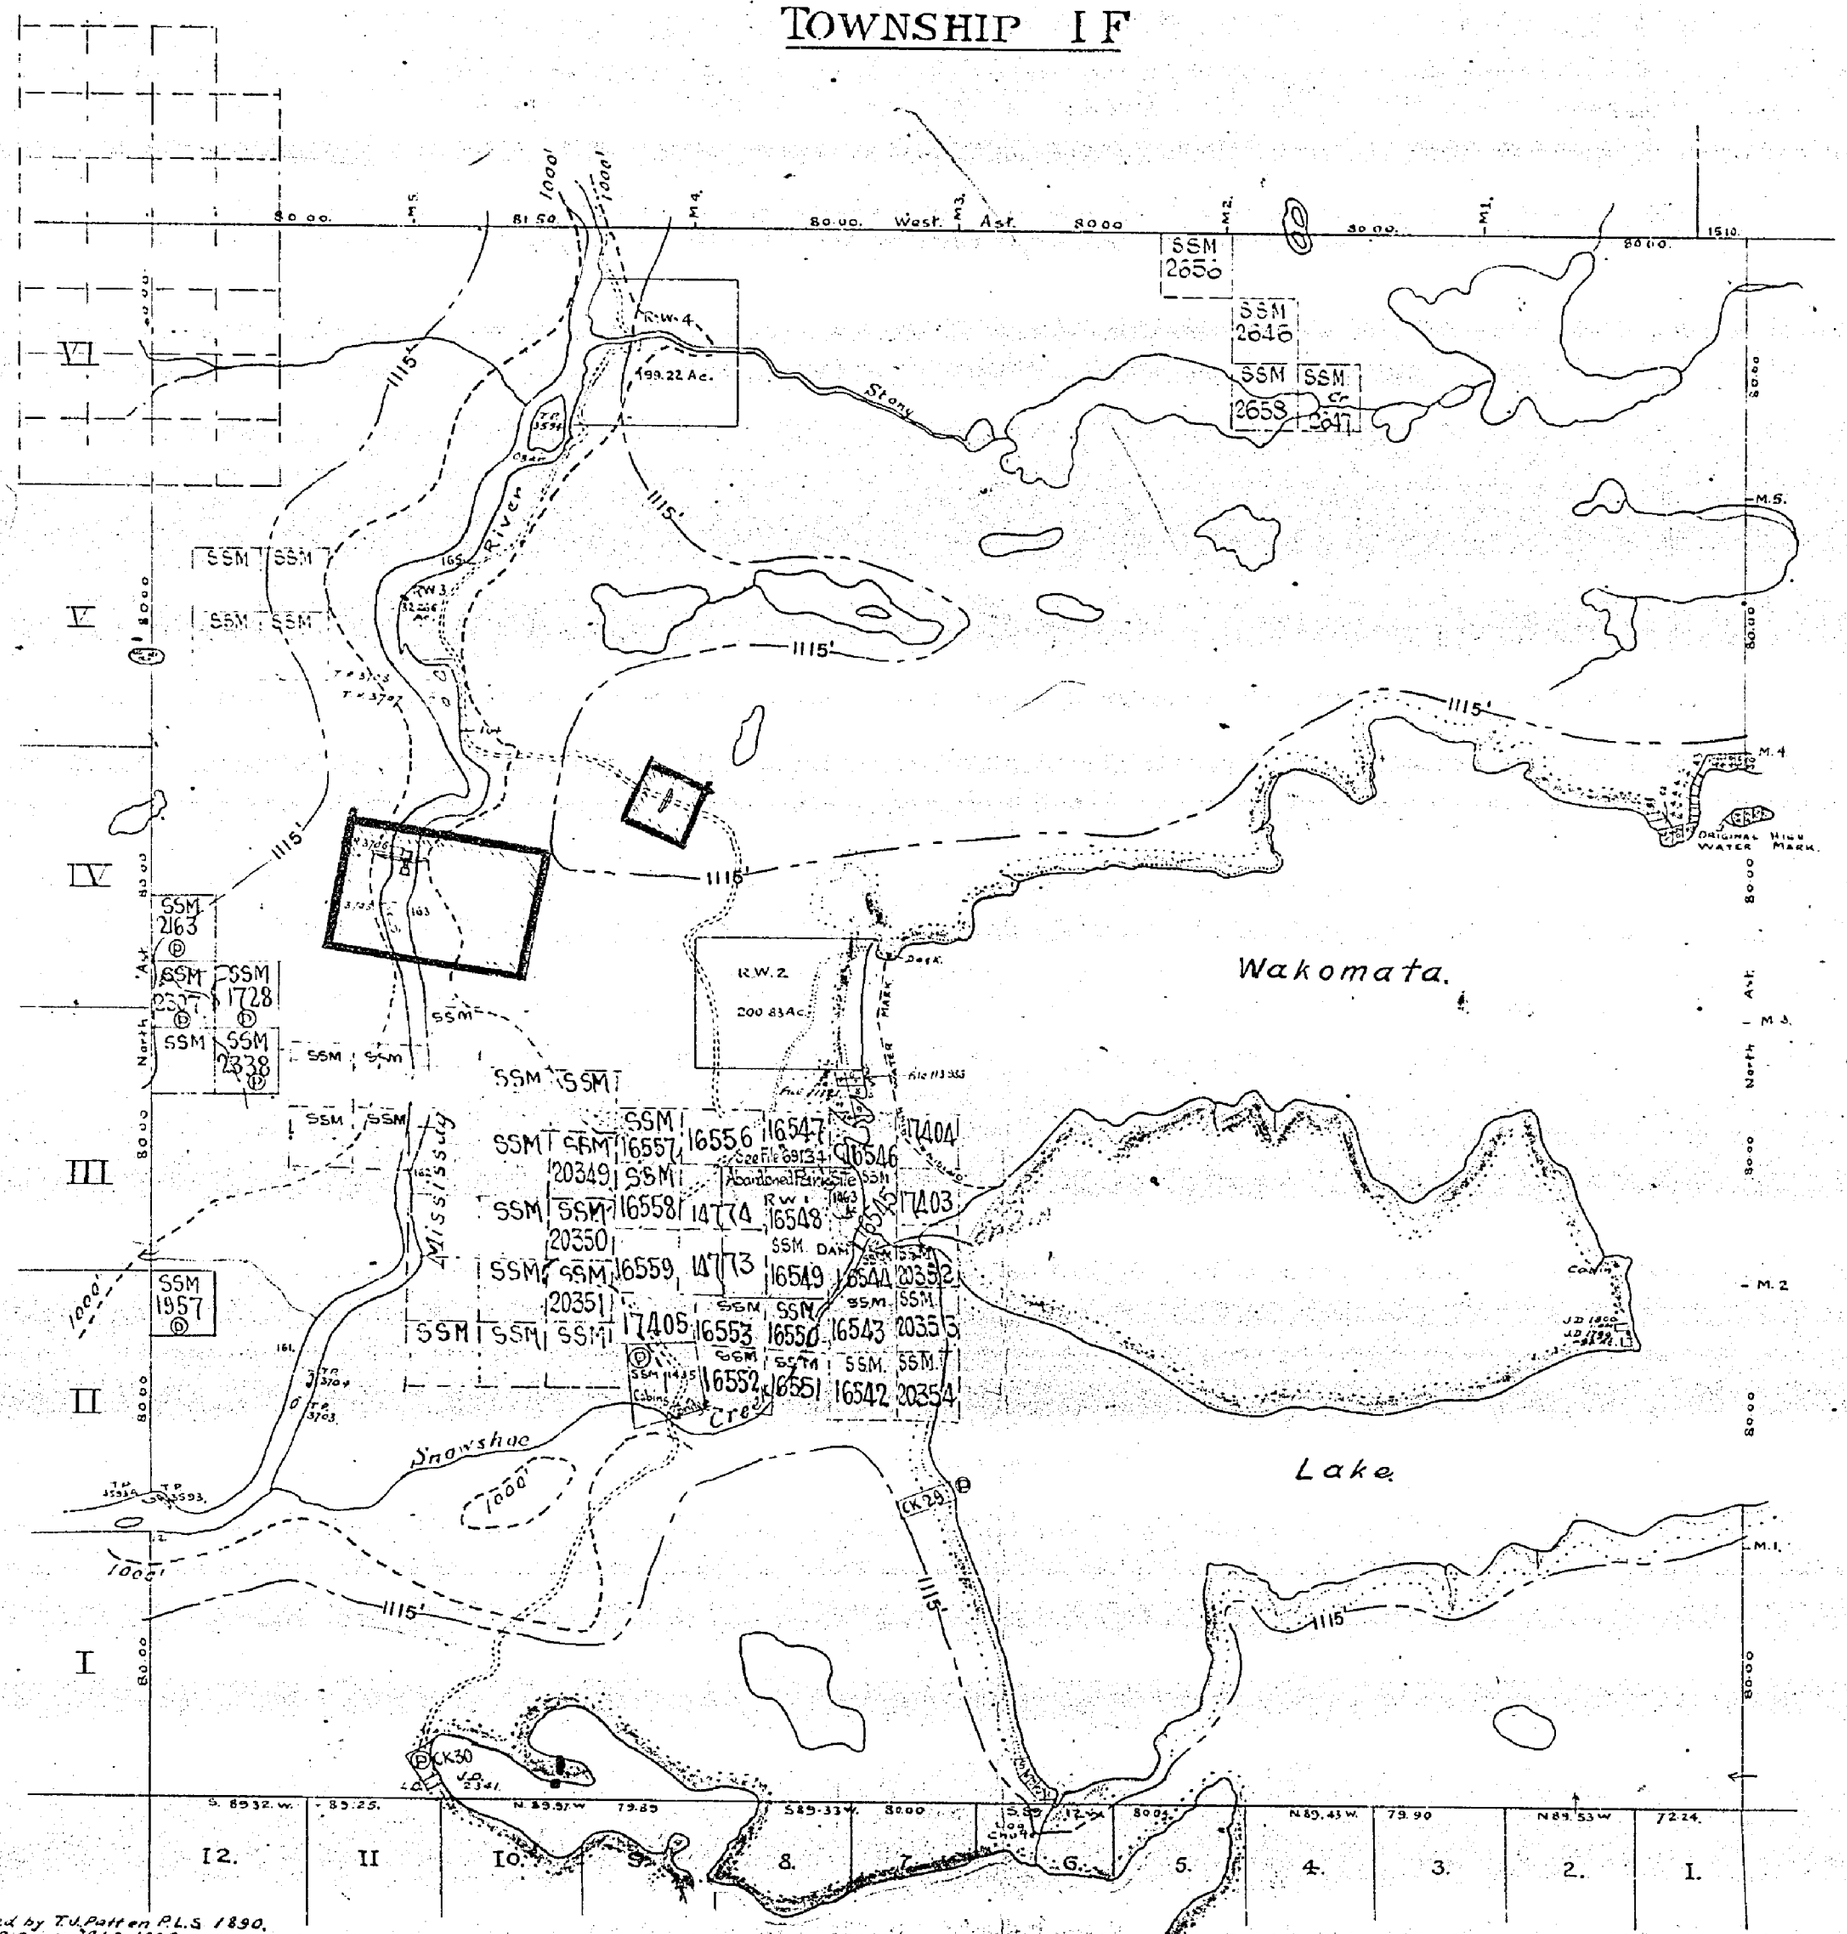

OTTER

TOWNSHIP 182

North & East boundaries surveyed by T.J. Patten P.L.S. 1890.
South boundary surveyed by O. Bautty P.L.S. 1885.
West boundary surveyed by H.G. Cavana P.L.S. 1886.
South boundary re-surveyed by J.S. Dobie O.L.S. 1933.
Flooded lands surveyed by E.M. MacQuarrie O.L.S. 1928 to contour 1131.9. Area 284.7 Ac. shown thus
for the Mississagi River Improvement Co. Ltd. File 2136 L.O. 2084.
Mississagi River surveyed by T.J. Patten O.L.S. 1922.
Roads surveyed by C.F. Bush O.L.S. 1930 under instructions from the Dept. of Lands & Forests shown thus
Public Camps & Park Sites R.W.1, R.W.2, R.W.3 R.W.4 surveyed by R.W. Code O.L.S. 1939 under instructions
from the Dept. of Lands & Forests dated Aug 8th 1939. R.W.1 to R.W.4 inclusive are originally known as
Park or Camp reservations Nos 23, 24, 25 & 28 respectively and referred to in file 113986.
Subdivisions showing lots 1 to 5, 6 to 10, 39 to 57 inclusive, surveyed by J.S. Dobie O.L.S. 1939
under instructions from the Dept. of Lands & Forests
Lakes & Rivers from aerial survey Ontario Forestry Branch, Dept. of Lands & Forests 1928.

GOULD

Surface reservations 200' wide by Dept of L. & F. shown hereon thus

Reserve Flooding Rights to H.E.P.C. of Ontario to Contour 1120 G.S.C. File 5937. 1000'

FLOODING RIGHTS TO H.E.P.C. 1115'

Area Withdrawn From Staking Shown Thus

Parcels marked P. are Patented.
L. Leased.
LO. License of Occupation.

Department of Surveys.
Parliament Buildings.
Toronto, Ontario, Canada.

M.22

1615

TOWNSHIP 188

DISTRICT OF ALGOMA

(CASSON)
M. 1615

Scale 40 Chains = 1 Inch

TOWNSHIP 1F

PARK OR CAMP RESERVE No. 28 FILE 113986

PARK OR CAMP RESERVE No. 25 FILE 113986

PARK OR CAMP RESERVE No. 24. FILE 113986

PARK OR CAMP RESERVE No. 23 FILE 113986

Steen cr

Mississagi River

Snowshoe Creek

Wahomata Lake

OTTER

TOWNSHIP 182

M & L Bdys by P.L.S T.J. Patten 1890.
S Bdy " P.L.S. D. Beatty 1885
W " P.L.S. A.G Cavana 1886.
Flooded lands by O.L.S. E.M. MacQuorrie Jan 4th 1928 to Contour 1139 shown thus ▨ Area 284.7 Acres
Traverse of Mississagi River by O.L.S. T.J. Patten 1922

Road shown thus ═══ surveyed by O.L.S. C.E. Bush 1930
Other Lakes and Rivers from Aerial Survey

GOULD

Department of Surveys
Parliament Buildings
Toronto, Ontario, Canada

1615

PLAN OF TWP. 188.

OFFICE MAP (CASSON)

SAULT STE. MARIE MINING DIVISION.

DISTRICT OF ALGOMA.

Scale, 40 chains to an inch.

M. 1615

TWP. 1.F

Azt. North.

W. E. S.

OTTER T'WP.

T'WP. 182.

WAKOMATA LAKE.

GOULD T'WP.

Mississagi River

Stony

Snowshoe Creek

R.W.4 99.22 Ac.

R.W.2 Ac. 200.83

R.W.3 Ac. 32.266

Albondonned Camp Site 1.43 Ac.

Cabin

Bridge

Original High Water Mark.

Notes.

Railways Shewn
Paved Highways
Gravel "
Highway Route Nos (2)
Other Roads
Trails & Paths
Telephone & Telegraph Lines
Electric Power Lines
Non-perennial Streams
Surface reservations 200' cubic by Dept. of L & F Shewn

Bridges
Buildings
Swamps
Areas marked R are Patented
" " L " Leased
" " LO " held under Licence of Occupation
Areas with drawn from Staking.
Flooding rights to H.E.P.C. to Contour 1115 Shewn 1115 to 1120 G.S.C. File 5937

TOWNSHIP 188 SSM 365

1615

PLAN OF
T'WP. 188. (CASSON)

SAULT STE. MARIE MINING DIVISION.
DISTRICT OF ALGOMA.

Scale, 40 chains to an inch.

M. 1615

TWP 1.F

TWP 182.

OTTER T'WP.

WAKOMATA LAKE.

GOULD T'WP.

Notes.

Railways shewn
Paved Highways
Gravel "
Highway Route Nos (2)
Other Roads
Trails & Paths.
Telephone & Telegraph Lines
Electric Power Lines
Non-perennial streams
Surface reservations 200' radius
By Dept. of L & F shewn

Bridges
Buildings
Swamps.
Areas marked P are Patented
L " Leased
LO " held under Licence of Occupation
Areas withdrawn from staking.
Flooding rights to H.E.P.C. to Contour 1115
Shewn 1115 to 1120 G.S.C. File 5937

TOWNSHIP 188. S.S.M.


1615

TOWNSHIP 188

DISTRICT OF ALGOMA (CASSON)

Scale 40 Chains 1 Inch. M. 1615

TOWNSHIP I F

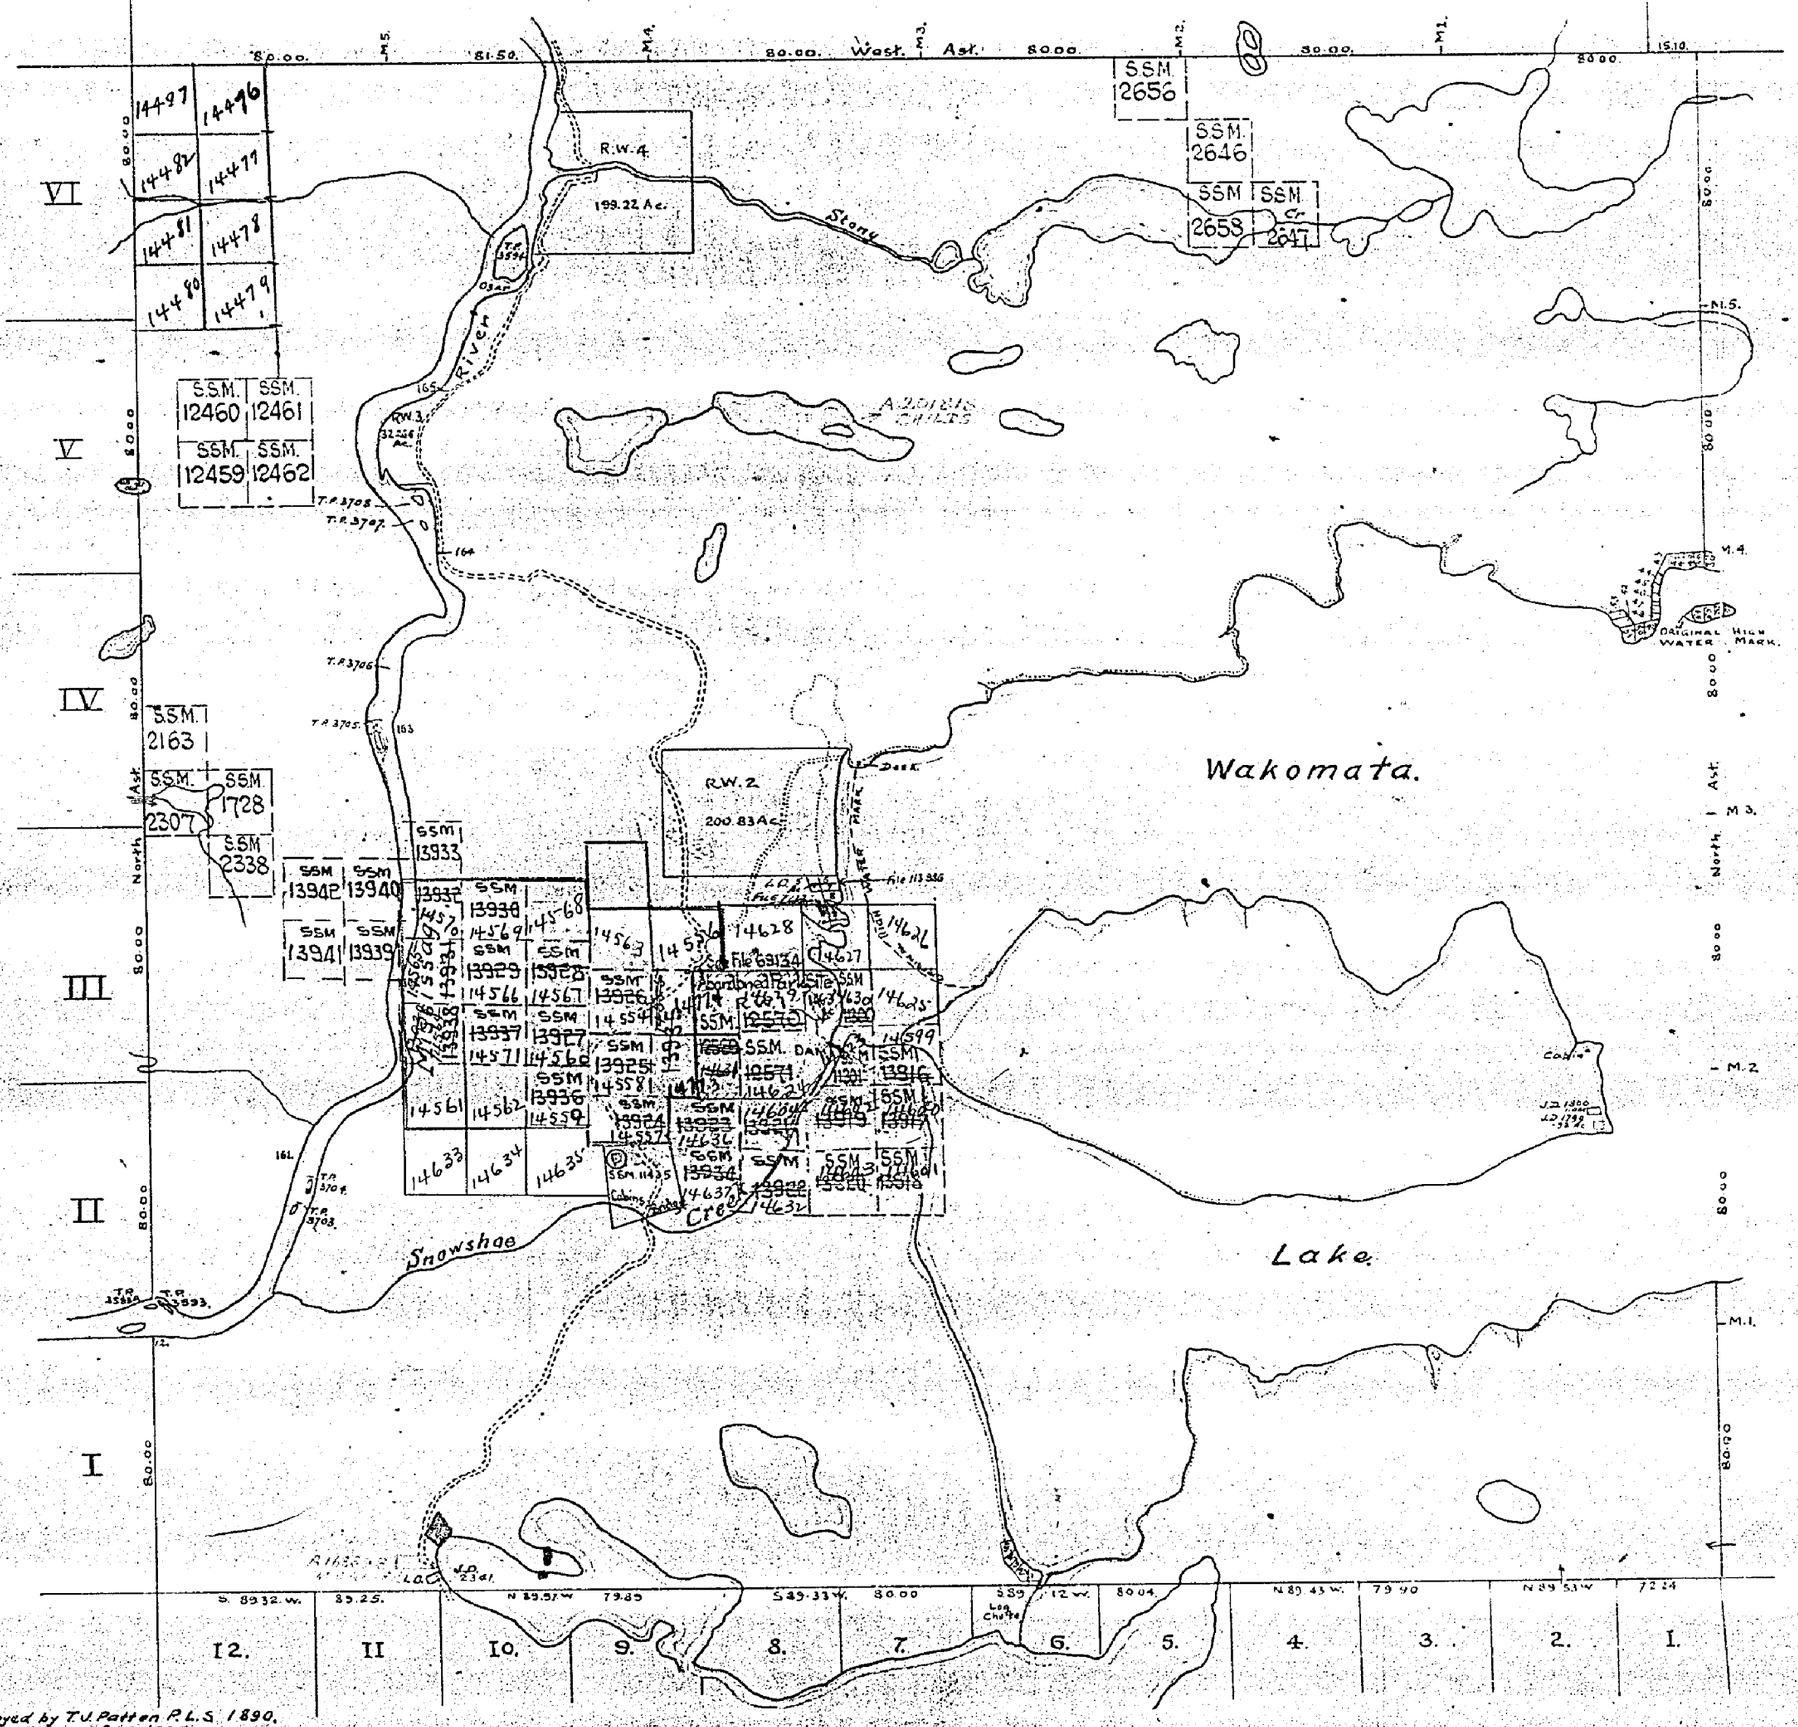

1615

DAGLE TP. M.1379

WAGG TP. M.1378

OTTER TWP. - M.1325

JACKSON TWP. M.1614

GOULD TWP. - M.455

5M. 4M. 3M. 2M. 1M.

+3M. +2M. +1M.

PARK SITE RW.4

PARK RW.3 SITE

PARK RW.2 SITE

Bijou Creek

River

Two Camp DAM

Snowshoe Lake DAM

Frobel Lake

Creek

Wakomata Lake

Damn Lake

Mississagi

Surface Rights only are reopened for prospecting, sale or lease - excepting SITC gravel pits, quarry permits, mineral claims, patented lands, unpatented Sec. 43 - M.A. lots, Crown roads, roads under license.

July 5/77

Deputy Minister

SSM 2163 (P)
SSM 2307 (P)
SSM 1728 (P)
SSM 282670 2338 (P)
SSM 282871
SSM 378964
SSM 282872 378963
SSM 378965 378962
SSM 1957 (P)
SSM 270269 270266
SSM 270270 270268 270267
SSM 321295
SSM 11435 (P)
TP3705
TP3703
TP3593
SSM 395849 395848
SSM 395850 395847
SSM 396043 396044 396045 396046 396047
396780 396781 396782 396783 396784 396785 396786 396787

REG. PLAN M.95

CK177 CK176 CK175 CK130 CK128

123

Lake Wabahmageeshig

46°31' 50"

83°20' 05"

b.k.

THE TOWNSHIP

CASSON

(Tp. 188)

DISTRICT OF ALGOMA

SAULT STE. MARIE MINING DIVISION

SCALE: 1-INCH = 40 CHAINS

LEGEND

PATENTED LAND	(P)
CROWN LAND SALE	C.S.
LEASES	(L)
LOCATED LAND	Loc.
LICENSE OF OCCUPATION	L.O.
MINING RIGHTS ONLY	M.R.O.
SURFACE RIGHTS ONLY	S.R.O.
ROADS	
IMPROVED ROADS	
KING'S HIGHWAYS	
RAILWAYS	
POWER LINES	
MARSH OR MUSKEG	
MINES	
CANCELLED	C.

NOTES

400' surface rights reservation along the shores of all lakes and rivers.

Summer resort locations patented for surface rights only shown thus (P)

Flooding rights

-on Mississagi River reserved to contour 903' W.P.L.A. Nº 35 F. 5937 vol.4

OTHER AREAS WITHDRAWN FROM STAKING

S.R. - SURFACE RIGHTS M.R.-MINING RIGHTS

Section	Order Nº.	Date	Disposition	File
(R1) 43 (R.S.O. 1970)	W.5610	25/8/72	S.R.	156507

DATE OF ISSUE OCT 7 1975

SAND & GRAVEL

(Q1) M.T.C. PIT Nº 1587
(Q2) M.T.C. PIT Nº 1333
(Q3) GRAVEL File 5937 vol.3
(Q4) GRAVEL File: 156507


PLAN NO. M.1615

ONTARIO
MINISTRY OF NATURAL RESOURCES
SURVEYS AND MAPPING BRANCH

1615

TWP. 1F - M.1379

TWP. 1E - M.1378

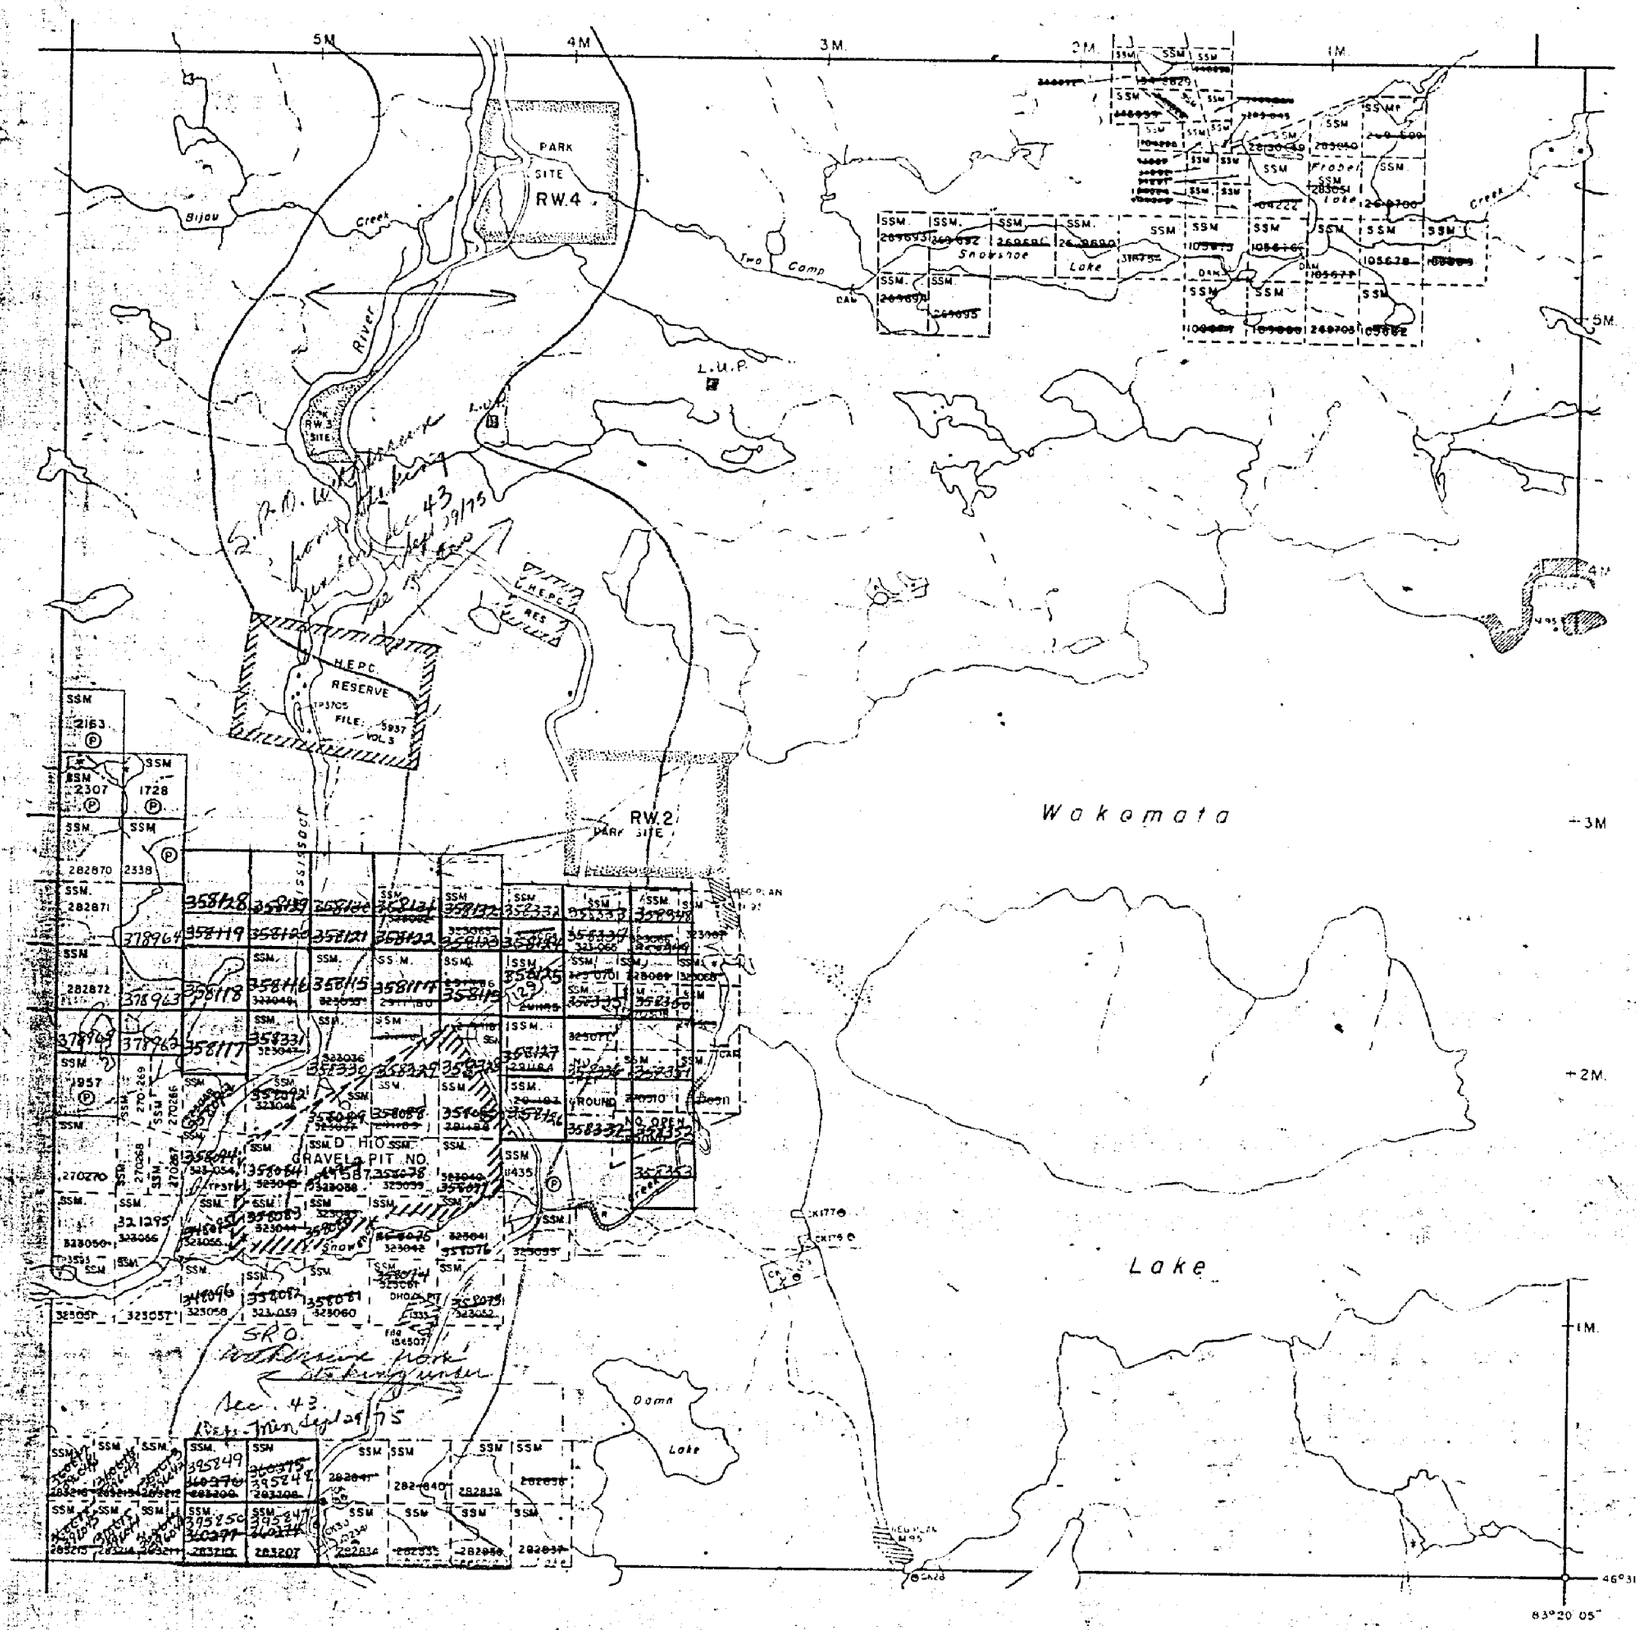

OTTER TWP. - M.1325

TWP. 182 - M.1614

GOULD TWP. - M.455

THE TOWNSHIP

188

(CASSON)

DISTRICT OF
ALGOMA

SAULT STE. MARIE
MINING DIVISION

SCALE: 1-INCH = 40 CHAINS

LEGEND

PATENTED LAND	(P)
CROWN LAND SALE	C.S
LEASES	(L)
LOCATED LAND	Loc
LICENSE OF OCCUPATION	L.O
MINING RIGHTS ONLY	M.R.O
SURFACE RIGHTS ONLY	S.R.O
ROADS	
IMPROVED ROADS	
KING'S HIGHWAYS	
RAILWAYS	
POWER LINES	
MARSH OR MUSKEG	
MINES	
CANCELLED	C

NOTES

400' surface rights reservation around all lakes and rivers.

Summer resort locations patented for surface rights only shown thus (P)

Flooding rights

-on Mississagi River reserved to contour 903' W.P.L.A. No. 35. File: 5937, Vol.4

-on Wakomata Lake to contour 1115' File: 2136, Vol. 182

AREA OUTLINED IN RED IS WITHDRAWN FROM PROSPECTING, STAKING OUT, SALE OR LEASE UNDER SEC 43 OF M.A. EXCEPTING & RESERVING THEREFROM ALL MTC GRAVEL PITS, QUARRY PERMITS, PARK SITES, SUSPENDED MINING CLAIMS, OTHER LANDS PATENTED, SOLD, LEASED OR OTHERWISE ALIENATED FROM THE CROWN, LETTER DEPT. TORONTO - SEPT 29/75.

PLAN NO. M.1615

ONTARIO
DEPARTMENT OF MINES
AND NORTHERN AFFAIRS


1615

TWP. IF - M.1379

TWP. IE - M.378

OTTER TWP. - M.1325

TWP. 182 - M.1614

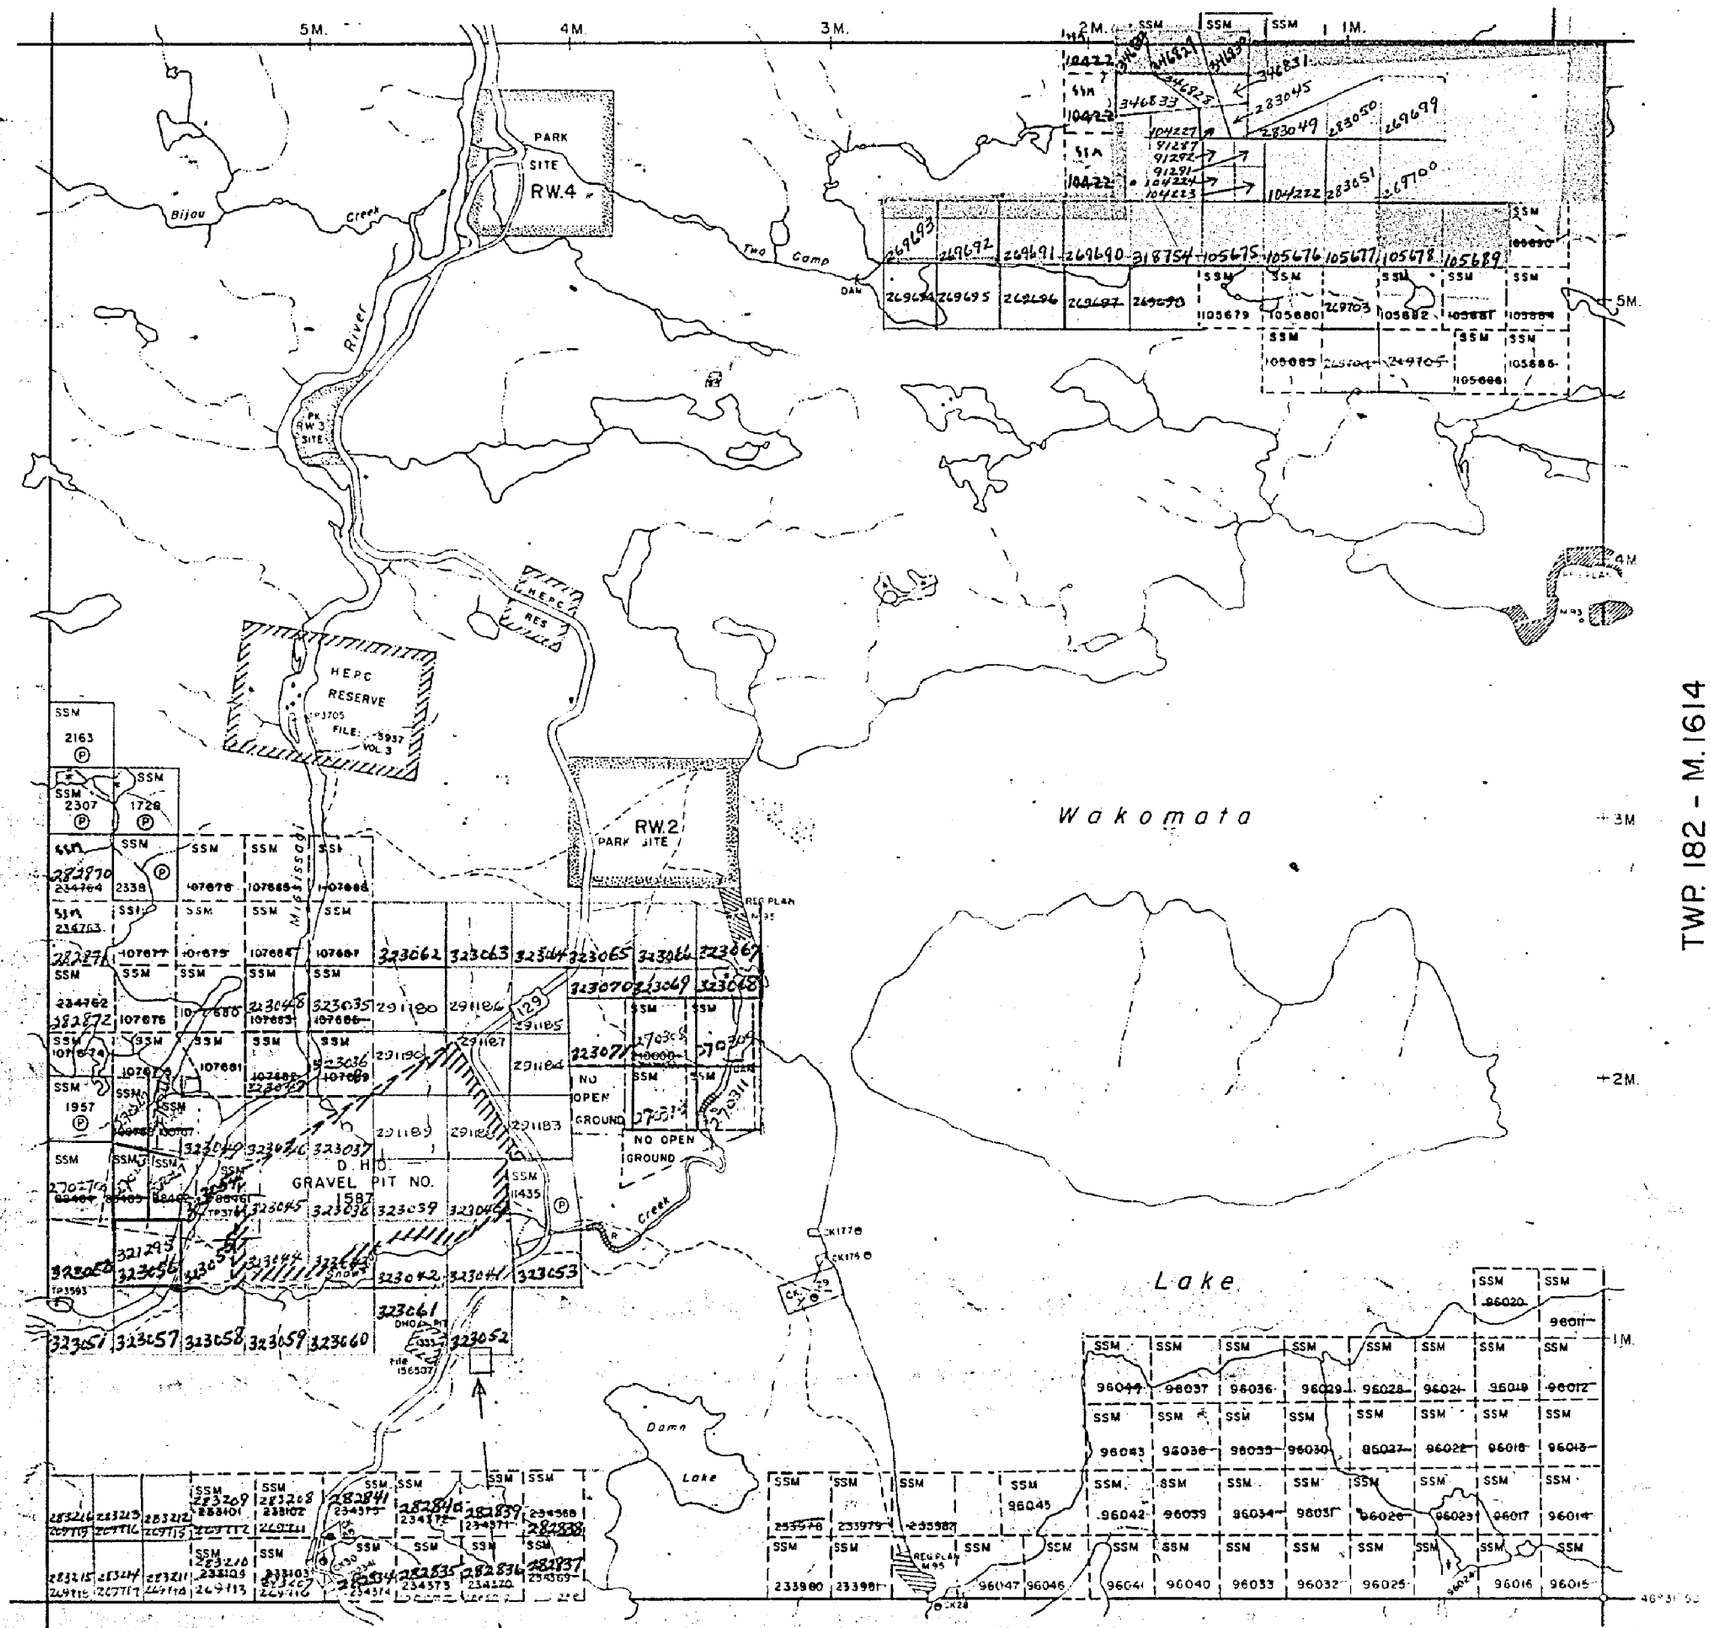

THE TOWNSHIP

188 CASSON

DISTRICT OF ALGOMA

SAULT STE. MARIE MINING DIVISION

SCALE: 1-INCH = 40 CHAINS

LEGEND

PATENTED LAND	P
CROWN LAND SALE	C.S
LEASES	L
LOCATED LAND	Loc.
LICENSE OF OCCUPATION	L.O.
MINING RIGHTS ONLY	M.R.O.
SURFACE RIGHTS ONLY	S.R.O
ROADS	
IMPROVED ROADS	
KING'S HIGHWAYS	
RAILWAYS	
POWER LINES	
MARSH OR MUSKEG	
MINES	
CANCELLED	C

NOTES

400' surface rights reservation around all lakes and rivers.

Summer resort locations patented for surface rights only shown thus

Flooding rights

- on Mississagi River reserved to contour 903' W.P.L.A. No. 35. File: 5937, Vol.4
- on Wakomata Lake to contour 1115' File: 2136, Vol. 182

PLAN NO. M.1615

ONTARIO DEPARTMENT OF MINES AND NORTHERN AFFAIRS

1615

TWP. 1F - M.1379

TWP. 1E - M.1378

OTTER TWP. - M.1325

TWP. 182 - M.1614

GOULD TWP. - M.455

THE TOWNSHIP

188

CASSON

DISTRICT OF
ALGOMA

SAULT STE. MARIE
MINING DIVISION

SCALE: 1-INCH = 40 CHAINS

LEGEND

PATENTED LAND	Ⓟ
CROWN LAND SALE	C.S.
LEASES	Ⓛ
LOCATED LAND	L.L.
LICENSE OF OCCUPATION	L.O.
MINING RIGHTS ONLY	M.R.O.
SURFACE RIGHTS ONLY	S.R.O.
ROADS	
IMPROVED ROADS	
KING'S HIGHWAYS	
RAILWAYS	
POWER LINES	
MARSH OR MUSKEG	
MINES	
CANCELLED	C

NOTES

400' surface rights reservation around all lakes and rivers.

Summer resort locations patented for surface rights only shown thus ◓

Flooding rights


- on Mississagi River reserved to contour 903' W.P.L.A. No. 35. File: 5937, Vol.4.
- on Wakomata Lake to contour 1115' File: 2136, Vol. 182

PLAN NO. M.1615

DEPARTMENT OF MINES

— ONTARIO —

1615

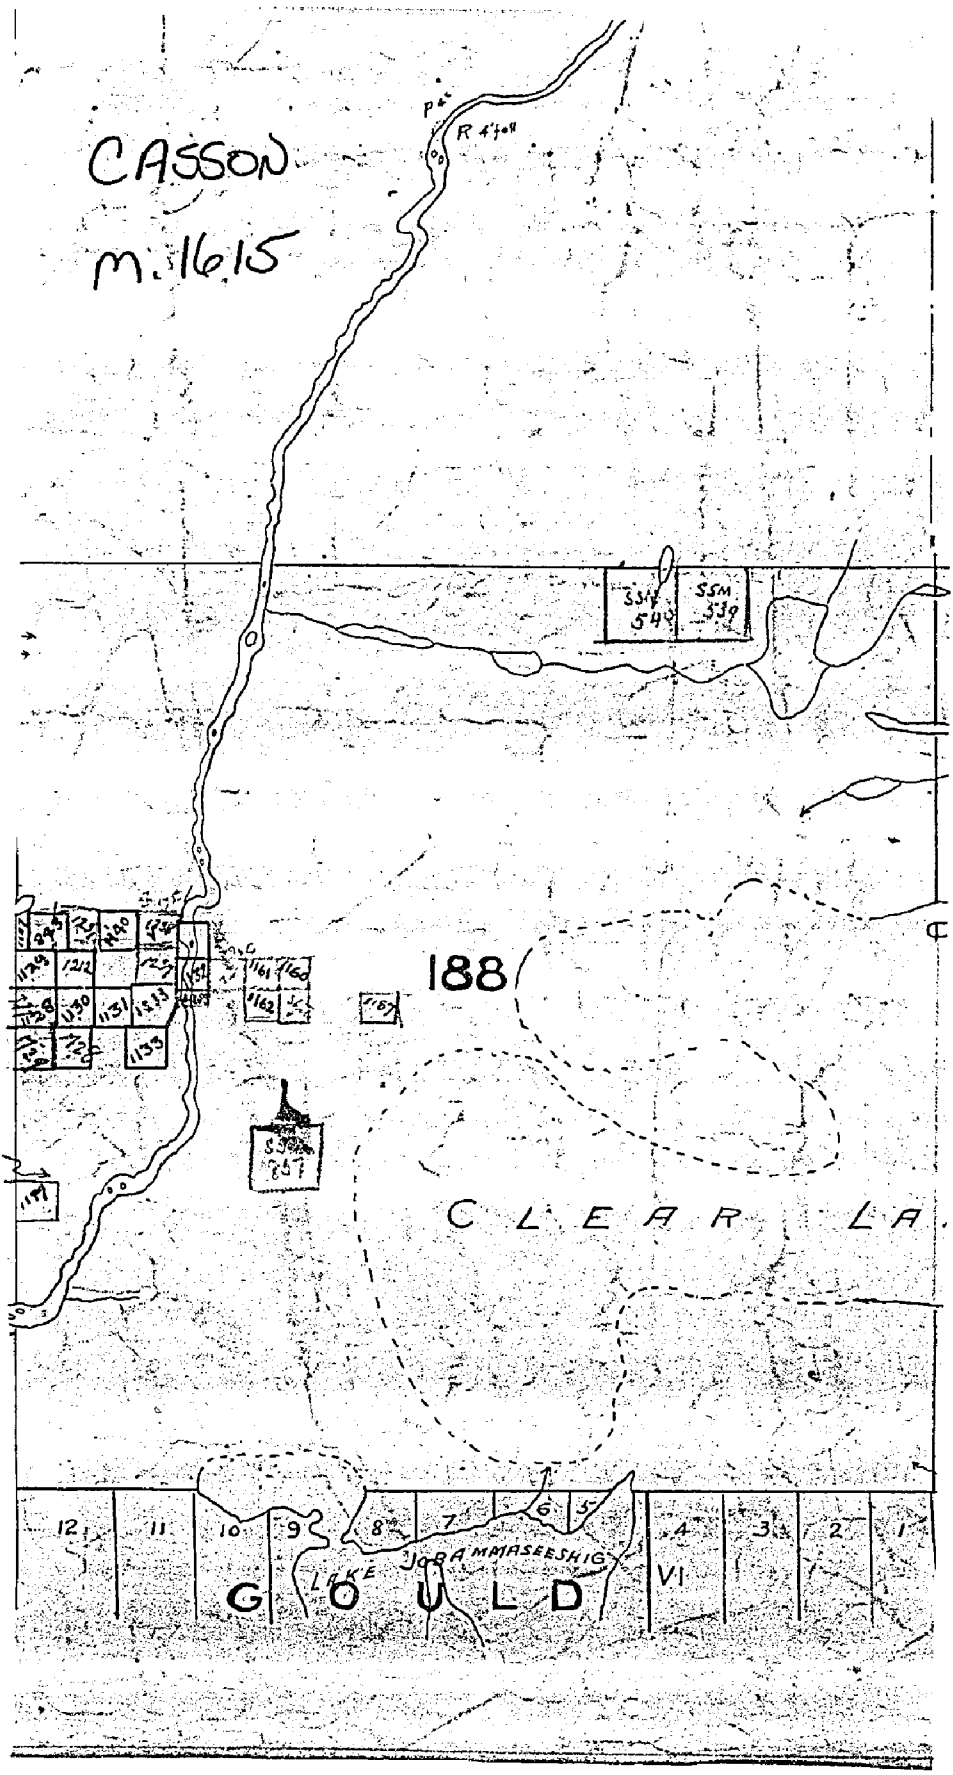
CASSON
M. 1615
R 4 to 11
188
CLEAR LA
LAKE JOSAMMASEESHIG
GOULD
12
11
10
9
8
7
6
5
4
3
2
1
VI

1615

PLAN OF
TWP. 188.


OFFICE MAP
(CASSON)

SAULT STE. MARIE MINING DIVISION.
DISTRICT OF ALGOMA.

Scale, 40 chains to an inch.

M. 1615

TWP 1.F

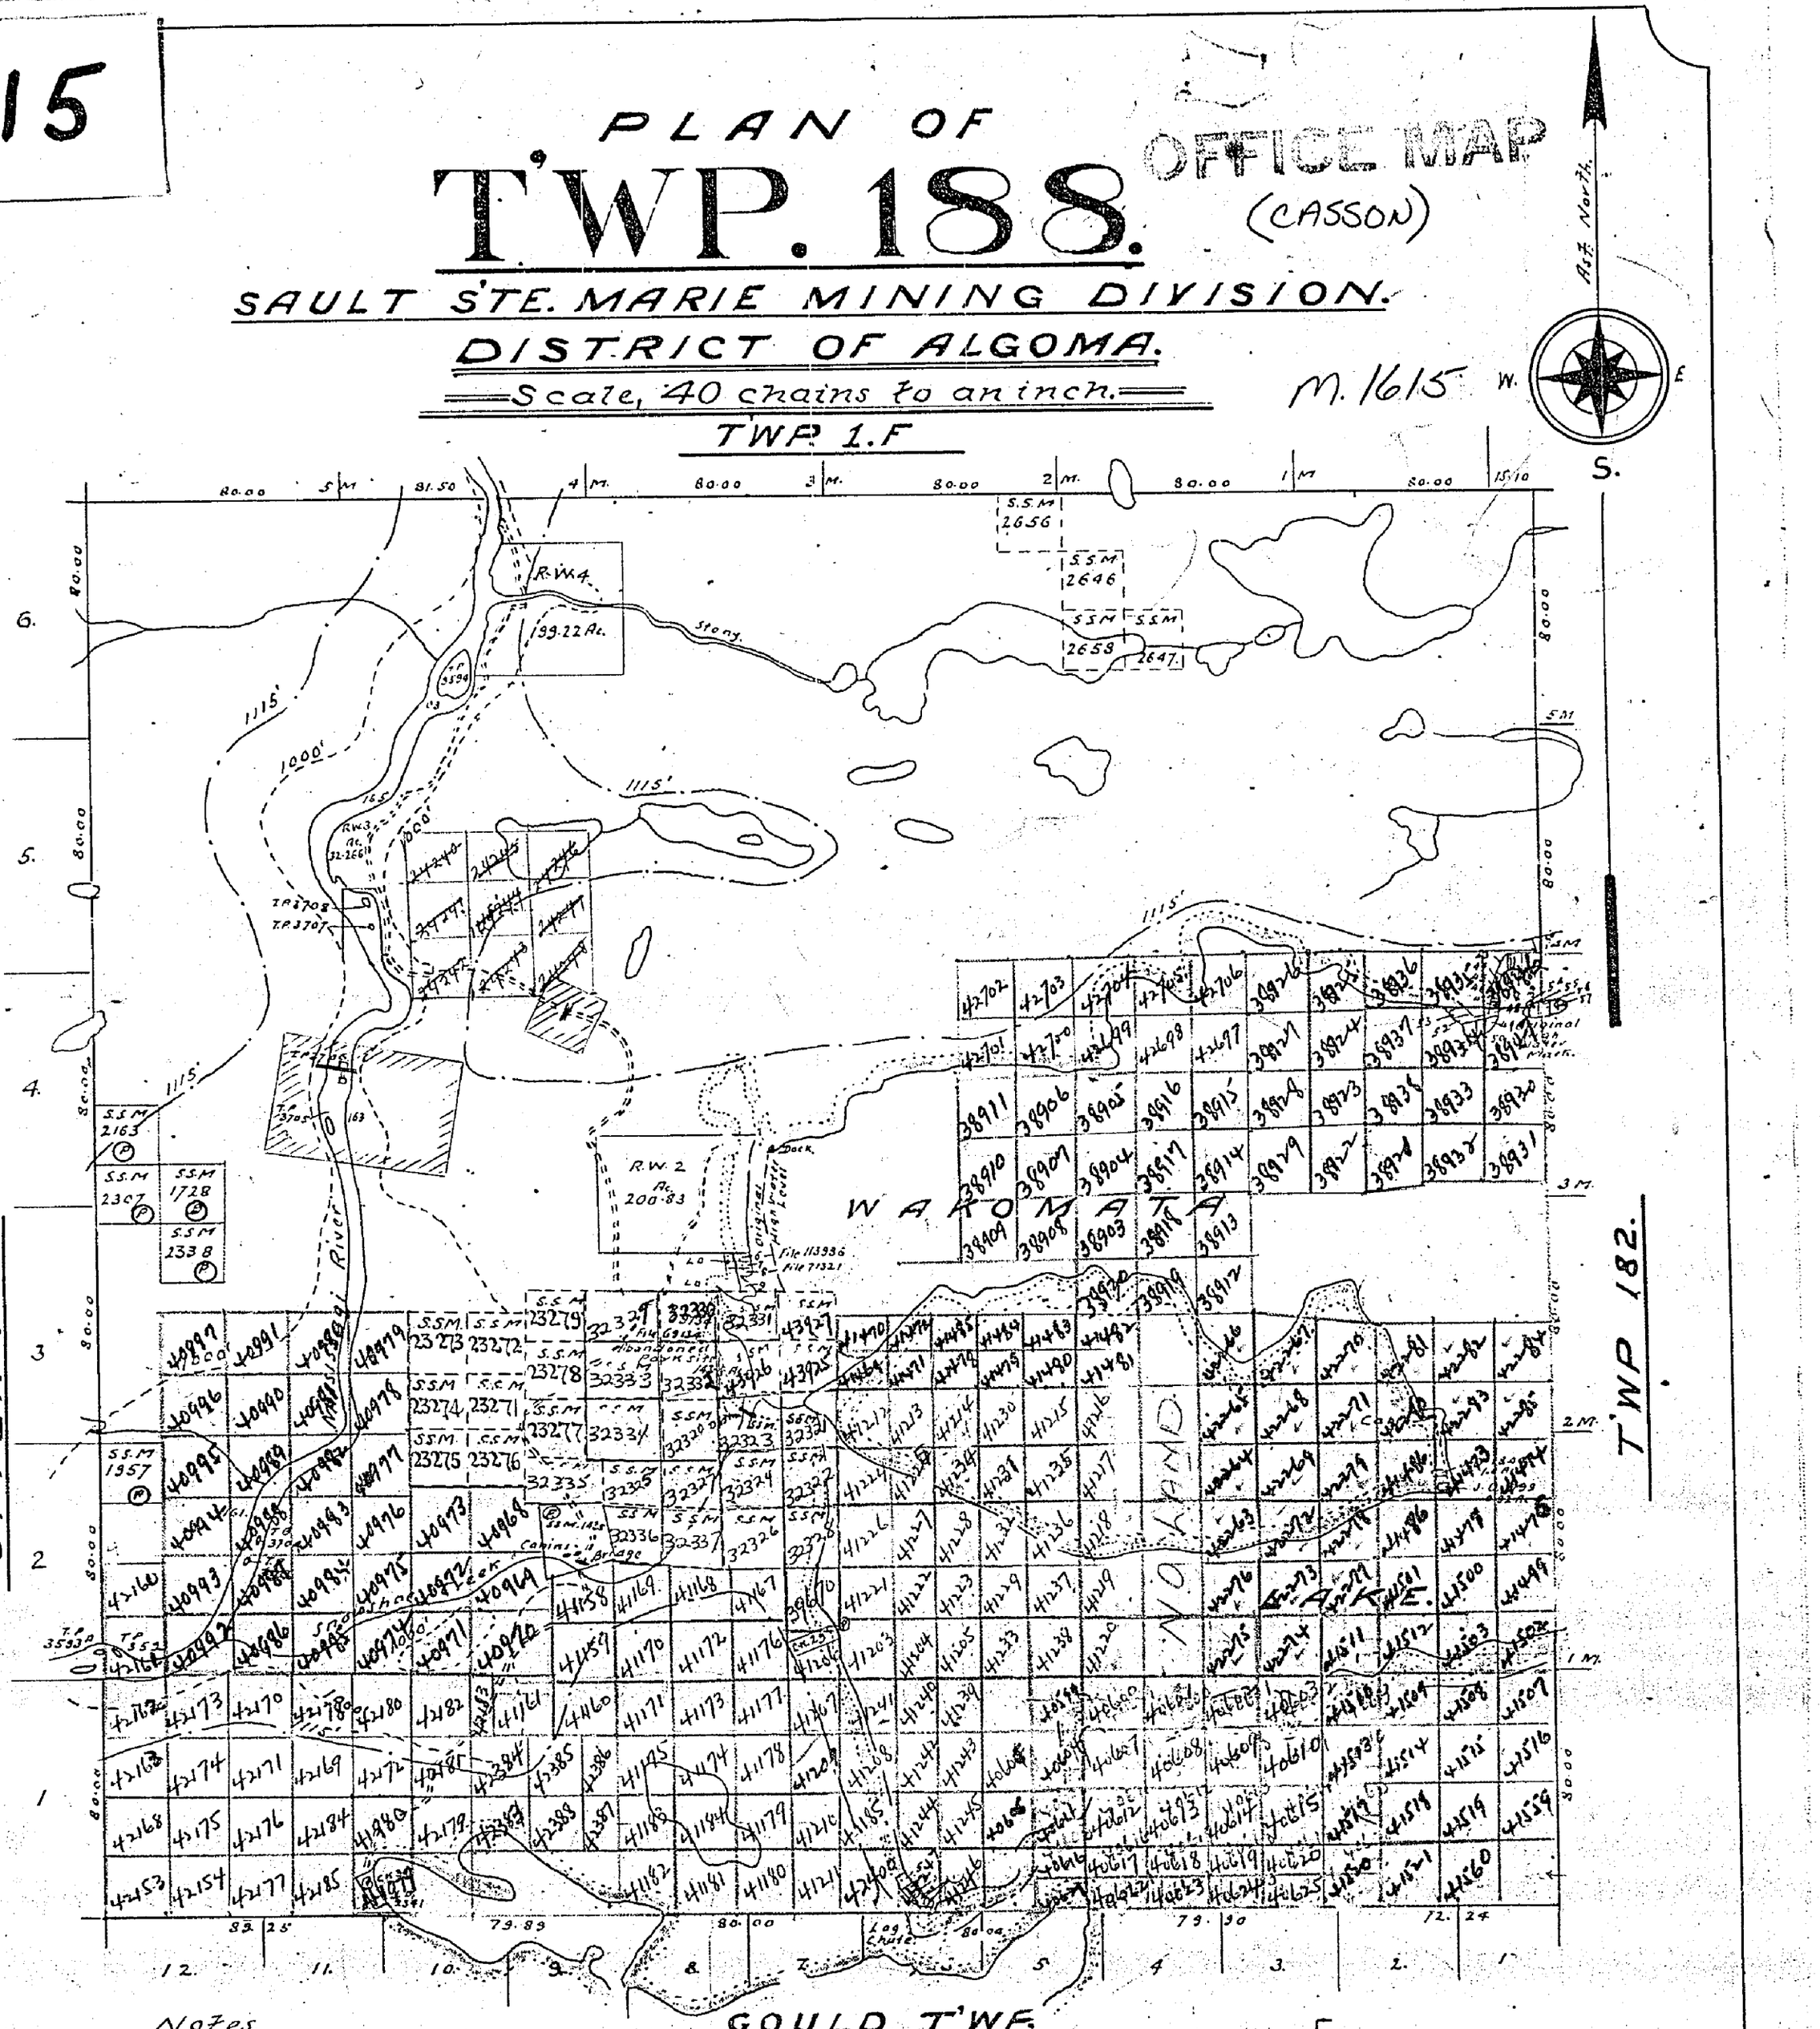

OTTER T'WP.

T'WP 182.

GOULD T'WP.

Notes.

Railways shewn
Paved Highways
Gravel
Highway Route Nos. (2)
Other Roads
Trails & Paths.
Telephone & Telegraph Lines
Electric Power Lines
Non-perennial streams
Surface reservations 200' wide by Dept. of L. & F. shewn

Bridges
Buildings
Swamps
Areas marked P. are Patented
L. Leased
LO. held under Licence-of-Occupation
Areas with arcuate from starting. 1115 shewn
Flooding rights to H.E.P.C. to Contour 1115 to 1123 G.S.C. File 5937

1516

Plan 2317 D 1874


PLAN OF
TWP. 188. (CASSON)

SAULT STE. MARIE MINING DIVISION.
DISTRICT OF ALGOMA.

Scale, 40 chains to an inch.

M. 1615

TWP. 1.F

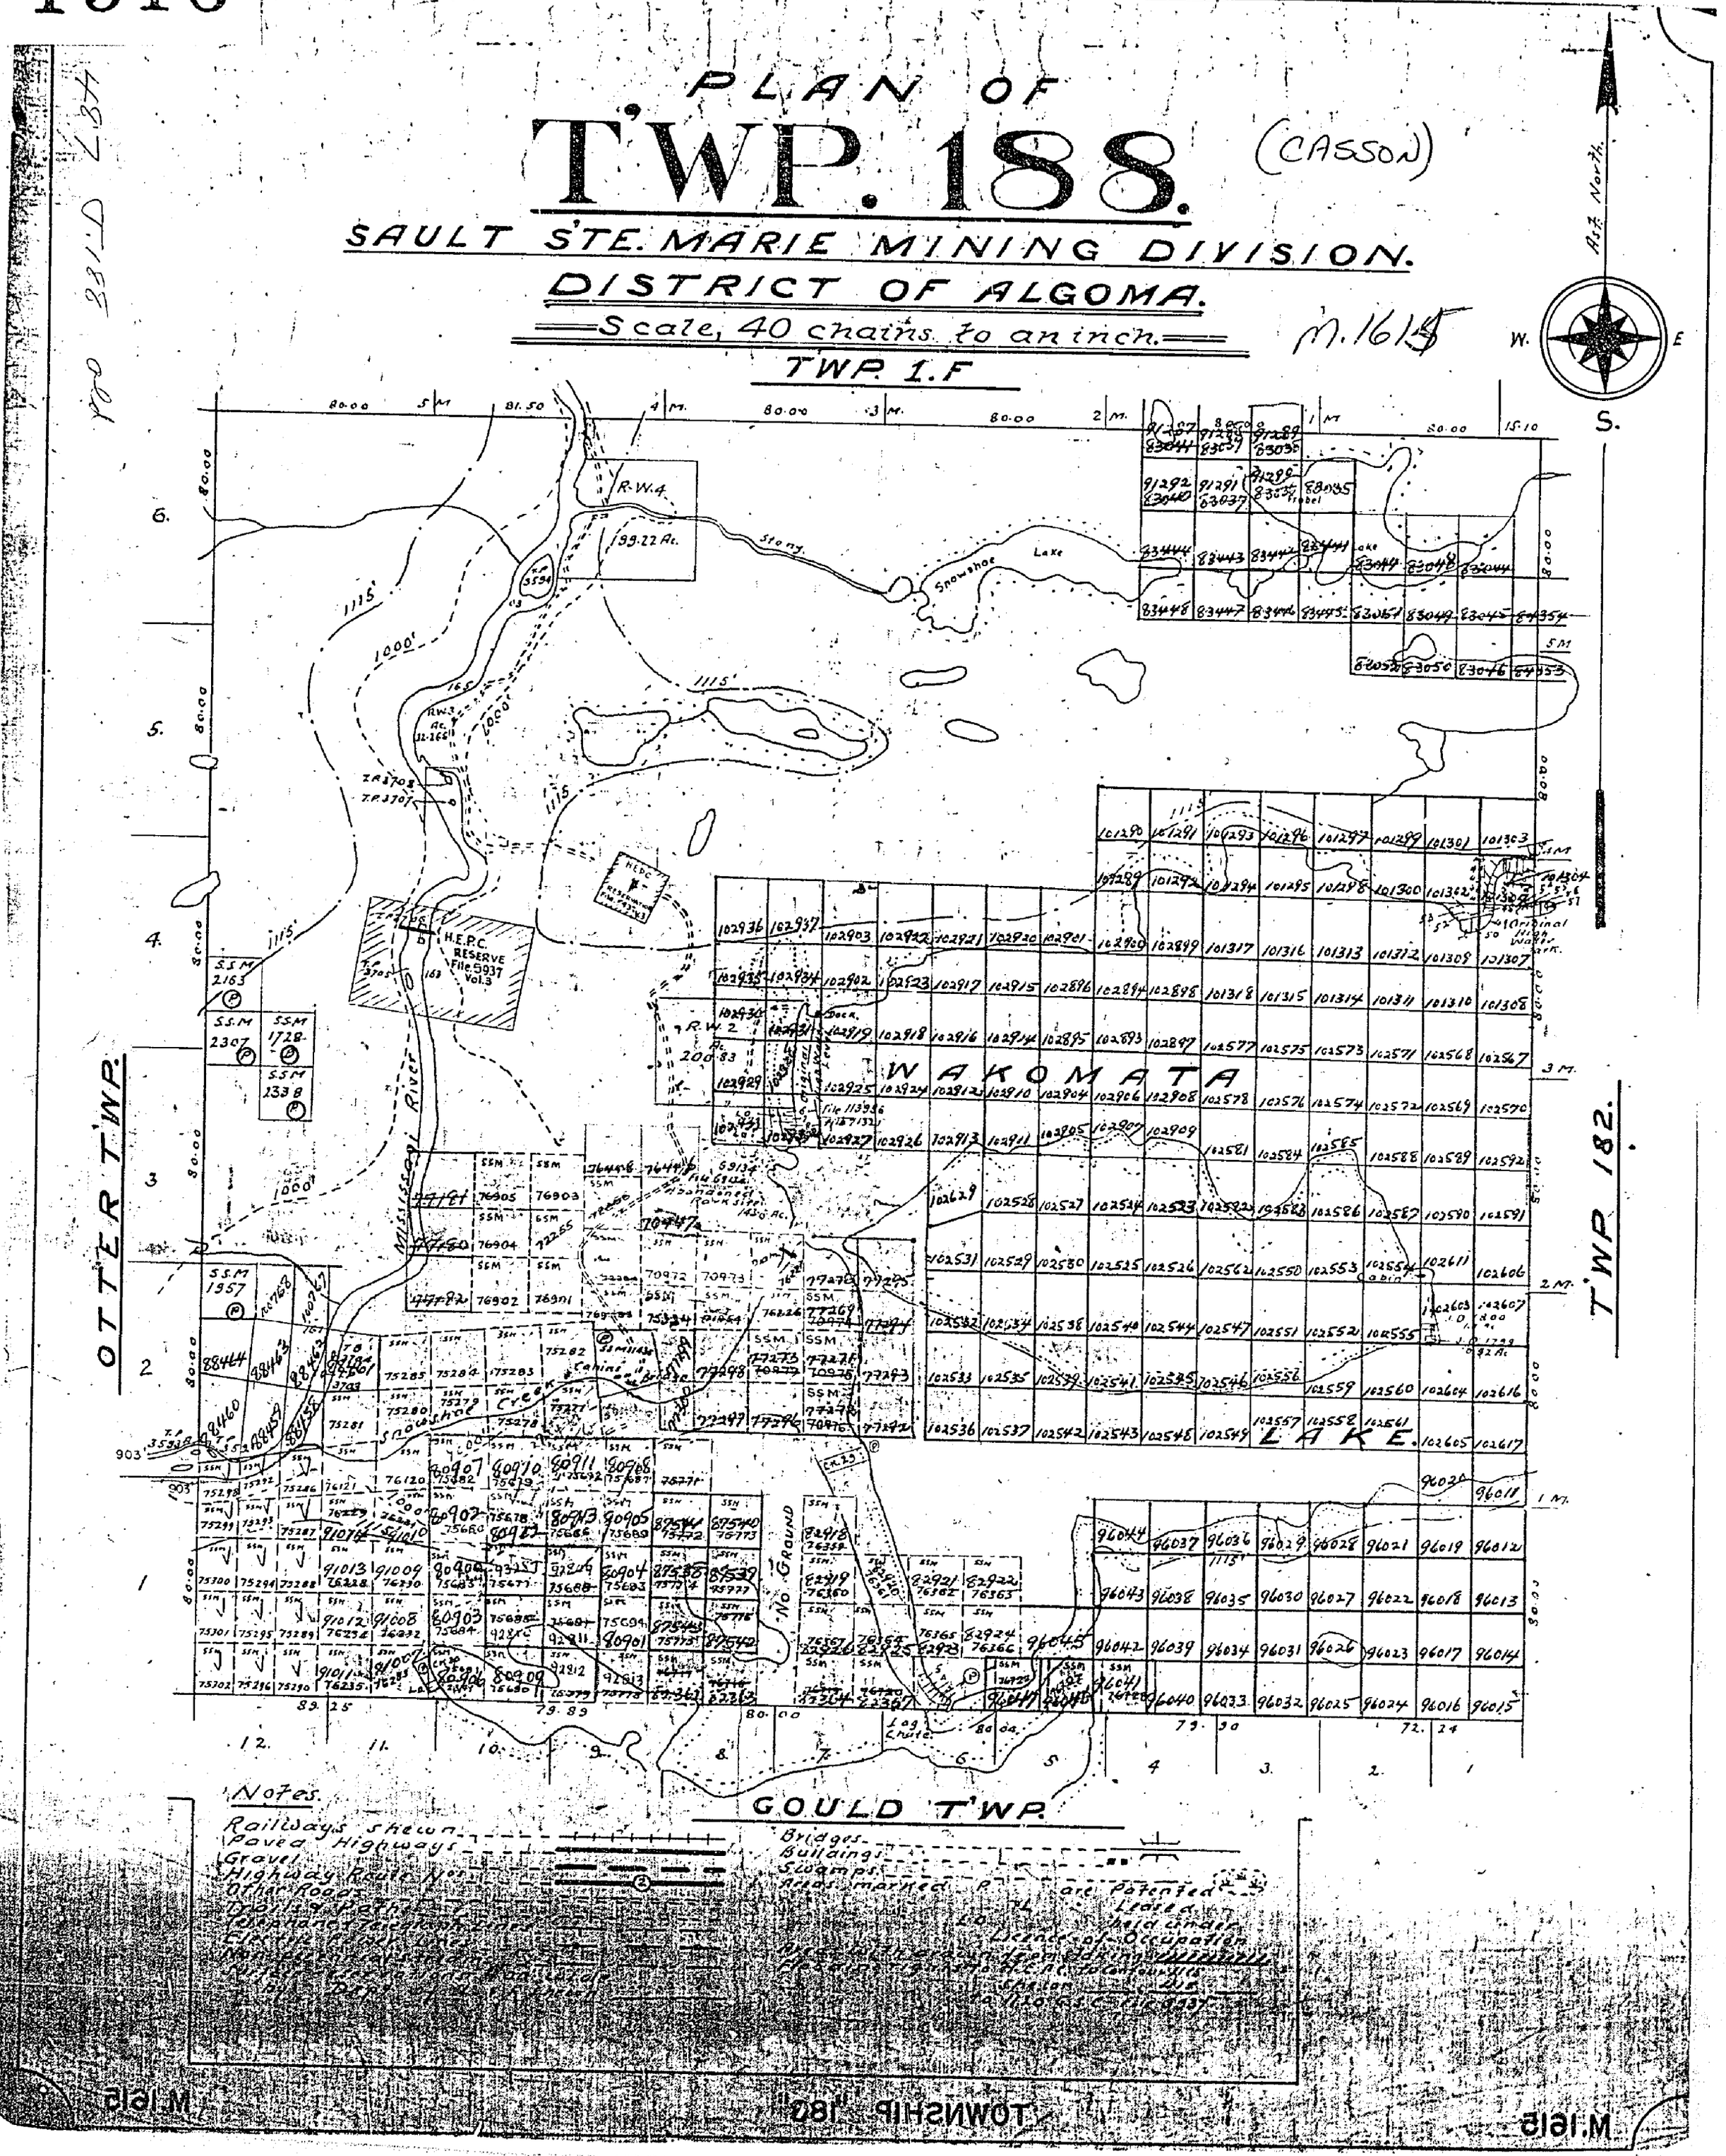

Notes.

Railways shewn
Paved Highways
Gravel
Highway Route Nos.
Other Roads
Trails, Paths
Telephone or Telegraph Lines
Electric Power Lines
Bridges
Buildings
Swamps
Rivers, marked P are Patented
Leased
Held under Licence of Occupation

TOWNSHIP 182

M.161S

1516

PLAN OF TWP. 188. (CASSON)

SAULT STE. MARIE MINING DIVISION.

DISTRICT OF ALGOMA.

Scale, 40 chains to an inch.

M.1614

TWP. 1.F

GOULD T'WP.

Notes.

Railways shewn
Paved Highways
Gravel
Highway Route Nos.
Other Roads
Trails, Paths
Telephone & Telegraph Lines
Electric Power Lines
Non-perennial Streams
Surface reservations for Lands by Dept. of Lands shewn

Bridges
Buildings
Swamps
Areas marked P are Patented
L Leased
LO held under Licence of Occupation
Areas with drawn from staking.
Flooding rights to H.C.A.C. to contour 1115
Shewn on Aq. 1130 G.S.C. file 8737


1615

TOWNSHIP 188

DISTRICT OF ALGOMA (CASSON)

Scale 40 Chains 1 Inch. M. 1615

TOWNSHIP I F

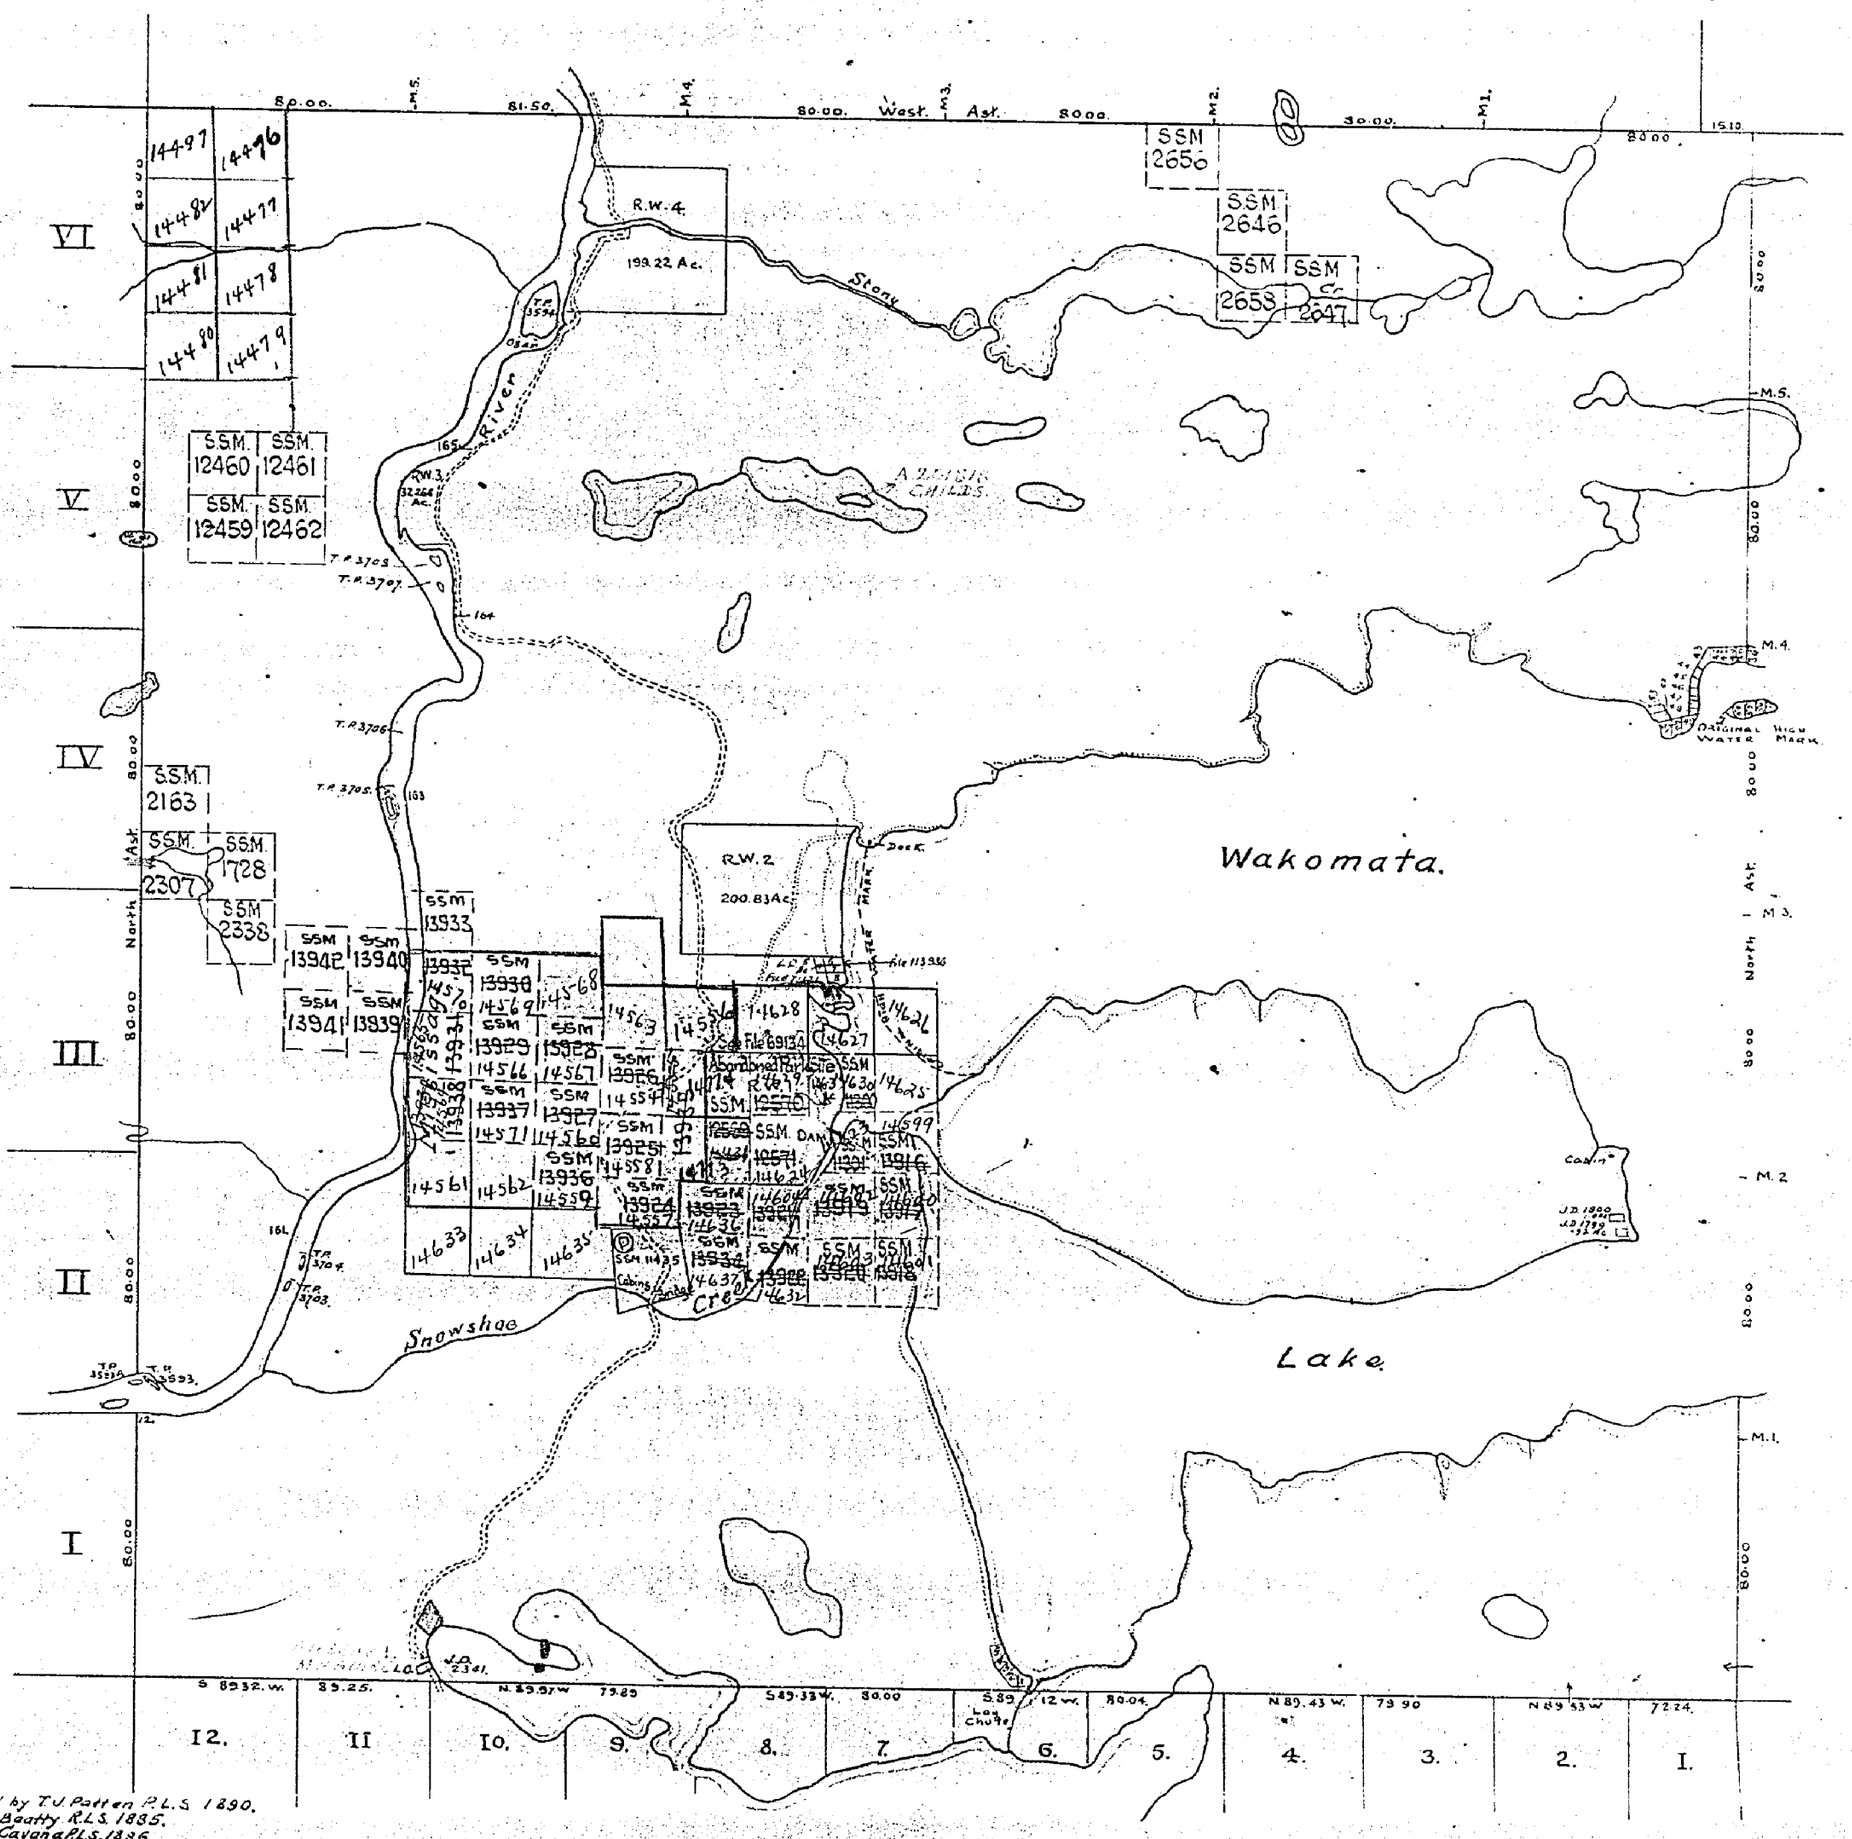

1615

TWP. 1F - M.1379

TWP. 1E - M.1378

OTTER TWP. - M.1325

TWP. 182 - M.1614

GOULD TWP. - M.455

THE TOWNSHIP

188 CASSON

DISTRICT OF
ALGOMA

SAULT STE. MARIE
MINING DIVISION

SCALE: 1-INCH = 40 CHAINS

LEGEND

PATENTED LAND	(P)
CROWN LAND SALE	C.S
LEASES	(L)
LOCATED LAND	Loc.
LICENSE OF OCCUPATION	L.O.
MINING RIGHTS ONLY	M.R.O.
SURFACE RIGHTS ONLY	S.R.O.
ROADS	
IMPROVED ROADS	
KING'S HIGHWAYS	
RAILWAYS	
POWER LINES	
MARSH OR MUSKEG	
MINES	
CANCELLED	C

NOTES

400' surface rights reservation around all lakes and rivers

Summer resort locations patented for surface rights only shown thus (P)

Flooding rights

- on Mississagi River reserved to contour 903' W.P.L.A. No. 35. File: 5937, Vol.4
- on Wakomata Lake to contour 1115' File: 2136, Vol. 182

PLAN NO. M.1615

DEPARTMENT OF MINES
— ONTARIO —

1516

PLAN OF TWP. 188. (CASSON)


SAULT STE. MARIE MINING DIVISION.

DISTRICT OF ALGOMA.

Scale, 40 chains to an inch.

M. 1615

TWP. 1.F

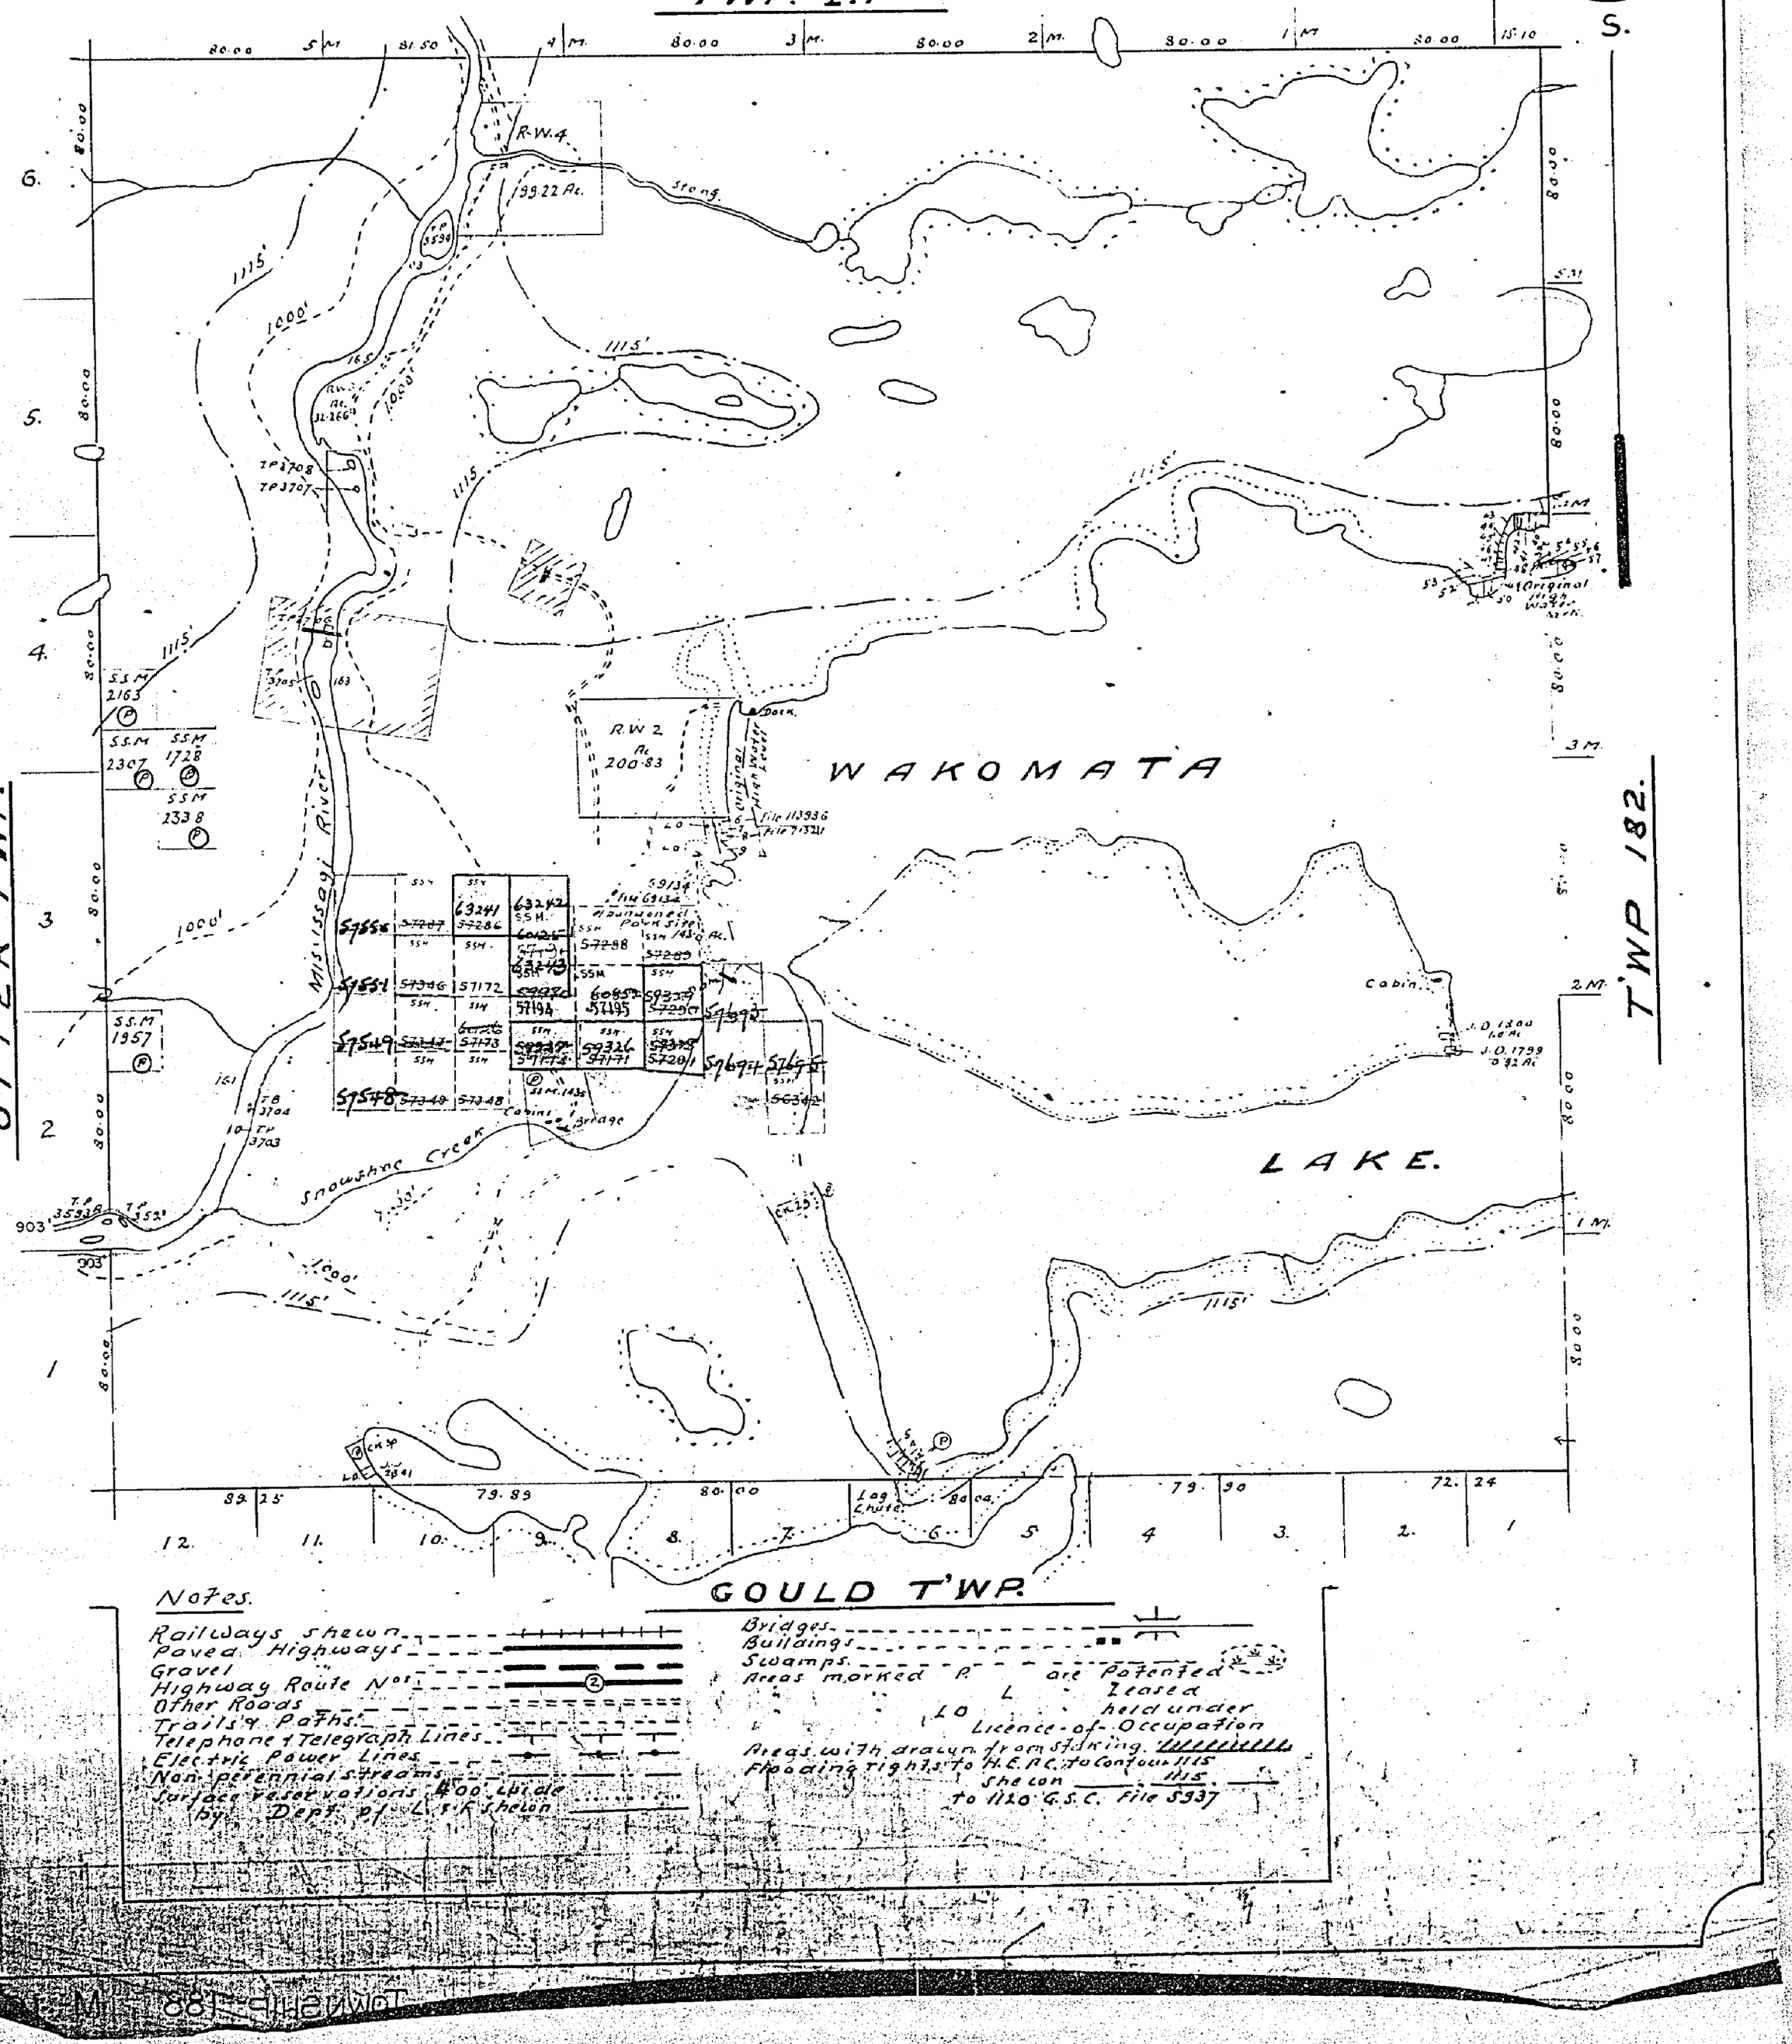

Notes.

Railways shewn
Paved Highways
Gravel "
Highway Route No.s
Other Roads
Trails & Paths
Telephone & Telegraph Lines
Electric Power Lines
Non-perennial streams
Surface reservations 400 chain by Dept. of L.S. & F. shewn

Bridges
Buildings
Swamps
Areas marked P are Patented
" " L " Leased
" " LO " held under Licence-of-Occupation
Areas with drawn from staking.
Flooding rights to H.E.P.C. to Contour 1115 shewn 1115. to 1120 G.S.C. File 5937

1516

OFFICE MAP

PLAN OF TWP. 188. (CASSON)

SAULT STE. MARIE MINING DIVISION.


DISTRICT OF ALGOMA.

M. 1614

Scale, 40 chains to an inch.

TWP. 1.F

OFFICE MAP

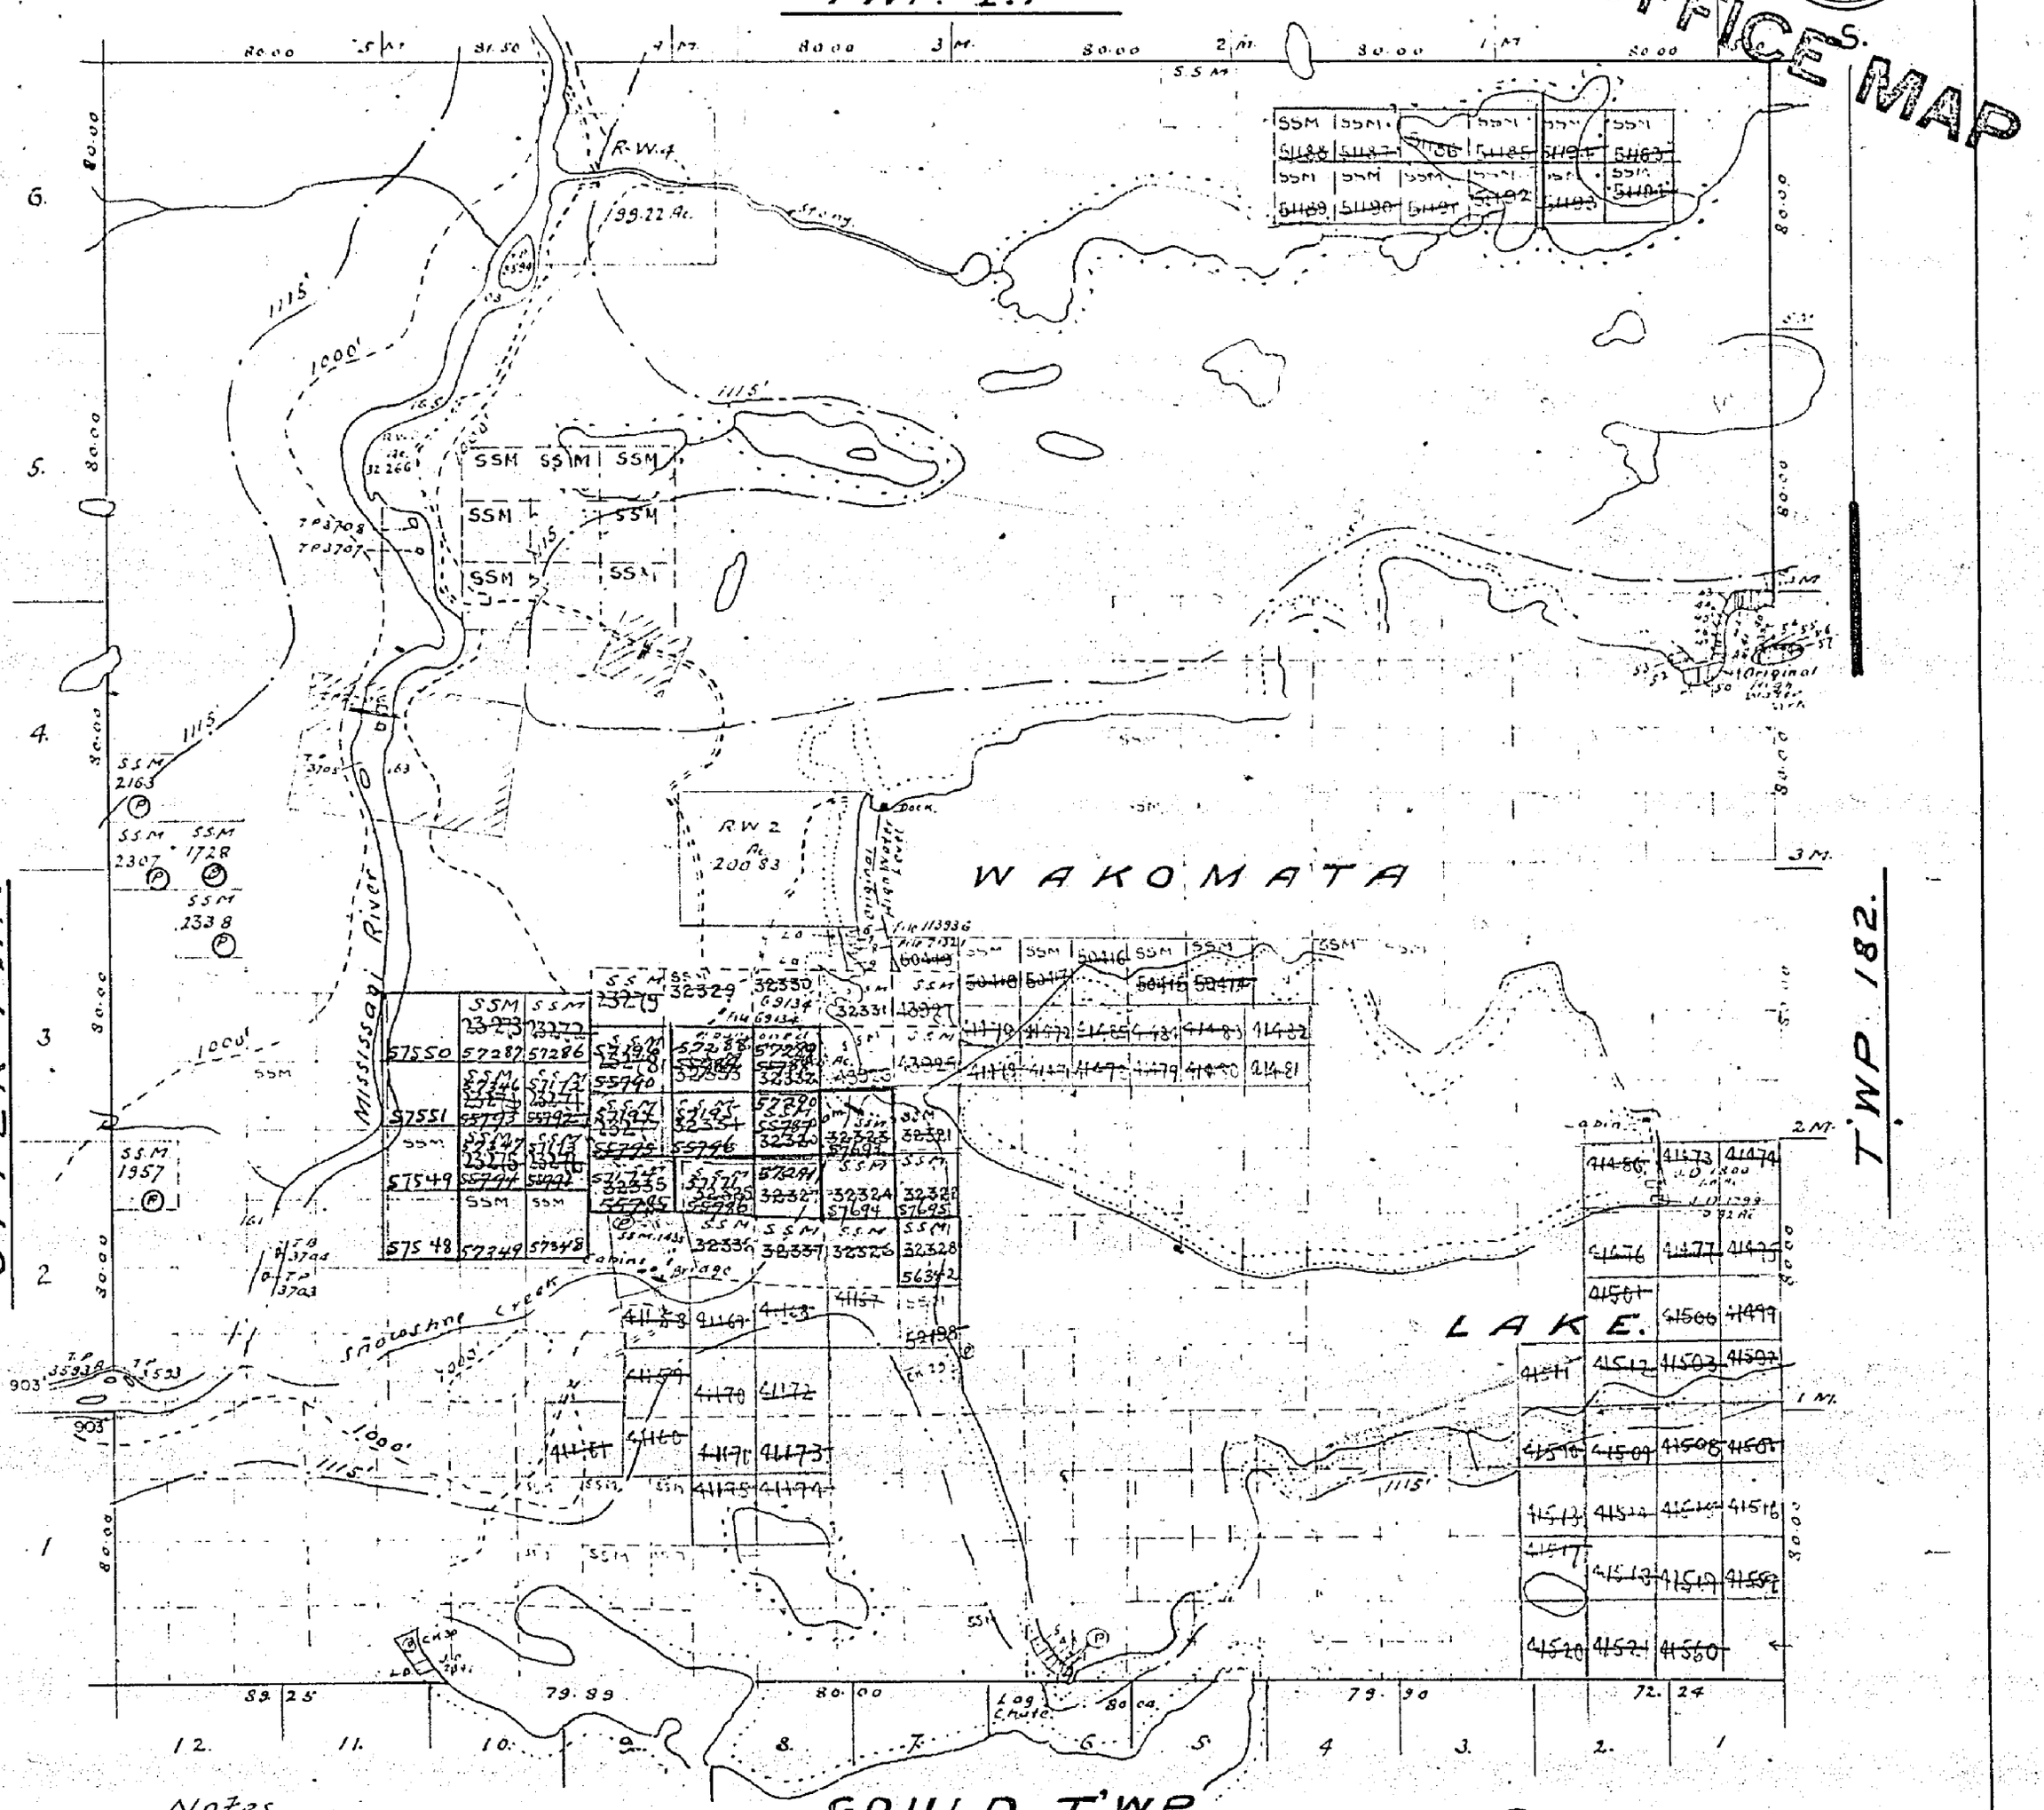

GOULD T'WP.

Notes.

Railways shewn
Paved Highways
Gravel "
Highway Route No. (2)
Other Roads
Trails & Paths
Telephone & Telegraph Lines
Electric Power Lines
Non-perennial Streams
Surface reservations 400' wide by Dept. of L. & F. shewn

Bridges
Buildings
Swamps
Areas marked P are Patented
L " Leased
LO " held under Licence-of-Occupation
Areas with arcuan from shading ||||||||||
Flooding rights to H.E.P.C. to Contour 1115 shewn 1115. to 1120 G.S.C. File 5937

TOWNSHIP 188 - M.

1516

PLAN OF TWP. 188. (CASSON)


SAULT STE. MARIE MINING DIVISION.

DISTRICT OF ALGOMA.

Scale, 40 chains to an inch.

M. 161

TWP. 1.F

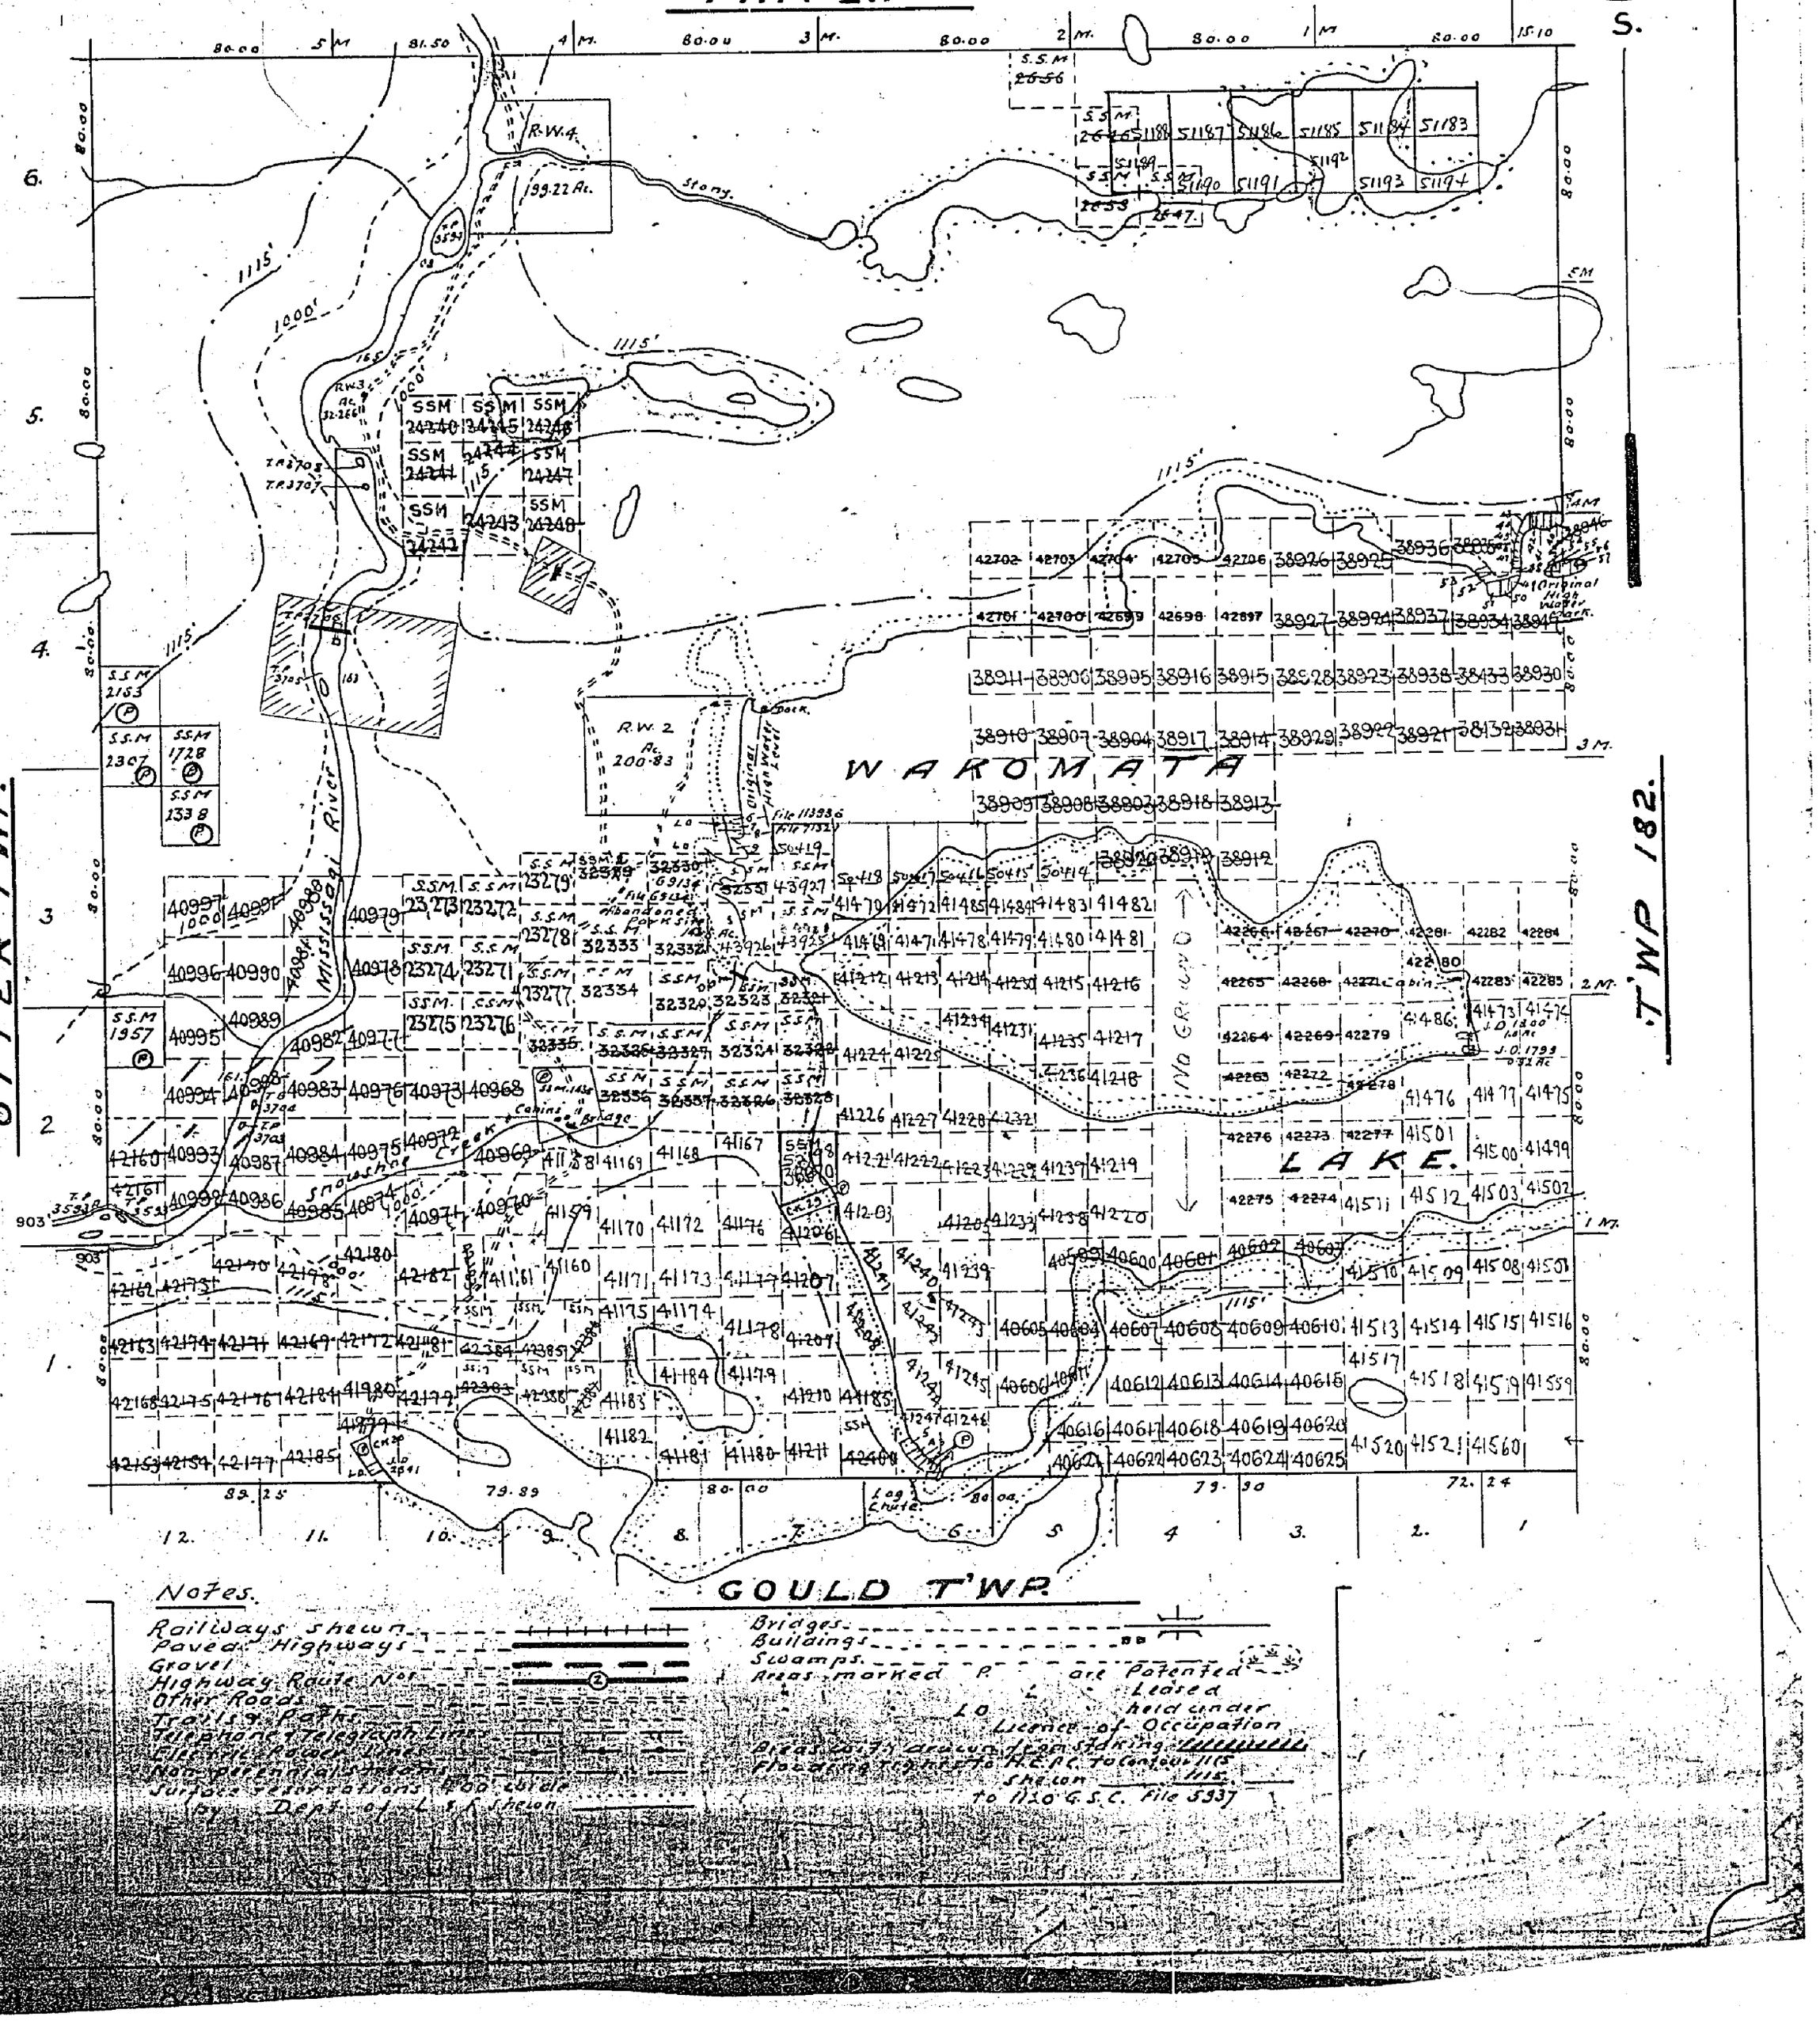

Notes.

Railways shewn
Paved Highways
Gravel
Highway Route No.
Other Roads
Trails & Paths
Telephone & Telegraph Lines
Electric Power Lines
Non-patented Areas shaded
Surface reservations 66 chains
(P) Dept. of Lands shewn

Bridges
Buildings
Swamps
Areas marked P are Patented
L Leased
LO held under Licence of Occupation
Broken Contour lines denote standing timber
Flooding to be expected to recede to Contour 1115 shewn thus 1115
to 1120 G.S.C. File 5937

1615

DAGLE TP. M.1379

WAGG TP. M.1378

OTTER TWP. - M.1325

JACKSON TWP. M.1614

GOULD TWP. - M.455

5M. 4M. 3M. 2M. 1M.

+3M. +2M. +1M.

PARK SITE RW.4

PARK RW.3 SITE

PARK SITE RW.2

Bijou Creek

Mississagi River

Two Camp Creek

Snowshoe Lake

Frobel Lake

Creek

Wakomata Lake

Damn Lake

Johnmageeshig Lake

Surface Rights only are reopened for prospecting, sale or lease - excepting MTC gravel pit No. 1587 and the unpatented mining claims as shown on plan. Sec. 43 - M.A. Act

July 5/71

Deputy Minister

REG. PLAN M.95

DAM

TP3705

TP3703

TP3593

CK177

CK176

CK28

46°31' 50"

83°20' 05"

THE TOWNSHIP

CASSON

(Tp. 188)

DISTRICT OF ALGOMA

SAULT STE. MARIE MINING DIVISION

SCALE: 1-INCH = 40 CHAINS

LEGEND

PATENTED LAND	Ⓟ
CROWN LAND SALE	C.S.
LEASES	Ⓛ
LOCATED LAND	Loc.
LICENSE OF OCCUPATION	L.O.
MINING RIGHTS ONLY	M.R.O.
SURFACE RIGHTS ONLY	S.R.O.
ROADS	
IMPROVED ROADS	
KING'S HIGHWAYS	
RAILWAYS	
POWER LINES	
MARSH OR MUSKEG	
MINES	
CANCELLED	C.

NOTES

400' surface rights reservation along the shores of all lakes and rivers.

Summer resort locations patented for surface rights only shown thus Ⓟ

Flooding rights

-on Mississagi River reserved to contour 903' W.P.L.A. Nº 35 F.5937 vol.4

OTHER AREAS WITHDRAWN FROM STAKING

S.R. - SURFACE RIGHTS M.R.-MINING RIGHTS

Section	Order Nº	Date	Disposition	File
(R1) 43(R.S.O.1970)	W.661/8	25/2/75	S.R.	156507

DATE OF ISSUE OCT 7 1975

SAND & GRAVEL

(R1) M.T.C. PIT Nº 1587

(R2) M.T.C. PIT Nº 1333

(R3) GRAVEL File 5937 vol.3

(R4) GRAVEL File: 156507

PLAN NO. M.1615

ONTARIO

MINISTRY OF NATURAL RESOURCES

SURVEYS AND MAPPING BRANCH

b.k.

1615

PLAN OF TWP. 188. (CASSON)


SAULT STE. MARIE MINING DIVISION.

DISTRICT OF ALGOMA.

Scale, 40 chains to an inch.

M. 1615

TWP. 1.F

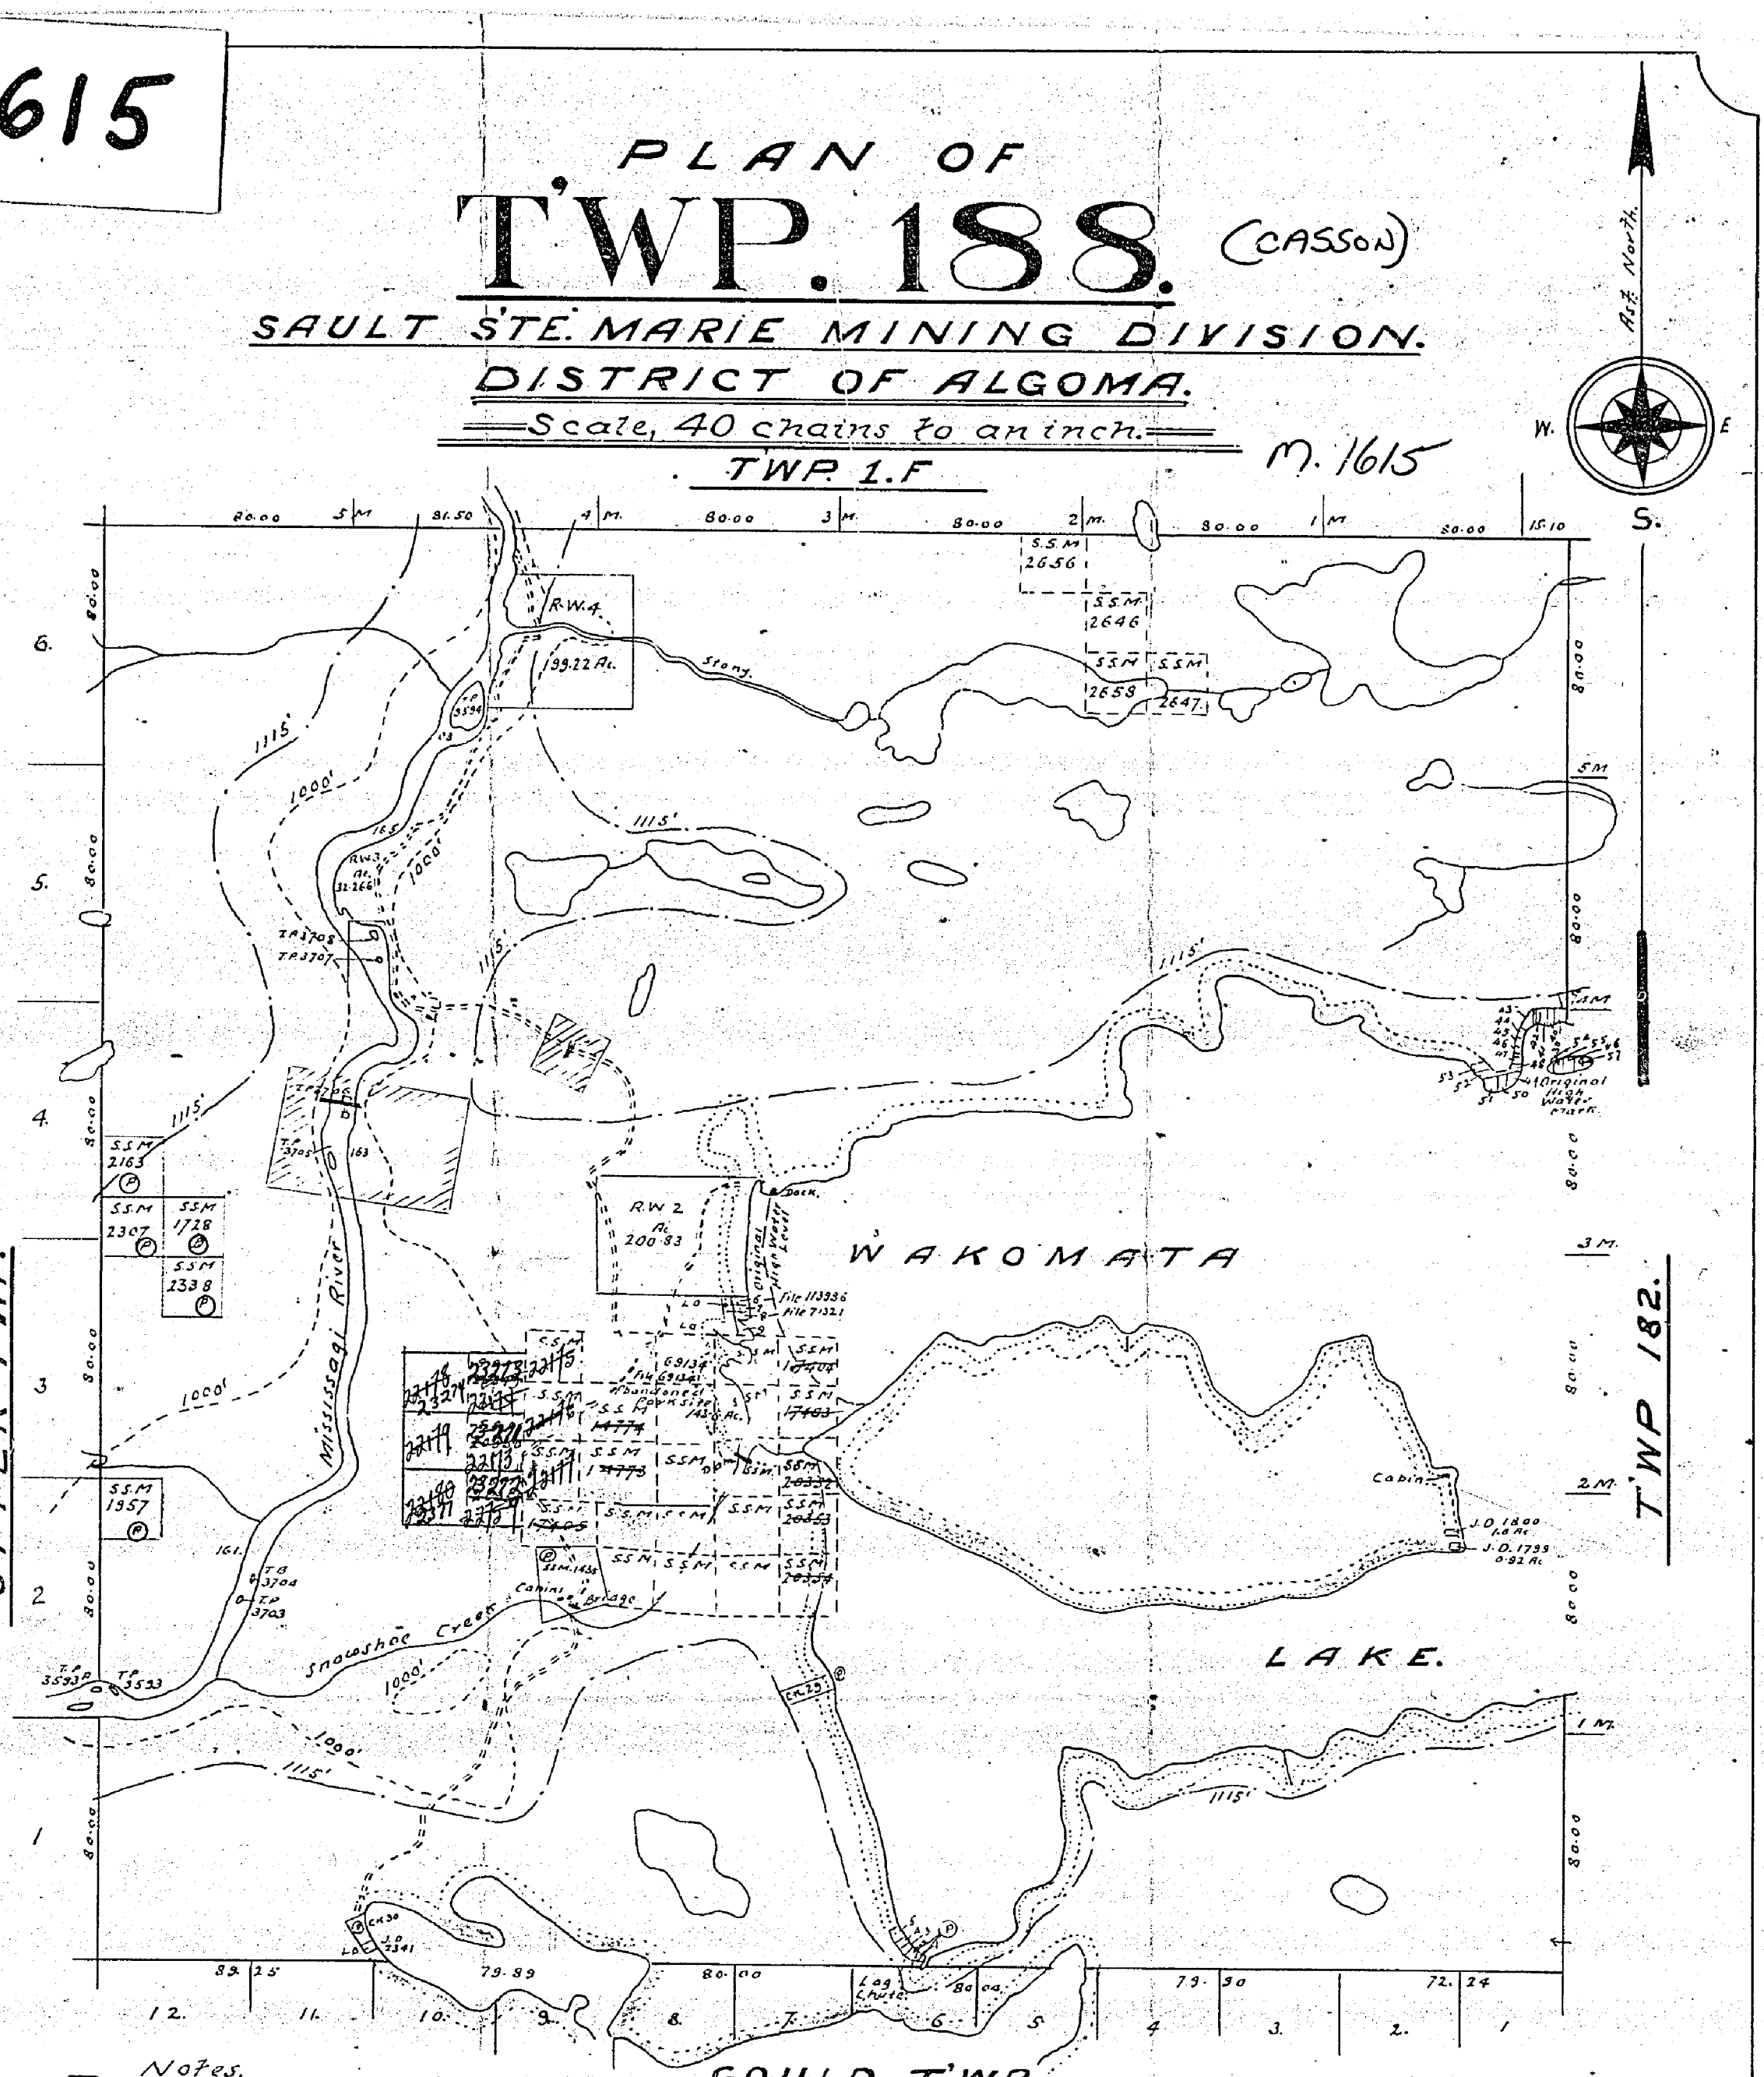

Notes.

Railways shewn
Paved Highways
Gravel
Highway Route Nos (2)
Other Roads
Trails & Paths
Telephone & Telegraph Lines
Electric Power Lines
Non-perennial streams
Surface reservations 200' wide by Dept of L. & F. shewn


Bridges
Buildings
Swamps
Areas marked P are Patented
L Leased
LO held under Licence-of-Occupation
Areas with drawn from staking.
Flooding rights to H.E.P.C. to Contour 1115 Shewn 1115 to 1120 G.S.C. File 5937

TOWNSHIP 188. S.S.M. 365.

1615

TWP. IF - M.1379

TWP. IE - M.1378

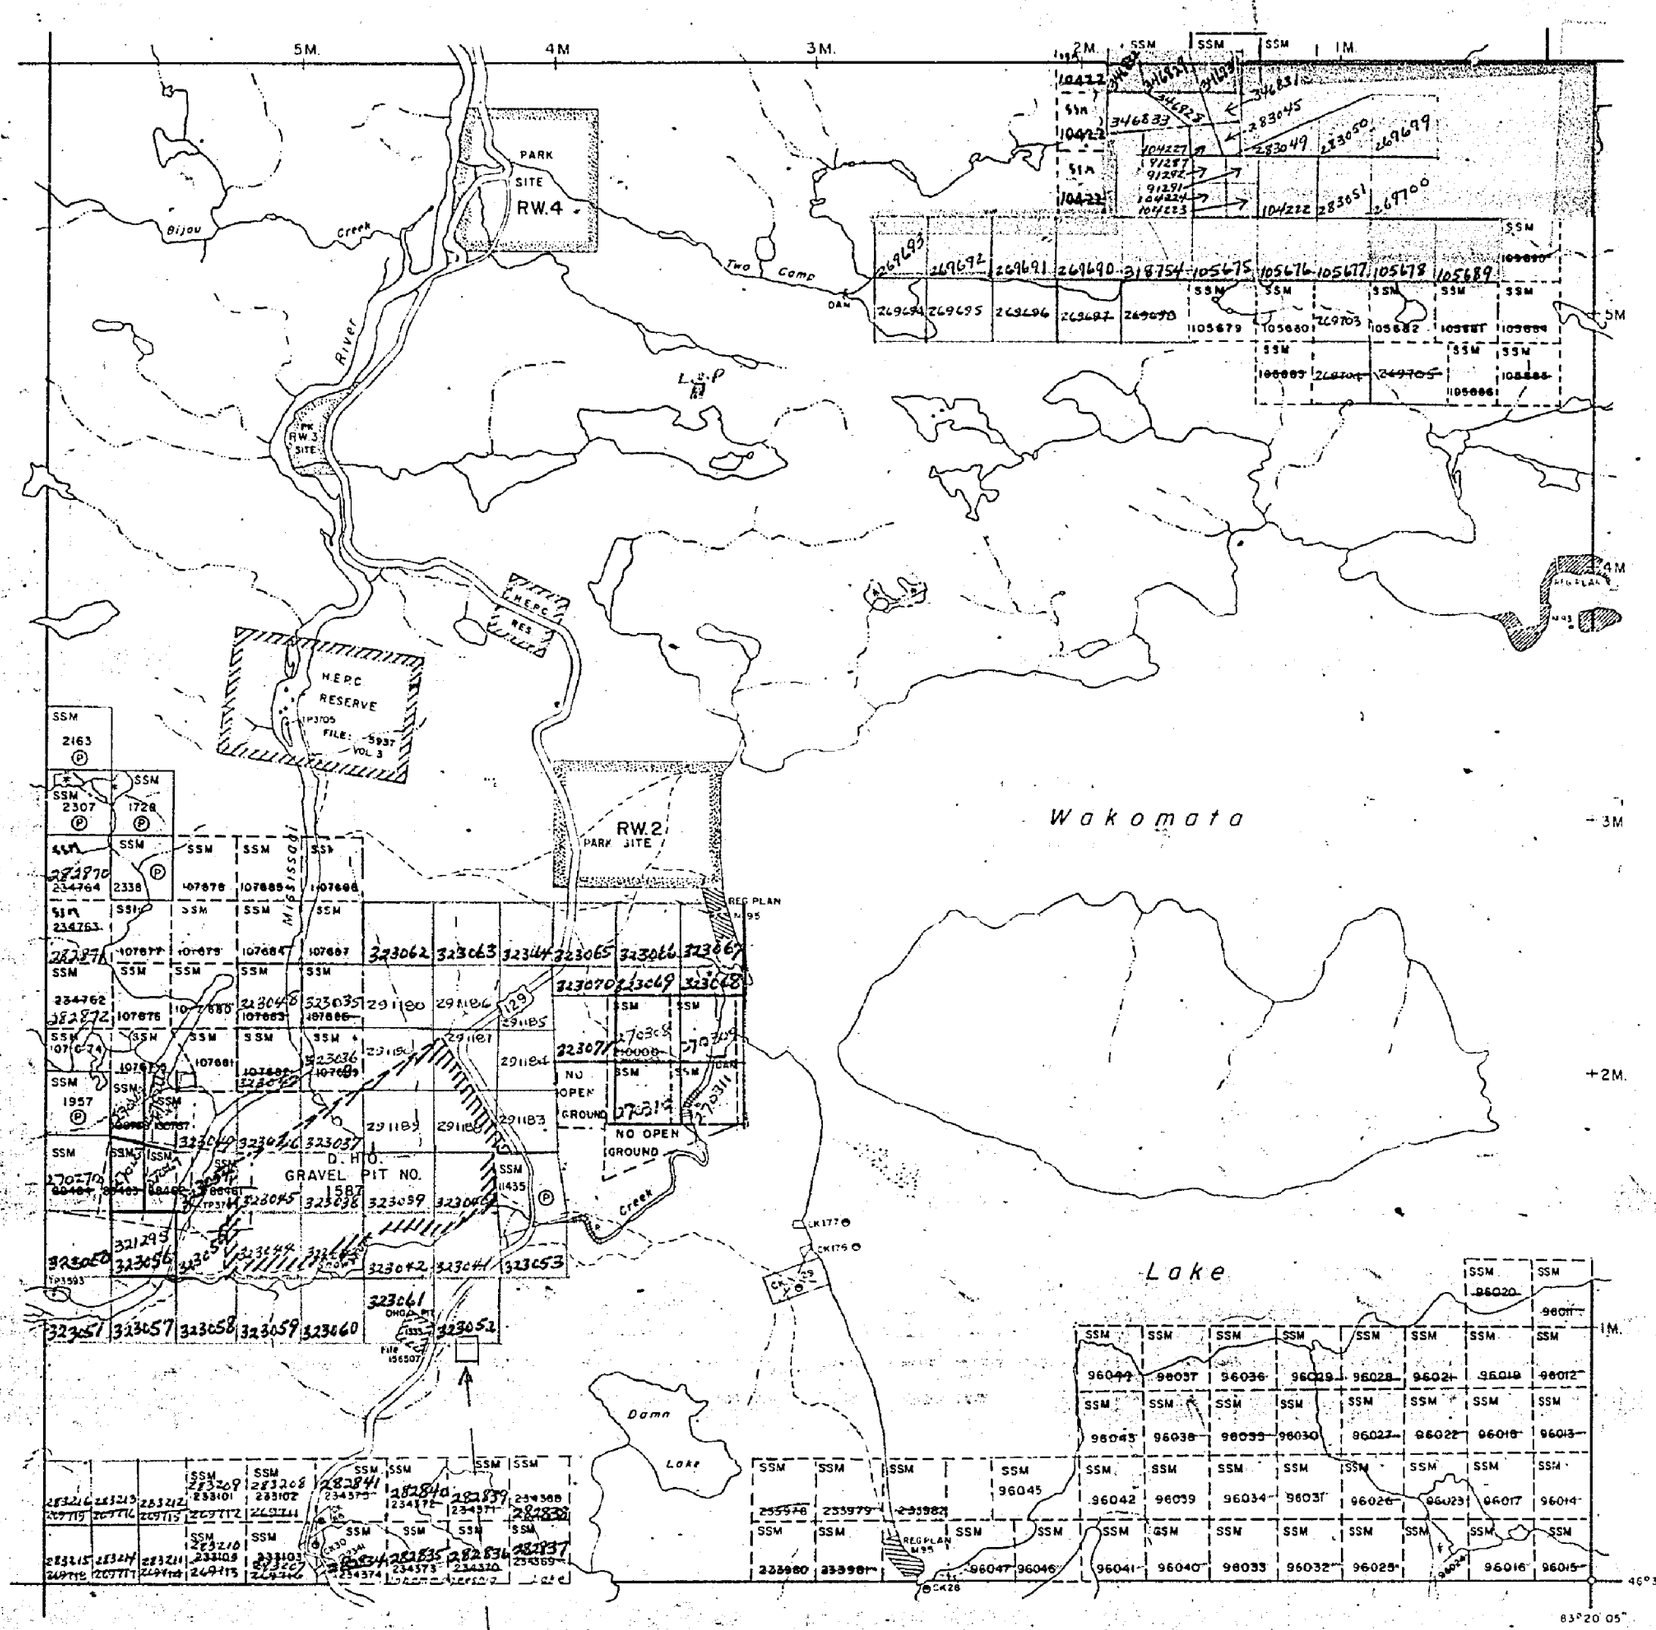

OTTER TWP. - M.1325

TWP. 182 - M.1614

GOULD TWP. - M.455

SEWAGE LAGOON
(SEE LANDROLL FILE)

THE TOWNSHIP

188

CASSON

DISTRICT OF
ALGOMA

SAULT STE. MARIE
MINING DIVISION

SCALE: 1-INCH = 40 CHAINS

LEGEND

PATENTED LAND	(P)
CROWN LAND SALE	C.S
LEASES	(L)
LOCATED LAND	Loc.
LICENSE OF OCCUPATION	L.O.
MINING RIGHTS ONLY	M.R.O.
SURFACE RIGHTS ONLY	S.R.O.
ROADS	
IMPROVED ROADS	
KING'S HIGHWAYS	
RAILWAYS	
POWER LINES	
MARSH OR MUSKEG	
MINES	
CANCELLED	C.

NOTES

400' surface rights reservation around all lakes and rivers.

Summer resort locations patented for surface rights only shown thus ◓.

Flooding rights

- on Mississagi River reserved to contour 903' W.P.L.A. No. 35. File: 5937, Vol.4
- on Wakomata Lake to contour 1115' File: 2136, Vol. 182

PLAN NO. M.1615

ONTARIO DEPARTMENT OF MINES AND NORTHERN AFFAIRS


1615

TWP. 1F - M.1379

TWP. 1E - M.1378

TWP. 182 - M.1614

OTTER TWP. - M.1325

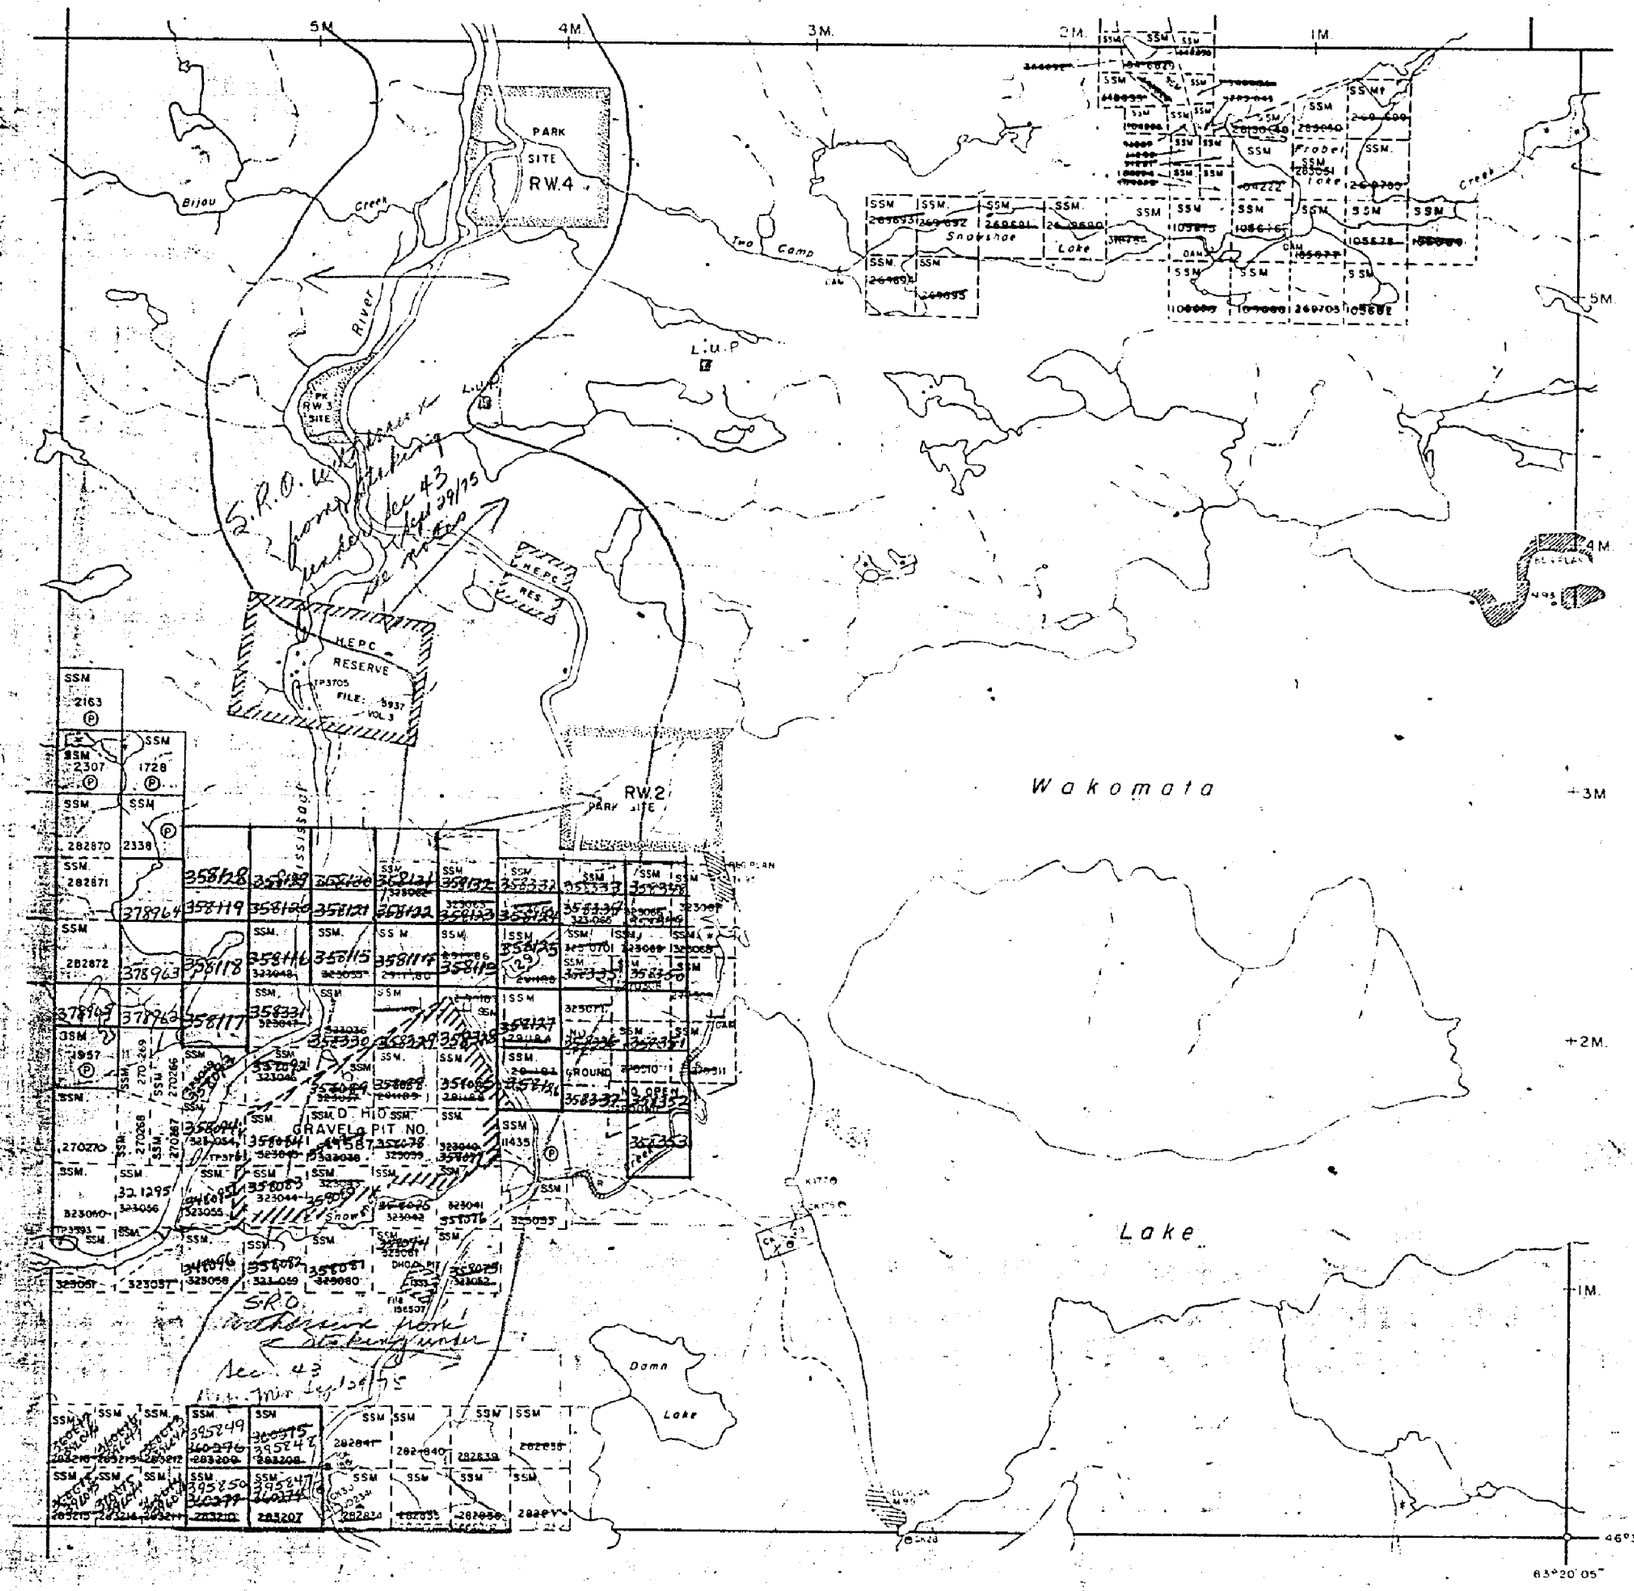

GOULD TWP. - M.455

THE TOWNSHIP

188

(CASSON)

DISTRICT OF ALGOMA

SAULT STE. MARIE MINING DIVISION

SCALE: 1-INCH = 40 CHAINS

LEGEND

PATENTED LAND	Ⓟ
CROWN LAND SALE	C.S
LEASES	Ⓛ
LOCATED LAND	Loc.
LICENSE OF OCCUPATION	L.O.
MINING RIGHTS ONLY	M.R.O
SURFACE RIGHTS ONLY	S.R.O
ROADS	
IMPROVED ROADS	
KING'S HIGHWAYS	
RAILWAYS	
POWER LINES	
MARSH OR MUSKEG	
MINES	
CANCELLED	C

NOTES

400' surface rights reservation around all lakes and rivers.

Summer resort locations patented for surface rights only shown thus Ⓟ

Flooding rights

- on Mississagi River reserved to contour 903' W.P.L.A. No. 35. File: 5937, Vol.4
- on Wakomata Lake to contour 1115' File: 2136, Vol. 182

AREA OUTLINED IN RED IS WITHDRAWN FROM PROSPECTING, STAKING OUT, SALE OR LEASE under Sec 43 of M.A. excepting & reserving therefrom all MTC Gravel Pits, quarry permits, park sites, unpatented mining claims & other lands patented, sold, leased or otherwise alienated from the Crown, letter Dep. Minister - Sept 29/75.

PLAN NO. M.1615

ONTARIO DEPARTMENT OF MINES AND NORTHERN AFFAIRS

1615


TMB 188

TOWNSHIP 188

DISTRICT OF ALGOMA (CASSON)

Scale 40 Chains 1 Inch. M. 1615

TOWNSHIP I F

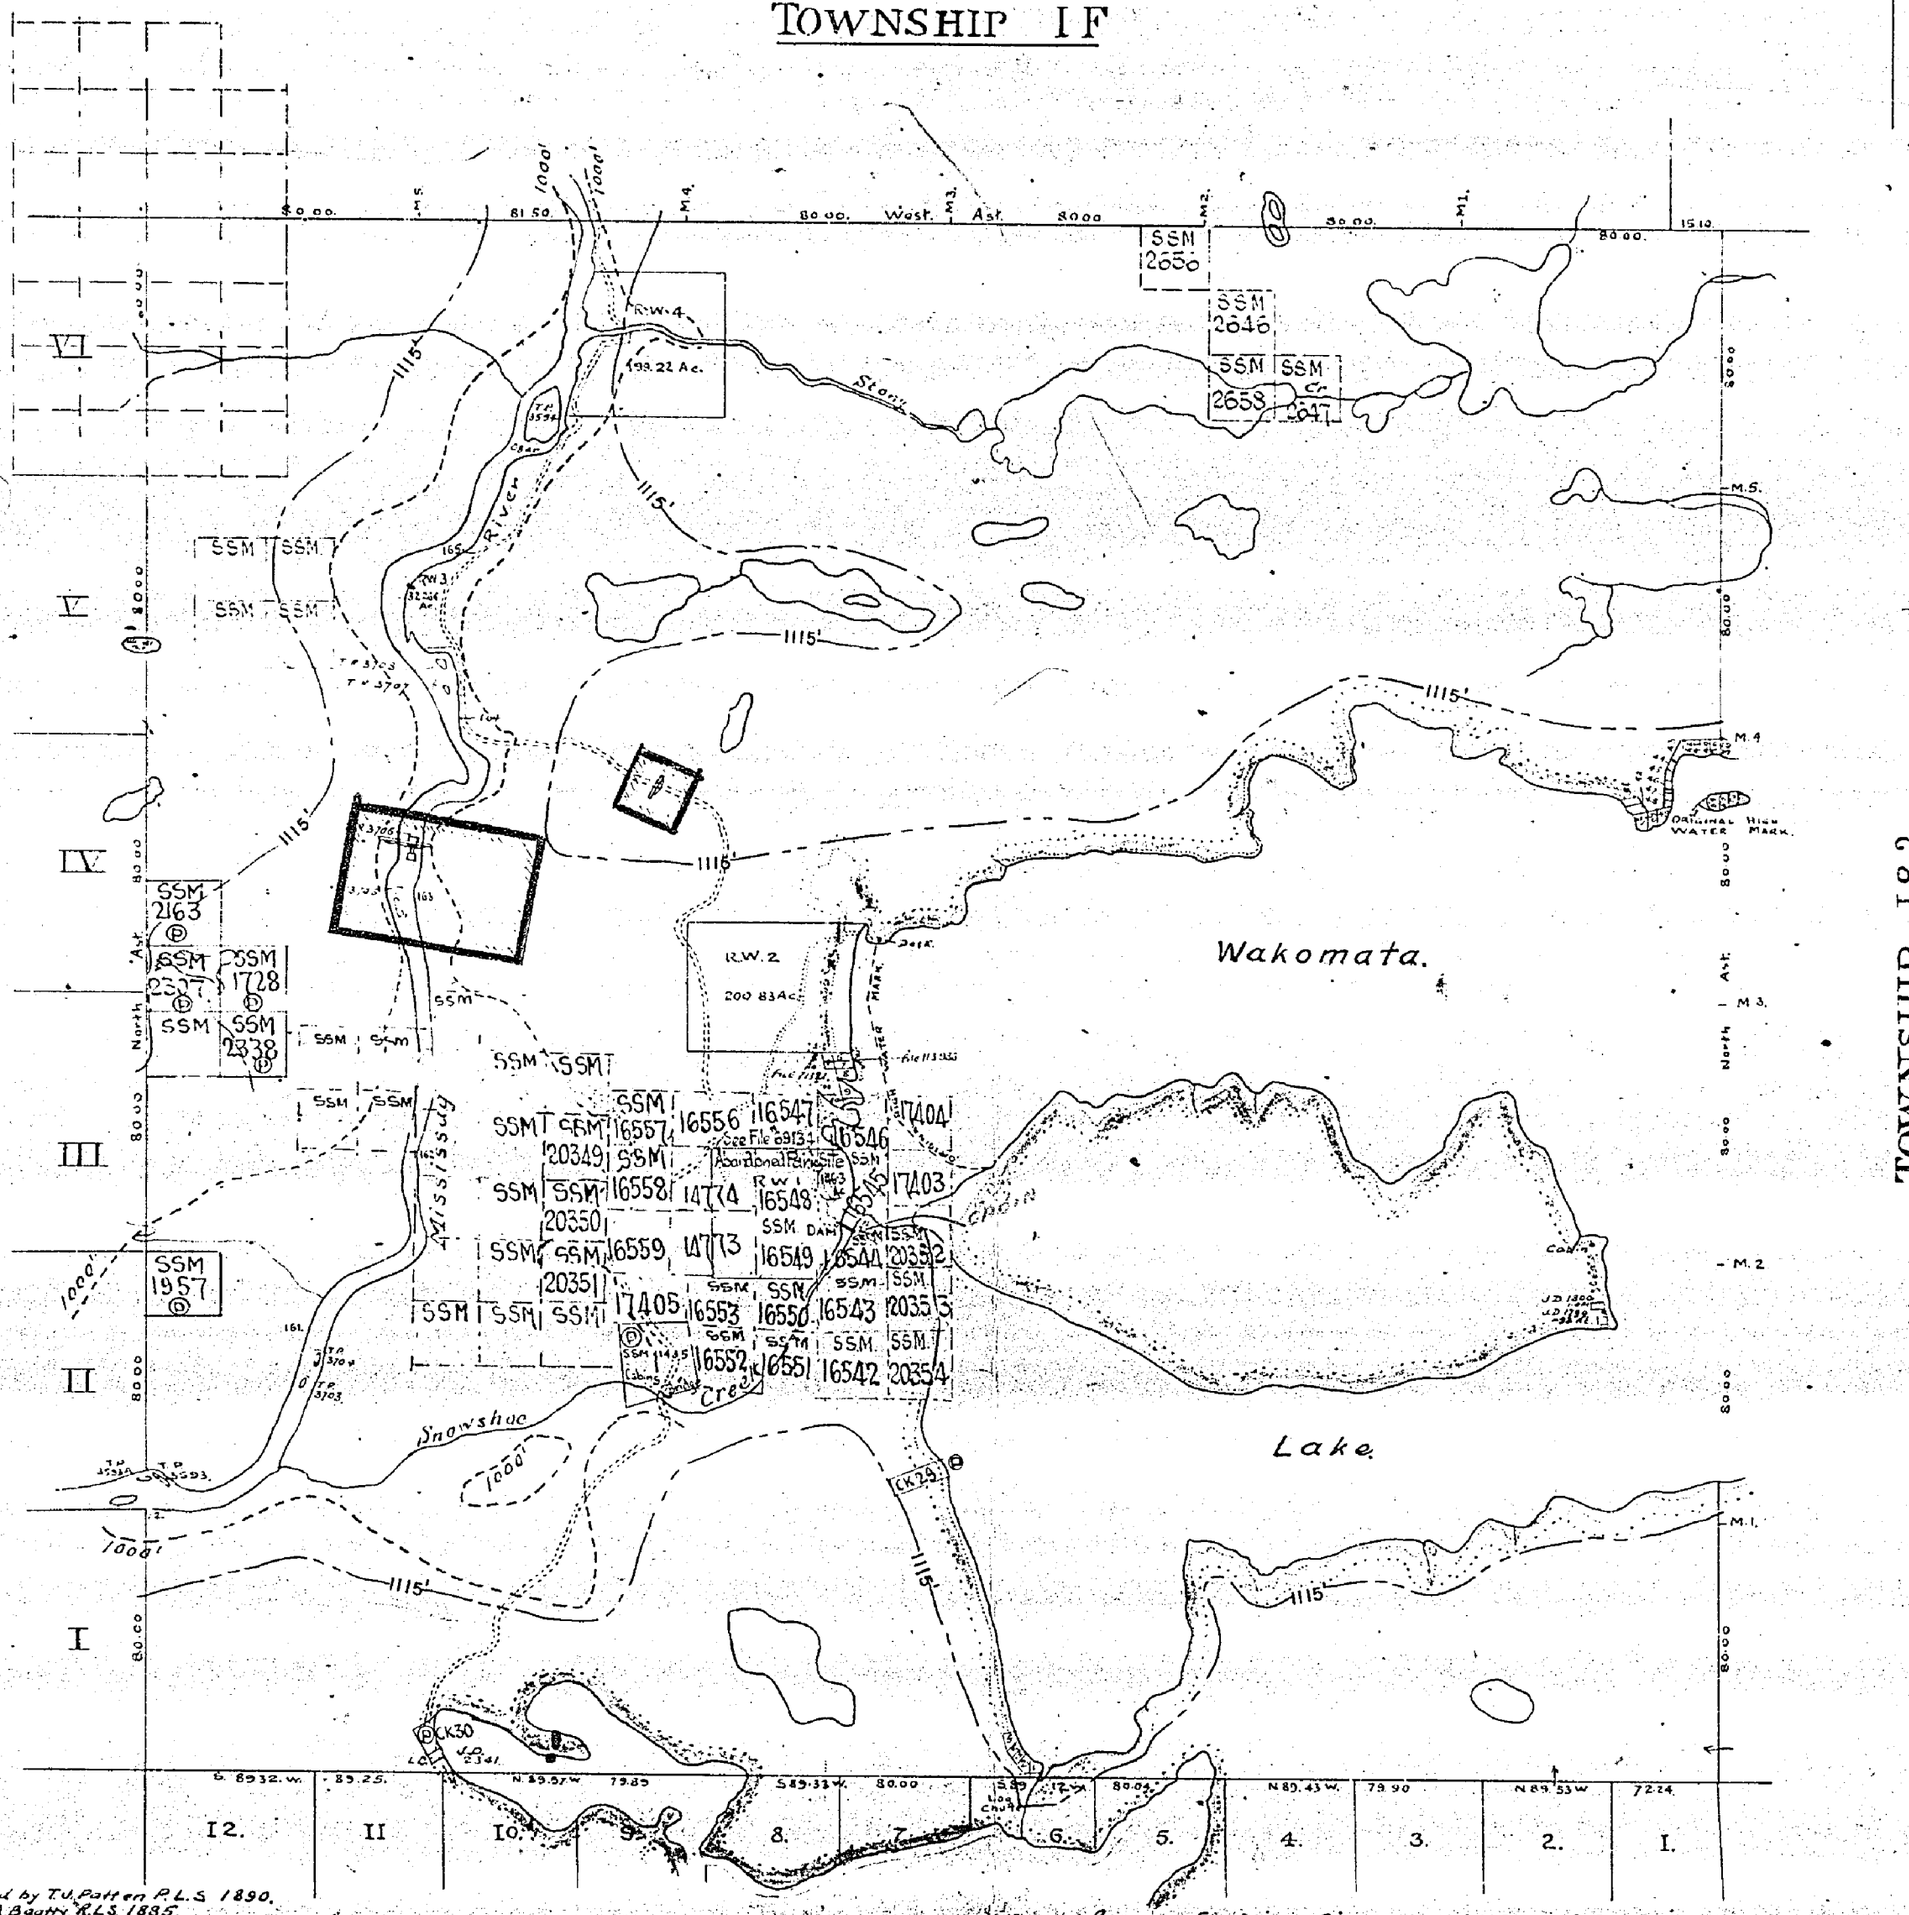

Var. N. & East boundaries surveyed by T.J. Patten P.L.S. 1890.
South boundary surveyed by O. Beatty P.L.S. 1885.
West boundary surveyed by A.G. Cavon P.L.S. 1836.
South boundary re-surveyed by J.S. Dobie O.L.S. 1933.
Flooded lands surveyed by E.M. MacQuarrie O.L.S. 1928 to contour 1115'9. Area 284.7 Ac. shown thus ——
for the Mississagi River Improvement Co. Ltd. File 2136 L.O. 2084.
Mississagi River surveyed by T.J. Patten O.L.S. 1922.
Road surveyed by C.F. Bush O.L.S. 1930 under instructions from the Dept. of Lands & Forests shown thus ——
Public Camp & Park Sites R.W.1, R.W.2, R.W.3 R.W.4 surveyed by R.W. Cade O.L.S. 1939 under instructions
from the Dept. of Lands & Forests dated Aug 8th 1939 R.W.1 to R.W.4 inclusive are originally known as
Park or Camp reservations Nos 23, 24, 25 & 28 respectively and referred to in file 113986.
Subdivisions showing lots 1 to 5, 6 to 10, 39 to 57 inclusive, surveyed by J.S. Dobie O.L.S. 1939
under instructions from the Dept. of Lands & Forests
Lakes & Rivers from aerial survey Ontario Forestry Branch, Dept. of Lands & Forests 1928.

Reserve Flooding Rights to H.E.P.C. of Ontario
to Contour 1120 G.S.C. File 5937. — Load —
FLOODING RIGHTS TO H.E.P.C. 1115' — — — —
Area Withdrawn From Staking Shown Thus ////////

GOULD

Surface reservations 200 wide by Dept. of L. & F.
Shewn hereon thus ——

Parcels marked P. are Patented.
L. Leased.
L.O. License of Occupation.

Department of Surveys.
Parliament Buildings.
Toronto, Ontario, Canada.

M.22

1615

TOWNSHIP 188

DISTRICT OF ALGOMA (CASSON)

Scale 40 Chains 1 Inch.

M. 1615

TOWNSHIP 1F

TOWNSHIP 182

OTTER

Wakomata.

Lake

Stony River

Snowshoe

Mississagi River

R.W.4 199.22 Ac.

R.W.3 32246 Ac.

R.W.2 200.83 Ac.



1615

TOWNSHIP 188

DISTRICT OF ALGOMA (CASSON)

Scale 40 Chains 1 Inch.

M. 1615

TOWNSHIP 188

OTER

Wakomata.

Lake

Stony

Snowshoe

Mississaga River

Reserve Flooding Rights to H.E.P.C. of Ontario to Contour 1120 G.S.C. File 5937. — 1080 —
Area liable to flooding shewn thus — 1080 —

GOULD

Surface reservations 200' wide by Dept of Lands & Forests shewn thus
Shelving Reserve thus

Parcels marked R are Patented.
" " L are Leased.
" " Lic are Licensed for Occupation.

Department of Surveys.
Parliament Buildings.
Toronto, Ontario, Canada

North line surveyed by T.U. Patten P.L.S. 1890.
East boundaries surveyed by C. Beatty, O.L.S. 1885.
South boundary surveyed by A.G. Cavon a P.L.S. 1886.
West boundary surveyed by A.G. Cavon a P.L.S. 1886.
South boundary re-surveyed by J.S. Dobie O.L.S. 1933.
Flooded lands surveyed by E.M. MacQuarrie, O.L.S. 1928 to Contour 1139. Area 284.7 Ac. shown thus ——
for the Mississaga River Improvement Co. Ltd. File 2138 & Lo. 2084.
Mississaga River surveyed by T.U. Patten O.L.S. 1922.
Road surveyed by C.F. Bush O.L.S. 1930 under instructions from the Dept. of Lands & Forests shown thus ——
Public Camps & Park Sites R.W.1, R.W.2, R.W.3 R.W.4 surveyed by R.W. Cade O.L.S. 1939 under instructions from the Dept of Lands & Forests, dated Aug 8th 1939 R.W.1 to R.W.4 inclusive are originally known as Park or Camp Reservations Nos 23, 24, 25 & 28 respectively and referred to in file 113386.
Subdivisions shown by Lots (Lots 6 to 19 & 32 to 57 inclusive) surveyed by J.S. Dobie O.L.S. 1939 under instructions from the Dept of Lands & Forests.
Lakes & Rivers from aerial survey Ontario Forestry Branch, Dept of Lands & Forests 1928.

188

1615


DAGLE TP. M.1379

wagg tp. M.1378

OTTER TWP. - M.1325

JACKSON TP. M.1614

GOULD TWP. - M.455

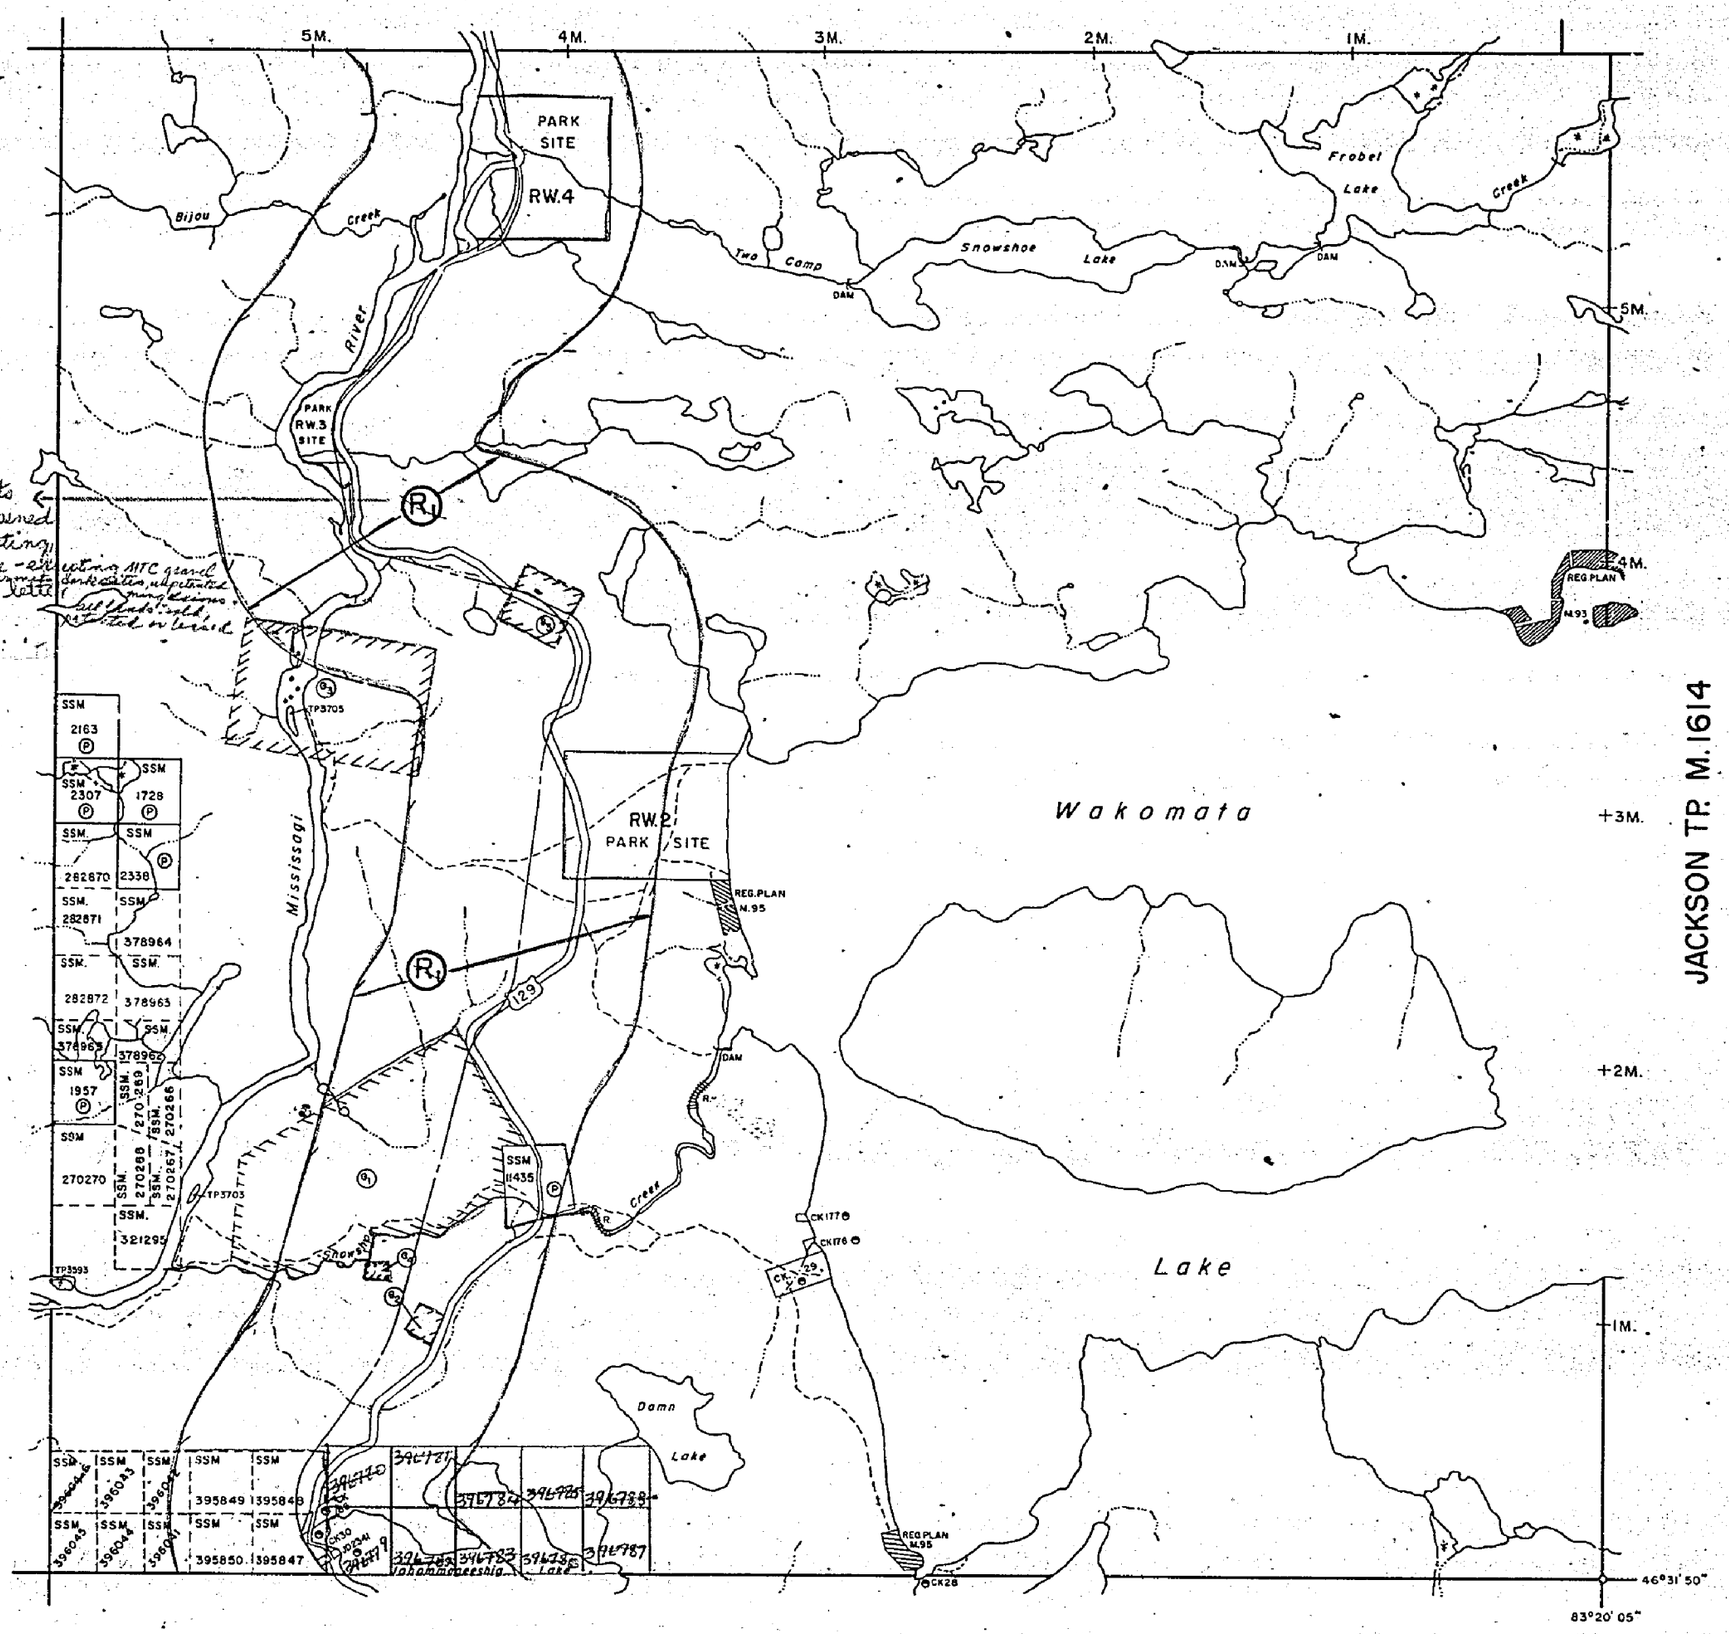

THE TOWNSHIP

CASSON

(Tp. 188)

DISTRICT OF
ALGOMA

SAULT STE. MARIE
MINING DIVISION

SCALE: 1-INCH = 40 CHAINS

LEGEND

PATENTED LAND	(P)
CROWN LAND SALE	C.S.
LEASES	(L)
LOCATED LAND	Loc.
LICENSE OF OCCUPATION	L.O.
MINING RIGHTS ONLY	M.R.O.
SURFACE RIGHTS ONLY	S.R.O.
ROADS	
IMPROVED ROADS	
KING'S HIGHWAYS	
RAILWAYS	
POWER LINES	
MARSH OR MUSKEG	
MINES	
CANCELLED	C.

NOTES

400' surface rights reservation along the shores of all lakes and rivers.

Summer resort locations patented for surface rights only shown thus (P)

Flooding rights

-on Mississagi River reserved to contour 903' W.P.L.A. N° 35 F. 5937 vol.4

OTHER AREAS WITHDRAWN FROM STAKING

S.R. - SURFACE RIGHTS M.R.-MINING RIGHTS

Section	Order N°.	Date	Disposition	File
(R) 43(8) S.O. (1970)	[illegible]	25/8/70	S.R.	156507

DATE OF ISSUE
OCT 7 1975

SAND & GRAVEL

(9) M.T.C. PIT N° 1587
(9) M.T.C. PIT N° 1333
(9) GRAVEL File 5937 vol.3
(9) GRAVEL File: 156507

PLAN NO. M.1615

ONTARIO
MINISTRY OF NATURAL RESOURCES
SURVEYS AND MAPPING BRANCH

b.k.

1615

TOWNSHIP 188

DISTRICT OF ALGOMA (CASSON)

Scale 40 Chains 1 Inch. M. 1615

TOWNSHIP I F

1615

PLAN OF
T'WP. 188. (CASSON)

SAULT STE. MARIE MINING DIVISION.

DISTRICT OF ALGOMA.

Scale, 40 chains to an inch.

M. 1615

TWP. 1.F

Ast North.

W. E S.

80.00 5 M. 81.50 4 M. 80.00 3 M. 80.00 2 M. 80.00 1 M. 80.00 15.10

5.5 M 2656 | S.S.M 2646 | S.S.M 2658 | S.S.M 2647

R.W.4. 193.22 Ac. Stony

1115' 1000' 165' R.W.3 Ac. 31.266 TP 3708 TP 3707 TP 3594

5. 4. 3. 2. 1.

S.S.M 2163 | S.S.M 2307 | S.S.M 1728 | S.S.M 1338 | S.S.M 1957

OTTER T'WP.

Mississagi River

R.W.2 Ac. 200.83 Dock. Original High Water Mark. Trail to Original High Water Mark. File 113936 File 71321

WAKOMATA LAKE.

Abandoned Power Site 1.43 Ac. S.S.M. 1435 Cabins Bridge

Snowshoe Creek TB 3704 TP 3703 TP 3593 TP 3533 CR 29

Cabin J.O. 1800 1.0 Ac. J.O. 1799 0.92 Ac.

CR 30 J.O. 2341 L.O.

83.25 79.89 80.00 Log Chute 80.04 79.90 72.24

12. 11. 10. 9. 8. 7. 6. 5. 4. 3. 2. 1.

GOULD T'WP.

T'WP 182.

Notes.

Railways shewn
Paved Highways
Gravel
Highway Route Nos (2)
Other Roads
Trails & Paths
Telephone & Telegraph Lines
Electric Power Lines
Non-perennial Streams
Surface reservations 200' wide by Dept. of L. & F. shewn

Bridges
Buildings
Swamps
Areas marked P. are Patented
" " L. - Leased
" " LO. - held under Licence-of-Occupation
Areas with drawn from staking.
Flooding rights to H.E.P.C. to contour 1115. shewn 1115. to 1120 G.S.C. File 5937

TOWNSHIP 188. S.S.M.

1615

PLAN OF TWP. 188.

OFFICE MAP

(CASSON)

SAULT STE. MARIE MINING DIVISION.

DISTRICT OF ALGOMA.

Scale, 40 chains to an inch.

M. 1615

TWP. 1.F

Arrz North.

W. E

S.

80.00 | 5 M. | 81.50 | 4 M. | 80.00 | 3 M. | 80.00 | 2 M. | 80.00 | 1 M. | 80.00 | 15.10

6. 5. 4. 3. 2. 1.

R.W.4. 99.22 Ac.

Stony.

S.S.M. 2656

S.S.M. 2646

S.S.M. 2658

S.S.M. 2647

1115'

1000'

1165'

R.W.3. Ac. 32.266

T.P. 3708

T.P. 3707

T.P. 3705

163

R.W.2. Ac. 200.83

Dock.

Original High Water Mark.

S.S.M. 2165

S.S.M. 2307

S.S.M. 1728

S.S.M. 2338

S.S.M. 1957

161.

T.P. 3704

T.P. 3703

T.P. 3593A

T.P. 3593

Mississagi River

OTTER T'WP.

WAKOMATA LAKE.

T'WP. 182.

Snowshoe Creek

Cabins

Bridge

Cabin

J.O. 1800 1.0 Ac.

J.O. 1799 0.92 Ac.

S.S.M. 1435

Ck. 29

Ck. 30

J.O. 2341

L.O.

File 113936

File 71321

22178 22174 22175 22176 22179 22173 22177 22180 22159

S.S.M. 16537 20343 16559 20350 16559 20355 16557 16558 14774 14773 16549 16550 16562 16561 16547 G9134 G9134 16546 16544 16543 20352 20353 20354 17404 17403

Abandoned Mr. Sites 1.43 Ac.

Log Chute

Notes.

Railways shewn

Paved Highways

Gravel "

Highway Route No. 2

Other Roads

Trails & Paths

Telephone & Telegraph Lines

Electric Power Lines

Non-perennial Streams

Surface reservations 200' wide by Dept. of L & F shewn

Bridges

Buildings

Swamps

Areas marked P are Patented

" L " Leased

" LO " held under Licence of Occupation

Areas with arcuate from striking. 1115

Flooding rights to H.E.P.C. to contour 1115 shewn to 1120 G.S.C. File 5937.

12. 11. 10. 9. 8. 7. 6. 5. 4. 3. 2. 1.

89.25 79.89 80.00 80.00 79.90 72.24

GOULD T'WP.

TOWNSHIP 188. S.S.M. 365.

1615

TOWNSHIP 188

DISTRICT OF ALGOMA

(CASSON)

M. 1615

Scale — 40 Chains = 1 Inch

TOWNSHIP 1F

PARK OR CAMP RESERVE No. 28 FILE 113986

PARK OR CAMP RESERVE No. 24 FILE 113986

PARK OR CAMP RESERVE No. 23 FILE 113986

Stony Cr.

River

Mississagi

Snowshoe Creek

Wahomata Lake

OTTER

TOWNSHIP 182


11 k.e. Bdys by P.L.S. T.J. Patten 1890.
S Bdy " P.L.S. D. Beatty 1885
W. " P.L.S. A.G. Cavana 1886.
Flooded lands by O.L.S. E.M. MacQuarrie Jan 4th 1928 to Contour 1139 shown thus [illegible] Area 284.7 Acs
Traverse of Mississagi River by O.L.S. T.J. Patten 1922

Road shown thus ——— surveyed by O.L.S. C.E. Bush 1930
Other lakes and Rivers from Aerial Survey

GOULD

Department of Surveys
Parliament Buildings
Toronto, Ontario, Canada

1615

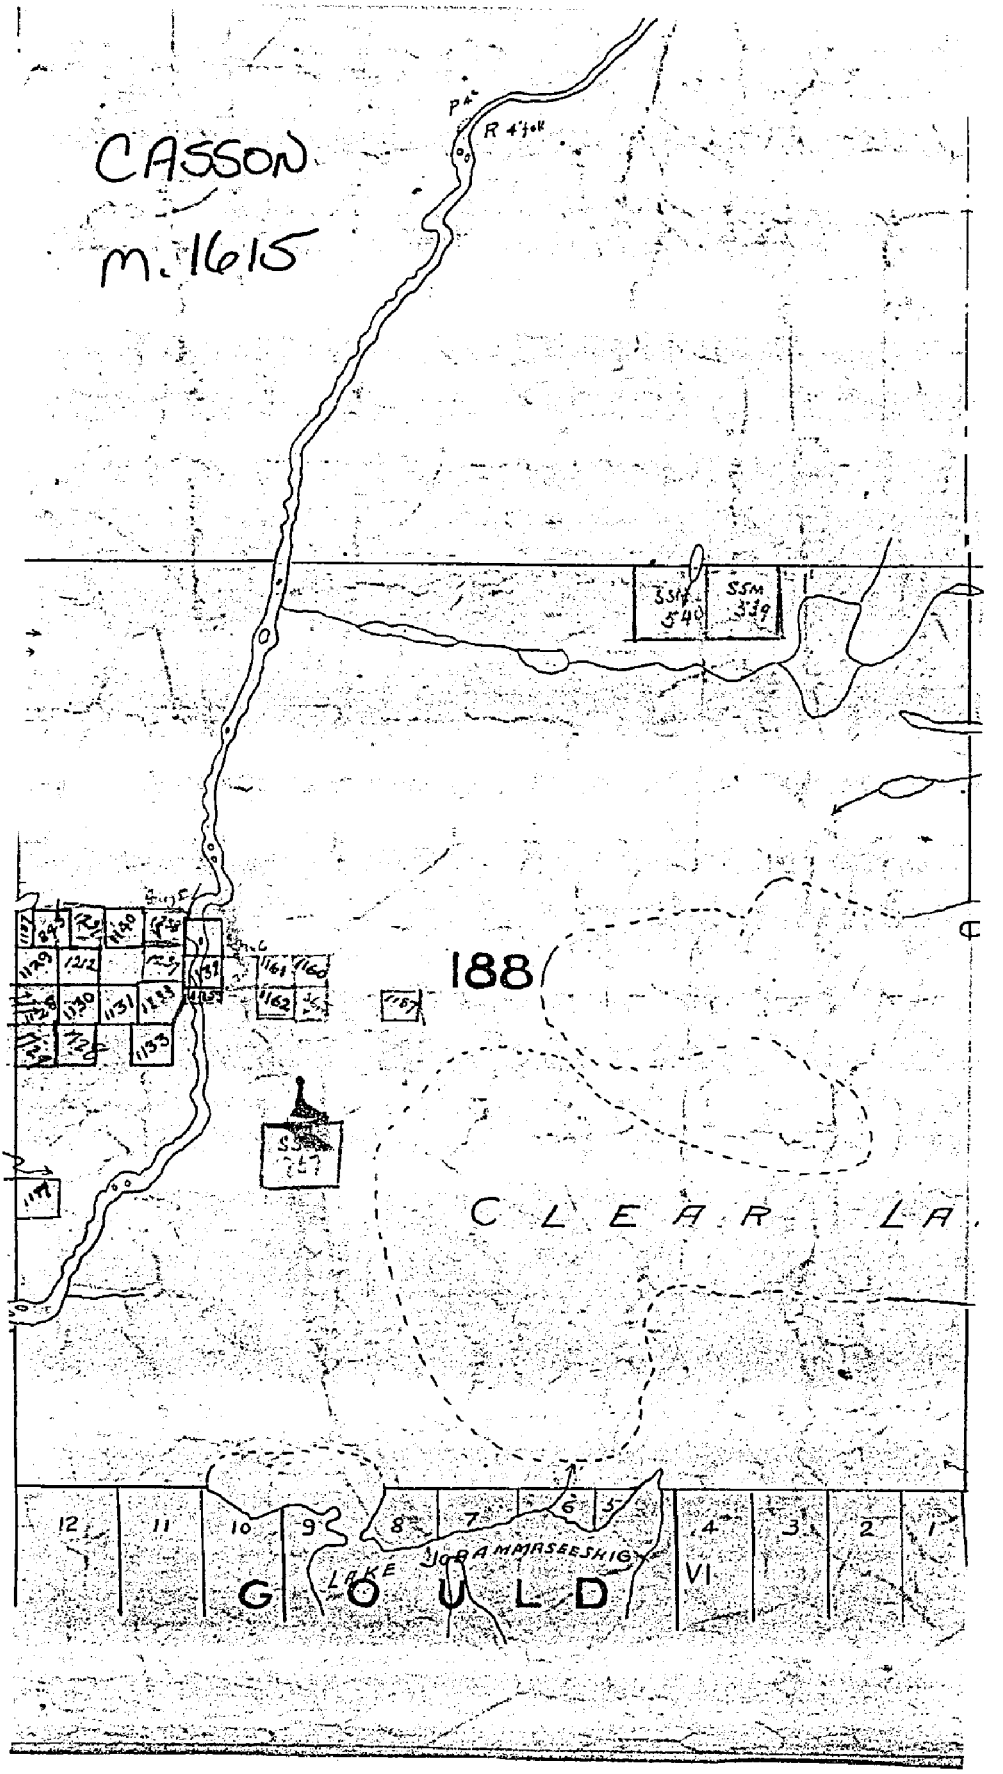

1615

TWP. 1F - M.1379

TWP. 1E - M.1378

OTTER TWP. - M.1325

TWP. 182 - M.1614

GOULD TWP. - M.455

THE TOWNSHIP

188 CASSON

DISTRICT OF
ALGOMA

SAULT STE. MARIE
MINING DIVISION

SCALE: 1-INCH = 40 CHAINS

LEGEND

PATENTED LAND	P
CROWN LAND SALE	C.S.
LEASES	L
LOCATED LAND	L.C.
LICENSE OF OCCUPATION	L.O.
MINING RIGHTS ONLY	M.R.O.
SURFACE RIGHTS ONLY	S.R.O.
ROADS	
IMPROVED ROADS	
KING'S HIGHWAYS	
RAILWAYS	
POWER LINES	
MARSH OR MUSKEG	
MINES	
CANCELLED	C

NOTES

400' surface rights reservation around all lakes and rivers.

Summer resort locations patented for surface rights only shown thus

Flooding rights

- on Mississagi River reserved to contour 903' W.P.L.A. No. 35. File: 5937, Vol.4.
- on Wakomata Lake to contour 1115' File: 2136, Vol. 182

PLAN NO. M.1615

DEPARTMENT OF MINES

— ONTARIO —

1615


TWP. 1F - M.1379

TWP. 1E - M.1378

TWP. 182 - M.1614

OTTER TWP. - M.1325

GOULD TWP. - M.455

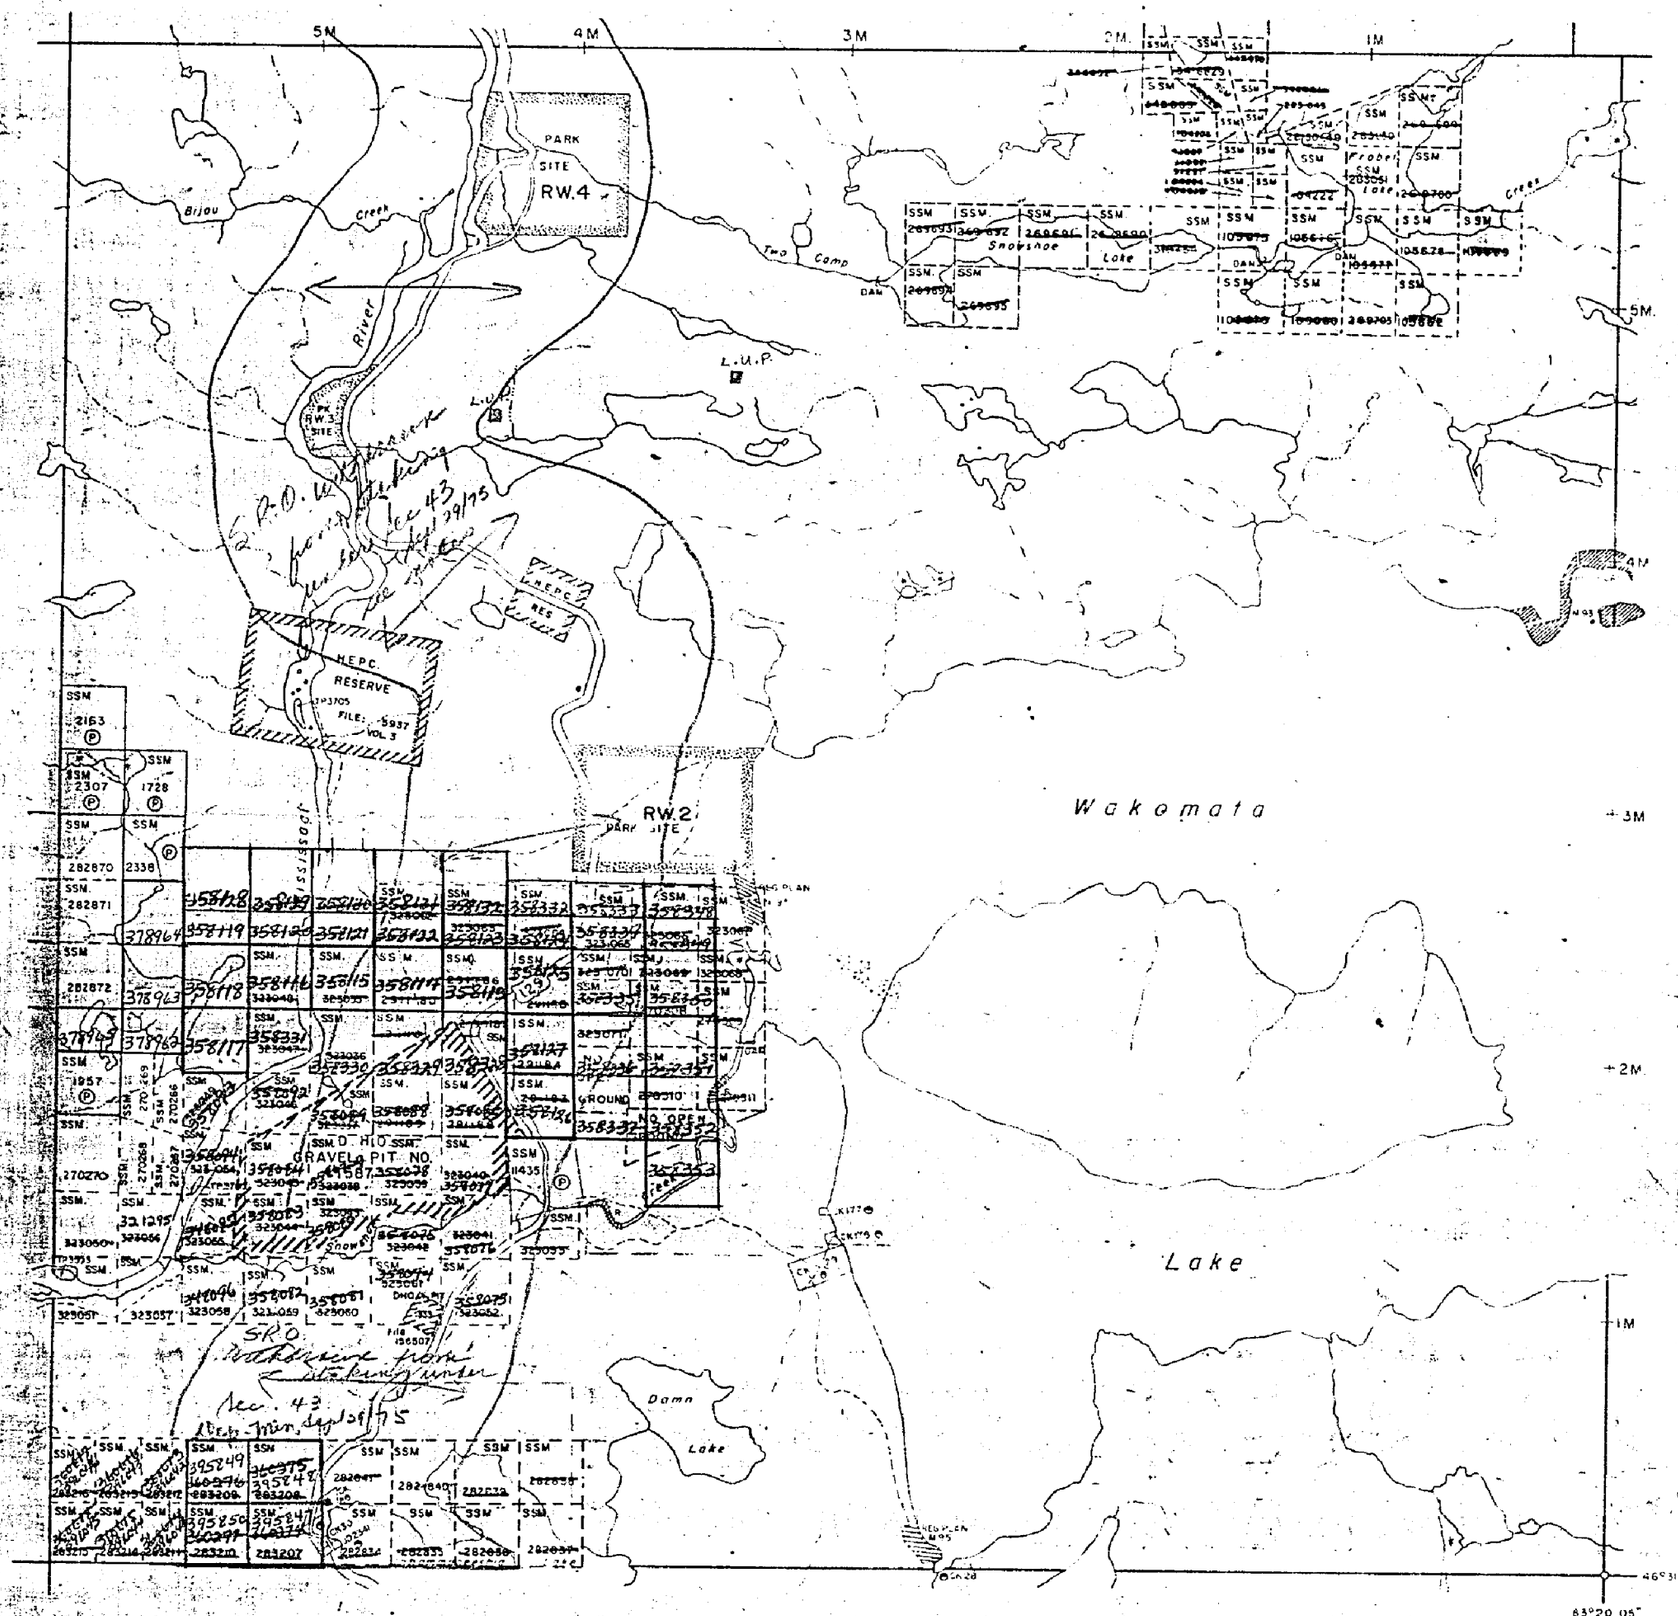

THE TOWNSHIP

188

(CASSON)

DISTRICT OF ALGOMA

SAULT STE. MARIE MINING DIVISION

SCALE: 1-INCH = 40 CHAINS

LEGEND

PATENTED LAND	P
CROWN LAND SALE	C.S.
LEASES	L
LOCATED LAND	Loc.
LICENSE OF OCCUPATION	L.O.
MINING RIGHTS ONLY	M.R.O.
SURFACE RIGHTS ONLY	S.R.O.
ROADS	
IMPROVED ROADS	
KING'S HIGHWAYS	
RAILWAYS	
POWER LINES	
MARSH OR MUSKEG	
MINES	
CANCELLED	C

NOTES

400' surface rights reservation around all lakes and rivers.

Summer resort locations patented for surface rights only shown thus ⊖

Flooding rights

- on Mississagi River reserved to contour 903' W.P.L.A. No. 35. File: 5937, Vol.4
- on Wakomata Lake to contour 1115' File: 2136, Vol. 182

AREA OUTLINED IN RED IS WITHDRAWN FROM PROSPECTING, STAKING OUT, SALE OR LEASE UNDER SEC 43 OF M.A. EXCEPTING & RESERVING THEREFROM ALL MTC GRAVEL PITS, QUARRY PERMITS, PARK SITES, UNPATENTED MINING CLAIMS & OTHER LANDS PATENTED, SOLD, LEASED OR OTHERWISE ALIENATED FROM THE CROWN, LETTER DEP. MINISTER - SEPT 29/75.

PLAN NO. M.1615

ONTARIO DEPARTMENT OF MINES AND NORTHERN AFFAIRS

1615


TWP. 1F - M.1379

TWP. 1E - M.1378

OTTER TWP. - M.1325

TWP. 182 - M.1614

GOULD TWP. - M.455

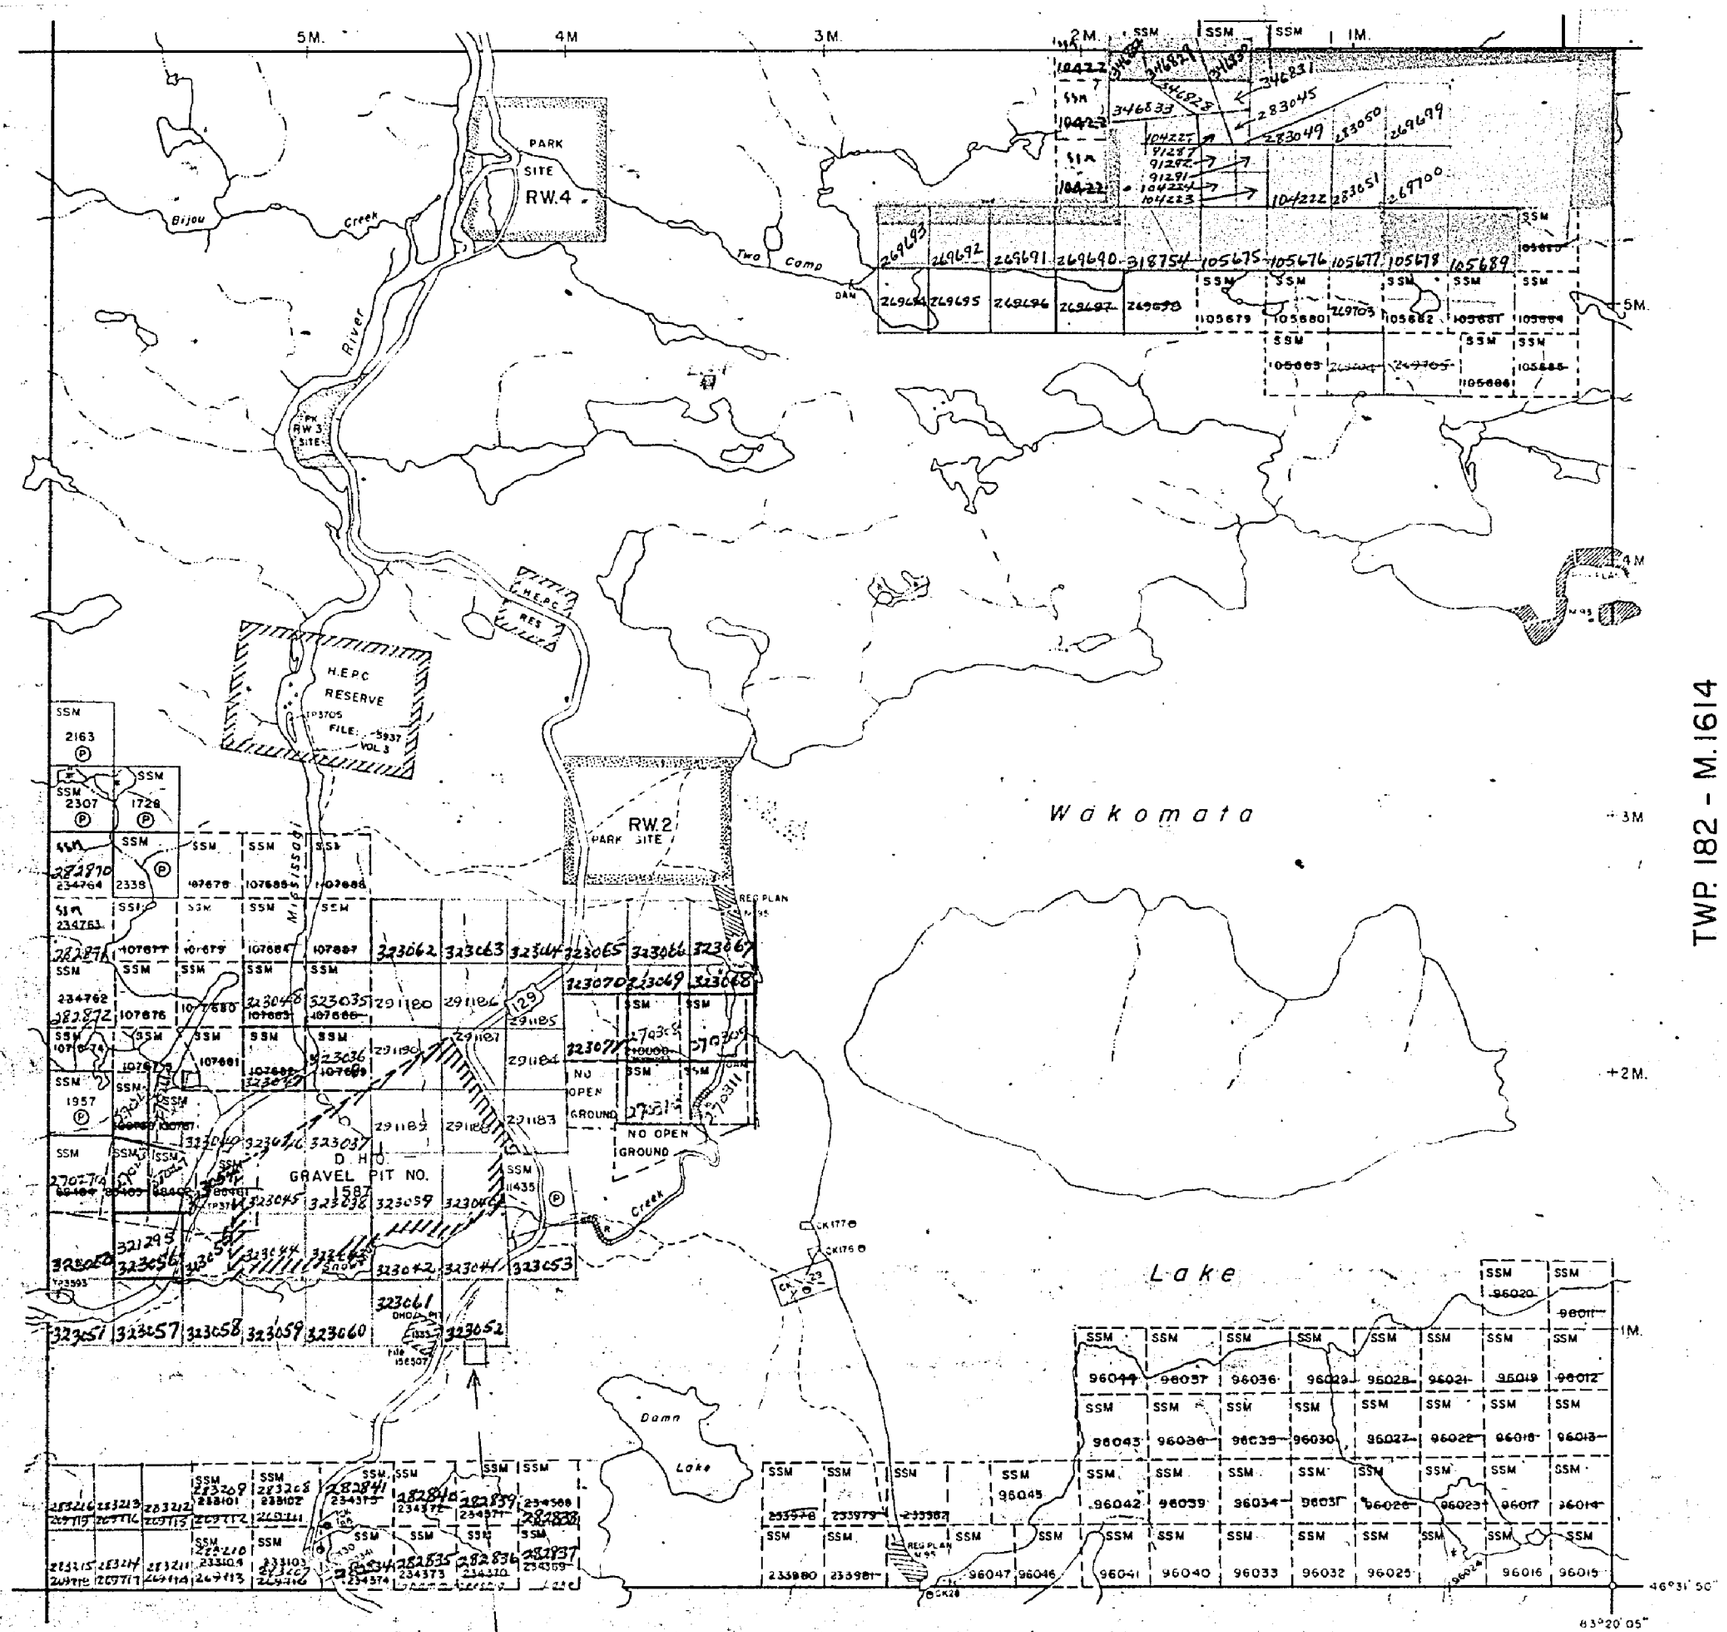

THE TOWNSHIP

188

CASSON

DISTRICT OF ALGOMA

SAULT STE. MARIE MINING DIVISION

SCALE: 1-INCH = 40 CHAINS

LEGEND

PATENTED LAND	Ⓟ
CROWN LAND SALE	C.S
LEASES	Ⓛ
LOCATED LAND	Loc
LICENSE OF OCCUPATION	L.O.
MINING RIGHTS ONLY	M.R.O.
SURFACE RIGHTS ONLY	S.R.O.
ROADS	
IMPROVED ROADS	
KING'S HIGHWAYS	
RAILWAYS	
POWER LINES	
MARSH OR MUSKEG	
MINES	
CANCELLED	C.

NOTES

400' surface rights reservation around all lakes and rivers.

Summer resort locations patented for surface rights only shown thus ◓

Flooding rights

- on Mississagi River reserved to contour 903' W.P.L.A. No. 35. File: 5937, Vol.4
- on Wakomata Lake to contour 1115' File: 2136, Vol. 182

PLAN NO. M.1615

ONTARIO DEPARTMENT OF MINES AND NORTHERN AFFAIRS

1615

TOWNSHIP 188

DISTRICT OF ALGOMA (CASSON)

M. 1615

Scale - 40 Chains = 1 Inch

TOWNSHIP 1 E

PARK OR CAMP RESERVE No 28 FILE 113986

PARK OR CAMP RESERVE No. 24. FILE 113986

PARK OR CAMP RESERVE No 23 FILE 113986

cemetery

Stony cr

Silver

Mississagi

Snowshoe Creek

Wakomata Lake

OTTER

TOWNSHIP 182

GOULD

T.E.L. Bdys by P.L.S. T.J. Patten 1890.
S Bdy " P.L.S. D. Beatty 1885
W " P.L.S. A.G Covana 1886
Flooded lands by O.L.S. E.M MacQuarrie Jan 4th 1928 to Contour 113'9 shown thus ▬ Area 284.7 Acs
Traverse of Mississagi River by O.L.S. T.J. Patten 1922

Road shown thus ═══ surveyed by O.L.S. C.E Bush 1930
Other Lakes and Rivers from Aerial Survey

Department of Surveys
Parliament Buildings
Toronto, Ontario, Canada

1615

TOWNSHIP 188

DISTRICT OF ALGOMA (CASSON)

Scale 40 Chains 1 Inch M. 1615

TOWNSHIP 182

OTTER

Wakomata Lake

Stony River

Snowshoe Creek

Mississagi River

Reserve Flooding Rights to H.E.P.C. of Ontario to Contour 1120 G.S.C. File 3937. 1000'

FLOODING RIGHTS TO H.E.P.C. 1115'

Area Withdrawn From Staking Shown Thus

GOULD

Surface reserve areas 200 wide by Dept of L. & F. shewn hereon thus

Parcels marked P are Patented.
L. Leased.
L.O. Licensed of Occupation.

North & East boundaries surveyed by T.J. Patton P.L.S. 1890.
South boundary surveyed by O. Beatty P.L.S. 1885.
West boundary surveyed by A.G. Cavana P.L.S. 1836.
South boundary re-surveyed by J.S. Dobie O.L.S. 1933.
Flooded lands surveyed by E.M. MacQuarrie O.L.S. 1928 to contour 1131.9. Area 284.7 Ac. shown thus
for the Mississagi River Improvement Co. Ltd. File 2138 L.O. 2084.
Mississagi River surveyed by T.J. Patton O.L.S. 1922.
Road surveyed by C.F. Bush O.L.S. 1930 under instructions from the Dept. of Lands & Forests shown thus
Public Camps & Park Sites R.W.1, R.W.2, R.W.3 R.W.4 surveyed by R.W. Code O.L.S. 1939 under instructions from the Dept. of Lands & Forests dated Aug 8th 1939 R.W.1 to R.W.4 inclusive are originally known as Park or Camp reservations Nos 23, 24, 25 & 28 respectively and referred to in file 113936
Subdivisions shown in 9 lots 1 to 5, 6 to 10, 39 to 57 inclusive, surveyed by J.S. Dobie O.L.S. 1939 under instructions from the Dept. of Lands & Forests
Lakes & Rivers from aerial survey Ontario Forestry Branch, Dept. of Lands & Forests 1928,

Department of Surveys.
Parliament Buildings.
Toronto, Ontario, Canada.

M.22

1615


TOWNSHIP 188

DISTRICT OF ALGOMA (CASSON)

Scale 40 Chains 1 Inch.

M. 1615

TOWNSHIP 1F

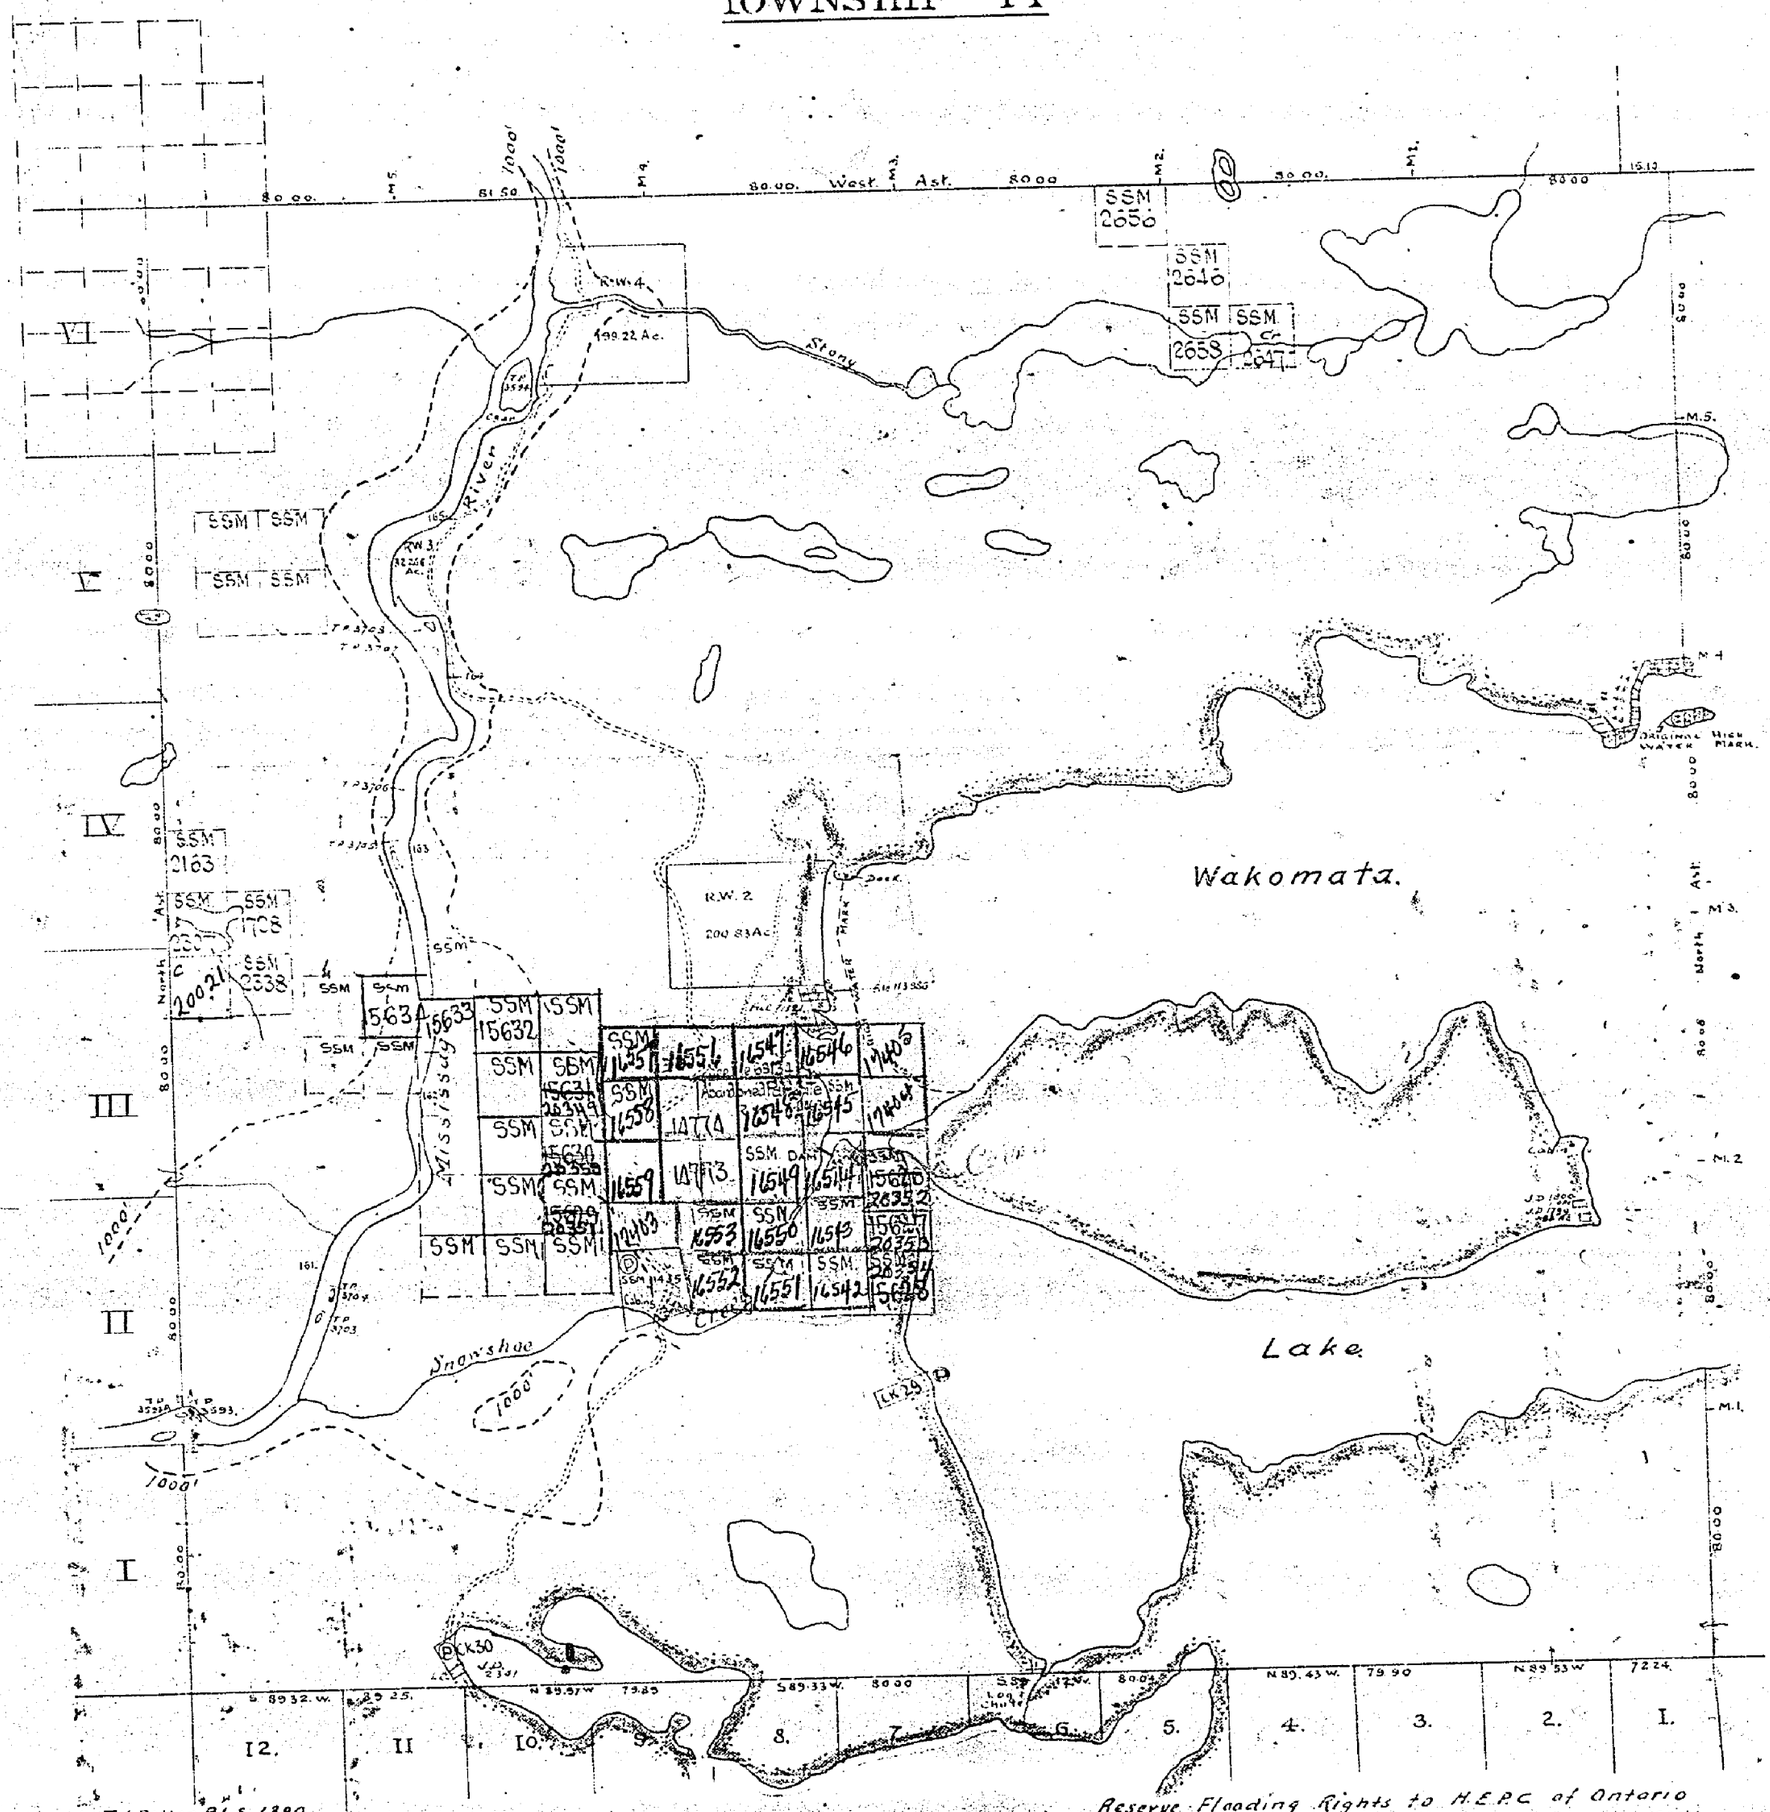

1615

PLAN OF
T'WP. 188.


OFFICE MAP
(CASSON)

SAULT STE. MARIE MINING DIVISION.
DISTRICT OF ALGOMA.

Scale, 40 chains to an inch.

M. 1615

TWP. 1.F

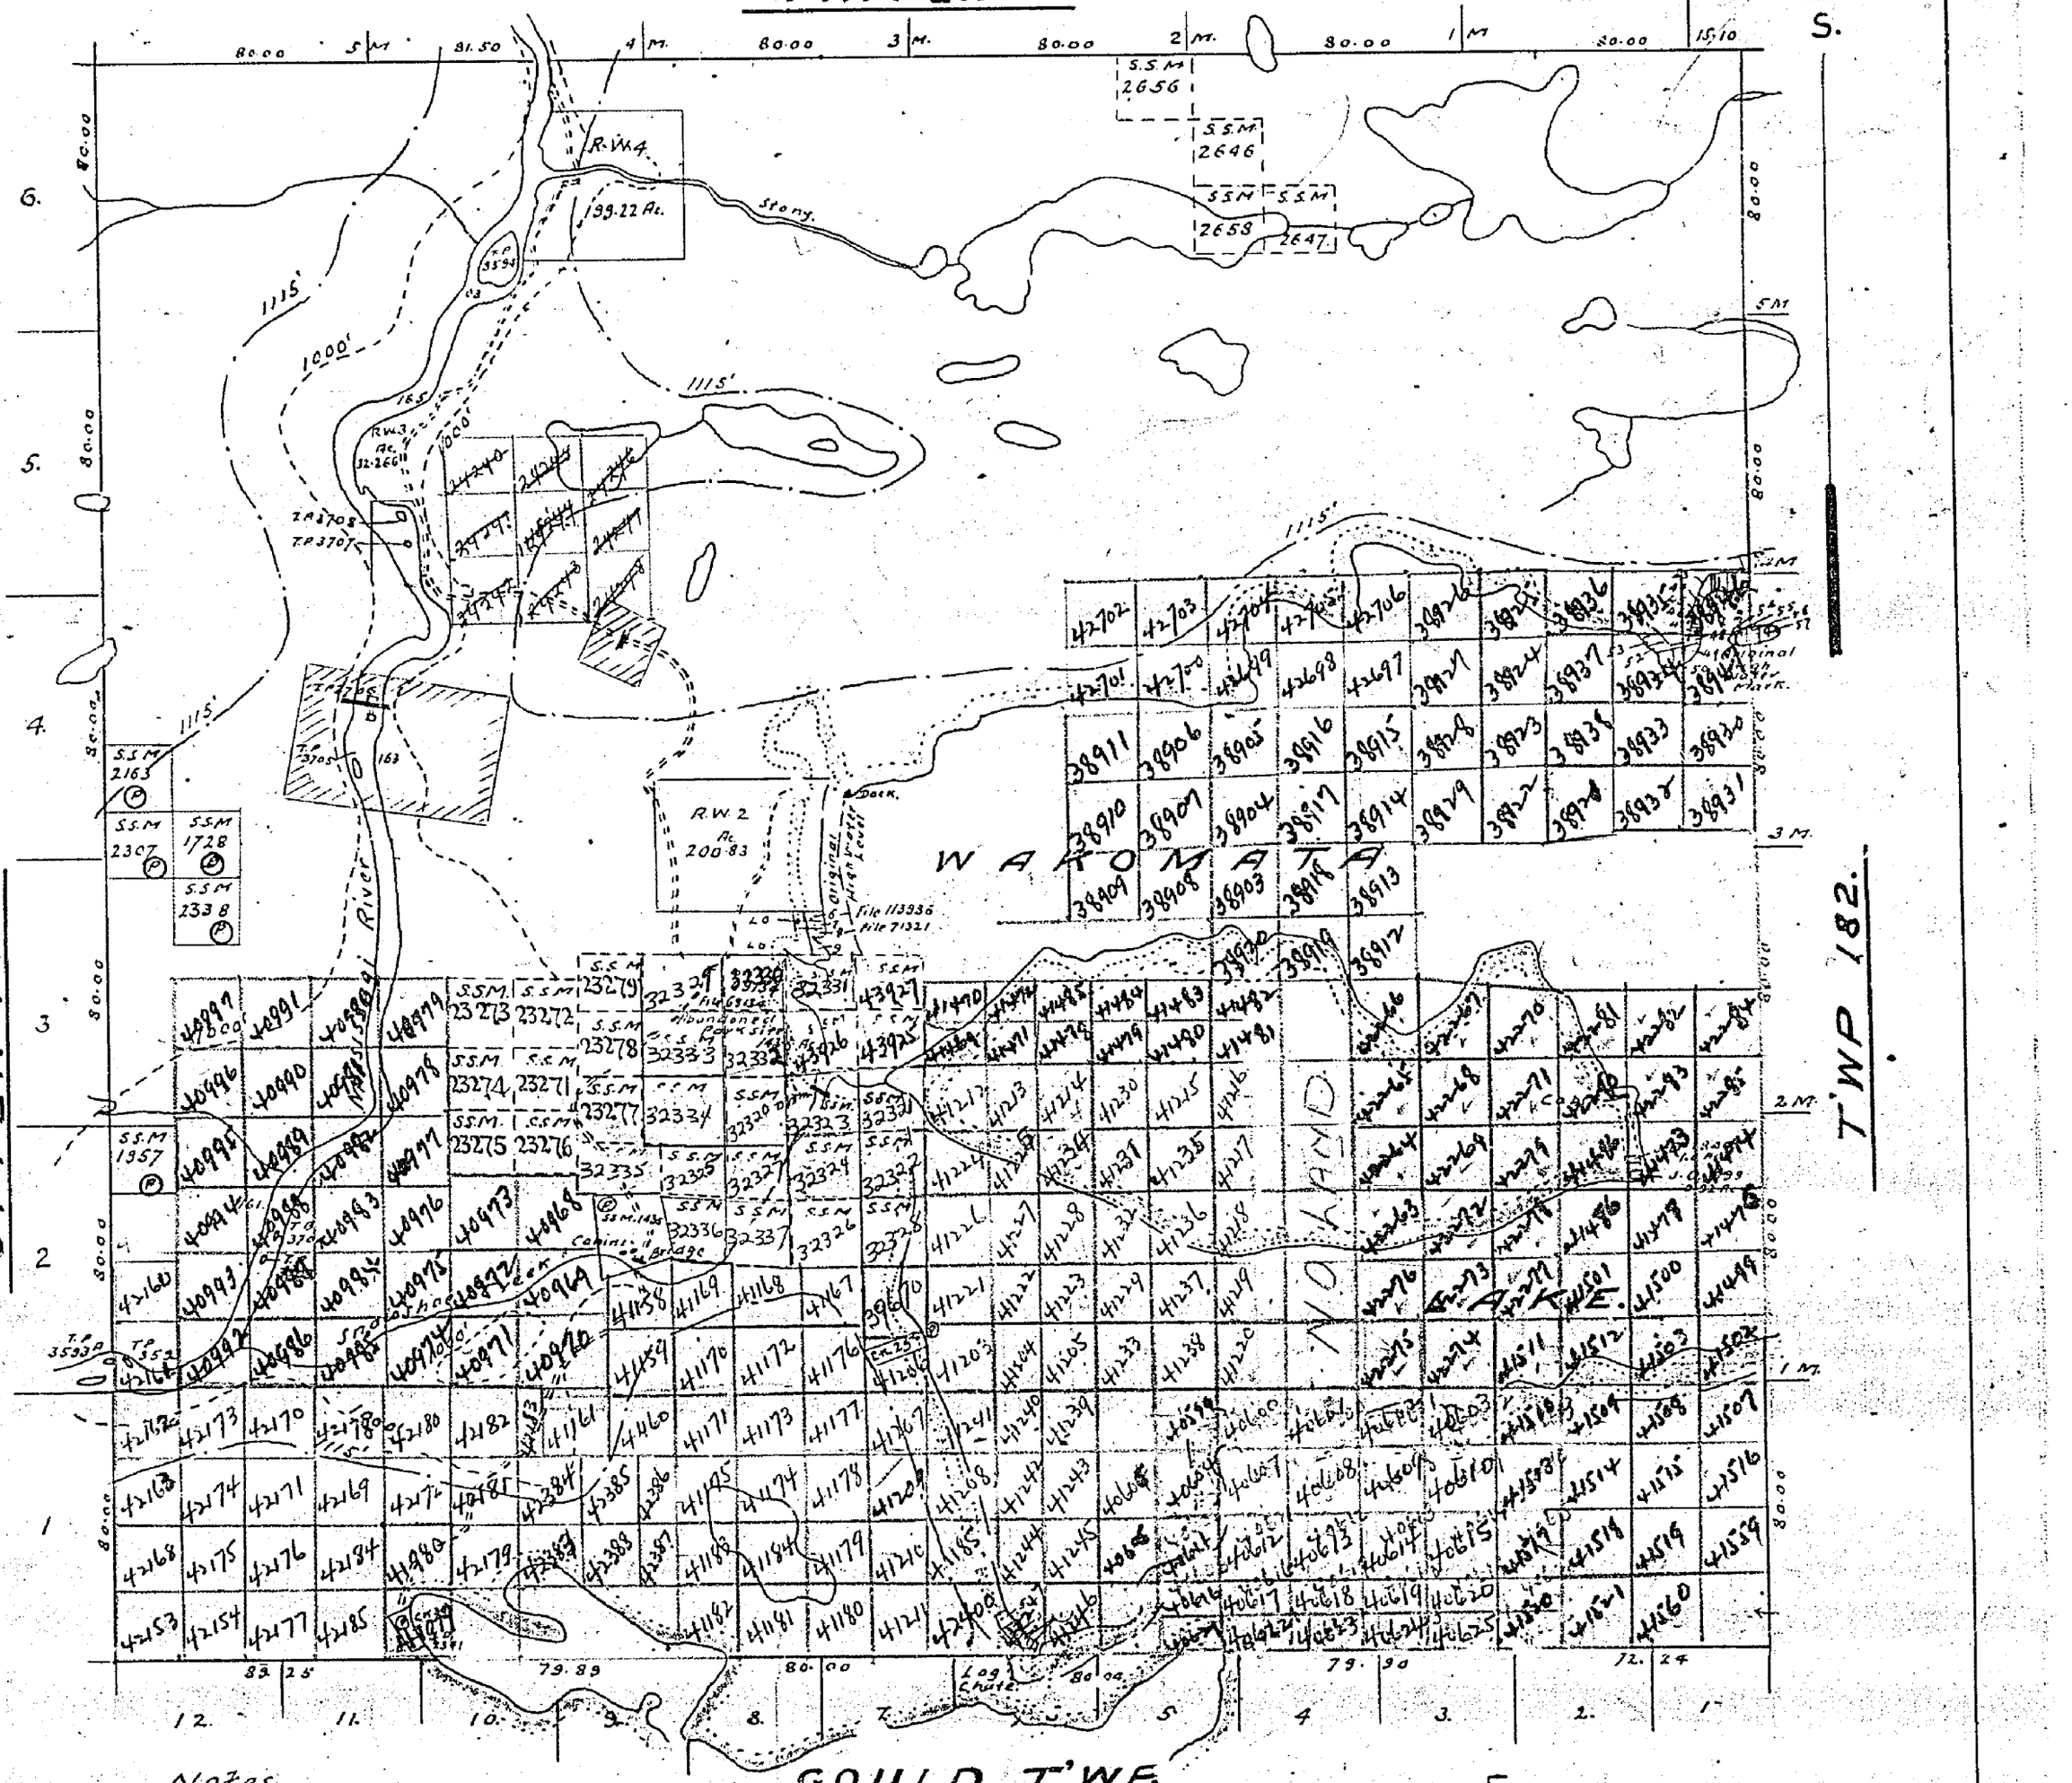
Astr. North.
W.
E.
S.
80.00
5 M.
81.50
4 M.
80.00
3 M.
80.00
2 M.
80.00
1 M.
20.00
15.10
5.5 M 2656
5.5 M 2646
5.5 M 2658
5.5 M 2647
R.W.4.
Ac. 199.22
Stony
1115'
1000'
R.W.3
Ac. 32.266
R.W.2
Ac. 200.83
Dock
Original High Water Mark
File 113936
File 71321
Abandoned Rock Siding
Cabins
Log Chute
Otter River
OTTER T'WP.
T'WP 182.
GOULD T'WP.
S.S.M. 2163
S.S.M. 2307
S.S.M. 1728
S.S.M. 2338
S.S.M. 1957
S.S.M. 23279
S.S.M. 23273
S.S.M. 23272
S.S.M. 23278
S.S.M. 23274
S.S.M. 23271
S.S.M. 23277
S.S.M. 23275
S.S.M. 23276
S.S.M. 32329
S.S.M. 32331
S.S.M. 43927
S.S.M. 32333
S.S.M. 32332
S.S.M. 43926
S.S.M. 32334
S.S.M. 32323
S.S.M. 32335
S.S.M. 32325
S.S.M. 32327
S.S.M. 32324
S.S.M. 32322
S.S.M. 32336
S.S.M. 32337
S.S.M. 32326
S.S.M. 32328
S.S.M. 39670
S.S.M. 32330
S.S.M. 32331
42702
42703
42704
42706
38926
38925
38936
38935
38911
38906
38905
38916
38915
38928
38923
38938
38933
38930
38910
38907
38904
38917
38914
38929
38924
38939
38931
38909
38908
38903
38918
38913
38912
38990
38919
42701
42700
42699
42698
42697
38927
38937
42702
42703
1615

PLAN OF TWP. 188

OFFICE MAP (CASSON)


SAULT STE. MARIE MINING DIVISION.

DISTRICT OF ALGOMA.

Scale, 40 chains to an inch.

M. 1615

TWP. 1. F

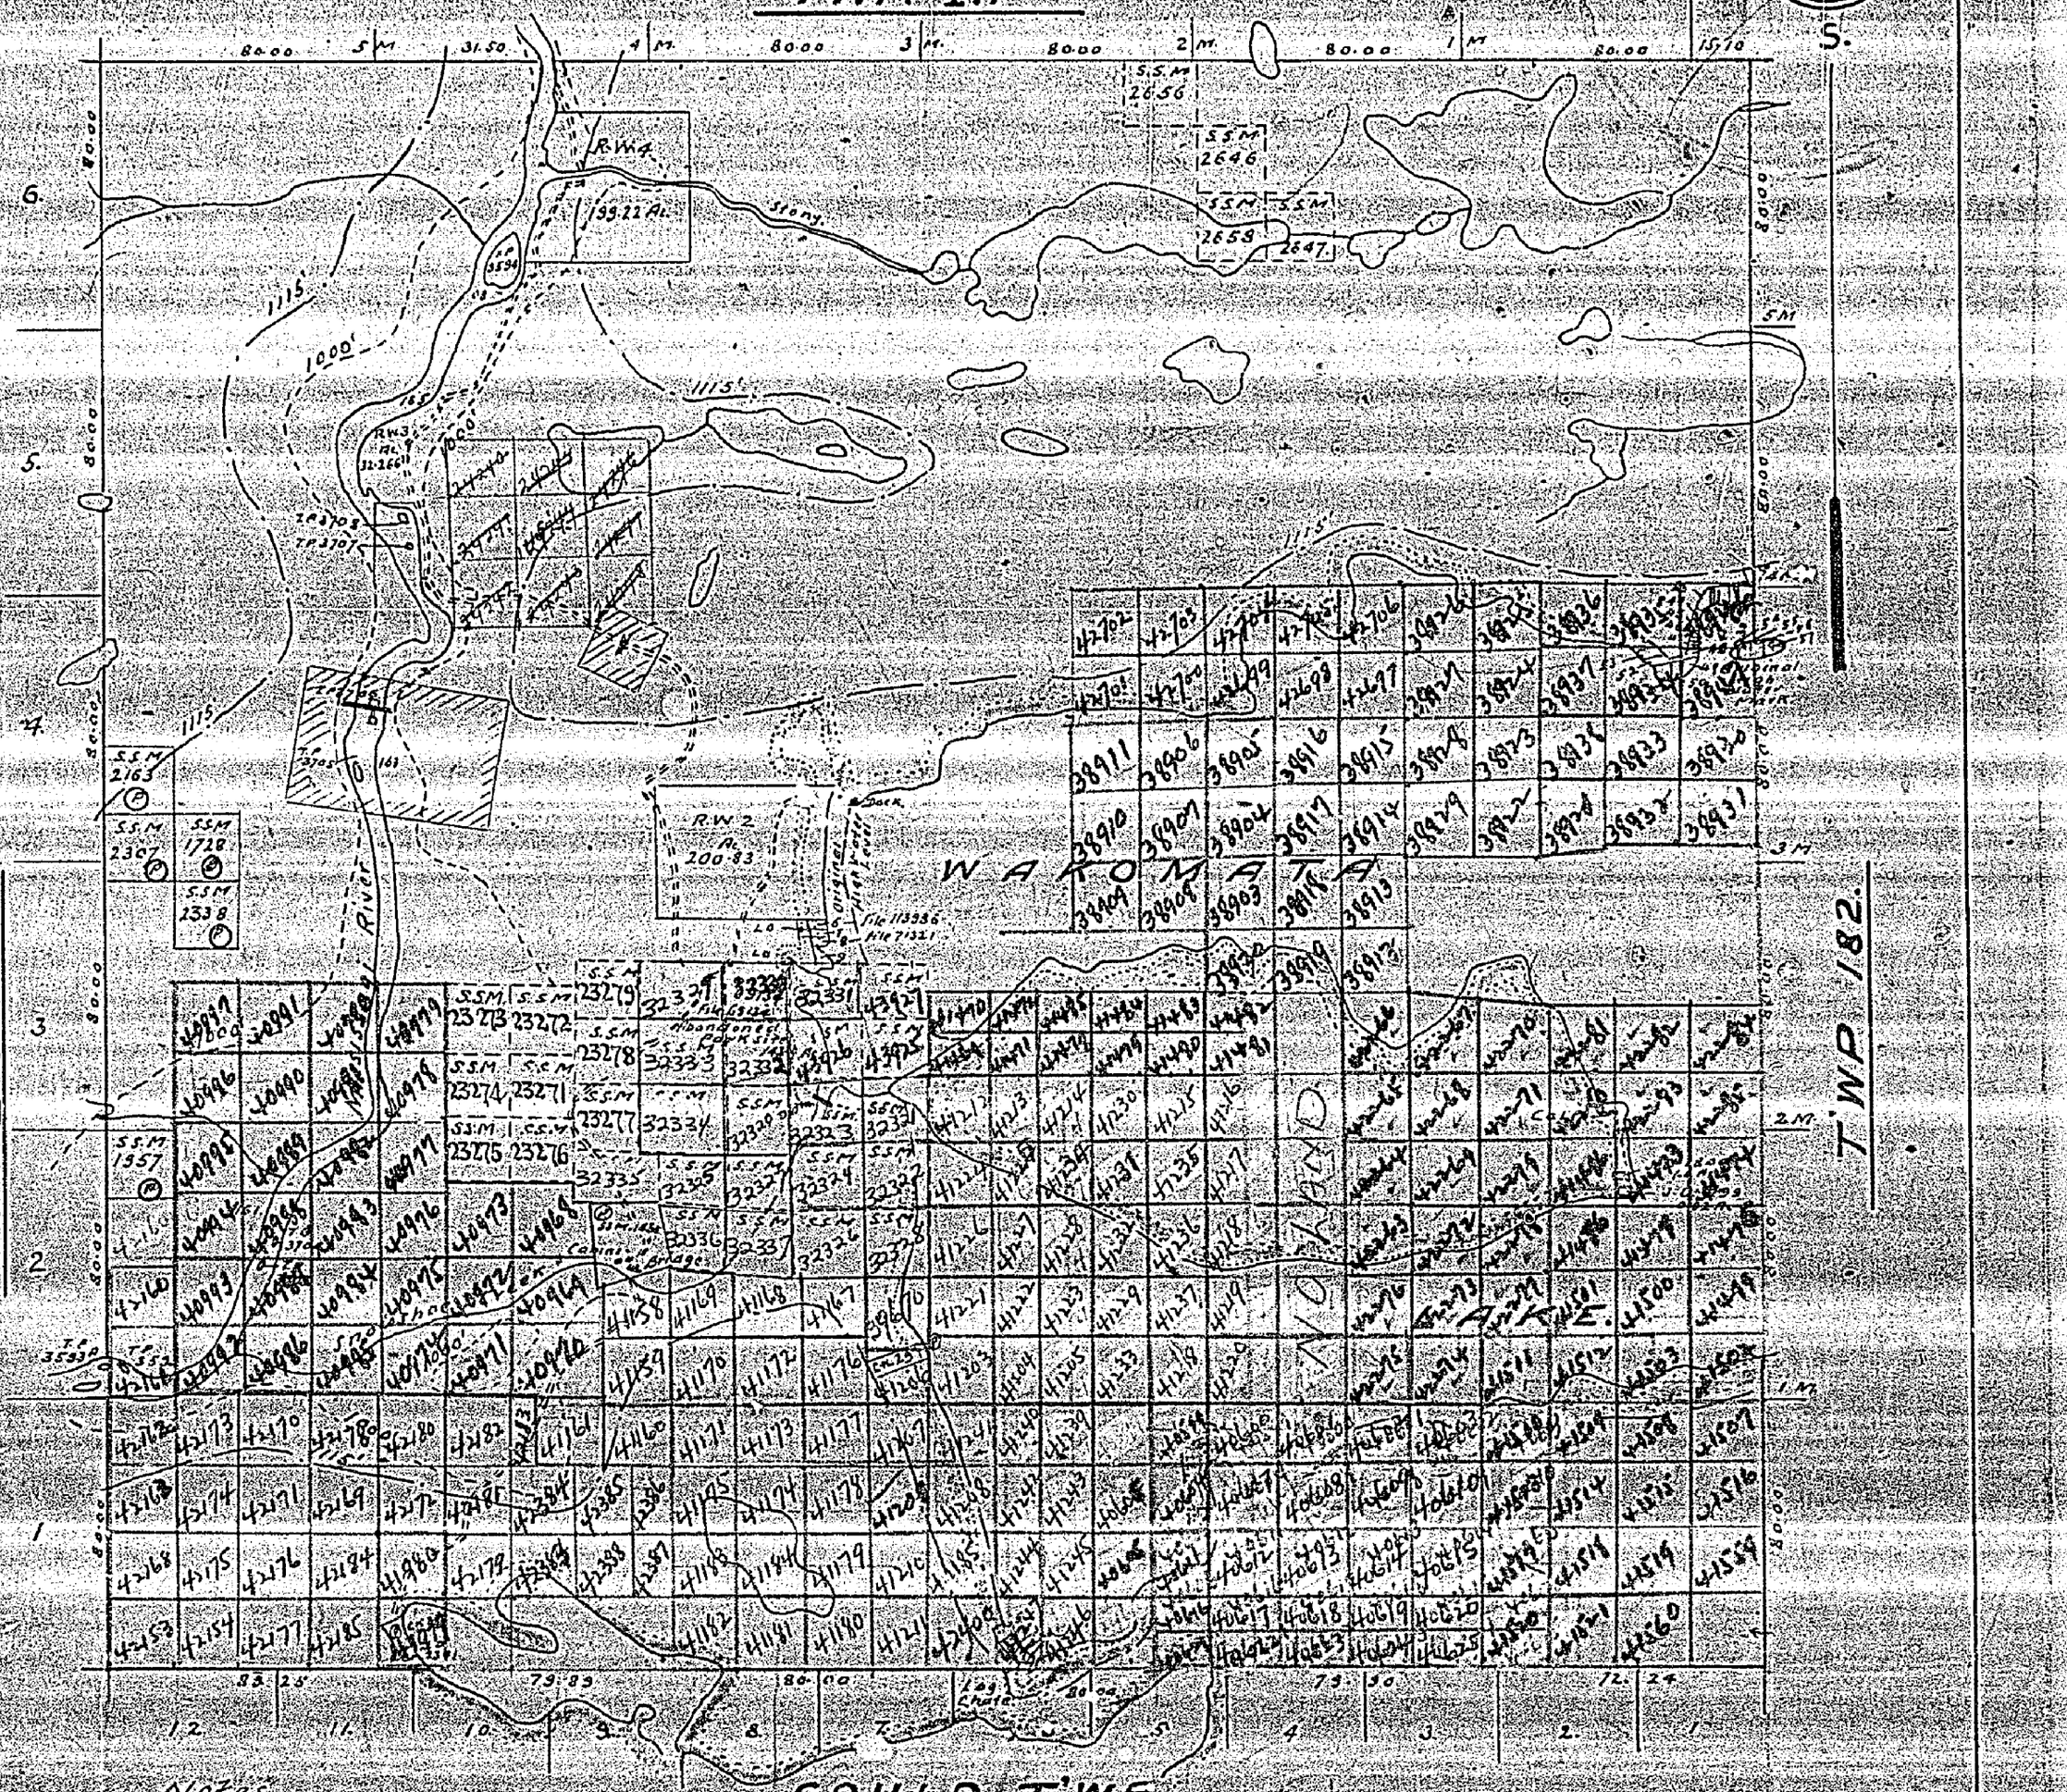
N.
S.
E.
W.
Riz. North.
80.00
31.50
15.70
5 M.
4 M.
3 M.
2 M.
1 M.
5.5 M.
26.56
2646
2658
2647
R.W.4.
199.22 Ac.
Stony
3594
1115'
1000'
R.W.3.
Ac. 32.26
R.W.2.
Ac. 200.83
Spur
Spur
Spur

1615

OFFICE MAP


PLAN OF TWP. 188. (CASSON)

SAULT STE. MARIE MINING DIVISION.

DISTRICT OF ALGOMA.

Scale, 40 chains to an inch. M. 1615

TWP. 1.F

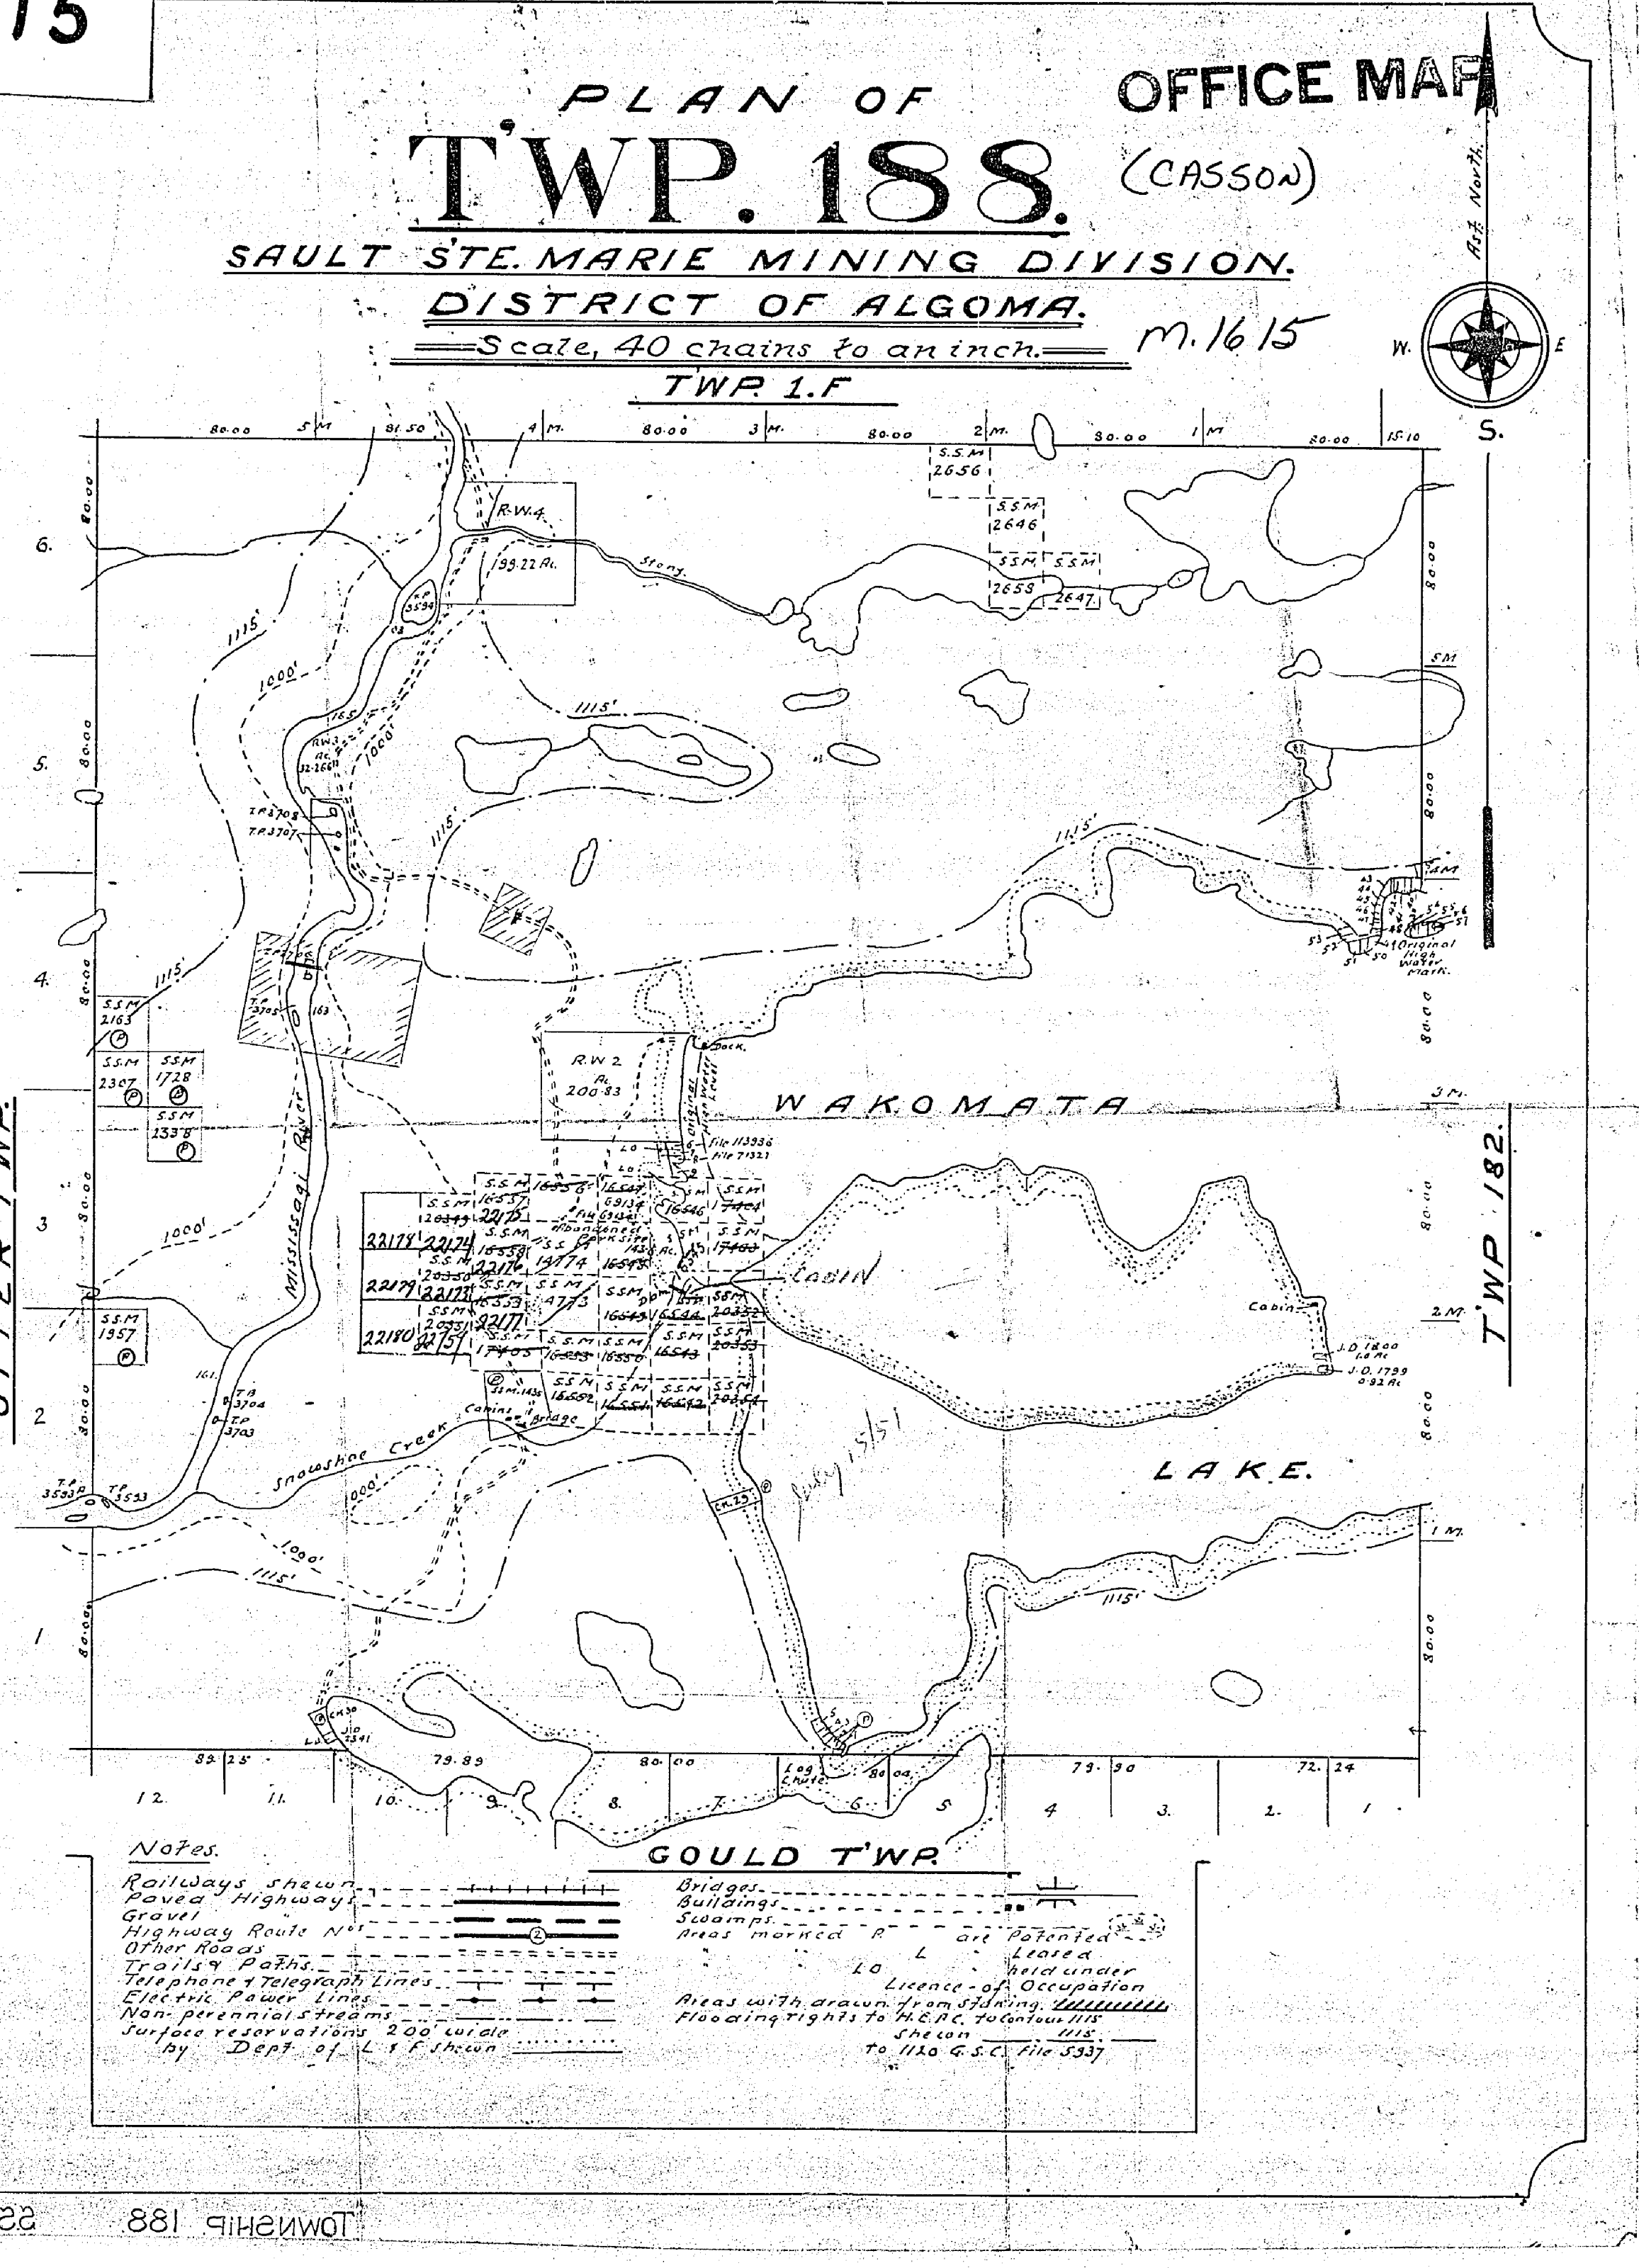

Notes.

Railways shewn
Paved Highways
Gravel "
Highway Route Nos (2)
Other Roads
Trails & Paths.
Telephone & Telegraph Lines
Electric Power Lines
Non-perennial streams
Surface reservations 200' wide by Dept. of L. & F. shewn

Bridges
Buildings
Swamps.
Areas marked P. are Patented
" " L. " Leased
" " LO. " held under Licence of Occupation
Areas with arrows from shoreline. Flooding rights to H.E.P.C. to contour 1115 shewn 1115 to 1120 G.S.C. file 5937

TOWNSHIP 188 SSM.365.


DAGLE TP. M.1379

wagg tp. M.1378

OTTER TWP. - M.1325

JACKSON TP. M.1614

GOULD TWP. - M.455

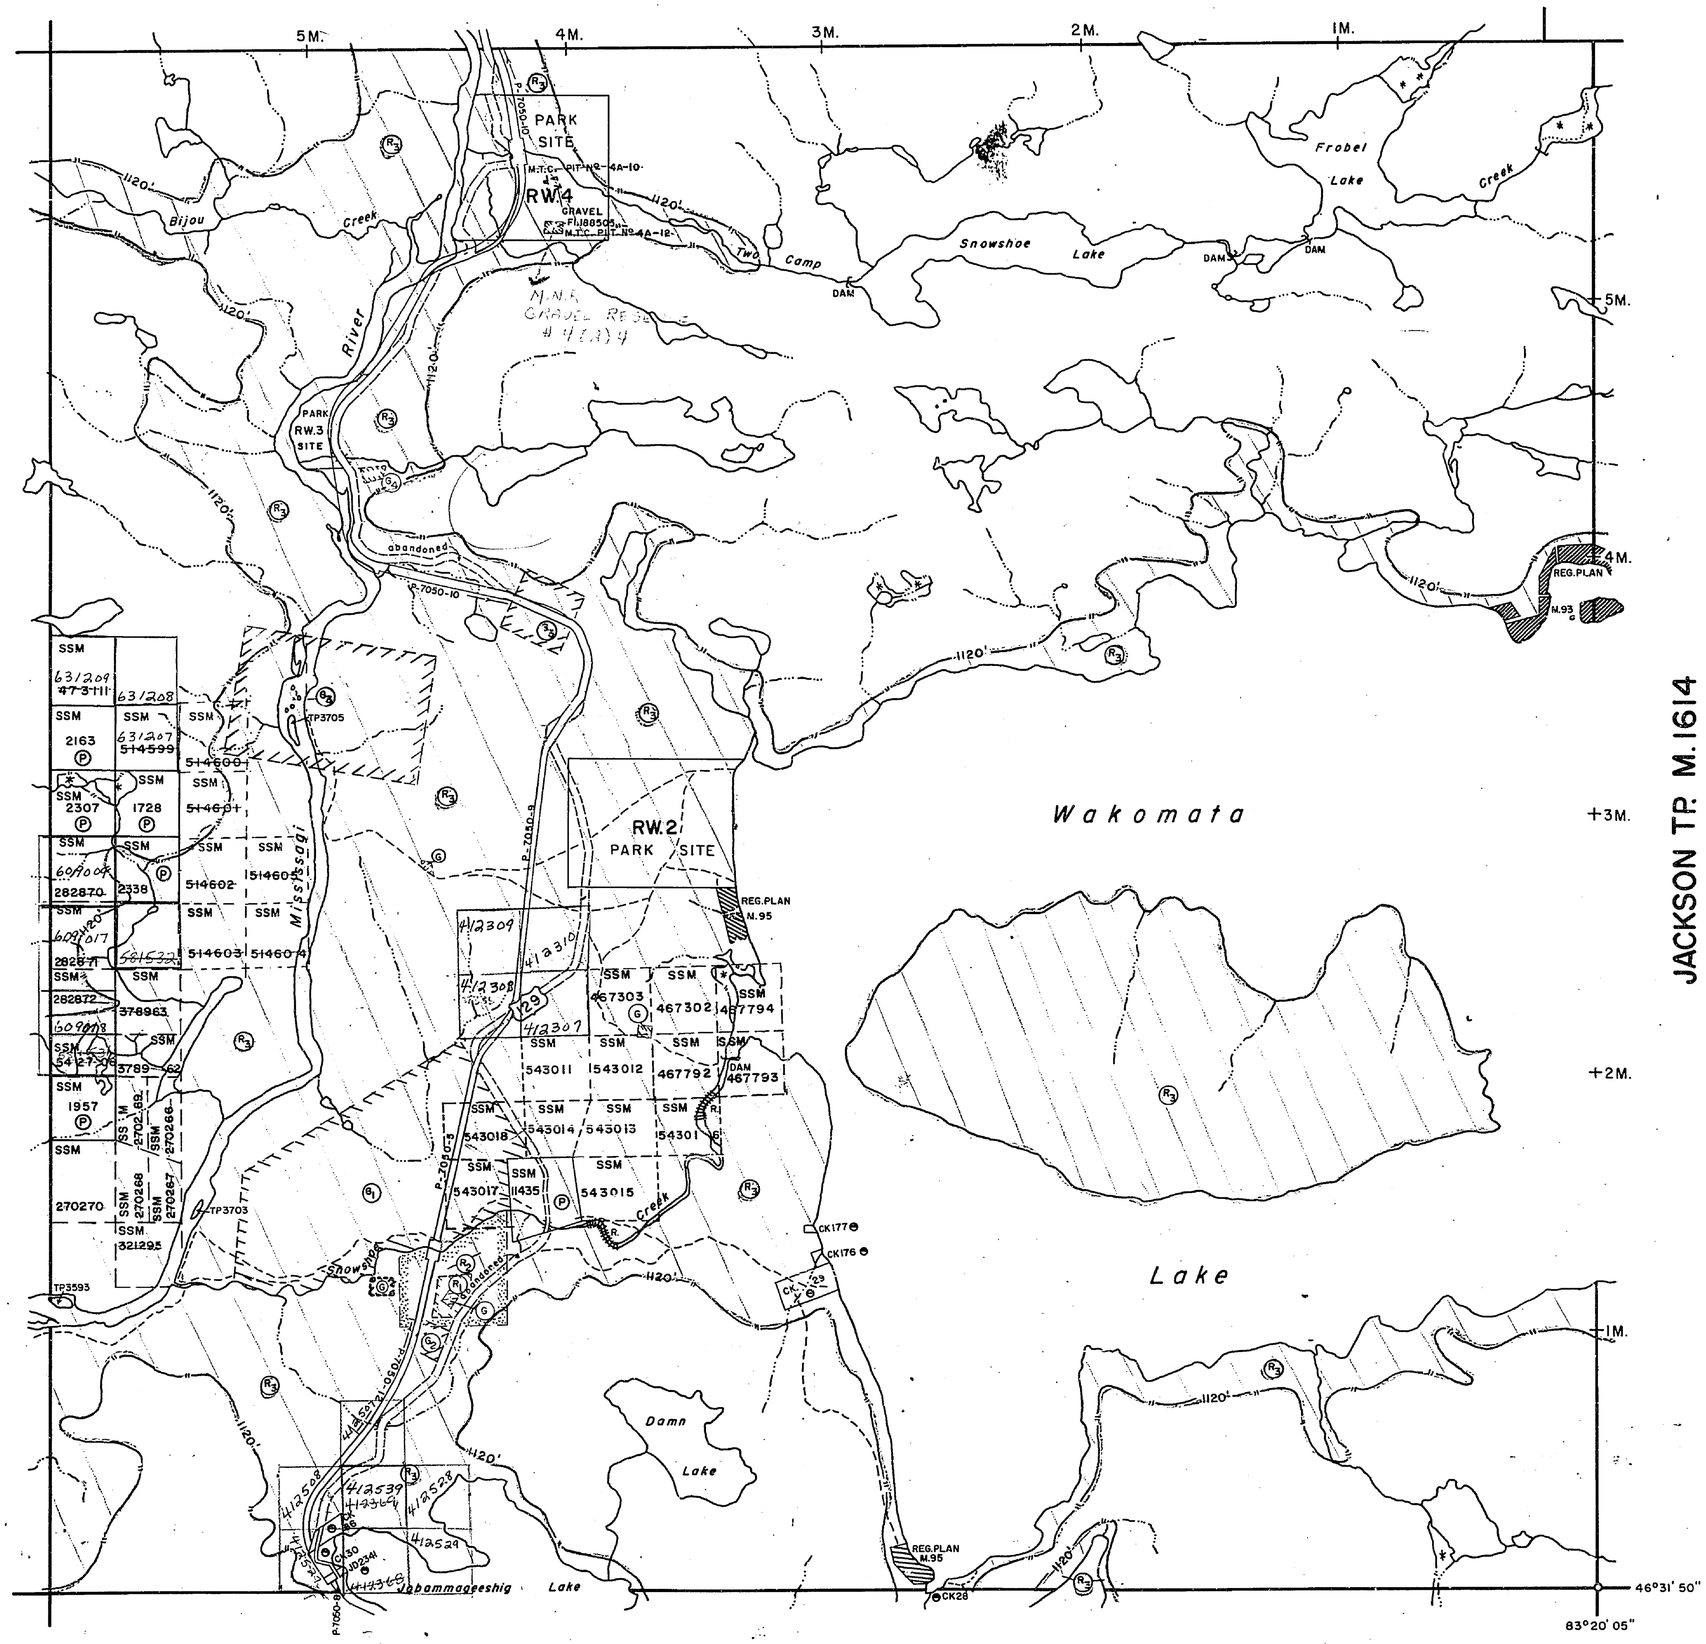

THE TOWNSHIP

CASSON

(Tp. 188)

DISTRICT OF
ALGOMA

SAULT STE. MARIE
MINING DIVISION

SCALE: 1-INCH = 40 CHAINS

LEGEND

PATENTED LAND	(P)
CROWN LAND SALE	C.S.
LEASES	(L)
LOCATED LAND	Loc.
LICENSE OF OCCUPATION	L.O.
MINING RIGHTS ONLY	M.R.O.
SURFACE RIGHTS ONLY	S.R.O.
ROADS	
IMPROVED ROADS	
KING'S HIGHWAYS	
RAILWAYS	
POWER LINES	
MARSH OR MUSKEG	
MINES	
CANCELLED	C.

NOTES

400' surface rights reservation along the shores of all lakes and rivers.

Summer resort locations patented for surface rights only shown thus (P)

Flooding rights

-on Mississagi River reserved to contour 903'
W.P.L.A. Nº 35 F. 5937 vol.4

OTHER AREAS WITHDRAWN FROM STAKING

S.R. - SURFACE RIGHTS M.R.-MINING RIGHTS

	Section	Order Nº	Date	Disposition	File
(R1)	Sec. 43 (R.S.O. '70)	W.1/79 BR	13/6/79	S.R.	
(R2)	Sec. 43 (R.S.O. '70)	W.6/79 BR	1/2/80	S.R.	
(R3)	Sec. 43 (R.S.O. '70)	W.10/80	30/7/80	S.R.	188505
	(Flooding to contour elevation 1120')				

SAND and GRAVEL

(G)	GRAVEL LOCATION
(G1)	M.T.C. PIT Nº 1587
(G2)	M.T.C. PIT Nº 1333
(G3)	GRAVEL File 5937 vol.3
(G4)	M.T.C. PIT Nº 4A-11

PLAN NO. ~~M.1615~~

ONTARIO
MINISTRY OF NATURAL RESOURCES
SURVEYS AND MAPPING BRANCH

G.3266

b.k.

10 8 6 4 2 1 2 4 6 8

DAGLE TP. M.1379

WAGG TP. M.1378

OTTER TWP. - M.1325

JACKSON TP. M.1614

GOULD TWP. - M.455

THE TOWNSHIP

CASSON

(Tp. 188)

DISTRICT OF
ALGOMA

SAULT STE. MARIE
MINING DIVISION

SCALE: 1-INCH = 40 CHAINS

LEGEND

PATENTED LAND	(P)
CROWN LAND SALE	C.S.
LEASES	(L)
LOCATED LAND	Loc.
LICENSE OF OCCUPATION	L.O.
MINING RIGHTS ONLY	M.R.O.
SURFACE RIGHTS ONLY	S.R.O.
ROADS	
IMPROVED ROADS	
KING'S HIGHWAYS	
RAILWAYS	
POWER LINES	
MARSH OR MUSKEG	
MINES	
CANCELLED	C.

NOTES

400' surface rights reservation along the shores of all lakes and rivers.

Summer resort locations patented for surface rights only shown thus (P)

Flooding rights

- on Mississagi River reserved to contour 903'
W.P.L.A. N° 35 F. 5937 vol.4

OTHER AREAS WITHDRAWN FROM STAKING

S.R. - SURFACE RIGHTS M.R.-MINING RIGHTS

Section	Order N°	Date	Disposition	File
4/3				

(1) NOTE: Surface Rights Only withdrawn from (Sec. 43) prospecting, staking out, sale or lease under Order # W. 1179 - BLIND RIVER - dated June 13/79.

(2) NOTE: SURFACE RIGHTS ONLY RE-OPENED FOR PROSPECTING, STAKING OUT, SALE OR LEASE ON 4 HECTARES UNDER ORDER # O. 2/79 - Blind River - July 10/79 (Sec. 43)

SAND & GRAVEL

(g1) M.T.C. PIT N° 1587
(g2) M.T.C. PIT N° 1333
(g3) GRAVEL File 5937 vol.3
(g4) GRAVEL File: 156507

(3) NOTE: Surface Rights Only withdrawn from prospecting, staking out, sale or lease on 27 hectares under ORDER # W-1179 - BLIND RIVER - Feb 1/80

DATE OF ISSUE AUG 21 1979

PLAN NO. ~~M.1615~~

ONTARIO
MINISTRY OF NATURAL RESOURCES
SURVEYS AND MAPPING BRANCH

G. 3266

b.k.

G-3588



Ministry of Natural Resources
Ontario

Ministry of Northern Development and Mines

INDEX TO LAND DISPOSITION

PLAN
G-3266

TOWNSHIP
CASSON

M.N.R. ADMINISTRATIVE DISTRICT
BLIND RIVER

MINING DIVISION
SAULT STE. MARIE

LAND TITLES/REGISTRY DIVISION
ALGOMA

Scale 1:20 000

Metres 0 1000 2000 Metres

feet 1000 0 1000 2000 3000 4000 5000 6000 7000 8000 9000 10000 feet

Contour Interval 10 Metres

SYMBOLS

- Boundary
  - Township, Meridian, Baseline
  - Road allowance; surveyed
  - shoreline
  - Lot/Concession; surveyed
  - unsurveyed
  - Parcel; surveyed
  - unsurveyed
  - Right-of-way; road
  - railway
  - utility
  - Reservation
  - Cliff, Pile
  - Contour (20)
  - Interpolated
  - Approximate
  - Depression
  - Control point (horizontal)
  - Flooded
  - Mine head frame
  - Pipeline (above ground)
  - Railway; single track
  - double track
  - abandoned
  - Road; highway, county, township
  - access
  - trail, bush
  - Shoreline (original)
  - Transmission line
  - Wooded area

AREAS WITHDRAWN FROM DISPOSITION

MRO - Mining Rights Only
SRO - Surface Rights Only
M & S - Mining and Surface Rights

Description	Order No.	Date	Disposition	File
(M) SEC. 36(R.S.O. 1980)	W6/798R	13/6/79	SRO	
(M) SEC. 36(R.S.O. 1980)	W6/798R	1/2/80	SRO	
(M) SEC. 36(R.S.O. 1980)	W10/80	30/7/80	SRO	188505

(FLOODING TO CONTOUR ELEVATION 1·26')

DISPOSITION OF CROWN LANDS

- Patent
  - Surface & Mining Rights
  - Surface Rights Only
  - Mining Rights Only
- Lease
  - Surface & Mining Rights
  - Surface Rights Only
  - Mining Rights Only
- Licence of Occupation
- Order-in-Council (OC)
- Cancelled (C)
- Reservation (R)
- Sand & Gravel (S)

DATE OF ISSUE

NOV 17 1997

PROVINCIAL RECORDING OFFICE - SUDBURY

NOTES

FLOODING RIGHTS ON MISSISSAGI RIVER RESERVED TO CONTOUR 903' W.P.L.A. Nº 35 FILE 5937 vol. 4

The 1980 Magnetic Bearing Approx. 7°W Annual Change Decreasing

THE INFORMATION THAT APPEARS ON THIS MAP HAS BEEN COMPILED FROM VARIOUS SOURCES, AND ACCURACY IS NOT GUARANTEED. THOSE WISHING TO STAKE MINING CLAIMS SHOULD CONSULT WITH THE MINING RECORDER, MINISTRY OF NORTHERN DEVELOPMENT AND MINES, FOR ADDITIONAL INFORMATION ON THE STATUS OF THE LANDS SHOWN HEREON.

Base mapping and land disposition drafting by Surveys and Mapping Branch, Ministry of Natural Resources

The disposition of land, location of lot fabric and parcel boundaries on this index was compiled for administrative purposes only.

CASSON TWP
G-3588