1861

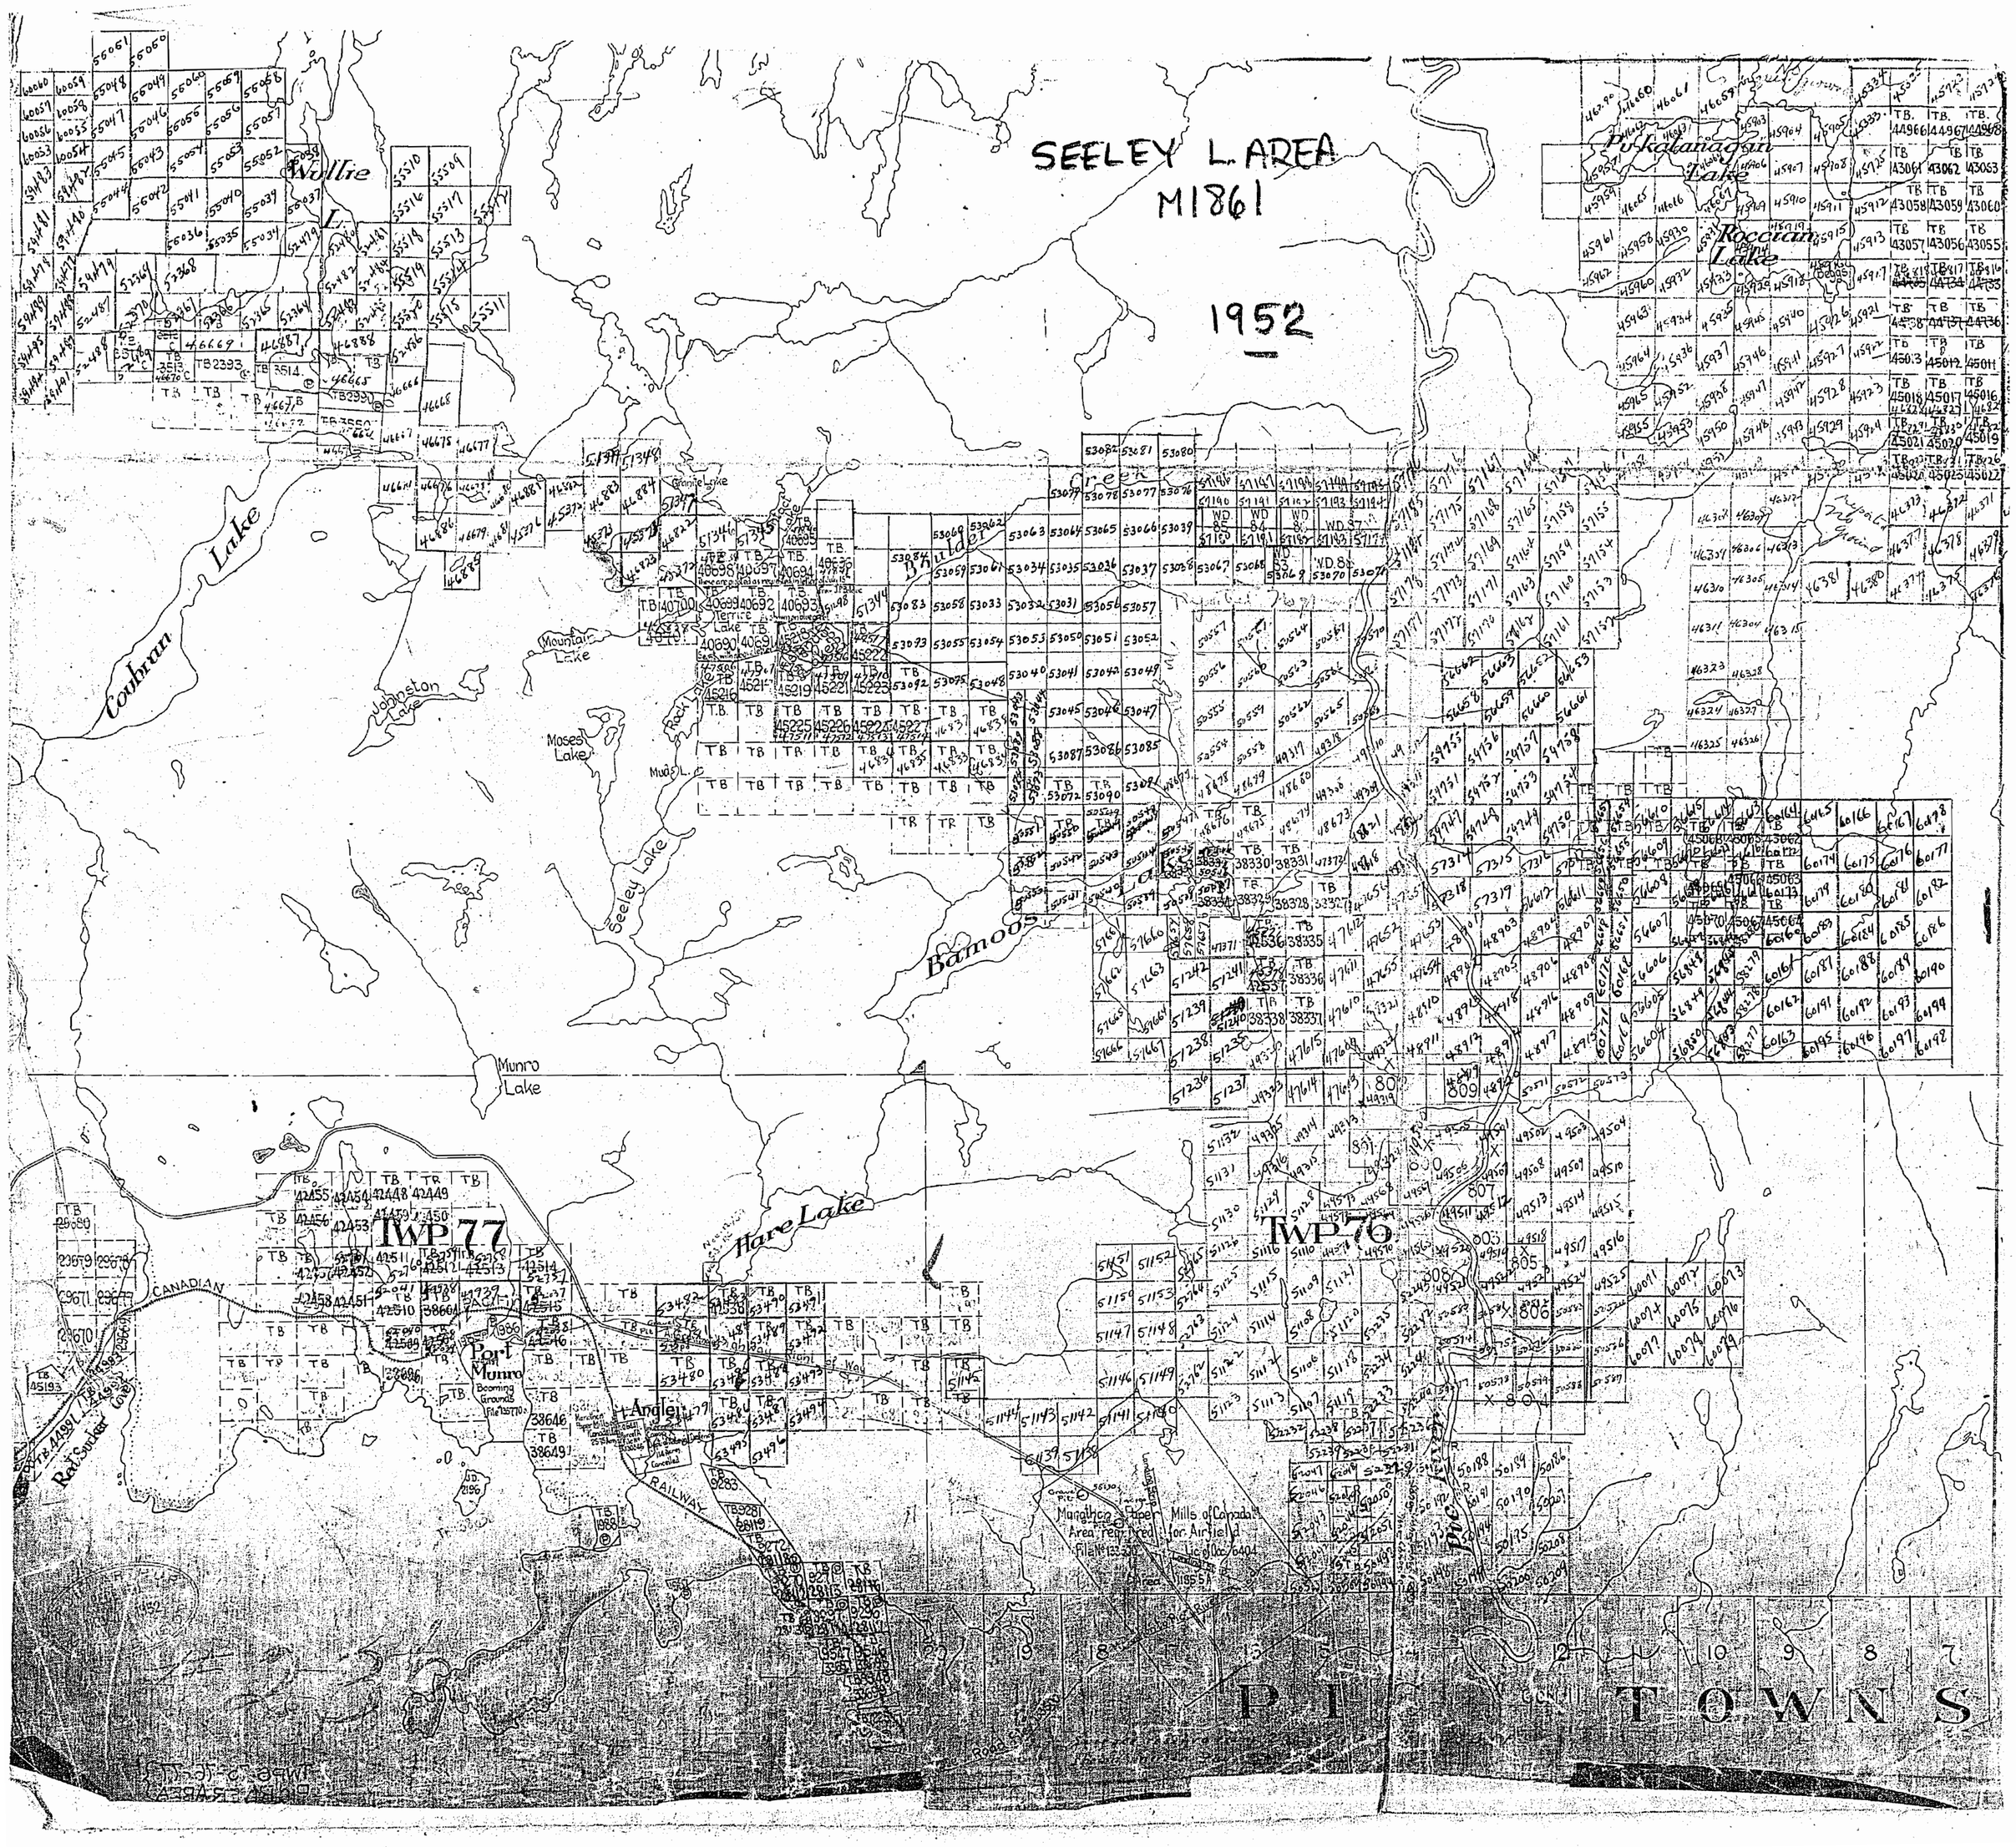
SEELEY L. AREA
M1861
1952
Wollie L.
Pukatanagan Lake
Roccian Lake
Coubran Lake
Johnston Lake
Mountain Lake
Moses Lake
Seeley Lake
Bamoos Lake
Munro Lake
Hare Lake
TWP 77
TWP 76
Port Munro
Angler
CANADIAN
RAILWAY
Manathon Paper Mills of Canada
Area required for Airfield
Lic of Occ 6404
Area 1155 A
PI TOWNS

1861

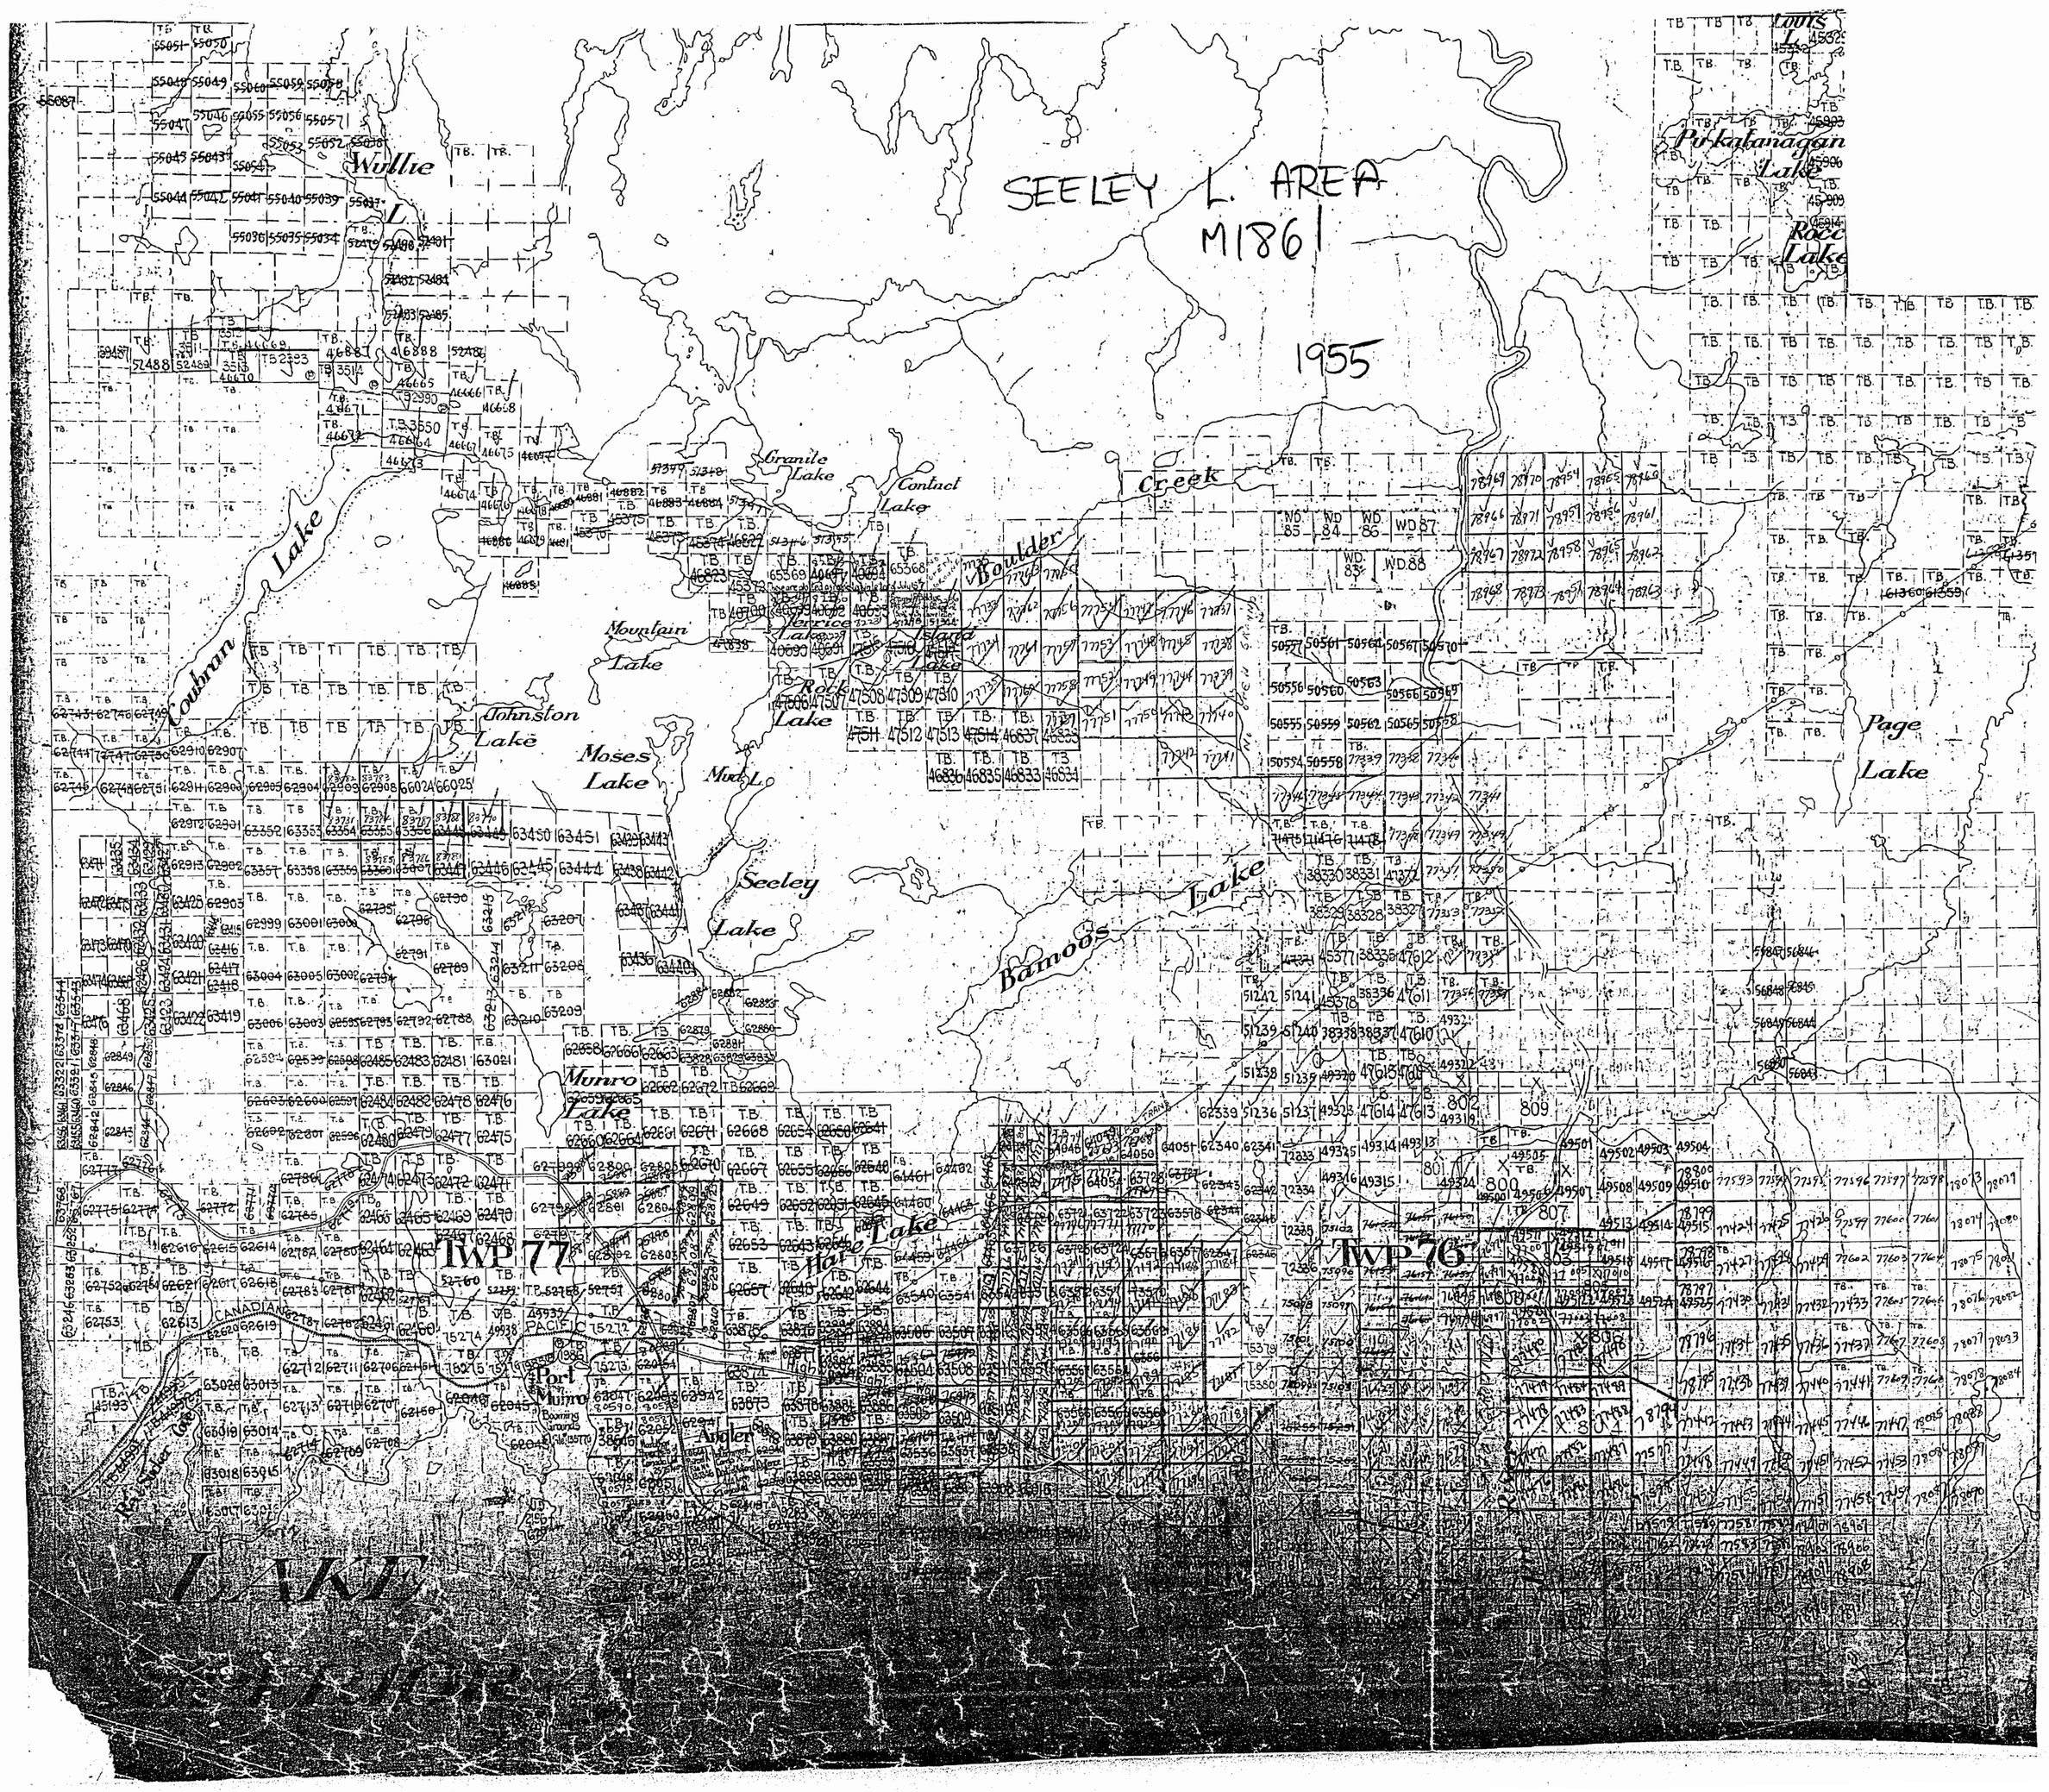
SEELEY L. AREA
M1861
1955
Wullie L.
Coubran Lake
Granite Lake
Contact Lake
Boulder Creek
Mountain Lake
Johnston Lake
Moses Lake
Mud L.
Seeley Lake
Bamoos Lake
Munro Lake
Hare Lake
Page Lake
Pukatanagan Lake
Rock Lake
Port Munro
Angler
TWP 77
TWP 76
CANADIAN PACIFIC
LAKE

1861

AREA OF

SEELEY LAKE

DISTRICT OF
THUNDER BAY

PORT ARTHUR
MINING DIVISION

SCALE: 1-INCH = 40 CHAINS

LEGEND

PATENTED LAND	Ⓟ
CROWN LAND SALE	C.S.
LEASES	Ⓛ
LOCATED LAND	Loc.
LICENSE OF OCCUPATION	L.O.
MINING RIGHTS ONLY	M.R.O.
SURFACE RIGHTS ONLY	S.R.O.
ROADS	
IMPROVED ROADS	
KING'S HIGHWAYS	
RAILWAYS	
POWER LINES	
MARSH OR MUSKEG	
MINES	⚒
CANCELLED	C.

NOTES

400' Reserve around all Lakes & Rivers to Dept. of Lands & Forests.

Land under water in Lake Superior withdrawn from staking by Order In Council dated April 30, 1912

Limits of Marathon Improvement District shown thus: File: 129282 Vol. I

1957

PLAN NO. M. 1861

DEPARTMENT OF MINES
— ONTARIO —

1861

Martinet Lake Area (M-2488)

Twp. 79 (M-1923)

Twp. 78 (M-1921)

Lorna Lake Area (M-2487)

AREA OF

SEELEY LAKE

DISTRICT OF
THUNDER BAY

PORT ARTHUR
MINING DIVISION

SCALE: 1-INCH = 40 CHAINS

LEGEND

PATENTED LAND	(P)
CROWN LAND SALE	C.S.
LEASES	(L)
LOCATED LAND	Loc.
LICENSE OF OCCUPATION	L.O.
MINING RIGHTS ONLY	M.R.O.
SURFACE RIGHTS ONLY	S.R.O.
ROADS	
IMPROVED ROADS	
KING'S HIGHWAYS	
RAILWAYS	
POWER LINES	
MARSH OR MUSKEG	
MINES	
CANCELLED	C.

NOTES

400' Reserve around all Lakes & Rivers to Dept. of Lands & Forests.

Land under water in Lake Superior withdrawn from staking by Order In Council dated April 30, 1912.

Limits of Marathon Improvement District shown thus: File: 129282, Vol. I.

PLAN NO. M. 1861

DEPARTMENT OF MINES
— ONTARIO —

1861

Martinet Lake Area (M-2488)

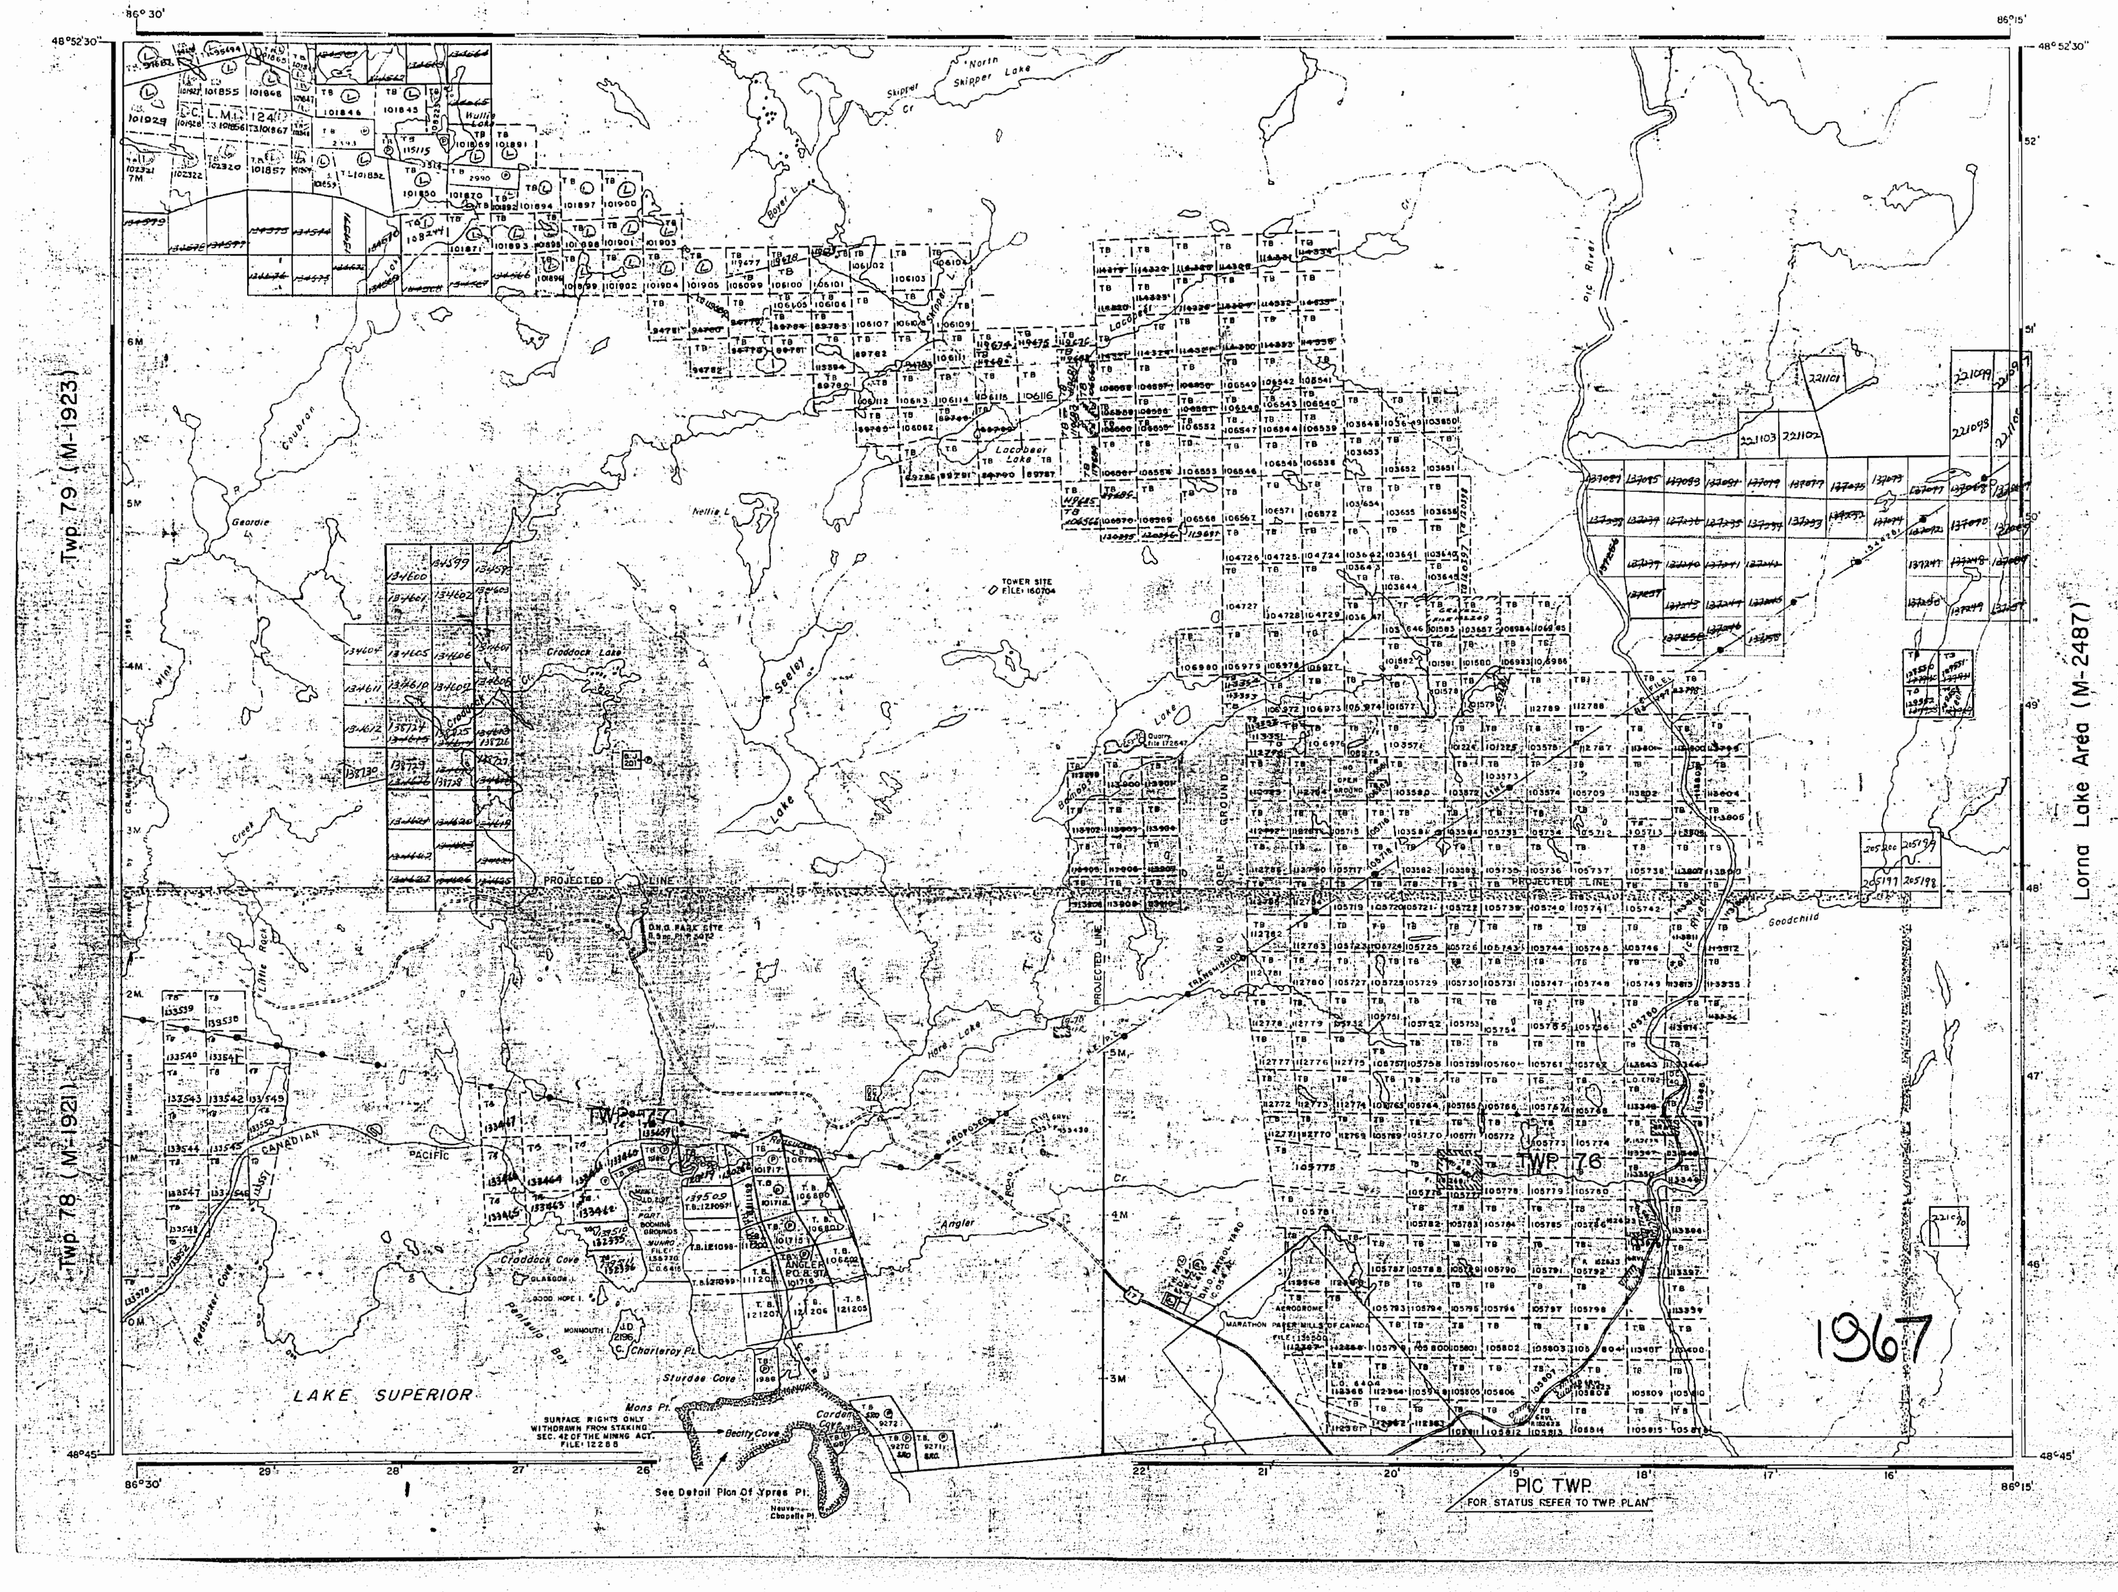

AREA OF

SEELEY LAKE

DISTRICT OF
THUNDER BAY

PORT ARTHUR
MINING DIVISION

SCALE: 1-INCH = 40 CHAINS

LEGEND

PATENTED LAND	P.
CROWN LAND SALE	C.S.
LEASES	L
LOCATED LAND	Loc.
LICENSE OF OCCUPATION	L.O.
MINING RIGHTS ONLY	M.R.O.
SURFACE RIGHTS ONLY	S.R.O.
ROADS	
IMPROVED ROADS	
KING'S HIGHWAYS	
RAILWAYS	
POWER LINES	
MARSH OR MUSKEG	
MINES	
CANCELLED	

NOTES

400' SURFACE RIGHTS RESERVATION AROUND ALL LAKES AND RIVERS.

Land under water in Lake Superior withdrawn from staking by Order In Council dated April 30, 1912.

LIMITS OF MARATHON IMPROVEMENT DISTRICT SHOWN THUS: FILE: 129282

DETAIL PLAN OF YPRES POINT.

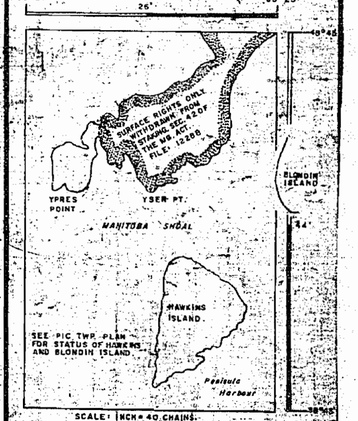

PLAN NO. M. 1861

DEPARTMENT OF MINES
— ONTARIO —

1861

Martinet Lake Area (M-2488)

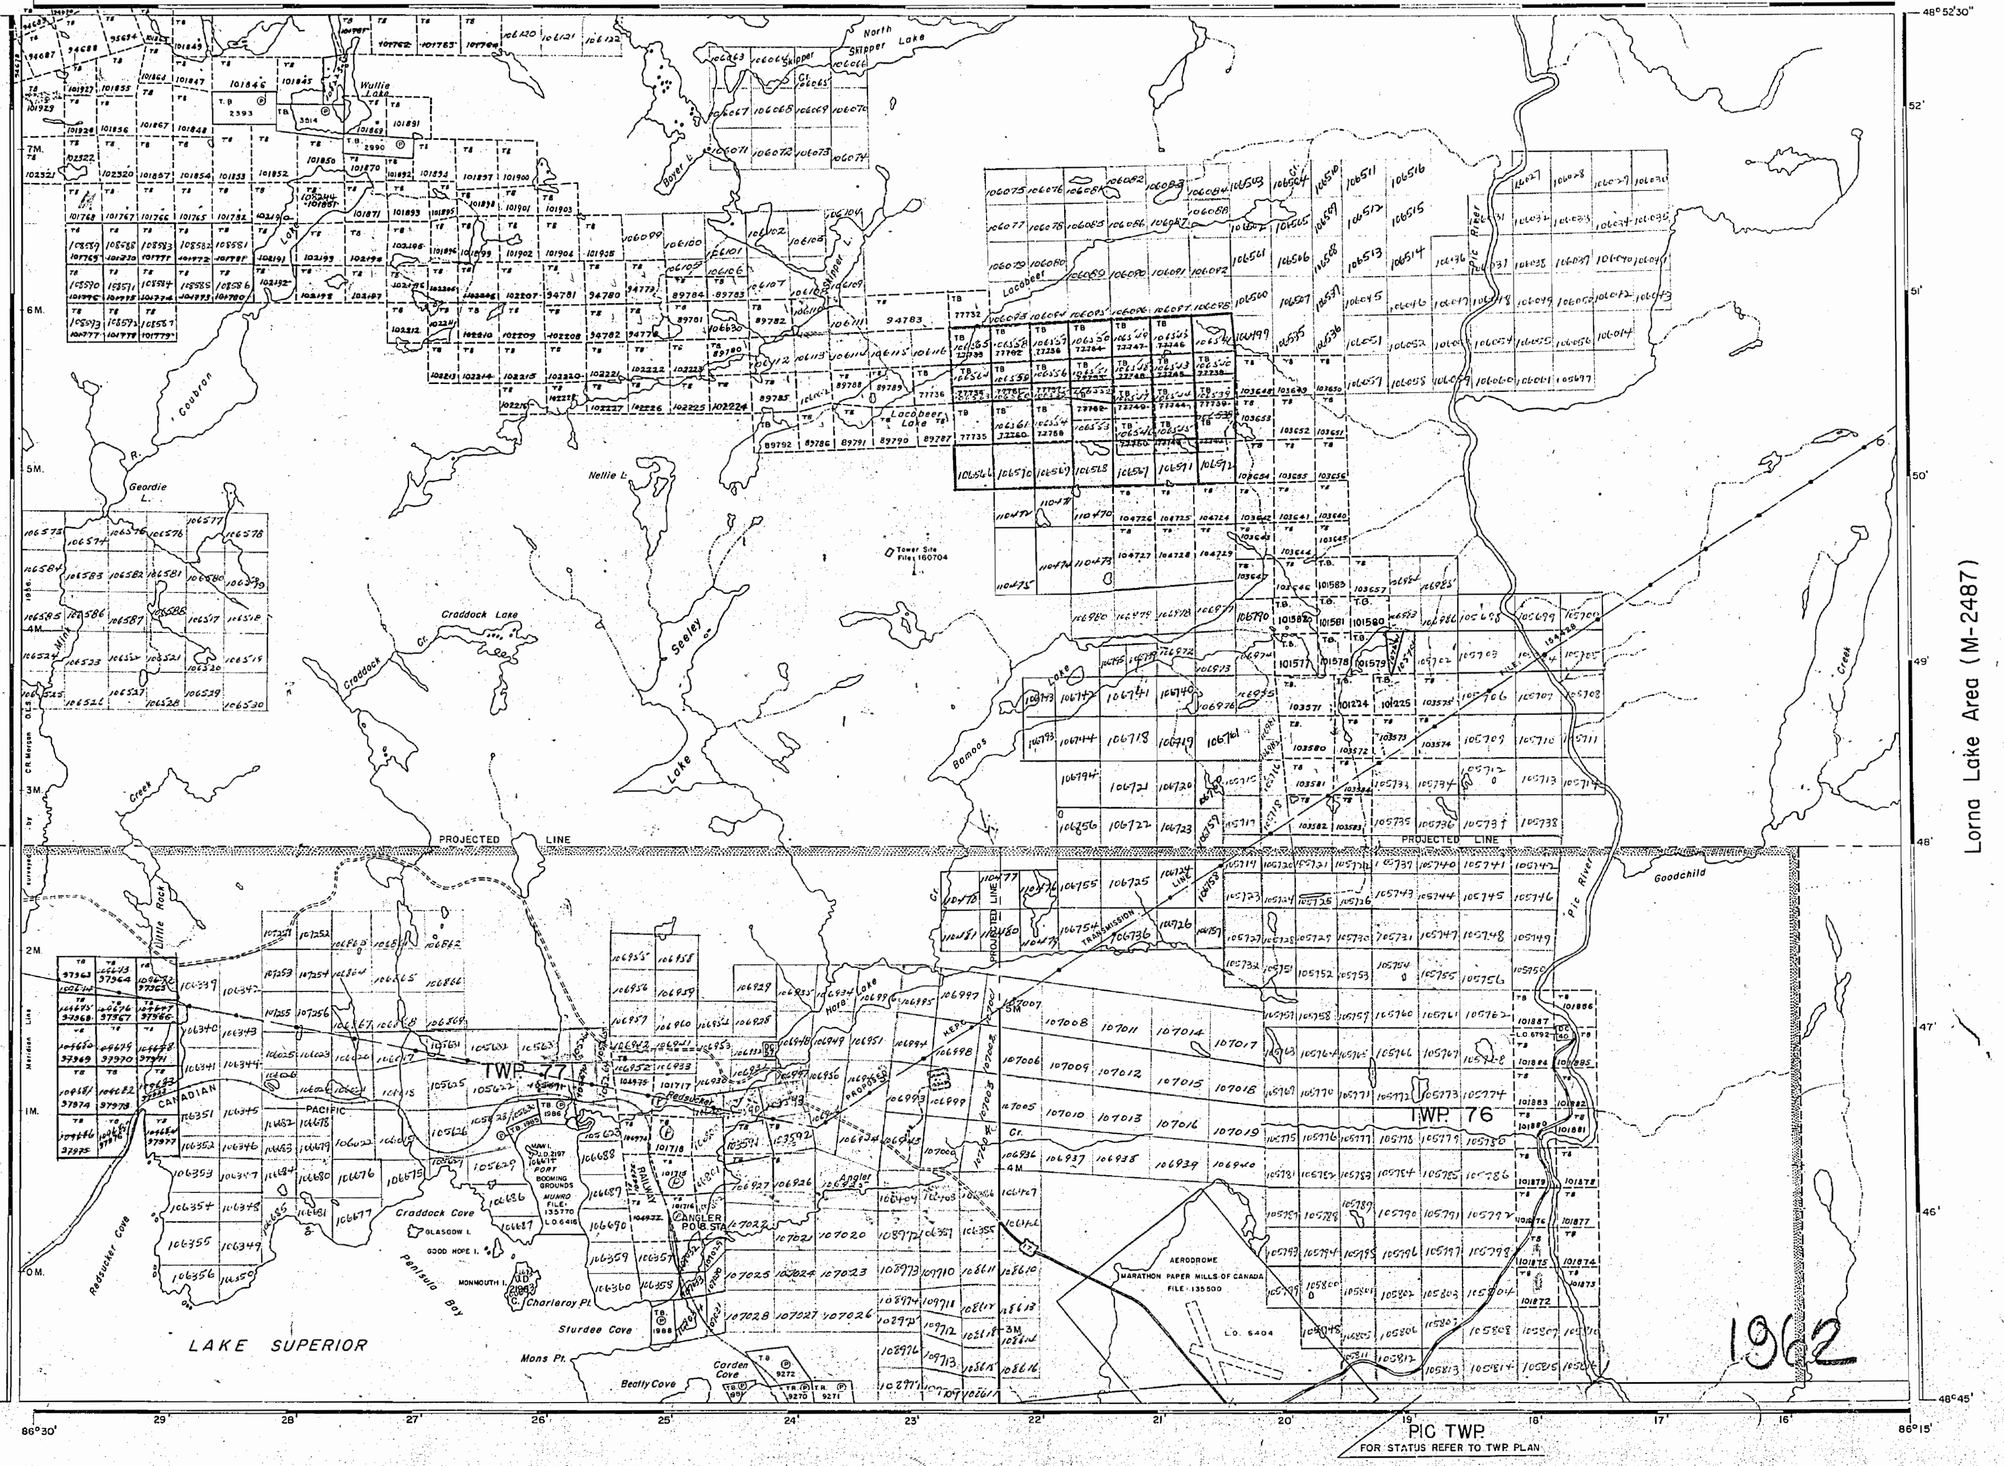

AREA OF

SEELEY LAKE

DISTRICT OF
THUNDER BAY

PORT ARTHUR
MINING DIVISION

SCALE: 1-INCH = 40 CHAINS

LEGEND

PATENTED LAND	(P)
CROWN LAND SALE	C.S.
LEASES	(L)
LOCATED LAND	Loc.
LICENSE OF OCCUPATION	L.O.
MINING RIGHTS ONLY	M.R.O.
SURFACE RIGHTS ONLY	S.R.O.
ROADS	
IMPROVED ROADS	
KING'S HIGHWAYS	
RAILWAYS	
POWER LINES	
MARSH OR MUSKEG	
MINES	
CANCELLED	C.

NOTES

400' Reserve around all Lakes & Rivers to Dept. of Lands & Forests.

Land under water in Lake Superior withdrawn from staking by Order In Council dated April 30, 1912.

Limits of Marathon Improvement District shown thus: File 129282, Vol. I.

PLAN NO. M. 1861

DEPARTMENT OF MINES
— ONTARIO —

1861

Martinet Lake Area (M-2488)

Twp. 79 (M-1923)

Twp. 78 (M-1921)

Lorna Lake Area (M-2487)

AREA OF

SEELEY LAKE

DISTRICT OF
THUNDER BAY

PORT ARTHUR
MINING DIVISION

SCALE: 1-INCH 40 CHAINS

LEGEND

PATENTED LAND	(P)
CROWN LAND SALE	C.S.
LEASES	(L)
LOCATED LAND	Loc.
LICENSE OF OCCUPATION	L.O.
MINING RIGHTS ONLY	M.R.O.
SURFACE RIGHTS ONLY	S.R.O.
ROADS	
IMPROVED ROADS	
KING'S HIGHWAYS	
RAILWAYS	
POWER LINES	
MARSH OR MUSKEG	
MINES	
CANCELLED	C

NOTES

400' SURFACE RIGHTS RESERVATION AROUND ALL LAKES AND RIVERS.

Land under water in Lake Superior withdrawn from staking by Order In Council dated April 30, 1912

LIMITS OF MARATHON IMPROVEMENT DISTRICT SHOWN THUS [dashed] FILE 129282

DETAIL PLAN OF YPRES POINT

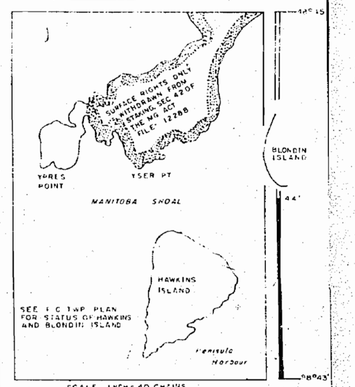

PORT ARTHUR
RECEIVED
JUN 18 1965
MINING DIVISION

PLAN NO. M. 1861

DEPARTMENT OF MINES
— ONTARIO —

1965

1861

Martinet Lake Area (M-2488)

Twp. 79 (M-1923)

Twp. 78 (M-1921)

Lorna Lake Area (M-2487)

PROJECTED LINE

TWP. 77

TWP. 76

PIC TWP
FOR STATUS REFER TO TWP PLAN

LAKE SUPERIOR

CANADIAN PACIFIC

Craddock Lake

Craddock Cr.

Seeley Lake

Lacobeer Lake

Georgie L.

Hollie L.

Hollie Lake

North Skipper Lake

Skipper Cr.

Skipper L.

O'Connor L.

Hore Lake

Hore Cr.

Angler

Craddock Cove

Peninsula Bay

Sturdee Cove

Mons Pt.

Beatty Cove

Cordova Cove

Goodchild

Monmouth I.

C. Charleroy Pt.

Nieuve Chapelle Pt.

Glasgow L.

Good Hope I.

Little Rapids

Reluctant Cove







1861

Martinet Lake Area (M-2488)

Twp. 79 (M-1923)

Twp. 78 (M-1921)

Long Lake Area (M-2487)

TWP. 77

TWP. 76

PROJECTED LINE

LAKE SUPERIOR

PIC TWP.
FOR STATUS REFER TO TWP. PLAN

SURFACE RIGHTS ONLY WITHDRAWN FROM STAKING SEC. 42 OF THE MINING ACT. FILE: 12288

See Detail Plan Of Tyres Pt.

1971

AREA OF

SEELEY LAKE

DISTRICT OF
THUNDER BAY

THUNDER BAY
MINING DIVISION

SCALE: 1 INCH = 40 CHAINS

LEGEND

PATENTED LAND	(P)
CROWN LAND SALE	C.S.
LEASES	(L)
LOCATED LAND	Loc.
LICENSE OF OCCUPATION	L.O.
MINING RIGHTS ONLY	M.R.O.
SURFACE RIGHTS ONLY	S.R.O.
ROADS	
IMPROVED ROADS	
KING'S HIGHWAYS	
RAILWAYS	
POWER LINES	
MARSH OR MUSKEG	
MINES	
CANCELLED	K.C.

NOTES

400' SURFACE RIGHTS RESERVATION AROUND ALL LAKES AND RIVERS

Land under water in Lake Superior withdrawn from staking by Order in Council dated April 30, 1912.

LIMITS OF MARATHON IMPROVEMENT DISTRICT SHOWN THUS ——— FILE: 129282

DETAIL PLAN OF TYRES POINT

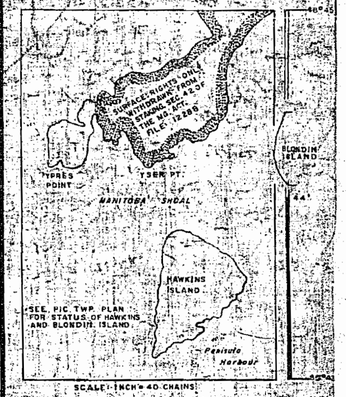

NATIONAL TOPOGRAPHIC SERIES 42 D/16

PLAN NO. M 1861

ONTARIO
DEPARTMENT OF MINES
AND NORTHERN AFFAIRS

1861

Martinet Lake Area (M-2488).

86°30' 86°15' 48°52'30"

Grain Tp - (M-1923)

Coldwell Tp - (M-1921)

Lorna Lake Area (M-2487)

CLM. 123 CLM. 124 7M. 6M. 5M. 4M. 3M. 2M. 1M. 0M.

Wullie Lake Skipper Cr. North Skipper Lake Boyer L. Lacabeer Lake Lacabeer Cr. Pic River Goodchild Cr. Coulron L. Geordie L. Nellie L. Mine Creek Craddock Lake Craddock Cr. Seeley Lake Seeley Cr. Bernoos Lake Hare Lake Angler Cr. Redsucker Cove Peninsula Bay Sturdee Cove Mons Pt. Beatty Cove Garden Cove LAKE SUPERIOR

TOWER SITE FILE: 160704

GRAVEL PIT 15343 LINE 6838C

PROJECTED

D.N.D. PARK SITE B.S.oc.Pl. R 3072

McCOY TP. (TWP. 77)

ONEILL TP. (TWP. 76)

PROJECTED LINE

TRANSMISSION

PROPOSED

CANADIAN PACIFIC

Meridian Line

Redsucker Creek

PORT BOOKING GROUNDS MUNRO FILE: 135770 L.O. 6416

ANGLER P.O. & STA.

GLASGOW I. GOOD HOPE I. MONMOUTH I. J.D. 2196 C. Charleroy Pt.

J.D. 2197

AERODROME MARATHON PAPER MILLS OF CANADA FILE: 133500

MTC PIT 1522

CL. 1095 L.O. 8155 793.96 Ac±

GRAVEL PIT 15283 LINE 6838C

GRAVEL PIT 15282 LINE 6838C

GRAVEL PIT 15283 LINE 6838C

GRAVEL PIT 15284 LINE 6838C

GRAVEL PIT 15430

GRAVEL PIT 15285

T.B. 71 P.C. 1945 SRO 1945 8.05 Ac.

T.B. 580 9272 SRO

T.B. 9270 SRO

T.B. 9271 SRO

SURFACE RIGHTS ONLY WITHDRAWN FROM STAKING SEC. 42 OF THE MINING ACT. (R.S.O. 1960) FILE: 12288

See Detail Plan Of Ypres Pt.

Neuve Chapelle Pt.

PIC TWP. FOR STATUS REFER TO TWP PLAN

→ DO NOT ISSUE ANY QUARRY PERMITS EAST OF THIS LINE CLEAR WITH L. FENWICK. 1975

86°30' 29' 28' 27' 26' 86°15' 22' 21' 20' 19' 18' 17' 16' 48°45' 5M 4M 3M 52' 51' 50' 49' 48' 47' 46'

IPv.k.

AREA OF

SEELEY LAKE

DISTRICT OF THUNDER BAY

THUNDER BAY MINING DIVISION

SCALE: 1-INCH = 40 CHAINS

LEGEND

PATENTED LAND	(P)
CROWN LAND SALE	C.S.
LEASES	(L)
LOCATED LAND	Loc.
LICENSE OF OCCUPATION	L.O.
MINING RIGHTS ONLY	M.R.O.
SURFACE RIGHTS ONLY	S.R.O.
ROADS	
IMPROVED ROADS	
KING'S HIGHWAYS	
RAILWAYS	
POWER LINES	
MARSH OR MUSKEG	
MINES	
CANCELLED	C.

NOTES

400' surface rights reservation along the shores of all lakes and rivers.

Land under water in Lake Superior withdrawn from staking by Order In Council dated April 30, 1912.

LIMITS OF MARATHON IMPROVEMENT DISTRICT SHOWN THUS: FILE: 129282

DETAIL PLAN OF YPRES POINT.

86°27' 26' 86°25' 48°45' 44' 88°43'

SURFACE RIGHTS ONLY WITHDRAWN FROM STAKING UNDER SEC. 42 OF THE MINING ACT. R.S.O. 1960 FILE: 12288

YPRES POINT YSER PT. MANITOBA SHOAL BLONDIN ISLAND HAWKINS ISLAND.

SEE PIC TWP. PLAN FOR STATUS OF HAWKINS AND BLONDIN ISLAND.

SCALE: INCH = 40 CHAINS

DATE OF ISSUE FEB 28 1975

TER

NATIONAL TOPOGRAPHIC SERIES 42 D 16

PLAN NO. M. 1861

ONTARIO

MINISTRY OF NATURAL RESOURCES

SURVEYS AND MAPPING BRANCH

1861

Martinet Lake Area (M-2488)

Grain Tp - (M-1923)

Coldwell Tp - (M-1921)

Lorna Lake Area (M-2487)

66° 30'

86° 15'

48° 52' 30"

48° 45'

McCOY TP.

(TWP. 77)

O'NEILL TP.

(TWP. 76)

PIC TWP.

FOR STATUS REFER TO TWP. PLAN

LAKE SUPERIOR

PROJECTED LINE

PROPOSED

CANADIAN PACIFIC

TRANSMISSION

Wullie Lake

Skipper Lake

North Skipper Lake

Skipper L.

Lacobeer Lake

Lacobeer

Pic River

Nellie L.

Seeley Lake

Graddock Lake

Graddock Cr.

Hare Lake

Angler

Goodchild

Coubran R.

Geordie L.

Minx Creek

Redsucker Cove

Peninsula Bay

Croddock Cove

Sturdee Cove

Mons Pt.

Beatty Cove

Gordon Cove

Charleroy Pt.

Neuve Chapelle Pt.

Bamoos

Boivin L.

TOWER SITE FILE: 160704

DHO PARK SITE R.Soc Pl P 3072

GRAVEL 1937 FILE: 155182

GRAVEL FILE: 153430

GRAVEL FILE: 152825

GRAVEL FILE: 152822

QUARRY FILE: 172647

SURFACE RIGHTS ONLY WITHDRAWN FROM STAKING SEC. 42 OF THE MINING ACT. R.S.O. 1980 FILE: 12288

See Detail Plan Of Ypres Pt.

AERODROME

MARATHON PAPER MILLS OF CANADA FILE: 133500

CL. 1095

L.O. 8185

793.96 Ac ±

M.T.C. PIT 1522

CL. 123

CLM. 124

6M.

5M.

4M.

3M.

2M.

1M.

0M.

1977

AREA OF

SEELEY LAKE

DISTRICT OF THUNDER BAY

THUNDER BAY MINING DIVISION

SCALE: 1-INCH = 40 CHAINS

LEGEND

PATENTED LAND	(P)
CROWN LAND SALE	C.S.
LEASES	(L)
LOCATED LAND	Loc.
LICENSE OF OCCUPATION	L.O.
MINING RIGHTS ONLY	M.R.O.
SURFACE RIGHTS ONLY	S.R.O.
ROADS	
IMPROVED ROADS	
KING'S HIGHWAYS	
RAILWAYS	
POWER LINES	
MARSH OR MUSKEG	
MINES	
CANCELLED	C.

NOTES

400' surface rights reservation along the shores of all lakes and rivers.

Land under water in Lake Superior withdrawn from staking by Order In Council dated April 30, 1912.

LIMITS OF MARATHON IMPROVEMENT DISTRICT SHOWN THUS: FILE: 129282

DETAIL PLAN OF YPRES POINT

86° 27' 26' 86° 25'

SURFACE RIGHTS ONLY WITHDRAWN FROM STAKING UNDER SEC. 42 OF THE MINING ACT. R.S.O. 1980 FILE: 12288

YPRES POINT

YSER PT.

MANITOBA SHOAL

HAWKINS ISLAND

Peninsula Harbour

SEE PIC TWP. PLAN FOR STATUS OF HAWKINS AND BLONDIN ISLAND.

SCALE: 1 INCH = 40 CHAINS

TERRACE BAY DISTRICT

NATIONAL TOPOGRAPHIC SERIES 42 D

PLAN NO. M. 1861

March 21, 1977 ONTARIO

MINISTRY OF NATURAL RESOUR

SURVEYS AND MAPPING BRANCH

JP.v.k.

1861

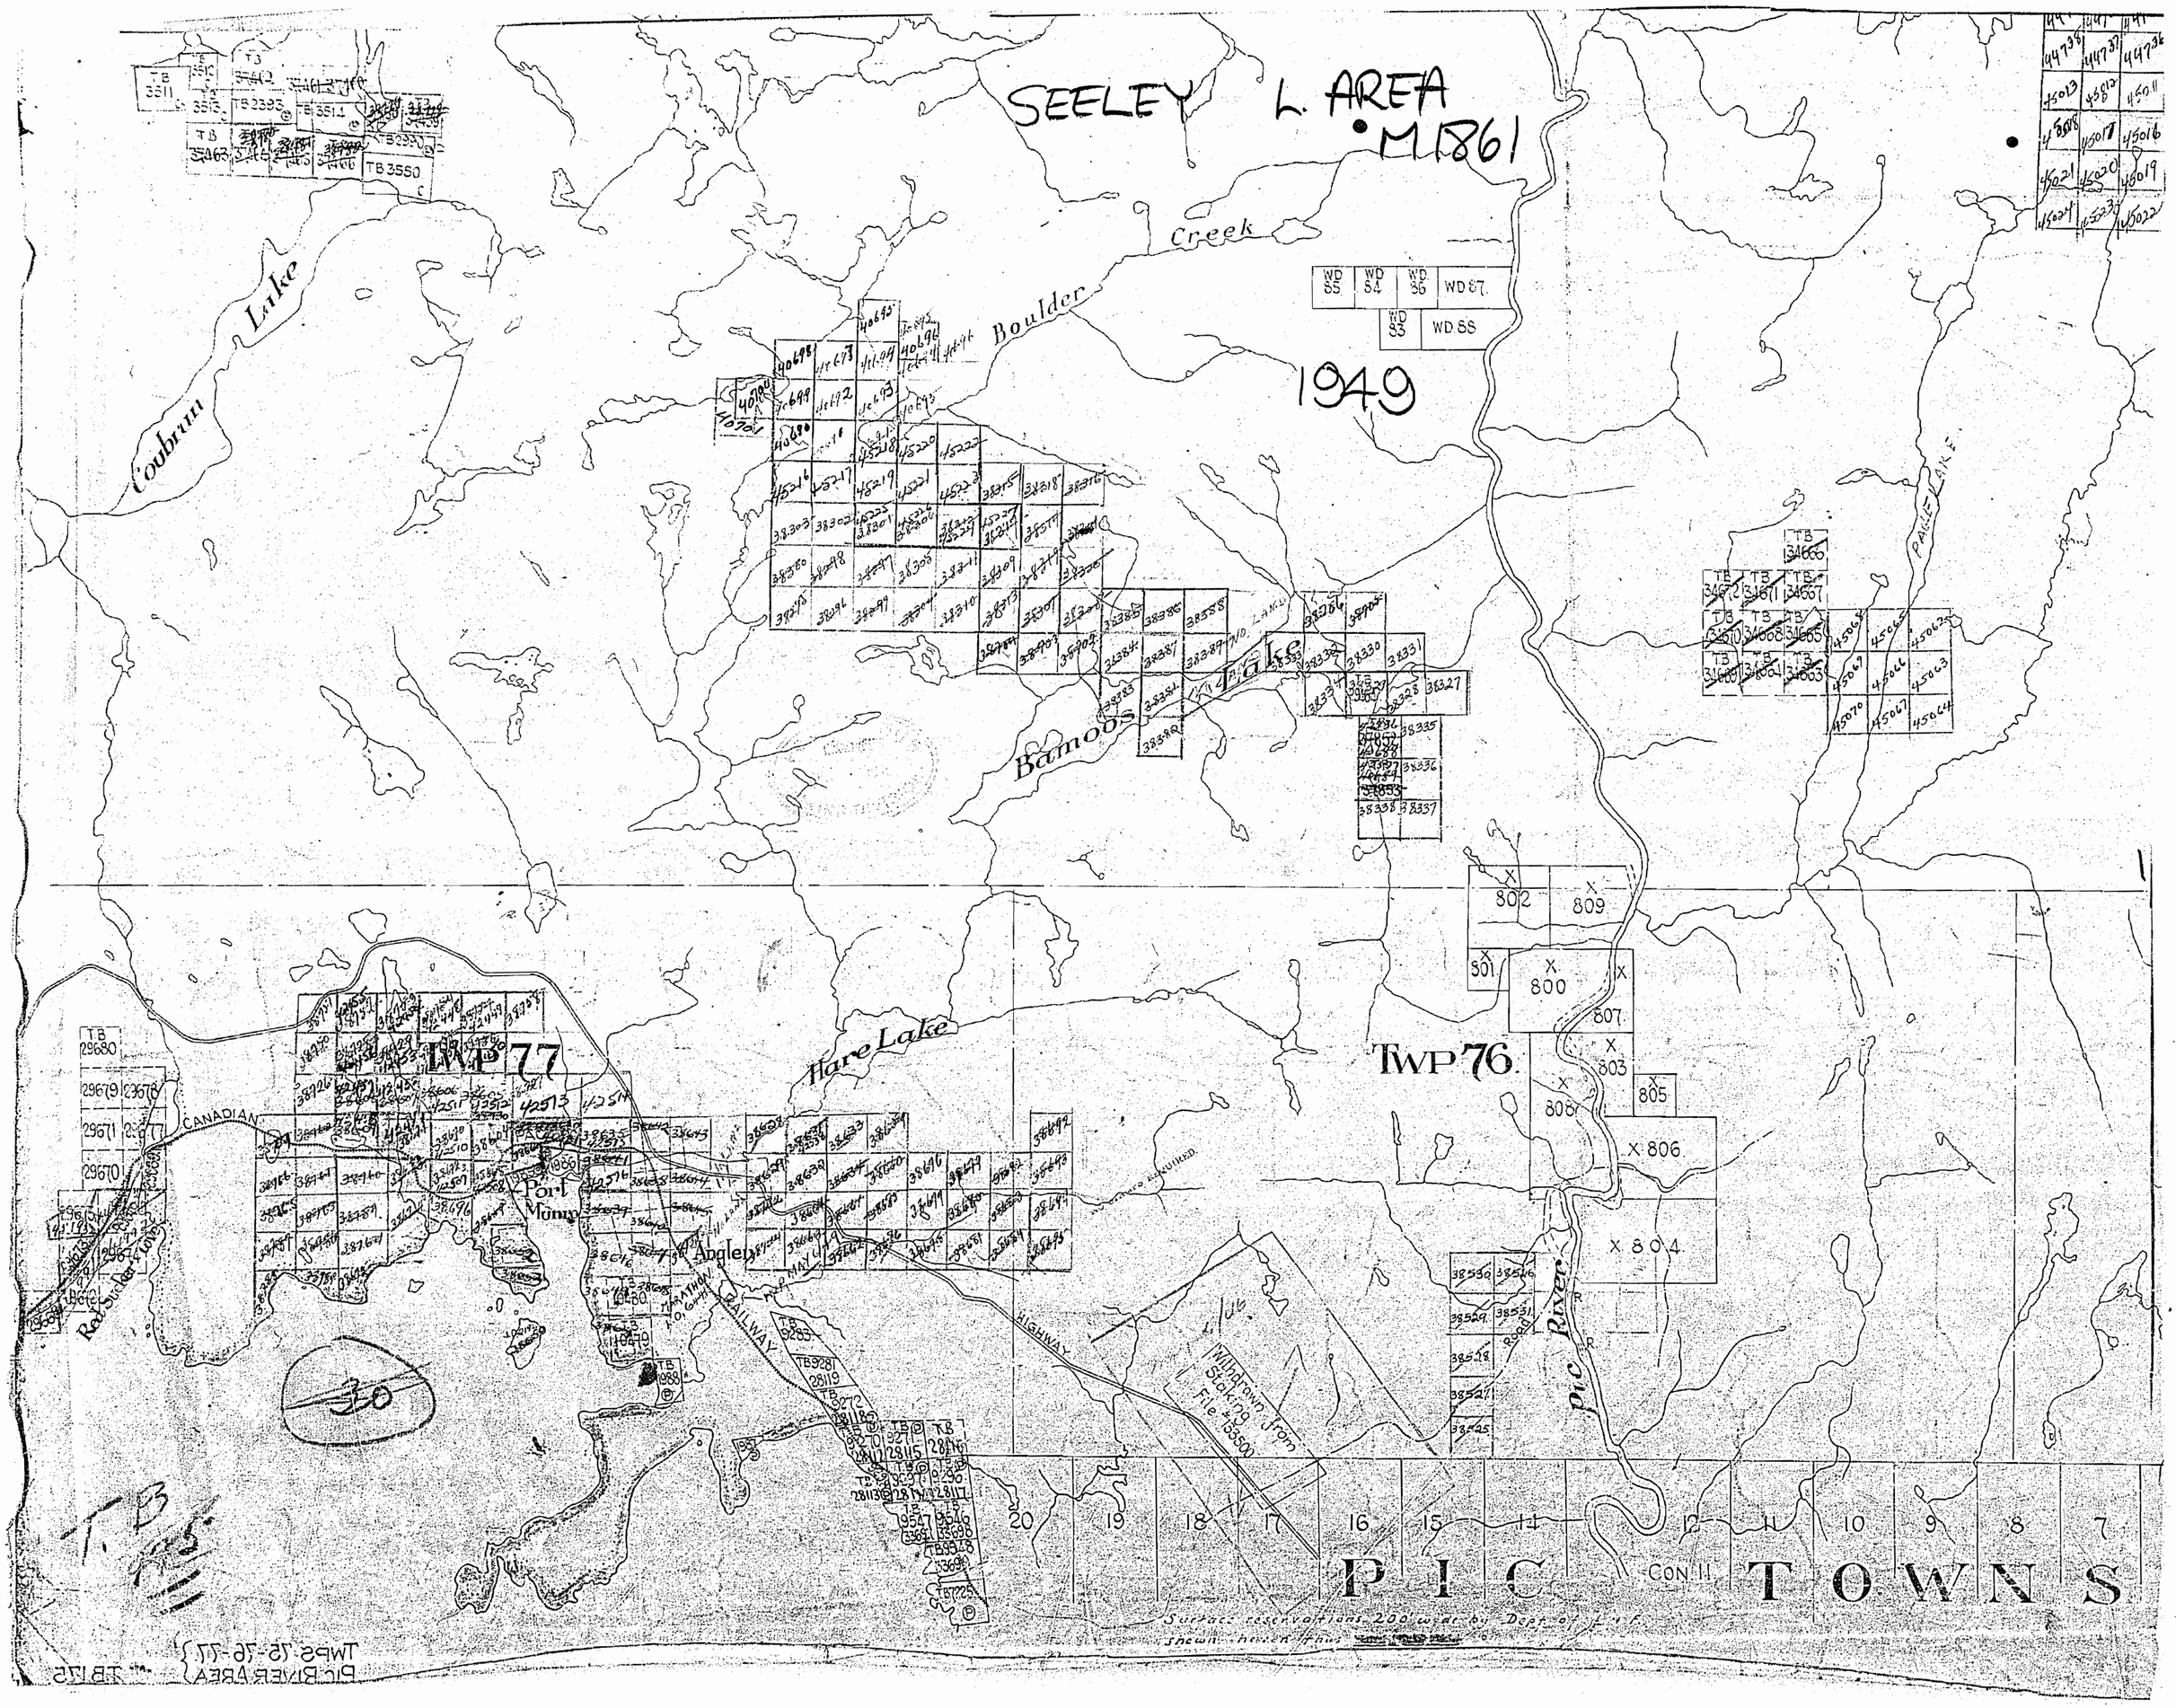
SEELEY L. AREA
M1861
1949
Boulder Creek
Coubrun Lake
Bamoos Lake
Hare Lake
Pic River
TWP 77
TWP 76
Port Munro
Angler
CANADIAN
RAILWAY
HIGHWAY
Withdrawn from Staking File #133500
PIC TOWNS
CON 11
Surface reservations 200' wide by Dept of L & F
shown herein thus
TWPS 75-76-77
PIC RIVER AREA
TB 175

Martinet Lake Area (M-2488)

Grain Tp - (M-1923)

Coldwell Tp - (M-1921)

Lorna Lake Area (M-2487)

AREA OF

SEELEY LAKE

DISTRICT OF
THUNDER BAY

THUNDER BAY
MINING DIVISION

SCALE: 1-INCH = 40 CHAINS

LEGEND

PATENTED LAND	(P)
CROWN LAND SALE	C.S.
LEASES	(L)
LOCATED LAND	Loc.
LICENSE OF OCCUPATION	L.O.
MINING RIGHTS ONLY	M.R.O.
SURFACE RIGHTS ONLY	S.R.O.
ROADS	
IMPROVED ROADS	
KING'S HIGHWAY	
RAILWAYS	
POWER LINES	
MARSH OR MUSKEG	
MINES	
CANCELLED	C.

THUNDER BAY DISTRICT
RECEIVED
JUL 14 1981

NOTES

400' surface rights reservation along the shores of all lakes and rivers.

Land under water in Lake Superior withdrawn from staking by Order in Council dated April 30, 1912.

LIMITS OF MARATHON IMPROVEMENT DISTRICT SHOWN THUS: FILE: 129282

DETAIL PLAN OF YPRES POINT

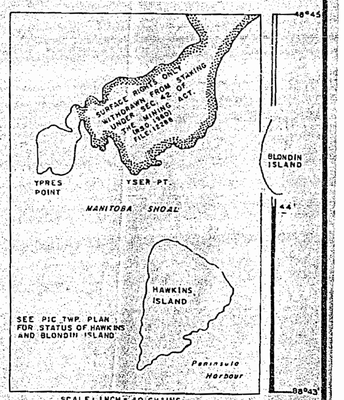

SCALE: 1 INCH = 40 CHAINS

S.R.& M.R. WITHDRAWN W.A.C.R. 43/81 Pic. Twp. LANDROLL

G 613

TERRACE BAY DIST. MAY 30/79
NATIONAL TOPOGRAPHIC SERIES 42 D 16

PLAN NO. M. 1861

ONTARIO
MINISTRY OF NATURAL RESOURCES
SURVEYS AND MAPPING BRANCH

MARTINET LAKE G-601

GRAIN TWP. FOR STATUS REFER TO G-628

COLDWELL TWP.

McCOY TWP.

O'NEILL TWP.

PIC TWP. FOR STATUS REFER TO G-630

LORNA LAKE G-598

WULLIE LAKE

COUBRAN LAKE

NORTH SKIPPER LAKE

SKIPPER LAKE

BUYER LAKE

Skipper Creek

Ladder Creek

LACOBEER LAKE

GEORDIE LAKE

NELLIE LAKE

SEELEY LAKE

BILL LAKE

BAMOOS LAKE

CRADDOCK LAKE

Craddock Creek

Little Redsucker Creek

Redsucker Creek

HARE LAKE

Transmission Line

PROJECTED LINE OF MARATHON IMPROVEMENT DISTRICT File 129282 5/11/1943

D.K.O. PARK SITE 11.9 ACRES D.R.O. PLAN P-3072

H.E.P.C.

C.P.R.

PORT MUNRO

Booming Grounds L.O. 5416

Craddock Cove (GLASGOW ID.)

GOOD HOPE ID.

MONMOUTH ID.

Charlerol Pt.

Sturdee Cove

Mons Pt.

Redsucker Cove

PENINSULA

LAKE SUPERIOR

BAY

RESERVED FROM STAKING: JULY 4/33 W.S. 83*

TEMPORARILY WITHDRAWN FROM DISPOSITION MAR. 22, 1967 — FILE: 172503

SEE DETAIL PLAN OF YPRES POINT

Marathon Aerodrome TW170

File: 133500

793.96 Ac. ±

WNCR 5/84 S.M. Rights WITHDRAWN

WITHDRAWN FROM DISPOSITION JUNE 24, 1981 File 133500

S.M. RIGHTS WITHDRAWN WNCR 81/21

Wind Velocity Site No. 31 Dept. of Trans. File 169567

Terrace Bay

Goodchild

Astronomic North

Angler

Ant

Twp. Limit of PIC

86°30' 86°25' 86°15' 48°52'30" 48°45' 48°30'

REFERENCES

NOTES

Land under water in Lake Superior withdrawn from staking by Order in Council dated April 30, 1912.

LIMITS OF MARATHON IMPROVEMENT DISTRICT SHOWN THUS: FILE: 129282

* Disposition by exploratory licence of occupation only

THUNDER BAY MINING DIVISION RECEIVED MAY 15 1984 AM 7 8 9 10 11 12 1 2 3 4 5 6 PM

J.R. WITHDRAWN - W.N.C.R. 31/81 SEELEY LAKE LANDSALE

LEGEND

- HIGHWAY AND ROUTE No.
- OTHER ROADS
- TRAILS
- SURVEYED LINES: TOWNSHIPS, BASE LINES, ETC.
- LOTS, MINING CLAIMS, PARCELS, ETC.
- UNSURVEYED LINES: LOT LINES
- PARCEL BOUNDARY
- MINING CLAIMS ETC.
- RAILWAY AND RIGHT OF WAY
- UTILITY LINES
- NON-PERENNIAL STREAM
- FLOODING OR FLOODING RIGHTS
- SUBDIVISION OR COMPOSITE PLAN
- RESERVATIONS
- ORIGINAL SHORELINE
- MARSH OR MUSKEG
- MINES
- TRAVERSE MONUMENT

DISPOSITION OF CROWN LANDS

TYPE OF DOCUMENT	SYMBOL
PATENT, SURFACE & MINING RIGHTS	
SURFACE RIGHTS ONLY	
MINING RIGHTS ONLY	
LEASE, SURFACE & MINING RIGHTS	
SURFACE RIGHTS ONLY	
MINING RIGHTS ONLY	
LICENCE OF OCCUPATION	
ORDER-IN-COUNCIL	OC
RESERVATION	R
CANCELLED	C
SAND & GRAVEL	S

NOTE: MINING RIGHTS IN PARCELS PATENTED PRIOR TO MAY 5, 1913, VESTED IN ORIGINAL PATENTEE BY THE PUBLIC LANDS ACT, R.S.O. 1910, CHAP. 30, SEC. 63, SUBSEC. 1

SCALE: 1 INCH = 40 CHAINS

FEET 0 1000 2000 4000 6000 8000

METRES 0 200 1000 (1 KM) 2000 (2 KM)

AREA

SEELEY LAKE

M.N.R. ADMINISTRATIVE DISTRICT

TERRACE BAY

MINING DIVISION

THUNDER BAY

LAND TITLES / REGISTRY DIVISION

THUNDER BAY

Ministry of Natural Resources — Land Management Branch — Ontario

Mar. 31/1982

Date FEBRUARY 1982 Number G-613

REFERENCES

AREAS WITHDRAWN FROM DISPOSITION

S.R. - SURFACE RIGHTS M.R. - MINING RIGHTS

Description	Order No.	Date	Disposition	File
SEC 36/7-80	1 26 83	20/10/83	S.R.	
SEC 36/7-80	4 6 83	04/10/83	S.R.	

RECEIVED
THUNDER BAY
MINING DIVISION
'88 APR 12 PM 5 44

DETAIL PLAN
OF YPRES POINT

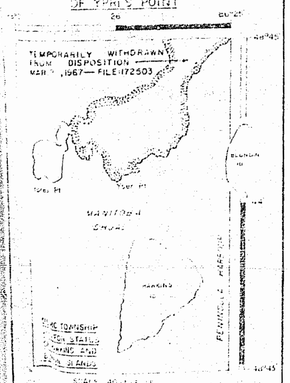

MARTINET LAKE G-601

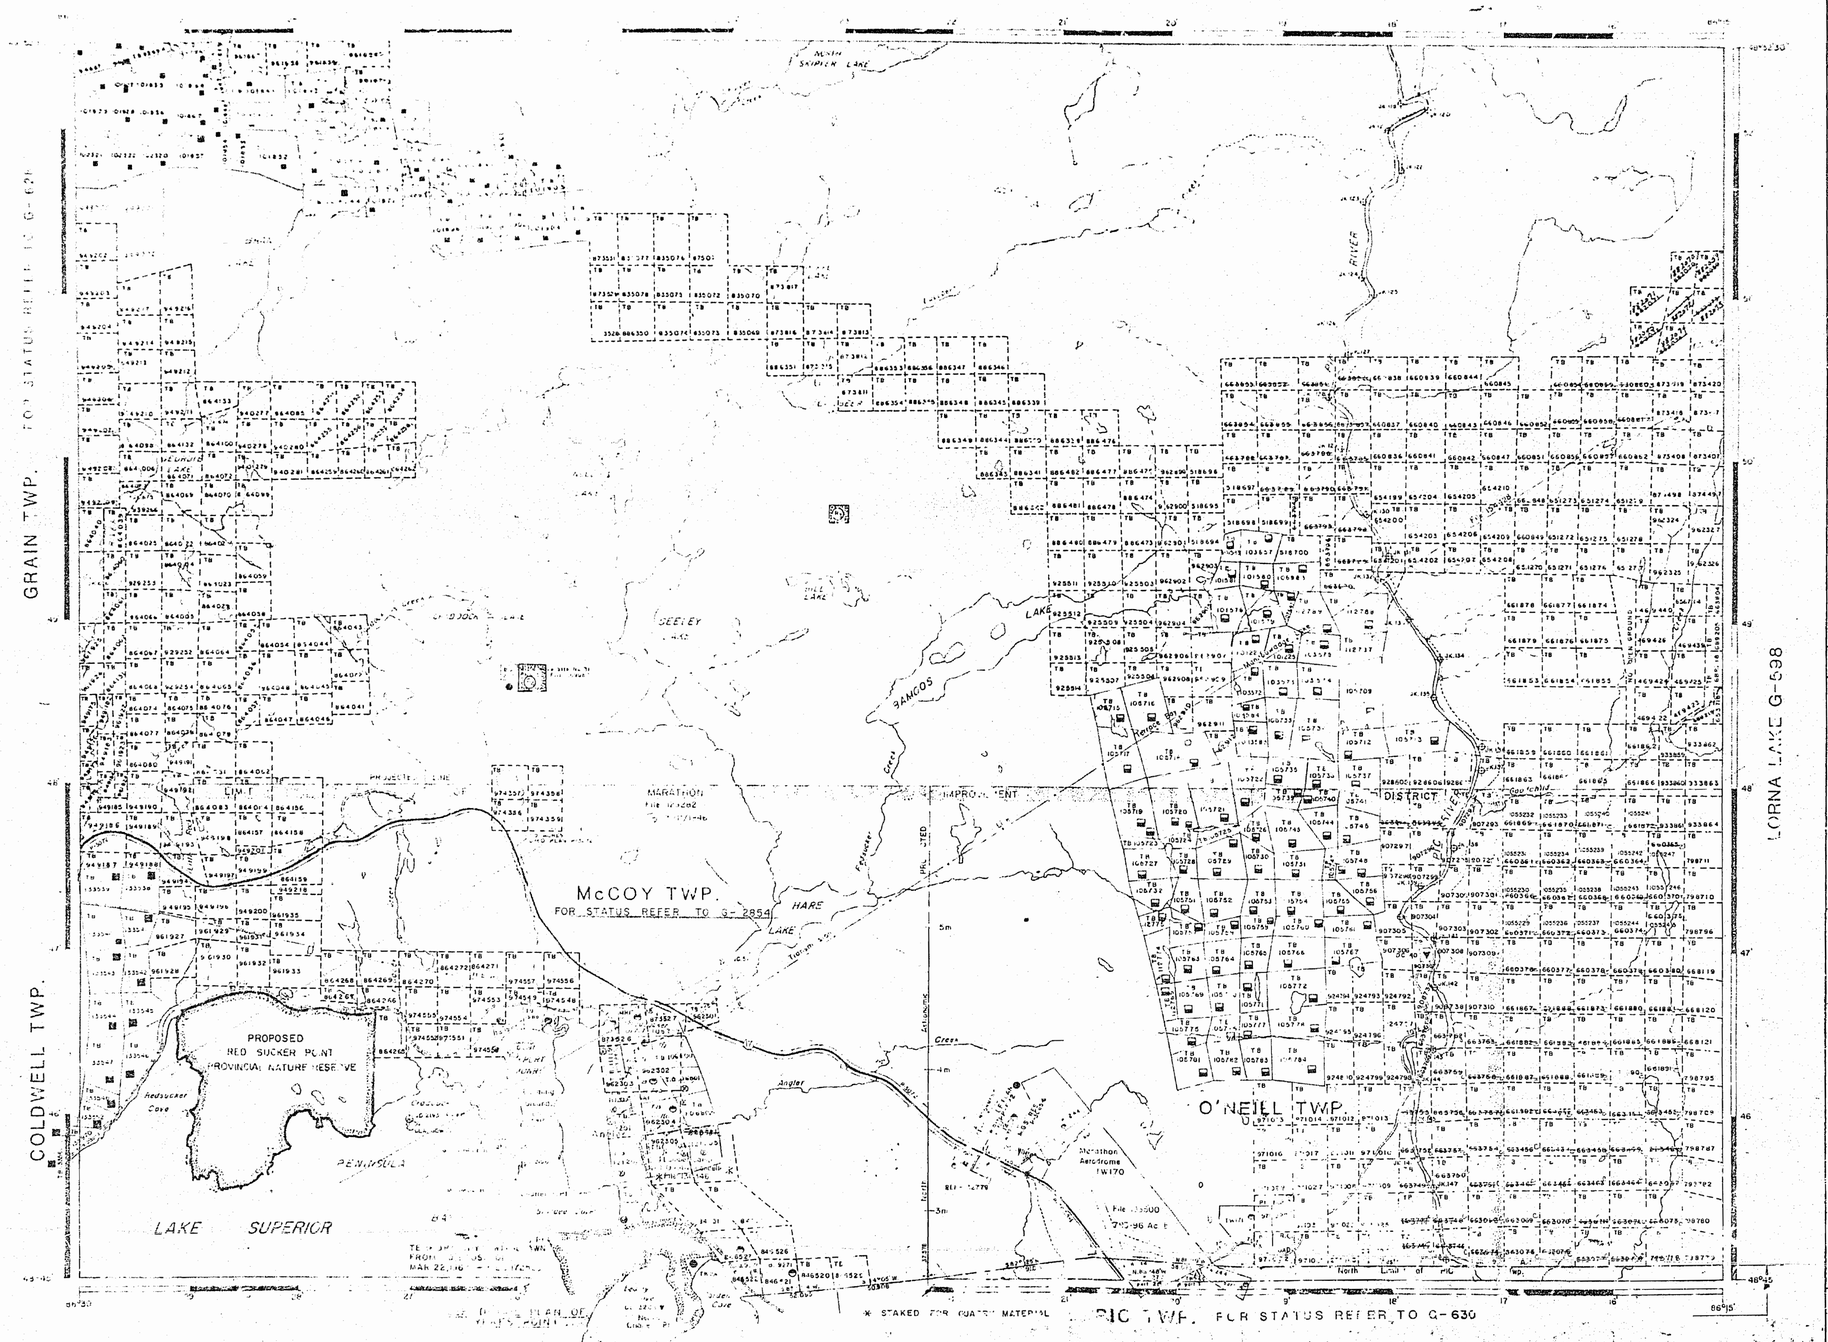

REFERENCES

AREA SHOWN THUS [illegible] IS WITHDRAWN FROM STAKING PURSUANT TO PROVISIONS OF SECTION 32 OF THE MINING ACT, R.S.O. 1980, CHAPTER 258. DISPOSITION BY EXPLORATORY LICENCE OF OCCUPATION ONLY

LAND UNDER WATER IN LAKE SUPERIOR IS WITHDRAWN FROM STAKING BY ORDER IN COUNCIL, DATED APRIL 30, 1912

LEGEND

DISPOSITION OF CROWN LANDS

TYPE OF DOCUMENT	SYMBOL
PATENT SURFACE & MINING RIGHTS	
" SURFACE RIGHTS ONLY	
" MINING RIGHTS ONLY	
LEASE SURFACE & MINING RIGHTS	
" SURFACE RIGHTS ONLY	
" MINING RIGHTS ONLY	
LICENCE OF OCCUPATION	
ORDER IN COUNCIL	
RESERVATION	
CANCELLED	
SAND & GRAVEL	

NOTE: MINING RIGHTS IN PARCELS PATENTED [illegible] 1913 VESTED IN ORIGINAL PATENTEE [illegible] LANDS ACT, R.S.O. 1970, CHAP. 380, SEC. [illegible]

SCALE 1 INCH = 40 CHAINS

AREA

SEELEY LAKE

M.N.R. ADMINISTRATIVE DISTRICT

TERRACE BAY

MINING DIVISION

THUNDER BAY

LAND TITLES / REGISTRY DIVISION

THUNDER BAY

Ministry of Natural Resources — Land Management Branch

Ontario

Date FEBRUARY 1982

Number G-613

SEELEY LAKE

REFERENCES

AREAS WITHDRAWN FROM DISPOSITION

S.R.-SURFACE RIGHTS M.R.-MINING RIGHTS

DESCRIPTION	ORDER #	DATE	DISPOSITION	FILE
SEC 36/80	W28/83	20/10/83	S.R.O.	
SEC 36/80	W3/82	20/06/82	S.R.O.	
	W-4378		NO STAKING ALLOWED	
SEC 35/90	W22/92	92/04/27	S.R.O.	

DETAIL PLAN OF YPRES POINT

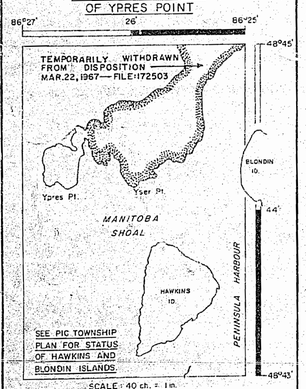

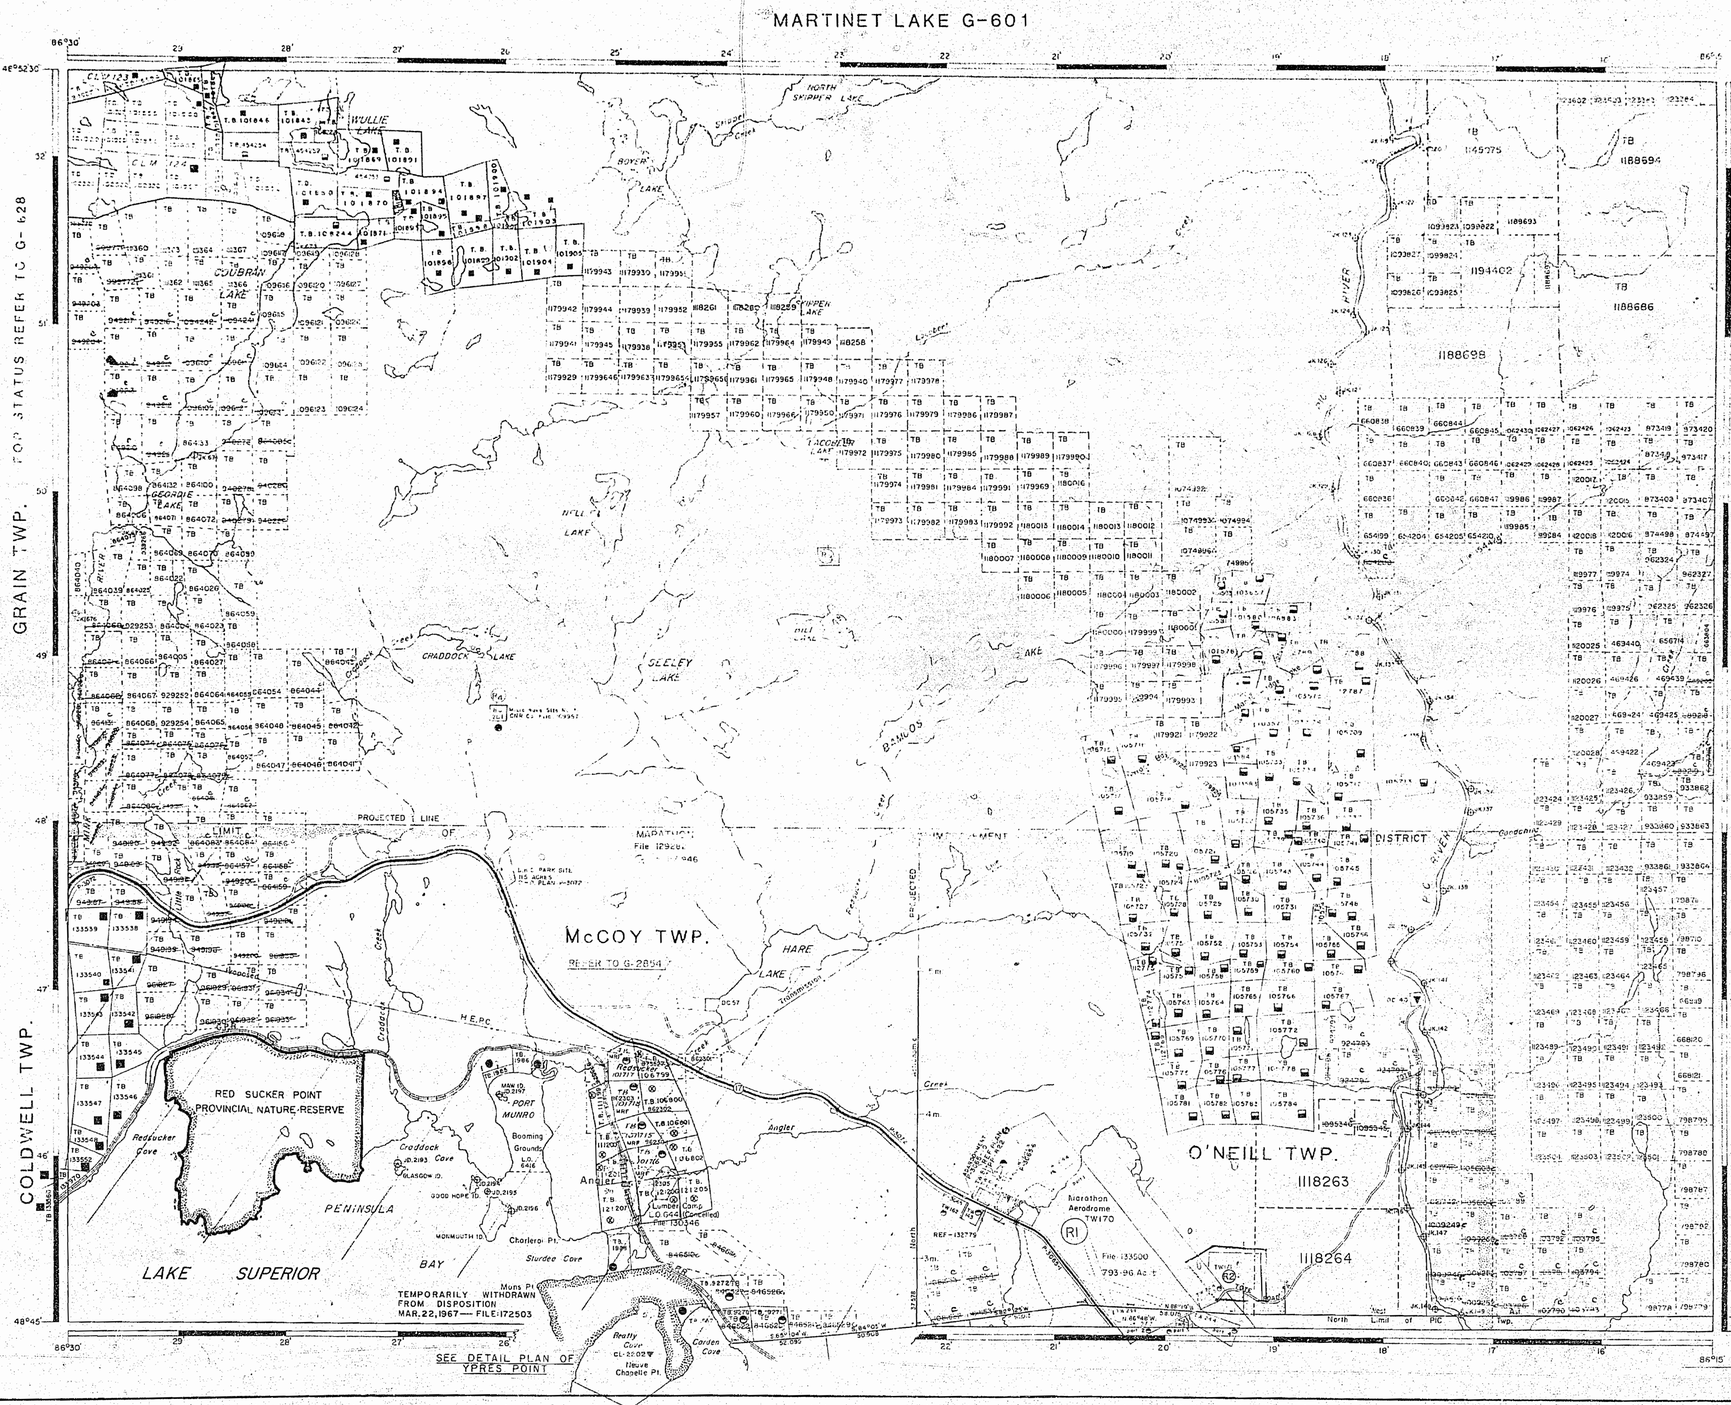

REFERENCES

THE INFORMATION THAT APPEARS ON THIS MAP HAS BEEN COMPILED FROM VARIOUS SOURCES, AND ACCURACY IS NOT GUARANTEED. THOSE WISHING TO STAKE MINING CLAIMS SHOULD CONSULT WITH THE MINING RECORDER, MINISTRY OF NORTHERN DEVELOPMENT AND MINES, FOR ADDITIONAL INFORMATION ON THE STATUS OF THE LANDS SHOWN HEREON.

LEGEND

DISPOSITION OF CROWN LANDS

TYPE OF DOCUMENT SYMBOL

LAND USE PERMITS FOR COMMERCIAL TOURISM OUTPOST CAMPS

SCALE 1 INCH = 40 CHAINS

AREA

SEELEY LAKE

ADMINISTRATIVE DISTRICT

TERRACE BAY

MINING DIVISION

THUNDER BAY

LAND TITLES REGISTRY DIVISION

THUNDER BAY

Ministry of Natural Resources — Land Management Branch

FEBRUARY 1982

Number G-613

RECEIVED THUNDER BAY MINING DIVISION '92 SEP 18 PM 1 27

TRIM TO THIS LINE ALL AROUND

MARTINET LAKE G-601

REFERENCES

AREAS WITHDRAWN FROM DISPOSITION

S.R.-SURFACE RIGHTS M.R.-MINING RIGHTS

DESCRIPTION	ORDER #	DATE	DISPOSITION	FILE
(R1)	W-43/81		NO STAKING ALLOWED	
(R2)	SEC. 35/90	W22/92	92/04/27	S.R.O.
(R3)	SEC. 36/80	W28/83	20/10/83	S.R.O.
(R4)	SEC. 36/80	W3/82	09/06/82	S.R.O.

DETAIL PLAN OF YPRES POINT

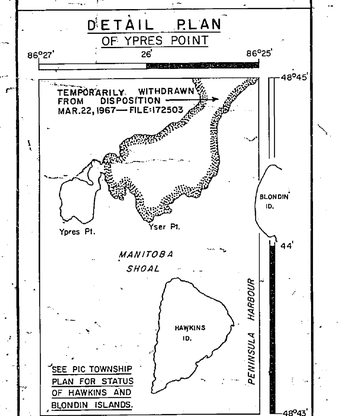

SEE PIC TOWNSHIP PLAN FOR STATUS OF HAWKINS AND BLONDIN ISLANDS.

SCALE: 40 ch. = 1 in.

REFERENCES

RECEIVED
THUNDER BAY
MINING DIVISION
'94 MAY 30 AM 11 08

NOTICE:
The information that appears on this map has been compiled from various sources, and accuracy is not guaranteed. Those wishing to stake mining claims should consult with the Mining Recorder, Ministry of Northern Development and Mines, for additional information on the status of the lands shown hereon.

LEGEND

- HIGHWAY AND ROUTE No.
- OTHER ROADS
- TRAILS
- SURVEYED LINES:
  - TOWNSHIPS, BASE LINES, ETC.
  - LOTS, MINING CLAIMS, PARCELS, ETC.
- UNSURVEYED LINES:
  - LOT LINES
  - PARCEL BOUNDARY
  - MINING CLAIMS ETC.
- RAILWAY AND RIGHT OF WAY
- UTILITY LINES
- NON-PERENNIAL STREAM
- FLOODING OR FLOODING RIGHTS
- SUBDIVISION OR COMPOSITE PLAN
- RESERVATIONS
- ORIGINAL SHORELINE
- MARSH OR MUSKEG
- MINES
- TRAVERSE MONUMENT

DISPOSITION OF CROWN LANDS

TYPE OF DOCUMENT	SYMBOL
PATENT, SURFACE & MINING RIGHTS	●
" , SURFACE RIGHTS ONLY	◒
" , MINING RIGHTS ONLY	◒
LEASE, SURFACE & MINING RIGHTS	■
" , SURFACE RIGHTS ONLY	◨
" , MINING RIGHTS ONLY	◨
LICENCE OF OCCUPATION	▼
ORDER-IN-COUNCIL	OC
RESERVATION	(R)
CANCELLED	⊗
SAND & GRAVEL	(S)

LAND USE PERMITS FOR COMMERCIAL TOURISM, OUTPOST CAMPS ▽
NOTE: MINING RIGHTS IN PARCELS PATENTED PRIOR TO MAY 6, 1913, VESTED IN ORIGINAL PATENTEE BY THE PUBLIC LANDS ACT, R.S.O. 1970, CHAP. 380, SEC. 63, SUBSEC 1.

SCALE: 1 INCH = 40 CHAINS

FEET 0 1000 2000 4000 6000 8000
METRES 0 200 1000 2000
(1 KM) (2 KM)

AREA

SEELEY LAKE

M.N.R. ADMINISTRATIVE DISTRICT
TERRACE BAY
MINING DIVISION
THUNDER BAY
LAND TITLES / REGISTRY DIVISION
THUNDER BAY

Ontario Ministry of Natural Resources — Land Management Branch

DATE FEBRUARY 1982 | NUMBER G-613

In Service Dec. 15/93.

MAY 30, 1994

MARTINET LAKE G-601

RECEIVED
THUNDER BAY
MINING DIVISION
'95 AUG 23 AM 11 32

REFERENCES

AREAS WITHDRAWN FROM DISPOSITION

S.R.-SURFACE RIGHTS M.R.-MINING RIGHTS

DESCRIPTION	ORDER #	DATE	DISPOSITION	FILE
(R1)	W-43/81		NO STAKING ALLOWED	
(R2) SEC. 35/80	W22/82	92/04/27	S.R.O.	
(R3) SEC. 36/80	W28/83	20/10/83	S.R.O.	
(R4) SEC. 36/80	W3/82	09/06/82	S.R.O.	

DETAIL PLAN OF YPRES POINT

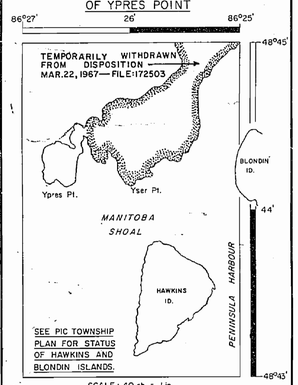

SCALE: 40 ch. = 1 in.

FOR STATUS REFER TO G-628

GRAIN TWP.

COLDWELL TWP.

McCOY TWP.
REFER TO G-2854.

O'NEILL TWP.

PIC RIVER

LORNA LAKE G-598

LIMIT OF IMPROVEMENT DISTRICT

PROJECTED LINE

MARATHON File 129282 5/11/1946

D.N.D. PARK SITE 11.5 ACRES D.N.D. PLAN P-3072

RED SUCKER POINT PROVINCIAL NATURE RESERVE

PENINSULA

LAKE SUPERIOR

BAY

TEMPORARILY WITHDRAWN FROM DISPOSITION MAR.22,1967— FILE:172503

SEE DETAIL PLAN OF YPRES POINT

Marathon Aerodrome TW170 File:133500 793-96 Ac. ±

Windrawn from disposition File:190509 Mar.15,1988

Lumber Camp L.O. 646 (Cancelled) File:130346

Booming Grounds L.O. 6416

Reduction 101777 102799

Addition 101776

Addition 101778

Addition 101779

Addition

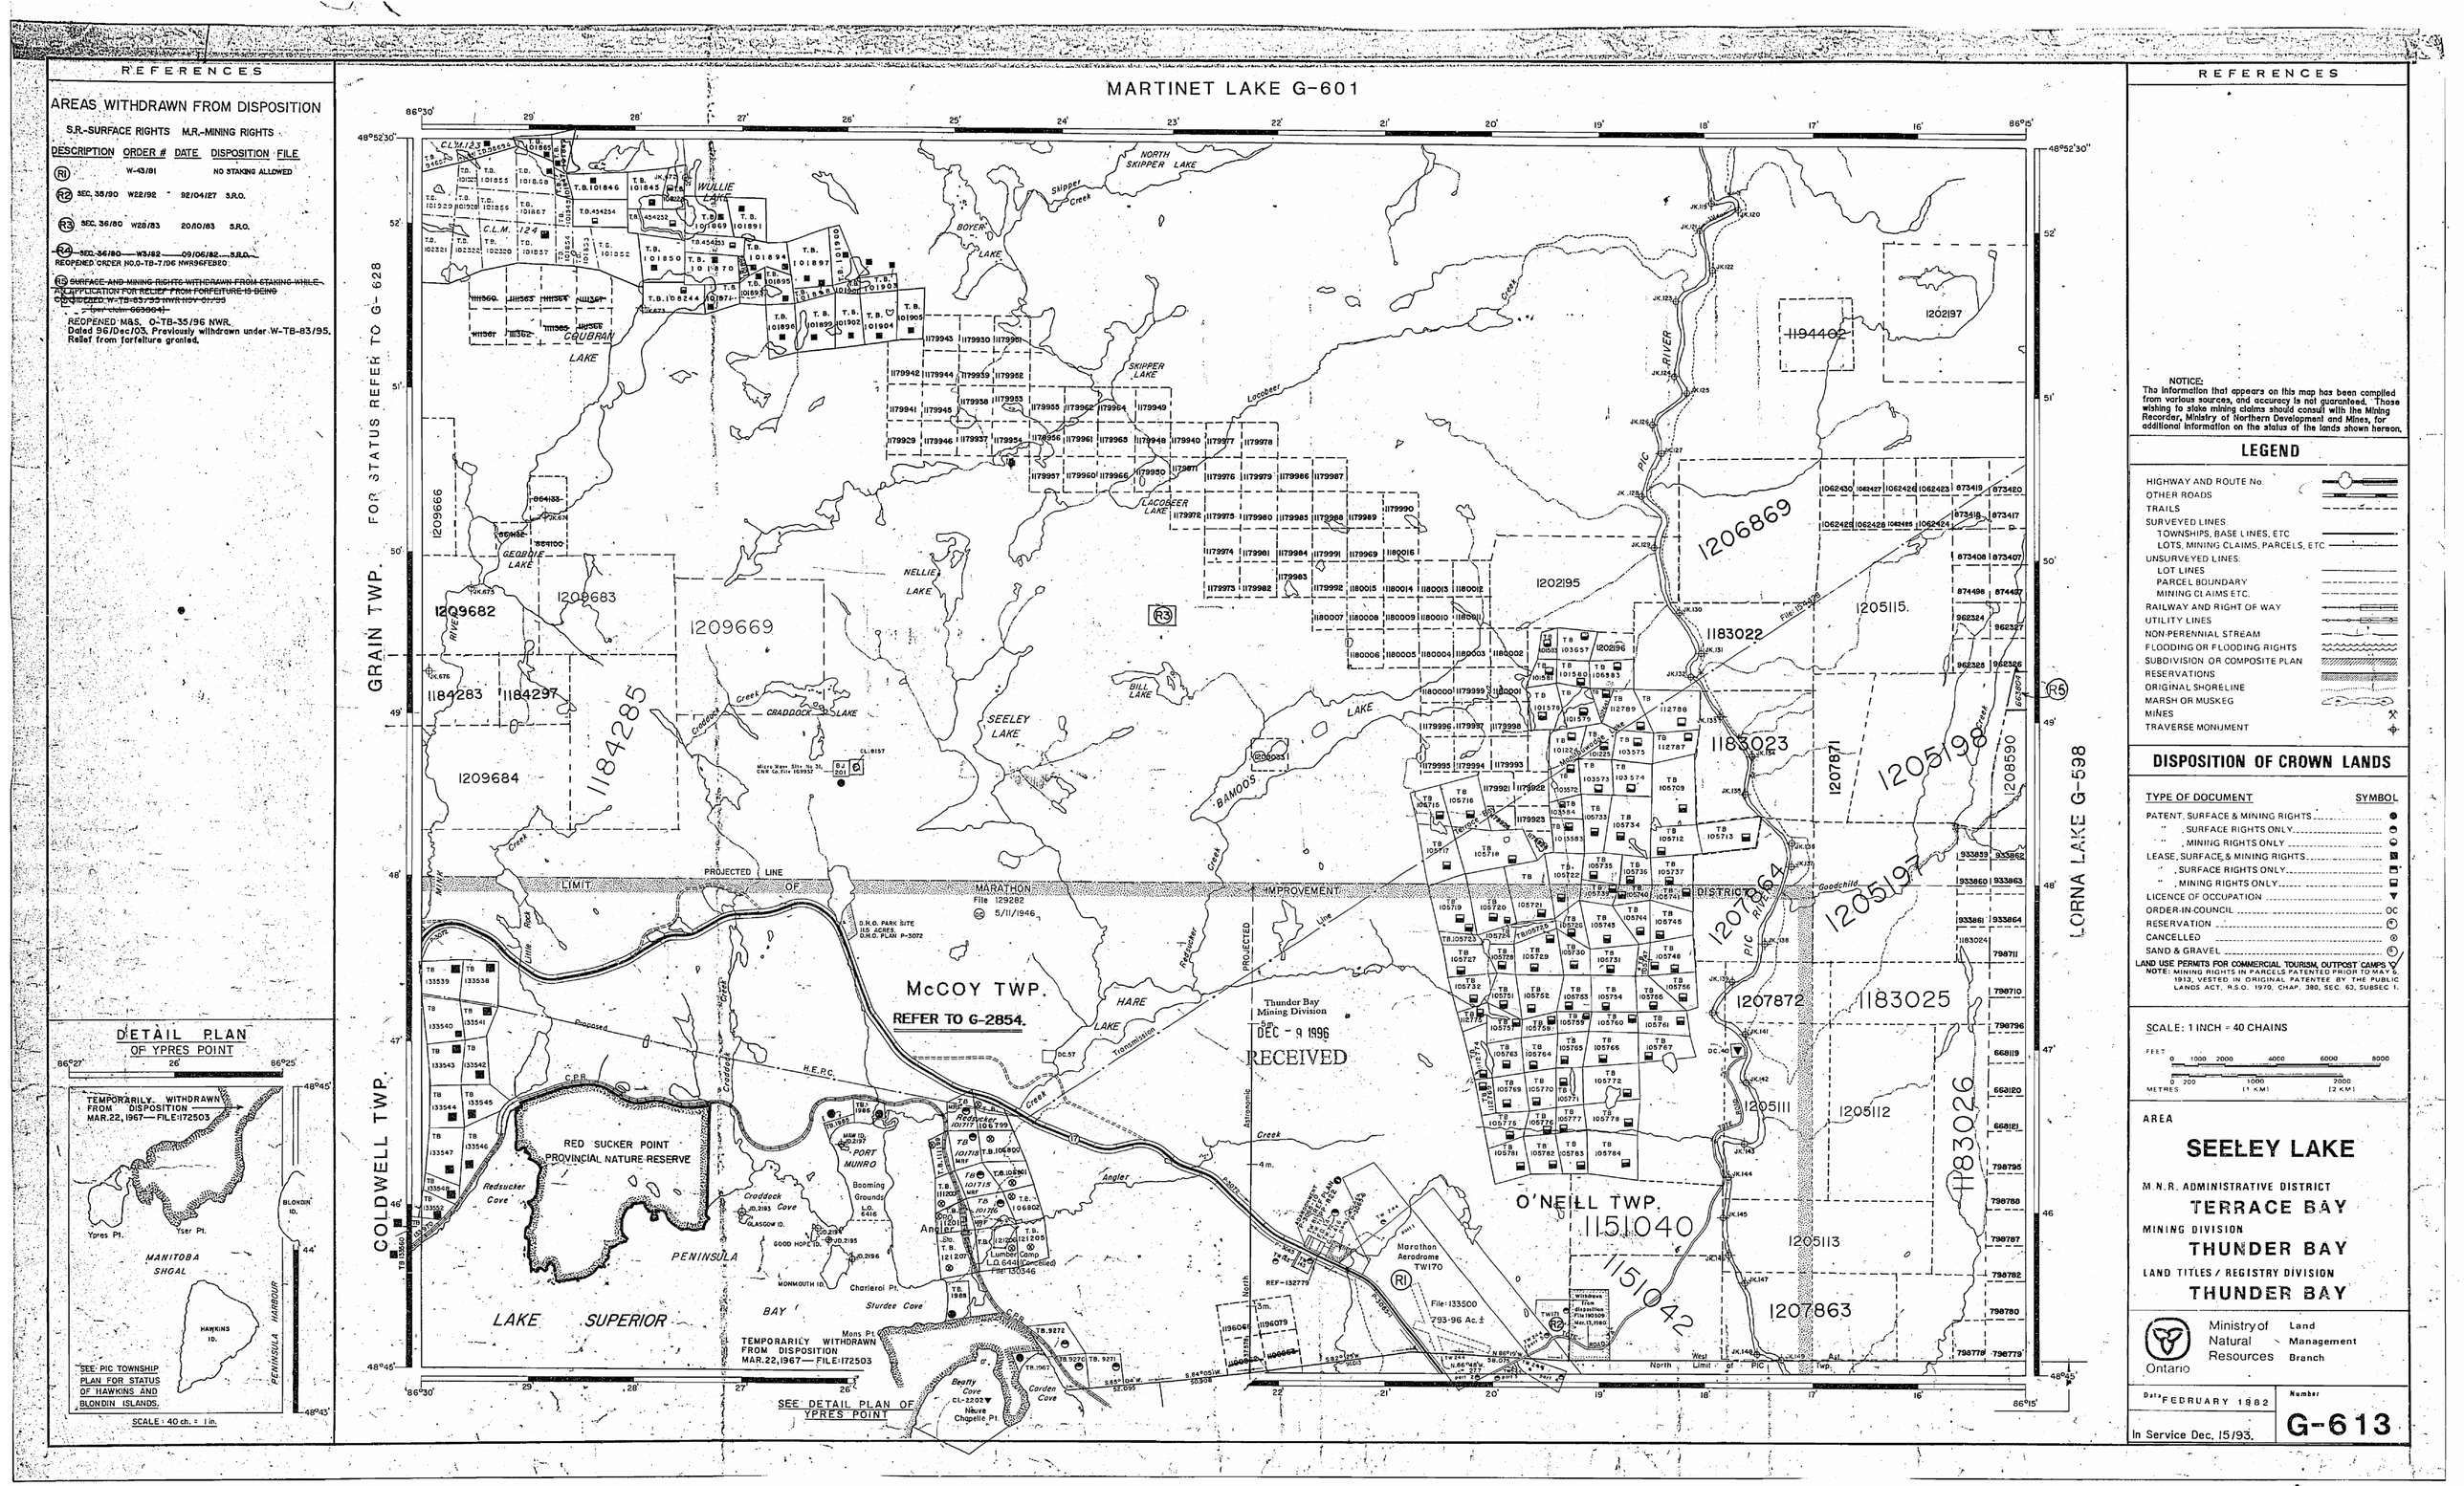

REFERENCES

AREAS WITHDRAWN FROM DISPOSITION

S.R.-SURFACE RIGHTS M.R.-MINING RIGHTS

DESCRIPTION	ORDER #	DATE	DISPOSITION	FILE
R1	W-43/81		NO STAKING ALLOWED	
R2 SEC. 35/90	W22/92	92/04/27	S.R.O.	
R3 SEC. 36/80	W28/83	20/10/83	S.R.O.	
~~R4 SEC. 36/80~~	~~W3/82~~	~~09/06/82~~	~~S.R.O.~~	

REOPENED ORDER NO.0-TB-7/96 NWR96FEB20

~~R5 SURFACE AND MINING RIGHTS WITHDRAWN FROM STAKING WHILE AN APPLICATION FOR RELIEF FROM FORFEITURE IS BEING CONSIDERED W-TB-83/95 NWR NOV 01/95~~

~~(per claim 663904)~~

REOPENED MAS. O-TB-35/96 NWR.
Dated 96/Dec/03. Previously withdrawn under W-TB-83/95.
Relief from forfeiture granted.

REFERENCES

NOTICE:
The information that appears on this map has been compiled from various sources, and accuracy is not guaranteed. Those wishing to stake mining claims should consult with the Mining Recorder, Ministry of Northern Development and Mines, for additional information on the status of the lands shown hereon.

LEGEND

HIGHWAY AND ROUTE No.
OTHER ROADS
TRAILS
SURVEYED LINES:
TOWNSHIPS, BASE LINES, ETC
LOTS, MINING CLAIMS, PARCELS, ETC
UNSURVEYED LINES:
LOT LINES
PARCEL BOUNDARY
MINING CLAIMS ETC.
RAILWAY AND RIGHT OF WAY
UTILITY LINES
NON-PERENNIAL STREAM
FLOODING OR FLOODING RIGHTS
SUBDIVISION OR COMPOSITE PLAN
RESERVATIONS
ORIGINAL SHORELINE
MARSH OR MUSKEG
MINES
TRAVERSE MONUMENT

DISPOSITION OF CROWN LANDS

TYPE OF DOCUMENT	SYMBOL
PATENT, SURFACE & MINING RIGHTS	●
" , SURFACE RIGHTS ONLY	
" , MINING RIGHTS ONLY	
LEASE, SURFACE & MINING RIGHTS	
" , SURFACE RIGHTS ONLY	
" , MINING RIGHTS ONLY	
LICENCE OF OCCUPATION	▼
ORDER-IN-COUNCIL	OC
RESERVATION	
CANCELLED	
SAND & GRAVEL	

LAND USE PERMITS FOR COMMERCIAL TOURISM, OUTPOST CAMPS
NOTE: MINING RIGHTS IN PARCELS PATENTED PRIOR TO MAY 6, 1913, VESTED IN ORIGINAL PATENTEE BY THE PUBLIC LANDS ACT, R.S.O. 1970, CHAP. 380, SEC. 63, SUBSEC 1.

SCALE: 1 INCH = 40 CHAINS

FEET 0 1000 2000 4000 6000 8000
METRES 0 200 1000 (1 KM) 2000 (2 KM)

AREA

SEELEY LAKE

M.N.R. ADMINISTRATIVE DISTRICT
TERRACE BAY
MINING DIVISION
THUNDER BAY
LAND TITLES / REGISTRY DIVISION
THUNDER BAY

Ministry of Natural Resources — Land Management Branch — Ontario

Date FEBRUARY 1982
In Service Dec. 15/93.
Number **G-613**

REFERENCES

AREAS WITHDRAWN FROM DISPOSITION

S.R.-SURFACE RIGHTS M.R.-MINING RIGHTS

DESCRIPTION	ORDER #	DATE	DISPOSITION	FILE
R1	W-43/81		NO STAKING ALLOWED	
R2 SEC. 35/90	W22/92	92/04/27	S.R.O.	
R3 SEC. 36/80	W28/83	20/10/83	S.R.O.	
~~R4 SEC. 36/80~~	~~W3/82~~	~~09/06/82~~	~~S.R.O.~~	

REOPENED ORDER NO.0-TB-7/96 NWR96FEB20

~~R5 SURFACE AND MINING RIGHTS WITHDRAWN FROM STAKING WHILE AN APPLICATION FOR RELIEF FROM FORFEITURE IS BEING CONSIDERED W-TB-83/95 NWR NOV 01/95 (per claim 663084).~~

REOPENED M&S. 0-TB-35/96 NWR.
Dated 96/Dec/03. Previously withdrawn under W-TB-83/95.
Relief from forfeiture granted.

DETAIL PLAN OF YPRES POINT

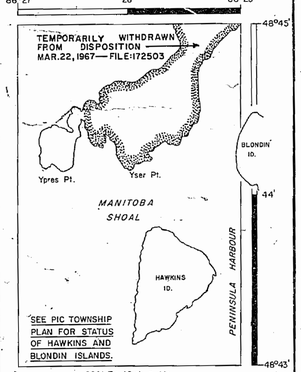

MARTINET LAKE G-601

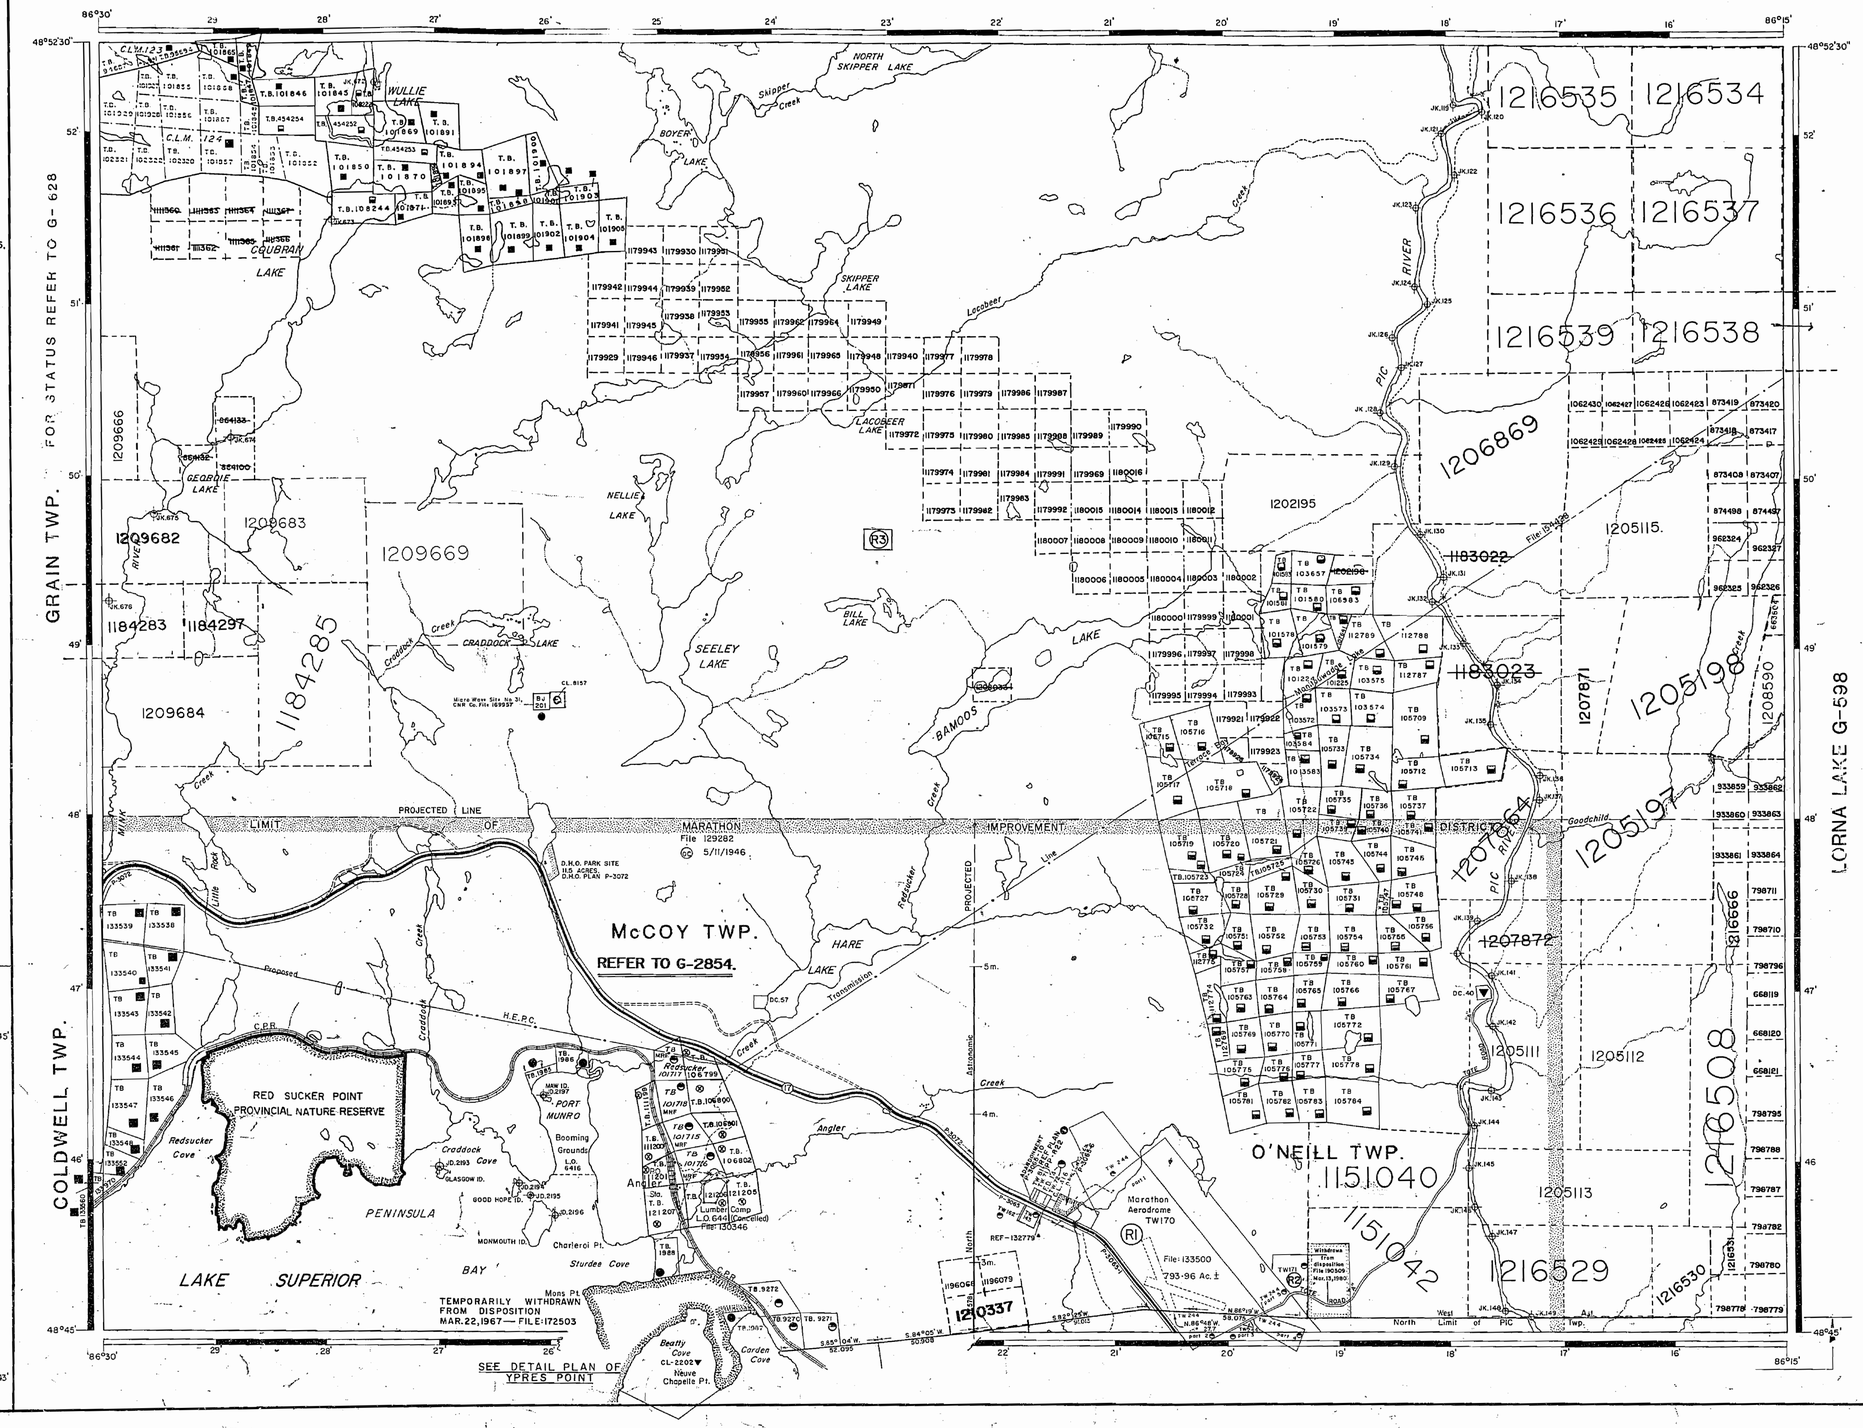

REFERENCES

Thunder Bay Mining Division
JUL 30 1997
RECEIVED

NOTICE:
The information that appears on this map has been compiled from various sources, and accuracy is not guaranteed. Those wishing to stake mining claims should consult with the Mining Recorder, Ministry of Northern Development and Mines, for additional information on the status of the lands shown hereon.

LEGEND

- HIGHWAY AND ROUTE No.
- OTHER ROADS
- TRAILS
- SURVEYED LINES
  - TOWNSHIPS, BASE LINES, ETC
  - LOTS, MINING CLAIMS, PARCELS, ETC
- UNSURVEYED LINES
  - LOT LINES
  - PARCEL BOUNDARY
  - MINING CLAIMS ETC.
- RAILWAY AND RIGHT OF WAY
- UTILITY LINES
- NON-PERENNIAL STREAM
- FLOODING OR FLOODING RIGHTS
- SUBDIVISION OR COMPOSITE PLAN
- RESERVATIONS
- ORIGINAL SHORELINE
- MARSH OR MUSKEG
- MINES
- TRAVERSE MONUMENT

DISPOSITION OF CROWN LANDS

TYPE OF DOCUMENT	SYMBOL
PATENT, SURFACE & MINING RIGHTS	●
" , SURFACE RIGHTS ONLY	◒
" , MINING RIGHTS ONLY	◓
LEASE, SURFACE & MINING RIGHTS	■
" , SURFACE RIGHTS ONLY	⬒
" , MINING RIGHTS ONLY	⬓
LICENCE OF OCCUPATION	▼
ORDER-IN-COUNCIL	OC
RESERVATION	⊙
CANCELLED	⊙
SAND & GRAVEL	⊙

LAND USE PERMITS FOR COMMERCIAL TOURISM, OUTPOST CAMPS ✓
NOTE: MINING RIGHTS IN PARCELS PATENTED PRIOR TO MAY 6, 1913, VESTED IN ORIGINAL PATENTEE BY THE PUBLIC LANDS ACT, R.S.O. 1970, CHAP. 380, SEC. 63, SUBSEC 1.

SCALE: 1 INCH = 40 CHAINS

FEET 0 1000 2000 4000 6000 8000
METRES 0 200 1000 (1 KM) 2000 (2 KM)

AREA

SEELEY LAKE

M.N.R. ADMINISTRATIVE DISTRICT
TERRACE BAY

MINING DIVISION
THUNDER BAY

LAND TITLES / REGISTRY DIVISION
THUNDER BAY

Ontario Ministry of Natural Resources — Land Management Branch

Date FEBRUARY 1982

In Service Dec. 15/93.

Number **G-613**

1861

Martinet Lake Area (M-2488)

Twp. 79 (M-1923)

Twp. 78 (M-1921)

Lorna Lake Area (M-2487)

AREA OF

SEELEY LAKE

DISTRICT OF
THUNDER BAY

PORT ARTHUR
MINING DIVISION

SCALE: 1-INCH = 40 CHAINS

LEGEND

PATENTED LAND	(P)
CROWN LAND SALE	C.S.
LEASES	(L)
LOCATED LAND	Loc.
LICENSE OF OCCUPATION	L.O.
MINING RIGHTS ONLY	M.R.O.
SURFACE RIGHTS ONLY	S.R.O.
ROADS	
IMPROVED ROADS	
KING'S HIGHWAYS	
RAILWAYS	
POWER LINES	
MARSH OR MUSKEG	
MINES	
CANCELLED	C.

NOTES

400' Reserve around all Lakes & Rivers to Dept. of Lands & Forests.

Land under water in Lake Superior withdrawn from staking by Order In Council dated April 30, 1912.

Limits of Marathon Improvement District shown thus: File 129282, Vol. I.

DETAIL PLAN OF YPRES POINT

SCALE: 1 INCH = 40 CHAINS

1964

PLAN NO. M. 1861

DEPARTMENT OF MINES
— ONTARIO —

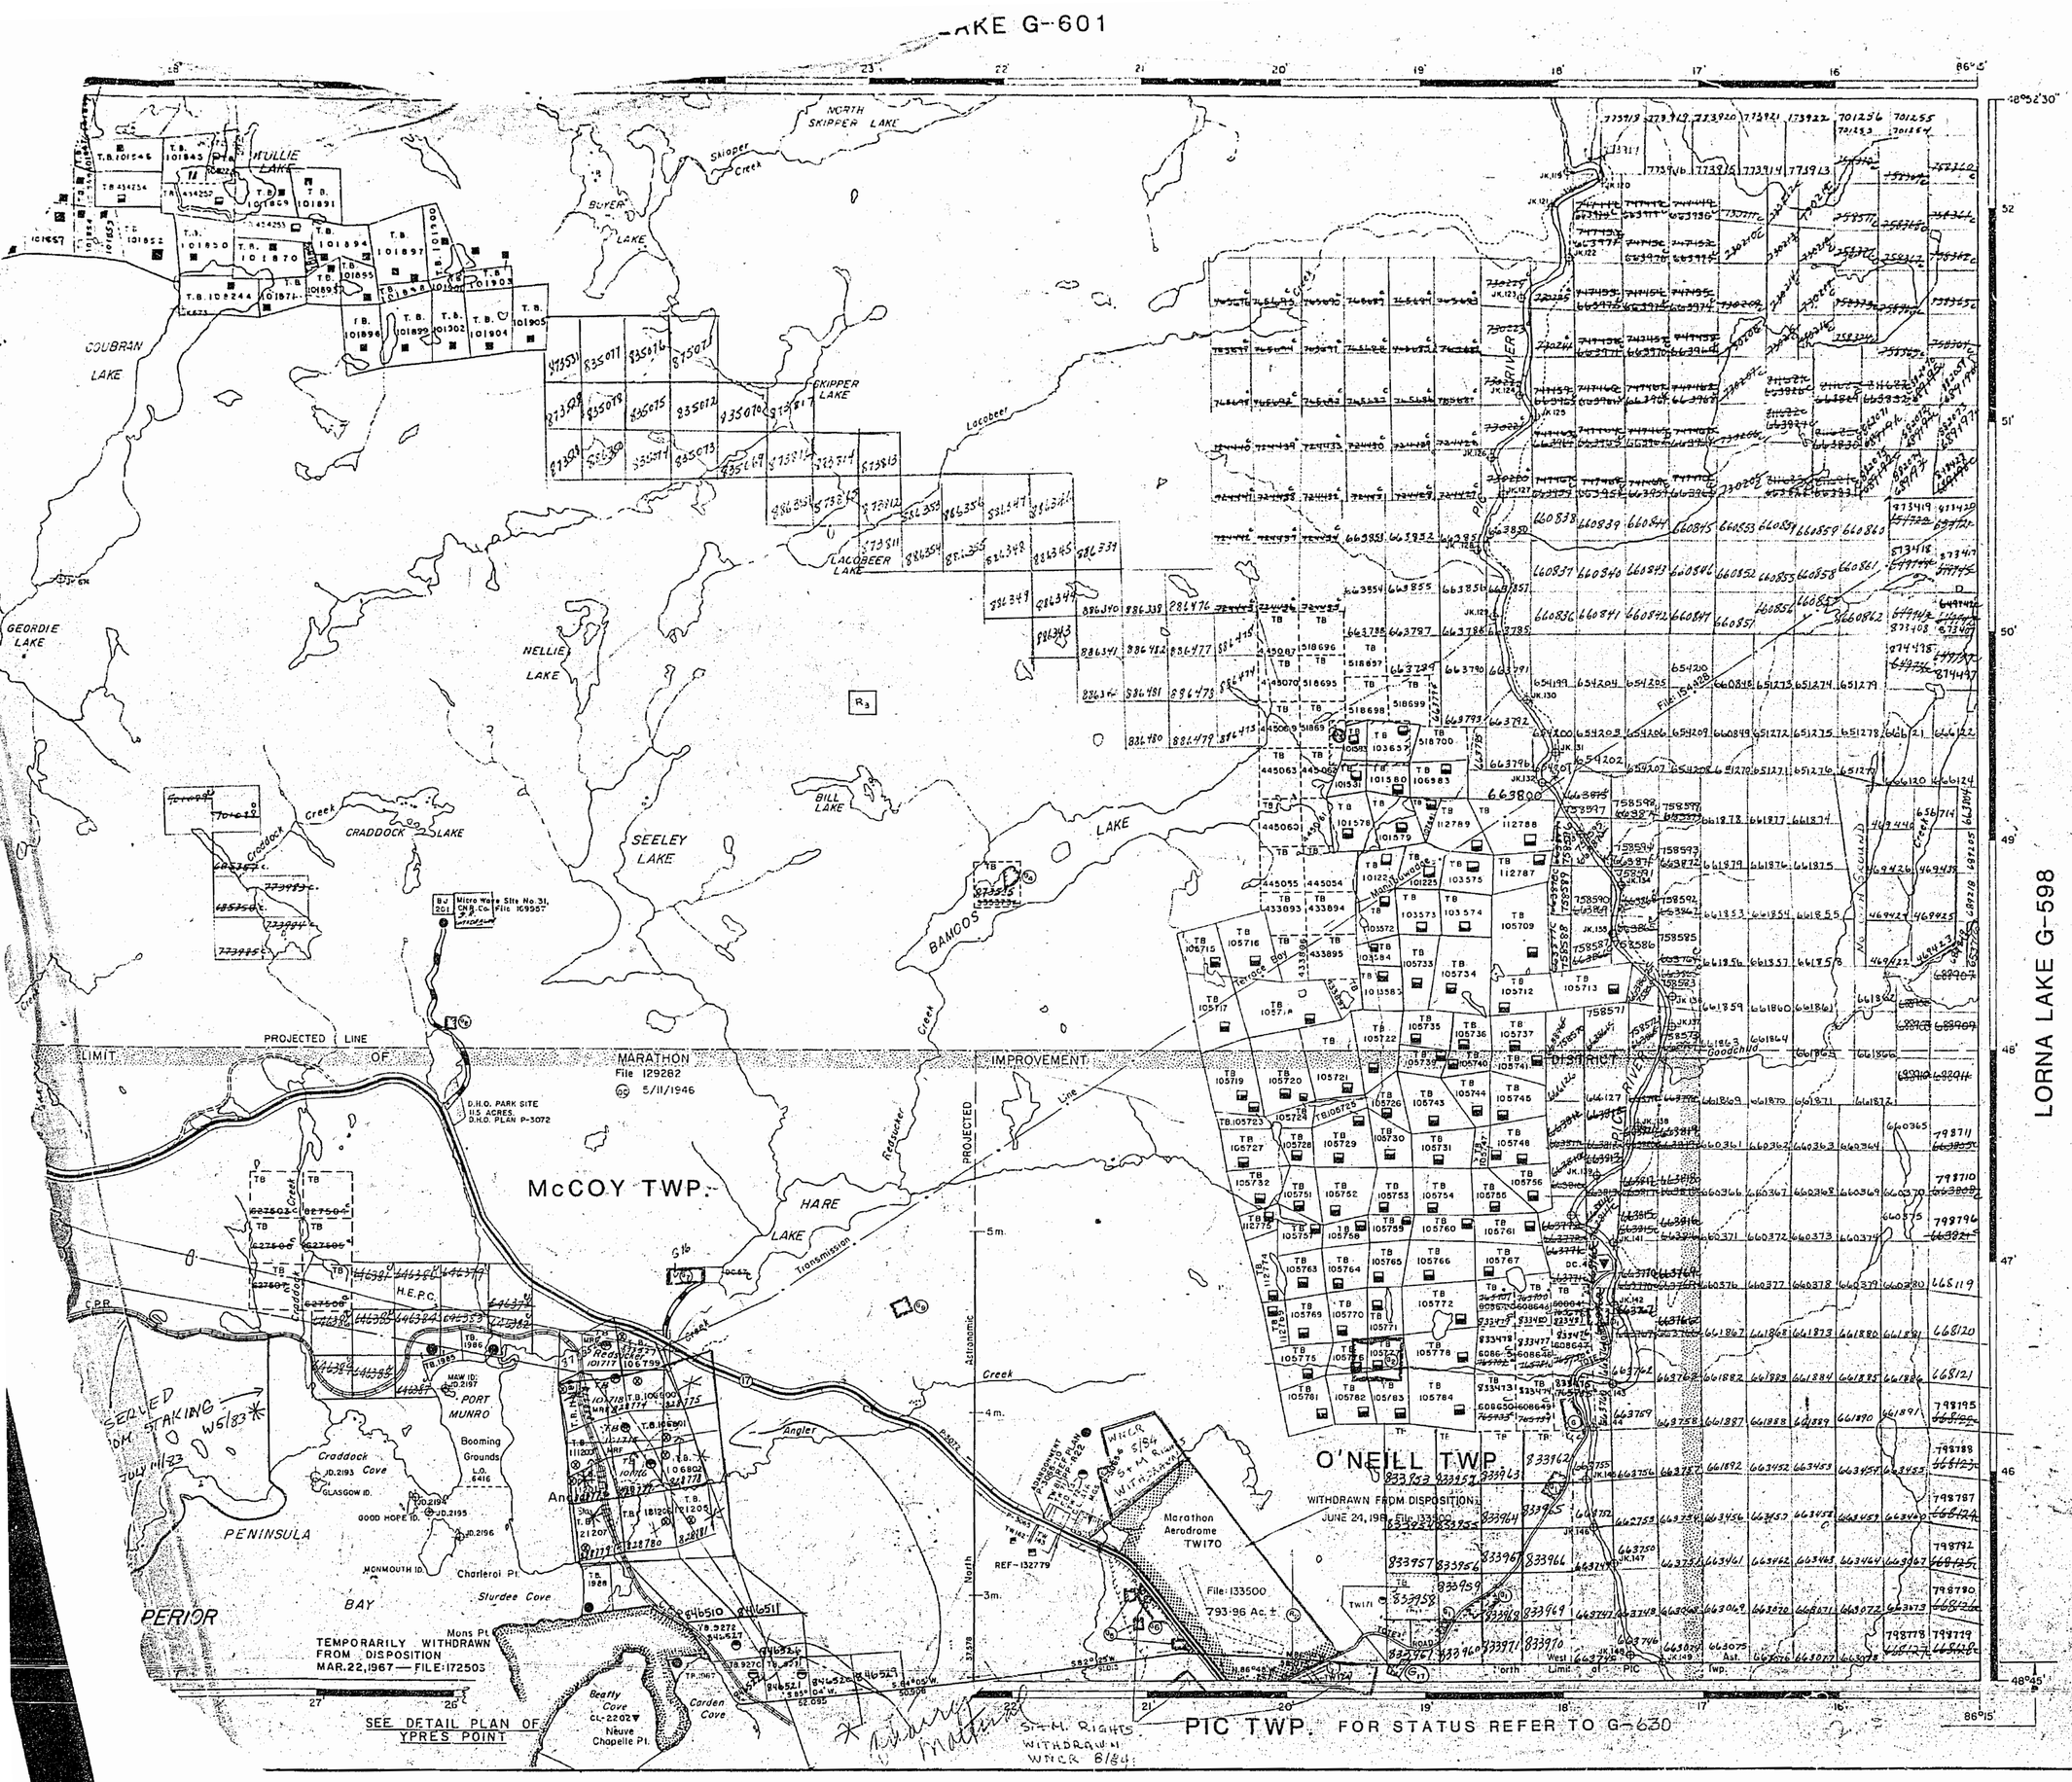

REFERENCES

NOTES

Land under water in Lake Superior withdrawn from staking by Order in Council dated April 30, 1912.

LIMITS OF MARATHON IMPROVEMENT DISTRICT SHOWN THUS: FILE: 129282

* Disposition by exploratory licence of occupation only

S.R. WITHDRAWN — WNCR 3/82 SEELEY LAKE LANDROLL

LEGEND

- HIGHWAY AND ROUTE No.
- OTHER ROADS
- TRAILS
- SURVEYED LINES:
  - TOWNSHIPS, BASE LINES, ETC.
  - LOTS, MINING CLAIMS, PARCELS, ETC.
- UNSURVEYED LINES:
  - LOT LINES
  - PARCEL BOUNDARY
  - MINING CLAIMS ETC.
- RAILWAY AND RIGHT OF WAY
- UTILITY LINES
- NON-PERENNIAL STREAM
- FLOODING OR FLOODING RIGHTS
- SUBDIVISION OR COMPOSITE PLAN
- RESERVATIONS
- ORIGINAL SHORELINE
- MARSH OR MUSKEG
- MINES
- TRAVERSE MONUMENT

DISPOSITION OF CROWN LANDS

TYPE OF DOCUMENT	SYMBOL
PATENT, SURFACE & MINING RIGHTS	●
" , SURFACE RIGHTS ONLY	◐
" , MINING RIGHTS ONLY	◑
LEASE, SURFACE & MINING RIGHTS	■
" , SURFACE RIGHTS ONLY	◧
" , MINING RIGHTS ONLY	◨
LICENCE OF OCCUPATION	▼
ORDER-IN-COUNCIL	OC
RESERVATION	®
CANCELLED	⊗
SAND & GRAVEL	Ⓢ

NOTE: MINING RIGHTS IN PARCELS PATENTED PRIOR TO MAY 6, 1913, VESTED IN ORIGINAL PATENTEE BY THE PUBLIC LANDS ACT R.S.O. 1970, CHAP. 380, SEC. 63, SUBSEC. 1.

SCALE: 1 INCH = 40 CHAINS

FEET 0 1000 2000 4000 6000 8000

METRES 0 200 1000 (1 KM) 2000 (2 KM)

AREA

SEELEY LAKE

M.N.R. ADMINISTRATIVE DISTRICT

TERRACE BAY

MINING DIVISION

THUNDER BAY

LAND TITLES / REGISTRY DIVISION

THUNDER BAY

Ontario Ministry of Natural Resources — Land Management Branch

MAY 31, 1982

Date FEBRUARY 1982

Number G-613

MARTINET LAKE G-601

GRAIN TWP. FOR STATUS REFER TO G-628

COLDWELL TWP.

McCOY TWP. FOR STATUS REFER TO G-2854

O'NEIL TWP. FOR STATUS REFER TO G-630

LORNA LAKE G-598
































PIC RIVER MATERIAL SITE

File 1-0500 700.96 Ac. ±

Reroute Sept 1981

Proposed Access Road

Proposed Transmission Line















































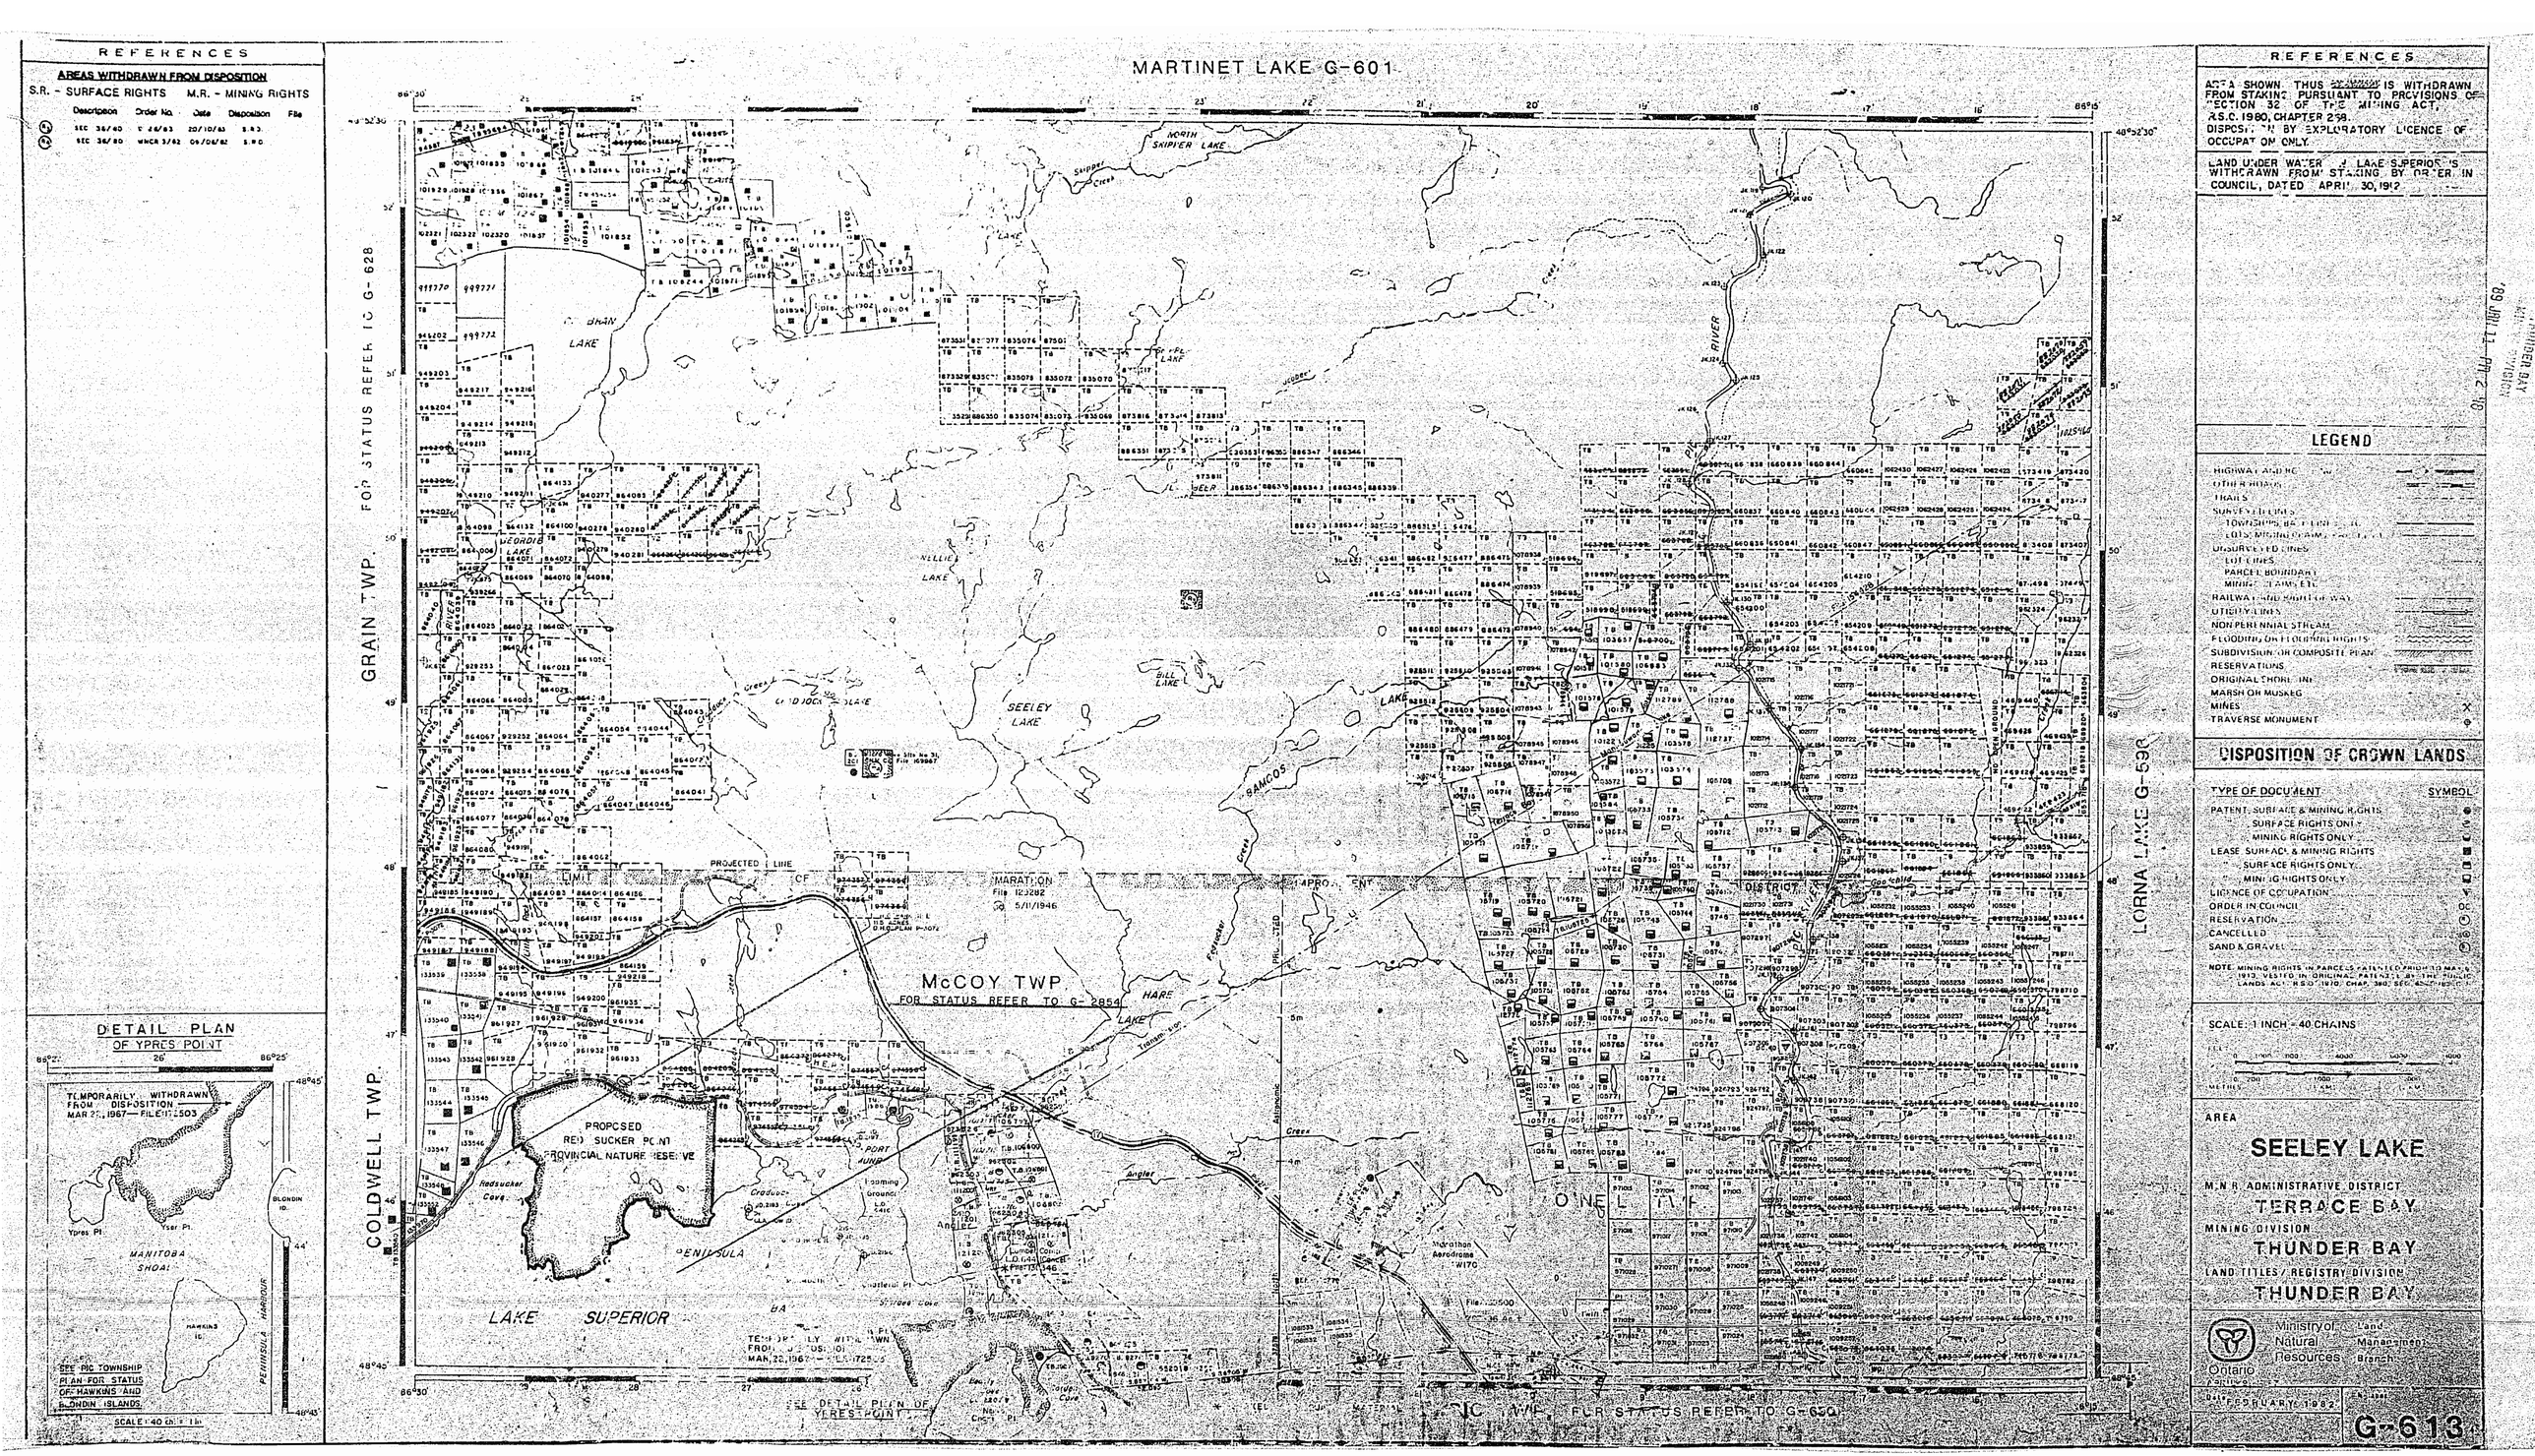

MARTINET LAKE G-601
GRAIN TWP.
FOR STATUS REFER TO G-628
COLDWELL TWP.
McCOY TWP
FOR STATUS REFER TO G-2854
LORNA LAKE G-598
LAKE SUPERIOR
PROPOSED RED SUCKER POINT PROVINCIAL NATURE RESERVE
SEELEY LAKE
NORTH SKIPPER LAKE
MARATHON
DISTRICT
SEE DETAIL PLAN OF YPRES POINT
REFERENCES
AREAS WITHDRAWN FROM DISPOSITION
S.R. - SURFACE RIGHTS M.R. - MINING RIGHTS
Description Order No. Date Disposition File
DETAIL PLAN OF YPRES POINT
TEMPORARILY WITHDRAWN FROM DISPOSITION MAR 22, 1967 — FILE 1725503
MANITOBA SHOAL
PENINSULA HARBOUR
SEE PIC TOWNSHIP PLAN FOR STATUS OF HAWKINS AND BLONDIN ISLANDS
SCALE 1:40 chs = 1 in
REFERENCES
AREA SHOWN THUS IS WITHDRAWN FROM STAKING PURSUANT TO PROVISIONS OF SECTION 32 OF THE MINING ACT, R.S.O. 1980, CHAPTER 258.
DISPOSITION BY EXPLORATORY LICENCE OF OCCUPATION ONLY.
LAND UNDER WATER OF LAKE SUPERIOR IS WITHDRAWN FROM STAKING BY ORDER IN COUNCIL, DATED APRIL 30, 1912
LEGEND
HIGHWAY AND RAILWAY
OTHER ROADS
TRAILS
SURVEYED LINES
TOWNSHIPS, BASE LINES, ETC.
LOTS, MINING CLAIMS, ETC.
UNSURVEYED LINES
LOT LINES
PARCEL BOUNDARY
MINING CLAIMS, ETC.
RAILWAY AND RIGHT OF WAY
UTILITY LINES
NON PERENNIAL STREAM
FLOODING OR FLOODING RIGHTS
SUBDIVISION OR COMPOSITE PLAN
RESERVATIONS
ORIGINAL SHORELINE
MARSH OR MUSKEG
MINES
TRAVERSE MONUMENT
DISPOSITION OF CROWN LANDS
TYPE OF DOCUMENT SYMBOL
PATENT, SURFACE & MINING RIGHTS
SURFACE RIGHTS ONLY
MINING RIGHTS ONLY
LEASE SURFACE & MINING RIGHTS
SURFACE RIGHTS ONLY
MINING RIGHTS ONLY
LICENCE OF OCCUPATION
ORDER IN COUNCIL
RESERVATION
CANCELLED
SAND & GRAVEL
NOTE: MINING RIGHTS IN PARCELS PATENTED PRIOR TO MAY 6, 1913, VESTED IN ORIGINAL PATENTEE BY THE PUBLIC LANDS ACT, R.S.O. 1970, CHAP. 380, SEC. 45
SCALE: 1 INCH = 40 CHAINS
AREA
SEELEY LAKE
M.N.R. ADMINISTRATIVE DISTRICT
TERRACE BAY
MINING DIVISION
THUNDER BAY
LAND TITLES / REGISTRY DIVISION
THUNDER BAY
Ministry of Natural Resources
Land Management Branch
Ontario
FEBRUARY 1982
G-613

MARTINET LAKE G-601

REFERENCES

AREAS WITHDRAWN FROM DISPOSITION

SR SURFACE RIGHTS MR MINING RIGHTS

DESCRIPTION	ORDER #	DATE	DISPOSITION	FILE
R1	W-4370		NO STAKING ALLOWED	
R2 SEC 33/80	W72/92	92/04/27	SRO	

DETAIL PLAN OF YPRES POINT

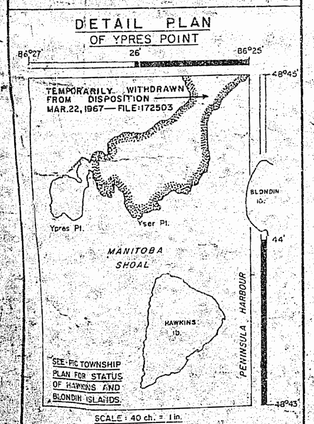

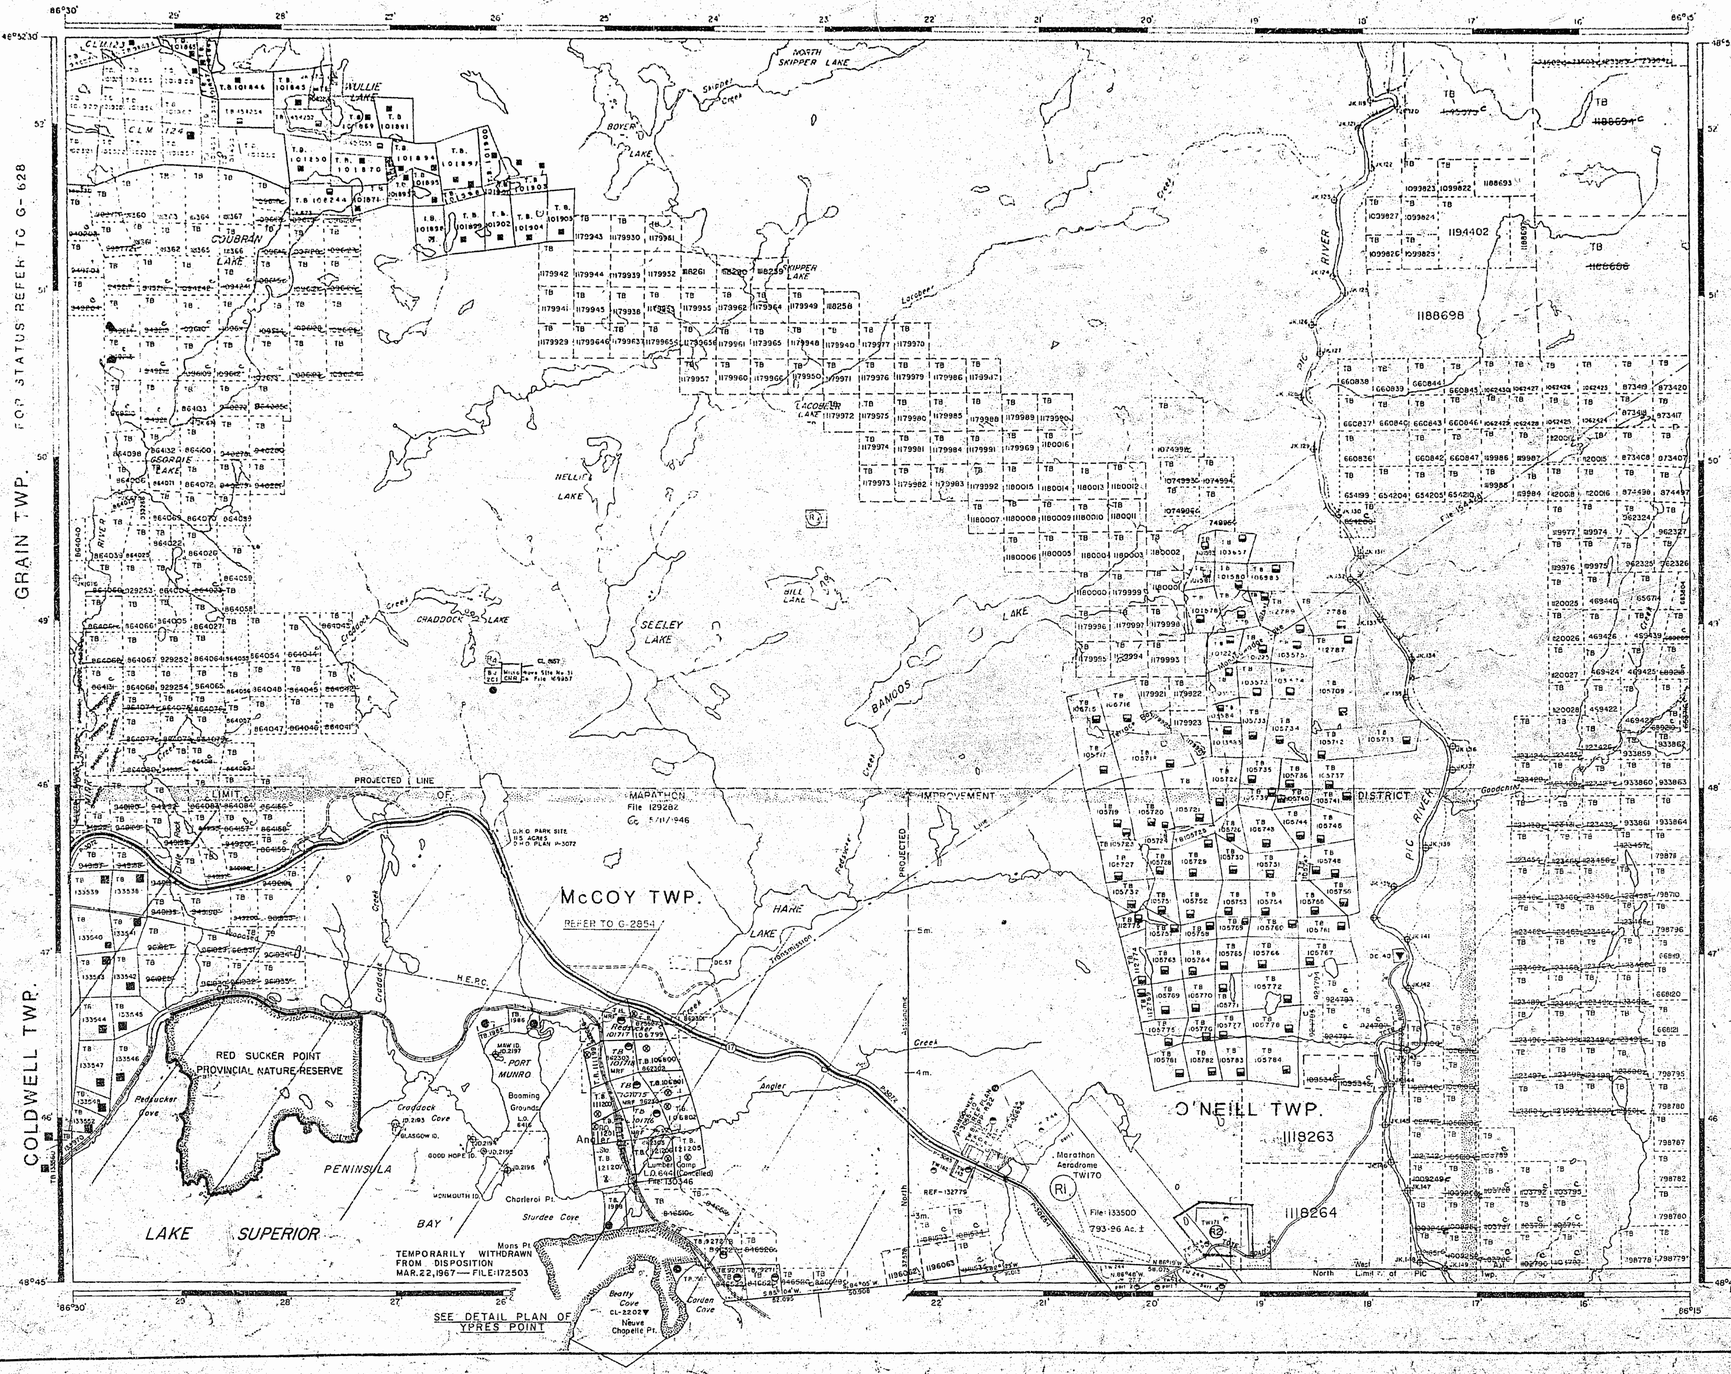
GRAIN TWP.
FOR STATUS REFER TO G-628
COLDWELL TWP.
McCOY TWP.
REFER TO G-2854
O'NEILL TWP.
LAKE SUPERIOR
BAY
PENINSULA
RED SUCKER POINT PROVINCIAL NATURE RESERVE
PROJECTED LINE OF IMPROVEMENT
LIMIT OF MARATHON DISTRICT
MARATHON File 129282 Co. 5/11/1946
TEMPORARILY WITHDRAWN FROM DISPOSITION MAR.22, 1967 — FILE: 172503
SEE DETAIL PLAN OF YPRES POINT
Marathon Aerodrome TWP70
File 133500
793-96 Ac. ±
1188263
1188264
1194402
1188698
1188694
1188696
1196063
SEELEY LAKE
BOYER LAKE
WILLIE LAKE
COUBRAN LAKE
GSORDIE LAKE
CHADDOCK LAKE
NORTH SKIPPER LAKE
SKIPPER LAKE
HARE LAKE
BANGOS Creek
P.I.C. RIVER
Goodchild
Peducker Cove
Croddock Cove
Sturdee Cove
Angler Point
Mans Pt.
Beatty Cove
Loran Cove
Nieuve Chapelle Pt.
PORT MUNRO
Booming Grounds
Lumber Loading (Cancelled) File: 130146
Marathon Water Supply
Reserve 11777 105799
105900
105901
MARTINET LAKE G-601

REFERENCES

AREAS WITHDRAWN FROM DISPOSITION

S.R.–SURFACE RIGHTS M.R.–MINING RIGHTS

DESCRIPTION	ORDER #	DATE	DISPOSITION	FILE
R1	W-43/81		NO STAKING ALLOWED	
R2	SEC. 35/90	W22/92	92/04/27	S.R.O.
R3	SEC. 36/80	W28/83	20/10/83	S.R.O.
~~R4~~	~~SEC. 36/80~~	~~W3/82~~	~~09/06/82~~	~~S.R.O.~~

~~REOPENED ORDER NO.O-TB-7/86 WITHDRAWN~~

~~R5 SURFACE AND MINING RIGHTS WITHDRAWN FROM STAKING WHILE APPLICATION FOR RELIEF FROM FORFEITURE IS BEING CONSIDERED W-TB-83/90 WITHDRAWN NOV. 01/90~~
~~- 5 per claim 965004-~~

REOPENED M&S. O-TB-35/96 NWR.
Dated 96/Dec/03. Previously withdrawn under W-TB-83/95.
Relief from forfeiture granted.

R6 - PENDING PROCEEDING

FOR STATUS REFER TO G-628

GRAIN TWP.

COLDWELL TWP.

McCOY TWP.
REFER TO G-2854.

O'NEILL TWP.

LORNA LAKE G-538

1209666 1209682 1209683 1209669 1209684 1184283 1184297

1202195 1205115. 1206869 1205198 1205197 1207871 1208590 1216508

1216535 1216534 1216536 1216537 1216539 1216538 1216677 1216676 1216679 1216529 1216530

1151040 1151042 1210337

COUBRAN LAKE
WILLIE LAKE
NORTH SKIPPER LAKE
SKIPPER LAKE
BOYER LAKE
LACOSEER LAKE
GEORGIE LAKE
NELLIE LAKE
SEELEY LAKE
BILL LAKE
BAMOOS LAKE
CRADDOCK LAKE
HARE LAKE
RED SUCKER POINT PROVINCIAL NATURE RESERVE
PENINSULA
LAKE SUPERIOR
BAY
PORT MUNRO
Booming Grounds
Lumber Camp L.D.6446 (Cancelled) File 150346
Marathon Aerodrome TW170 File 133500 793-96 Ac. ±
Beatty Cove CL-2202
Nieuwe Chapelle Pt.
Corden Cove
Sturdee Cove
Charlerol Pt.
Mons Pt.
Goodchild Creek
Skipper Creek
Locobeer Creek
Redsucker Cove
Croddock Cove
Angler Creek
Pic River Indian Reserve No. 51
Micro Wave Site No. 31 CNR Co. File 169937
R.N.G. PARK SITE 15.5 ACRES D.N.D. PLAN P-3072
Withdrawn from Disposition File 150309 Nov. 25, 1980
Withdrawn from Disposition File 150309 Nov. 25, 1980
Withdrawn from Disposition File 150309 Nov. 25, 1980

MARTINET LAKE G-601

REFERENCES

AREAS WITHDRAWN FROM DISPOSITION

S.R.–SURFACE RIGHTS M.R.–MINING RIGHTS

DESCRIPTION	ORDER #	DATE	DISPOSITION	FILE
R1	W-43/81		NO STAKING ALLOWED	
R2	SEC. 35/90 W22/82	92/04/27	S.R.O.	
R3	SEC. 36/80 W28/83	20/10/83	S.R.O.	
~~R4~~	~~SEC. 36/80 W3/82~~	~~09/06/82~~	~~S.R.O.~~	
	REOPENED ORDER NO.O-TB-7/DG NWR96FEB20			
~~R5~~	~~SURFACE AND MINING RIGHTS WITHDRAWN FROM STAKING WHILE AN APPLICATION FOR RELIEF FROM FORFEITURE IS BEING CONSIDERED. W-TB-83/95 NWR NOV 01/33~~			
	~~(Per Form 66360A).~~			
	REOPENED NBS. O-TB-35/96 NWR. Dated 96/Dec/03. Previously withdrawn under W-TB-83/95. Relief from forfeiture granted.			
R6	PENDING PROCEEDING			

DETAIL PLAN OF YPRES POINT

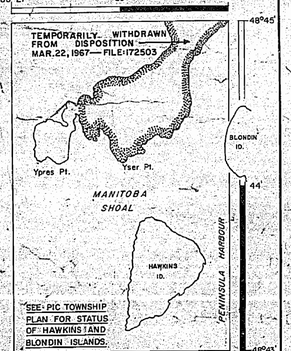

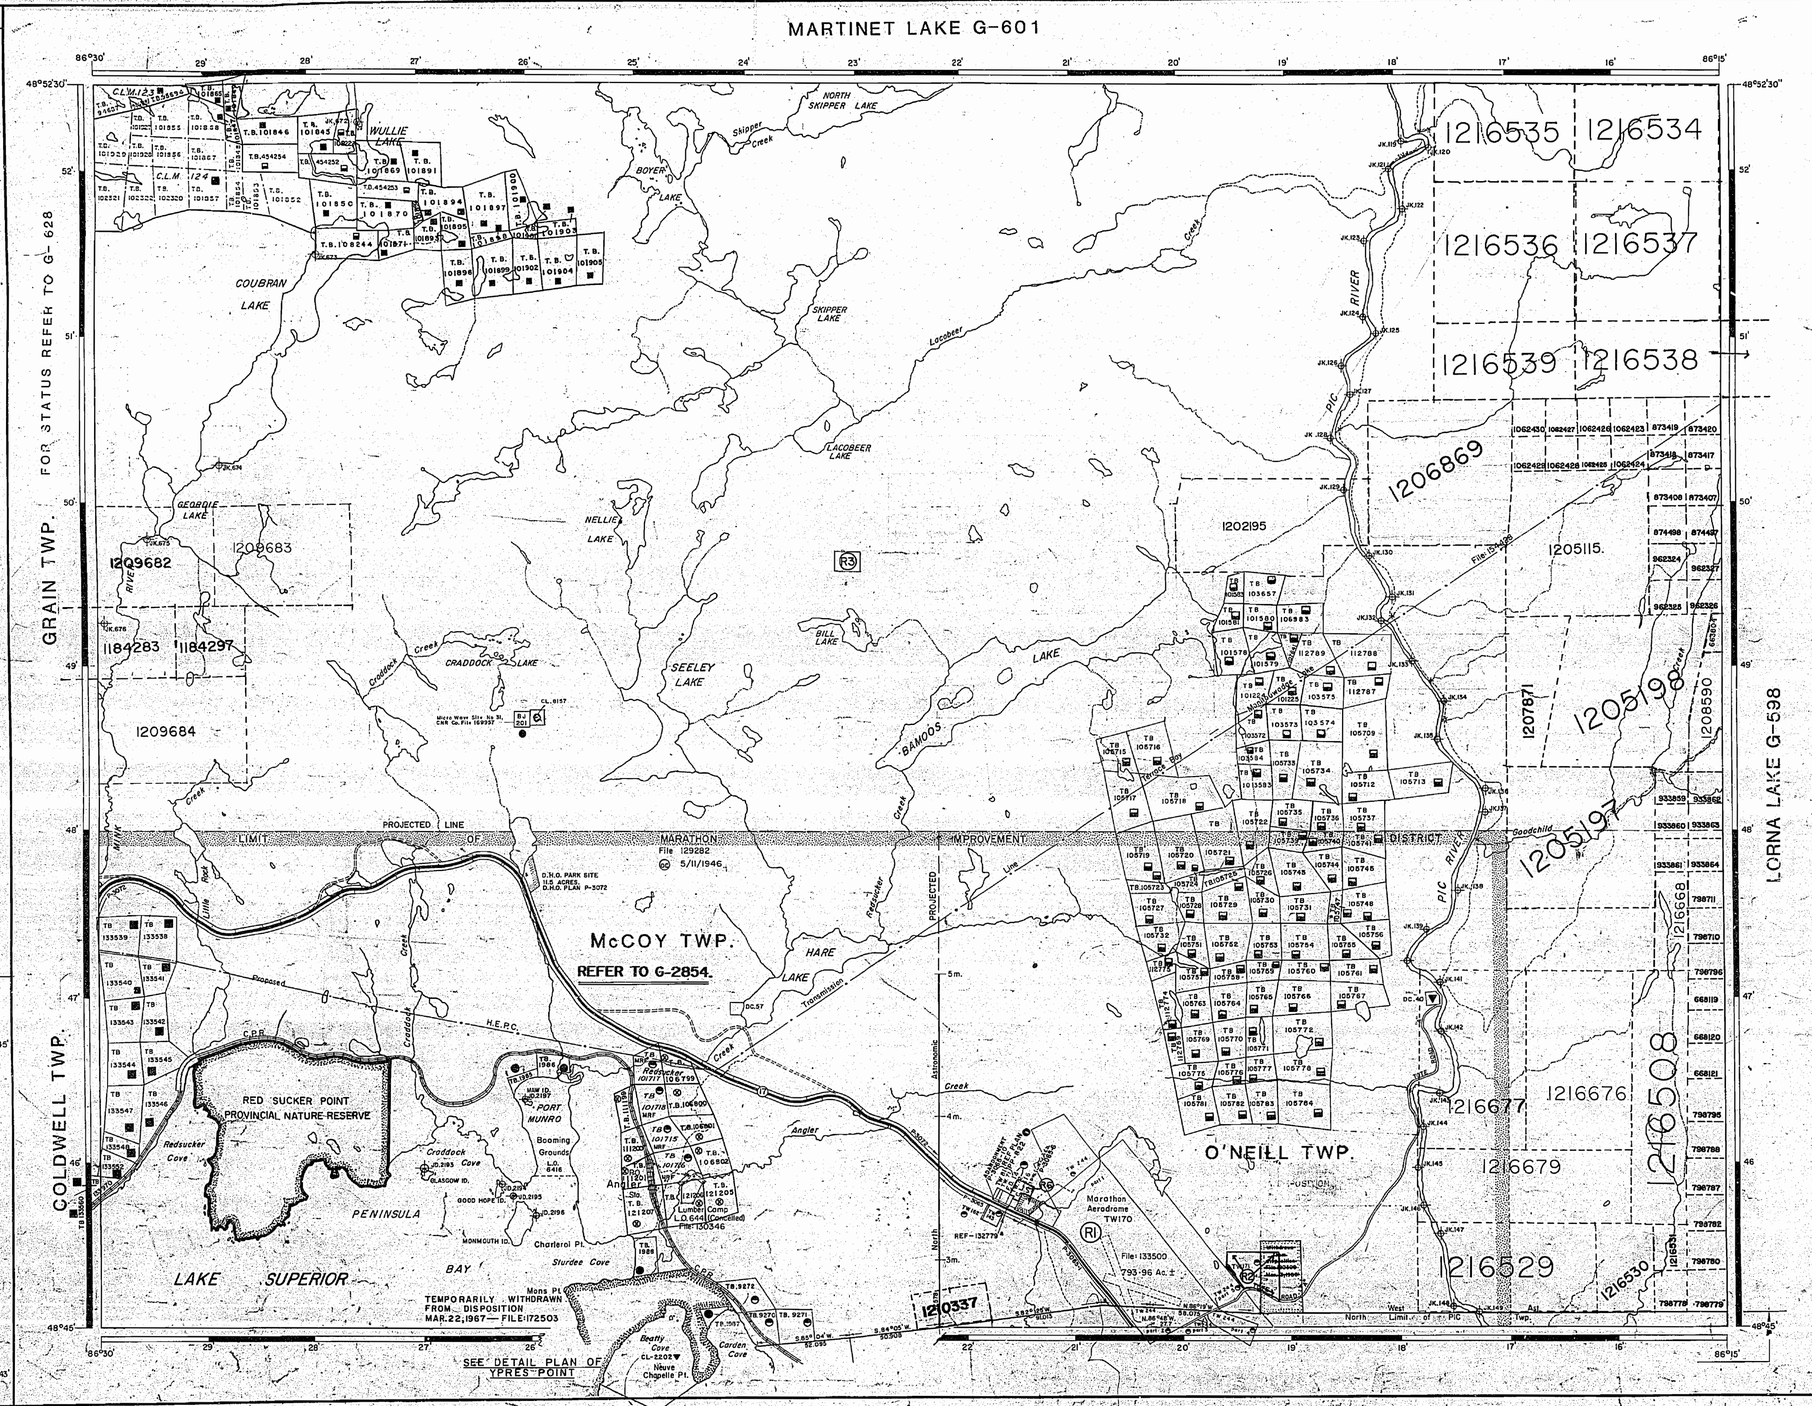
86°30'
86°15'
48°52'30"
48°45'
GRAIN TWP.
FOR STATUS REFER TO G-628
COLDWELL TWP.
McCOY TWP.
REFER TO G-2854.
O'NEILL TWP.
LORNA LAKE G-598
PROJECTED LINE OF LIMIT OF IMPROVEMENT DISTRICT
MARATHON File 129282 5/11/1946
O.N.R. PARK SITE 115 ACRES O.R.D. PLAN P-3072
WULLIE LAKE
NORTH SKIPPER LAKE
BOYER LAKE
COUBRAN LAKE
SKIPPER LAKE
LACOBEER LAKE
NELLIE LAKE
GEORGIE LAKE
SEELEY LAKE
BILL LAKE
CRADDOCK LAKE
BAMOOS LAKE
HARE LAKE
RED SUCKER POINT PROVINCIAL NATURE RESERVE
PENINSULA
LAKE SUPERIOR
BAY
PORT MUNRO
Booming Grounds
L.O. 6416
Lumber Camp
L.O. 644 (Cancelled)
File 130346
Marathon Aerodrome TW170
File: 133500
793-96 Ac. ±
REF-132779
Micro Wave Site No. 31 CNR Co. File 169937
TEMPORARILY WITHDRAWN FROM DISPOSITION — MAR.22, 1967 — FILE: 172503
SEE DETAIL PLAN OF YPRES POINT
1209682
1209683
1209684
1184283
1184297
1202195
1205115.
1205198
1205197
1207871
1206590
1206869
1216535
1216534
1216536
1216537
1216539
1216538
1216677
1216676
1216679
1216529
1216530
1216668
1216508
1220337
Proposed C.P.R.
H.E.P.C. Transmission Line
PIC RIVER
Goodchild Creek
Craddock Creek
Redsucker Cove
Craddock Cove
Sturdee Cove
Mons Pl.
Beatty Cove
Garden Cove
Nieve Chapelle Pl.
Charleroi Pl.
Good Hope Id.
Monmouth Id.
Glasgow Id.









MARTINET LAKE G-601

REFERENCE

AREAS WITHDRAWN FROM DISPOSITION

S.R. - SURFACE RIGHTS M.R. - MINING RIGHTS

	Description	Order No.	Date	Disposition	File
(S)	SSC 36710	24/83	[illegible] 782	S.R.C.	
(M)	SSC 36780	WDRT 3783	D 706 82	S.R.C.	

GRAIN TWP. FOR STATUS REFER TO G-628

COLDWELL TWP.

McCOY TWP. FOR STATUS REFER TO G-2854

LORNA LAKE G-638

FOR STATUS REFER TO G-630

LAKE SUPERIOR

PROPOSED RED SUCKER POINT PROVINCIAL NATURE RESERVE

Redsucker Cove

SEELEY LAKE

SAMCAS CREEK

PIC RIVER

NORTH SKIDDER LAKE

HARE LAKE

TEMPORARILY WITHDRAWN FROM DISPOSITION MAR 21, 1967 — FILE NO. 503

DETAIL PLAN OF YRES POINT

Yres Pt

MANITOBA SHOAL

PENINSULA RESERVE

SCALE: 40 CHAINS TO 1 INCH

SPECIFIC TOWNSHIP PLAN FOR STATUS OF HAWKINS AND GOODHUE ISLANDS.

REFERENCES

AREA SHOWN THUS [illegible] IS WITHDRAWN FROM STAKING PURSUANT TO PROVISIONS OF SECTION 32 OF THE MINING ACT, R.S.O. 1980, CHAPTER 268.

DISPOSITION IS BY EXPLORATORY LICENCE OF OCCUPATION ONLY.

LAND UNDER WATER IN LAKE SUPERIOR IS WITHDRAWN FROM STAKING BY ORDER IN COUNCIL, DATED APRIL 30, 1912

LEGEND

- RAILWAY LINE
- OTHER ROADS
- TRAILS
- SURVEYED LINES
  - TOWNSHIP, BOUNDARY
  - OTHER
- UNSURVEYED LINES
  - LOT LINES
  - PARCEL BOUNDARY
  - MINING CLAIM ETC.
- RAILWAY STATION
- OTHER LINES
- NON PERENNIAL STREAM
- FLOODING OR FLOODING RIGHTS
- SUBDIVISION OR COMPOSITE PLAN
- RESERVATIONS
- ORIGINAL SHORE LINE
- MARSH OR MUSKEG
- MINES
- TRAVERSE MONUMENT

DISPOSITION OF CROWN LANDS

TYPE OF DOCUMENT	SYMBOL
PATENT, SURFACE & MINING RIGHTS	
" SURFACE RIGHTS ONLY	
" MINING RIGHTS ONLY	
LEASE SURFACE & MINING RIGHTS	
" SURFACE RIGHTS ONLY	
" MINING RIGHTS ONLY	
LICENCE OF OCCUPATION	
ORDER IN COUNCIL	
RESERVATION	
CANCELLED	
SAND & GRAVEL	

NOTE: MINING RIGHTS & PARCELS PATENTED PRIOR TO MAY 1ST, 1913 ARE HELD IN FEE SIMPLE. PATENTS IN THE PUBLIC LANDS ACT, R.S.O. 1970 CHAP. 380 SEC. 81(1) & (2).

SCALE: 1 INCH = 40 CHAINS

AREA

SEELEY LAKE

M.N.R. ADMINISTRATIVE DISTRICT

TERRACE BAY

MINING DIVISION

THUNDER BAY

LAND TITLES / REGISTRY DIVISION

THUNDER BAY

Ministry of Natural Resources — Land Management Branch — Ontario

DATE: FEBRUARY 1982

OUT OF SERVICE NOV.9/89.

G-612

MARTINET LAKE G-601

GRAIN TWP. FOR STATUS REFER TO G-626

COLDWELL TWP.

McCOY TWP. FOR STATUS REFER TO G-2864

O'NEIL TWP.

LORNA LAKE G-598

PROPOSED RED SUCKER POINT PROVINCIAL NATURE RESERVE

LAKE SUPERIOR

MARATHON Fee 102282 Feb 5/1946

PROJECTED LIMIT OF TOWNSITE

Marathon Aerodrome W17C

Elev. 1176

File 2500 705.36 Ac. ±

Redsucker Cove

Peninsula

Angler Creek

Angler Lake

Seeley Lake

Bill Lake

Hare Lake

Gamgos Creek

North Skipden Lake

Skipden Lake

Lorna Lake

Pic River

Pic River Indian Reserve No. 51




























































































MARTINET LAKE G-601

REFERENCES

AREAS WITHDRAWN FROM DISPOSITION

S.R. – SURFACE RIGHTS M.R. – MINING RIGHTS

	Description	Order No.	Date	Disposition	File
⊗	SEC 36/45	1 26/83	20/7/83	S.R.	
⊗	SEC 36/80	WNCR 3/82	01/06/82	S.R.	

RECEIVED
THUNDER BAY
MINING DIVISION
'89 MAY 17 AM 11 07

GRAIN TWP. FOR STATUS REFER TO G-624

COLDWELL TWP.

McCOY TWP
FOR STATUS REFER TO G-2854

LAKE SUPERIOR

LORNA LAKE G-598

ONEIL TWP. FOR STATUS REFER TO G-630

PROPOSED
(RED SUCKER POINT)
PROVINCIAL NATURE RESERVE

SEELEY LAKE

HARE LAKE

DISTRICT

DETAIL PLAN
OF SHORE POINT

TEMPORARILY WITHDRAWN FROM DISPOSITION MAR 5 1987 – FILE 1503

Yates Pt

Shoal

PENINSULA AVENUE

SEE PIC TOWNSHIP PLAN FOR STATUS OF HAWKINS AND BOWDIN ISLANDS

SCALE 40 CHAINS = 1 INCH

REFERENCES

AREAS SHOWN THUS [illegible] IS WITHDRAWN FROM STAKING PURSUANT TO PROVISIONS OF SECTION 32 OF THE MINING ACT, R.S.O. 1980, CHAPTER 268.
DISPOSITION BY EXPLORATORY LICENCE OF OCCUPATION ONLY.

LAND UNDER WATER IN LAKE SUPERIOR IS WITHDRAWN FROM STAKING BY ORDER IN COUNCIL, DATED APRIL 30, 1912.

LEGEND

- MINES ×
- TRAVERSE MONUMENT ⊕

DISPOSITION OF CROWN LANDS

TYPE OF DOCUMENT	SYMBOL
PATENT, SURFACE & MINING RIGHTS	●
SURFACE RIGHTS ONLY	○
MINING RIGHTS ONLY	◐
LEASE, SURFACE & MINING RIGHTS	▲
SURFACE RIGHTS ONLY	△
MINING RIGHTS ONLY	◭
LICENCE OF OCCUPATION	■
ORDER IN COUNCIL	▼
RESERVATION	⊗
CANCELLED	⊘
SAND & GRAVEL	⊙

NOTE: MINING RIGHTS INCLUDE ALL BASE AND PRECIOUS METALS AND INDUSTRIAL MINERALS EXCEPT SAND AND GRAVEL UNLESS OTHERWISE NOTED.

SCALE: 1 INCH = 40 CHAINS

AREA
SEELEY LAKE

M.N.R. ADMINISTRATIVE DISTRICT
TERRACE BAY

MINING DIVISION
THUNDER BAY

LAND TITLES / REGISTRY DIVISION
THUNDER BAY

Ministry of Natural Resources — Land Management Branch — Ontario

DATE: FEBRUARY 1982

Number
G-613

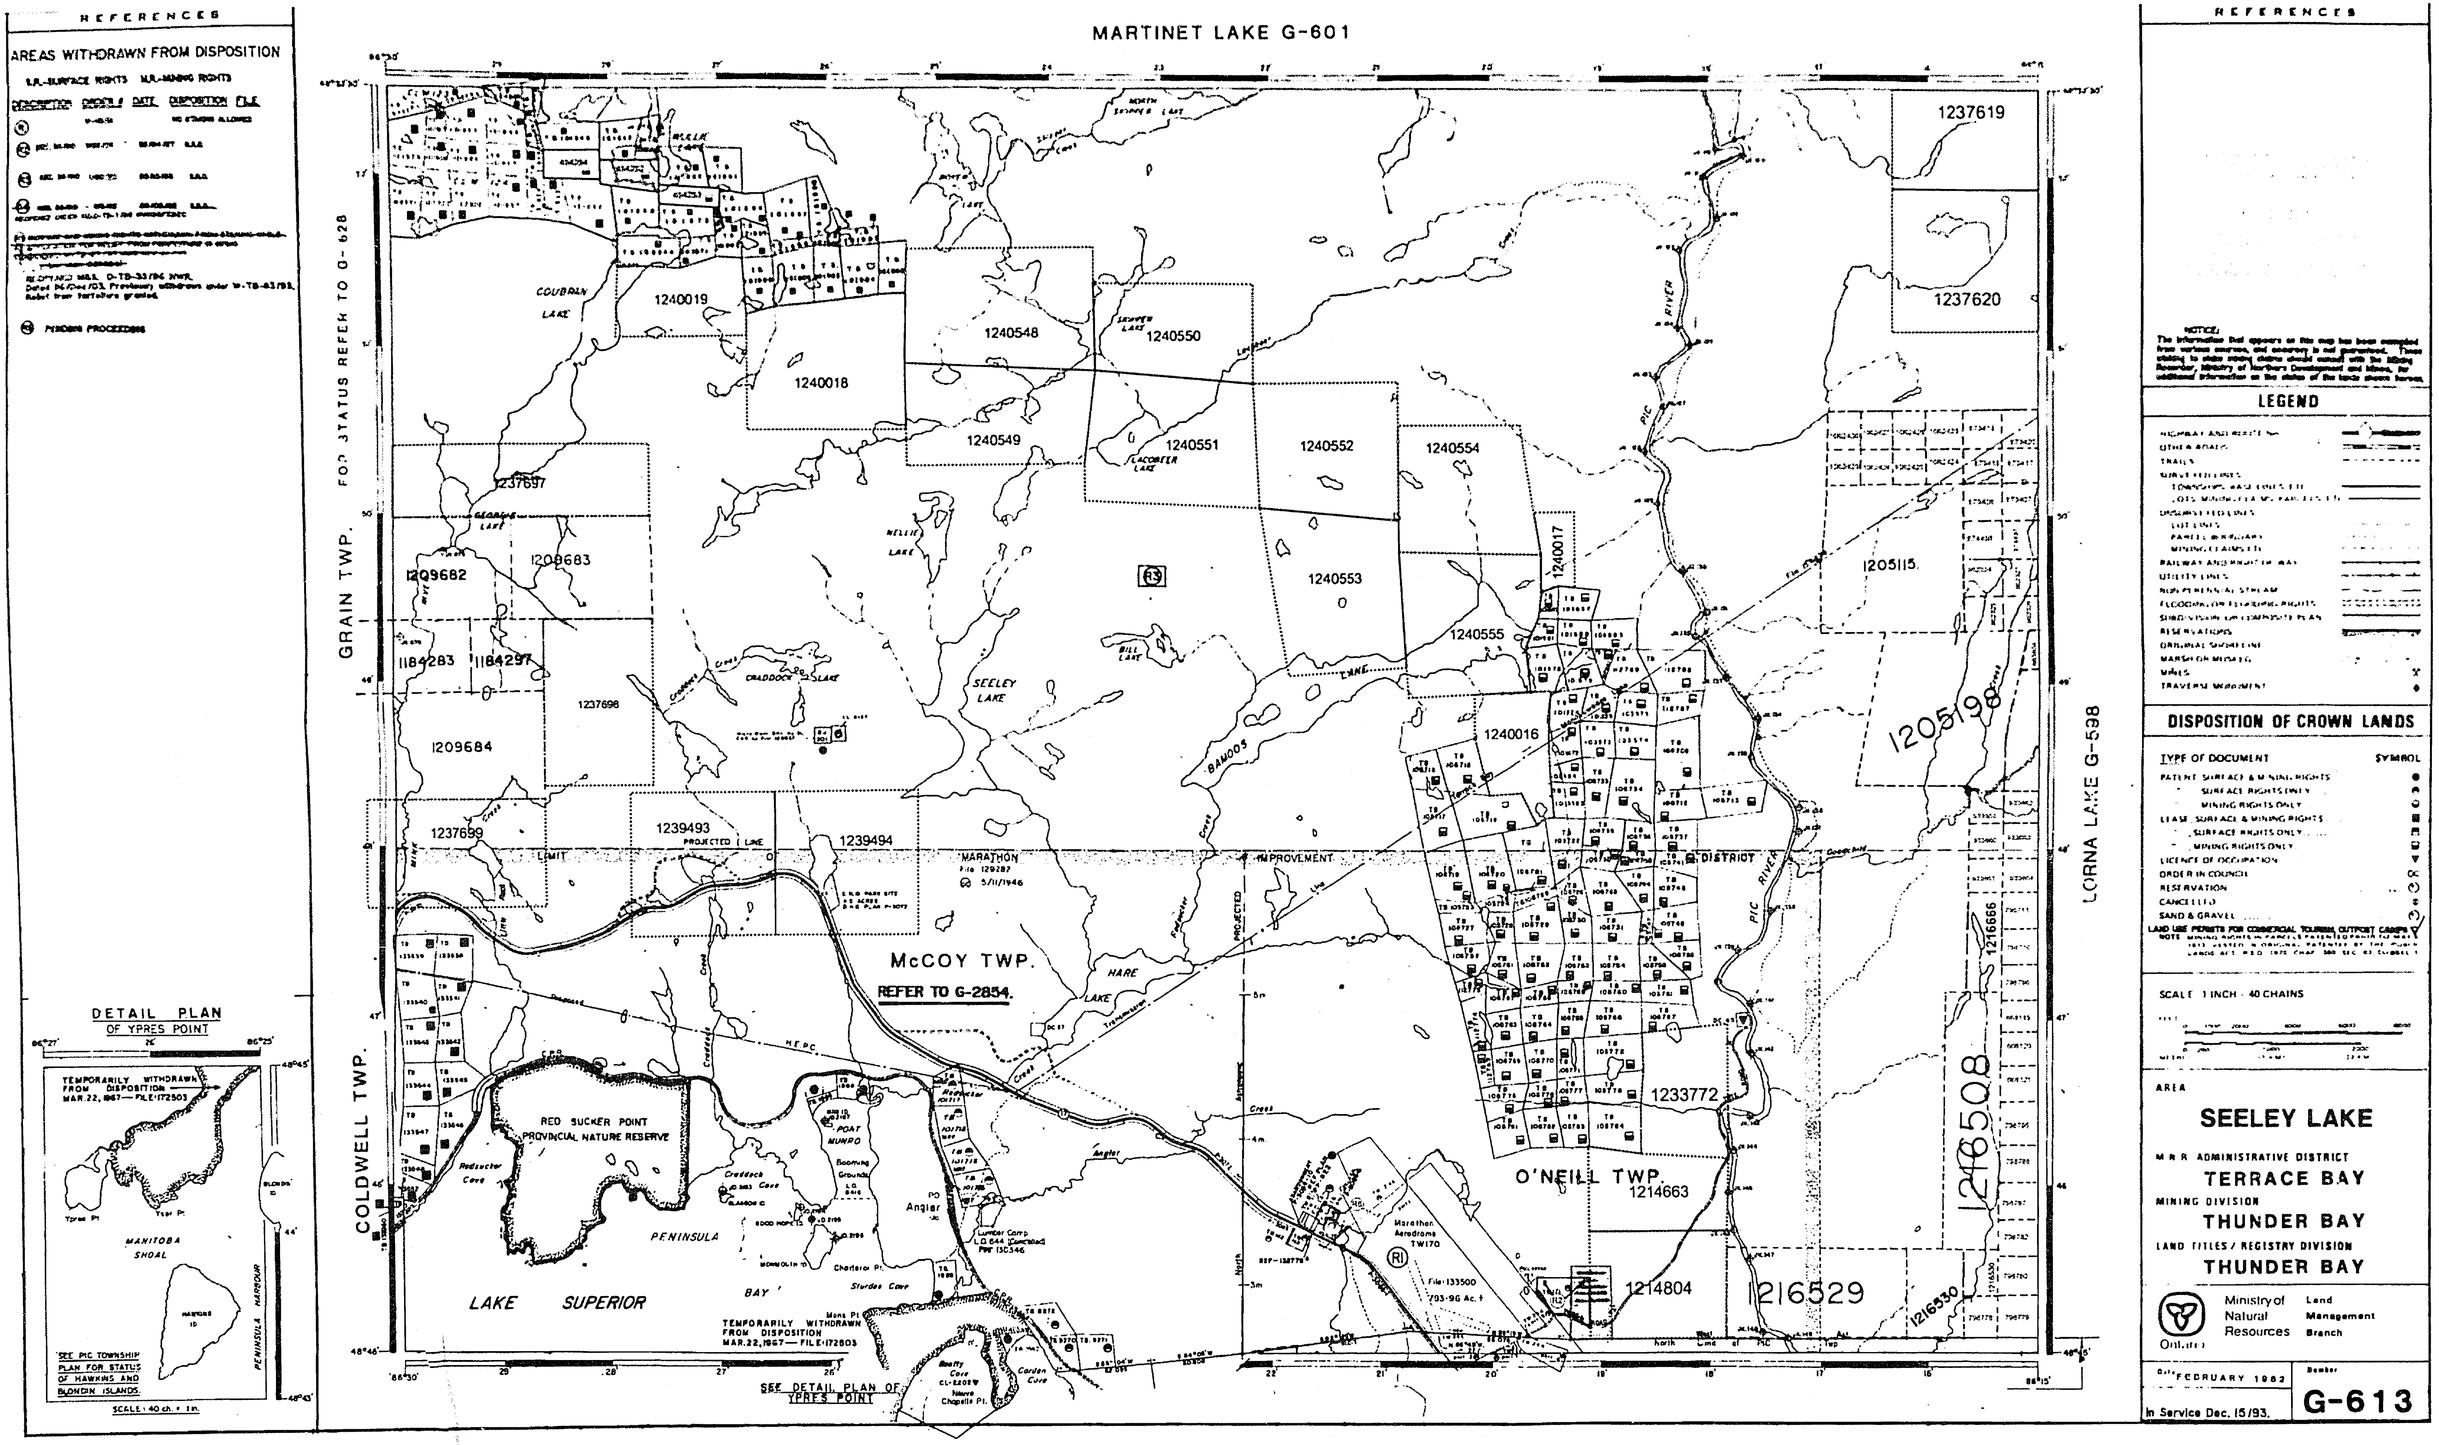

MARTINET LAKE G-601
REFERENCES
AREAS WITHDRAWN FROM DISPOSITION
S.R.-SURFACE RIGHTS M.R.-MINING RIGHTS
DESCRIPTION ORDER # DATE DISPOSITION FILE
PENDING PROCEEDINGS
GRAIN TWP.
FOR STATUS REFER TO G-628
COLDWELL TWP.
LORNA LAKE G-598
McCOY TWP.
REFER TO G-2854.
O'NEILL TWP.
COUBRAN LAKE
SEELEY LAKE
NELLIE LAKE
CRADDOCK LAKE
BAMOOS LAKE
HARE LAKE
PIC RIVER
RED SUCKER POINT PROVINCIAL NATURE RESERVE
PENINSULA BAY
LAKE SUPERIOR
MARATHON
IMPROVEMENT
DISTRICT
1240019
1240018
1240548
1240549
1240550
1240551
1240552
1240553
1240554
1240555
1240016
1240017
1237619
1237620
1237697
1209682
1209683
1184283
1184297
1237698
1209684
1237699
1239493
1239494
1205115
1205198
1216666
1216508
1233772
1214663
1214804
1216529
1216530
TEMPORARILY WITHDRAWN FROM DISPOSITION MAR.22,1967—FILE 172503
SEE DETAIL PLAN OF YPRES POINT
DETAIL PLAN OF YPRES POINT
TEMPORARILY WITHDRAWN FROM DISPOSITION MAR.22,1967—FILE 172503
MANITOBA SHOAL
PENINSULA HARBOUR
SEE PIC TOWNSHIP PLAN FOR STATUS OF HAWKINS AND BLONDIN ISLANDS.
SCALE: 40 ch. = 1 in.
REFERENCES
NOTICE:
LEGEND
DISPOSITION OF CROWN LANDS
TYPE OF DOCUMENT
SYMBOL
PATENT SURFACE & MINING RIGHTS
SURFACE RIGHTS ONLY
MINING RIGHTS ONLY
LEASE SURFACE & MINING RIGHTS
SURFACE RIGHTS ONLY
MINING RIGHTS ONLY
LICENCE OF OCCUPATION
ORDER IN COUNCIL
RESERVATION
CANCELLED
SAND & GRAVEL
LAND USE PERMITS FOR COMMERCIAL TOURISM, OUTPOST CAMPS
SCALE 1 INCH - 40 CHAINS
AREA
SEELEY LAKE
M.N.R. ADMINISTRATIVE DISTRICT
TERRACE BAY
MINING DIVISION
THUNDER BAY
LAND TITLES / REGISTRY DIVISION
THUNDER BAY
Ministry of Natural Resources
Ontario
Land Management Branch
FEBRUARY 1982
In Service Dec. 15/93.
G-613

MARTINET LAKE G-601

REFERENCES

AREAS WITHDRAWN FROM DISPOSITION

S.R.–SURFACE RIGHTS M.R.–MINING RIGHTS

DESCRIPTION	ORDER #	DATE	DISPOSITION FILE
(R1)	W-43/81		NO STAKING ALLOWED
(R2)	SEC. 35/90	W22/92	92/04/27 S.R.O.
(R3)	SEC. 36/80	W28/83	20/10/83 S.R.O.
~~(R4)~~	~~SEC. 36/80~~	~~W3/82~~	~~09/06/82 S.R.O.~~

REOPENED ORDER NO.0-TB-7/86 NWR96FEB20

~~(R5) SURFACE AND MINING RIGHTS WITHDRAWN FROM STAKING WHILE APPLICATION FOR RELIEF FROM FORFEITURE IS BEING CONSIDERED W-TB-83/95 NWR NOV 01/95~~

~~(Per Instr 960904)~~

REOPENED M&S, O-TB-35/96 NWR,
Dated 96/Dec/03. Previously withdrawn under W-TB-83/95,
Relief from forfeiture granted.

(R6) PENDING PROCEEDING

DETAIL PLAN OF YPRES POINT

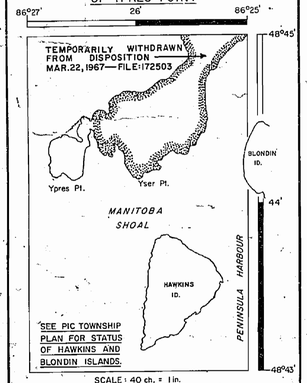

SCALE: 40 ch. = 1 in.

FOR STATUS REFER TO G-628

GRAIN TWP.

COLDWELL TWP.

McCOY TWP.
REFER TO G-2854.

O'NEILL TWP.

LORNA LAKE G-538

WULLIE LAKE
BOYER LAKE
NORTH SKIPPER LAKE
SKIPPER LAKE
LACOSEER LAKE
COLBRAN LAKE
GEORGIE LAKE
NELLIE LAKE
SEELEY LAKE
BILL LAKE
CRADDOCK LAKE
HARE LAKE
BAMOOS Creek
Skipper Creek
Lacoseer Creek
Crowduck Creek
Little Redsucker Creek
Redsucker Creek
Croddock Creek
Frederick Creek
Antoinette Creek
PIC RIVER
Goodchild Creek
Terrace Bay Creek
Flier Creek
Little Pic River

RED SUCKER POINT PROVINCIAL NATURE RESERVE
PENINSULA
LAKE SUPERIOR
BAY
Redsucker Cove
Croddock Cove
Sturdee Cove
Corden Cove
Beatty Cove
Nieuve Chapelle Pl.
Mons Pt.
Charleroi Pt.
Monmouth Id.
Glasgow Id.
Good Hope Id.
PORT MUNRO
Booming Grounds
L.O. 6416
Lumber Camp
L.O.6441 (Cancelled)
File 130346
Marathon Aerodrome TWI70
File: 133500
793-96 Ac. ±
Winnipeg, Fort Frances & Port Arthur Ry. Co. Plan 160509 Mar. 15, 1900
Abandoned Canadian Pacific Railway
Proposed C.P.R.
H.E.P.C. Transmission Line
PROJECTED LINE OF MARATHON IMPROVEMENT DISTRICT
PROJECTED North Limit of PIC Twp.
MARATHON File 129282 (R2) 5/11/1946
D.N.O. PARK SITE 15.5 ACRES D.N.O. PLAN P-3072
TEMPORARILY WITHDRAWN FROM DISPOSITION MAR.22,1967 — FILE:172503
REF-132779
SEE DETAIL PLAN OF YPRES POINT

1216535 1216534
1216536 1216537
1216539 1216538
1206869
1202195
1205115
1183022
1183023
1207871
1205198
1207864
1205197
1207872
1205111
1205112
1216676
1216677
1216679
1205113
1216529
1216530
1216508
1151040
1151042
1210337
1209666
1209682
1209683
1209669
1209684
1184283
1184297
H84285

REFERENCES

DATE OF ISSUE
MAR 1 3 1998
PROVINCIAL RECORDING OFFICE - SUDBURY

NOTICE:
The information that appears on this map has been compiled from various sources, and accuracy is not guaranteed. Those wishing to stake mining claims should consult with the Mining Recorder, Ministry of Northern Development and Mines, for additional information on the status of the lands shown hereon.

LEGEND

- HIGHWAY AND ROUTE No
- OTHER ROADS
- TRAILS
- SURVEYED LINES
  - TOWNSHIPS, BASE LINES, ETC
  - LOTS, MINING CLAIMS, PARCELS, ETC
- UNSURVEYED LINES
  - LOT LINES
  - PARCEL BOUNDARY
  - MINING CLAIMS ETC.
- RAILWAY AND RIGHT OF WAY
- UTILITY LINES
- NON-PERENNIAL STREAM
- FLOODING OR FLOODING RIGHTS
- SUBDIVISION OR COMPOSITE PLAN
- RESERVATIONS
- ORIGINAL SHORELINE
- MARSH OR MUSKEG
- MINES
- TRAVERSE MONUMENT

DISPOSITION OF CROWN LANDS

TYPE OF DOCUMENT	SYMBOL
PATENT, SURFACE & MINING RIGHTS	●
" , SURFACE RIGHTS ONLY	◒
" , MINING RIGHTS ONLY	◓
LEASE, SURFACE, & MINING RIGHTS	■
" , SURFACE RIGHTS ONLY	◪
" , MINING RIGHTS ONLY	◩
LICENCE OF OCCUPATION	▼
ORDER-IN-COUNCIL	OC
RESERVATION	(R)
CANCELLED	⊗
SAND & GRAVEL	(G)

LAND USE PERMITS FOR COMMERCIAL TOURISM, OUTPOST CAMPS (V)
NOTE: MINING RIGHTS IN PARCELS PATENTED PRIOR TO MAY 6, 1913, VESTED IN ORIGINAL PATENTEE BY THE PUBLIC LANDS ACT, R.S.O. 1970, CHAP. 380, SEC. 63, SUBSEC 1.

SCALE: 1 INCH = 40 CHAINS

FEET 0 1000 2000 4000 6000 8000
METRES 0 200 400 1000 2000 (1 KM) (2 KM)

AREA
SEELEY LAKE
M.N.R. ADMINISTRATIVE DISTRICT
TERRACE BAY
MINING DIVISION
THUNDER BAY
LAND TITLES / REGISTRY DIVISION
THUNDER BAY

Ontario Ministry of Natural Resources — Land Management Branch

DATE FEBRUARY 1982
Number **G-613**
In Service Dec. 15/93.

MARTINET LAKE G-601

REFERENCES

AREAS WITHDRAWN FROM DISPOSITION

S.R. - SURFACE RIGHTS M.R. - MINING RIGHTS

	Description	Order No.	Date	Disposition	File
(26)	SEC 36/60	1 28/63	20/10/83	S R C	
	SEC 36/60	WAIVER 5/83	04/08/83	S R C	

RECEIVED
THUNDER BAY
DIVISION
'88 APR 18 PM 6 52

FOR STATUS REFER TO G-628

GRAIN TWP.

COLDWELL TWP.

McCOY TWP.
FOR STATUS REFER TO G-2854

O'NEILL TWP.
FOR STATUS REFER TO G-630

LORNA LAKE G-598

NORTH SNIPER LAKE
SNIPER CREEK
GRAIN LAKE
KELLEY LAKE
SEELEY LAKE
GILL LAKE
GEORDIE LAKE
LAKE SUPERIOR
BAMGOS CREEK
PROJECTED LIMIT OF IMPROVEMENT DISTRICT
MARATHON File 123462 to 5/11/1946
PROPOSED RED SUCKER POINT PROVINCIAL NATURE RESERVE
PENINSULA BAY
PORT JUNO
Redsucker Cove
Sucker Cove
Angler
Marathon Aerodrome TWI7O
File 13500
TEMPORARILY WITHDRAWN FROM DISPOSITION MAR 22, 1967 — FILE 172503
SEE DETAIL PLAN OF YPRES POINT
* STAKED FOR QUARRY MATERIAL
SEE PIC TWP. FOR STATUS REFER TO G-630

DETAIL PLAN OF YPRES POINT

TEMPORARILY WITHDRAWN FROM DISPOSITION — MAR. 22, 1967 — FILE 172503

Ypres Pt
Tyser Pt
MANITOBA SHOAL
HAWKINS I.
PENINSULA HARBOUR
BLONDIN ISLANDS

SEE PIC TOWNSHIP PLAN FOR STATUS OF HAWKINS AND BLONDIN ISLANDS.

SCALE: 40 CHAINS TO 1 INCH

REFERENCES

AREA SHOWN THUS [illegible] IS WITHDRAWN FROM STAKING PURSUANT TO PROVISIONS OF SECTION 32 OF THE MINING ACT, R.S.O. 1980, CHAPTER 258.
DISPOSITION BY EXPLORATORY LICENCE OF OCCUPATION ONLY.

LAND UNDER WATER IN LAKE SUPERIOR WITHDRAWN FROM STAKING BY ORDER IN COUNCIL, DATED APRIL 30, 1912

LEGEND

- HIGHWAYS AND ROADS
- OTHER ROADS
- TRAILS
- SURVEYED LINES
  - TOWNSHIP, BASE LINE
  - LOTS, MINING CLAIMS, ETC.
- UNSURVEYED LINES
  - LOT LINES
  - PARCEL BOUNDARY
  - MINING CLAIMS, ETC.
- RAILWAYS AND RIGHT OF WAY
- UTILITY LINES
- NON PERENNIAL STREAM
- FLOODING OR FLOODING RIGHTS
- SUBDIVISION OR COMPOSITE PLAN
- RESERVATIONS
- ORIGINAL SHORE LINE
- MARSH OR MUSKEG
- MINES
- TRAVERSE MONUMENT

DISPOSITION OF CROWN LANDS

TYPE OF DOCUMENT	SYMBOL
PATENT, SURFACE & MINING RIGHTS	●
" SURFACE RIGHTS ONLY	○
" MINING RIGHTS ONLY	◐
LEASE, SURFACE & MINING RIGHTS	■
" SURFACE RIGHTS ONLY	□
" MINING RIGHTS ONLY	▣
LICENCE OF OCCUPATION	V
ORDER IN COUNCIL	OC
RESERVATION	R
CANCELLED	⊗
SAND & GRAVEL	S

NOTE: MINING RIGHTS IN PARCELS PATENTED PRIOR TO MAY 9, 1913, VESTED IN ORIGINAL PATENTEE BY THE PUBLIC LANDS ACT, R.S.O. 1970, CHAP. 380, SEC. 63 SUBSEC. 1

SCALE: 1 INCH = 40 CHAINS

AREA
SEELEY LAKE
M.N.R. ADMINISTRATIVE DISTRICT
TERRACE BAY
MINING DIVISION
THUNDER BAY
LAND TITLES / REGISTRY DIVISION
THUNDER BAY

Ministry of Natural Resources — Land Management Branch
Ontario

Date: FEBRUARY 1982
Number: **G-613**

MARTINET LAKE G-601

REFERENCES

AREAS WITHDRAWN FROM DISPOSITION

S.R. – SURFACE RIGHTS M.R. – MINING RIGHTS

	Description	Order No.	Date	Disposition	File
S.R.	SSE 36/10	[illegible] /83	10/ /83		3.R.3
M.R.	SSE 36/10	WMPC 3/83	07/06/83		3.R.3

REFERENCES

AREA SHOWN THUS [illegible] IS WITHDRAWN FROM STAKING PURSUANT TO PROVISIONS OF SECTION 32 OF THE MINING ACT, R.S.O. 1980, CHAPTER 268.
DISPOSITION BY EXPLORATORY LICENCE OF OCCUPATION ONLY.

LAND UNDER WATER OF LAKE SUPERIOR IS WITHDRAWN FROM STAKING BY ORDER IN COUNCIL, DATED APRIL 30, 1912.

LEGEND

- HIGHWAYS AND ROADS
- OTHER ROADS
- TRAILS
- SURVEYED LINES
  - TOWNSHIP OR BASE LINE
  - LOTS, MINING CLAIMS, ETC.
- UNSURVEYED LINES
  - LOT LINES
  - PARCEL BOUNDARY
  - MINING CLAIMS ETC.
- RAILWAYS AND RIGHTS OF WAY
- UTILITY LINES
- NON PERENNIAL STREAM
- FLOODING OR FLOODING RIGHTS
- SUBDIVISION OR COMPOSITE PLAN
- RESERVATIONS
- ORIGINAL SHORE LINE
- MARSH OR MUSKEG
- MINES
- TRAVERSE MONUMENT

DISPOSITION OF CROWN LANDS

TYPE OF DOCUMENT	SYMBOL
PATENT, SURFACE & MINING RIGHTS	
" SURFACE RIGHTS ONLY	
" MINING RIGHTS ONLY	
LEASE, SURFACE & MINING RIGHTS	
" SURFACE RIGHTS ONLY	
" MINING RIGHTS ONLY	
LICENCE OF OCCUPATION	
ORDER-IN-COUNCIL	
RESERVATION	
CANCELLED	
SAND & GRAVEL	

NOTE: MINING RIGHTS TO PARCELS PATENTED PRIOR TO MAY 6, 1913 VESTED IN ORIGINAL PATENTEE BY THE PUBLIC LANDS ACT, R.S.O. 1970, CHAP. 380, SECTION 60 (1).

SCALE: 1 INCH = 40 CHAINS

0 100 200 300 400 500 1000 1500 2000 METRES

AREA

SEELEY LAKE

M.N.R. ADMINISTRATIVE DISTRICT

TERRACE BAY

MINING DIVISION

THUNDER BAY

LAND TITLES / REGISTRY DIVISION

THUNDER BAY

Ministry of Natural Resources — Land Management Branch — Ontario

DATE: FEBRUARY 1982

G-601

RECEIVED
THUNDER BAY
MINING DIVISION
89 OCT 13 PM 12 09

GRAIN TWP. — FOR STATUS REFER TO G-628

COLDWELL TWP.

McCOY TWP. — FOR STATUS REFER TO G-2854

LORNA LAKE G-538

LAKE SUPERIOR

NORTH SKIPPER LAKE

SKIPPER CREEK

JEAN LAKE

ELLIE LAKE

SEELEY LAKE

BILL LAKE

GUNDOCK CREEK

SAMSOS CREEK

JEUDEVINE CREEK

PIC RIVER

HARE LAKE

PROPOSED RED SUCKER POINT PROVINCIAL NATURE RESERVE

Redsucker Cove

Caledonia Creek

Anglers Cove

Strawberry Cove

Loaming Ground

PROJECTED LIMIT OF APPROPRIATION

DISTRICT

CONE

PORT ARTHUR

MARATHON File 12°202 5/11/1946

TEMPORARILY WITHDRAWN FROM DISPOSITION MAR. 27, 1967 — FILE NT.2503

TEMPORARILY WITHDRAWN FROM DISPOSITION MAR. 27, 1967 — FILE NT.1725

SEE DETAIL PLAN OF YPRES POINT

SEE TOWNSHIP PLAN FOR STATUS OF HAWKINS AND BLONDIN ISLANDS

SEE TOWNSHIP MAP FOR STATUS REFER TO G-630

DETAIL PLAN OF YPRES POINT

Ypres Pt. — Yser Pt. — MANITOBA SHOAL — BLONDIN I. — HARBOUR — PENINSULA

SCALE 1:40 ch. = 1 in.

MARTINET LAKE G-601

REFERENCES

AREAS WITHDRAWN FROM DISPOSITION

S.R.-SURFACE RIGHTS M.R.-MINING RIGHTS

DESCRIPTION	ORDER #	DATE	DISPOSITION	FILE
(R3) SEC 36/80	W28/83	20/10/83	S.R.O.	
(R4) SEC 36/80	W3/82	09/06/82	S.R.O.	
(R)	W-43/81		NO STAKING ALLOWED	
(R2) SEC 35/90 W22/92		92/04/27	S.R.O.	

GRAIN TWP. FOR STATUS REFER TO G-628

COLDWELL TWP.

McCOY TWP. REFER TO G-2854

O'NEILL TWP.

LORNA LAKE G-638

SEELEY LAKE G-613

LAKE SUPERIOR

PENINSULA BAY

RED SUCKER POINT PROVINCIAL NATURE RESERVE

PROJECTED LIMIT OF IMPROVEMENT DISTRICT

PROJECTED LINE

MARATHON File 129282 5/11/1946

D.N.D. PARK SITE 0.5 ACRES D.N.D. PLAN P-3072

Marathon Aerodrome TW17O File 133500 793-96 Ac. ±

TEMPORARILY WITHDRAWN FROM DISPOSITION MAR.22,1967 — FILE:172503

SEE DETAIL PLAN OF YPRES POINT

DETAIL PLAN OF YPRES POINT

TEMPORARILY WITHDRAWN FROM DISPOSITION MAR.22,1967 — FILE:172503

Ypres Pt. Yser Pt. MANITOBA SHOAL BLONDIN ID. HAWKINS ID. PENINSULA HARBOUR

SEE PIC TOWNSHIP PLAN FOR STATUS OF HAWKINS AND BLONDIN ISLANDS.

SCALE: 40 ch. = 1 in.

REFERENCES

THE INFORMATION THAT APPEARS ON THIS MAP HAS BEEN COMPILED FROM VARIOUS SOURCES. AND ACCURACY IS NOT GUARANTEED. THOSE WISHING TO STAKE MINING CLAIMS SHOULD CONSULT WITH THE MINING RECORDER, MINISTRY OF NORTHERN DEVELOPMENT AND MINES, FOR ADDITIONAL INFORMATION ON THE STATUS OF THE LANDS SHOWN HEREON.

LEGEND

- HIGHWAY AND ROUTE No.
- OTHER ROADS
- TRAILS
- SURVEYED LINES
  - TOWNSHIP, BASE LINE, ETC.
  - LOT, MINING CLAIM, PARCEL ETC.
- UNSURVEYED LINES
  - TIE LINES
  - PARCEL BOUNDARY
  - MINING CLAIM ETC.
- RAILWAY AND RIGHT OF WAY
- UTILITY LINES
- NON PERENNIAL STREAM
- FLOODING OR FLOODING RIGHTS
- SUBDIVISION OR COMPOSITE PLAN
- RESERVATIONS
- ORIGINAL SHORELINE
- MARSH OR MUSKEG
- MINES
- TRAVERSE MONUMENT

DISPOSITION OF CROWN LANDS

TYPE OF DOCUMENT	SYMBOL
PATENT, SURFACE & MINING RIGHTS	
SURFACE RIGHTS ONLY	
MINING RIGHTS ONLY	
LEASE, SURFACE & MINING RIGHTS	
SURFACE RIGHTS ONLY	
MINING RIGHTS ONLY	
LICENCE OF OCCUPATION	
ORDER-IN-COUNCIL	OC
RESERVATION	
CANCELLED	
SAND & GRAVEL	

LAND USE PERMITS FOR COMMERCIAL TOURISM OUTPOST CAMPS

NOTE: MINING RIGHTS IN PARCELS PATENTED PRIOR TO MAY 6, 1913, VESTED IN ONTARIO, PATENTED BY THE PUBLIC LANDS ACT, R.S.O. 1970, CHAP. 380, SEC. 50, SUBSEC. 1.

SCALE: 1 INCH 40 CHAINS

FEET 0 1000 2000 4000 6000 8000

METRES 0 200 400 

MARTINET LAKE G-601

REFERENCES

AREAS WITHDRAWN FROM DISPOSITION

S.R.–SURFACE RIGHTS M.R.–MINING RIGHTS

DESCRIPTION	ORDER #	DATE	DISPOSITION	FILE
(R1)	W-43/81		NO STAKING ALLOWED	
(R2)	SEC. 35/90	W22/92	92/04/27	S.R.O.
(R3)	SEC. 36/90	W28/93	20/10/93	S.R.O.
~~(R4)~~	~~SEC. 16/90~~	~~W3/92~~	~~09/06/92~~	~~S.R.O.~~

~~REOPENED ORDER NO.O-TB-7/96 NWR96FEB20~~

~~(R5) SURFACE AND MINING RIGHTS WITHDRAWN FROM STAKING WHILE APPLICATION FOR RELIEF FROM FORFEITURE IS BEING CONSIDERED.W-TB-83/95 NWR NOV 01/95~~

~~FOR MNR DECISION~~

REOPENED M&S. O-TB-35/96 NWR.
Dated 96/Dec/03. Previously withdrawn under W-TB-83/95.
Relief from forfeiture granted.

(R6) PENDING PROCEEDING

FOR STATUS REFER TO G-628

GRAIN TWP.

COLDWELL TWP.

McCOY TWP.
REFER TO G-2854.

O'NEILL TWP.

LORNA LAKE G-598

DETAIL PLAN OF YPRES POINT

TEMPORARILY WITHDRAWN FROM DISPOSITION MAR.22,1967— FILE:172503

SEE DETAIL PLAN OF YPRES POINT

SEE PIC TOWNSHIP PLAN FOR STATUS OF HAWKINS AND BLONDIN ISLANDS

SCALE: 40 ch. = 1 in.

TEMPORARILY WITHDRAWN FROM DISPOSITION MAR.22,1967— FILE:172503

LIMIT OF PROJECTED IMPROVEMENT DISTRICT

MARATHON File 129282 (SC) 5/11/1946

C.N.O. PARK SITE 11.5 ACRES O.N.D. PLAN P-3072

PROJECTED LINE

Marathon Aerodrome TW170 File:133500 793-96 Ac.±

REF:132779

North Limit of PIC Twp.

1216535 1216534 1216536 1216537 1216539 1216538 1206869 1202195 1205115. 1205198 1205197 1216508 1216677 1216676 1216679 1216529 1216530 1207871 1208590 1151040 1151042 1210337

1209682 1209683 1209669 1209684 1184283 1184297

RED SUCKER POINT PROVINCIAL NATURE RESERVE

PENINSULA

LAKE SUPERIOR

BAY

PORT MUNRO

Booming Grounds L.O. 6416

Lumber Camp L.O.644 (Cancelled) File:130346

Marathon Aerodrome

Mons Pt.

Beauty Cove CL-2202

Nieuve Chapelle Pt.

Corden Cove

Ypres Pt.

Tser Pt.

MANITOBA SHOAL

BLONDIN IS.

HAWKINS IS.

HARBOUR

PENINSULA

Micro Wave Site No 31, CWR Cl. Rite 169937

CL. 8157

BJ 201

REFERENCES

DATE OF ISSUE
NOV 13 1998
PROVINCIAL RECORDING OFFICE - SUDBURY

NOTICE:
The information that appears on this map has been compiled from various sources, and accuracy is not guaranteed. Those wishing to stake mining claims should consult with the Mining Recorder, Ministry of Northern Development and Mines, for additional information on the status of the lands shown hereon.

LEGEND

- HIGHWAY AND ROUTE No.
- OTHER ROADS
- TRAILS
- SURVEYED LINES:
  - TOWNSHIPS, BASE LINES, ETC.
  - LOTS, MINING CLAIMS, PARCELS, ETC.
- UNSURVEYED LINES:
  - LOT LINES
  - PARCEL BOUNDARY
  - MINING CLAIMS ETC.
- RAILWAY AND RIGHT OF WAY
- UTILITY LINES
- NON-PERENNIAL STREAM
- FLOODING OR FLOODING RIGHTS
- SUBDIVISION OR COMPOSITE PLAN
- RESERVATIONS
- ORIGINAL SHORELINE
- MARSH OR MUSKEG
- MINES
- TRAVERSE MONUMENT

DISPOSITION OF CROWN LANDS

TYPE OF DOCUMENT	SYMBOL
PATENT, SURFACE & MINING RIGHTS	●
" , SURFACE RIGHTS ONLY	●
" , MINING RIGHTS ONLY	●
LEASE, SURFACE & MINING RIGHTS	■
" , SURFACE RIGHTS ONLY	■
" , MINING RIGHTS ONLY	■
LICENCE OF OCCUPATION	▼
ORDER-IN-COUNCIL	OC
RESERVATION	(R)
CANCELLED	⊗
SAND & GRAVEL	(R)

LAND USE PERMITS FOR COMMERCIAL TOURISM, OUTPOST CAMPS
NOTE: MINING RIGHTS IN PARCELS PATENTED PRIOR TO MAY 6, 1913, VESTED IN ORIGINAL PATENTEE BY THE PUBLIC LANDS ACT, R.S.O. 1970, CHAP. 380, SEC. 63, SUBSEC 1.

SCALE: 1 INCH = 40 CHAINS

FEET 0 1000 2000 4000 6000 8000
METRES 0 200 1000 2000
(1 KM) (2 KM)

AREA
SEELEY LAKE

M.N.R. ADMINISTRATIVE DISTRICT
TERRACE BAY

MINING DIVISION
THUNDER BAY

LAND TITLES / REGISTRY DIVISION
THUNDER BAY

Ministry of Natural Resources — Land Management Branch
Ontario

Date FEBRUARY 1982
Number **G-613**
In Service Dec. 15/93.

1861

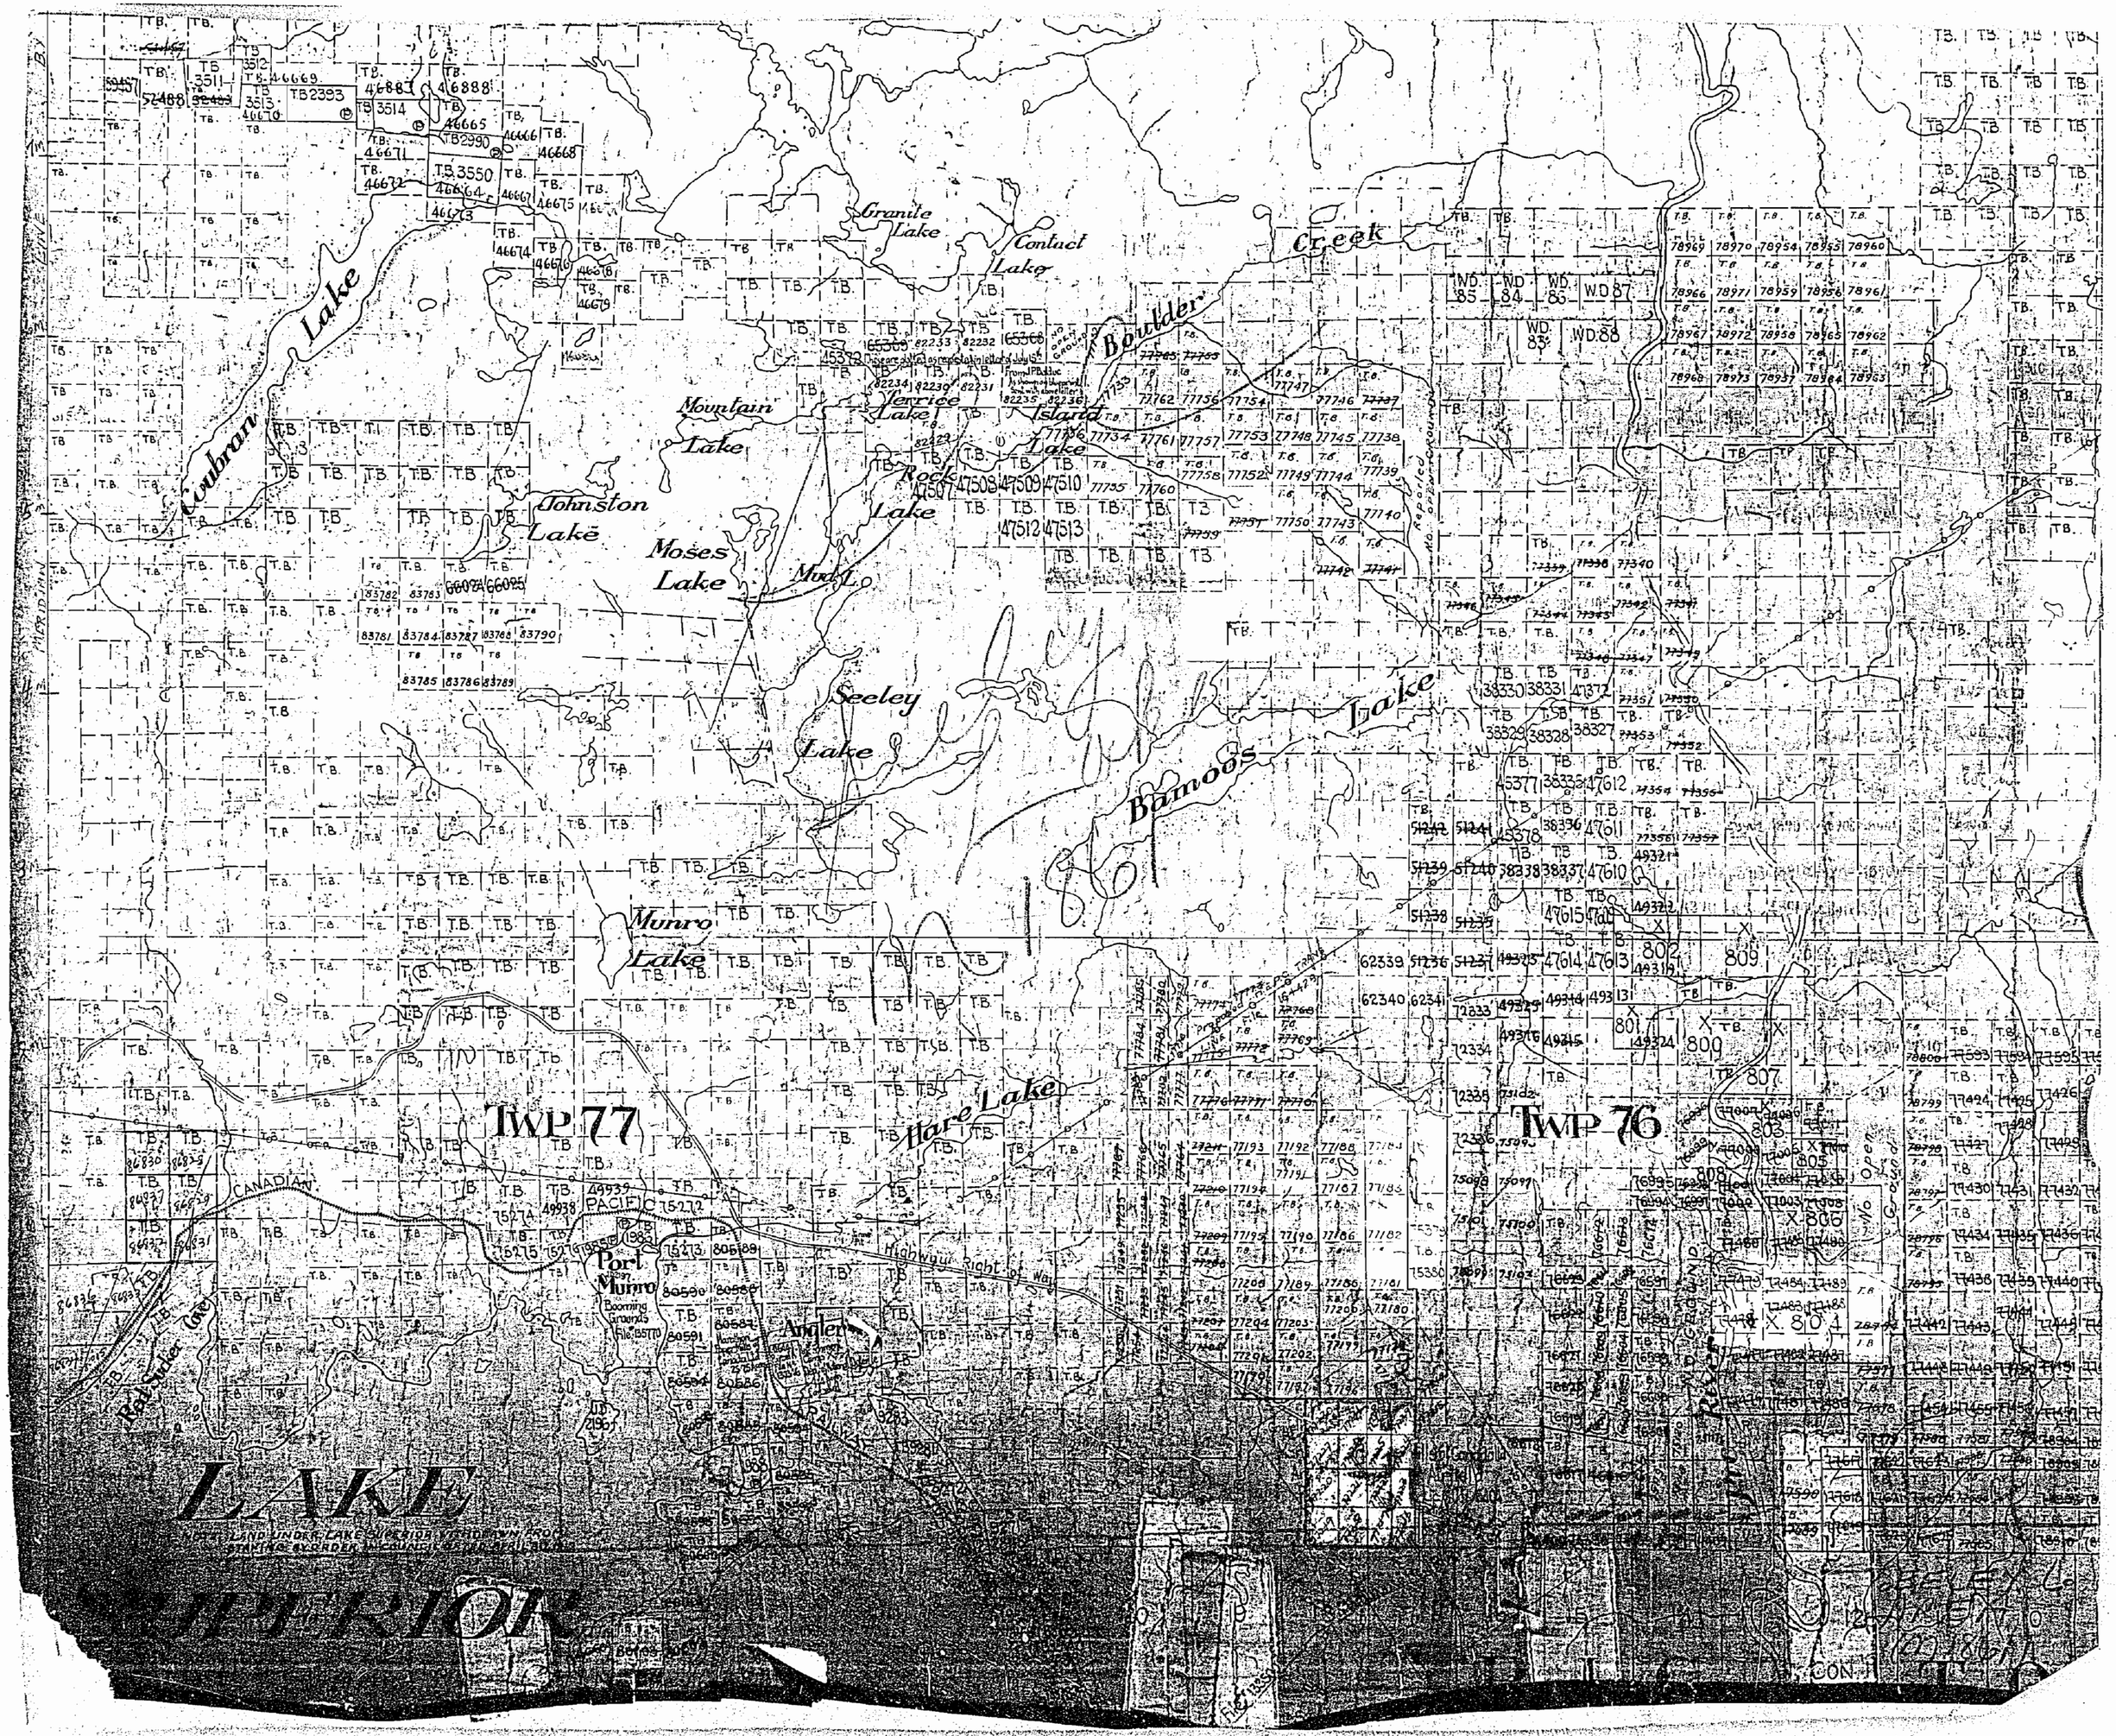

Coubran Lake
Granite Lake
Contact Lake
Boulder Creek
Mountain Lake
Terrice Lake
Island Lake
Rock Lake
Johnston Lake
Moses Lake
Mud L.
Seeley Lake
Bamoos Lake
Munro Lake
Hare Lake
TWP 77
TWP 76
Port Munro
Angler
Highway Right of Way
CANADIAN PACIFIC
LAKE SUPERIOR

1861

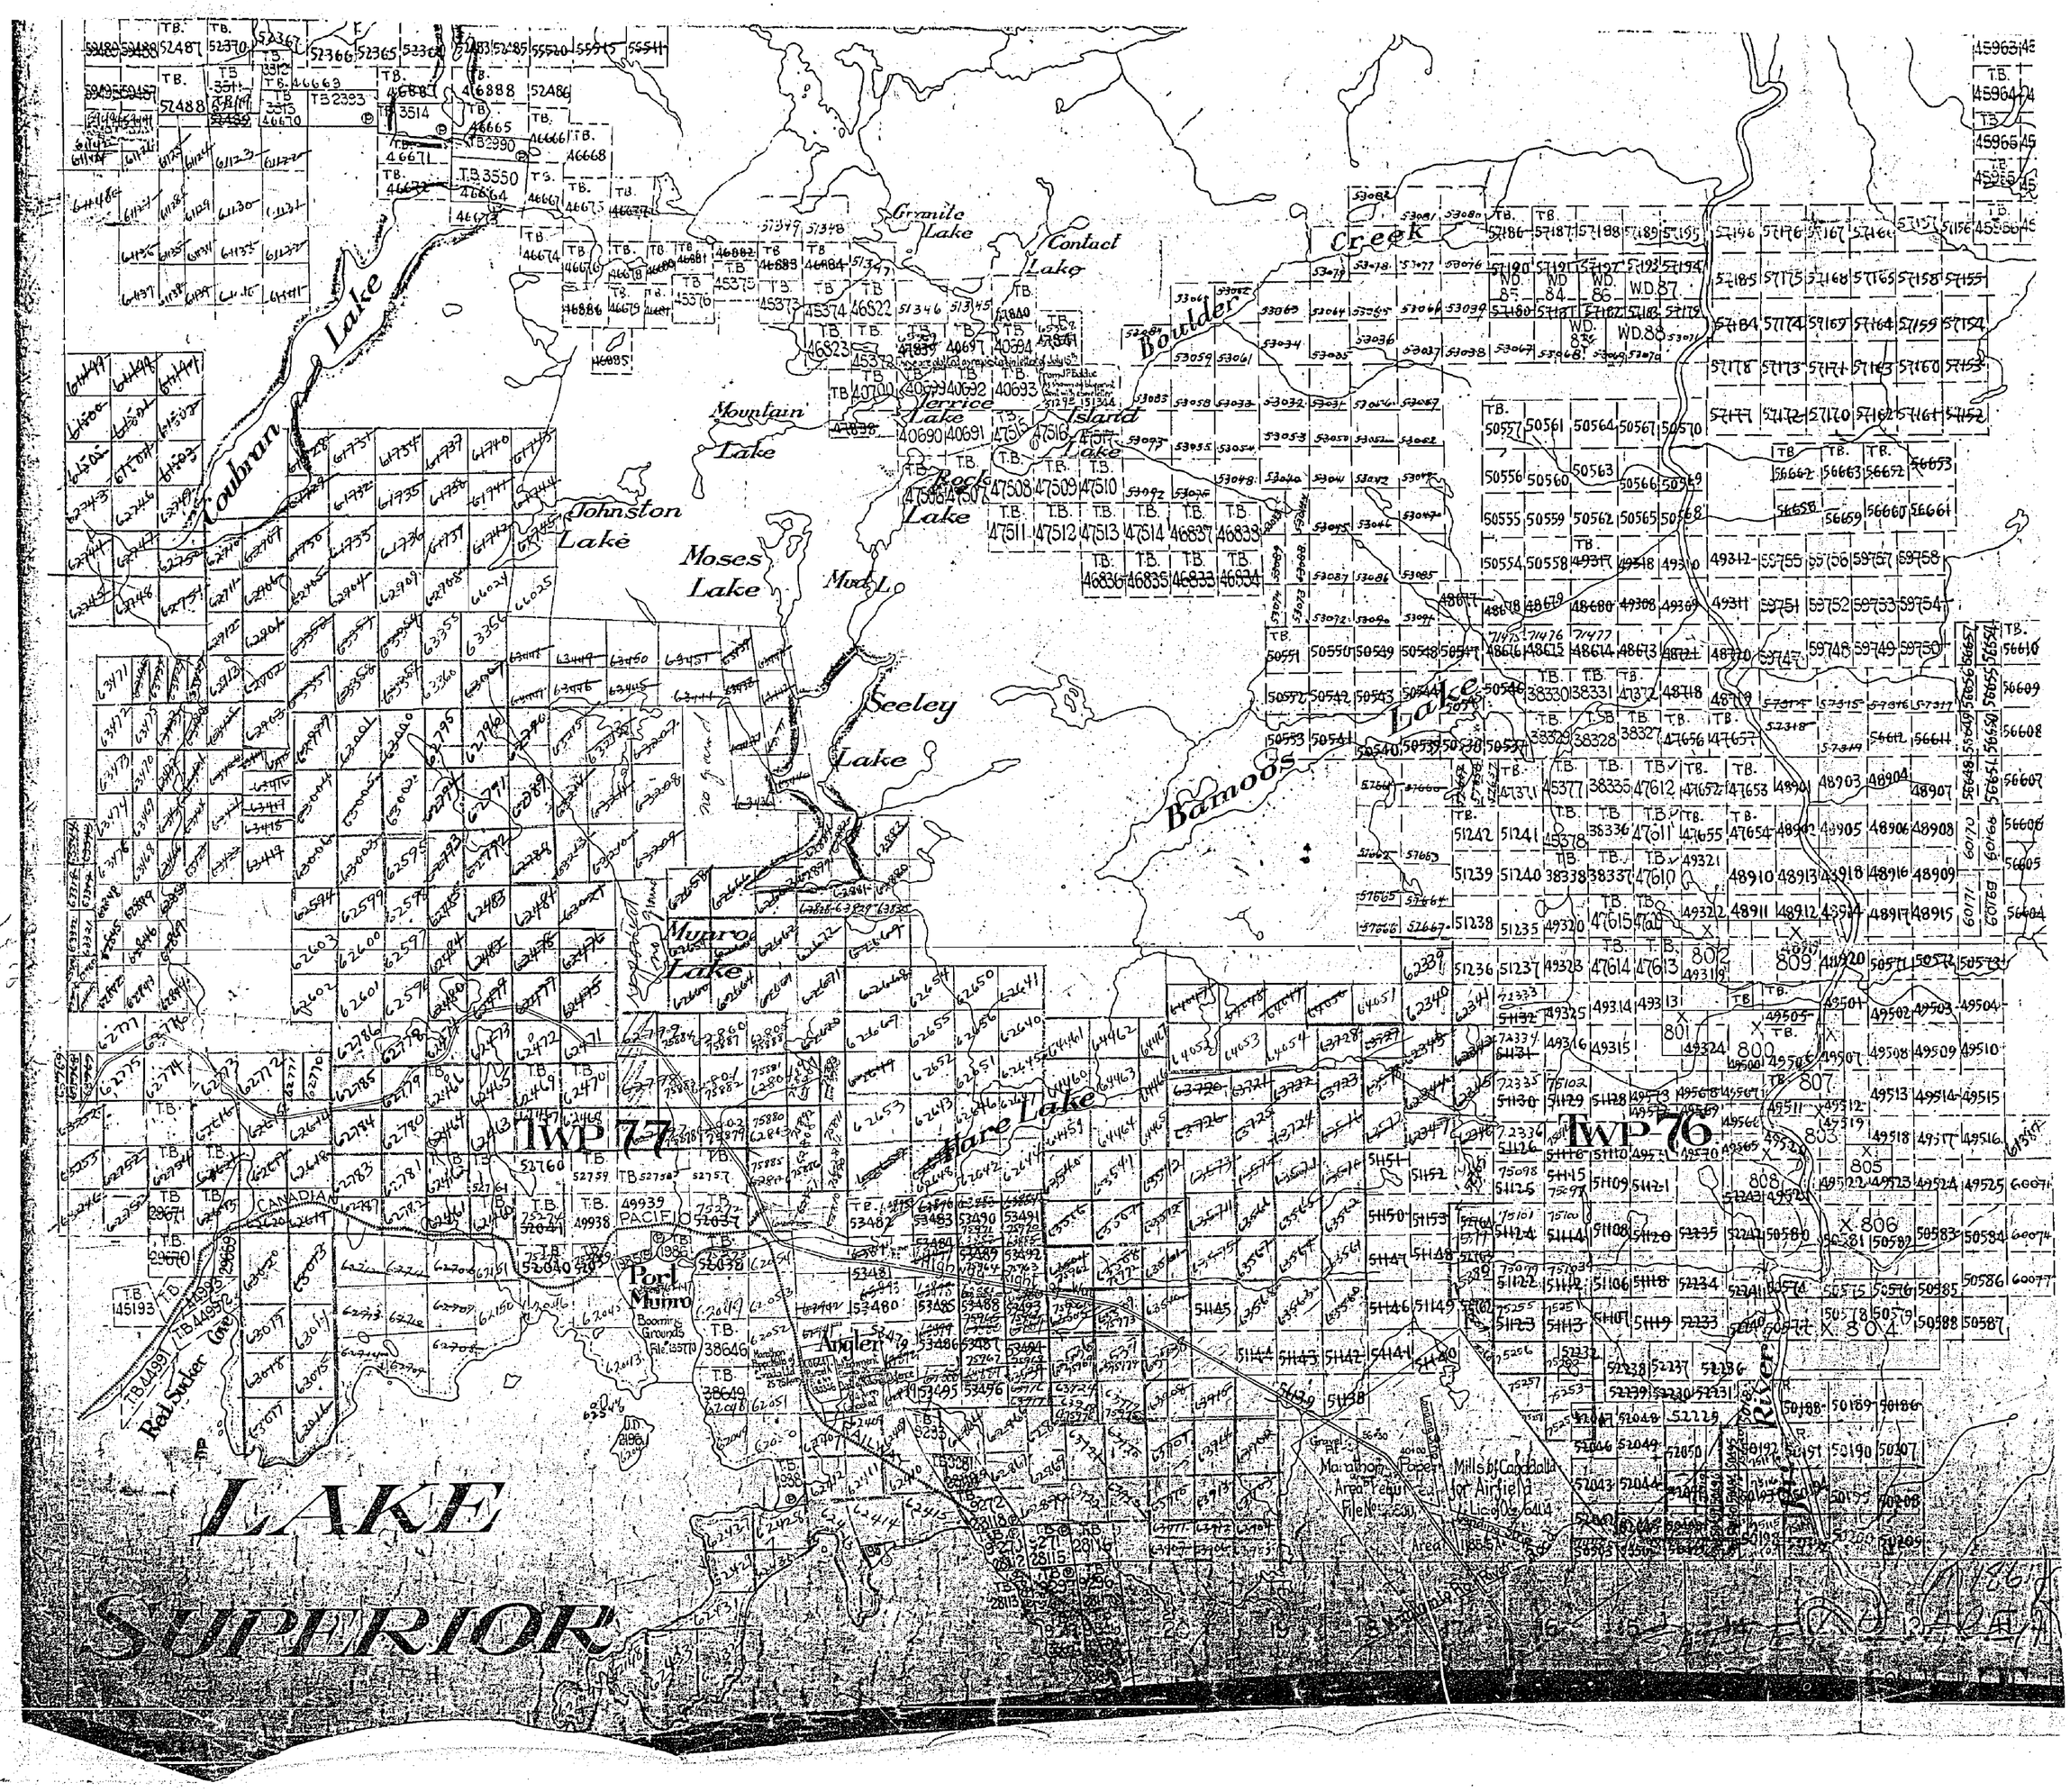

Coubran Lake
Granite Lake
Contact Lake
Boulder Creek
Mountain Lake
Jerrice Lake
Island Lake
Rock Lake
Johnston Lake
Moses Lake
Mud L.
Seeley Lake
Bamoos Lake
Munro Lake
Hare Lake
TWP 77
TWP 76
Port Munro
Angler
Red Sucker Cove
CANADIAN PACIFIC
LAKE SUPERIOR

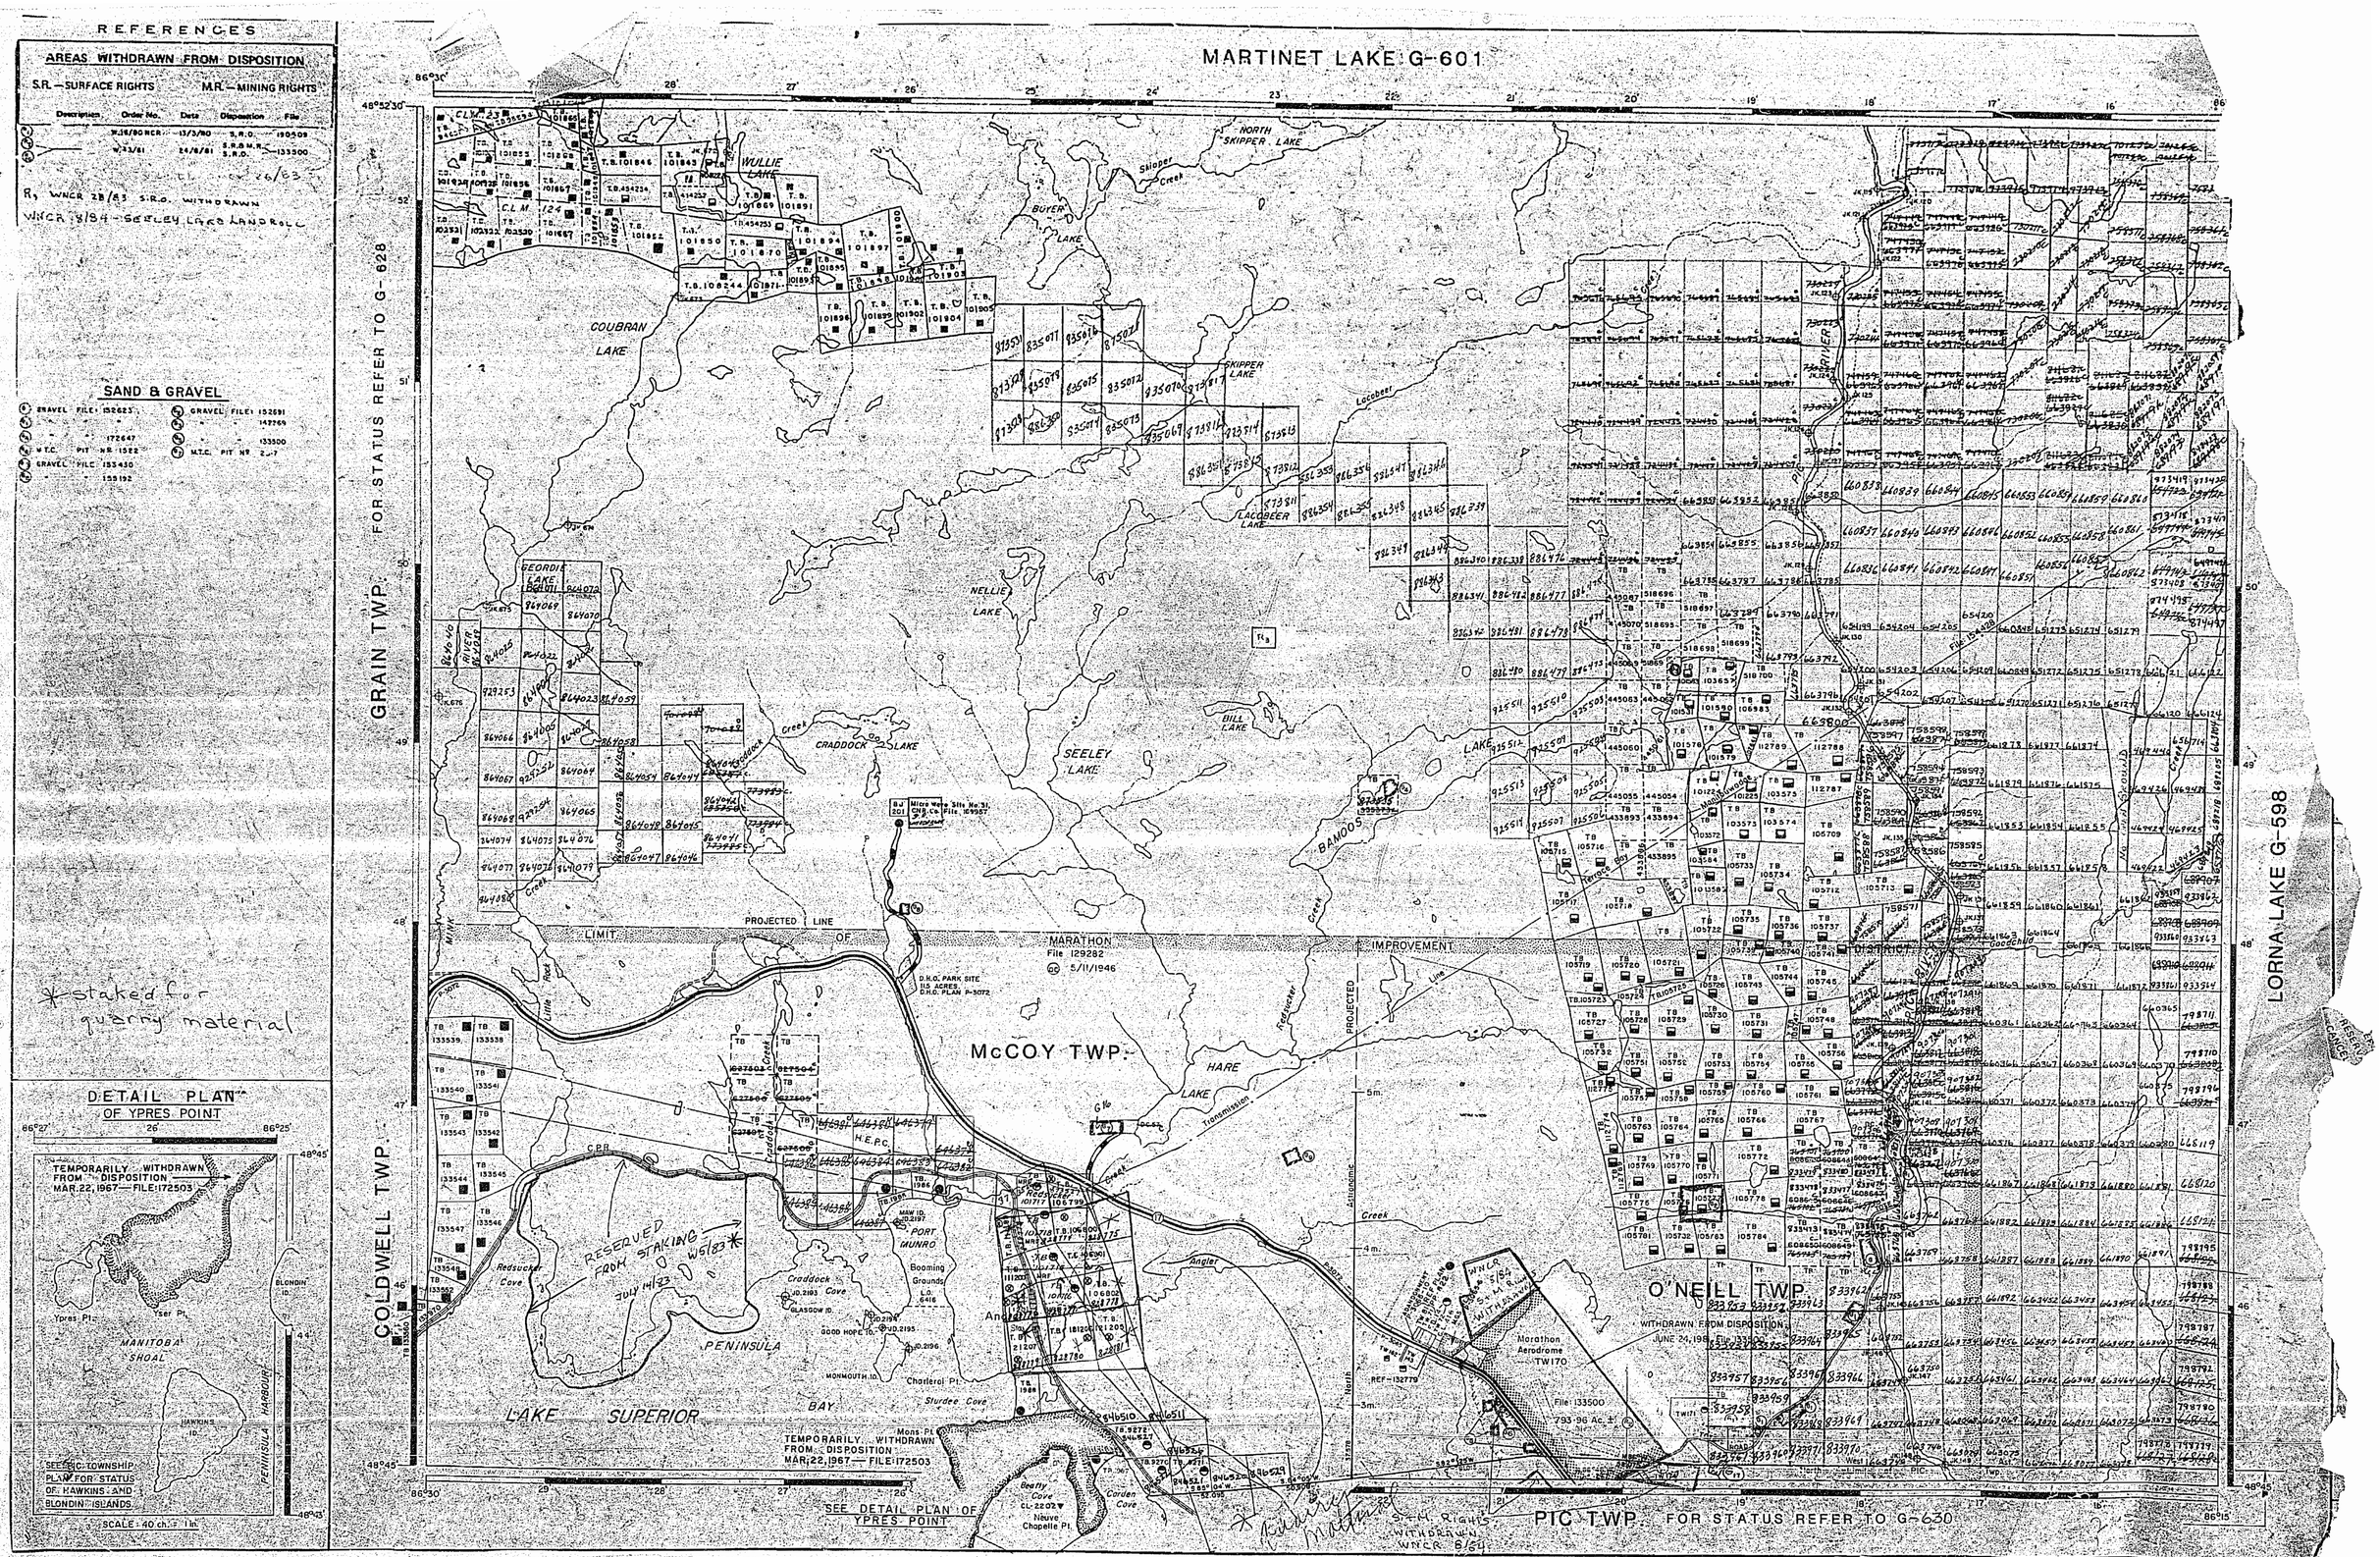

REFERENCES
AREAS WITHDRAWN FROM DISPOSITION
S.R. — SURFACE RIGHTS
M.R. — MINING RIGHTS
Description
Order No.
Date
Disposition
File
W.16/80 NCR
13/3/80
S.R.O.
190509
W.43/81
24/8/81
S.R.O.
133500
R, WNCR 28/83 S.R.O. WITHDRAWN
WNCR 8/84 - SEELEY LAKE LANDROLL
SAND & GRAVEL
GRAVEL FILE: 152623
GRAVEL FILE: 152691
172647
142269
M.T.C. PIT NO. 1522
133500
GRAVEL FILE 153430
M.T.C. PIT NO. 2-7
155192
*staked for quarry material
DETAIL PLAN OF YPRES POINT
TEMPORARILY WITHDRAWN FROM DISPOSITION MAR. 22, 1967 — FILE: 172503
MANITOBA SHOAL
SEE PIC TOWNSHIP PLAN FOR STATUS OF HAWKINS AND BLONDIN ISLANDS
SCALE: 40 ch. = 1 in.
MARTINET LAKE G-601
GRAIN TWP.
FOR STATUS REFER TO G-628
COLDWELL TWP.
McCOY TWP.
O'NEILL TWP.
PIC TWP.
FOR STATUS REFER TO G-630
LORNA LAKE G-598
LAKE SUPERIOR
PENINSULA BAY
PORT MUNRO
SEELEY LAKE
NELLIE LAKE
COUBRAN LAKE
WULLIE LAKE
NORTH SKIPPER LAKE
SKIPPER LAKE
LACOBEER LAKE
BILL LAKE
CRADDOCK LAKE
GEORDIE LAKE
BAMOOS LAKE
HARE LAKE
LIMIT OF MARATHON IMPROVEMENT DISTRICT
PROJECTED LINE
RESERVED FROM STAKING
TEMPORARILY WITHDRAWN FROM DISPOSITION MAR. 22, 1967 — FILE: 172503
SEE DETAIL PLAN OF YPRES POINT
Marathon Aerodrome TW170
File 133500
WITHDRAWN FROM DISPOSITION JUNE 24, 1981

1861

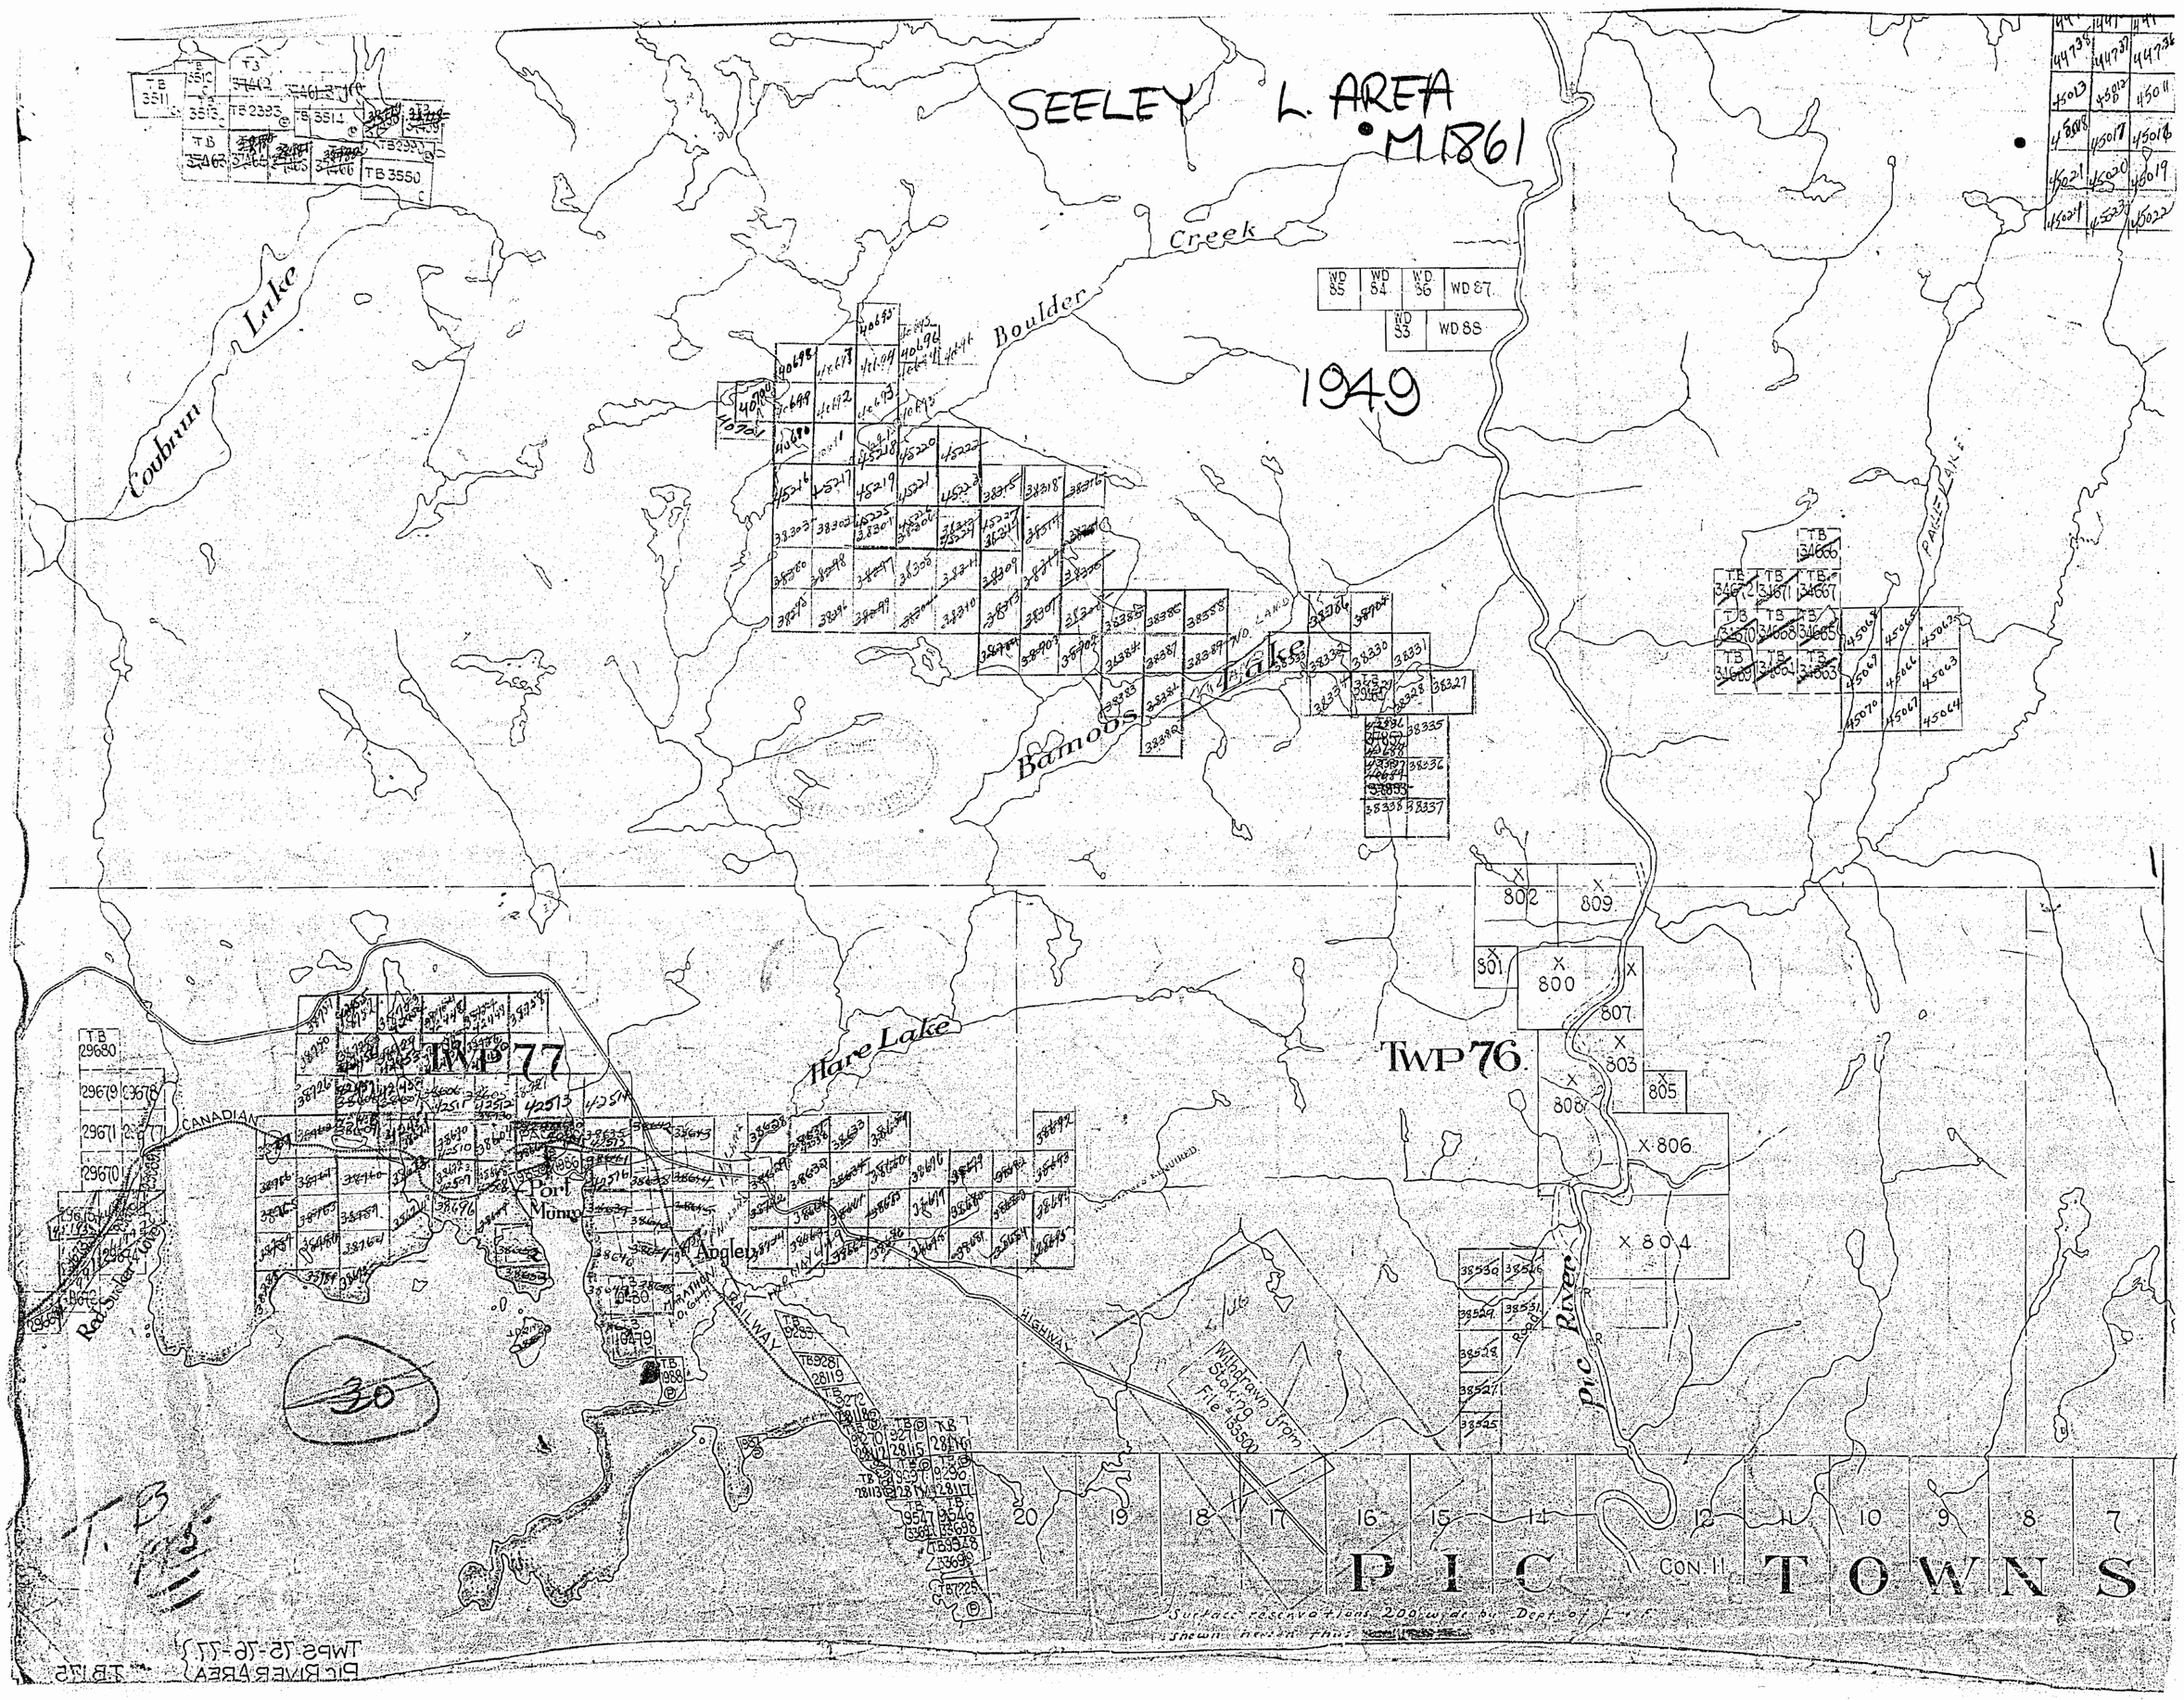
SEELEY L. AREA
M 1861
1949
Boulder Creek
Coubran Lake
Bamoos Lake
Hare Lake
Pic River
TWP 77
TWP 76
Port Munro
Angler
CANADIAN
RAILWAY
HIGHWAY
Withdrawn from Staking File #133500
PIC TOWNS
CON. 11
Surface reservations 200' wide by Dept. of L. & F. shown herein thus
TWPS 75-76-77
PIC RIVER AREA
T.B. 175

1861

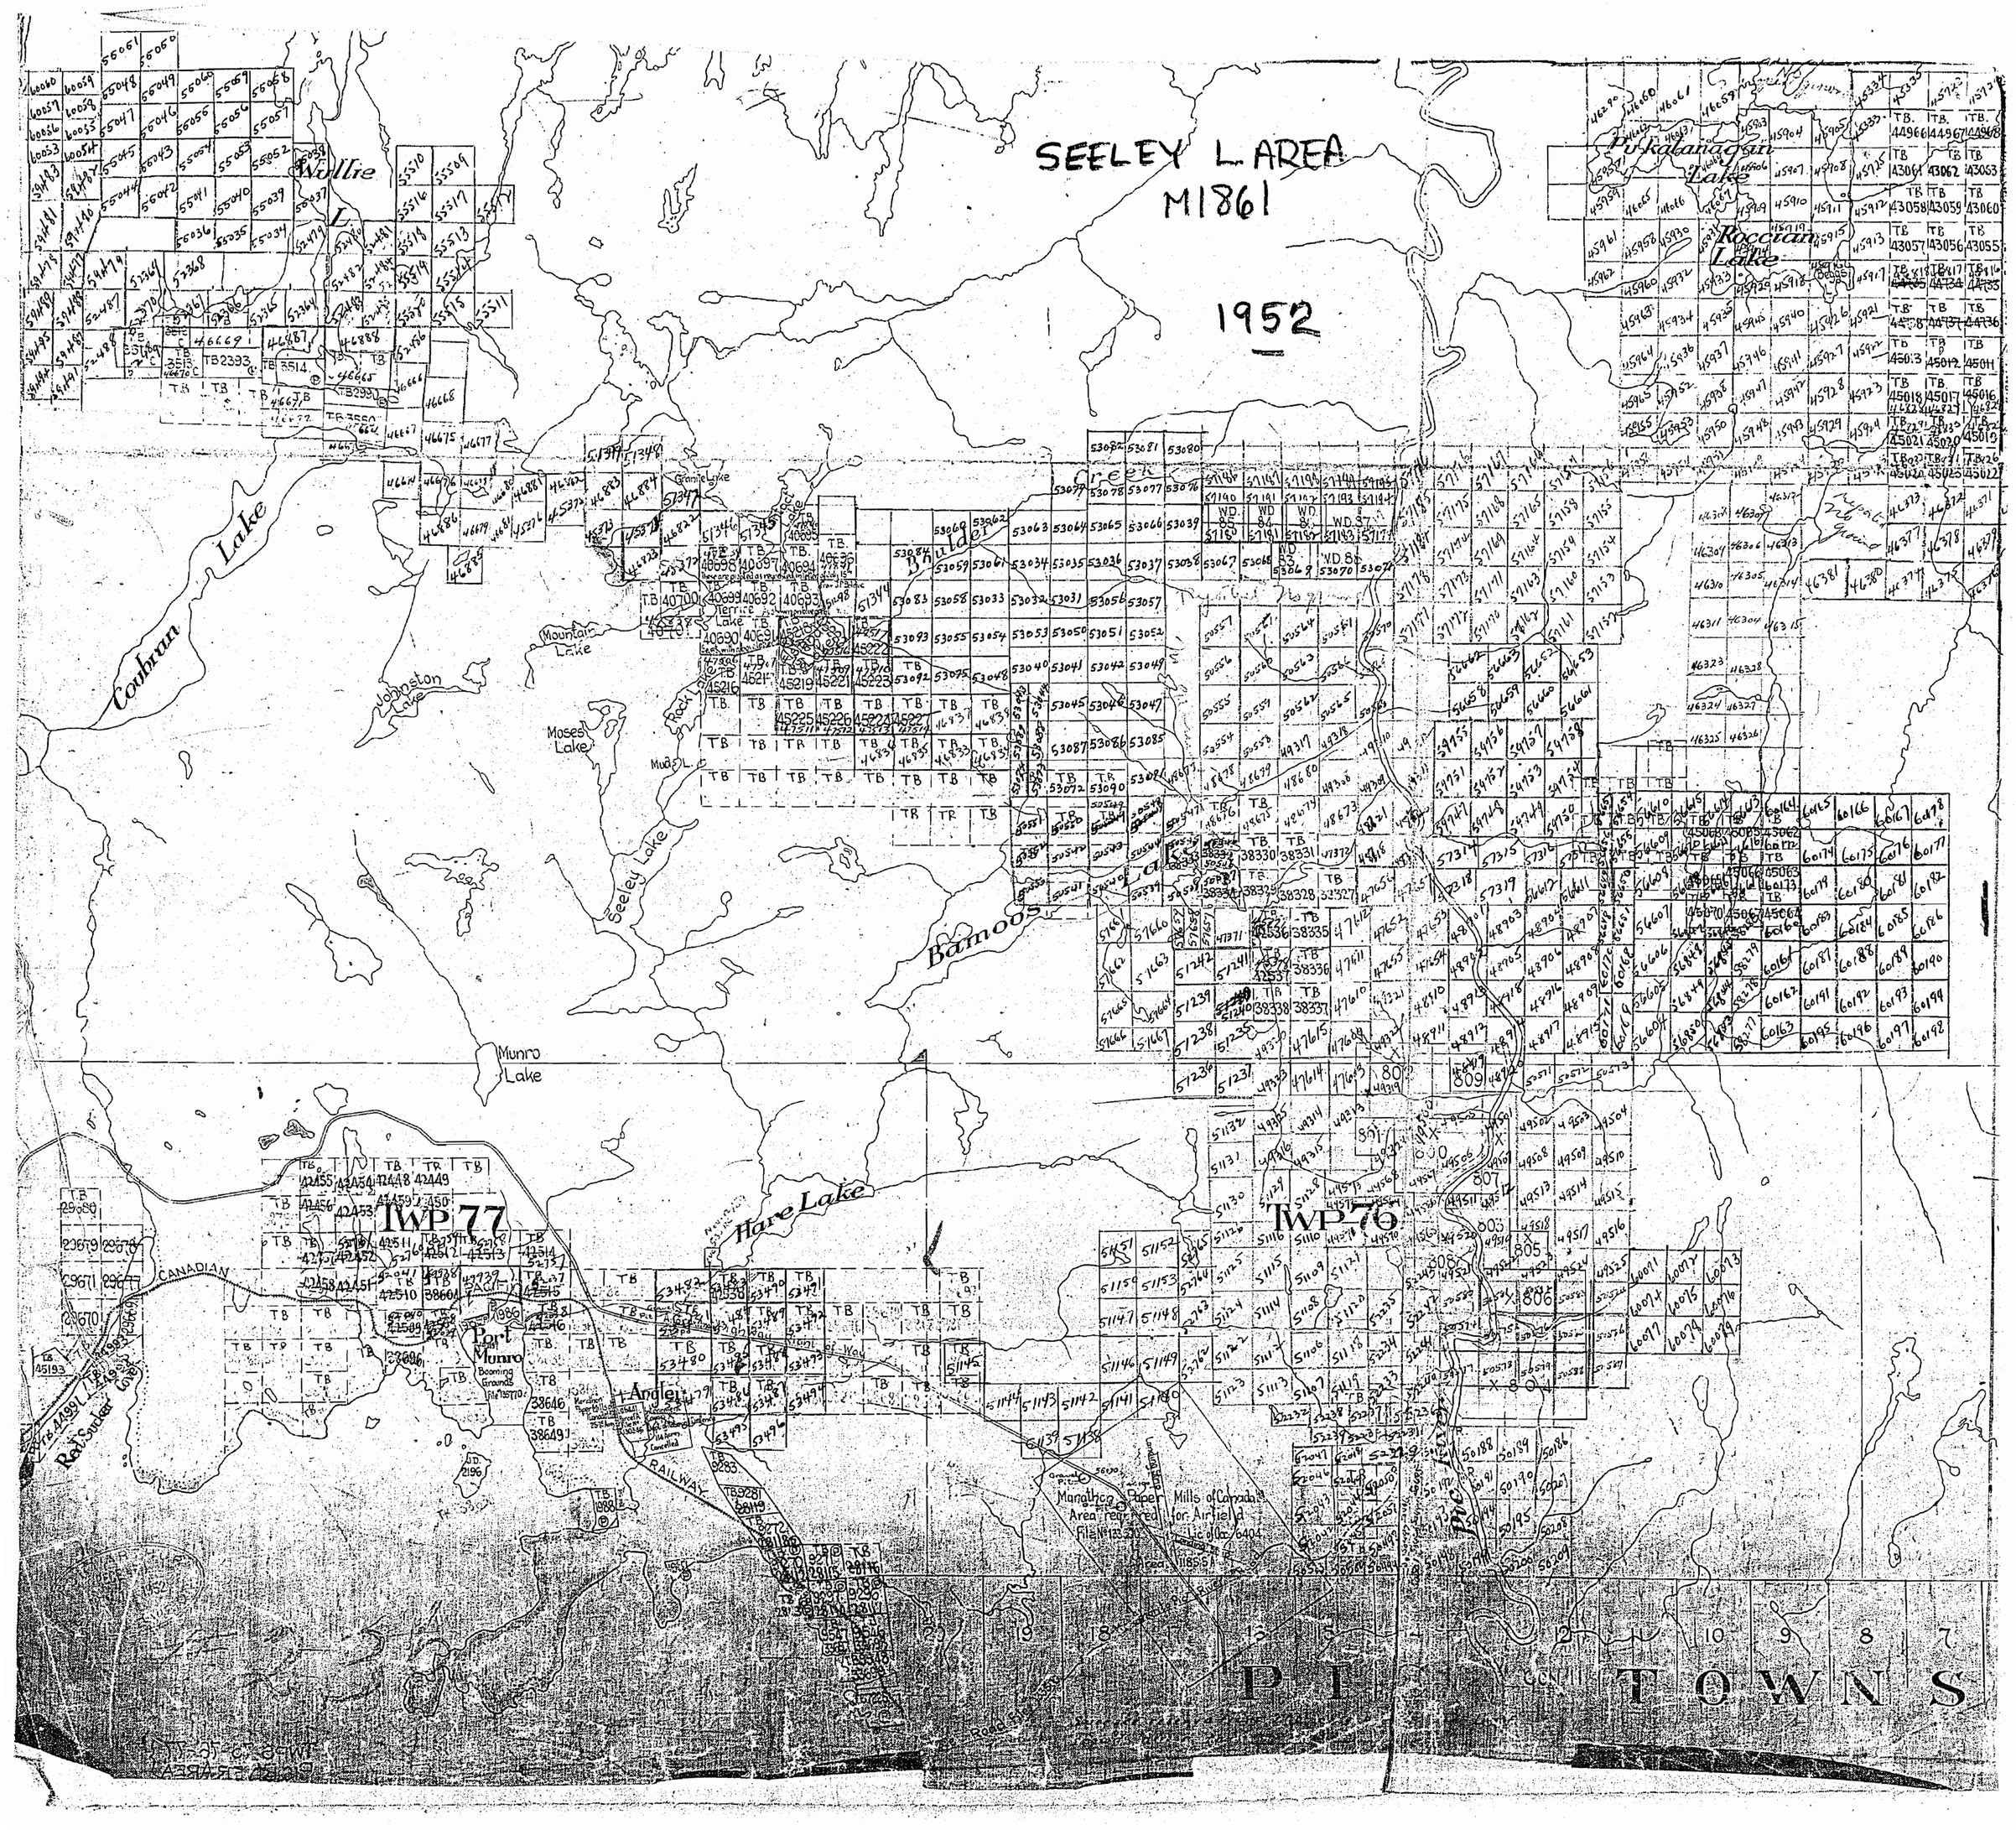
SEELEY L. AREA
M1861
1952
Wullie L.
Coubran Lake
Johnston Lake
Mountain Lake
Moses Lake
Seeley Lake
Bamoos
Munro Lake
Hare Lake
Pukatanagan Lake
Roccian Lake
Boulder Creek
TWP 77
TWP 76
Port Munro
Angler
CANADIAN
RAILWAY
Area required for Airfield
PT TOWNS

1861

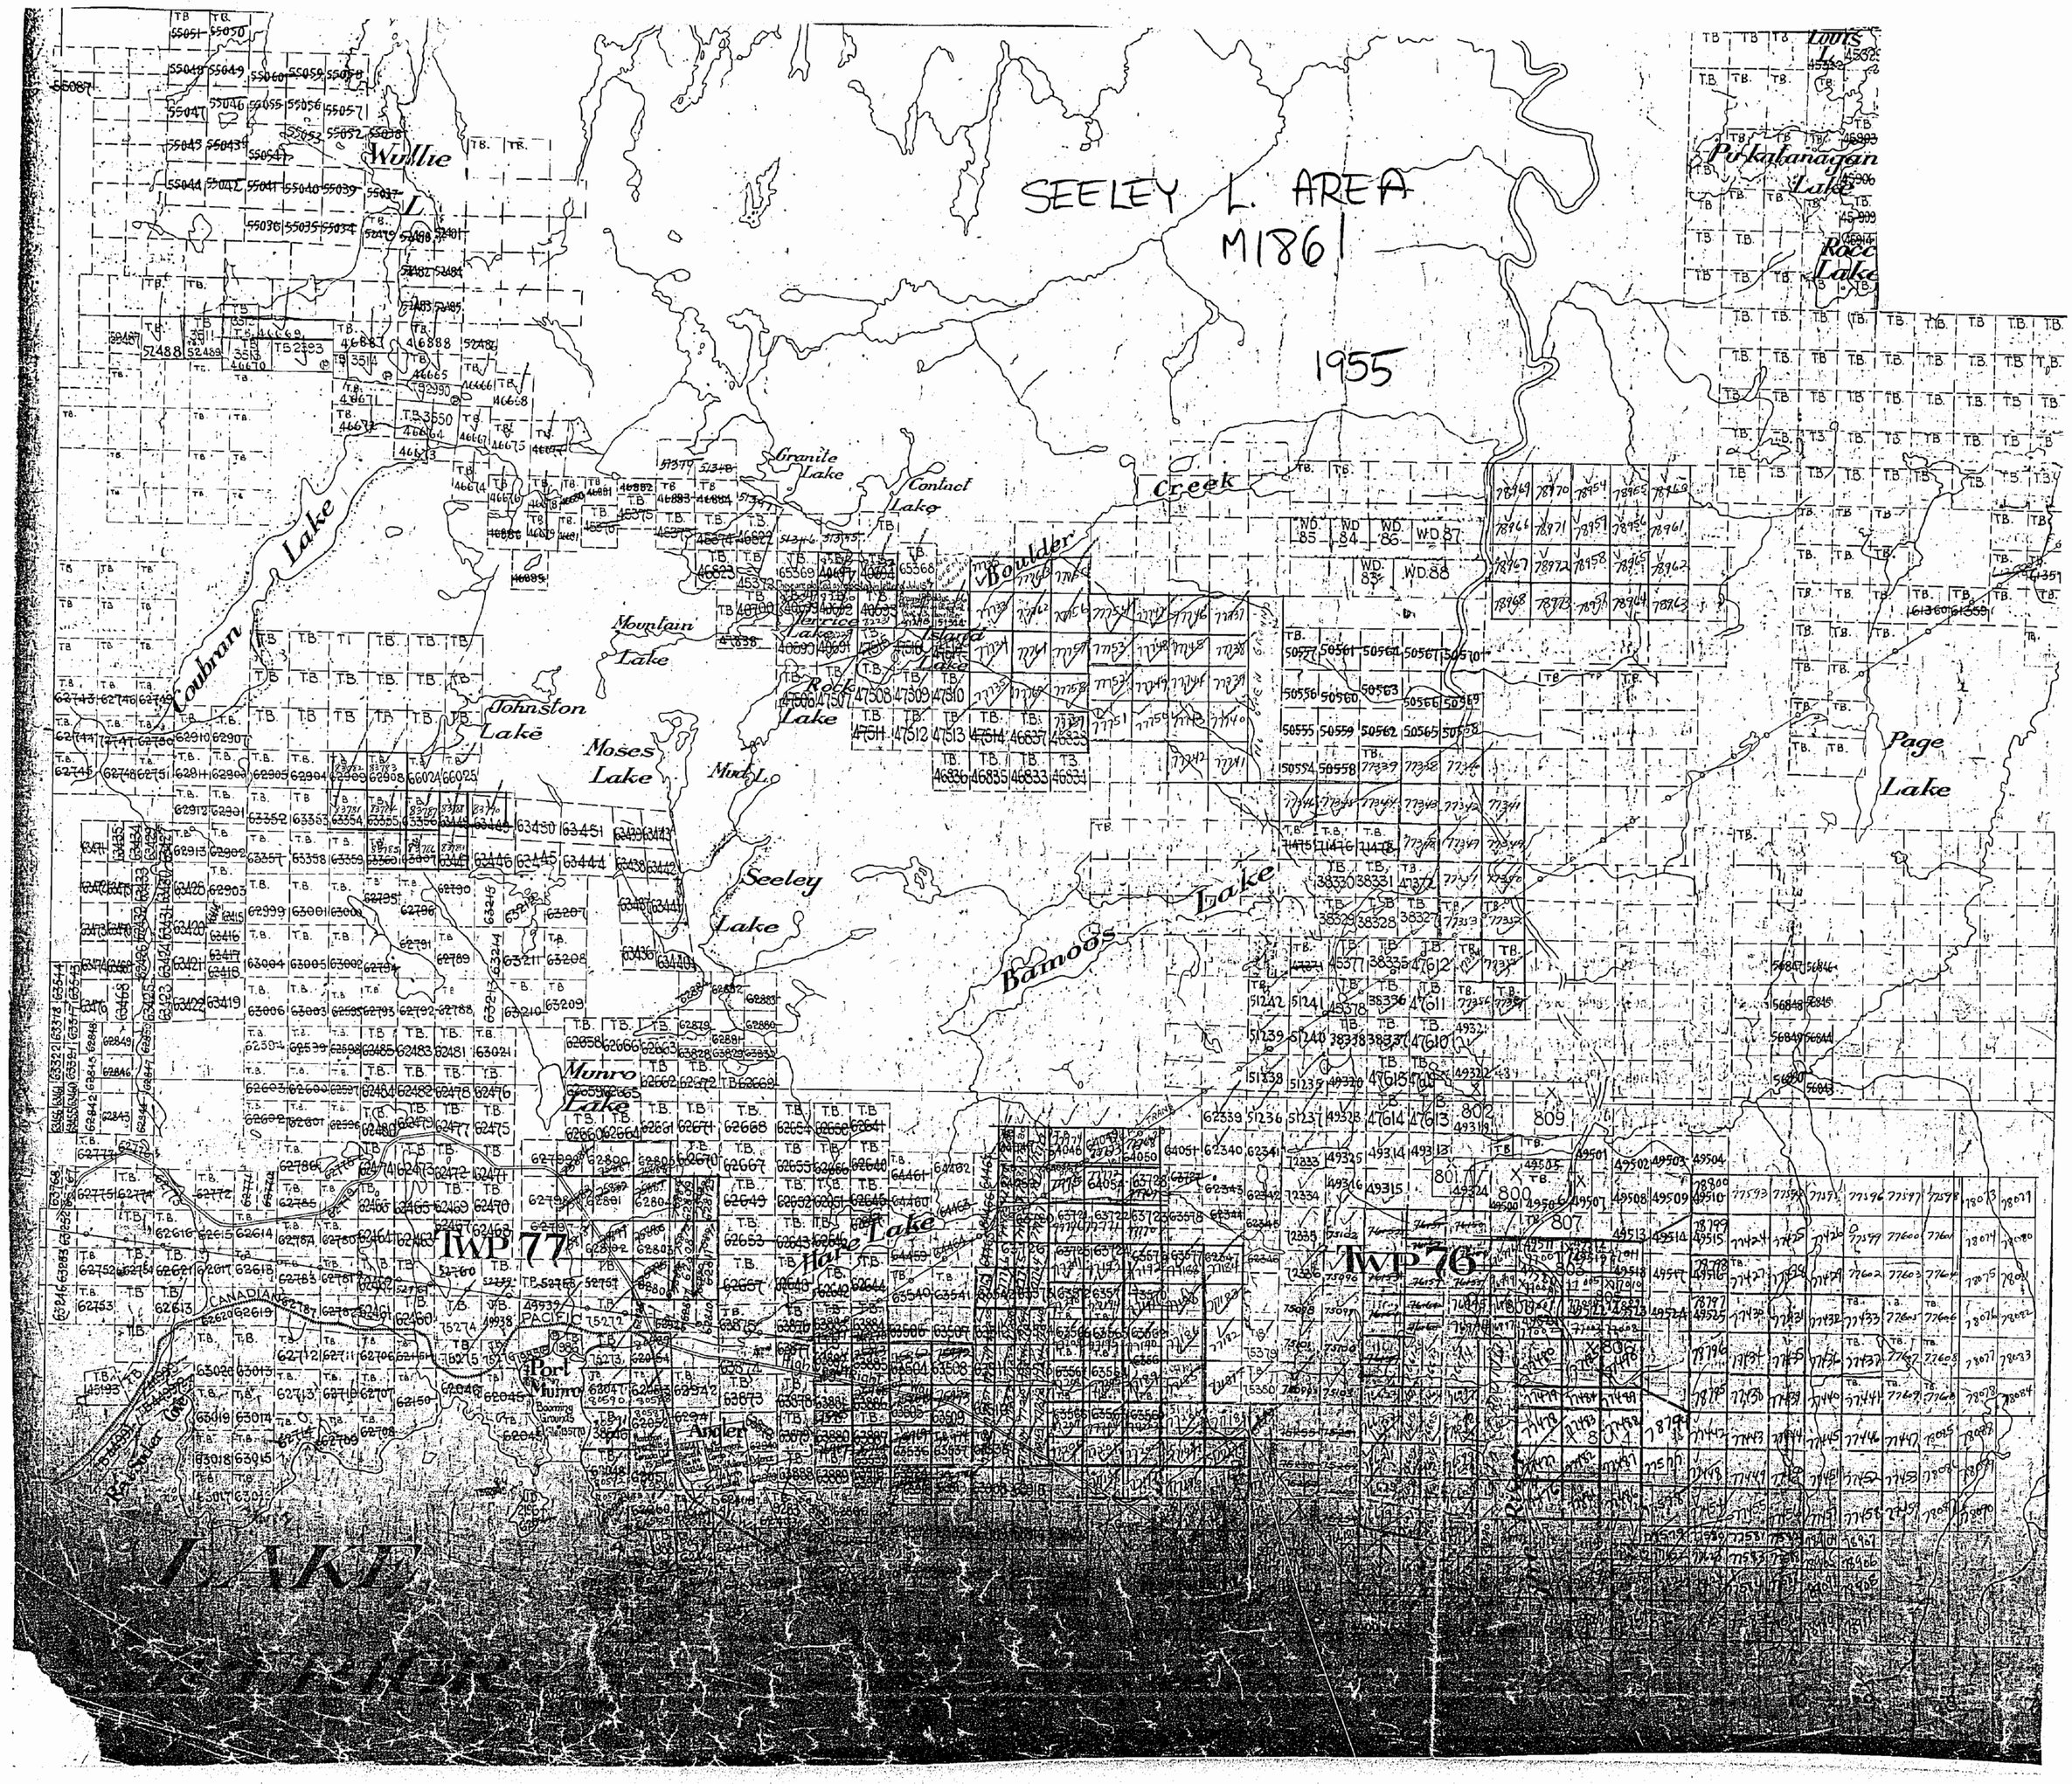
SEELEY L. AREA
M1861
1955
Wullie L.
Coubran Lake
Granite Lake
Contact Lake
Boulder Creek
Mountain Lake
Johnston Lake
Moses Lake
Rock Lake
Island Lake
Seeley Lake
Bamoos Lake
Munro Lake
Hare Lake
Page Lake
Pukatanagan Lake
Rock Lake
Louis L.
TWP 77
TWP 76
Port Munro
Angler
CANADIAN PACIFIC
LAKE

1861

AREA OF

SEELEY LAKE

DISTRICT OF
THUNDER BAY

PORT ARTHUR
MINING DIVISION

SCALE: 1-INCH = 40 CHAINS

LEGEND

PATENTED LAND	(P)
CROWN LAND SALE	C.S.
LEASES	(L)
LOCATED LAND	Loc.
LICENSE OF OCCUPATION	L.O.
MINING RIGHTS ONLY	M.R.O.
SURFACE RIGHTS ONLY	S.R.O.
ROADS	
IMPROVED ROADS	
KING'S HIGHWAYS	
RAILWAYS	
POWER LINES	
MARSH OR MUSKEG	
MINES	
CANCELLED	C.

NOTES

400' Reserve around all Lakes & Rivers to Dept. of Lands & Forests.

Land under water in Lake Superior withdrawn from staking by Order In Council dated April 30, 1912.

Limits of Marathon Improvement District shown thus: File: 129282 Vol. I.

PLAN NO. M. 1861

DEPARTMENT OF MINES
— ONTARIO —

1957

1861

Martinet Lake Area (M-2488)

Twp. 79 (M-1923)

Twp. 78 (M-1921)

Lorna Lake Area (M-2487)

AREA OF

SEELEY LAKE

DISTRICT OF
THUNDER BAY

PORT ARTHUR
MINING DIVISION

SCALE: 1-INCH = 40 CHAINS

LEGEND

PATENTED LAND	(P)
CROWN LAND SALE	C.S.
LEASES	(L)
LOCATED LAND	Loc.
LICENSE OF OCCUPATION	L.O.
MINING RIGHTS ONLY	M.R.O.
SURFACE RIGHTS ONLY	S.R.O.
ROADS	
IMPROVED ROADS	
KING'S HIGHWAYS	
RAILWAYS	
POWER LINES	
MARSH OR MUSKEG	
MINES	
CANCELLED	C

NOTES

400' Reserve around all Lakes & Rivers to Dept. of Lands & Forests.

Land under water in Lake Superior withdrawn from staking by Order In Council dated April 30, 1912

Limits of Marathon Improvement District shown thus: File: 129282, Vol. I.

PLAN NO. M. 1861

DEPARTMENT OF MINES
— ONTARIO —

1861

Martinet Lake Area (M-2488)

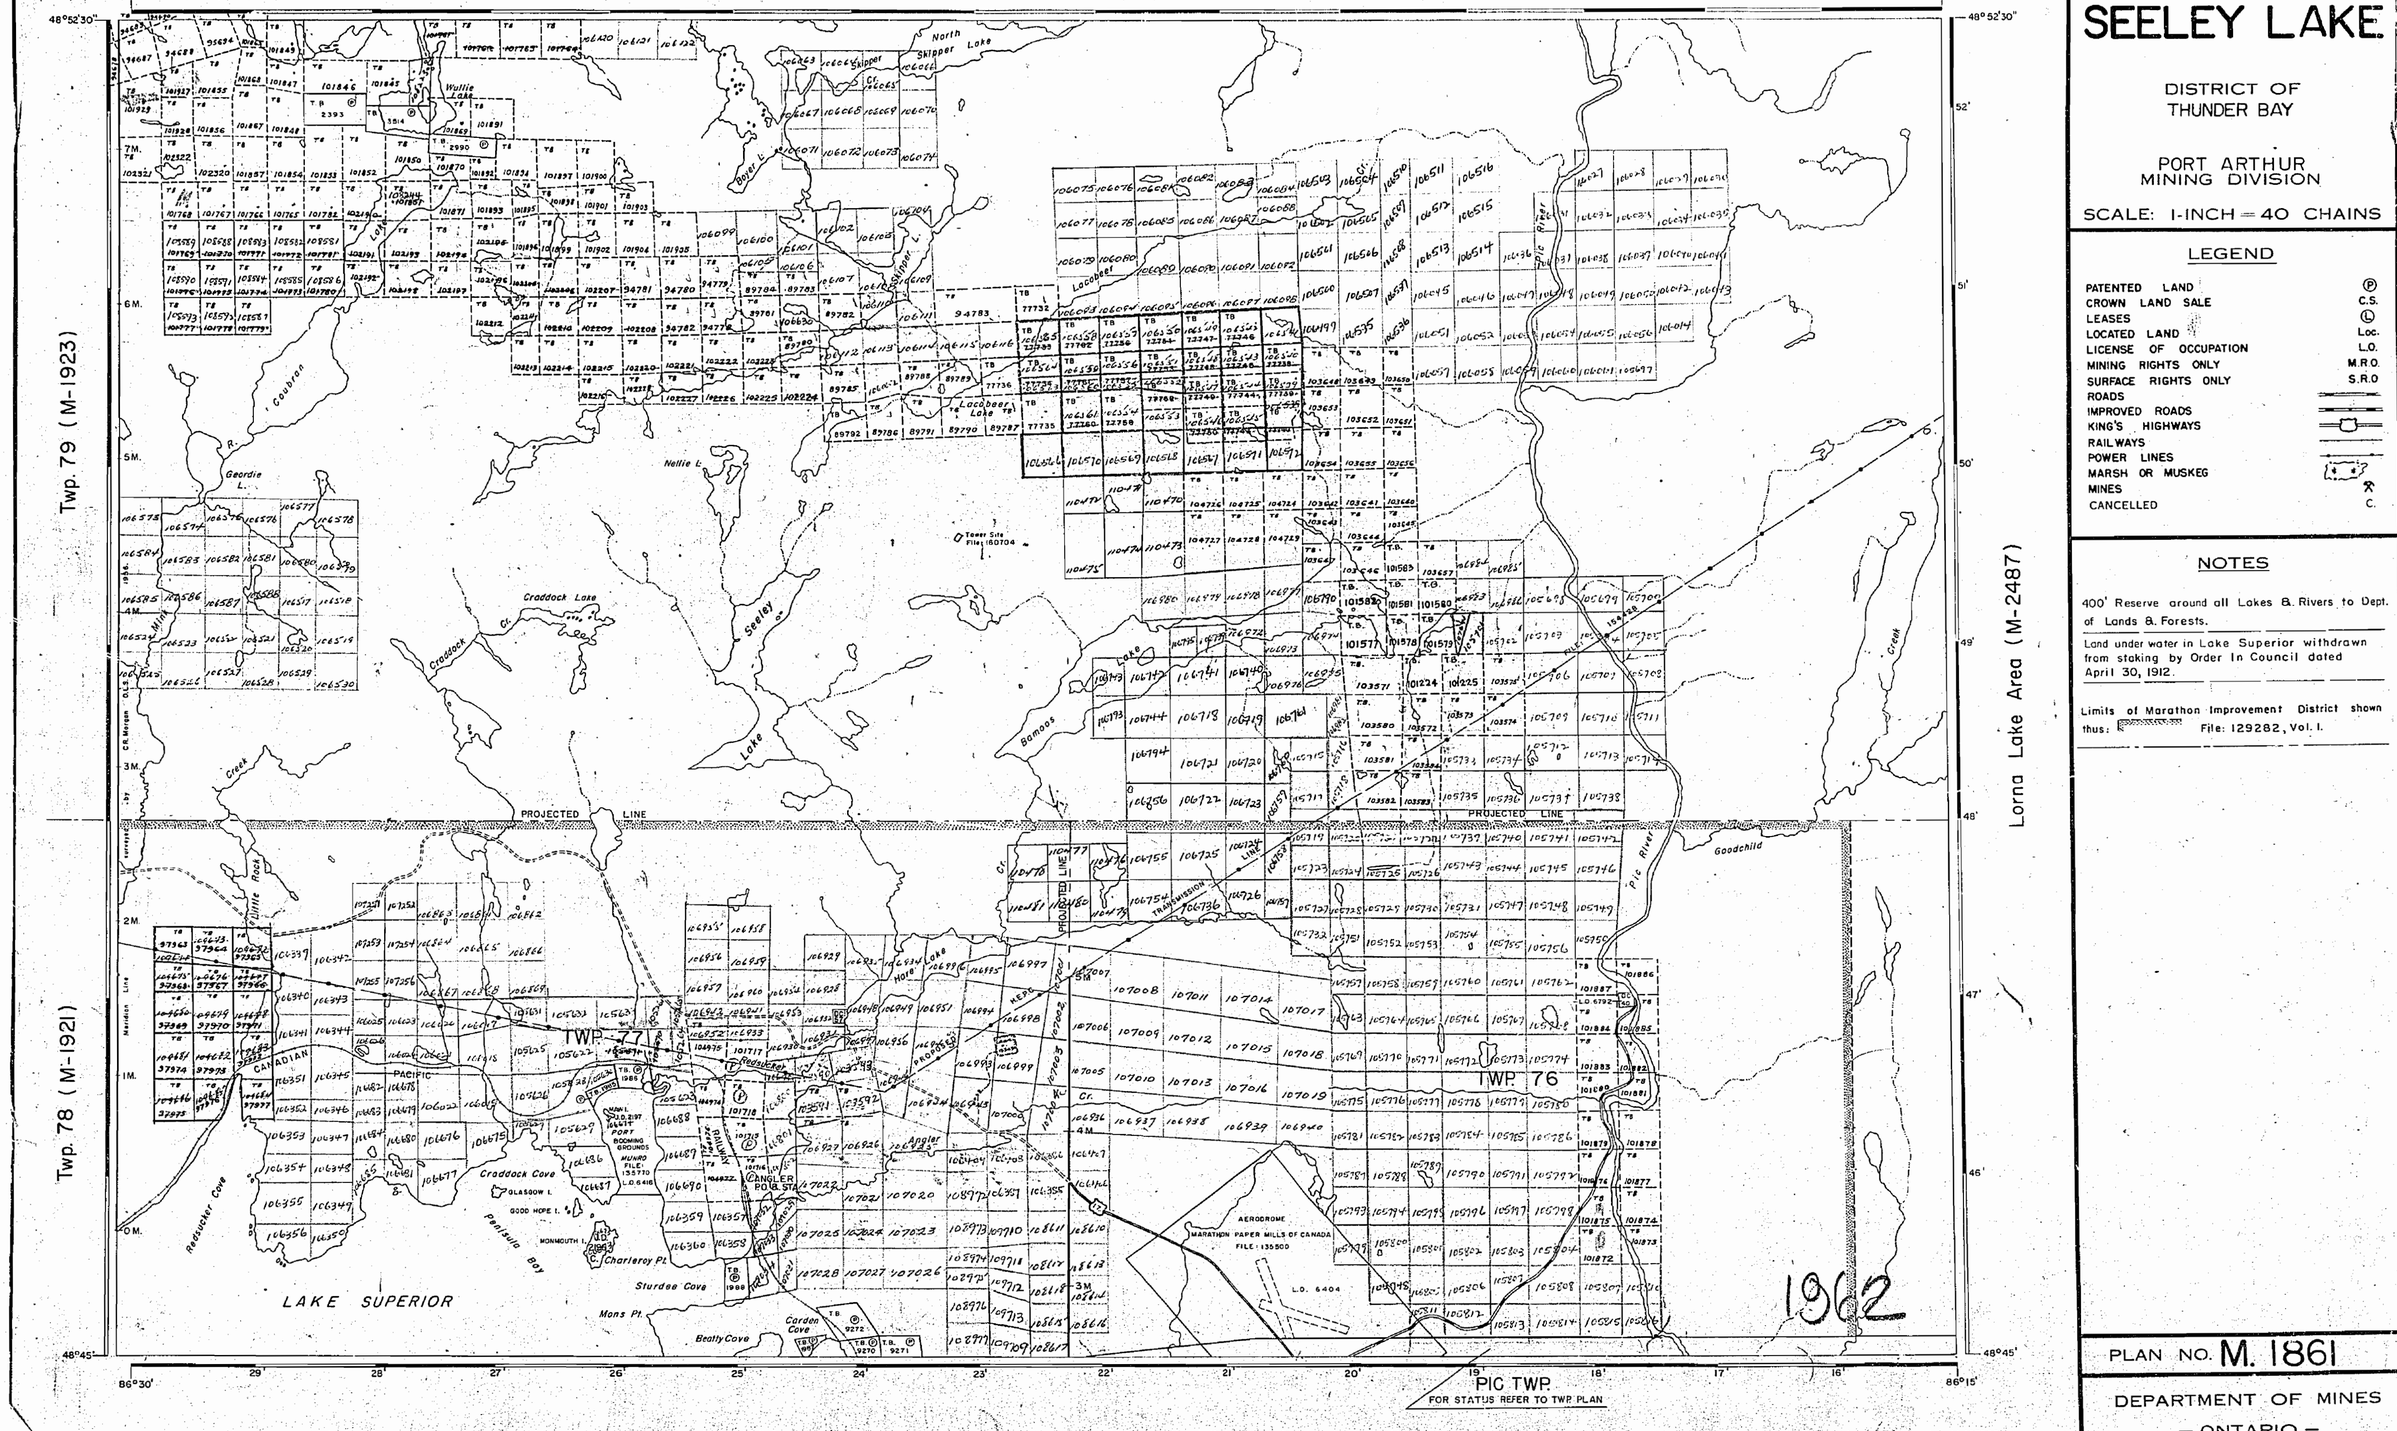

AREA OF

SEELEY LAKE

DISTRICT OF
THUNDER BAY

PORT ARTHUR
MINING DIVISION

SCALE: 1-INCH = 40 CHAINS

LEGEND

PATENTED LAND	(P)
CROWN LAND SALE	C.S.
LEASES	(L)
LOCATED LAND	Loc.
LICENSE OF OCCUPATION	L.O.
MINING RIGHTS ONLY	M.R.O.
SURFACE RIGHTS ONLY	S.R.O
ROADS	
IMPROVED ROADS	
KING'S HIGHWAYS	
RAILWAYS	
POWER LINES	
MARSH OR MUSKEG	
MINES	
CANCELLED	C.

NOTES

400' Reserve around all Lakes & Rivers to Dept. of Lands & Forests.

Land under water in Lake Superior withdrawn from staking by Order In Council dated April 30, 1912.

Limits of Marathon Improvement District shown thus: File: 129282, Vol. I.

1962

PLAN NO. M. 1861

DEPARTMENT OF MINES
— ONTARIO —

1861

Martinet Lake Area (M-2488)

Twp. 79 (M-1923)

Twp. 78 (M-1921)

Lorna Lake Area (M-2487)

AREA OF

SEELEY LAKE

DISTRICT OF
THUNDER BAY

PORT ARTHUR
MINING DIVISION

SCALE: 1-INCH 40 CHAINS

LEGEND

PATENTED LAND	(P)
CROWN LAND SALE	C.S.
LEASES	(L)
LOCATED LAND	Loc.
LICENSE OF OCCUPATION	L.O.
MINING RIGHTS ONLY	M.R.O.
SURFACE RIGHTS ONLY	S.R.O.
ROADS	
IMPROVED ROADS	
KING'S HIGHWAYS	
RAILWAYS	
POWER LINES	
MARSH OR MUSKEG	
MINES	
CANCELLED	C

NOTES

400' SURFACE RIGHTS RESERVATION AROUND ALL LAKES AND RIVERS.

Land under water in Lake Superior withdrawn from staking by Order In Council dated April 30, 1912

LIMITS OF MARATHON IMPROVEMENT DISTRICT SHOWN THUS: FILE 129282

DETAIL PLAN OF YPRES POINT

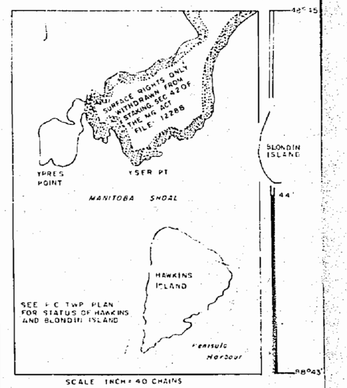

SCALE 1 INCH = 40 CHAINS

PORT ARTHUR
RECEIVED
JUN 18 1965
MINING DIVISION

PLAN NO. M. 1861

DEPARTMENT OF MINES
— ONTARIO —

1965

1861

Martinet Lake Area (M-2488)

AREA OF

SEELEY LAKE

DISTRICT OF
THUNDER BAY

THUNDER BAY
MINING DIVISION

SCALE: 1 INCH = 40 CHAINS

LEGEND

PATENTED LAND	Ⓟ
CROWN LAND SALE	C.S.
LEASES	Ⓛ
LOCATED LAND	Loc.
LICENSE OF OCCUPATION	L.O.
MINING RIGHTS ONLY	M.R.O.
SURFACE RIGHTS ONLY	S.R.O.
ROADS	
IMPROVED ROADS	
KING'S HIGHWAYS	
RAILWAYS	
POWER LINES	
MARSH OR MUSKEG	
MINES	
CANCELLED	C.

NOTES

400' SURFACE RIGHTS RESERVATION AROUND ALL LAKES AND RIVERS.

Land under water in Lake Superior withdrawn from staking by Order in Council dated April 30, 1912.

LIMITS OF MARATHON IMPROVEMENT DISTRICT SHOWN THUS: ——— FILE: 129288

DETAIL PLAN OF YPRES POINT

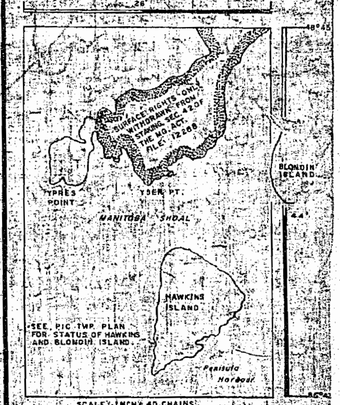

NATIONAL TOPOGRAPHIC SERIES 42D/16

PLAN NO. M. 1861

ONTARIO
DEPARTMENT OF MINES
AND NORTHERN AFFAIRS

Twp. 79 (M-1923)

Twp. 78 (M-1921)

Lorna Lake Area (M-2487)

TWP. 77

TWP. 76

PROJECTED LINE

LAKE SUPERIOR

PIC TWP.
FOR STATUS, REFER TO TWP. PLAN

SURFACE RIGHTS ONLY WITHDRAWN FROM STAKING SEC. 42 OF THE MINING ACT FILE: 123588

See Detail Plan of Ypres Pt.

1971

1861

Martinet Lake Area (M-2488).

Grain Tp - (M-1923)

Coldwell Tp - (M-1921)

Lorna Lake Area (M-2487)

86°30' 86°15' 48°52'30"

CLM. 123 CLM. 124 7M. 6M. 5M. 4M. 3M. 2M. 1M. 0M.

Wullie Lake Skipper Cr. North Skipper Lake Boyer L. Lacobeer Pic River Lake Coubron R. Geordie L. Nellie L. Lacobeer Lake Mink Creek Craddock Lake Craddock Ck. Seeley Lake Bamos Lake Goodchild Ck. Hare Lake Ck. Angler Redsucker Lake Peninsula Bay Cordon Cove Sturdee Cove Beatty Cove Mons Pt. Glasgow I. Good Hope I. Monmouth I. C. Charleroy Pt. Craddock Cove Redsucker Cove Maple Rock Creek

TOWER SITE FILE: 160704

PROJECTED LINE 69°30'

D.N.O. PARK SITE R.Sec.Pl. P-3072

McCOY TP. (TWP. 77)

ONEILL TP. (TWP. 76)

PIC TWP. FOR STATUS REFER TO TWP. PLAN

PROJECTED LINE

TRANSMISSION

CANADIAN PACIFIC

PROPOSED

Meridian Line

PORT BOOMING GROUNDS MUNRO FILE: 135770 L.D. 6416

ANGLER 106802 P.O. & STA.

AERODROME MARATHON PAPER MILLS OF CANADA FILE: 133500

C.L. 1095 L.O. 8155 793.96 Ac.±

MTC. PIT 1522

GRAVEL S.P. 15340

GRAVEL PIT 152623

GRAVEL PIT 152623

GRAVEL PIT 152623

SURFACE RIGHTS ONLY WITHDRAWN FROM STAKING SEC. 42 OF THE MINING ACT.(R.S.O.1960) FILE: 12288

See Detail Plan Of Ypres Pt.

LAKE SUPERIOR

48°45' 48°52'30"

29' 28' 27' 26' 22' 21' 20' 19' 18' 17' 16'

52' 51' 50' 49' 48' 47' 46'

DO NOT ISSUE ANY QUARRY PERMITS EAST OF THIS LINE CLEAR WITH K. FENWICK.

1975

AREA OF

SEELEY LAKE

DISTRICT OF THUNDER BAY

THUNDER BAY MINING DIVISION

SCALE: 1-INCH = 40 CHAINS

LEGEND

PATENTED LAND	(P)
CROWN LAND SALE	C.S.
LEASES	(L)
LOCATED LAND	Loc.
LICENSE OF OCCUPATION	L.O.
MINING RIGHTS ONLY	M.R.O.
SURFACE RIGHTS ONLY	S.R.O.
ROADS	
IMPROVED ROADS	
KING'S HIGHWAYS	
RAILWAYS	
POWER LINES	
MARSH OR MUSKEG	
MINES	
CANCELLED	C.

NOTES

400' surface rights reservation along the shores of all lakes and rivers.

Land under water in Lake Superior withdrawn from staking by Order In Council dated April 30, 1912.

LIMITS OF MARATHON IMPROVEMENT DISTRICT SHOWN THUS: FILE: 129282

DETAIL PLAN OF YPRES POINT.

86°27' 26' 86°25' 48°45' 44' 43'

SURFACE RIGHTS ONLY WITHDRAWN FROM STAKING UNDER SEC. 42 OF THE MINING ACT. R.S.O. 1960 FILE: 12288

YPRES POINT YSER PT. MANITOBA SHOAL BLONDIN ISLAND HAWKINS ISLAND. Peninsula Harbour

SEE PIC TWP. PLAN FOR STATUS OF HAWKINS AND BLONDIN ISLAND.

SCALE: 1 INCH = 40 CHAINS

DATE OF ISSUE FEB 28 1975

TER

NATIONAL TOPOGRAPHIC SERIES 42D/16

PLAN NO. M. 1861

ONTARIO

MINISTRY OF NATURAL RESOURCES

SURVEYS AND MAPPING BRANCH

P.v.K.

MARTINET LAKE G-601

REFERENCES

AREAS WITHDRAWN FROM DISPOSITION

SURFACE RIGHTS ONLY

DESCRIPTION

(S) SURFACE RIGHTS ONLY

(M) MINING RIGHTS ONLY

(S&M) SURFACE AND MINING RIGHTS ONLY

WATER NO CUTTING ALLOWED

RESERVED

RECORDED

'92 MAR 25 PM 1 20

THUNDER BAY MINING DIVISION

THE INFORMATION THAT APPEARS ON THIS MAP HAS BEEN COMPILED FROM VARIOUS SOURCES AND ACCURACY IS NOT GUARANTEED. THOSE WISHING TO STAKE MINING CLAIMS SHOULD CONSULT WITH THE MINING RECORDER, MINISTRY OF NORTHERN DEVELOPMENT AND MINES, FOR ADDITIONAL INFORMATION ON THE STATUS OF THE LANDS SHOWN HEREON.

LEGEND

DISPOSITION OF CROWN LANDS

TYPE OF DOCUMENT — STATUS

PATENT, LEASE & LICENSE OF OCCUPATION

SURFACE RIGHTS ONLY

MINING RIGHTS ONLY

SURFACE AND MINING RIGHTS

MINING RIGHTS ONLY

LEASE

LICENCE OF OCCUPATION

SAND & GRAVEL

LAND USE PERMITS FOR COMMERCIAL TOURISM OUTPOST CAMPS

NOTE: SUBSURFACE RIGHTS RESERVED TO THE CROWN IN PATENTS, LEASES AND LICENCES OF OCCUPATION ISSUED AFTER OCTOBER 1, 1913.

SCALE: 1 INCH = 40 CHAINS

AREA

SEELEY LAKE

M.N.R. ADMINISTRATIVE DISTRICT

TERRACE BAY

MINING DIVISION

THUNDER BAY

LAND TITLES / REGISTRY DIVISION

THUNDER BAY

Ontario Ministry of Natural Resources — Land Management Branch

DATE: FEBRUARY 1982

Number: G-613

SERVICE ONTARIO

GRAIN TWP. — FOR STATUS REFER TO G-628

COLDWELL TWP.

McCOY TWP.

O'NEILL TWP.

LAKE SUPERIOR

RED SUCKER POINT INDIAN RESERVE

DISTRICT

PROJECTED

TEMPORARILY WITHDRAWN FROM DISPOSITION MAR. 22, 1967 — FILE 172503

DETAIL PLAN OF YPRES POINT

DETAIL PLAN OF YPRES POINT

TEMPORARILY WITHDRAWN FROM DISPOSITION MAR. 22, 1967 — FILE 172503

Ypres Pt.

Ypres Pt.

MANITOBA SHOAL

BLONDIN I.

HAWKINS I.

PENINSULA HARBOUR

SEE PIC TOWNSHIP PLAN FOR STATUS OF HAWKINS AND BLONDIN ISLANDS

SCALE: 40 ch. = 1 in.

Marathon Aerodrome TW170

File 133500

799-96 Ac. ±

REF-127776

North Limit of PIC

Twp.

Angler

Charleston Pt.

Bluebee Cove

Redsucker Cove

Garden Cove

Native Chapelle Pt.
























SEE G-613

CORNA LAKE G-598

TRIM TO THIS LINE ALL AROUND

G-613

1861

Martinet Lake Area (M-2488)

AREA OF

SEELEY LAKE

DISTRICT OF
THUNDER BAY

PORT ARTHUR
MINING DIVISION

SCALE: 1-INCH = 40 CHAINS

LEGEND

PATENTED LAND	(P)
CROWN LAND SALE	C.S.
LEASES	(L)
LOCATED LAND	Loc.
LICENSE OF OCCUPATION	L.O.
MINING RIGHTS ONLY	M.R.O.
SURFACE RIGHTS ONLY	S.R.O.
ROADS	
IMPROVED ROADS	
KING'S HIGHWAYS	
RAILWAYS	
POWER LINES	
MARSH OR MUSKEG	
MINES	
CANCELLED	C.

NOTES

400' Reserve around all Lakes & Rivers to Dept. of Lands & Forests.

Land under water in Lake Superior withdrawn from staking by Order in Council dated April 30, 1912.

Limits of Marathon Improvement District shown thus: File 129282, Vol. I.

DETAIL PLAN OF YPRES POINT

SCALE: 1 INCH = 40 CHAINS

PLAN NO. M. 1861

DEPARTMENT OF MINES
— ONTARIO —

1964

Twp. 79 (M-1923)

Twp. 78 (M-1921)

Lorna Lake Area (M-2487)

LAKE SUPERIOR

TWP. 77

TWP. 76

PIC TWP.
FOR STATUS REFER TO TWP PLAN

See Detail Plan Of YPRES POINT

PROJECTED LINE

CANADIAN PACIFIC

Willie Lake

Loco Deer Lake

Craddock Lake

Craddock Cove

Redsucker Cove

Peninsula Bay

Sturdee Cove

Mons Pt.

Charleroy Pt.

Glasgow I.

Good Hope I.

Monmouth I.

Beauty Cove

Nauve Chapelle Pt.

Garden Cove

Angler

Falconbridge

Geordie

Skipper Lake

Skipper Cr.

Boom Lake

Lake Creek

Transmission Line

Pic River

Aerodrome




Tower Site Files 180T04

O.H.C. Park Site Section P-302

Port Booking Grounds Munro File 135770 L.O. 6416

S.R.O. Wildrawn from staking

Ypres Point

Yser Pt.

Manitoba Shoal

Blondin Island

Hawkins Island

Peninsula Harbour

SEE PICTAP PLAN FOR STATUS OF HAWKING AND BLONDIN ISLANDS.

S.R.O. withdrawn from staking - Sec. 41

86°30' 86°15' 48°52'30" 48°45' 52' 51' 50' 49' 48' 47' 46'

29' 28' 27' 26' 22' 21' 20' 19' 18' 17' 16'

487962

1861

Martinet Lake Area (M-2488)

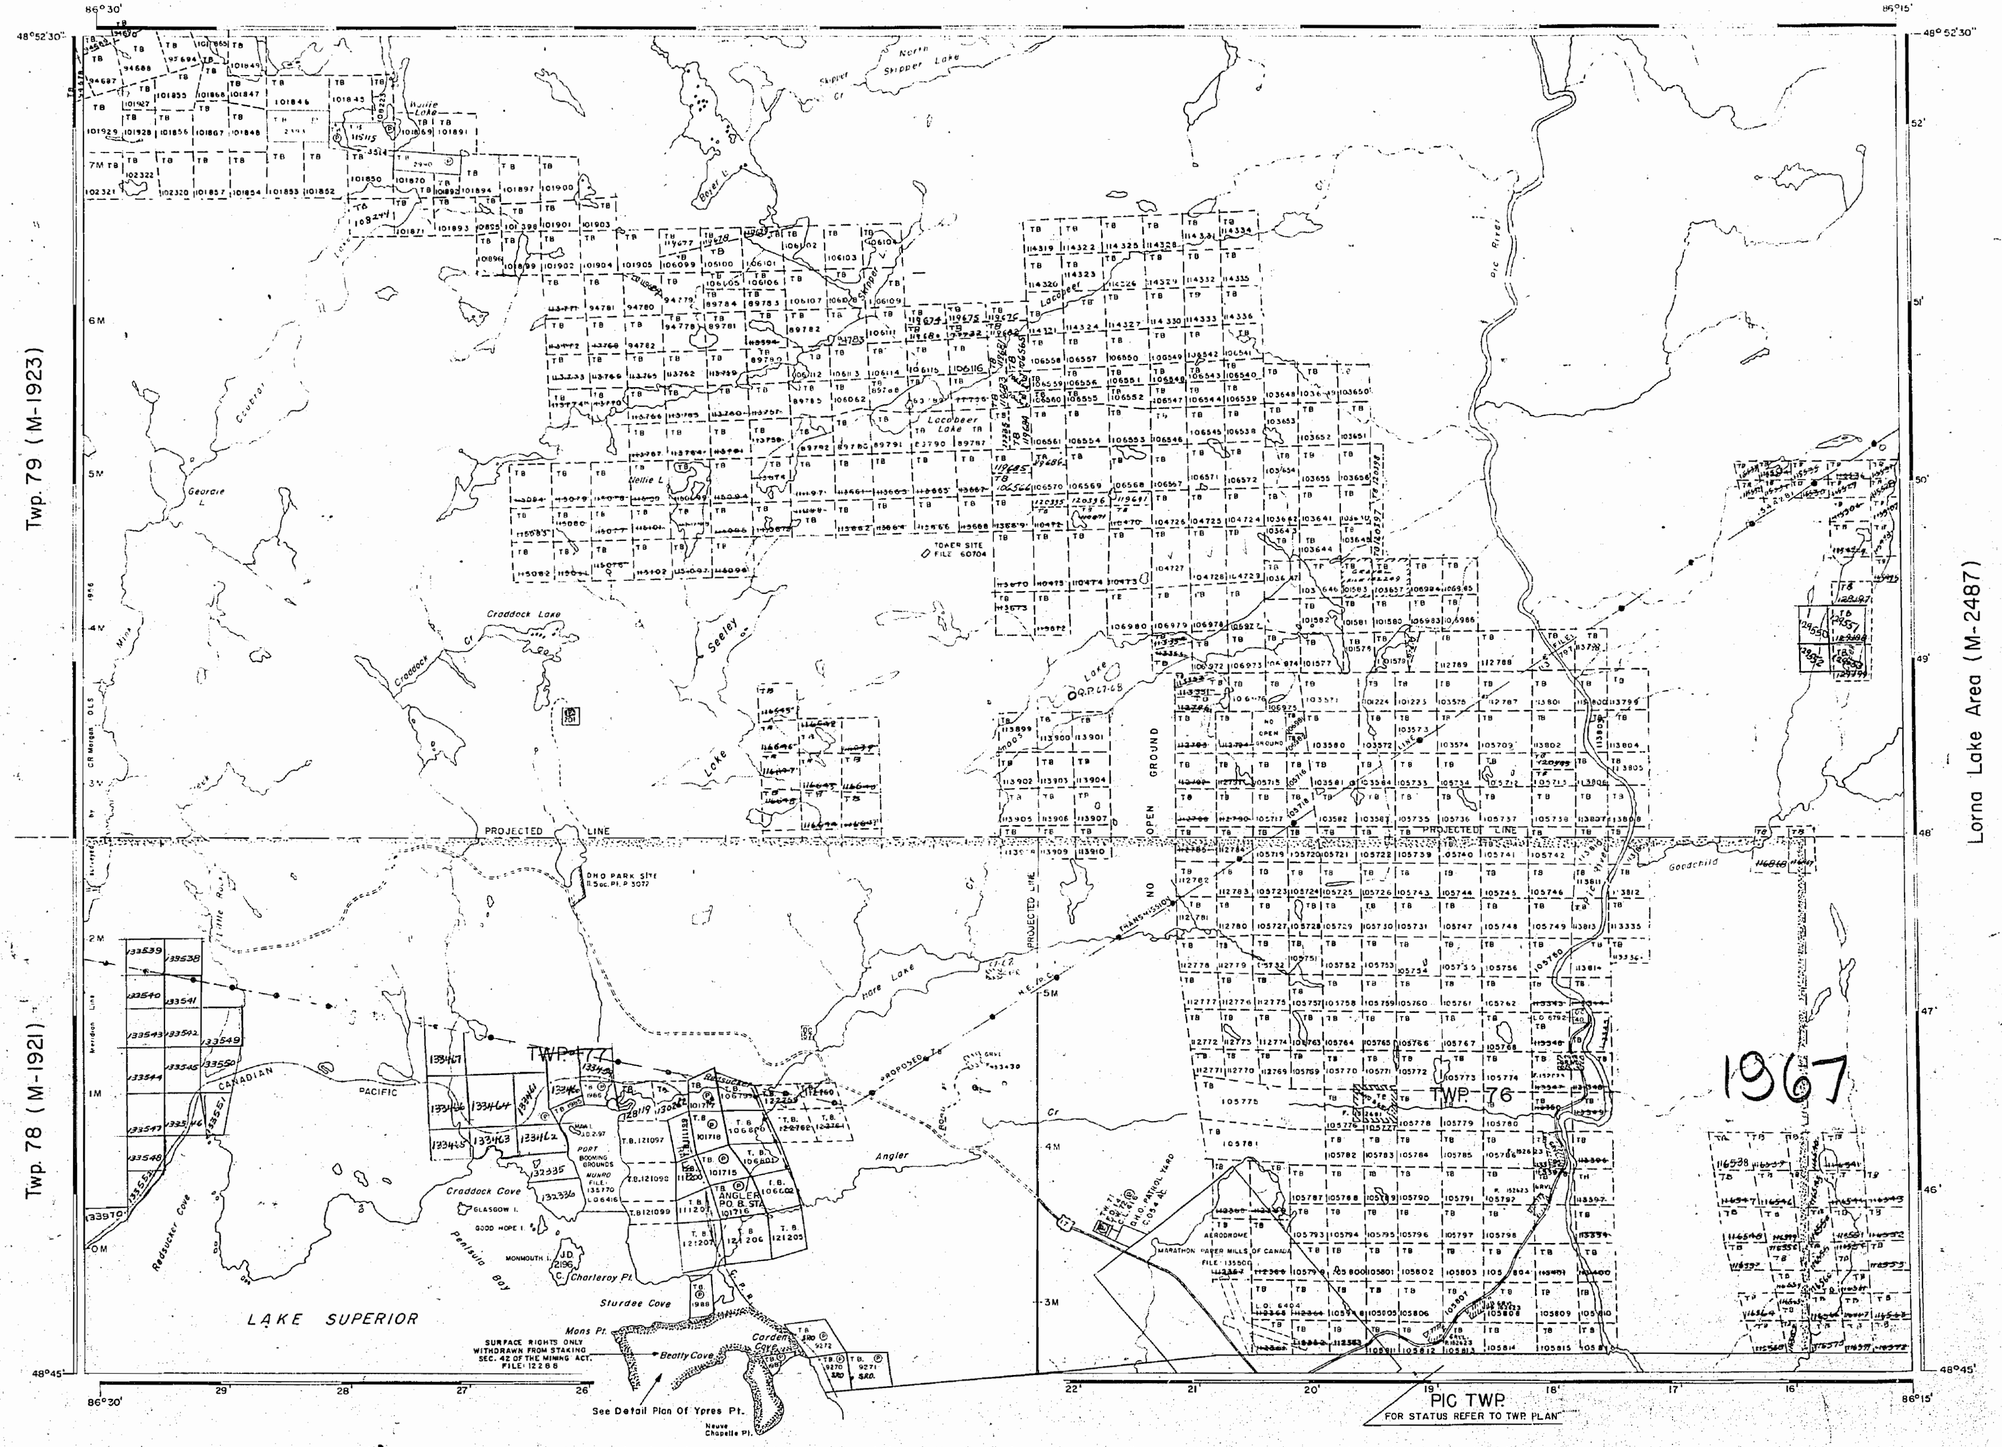

AREA OF

SEELEY LAKE

DISTRICT OF
THUNDER BAY

PORT ARTHUR
MINING DIVISION.

SCALE: 1-INCH = 40 CHAINS

LEGEND

PATENTED LAND	(P)
CROWN LAND SALE	C.S.
LEASES	(L)
LOCATED LAND	Loc.
LICENSE OF OCCUPATION	L.O.
MINING RIGHTS ONLY	M.R.O.
SURFACE RIGHTS ONLY	S.R.O.
ROADS	
IMPROVED ROADS	
KING'S HIGHWAYS	
RAILWAYS	
POWER LINES	
MARSH OR MUSKEG	
MINES	
CANCELLED	C.

NOTES

400' SURFACE RIGHTS RESERVATION AROUND ALL LAKES AND RIVERS.

Land under water in Lake Superior withdrawn from staking by Order In Council dated April 30, 1912.

LIMITS OF MARATHON IMPROVEMENT DISTRICT SHOWN THUS: FILE: 129282

DETAIL PLAN OF YPRES POINT.

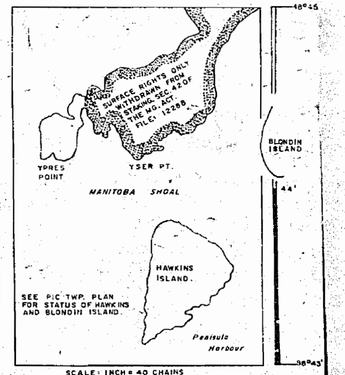

PT. ARTHUR MINING DIV.
RECEIVED
JAN 5 1967

PLAN NO. M. 1861

DEPARTMENT OF MINES
— ONTARIO —

1861

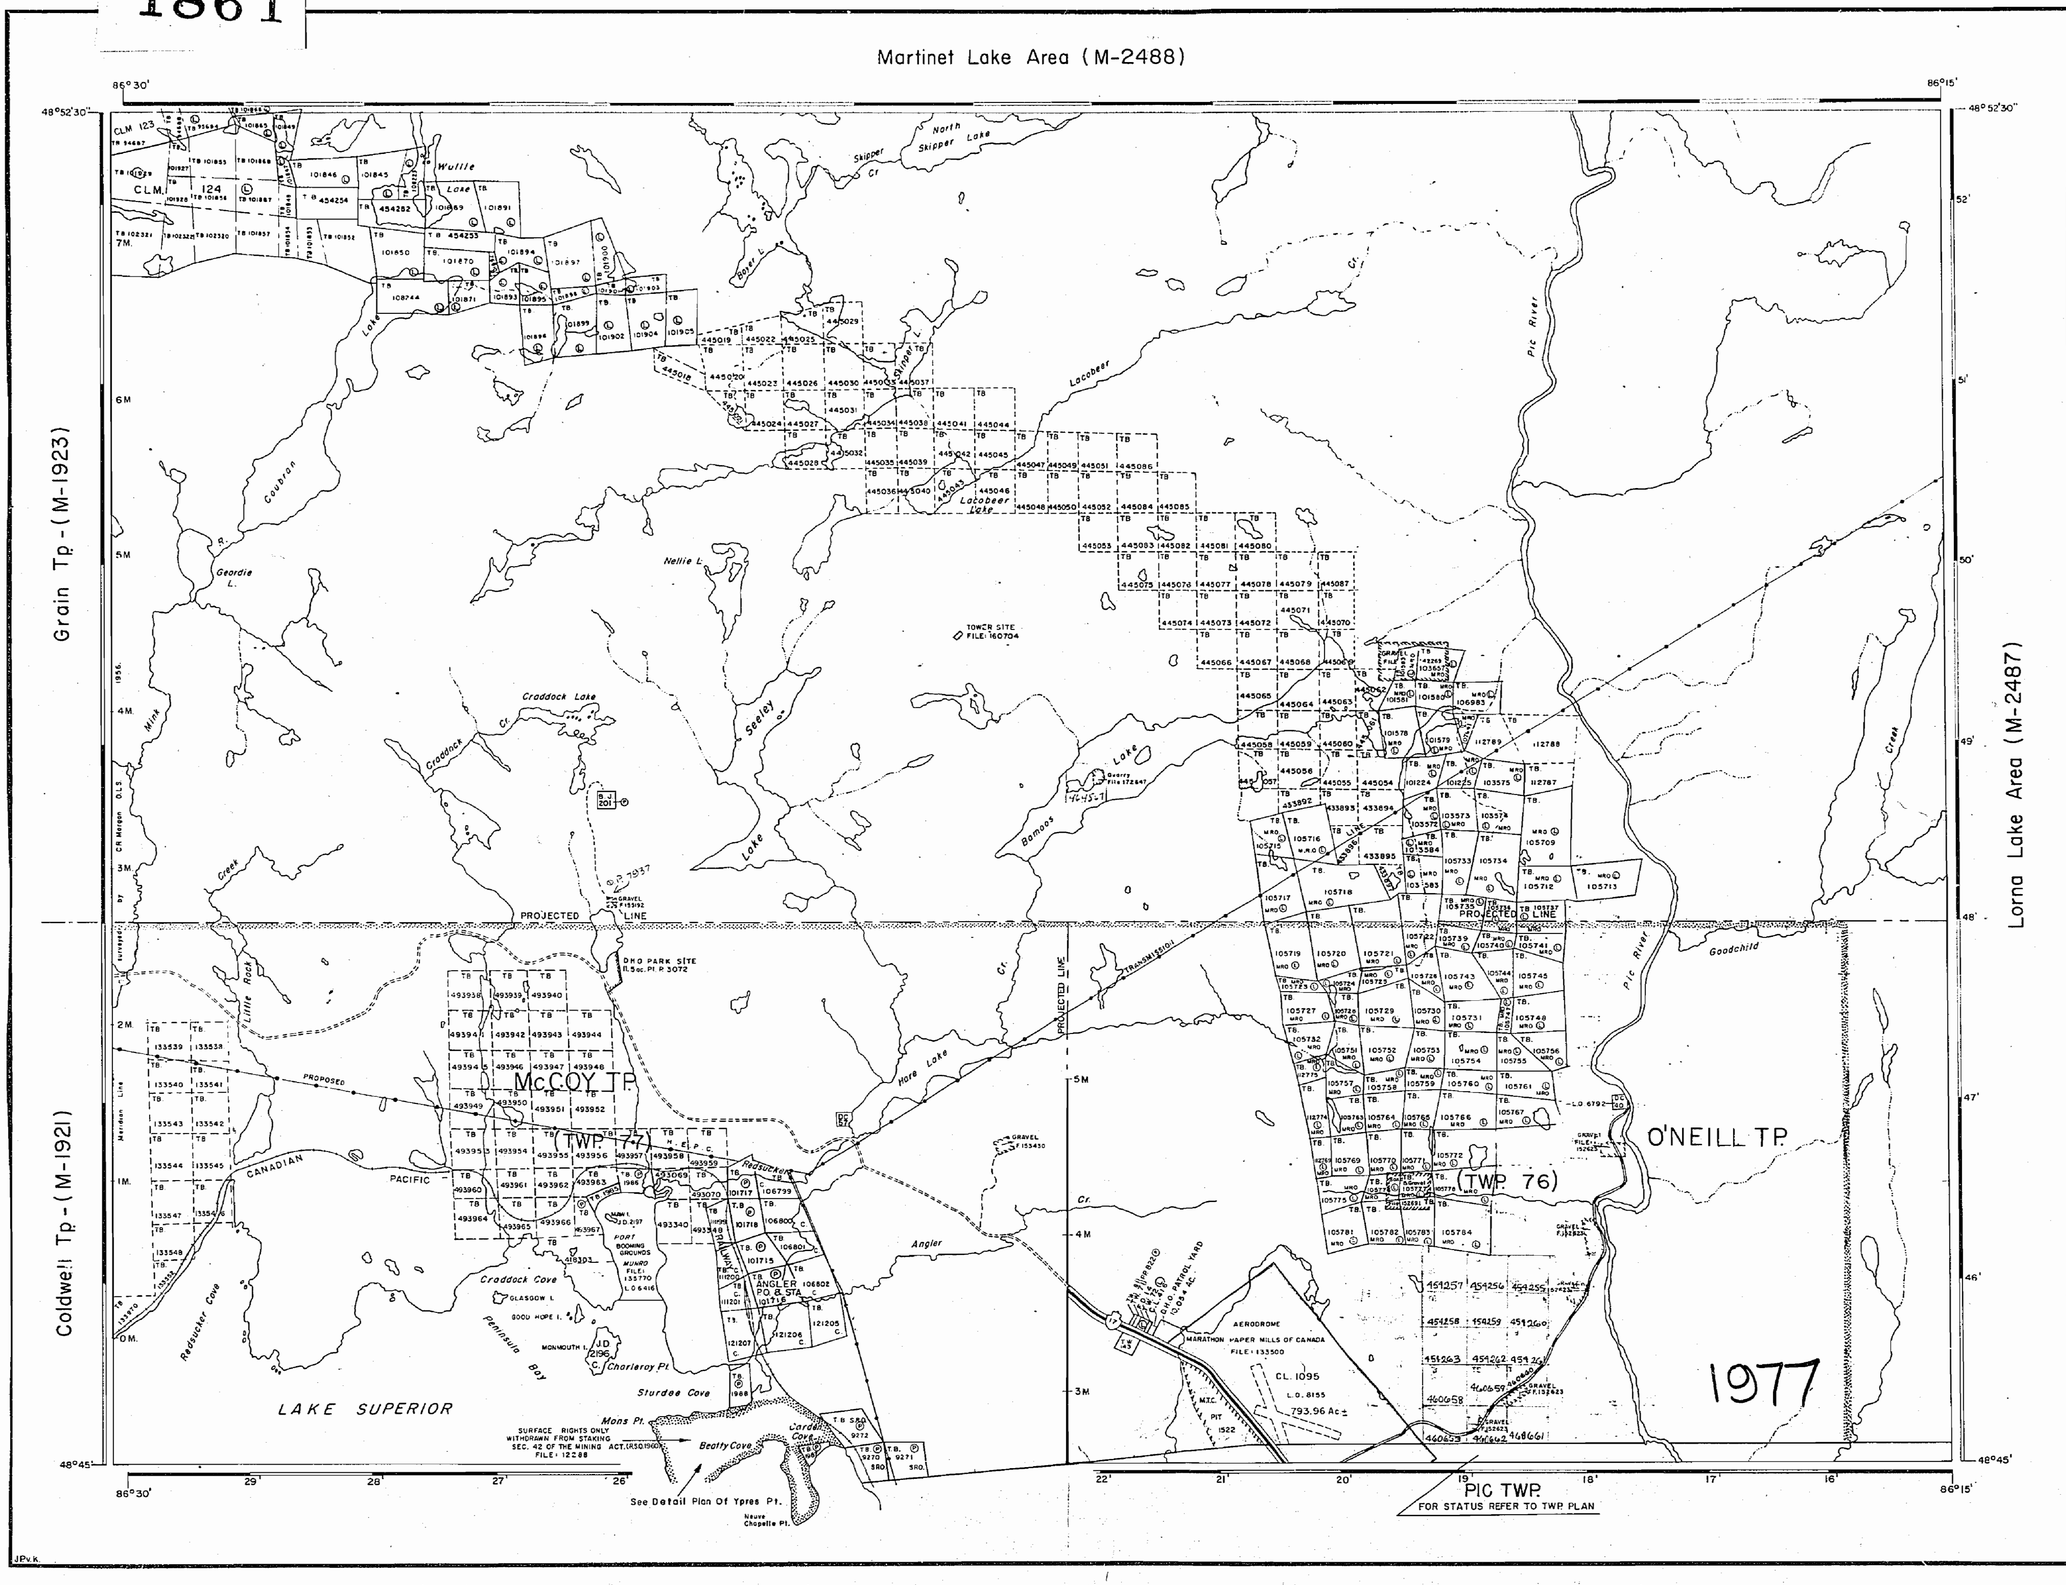

AREA OF

SEELEY LAKE

DISTRICT OF THUNDER BAY

THUNDER BAY MINING DIVISION

SCALE: 1-INCH = 40 CHAINS

LEGEND

PATENTED LAND	Ⓟ
CROWN LAND SALE	C.S.
LEASES	Ⓛ
LOCATED LAND	Loc.
LICENSE OF OCCUPATION	L.O.
MINING RIGHTS ONLY	M.R.O.
SURFACE RIGHTS ONLY	S.R.O.
ROADS	
IMPROVED ROADS	
KING'S HIGHWAYS	
RAILWAYS	
POWER LINES	
MARSH OR MUSKEG	
MINES	
CANCELLED	C.

NOTES

400' surface rights reservation along the shores of all lakes and rivers.

Land under water in Lake Superior withdrawn from staking by Order In Council dated April 30, 1912.

LIMITS OF MARATHON IMPROVEMENT DISTRICT SHOWN THUS: FILE: 129282

DETAIL PLAN OF YPRES POINT

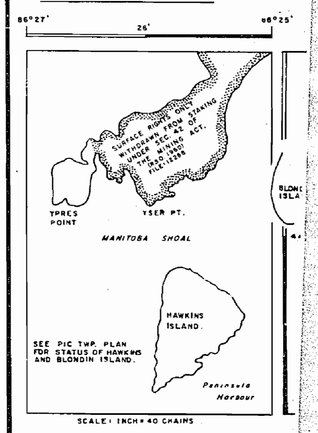

TERRACE BAY DISTRICT
NATIONAL TOPOGRAPHIC SERIES 42D

PLAN NO. M. 1861

March 21, 1977 ONTARIO

MINISTRY OF NATURAL RESOUR

SURVEYS AND MAPPING BRANCH

1861

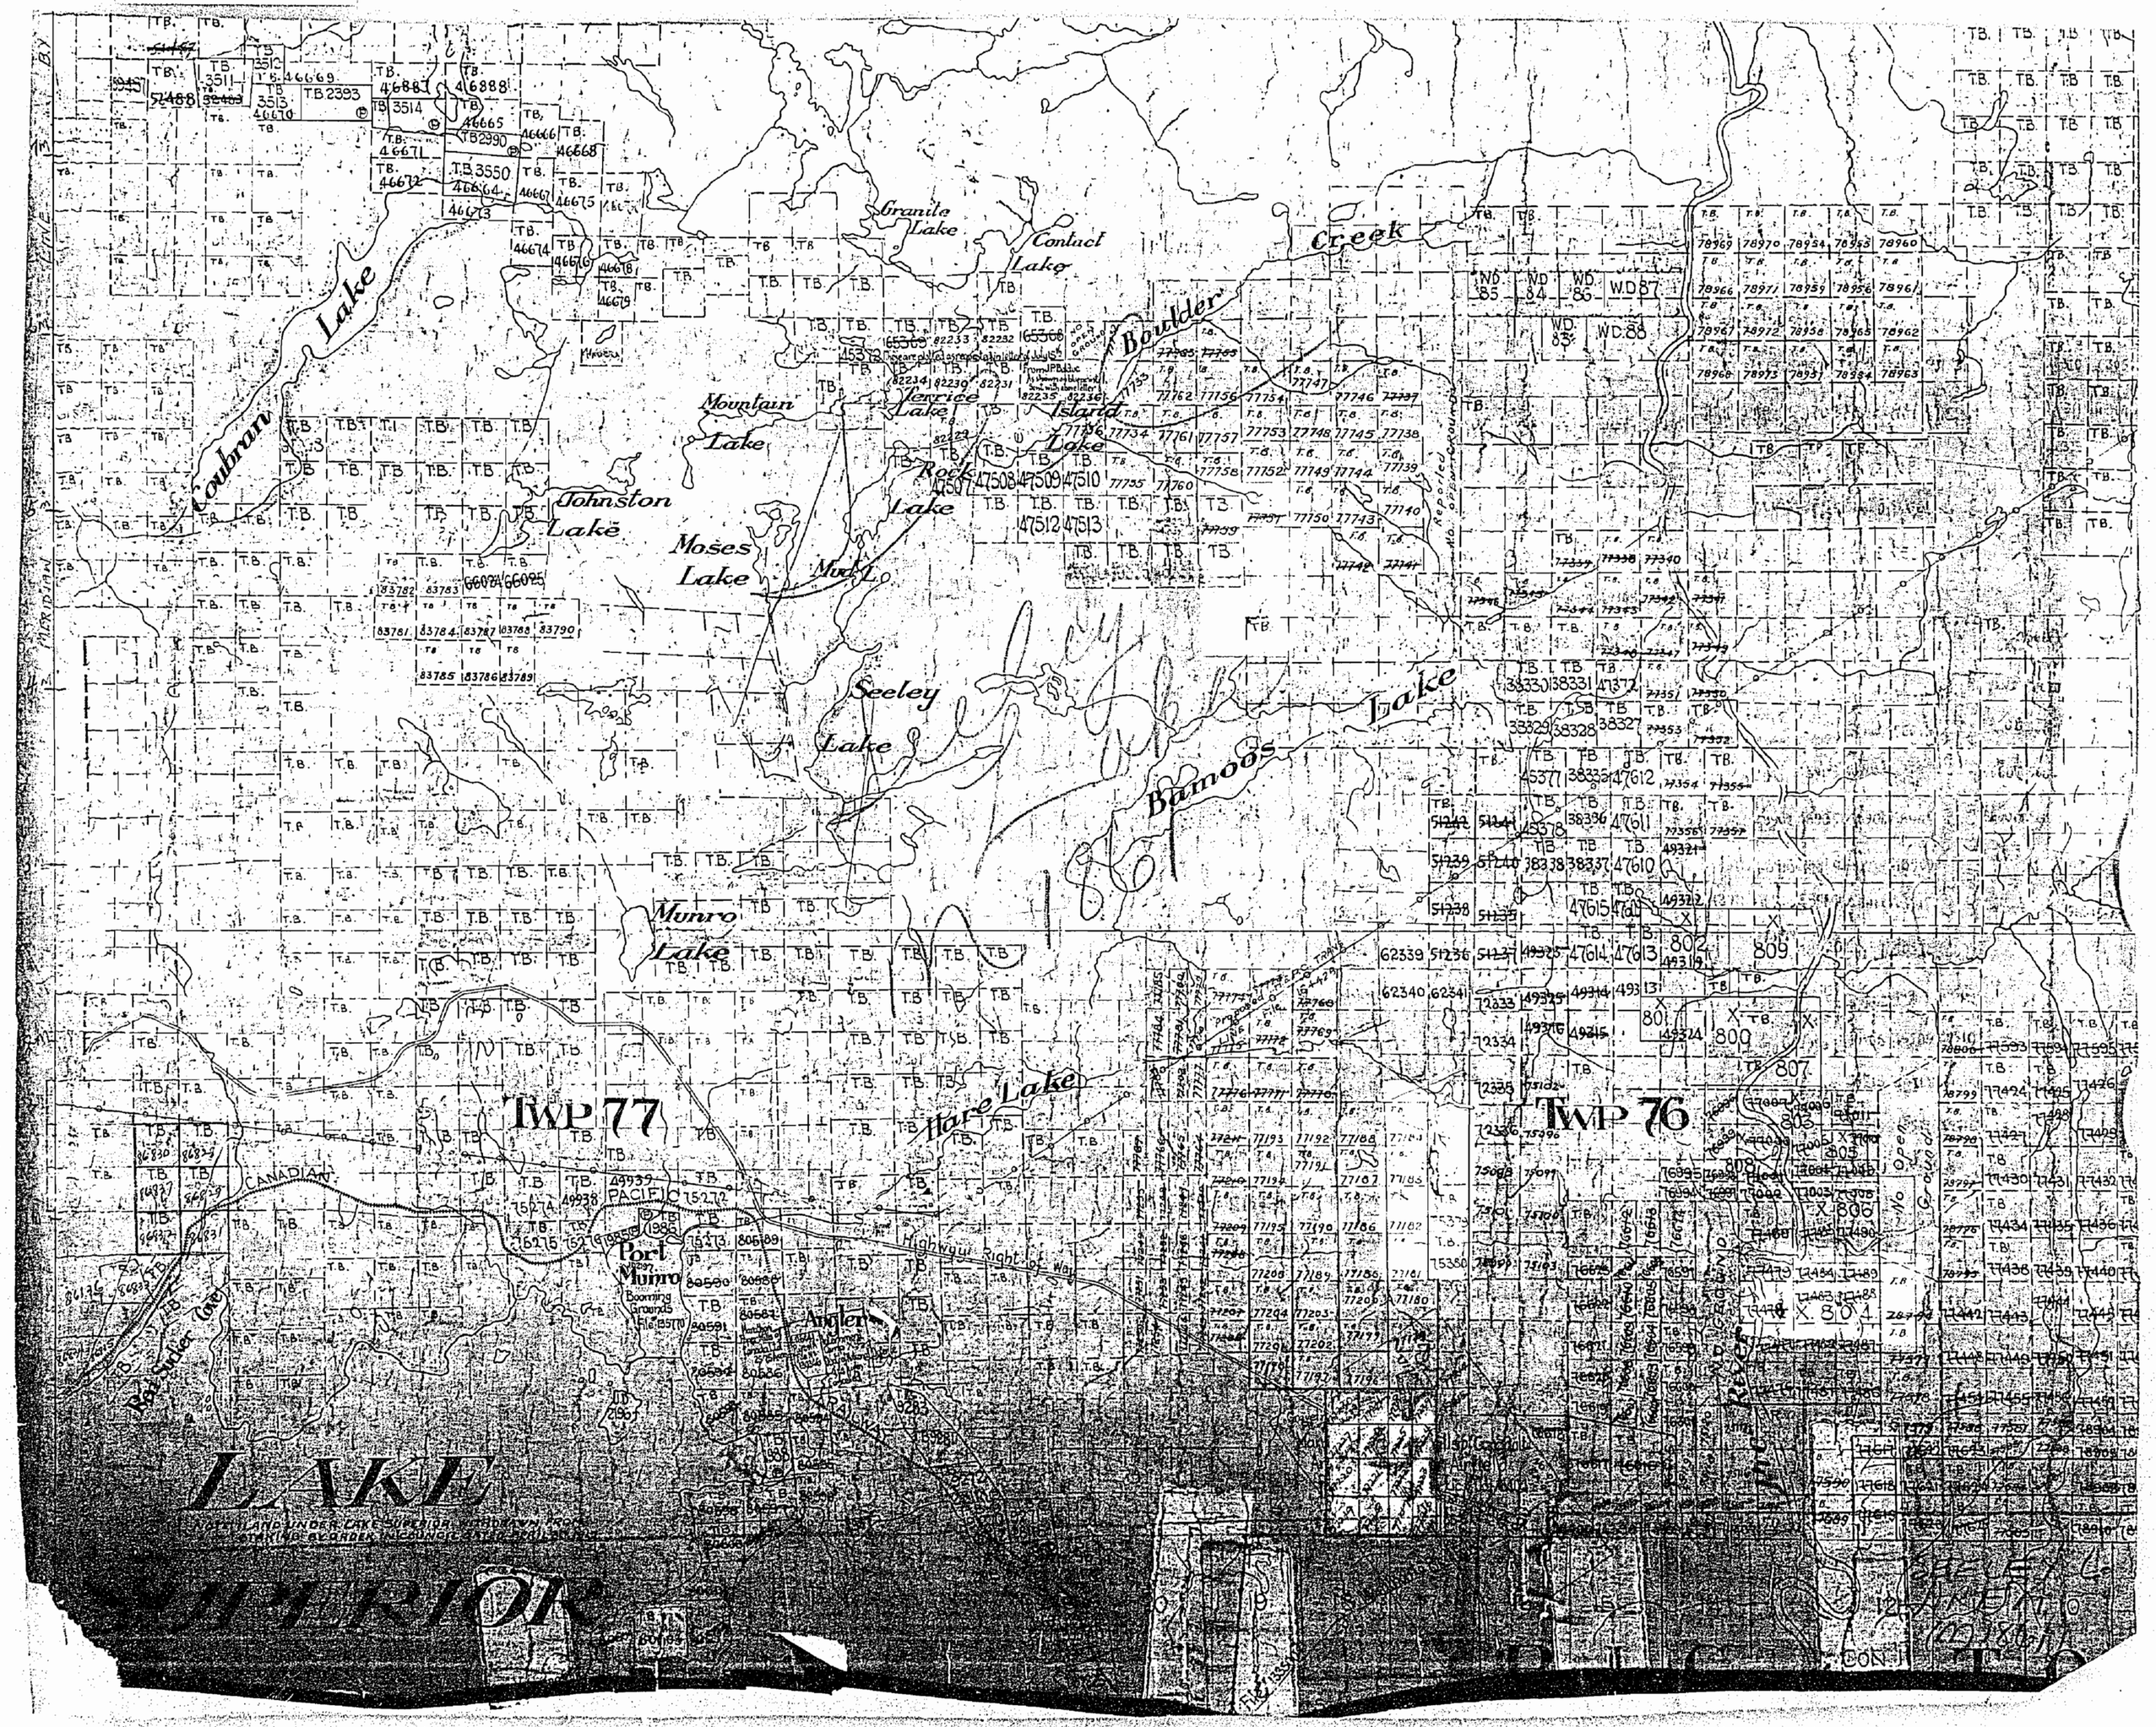
Granite Lake
Contact Lake
Boulder Creek
Mountain Lake
Terrace Lake
Island Lake
Rock Lake
Johnston Lake
Moses Lake
Mud L.
Seeley Lake
Bamoos Lake
Munro Lake
Hare Lake
TWP 77
TWP 76
Port Munro
Booming Grounds
Angler
CANADIAN PACIFIC
Highway Right of Way
LAKE SUPERIOR
MERIDIAN

1861

Martinet Lake Area (M-2488)

AREA OF

SEELEY LAKE

DISTRICT OF
THUNDER BAY

PORT ARTHUR
MINING DIVISION

SCALE: 1-INCH = 40 CHAINS

LEGEND

PATENTED LAND	(P)
CROWN LAND SALE	C.S.
LEASES	(L)
LOCATED LAND	Loc.
LICENSE OF OCCUPATION	L.O.
MINING RIGHTS ONLY	M.R.O.
SURFACE RIGHTS ONLY	S.R.O.
ROADS	
IMPROVED ROADS	
KING'S HIGHWAYS	
RAILWAYS	
POWER LINES	
MARSH OR MUSKEG	
MINES	
CANCELLED	C.

NOTES

400' Reserve around all Lakes & Rivers to Dept. of Lands & Forests.

Land under water in Lake Superior withdrawn from staking by Order In Council dated April 30, 1912

Limits of Marathon Improvement District shown thus: File: 129282, Vol. I.

DETAIL PLAN OF YPRES POINT

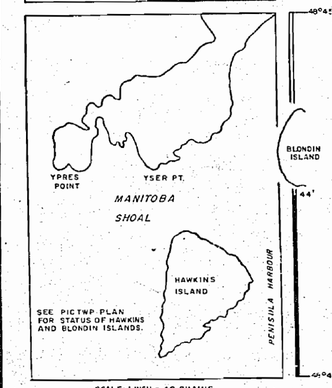

SCALE: 1 INCH = 40 CHAINS

PLAN NO. M. 1861

DEPARTMENT OF MINES
— ONTARIO —

1964

Twp. 79 (M-1923)

Twp. 78 (M-1921)

Lorna Lake Area (M-2487)

LAKE SUPERIOR

TWP 77

TWP 76

PIC TWP
FOR STATUS REFER TO TWP PLAN

PROJECTED LINE

See Detail Plan Of YPRES POINT

487362

1861

Martinet Lake Area (M-2488)

AREA OF

SEELEY LAKE

DISTRICT OF
THUNDER BAY

PORT ARTHUR
MINING DIVISION

SCALE: 1-INCH = 40 CHAINS

LEGEND

PATENTED LAND	(P)
CROWN LAND SALE	C.S.
LEASES	(L)
LOCATED LAND	Loc.
LICENSE OF OCCUPATION	L.O.
MINING RIGHTS ONLY	M.R.O.
SURFACE RIGHTS ONLY	S.R.O.
ROADS	
IMPROVED ROADS	
KING'S HIGHWAYS	
RAILWAYS	
POWER LINES	
MARSH OR MUSKEG	
MINES	
CANCELLED	C.

NOTES

400' SURFACE RIGHTS RESERVATION AROUND ALL LAKES AND RIVERS.

Land under water in Lake Superior withdrawn from staking by Order In Council dated April 30, 1912.

LIMITS OF MARATHON IMPROVEMENT DISTRICT SHOWN THUS: FILE: 129282

DETAIL PLAN OF YPRES POINT.

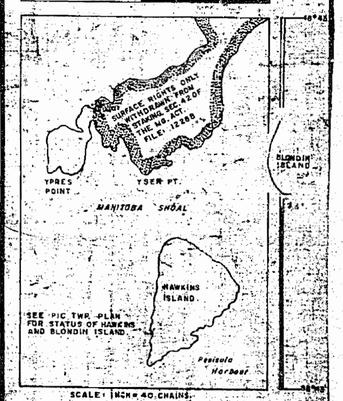

PLAN NO. M. 1861

DEPARTMENT OF MINES
— ONTARIO —

1967

1861


Loubrn Lake
Granite Lake
Contact Lake
Boulder Creek
Mountain Lake
Johnston Lake
Moses Lake
Mud L.
Rock Lake
Island Lake
Seeley Lake
Bamoos Lake
Munro Lake
Hare Lake
TWP 77
TWP-76
Port Munro
Angler
Red Sucker Cove
CANADIAN PACIFIC
LAKE SUPERIOR