

THISTLE

TIMISKAMING MINING DIVISION


Scale 40 Chains = 1 inch

M 1156



Overflow colored red
See L.O. No 1575

M-CALLUM

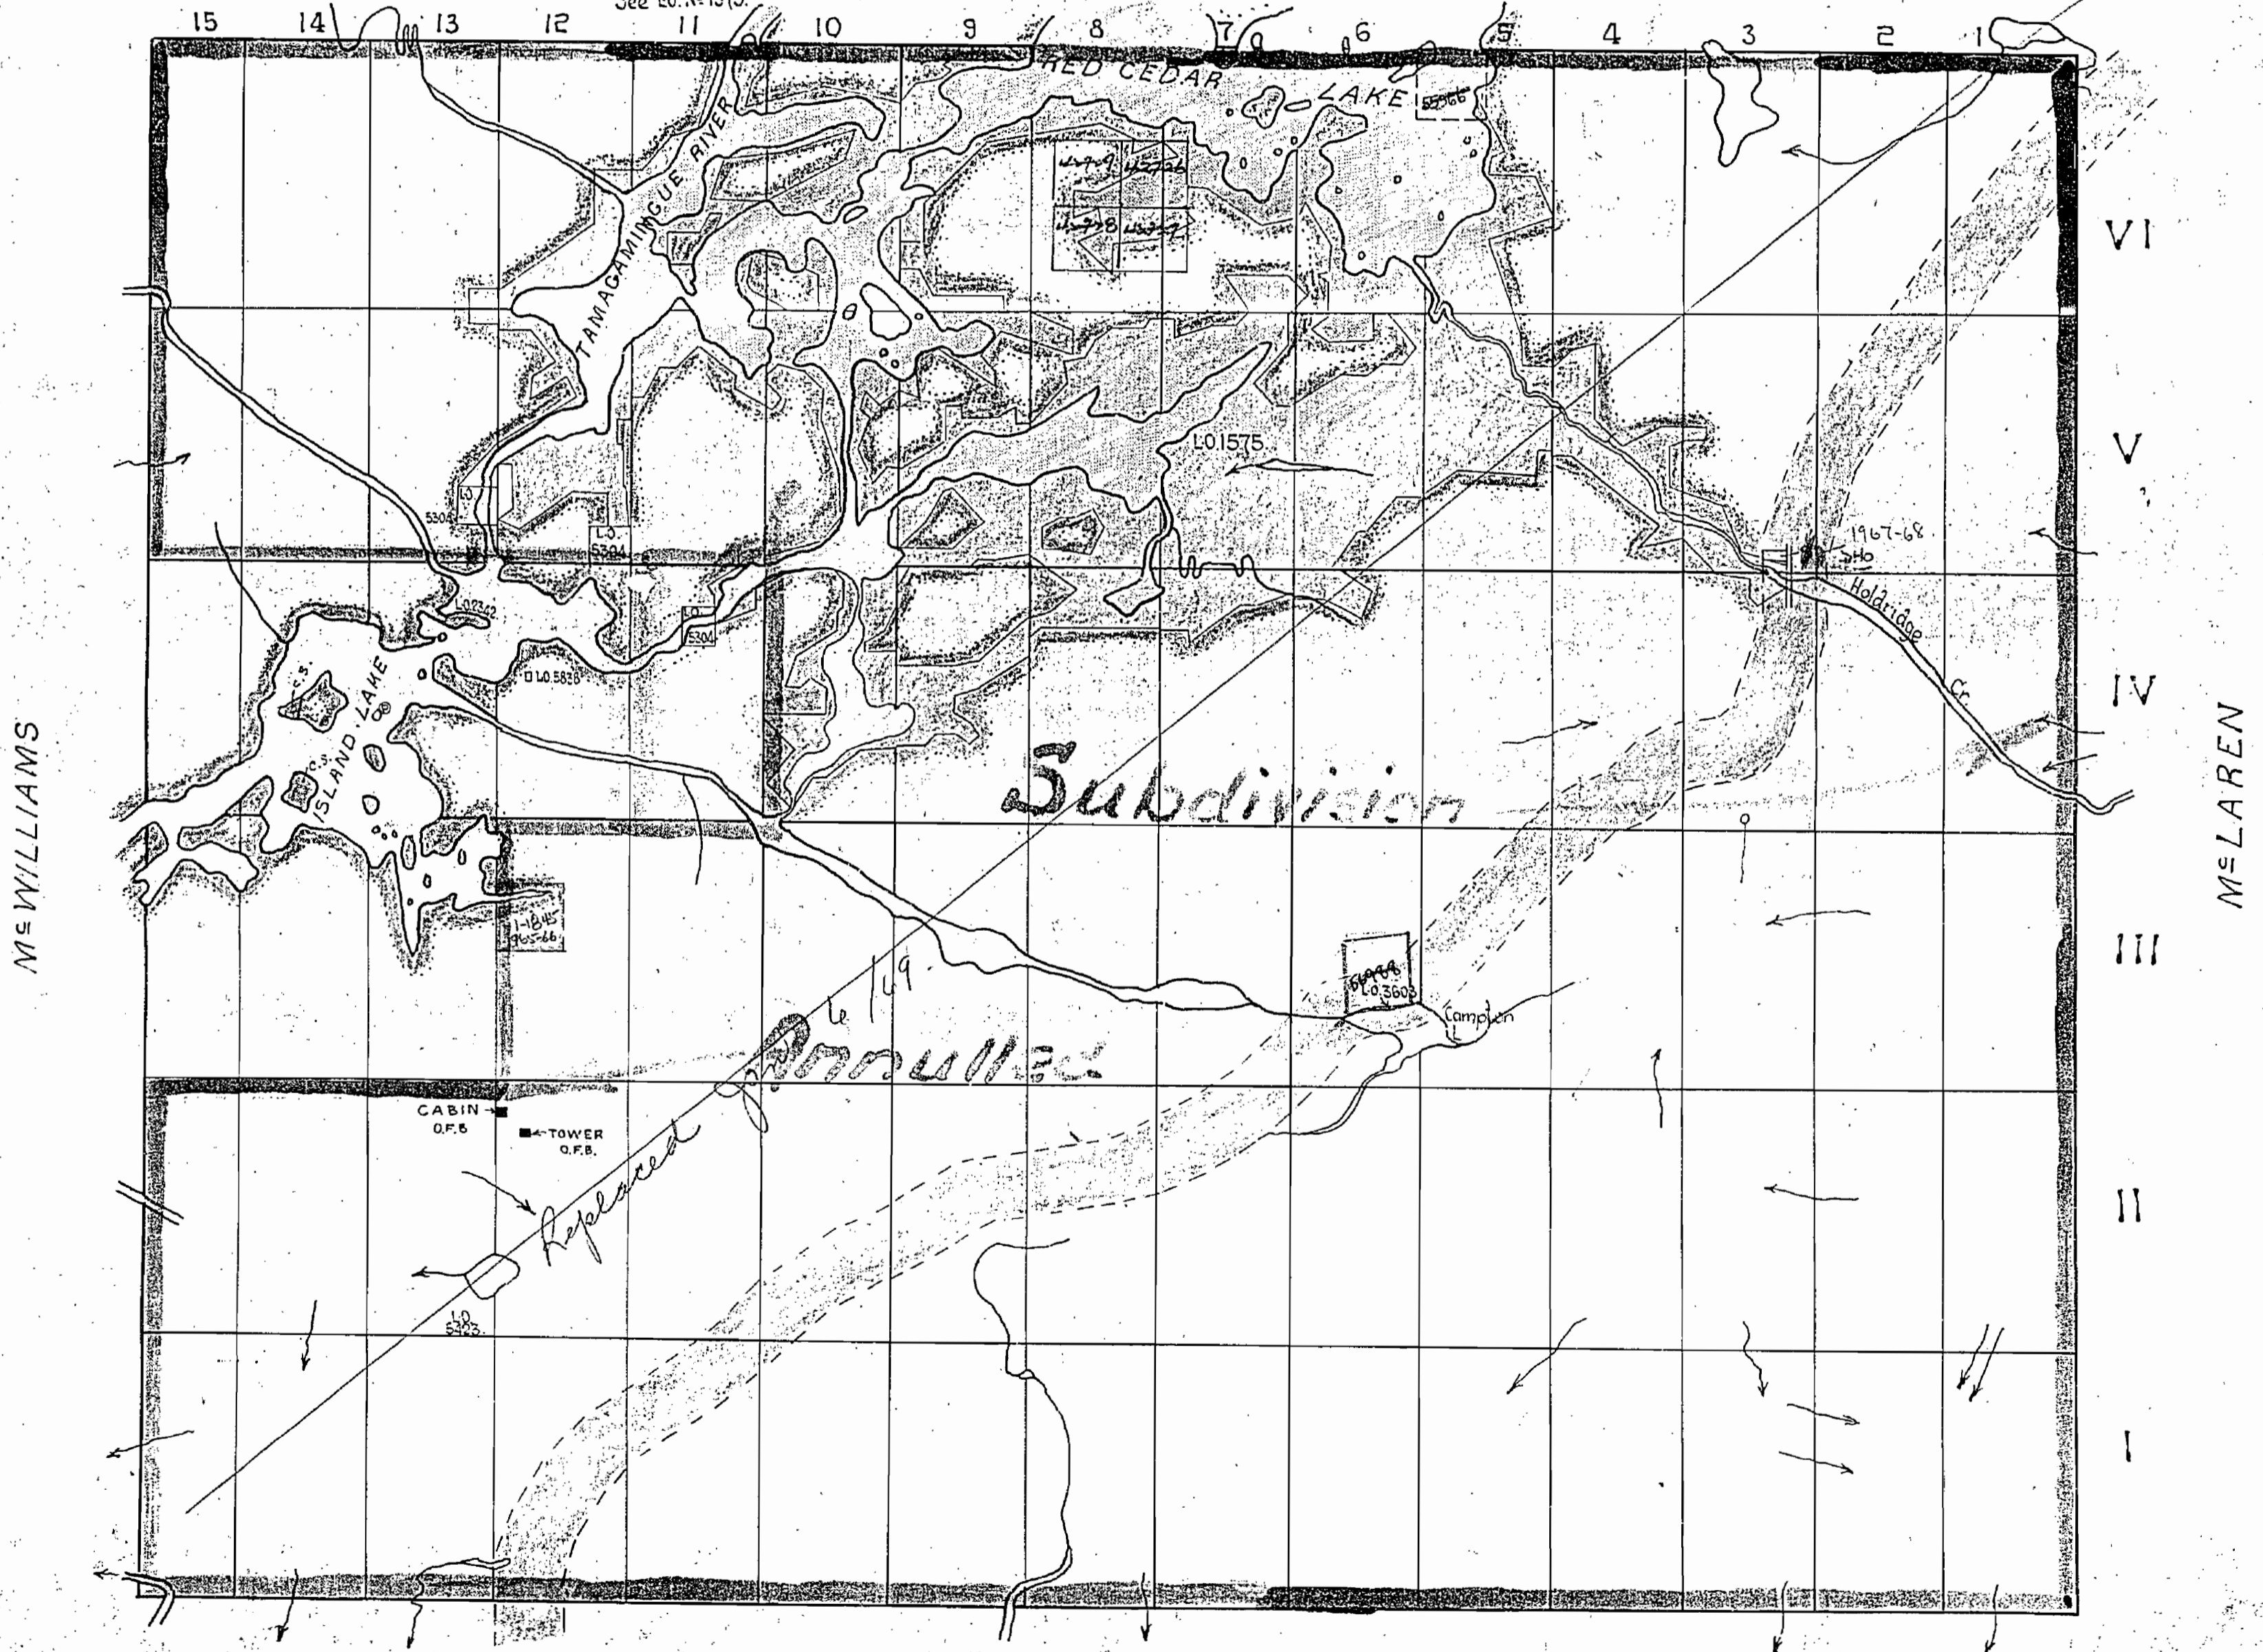

McWILLIAMS

McLAREN

Surface reservations 400' wide by Dept. of L. & F.
shown hereon thus

Note attached plan showing D.H.O. gravel pits

BASTEDO

1156

THISTLE

L'ARDEUR LAKE MINING DIVISION

Scale 40 Chains = 1 inch


M-1156

DATE OF ISSUE
DEC 19 1968
ONTARIO DEPT. OF MINES

ONT. DEPT. OF MINES
MINING LANDS BR.
THIS MAP FOR CHARGING
PURPOSES ONLY - MUST
NOT BE SOLD

Overflow colored red
See L.O. No 1575

McCALLUM

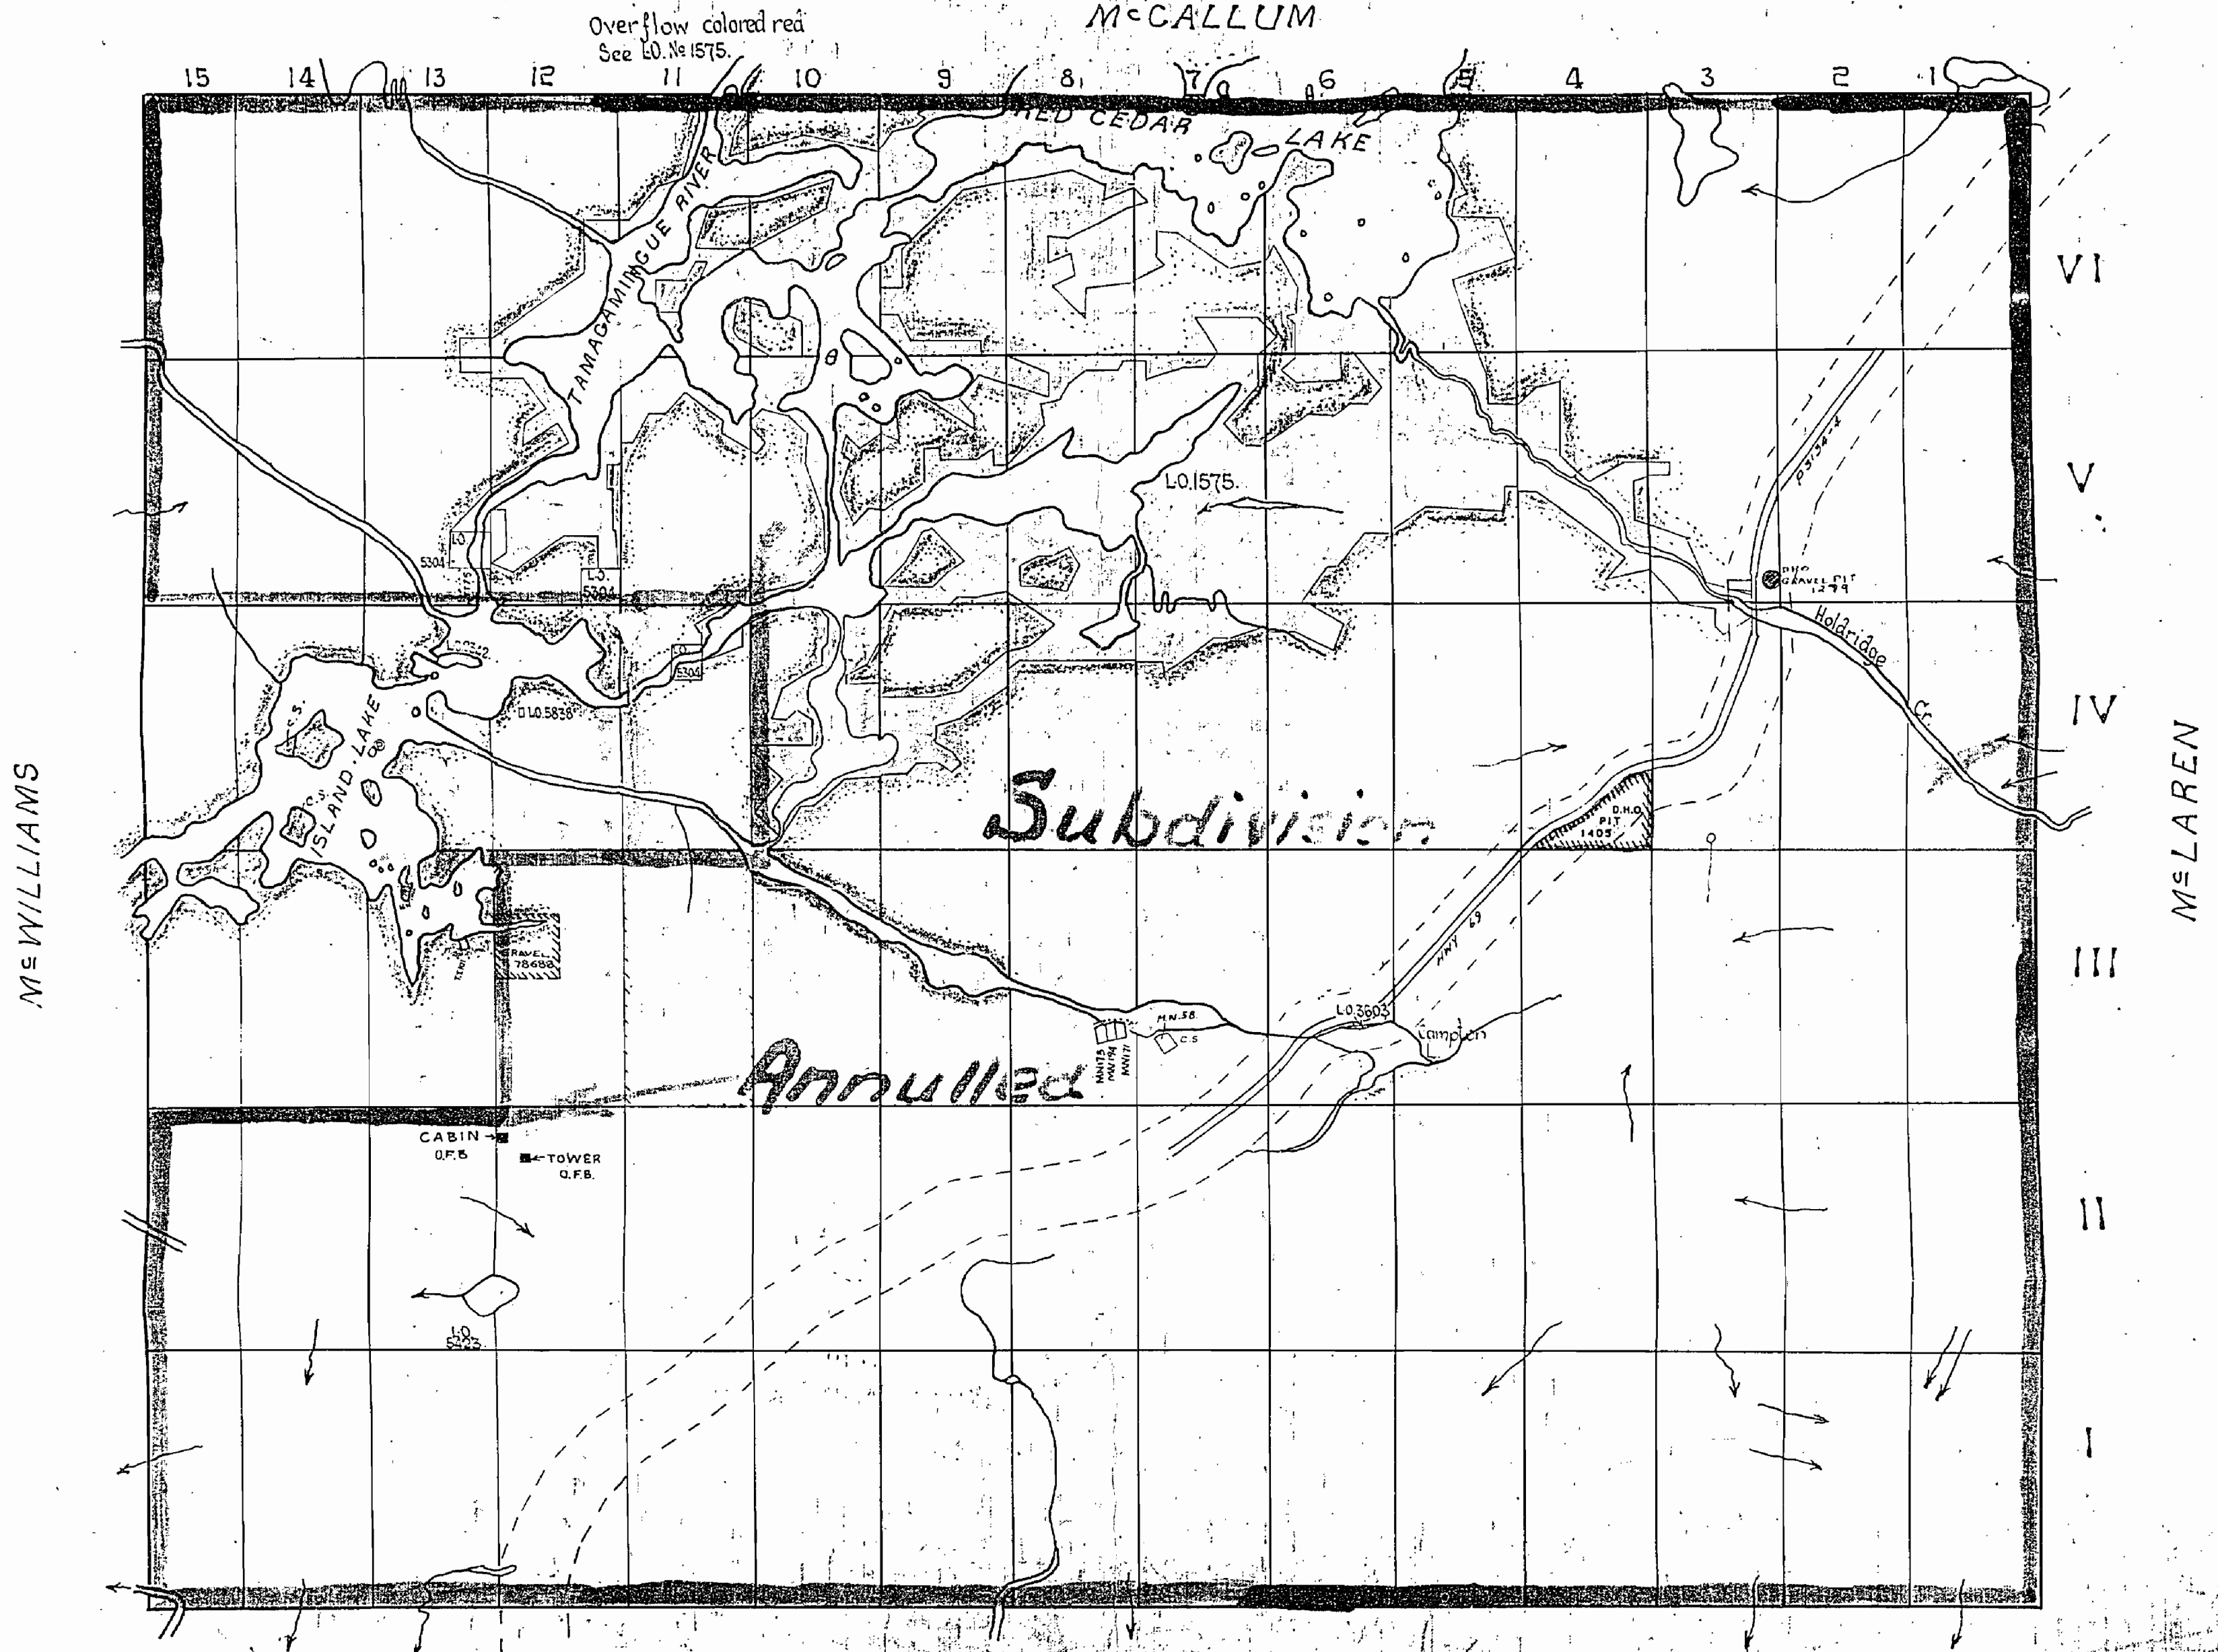

Subdivision

Annulled

CABIN Q.F.B.
TOWER Q.F.B.

BASTEDO

Surface reservations 400' wide by Dept. of L. & F.
shown hereon thus

THISTLE


1156-

LARDER LAKE MINING DIVISION

Scale 40 Chains = 1 inch

Overflow colored red
See L.O. No. 1575.

McCALLUM

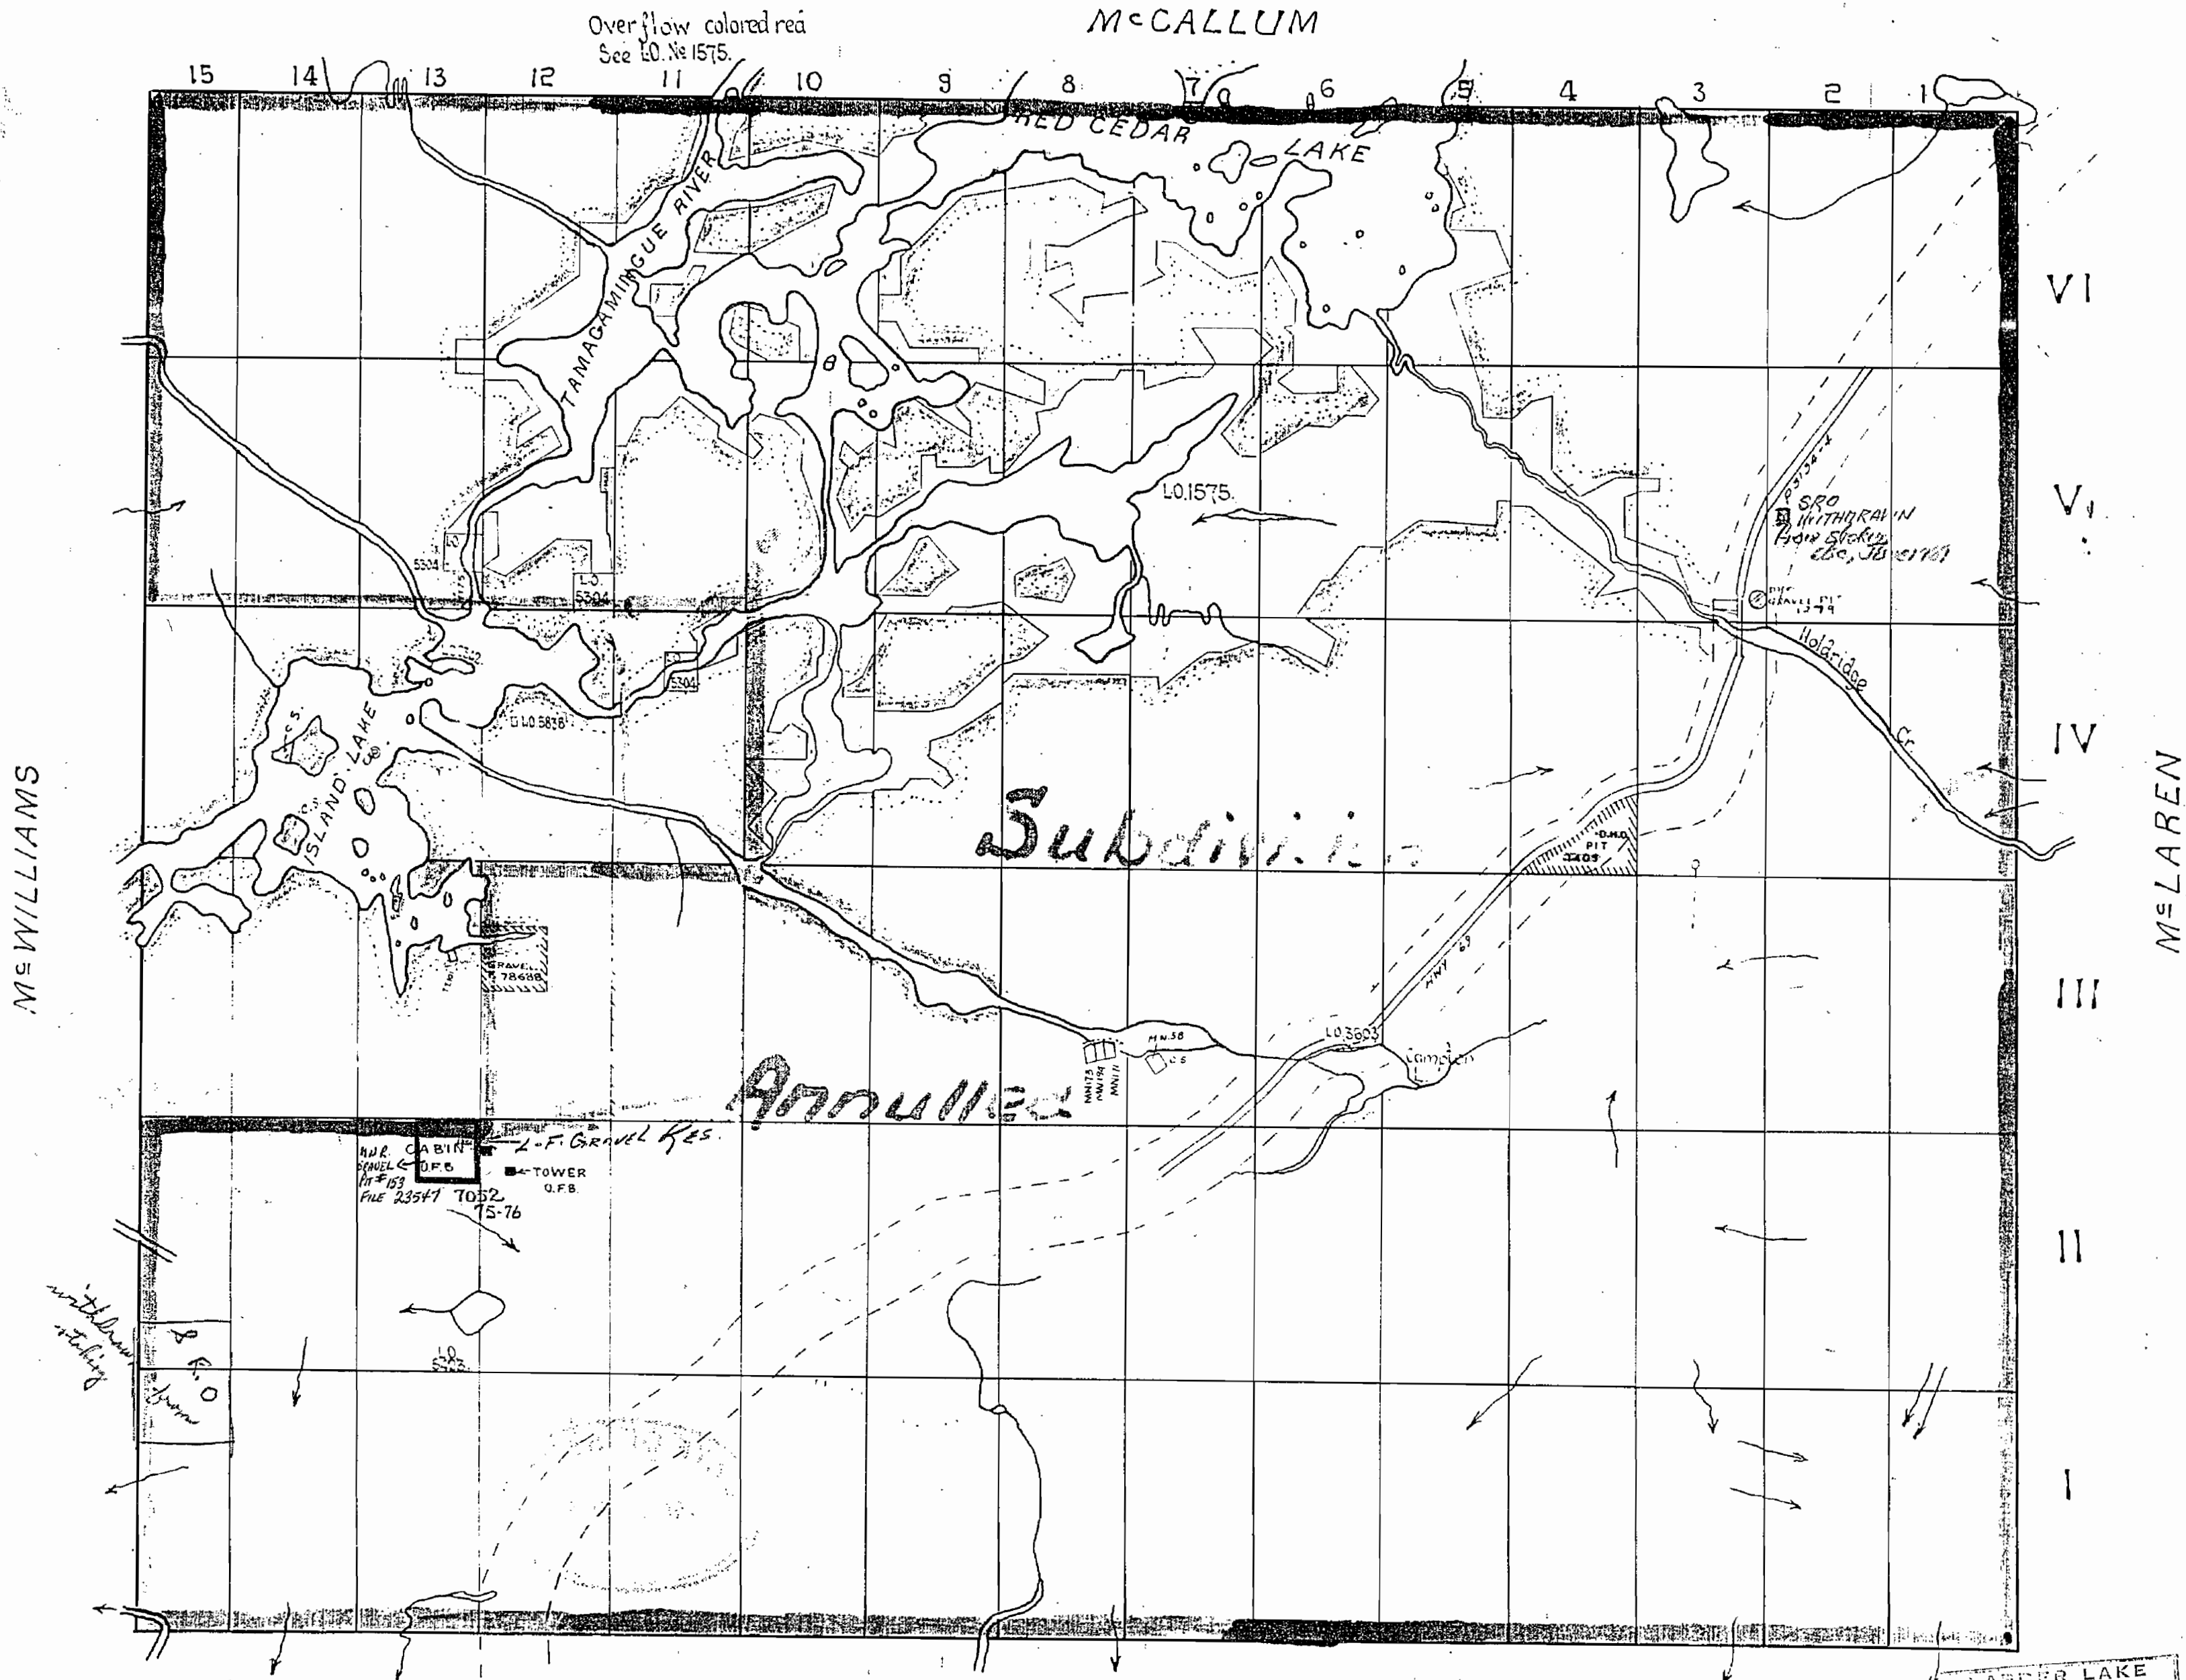

Surface reservations 400' wide by Dept. of L. & F.
shown hereon thus

BASTEDO

LARDER LAKE
MINING DIV.
RECEIVED
JAN 6 - 1969
1156-1156

THISTLE M1156

THISTLE

M. 1156
 ONTARIO
 MINISTRY OF NATURAL RESOURCES
 SURVEYS AND MAPPING BRANCH

SUBBURY MINING DIVISION


* In Service 1983 10 01 - 06

Township closed to staking effective
 May 8 '78, Sec. 387 of Mining Act.

Areas withdrawn from staking under Section
 43 of the Mining Act. (R.S.O. '70)

Scale 40 Chains = 1 inch

Order No.	File	Date	Disposition
W3/80	23547	Oct. 14, '80	S. R. O.
W.7/81		9/12/81	S.R.O.

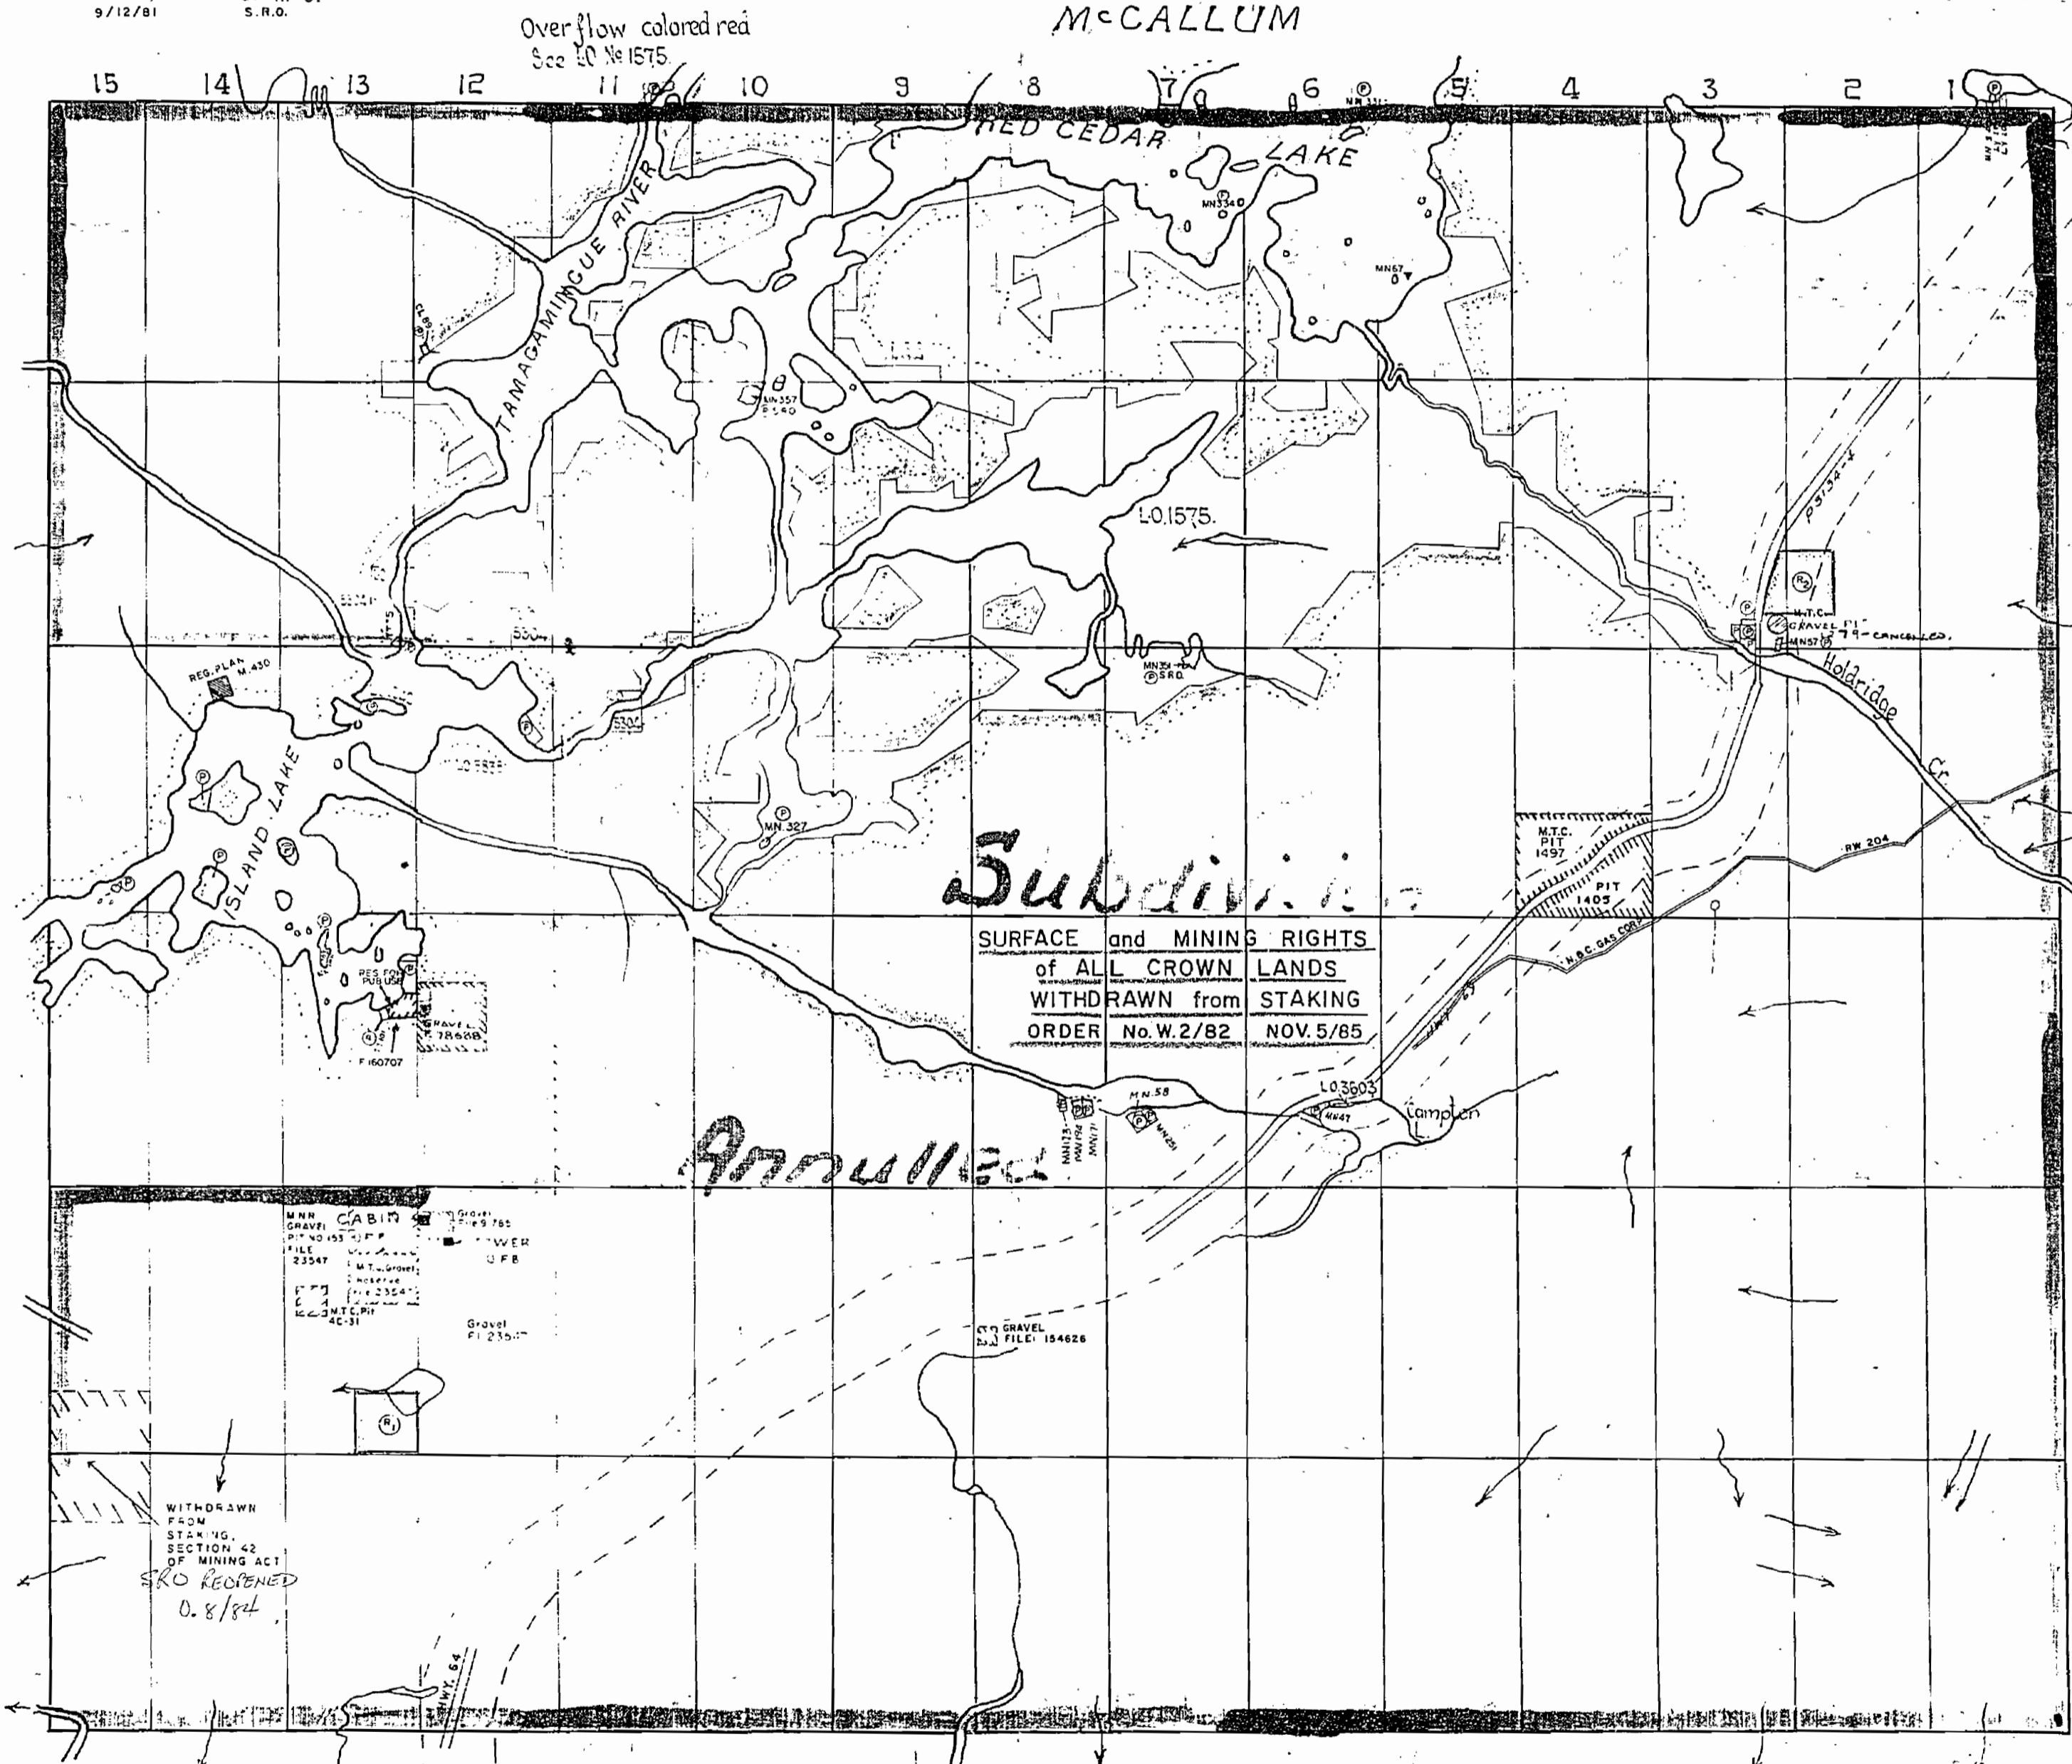

Surface reservations 400 wide by Dept. of L & F
 shown here thus

BASTEDO

THISTLE

MAP SYMBOLS

Aerial Cableway	Pipeline
Boundary	Railroad
International	Single Track
Interprovincial	Double Track
Boundary, Township	Abandoned
Watercourse	Turntable
Approach	Road
Let, Concession	Highway, County
Approach	Township
Park Boundary	Trunk Line (with
Bridge	multiple spans)
Red, Railroad	Trunk Line (with
Building	multiple spans)
Chimney	Rock
Cliff, Pit, Pile	Spur
Contours	Spot Elevation
Interpretation	(see elevation)
Depression	Tower
Control Points	Transmission Line
Horizontal	Pole
Vertical	Pylon
Culvert	Tunnel
Falls	Utility Pole
Deadline over river	Wharf, Dock, Pier
Fence, Hedge, Wall	Wooded Area
Feature Outline	
(Construction features, etc.)	
Flooded Land	
Lock	
Marsh or Swamp	
Mast	
Mine Head Frame	
Outcrop	

AREAS WITHDRAWN FROM DISPOSITION

M.R.O. - MINING RIGHTS ONLY
 S.R.O. - SURFACE RIGHTS ONLY
 M.S. - MINING AND SURFACE RIGHTS

Description	Order No.	Date	Disposition	File
SEC. 36/80	W.37/80	14/10/80	S.R.O.	23547
SEC. 36/80	W.77/81	9/12/81	S.R.O.	160707
SEC. 36/80	W.27/82	5/11/82	M.S.	
PUBLIC USE		11/12/80		160707 & 10541

Part of order W.27/82 REPEALED by order
 O.M.L. O.V.B. HER effective April 2/80 at 7:00 AM E.A.T.


SAND AND GRAVEL

- GRAVEL FILE: 7668
- GRAVEL FILE: 91785
- M.T.C. PIT 4C-31
- M.N.R. GRAVEL PIT NO. 153. FILE: 23547
- GRAVEL FILE: 154626
- M.T.C. PIT 1497
- M.T.C. - THISTLE FIRE TOWER

FLOODING

LO 5304 - Flooding Rights on Red Cedar Lake are reserved to Ont. Hydro to contour 104', File 46198.

NOTE:
 "THIS MAP SHOWS THE APPROXIMATE LOCATION OF THE BOUNDARIES OF THE AREA WHICH IS THE SUBJECT OF CURRENT LITIGATION. THE EXACT LOCATION WILL BE SHOWN FOLLOWING CONFIRMATION BY THE PARTIES TO THE ACTION"

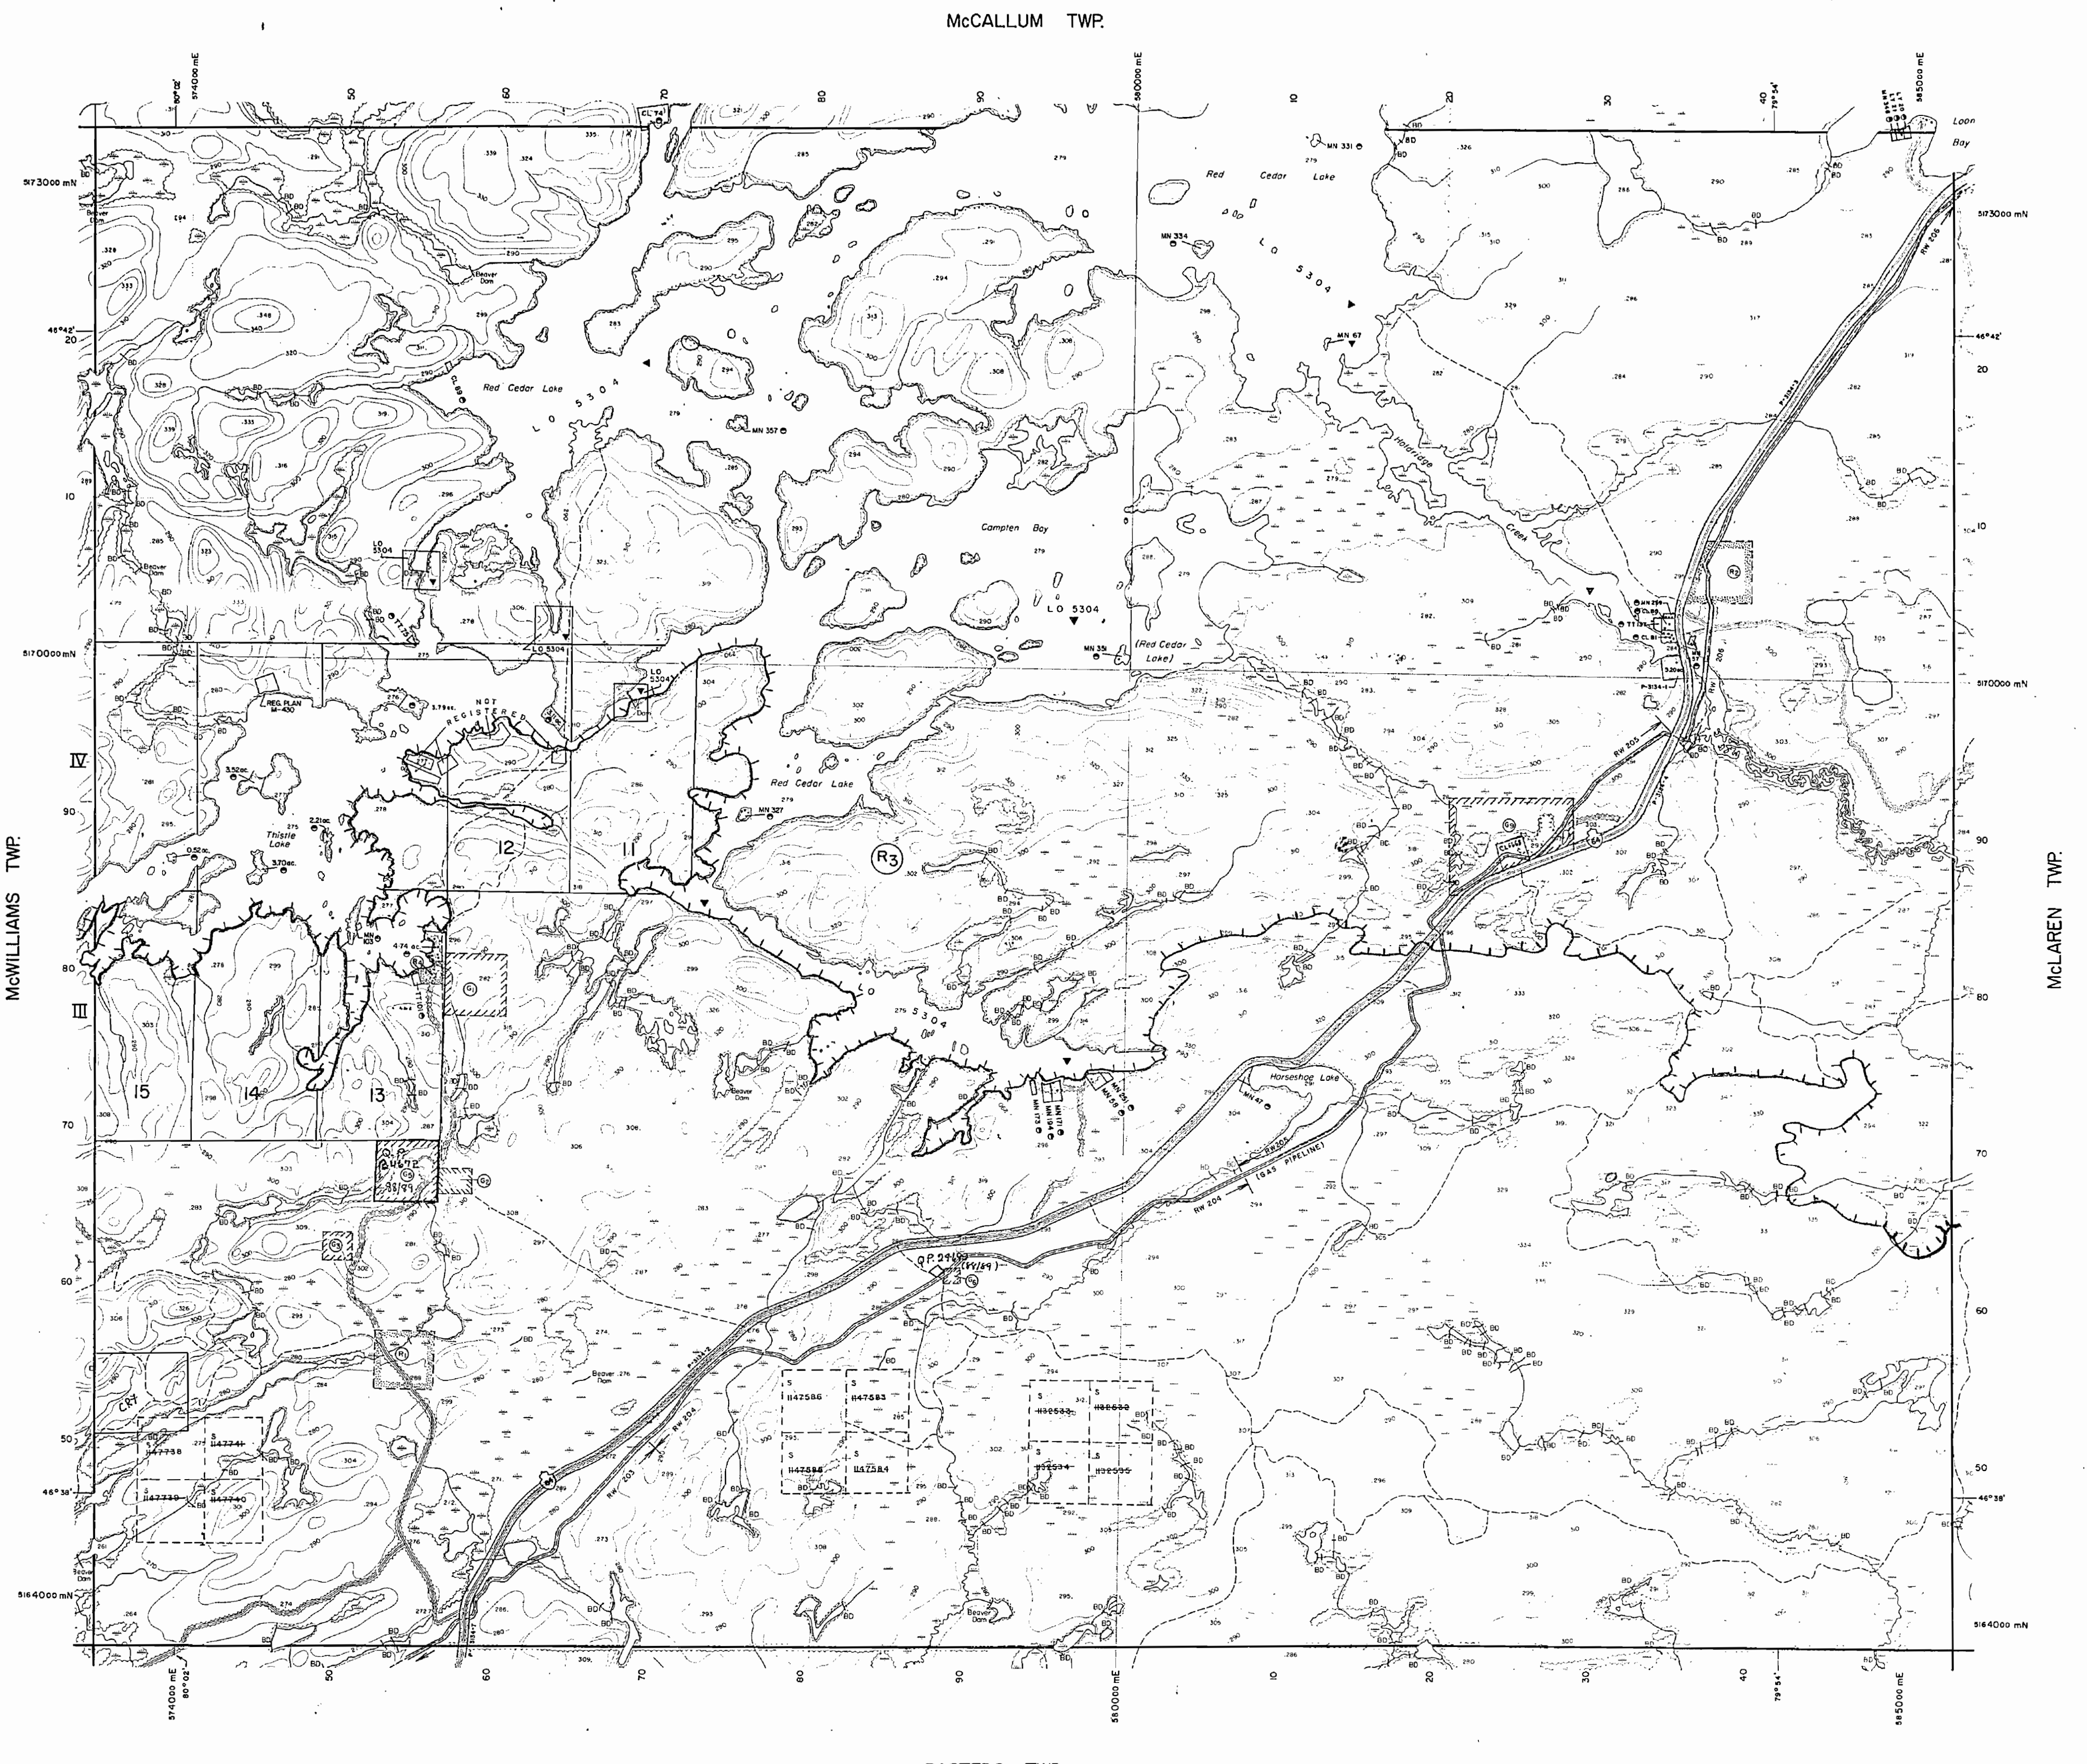


LEGEND

HIGHWAY AND ROUTE No	
OTHER ROADS	
TRAILS	
SURVEYED LINES	
TOWNSHIPS, BASE LINES, ETC	
LOTS, MINING CLAIMS, PARCELS, ETC	
UNSURVEYED LINES	
LOT LINES	
PARCEL BOUNDARY	
MINING CLAIMS ETC	
RAILWAY AND RIGHT OF WAY	
UTILITY LINES	
NON-PERENNIAL STREAM	
FLOODING OR FLOODING RIGHTS	
SUBDIVISION OR COMPOSITE PLAN	
RESERVATIONS	
ORIGINAL SHORELINE	
MARSH OR MUSKOG	
MINES	
TRAVERSE MONUMENT	


DISPOSITION OF CROWN LANDS

TYPE OF DOCUMENT	SYMBOL
PATENT, SURFACE & MINING RIGHTS	●
" SURFACE RIGHTS ONLY	○
" MINING RIGHTS ONLY	○
LEASE, SURFACE & MINING RIGHTS	■
" SURFACE RIGHTS ONLY	□
" MINING RIGHTS ONLY	□
LICENCE OF OCCUPATION	◊
ORDER-IN-COUNCIL	OC
RESERVATION	OC
CANCELLED	○
SAND & GRAVEL	○


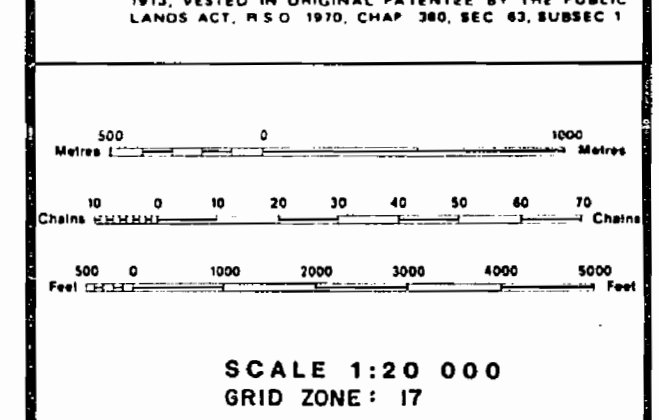

THE SUBDIVISION OF THIS TOWNSHIP INTO LOTS & CONCESSIONS WAS PARTIALLY ANNULLED ON JULY 23, 1953.

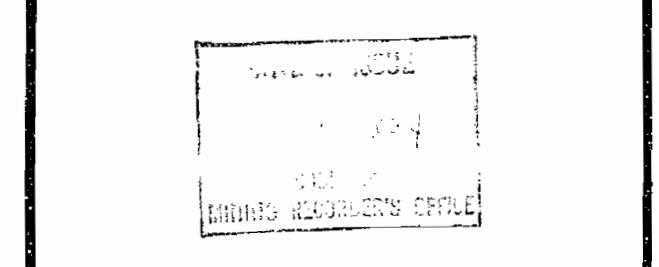

THE INFORMATION THAT APPEARS ON THIS MAP HAS BEEN COMPILED FROM VARIOUS SOURCES, AND ACCURACY IS NOT GUARANTEED. THOSE WISHING TO STAKE MINING CLAIMS SHOULD CONSULT WITH THE MINING RECORDER, MINISTRY OF NORTHERN DEVELOPMENT AND MINES, FOR ADDITIONAL INFORMATION ON THE STATUS OF THE LANDS SHOWN HEREON.

TOWNSHIP
THISTLE
 M.N.R. ADMINISTRATIVE DISTRICT
 NORTH BAY
 MINING DIVISION
 SUDBURY
 LAND TITLES / REGISTRY DIVISION
 NIPISSING

Ministry of Natural Resources
 Land Management Branch

Original Compilation MAY 1985
 Revised

Number
G-2838

G-5838

11212121

G-5838

MAP SYMBOLS

Aerial Cableway	Pipeline
Boundary	Railroad
Canal	Single Track
District, Township	Double Track
Indian Reserve	Interlocking
Aspen, Pine	Interlocking
Log, Concession	Road
Appropriation	Highway, Centre
Post Boundary	Tramway
Bridge	Access (free of essential
Road, Railroad	highway) (roadway)
Building	Trail, Back Road
Chimney	Interlocking, Street
Cliff, Pit, Pile	Rapids
Contours	Double line river
Interpretation	with multiple rapids
Appropriation	Reservoir
Depression	River, Stream, Canal
Control Points	Approximate
Intersect	Location
0 300.00	Station of River
Culvert	Rock
Falls	Shoal
Double line river	Spot Elevation
Fence, Hedge, Wall	(Data collected) 100.0
Feature Outline	Tower
Constitutive Features	Transmission Line
Flooded Land	Pole
Lock	Tunnel
Marsh or Swamp	Utility Poles
Moat	Wharf, Dock, Pier
Mine Head Frame	Wooded Area
Outcrop	

AREAS WITHDRAWN FROM DISPOSITION


M.R.O. - MINING RIGHTS ONLY				
S.R.O. - SURFACE RIGHTS ONLY				
M.S. - MINING AND SURFACE RIGHTS				
Description	Order No.	Date	Disposition	File
① SEC 36/80	W.3/80	14/10/80	S.R.O.	23547
② SEC 36/80	W.7/81	9/12/81	S.R.O.	160707
③ SEC 36/80	W.2/82	5/11/82	M.S.	
④ PUBLIC USE	1	11/12/89		160707 & 12541

Part of order W 2182 prepared by order
O.M. OIPD NER effective April 23/90 at 7:00 AM EST.

FLOODING
LO 5304 - Flooding Rights on Red Cedar Lake are reserved to Ont. Hydro to contour 104', File 4619B.

NOTE:
"THIS MAP SHOWS THE APPROXIMATE LOCATION OF THE BOUNDARIES OF THE AREA WHICH IS THE SUBJECT OF CURRENT LITIGATION. THE EXACT LOCATION WILL BE SHOWN FOLLOWING CONFIRMATION BY THE PARTIES TO THE ACTION"

McWILLIAMS TWP.

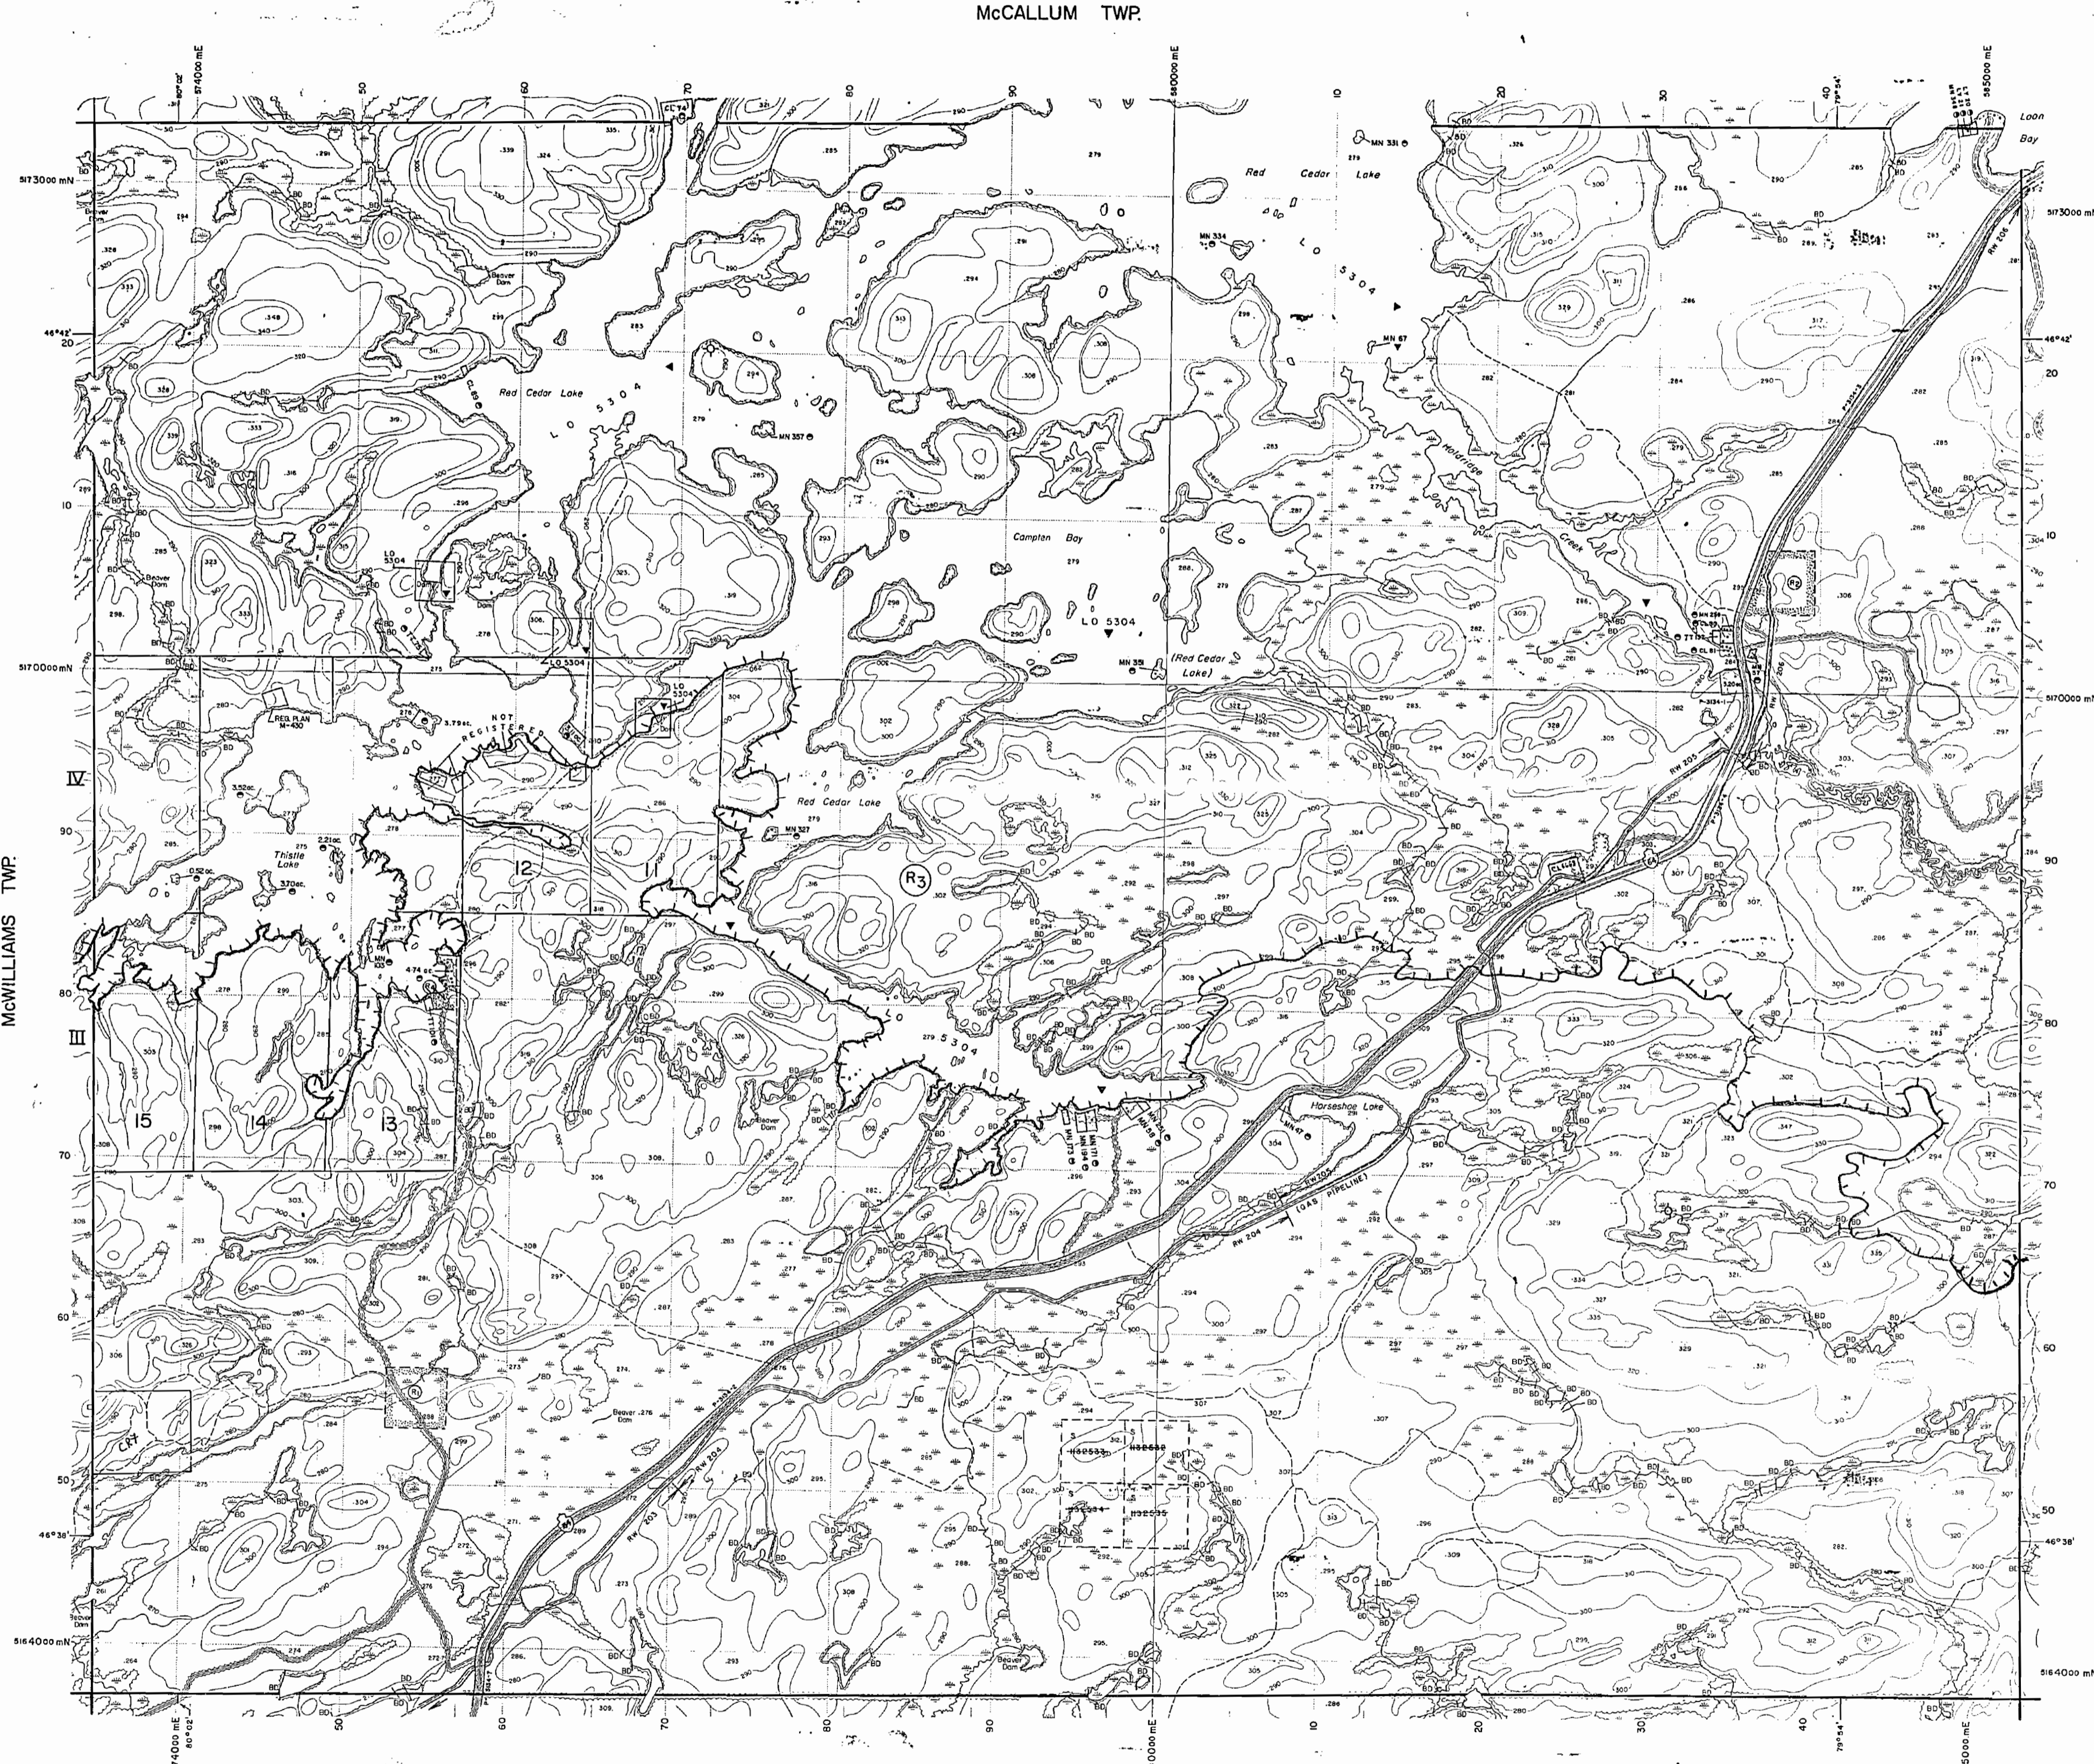

BASTEDO TWP.

McLAREN TWP.


LEGEND

HIGHWAY AND ROUTE No.	
OTHER ROADS	
TRAILS	
SURVEYED LINES:	
TOWNSHIPS, BASE LINES, ETC.	
LOTS, MINING CLAIMS, PARCELS, ETC.	
UNSURVEYED LINES	
LOT LINES	
PARCEL BOUNDARY	
MINING CLAIMS ETC.	
RAILWAY AND RIGHT OF WAY	
UTILITY LINES	
NON-PERENNIAL STREAM	
FLOODING OR FLOODING RIGHTS	
SUBDIVISION OR COMPOSITE PLAN	
RESERVATIONS	
ORIGINAL SHORELINE	
MARSH OR MUSKEG	
MINES	
TRAVERSE MONUMENT	

DISPOSITION OF CROWN LANDS

TYPE OF DOCUMENT	SYMBOL
PATENT, SURFACE & MINING RIGHTS	○
" SURFACE RIGHTS ONLY	○
" MINING RIGHTS ONLY	○
LEASE, SURFACE & MINING RIGHTS	□
" SURFACE RIGHTS ONLY	□
" MINING RIGHTS ONLY	□
LICENCE OF OCCUPATION	○
ORDER-IN-COUNCIL	OC
RESERVATION	OC
CANCELLED	○
SAND & GRAVEL	○
LAND USE PERMIT	○

NOTE: MINING RIGHTS IN PARCELS PATENTED PRIOR TO MAY 1, 1913, VESTED IN ORIGINAL PATENTEE BY THE PUBLIC LANDS ACT, R.S.O. 1970, CHAP. 300, SEC. 62, SUBSEC. 1.

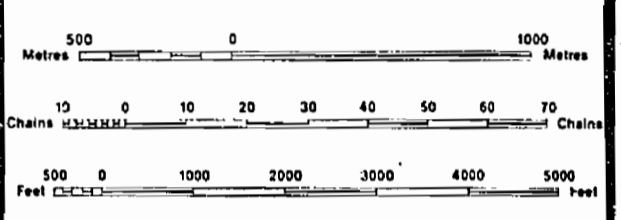

SCALE 1:20 000
GRID ZONE: 17

THE SUBDIVISION OF THIS TOWNSHIP INTO LOTS & CONCESSIONS WAS PARTIALLY ANNULLED ON JULY 23, 1953.

DATE OF ISSUE
FEB 16 1995
SUDBURY
MINING RECORDERS OFFICE

THE INFORMATION THAT APPEARS ON THIS MAP HAS BEEN COMPILED FROM VARIOUS SOURCES, AND ACCURACY IS NOT GUARANTEED. THOSE WISHING TO STAKE MINING CLAIMS SHOULD CONSULT WITH THE MINING RECORDER, MINISTRY OF NORTHERN DEVELOPMENT AND MINES, FOR ADDITIONAL INFORMATION ON THE STATUS OF THE LANDS SHOWN HEREON.

TOWNSHIP
THISTLE
M. N. R. ADMINISTRATIVE DISTRICT
NORTH BAY
MINING DIVISION
SUDBURY
LAND TITLES / REGISTRY DIVISION
NIPISSING

Ministry of Natural Resources
Land Management Branch
Ontario

Original Completion MAY 1985
Number
G-2838

G-5838

11212121

G-5838

G-5838

THISTLE TWP

G-5838



AREAS WITHDRAWN FROM DISPOSITION

M.R.O. - MINING RIGHTS ONLY				
S.R.O. - SURFACE RIGHTS ONLY				
M.+S. - MINING AND SURFACE RIGHTS				
FLOODING


LO 5304 - Flooding Rights in Red Cedar Lake are reserved to Ont. Hydro to contour 104', File 48198.

McWILLIAMS TWP.

McLAREN TWP.

McCALLUM TWP.

BASTEDO TWP.

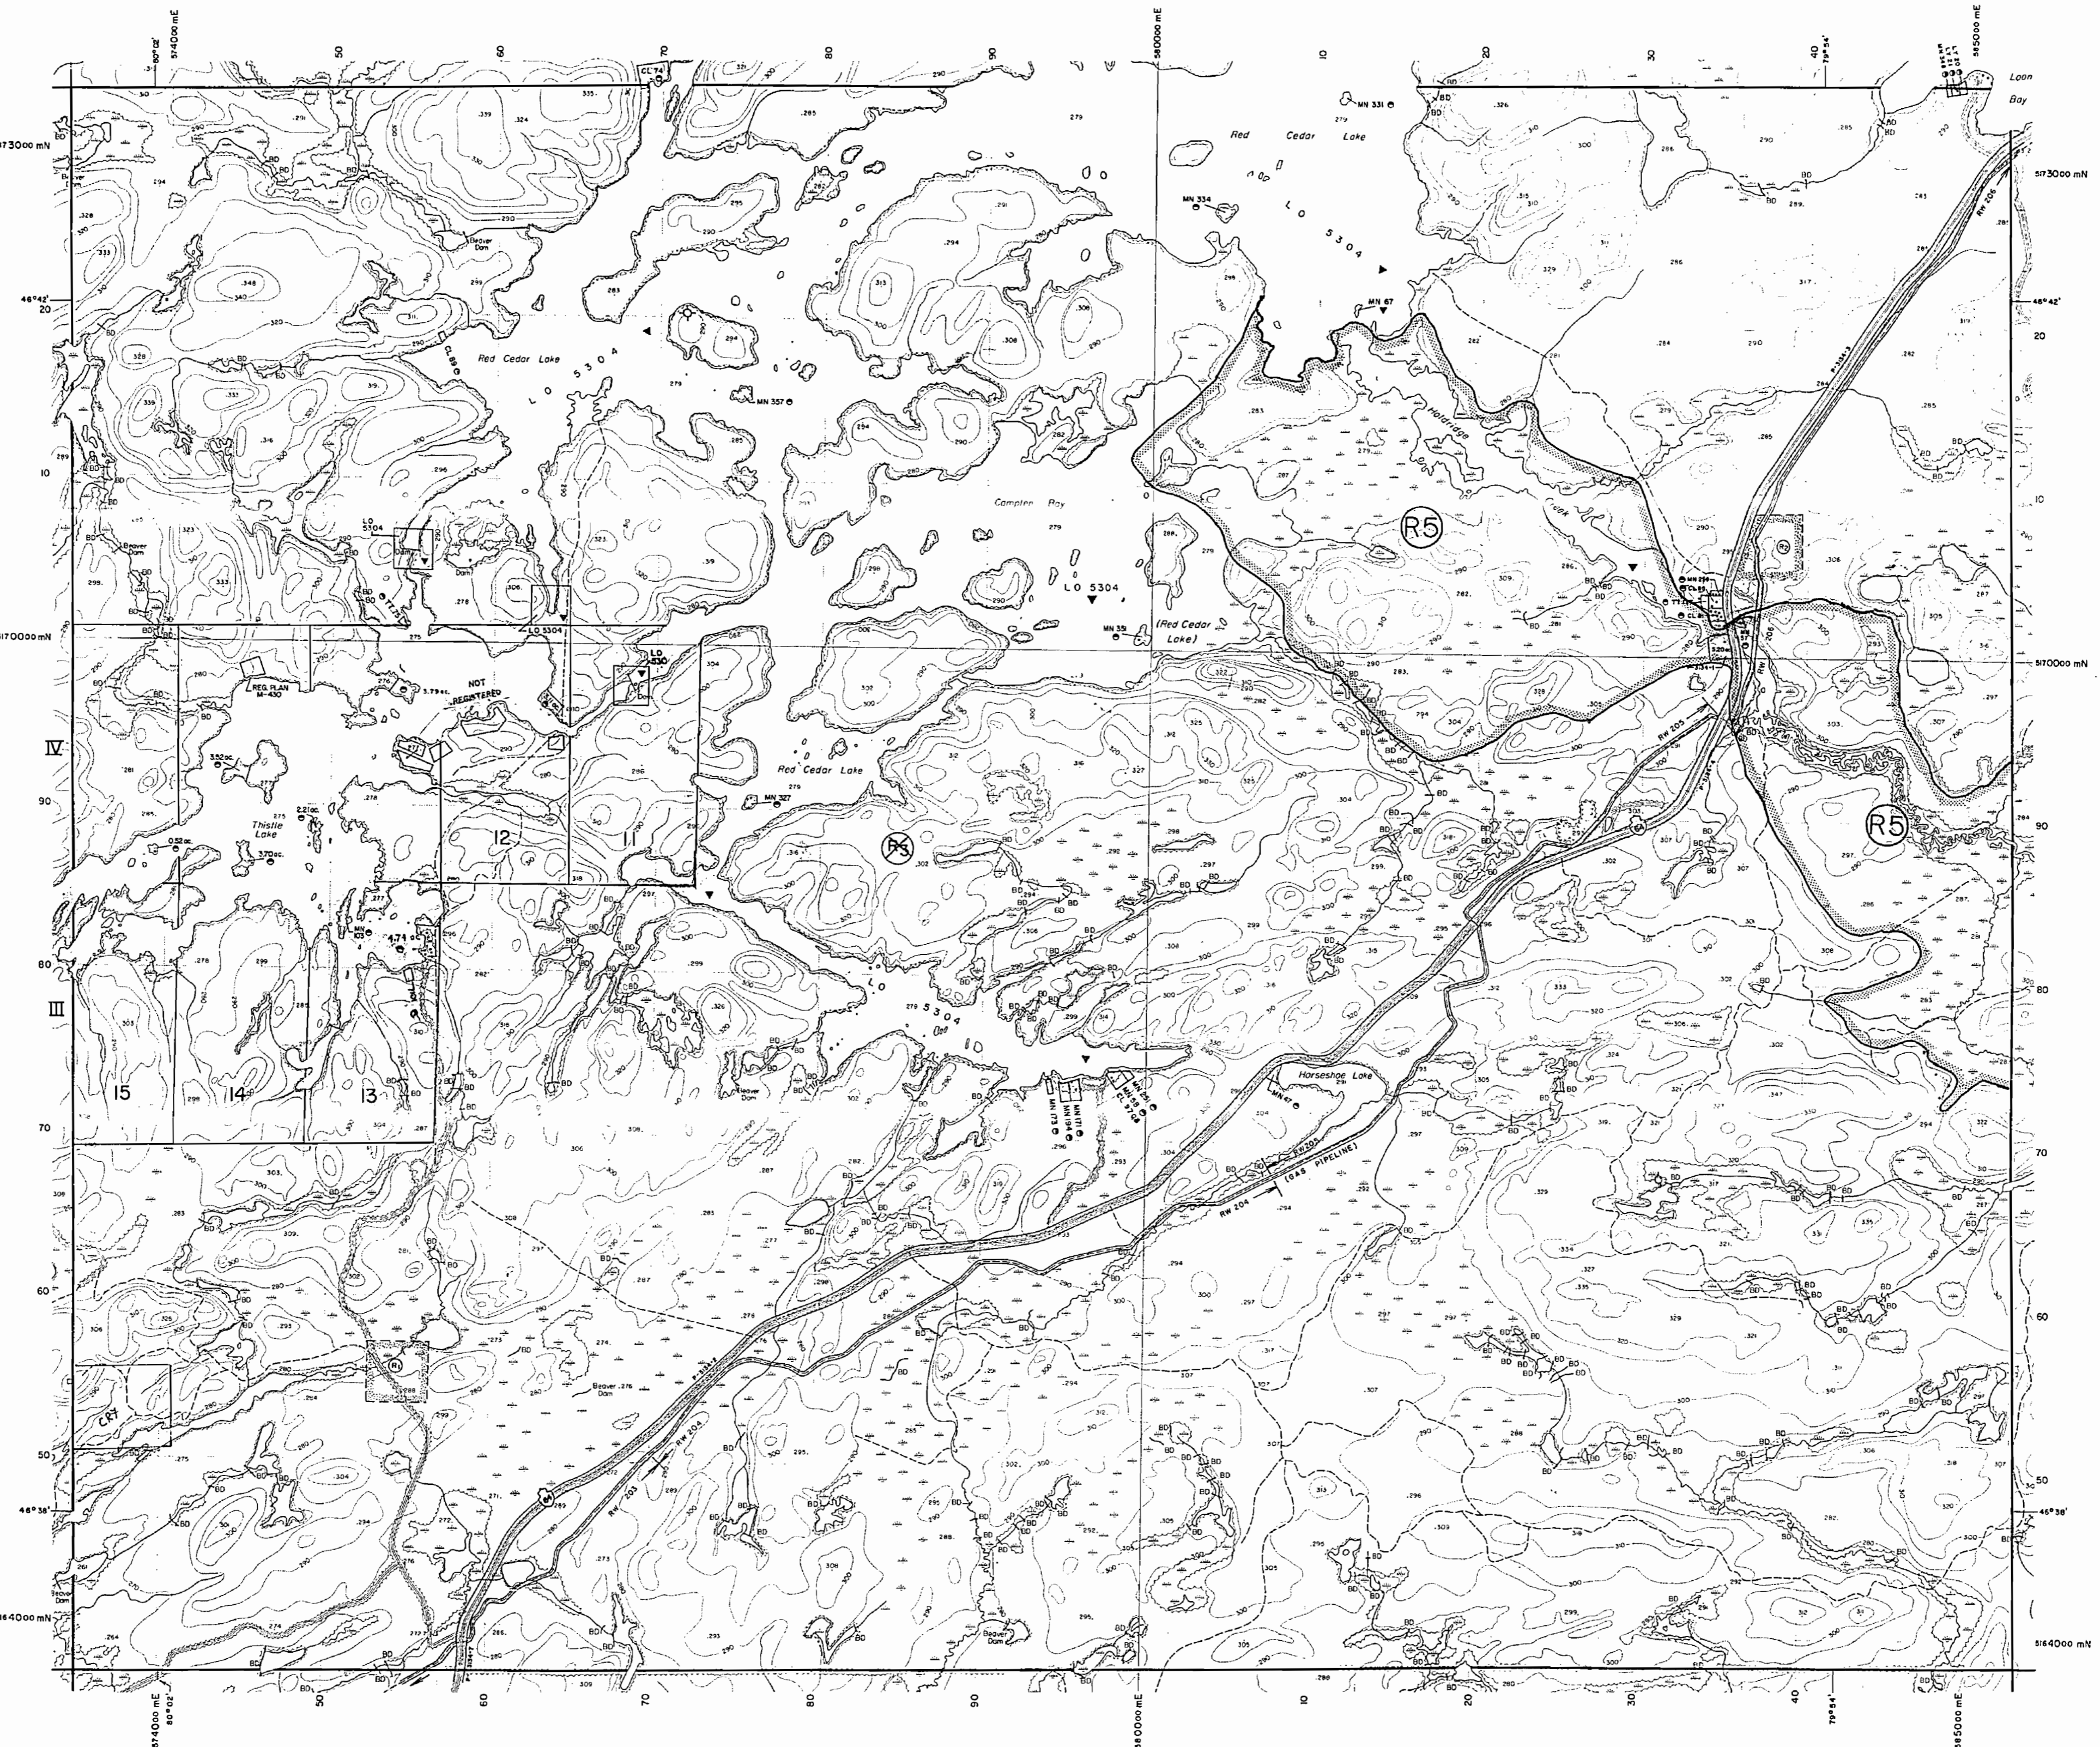


LEGEND

HIGHWAY AND ROUTE No.	
OTHER ROADS	
TRAILS	
SURVEYED LINES	
TOWNSHIPS, BASE LINES, ETC.	
LOTS, MINING CLAIMS, PARCELS, ETC.	
UNSURVEYED LINES	
LOT LINES	
PARCEL BOUNDARY	
MINING CLAIMS ETC.	
RAILWAY AND RIGHT OF WAY	
UTILITY LINES	
NON-PERENNIAL STREAM	
FLOODING OR FLOODING RIGHTS	
SUBDIVISION OR COMPOSITE PLAN	
RESERVATIONS	
ORIGINAL SURVEYLINE	
MARSH OR MUSKIE	
MINES	
TRAVERSE MONUMENT	

DISPOSITION OF CROWN LANDS


TYPE OF DOCUMENT	SYMBOL
PATENT, SURFACE & MINING RIGHTS	●
" SURFACE RIGHTS ONLY	○
" MINING RIGHTS ONLY	◐
LEASE, SURFACE & MINING RIGHTS	◑
" SURFACE RIGHTS ONLY	◒
" MINING RIGHTS ONLY	◓
LICENCE OF OCCUPATION	◔
ORDER-IN-COUNCIL	OC
RESERVATION	○
CANCELLED	○
SAND & GRAVEL	○
LAND USE PERMIT	○

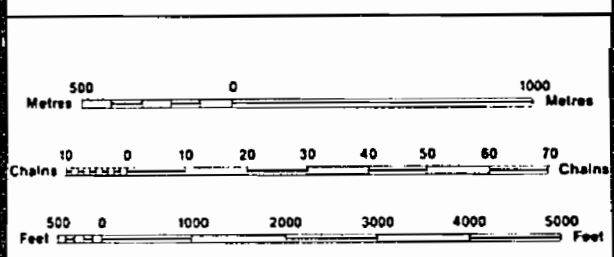

THE SUBDIVISION OF THIS TOWNSHIP INTO LOTS & CONCESSIONS WAS PARTIALLY ANNULLED ON JULY 23, 1953.

THE INFORMATION THAT APPEARS ON THIS MAP HAS BEEN COMPILED FROM VARIOUS SOURCES, AND ACCURACY IS NOT GUARANTEED. THOSE WISHING TO STAKE MINING CLAIMS SHOULD CONSULT WITH THE MINING RECORDER, MINISTRY OF NORTHERN DEVELOPMENT AND MINES, FOR ADDITIONAL INFORMATION ON THE STATUS OF THE LANDS SHOWN HEREON.

TOWNSHIP
THISTLE
 M.N.R. ADMINISTRATIVE DISTRICT
 NORTH BAY
 MINING DIVISION
 SUDBURY
 LAND TITLES / REGISTRY DIVISION
 NIPISSING

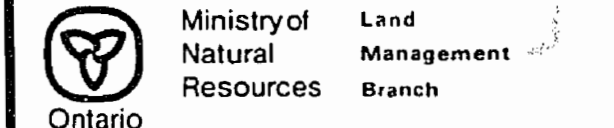

Original Completion MAY 1985
 Revised
 Number
G-2838

G-5838

THISTLE TWP

G-5838

THISTLE

* *Dec 1/85*
M 1156
 ONTARIO
 MINISTRY OF NATURAL RESOURCES
 SURVEYS AND MAPPING BRANCH

SUBBURY MINING DIVISION

* In Service 1983 10 01 - 06

Township closed to staking effective
 May 8 '78, Sec. 387 of Mining Act.

Areas withdrawn from staking under Section
 43 of the Mining Act. (R.S.O. '70)


scale 40 Chains = 1 inch

Order No. File Date Disposition

W 3/80	23547	Oct. 14, '80	S. R. O.
W 7/81		9/12/81	S. R. O.

Overflow colored red
 Sec 40 No 1575

McCALLUM

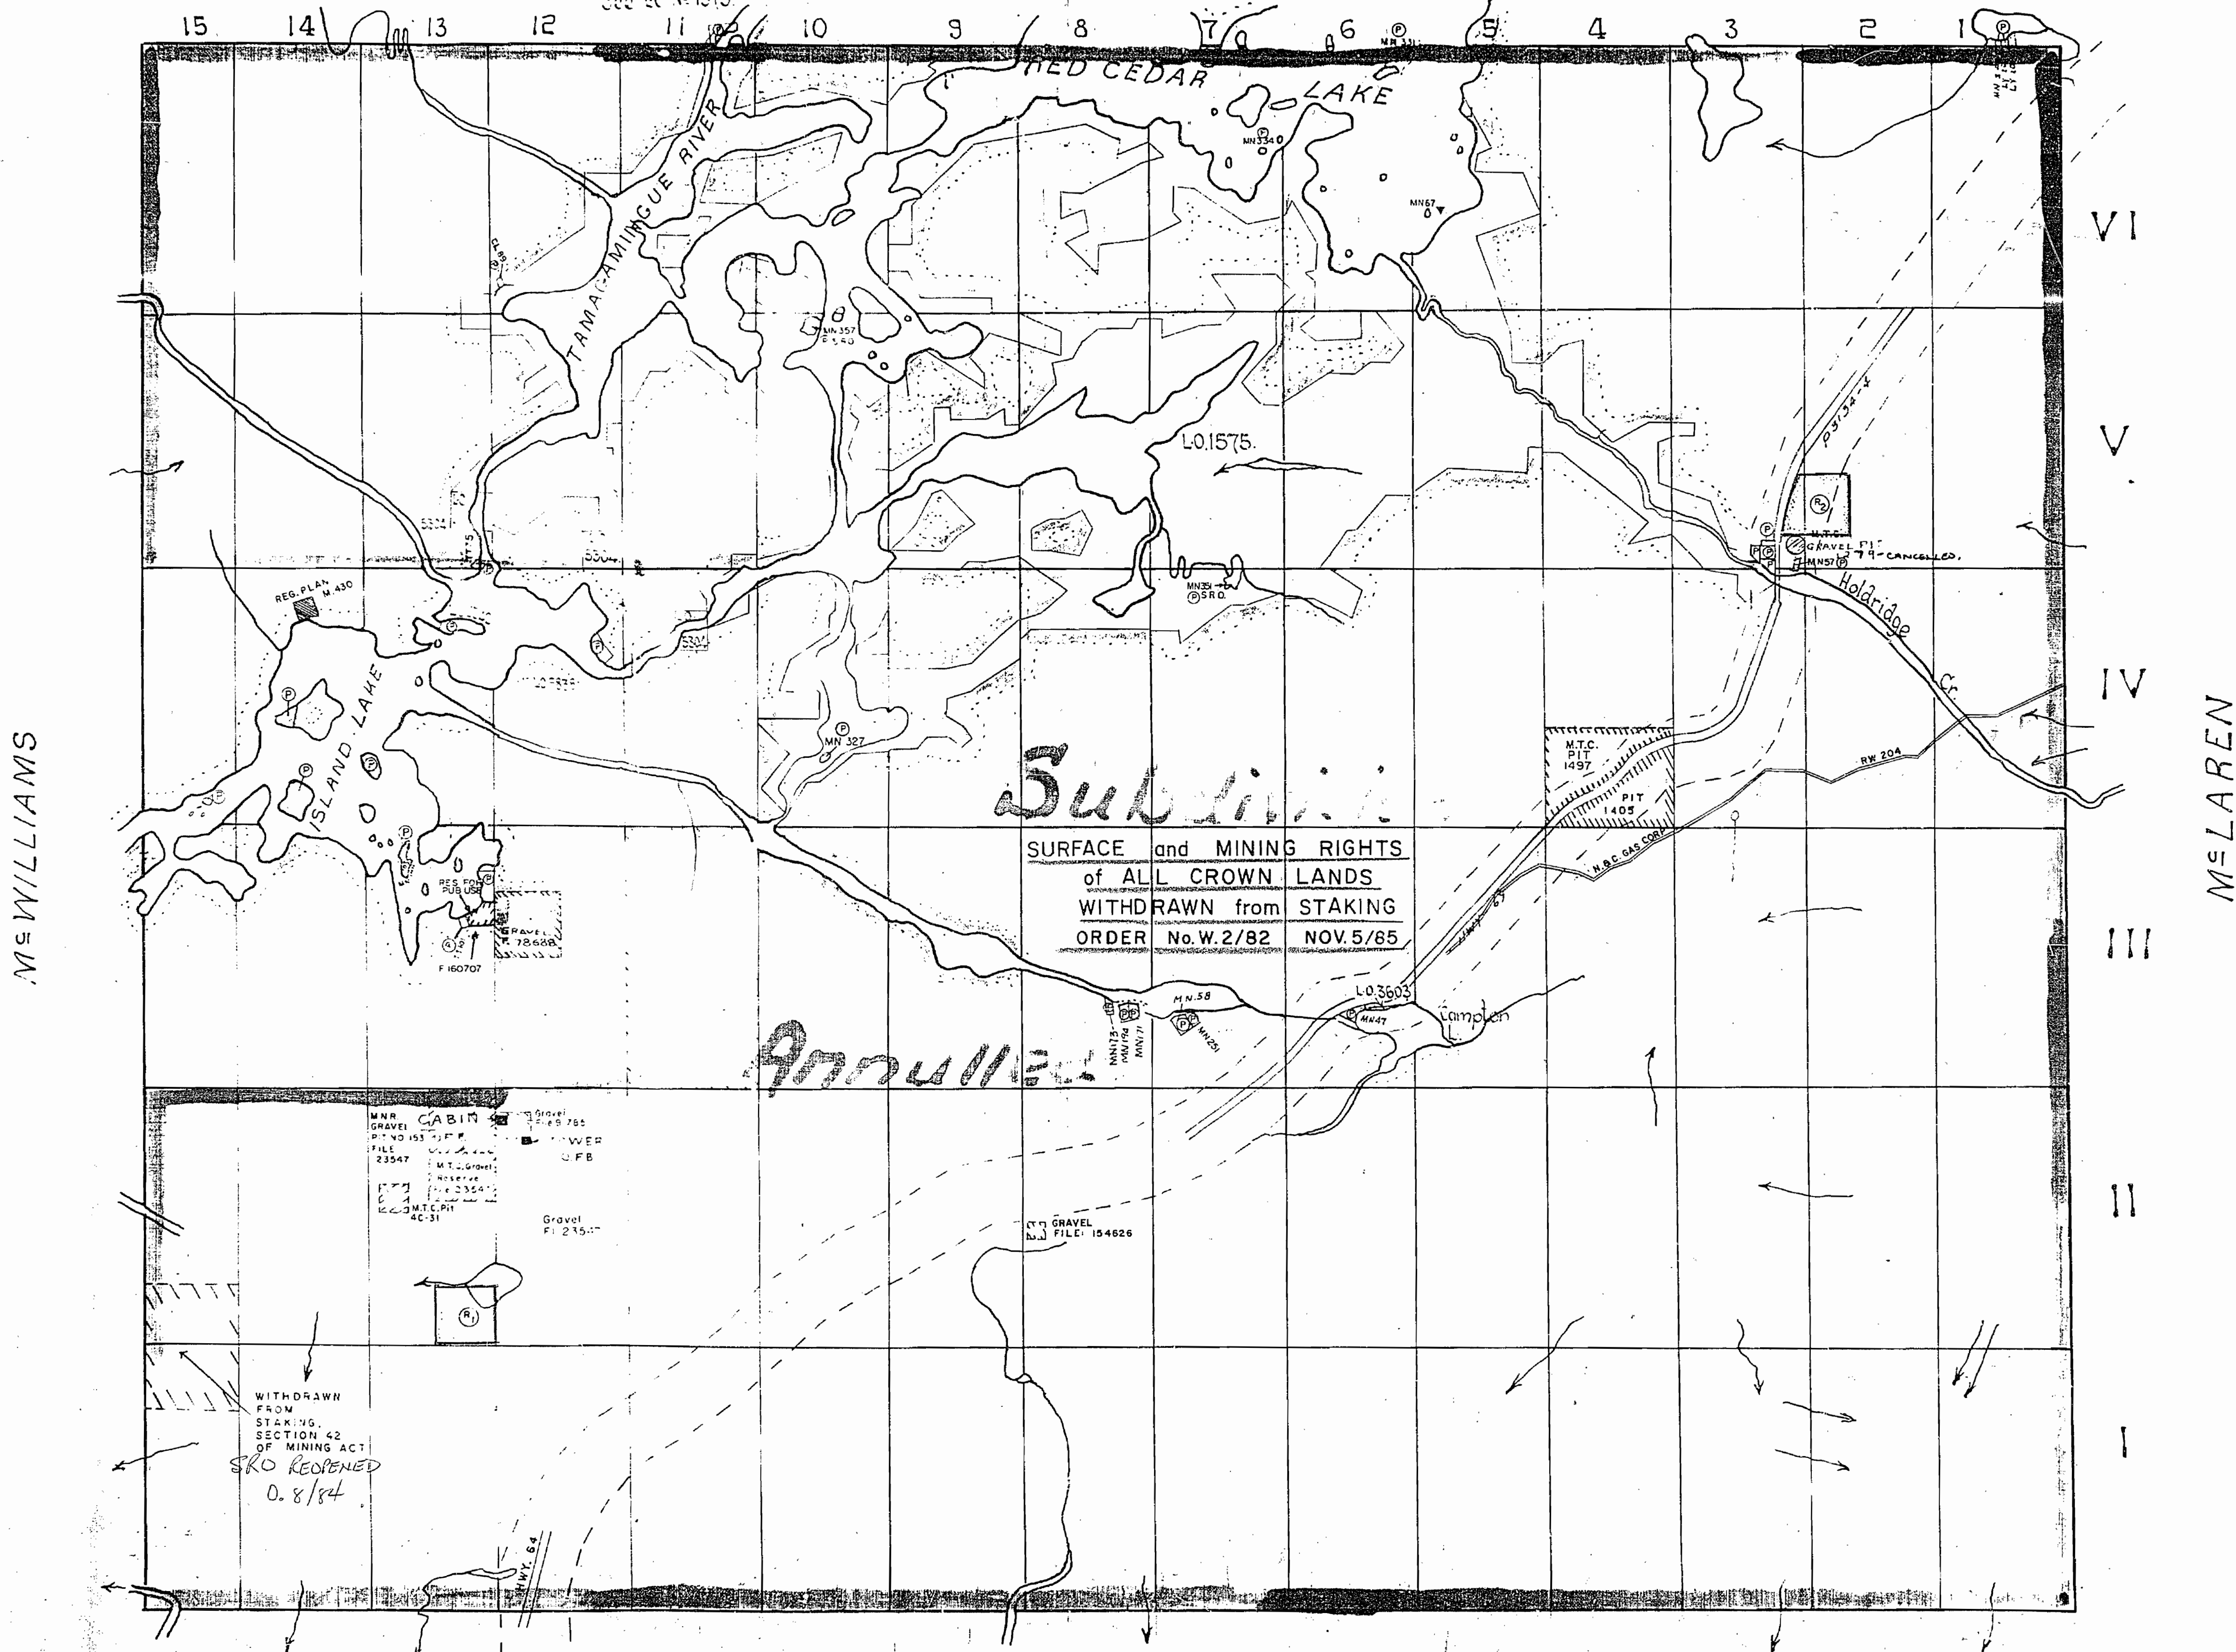

M. S. WILLIAMS

M. S. LAREN

Subdivided

Annulled

SURFACE and MINING RIGHTS
 of ALL CROWN LANDS
 WITHDRAWN from STAKING
 ORDER No. W. 2/82 NOV. 5/85

WITHDRAWN FROM STAKING SECTION 42 OF MINING ACT SKO REOPENED 0. 8/84

Surface reservations 400 wide by Dept. of L & F shown hereon thus

BASTEDO

THISTLE

1156

THISTLE

TIMISKAMING MINING DIVISION

Scale 40 Chains = 1 inch


M 1156



Mc WILLIAMS

McCALLUM

McLAREN

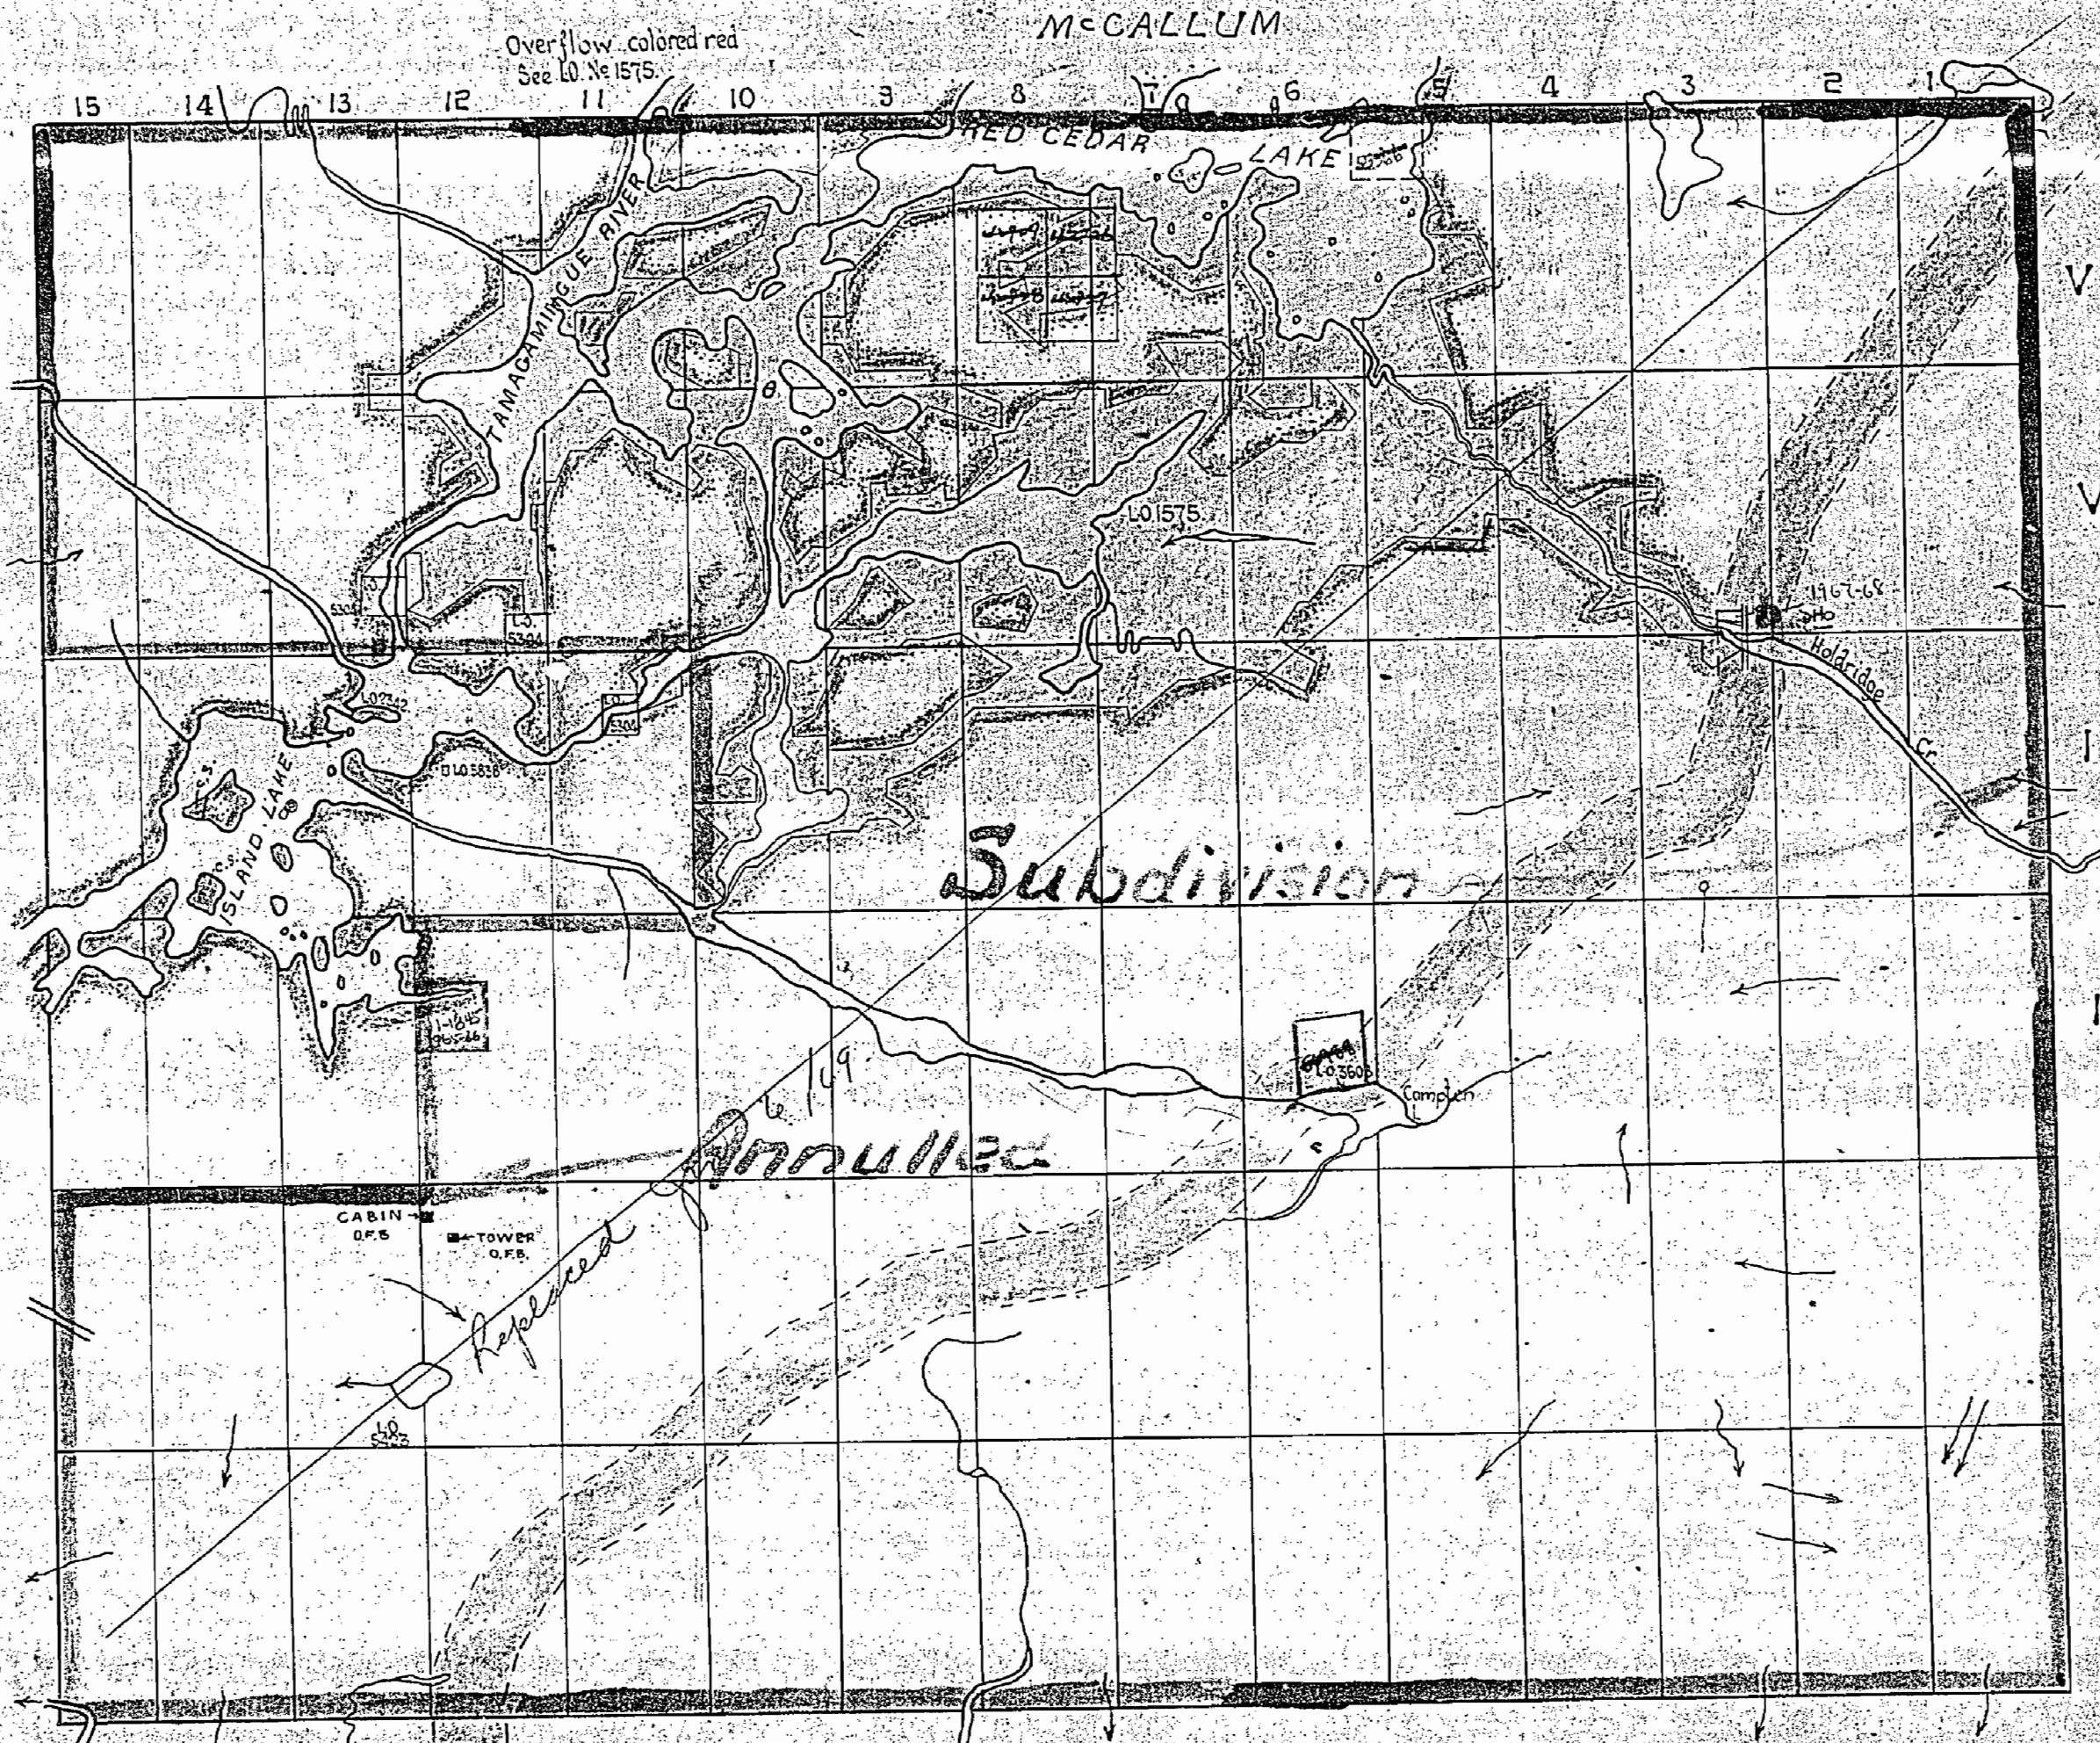

Subdivision

Annulled

Surface reservations 400' wide by Dept. of L.C.F. shown hereon thus ~~as indicated~~

BASTEDO

Note attached plan showing D.H.O. gravel pits

G-5838

THISTLE TWP.

G-5838

MAP SYMBOLOLOGY

Aerial Cableway	Pipeline (above ground)
Boundary	Railroad
Contour Interval	Single Track
District, Economic Section Reserve	Double Track
Assessment	Abandoned
Lot, Concession	Road
Approximate	Highway, County
Park Boundary	Subway
Rock, Retrace	Access (case of doubtful application of highway authority)
Building	Trail, Back Road (portage, alley)
Chimney	Rapids
Cliff, Pit, Pile	Shoals (case of doubtful application of highway authority)
Contours	Quartz Line (case of doubtful application of highway authority)
Intersecting	Reservoir
Assessment	Glyzer, Stream, Canal
Discharge	Approximate
Control Points	Assessment
Horizontal	Direction of flow
Vertical	Rock
Calvert	Significant
Falls	Shoal
Double line river	Spot Elevation (true elevation) 100.0
Fence, Hedge, Wall	Tower
Feature Outline (Construction Features, etc.)	Transmission Line
Flooded Land (1:5000)	Pole
Lock	Pillar
Marsh or Swamp	Tunnel
Mast	Utility Poles
Mine Head Frame	Wharf, Dock, Pier
Outcrop	Wooded Area

AREAS WITHDRAWN FROM DISPOSITION

M.R.O. - MINING RIGHTS ONLY			
S.R.O. - SURFACE RIGHTS ONLY			
M.S. - MINING AND SURFACE RIGHTS			
Description	Order No.	Date	Disposition File
① SEC. 36/80	W.3780	12/10/80	S.R.O. 23547
② SEC. 36/80	W.7761	9/12/81	S.R.O. 160707
③ SEC. 36/80	W.2782	5/11/82	M.S. 160707 & 165411
④ PUBLIC USE		11/12/89	

*Set of order W 2782 REOPENED by order O.M. OHSO NER effective April 22/90 at 7:00 AM EST.

FLOODING
 LO 5304 - Flooding Rights on Red Cedar Lake are reserved to Ont. Hydro to contour 104', File 46198.


NOTE:
 "THIS MAP SHOWS THE APPROXIMATE LOCATION OF THE BOUNDARIES OF THE AREA WHICH IS THE SUBJECT OF CURRENT LITIGATION. THE EXACT LOCATION WILL BE SHOWN FOLLOWING CONFIRMATION BY THE PARTIES TO THE ACTION"

McWILLIAMS TWP.

McLAREN TWP.

McCALLUM TWP.

BASTEDO TWP.

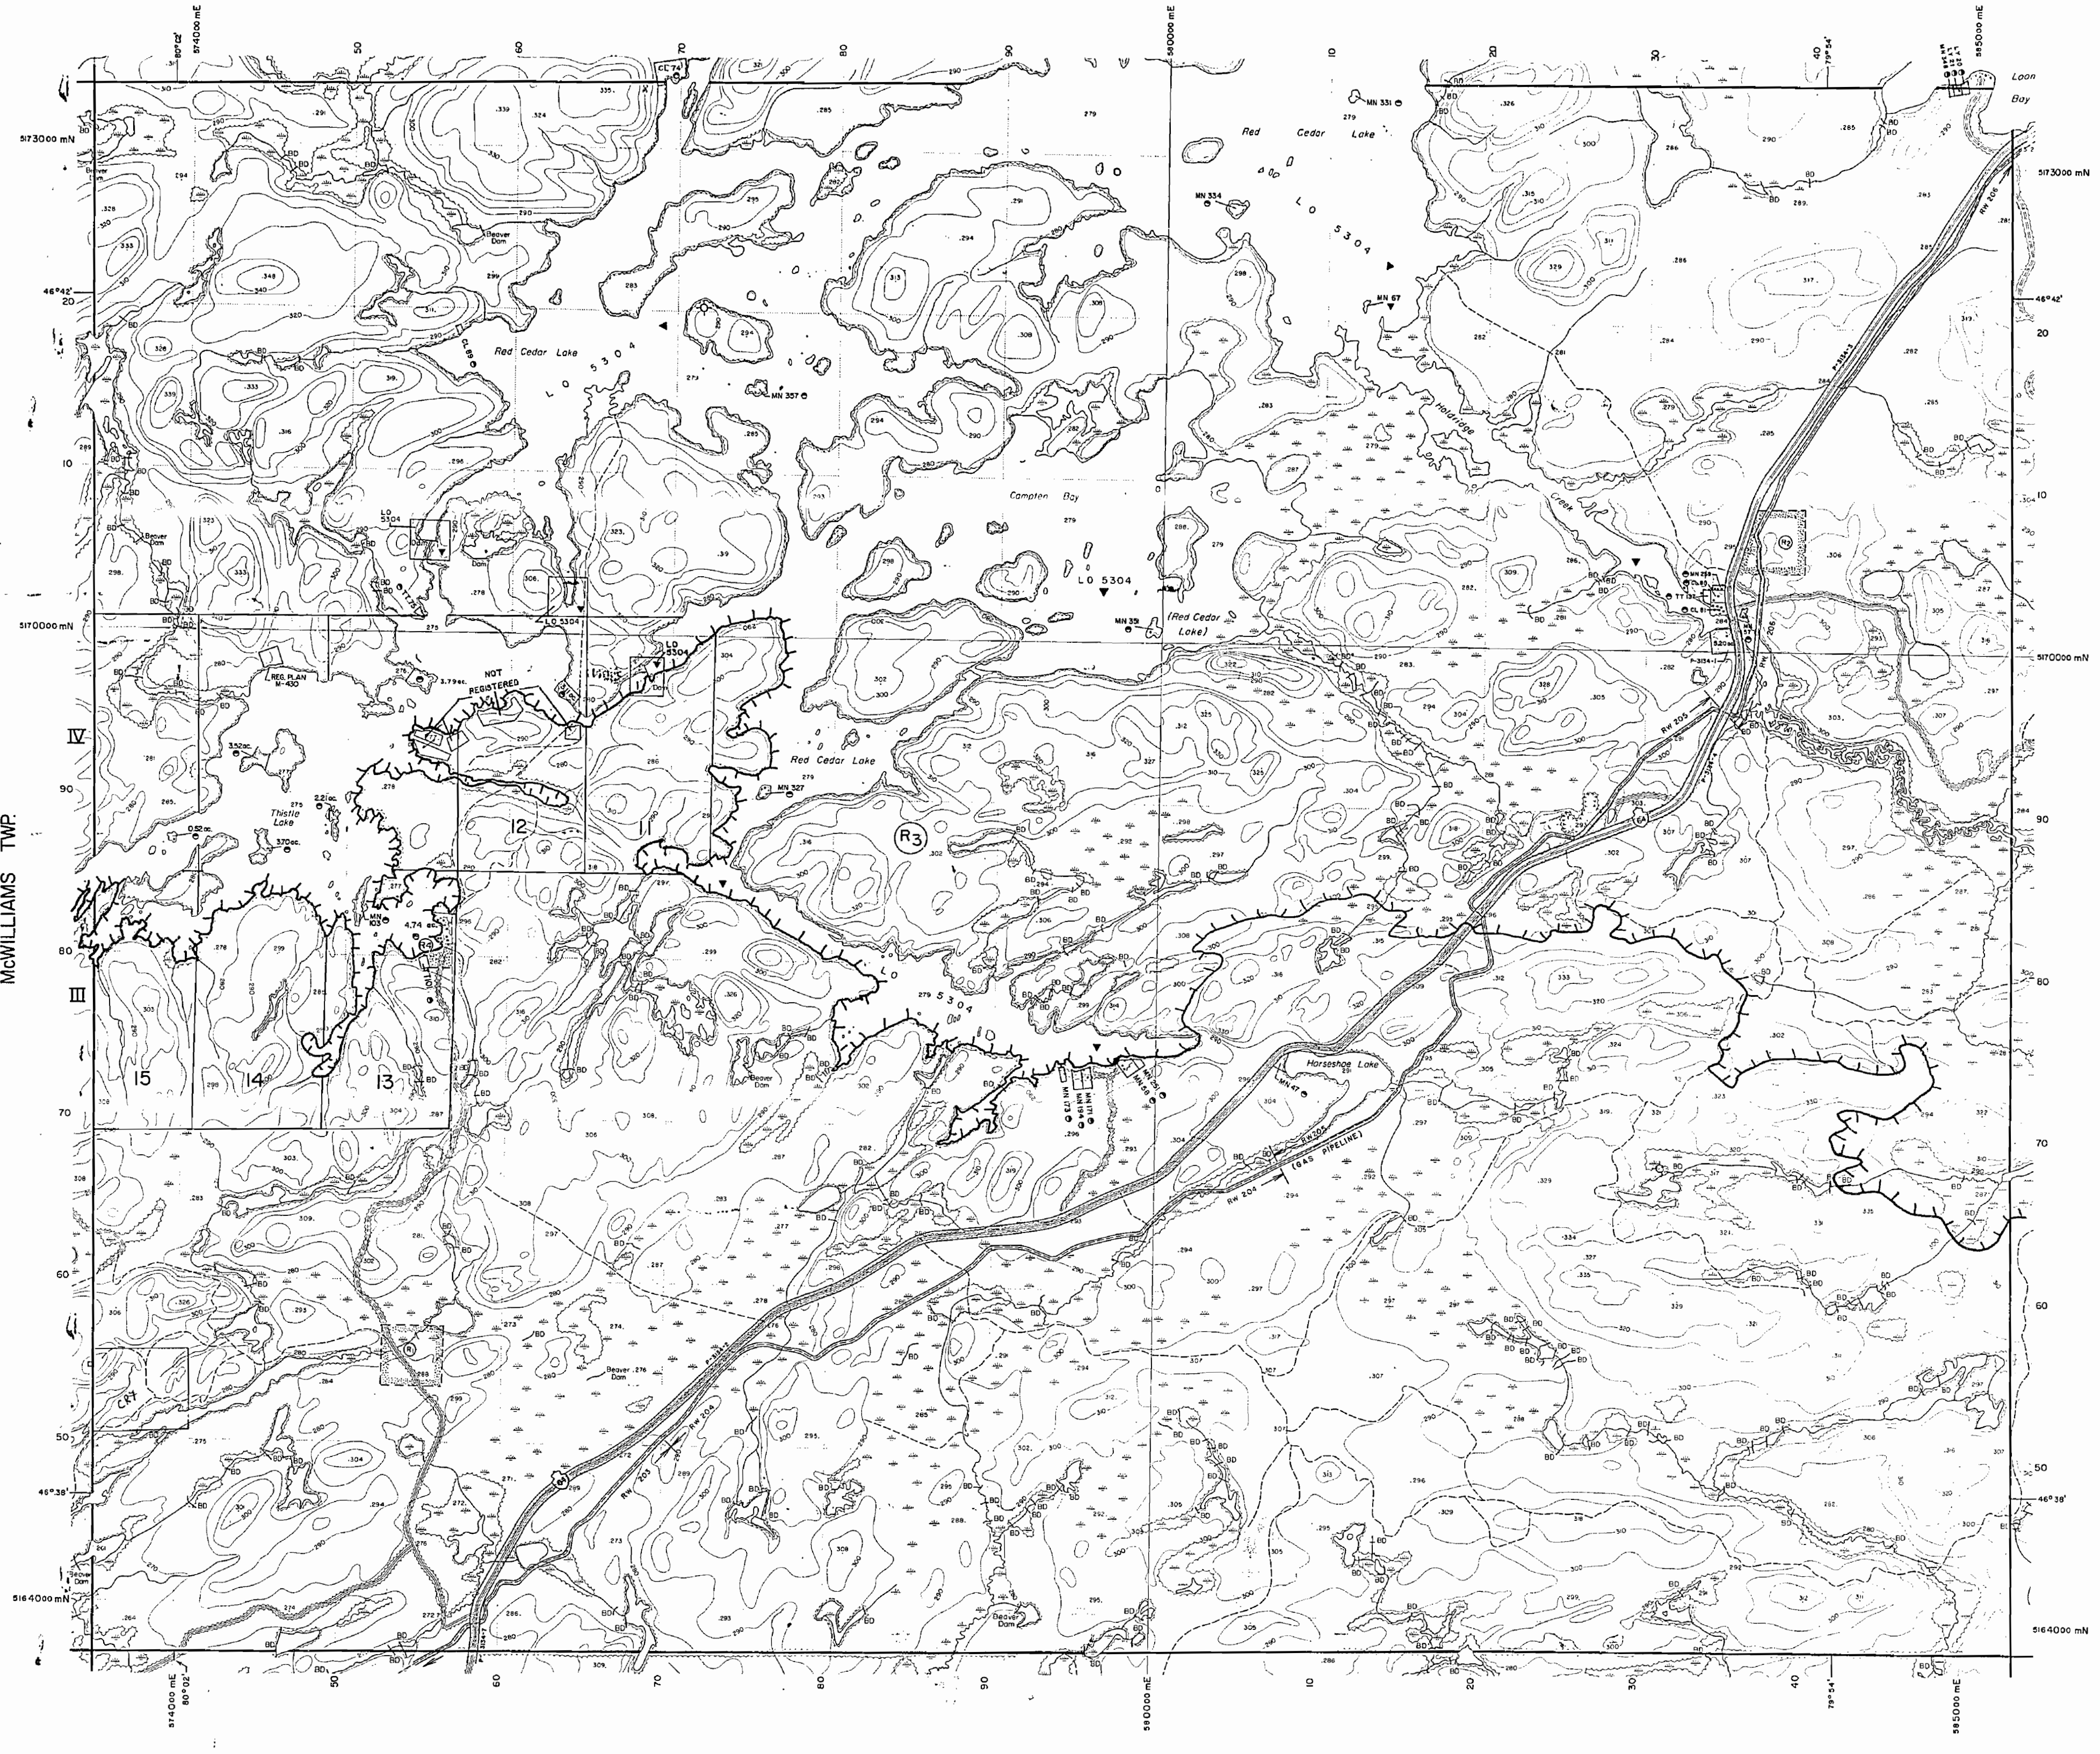


LEGEND

HIGHWAY AND ROUTE No.	
OTHER ROADS	
TRAILS	
SURVEYED LINES	
TOWNSHIPS, BASE LINES, ETC.	
LOTS, MINING CLAIMS, PARCELS, ETC.	
UNSURVEYED LINES	
LOT LINES	
PARCEL BOUNDARY	
MINING CLAIMS ETC.	
RAILWAY AND RIGHT OF WAY	
UTILITY LINES	
NON-PERENNIAL STREAM	
FLOODING OR FLOODING RIGHTS	
SUBDIVISION OR COMPOSITE PLAN	
RESERVATIONS	
ORIGINAL SHORELINE	
MARSH OR MUSKEG	
MINES	
TRAVERSE MONUMENT	

DISPOSITION OF CROWN LANDS

TYPE OF DOCUMENT	SYMBOL
PATENT, SURFACE & MINING RIGHTS	
SURFACE RIGHTS ONLY	
MINING RIGHTS ONLY	
LEASE, SURFACE & MINING RIGHTS	
SURFACE RIGHTS ONLY	
MINING RIGHTS ONLY	
LICENCE OF OCCUPATION	
ORDER-IN-COUNCIL	
RESERVATION	
CANCELLED	
SAND & GRAVEL	
LAND USE PERMIT	

NOTE: MINING RIGHTS IN PARCELS PATENTED PRIOR TO MAY 9, 1913, VESTED IN ORIGINAL PATENTEES BY THE PUBLIC LANDS ACT, R.S.O. 1910, CHAP. 280, SEC. 63, SUBSEC. 1.

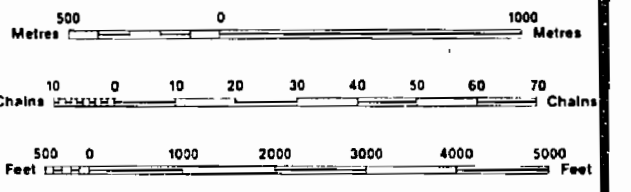

SCALE 1:20 000
GRID ZONE: 17

THE SUBDIVISION OF THIS TOWNSHIP INTO LOTS & CONCESSIONS WAS PARTIALLY ANNULLED ON JULY 23, 1953.


DATE OF ISSUE
 JUL 15 1988

DATE OF ISSUE
JUL 15 1988

THE INFORMATION THAT APPEARS ON THIS MAP HAS BEEN COMPILED FROM VARIOUS SOURCES AND ACCURACY IS NOT GUARANTEED. THOSE WISHING TO STAKE MINING CLAIMS SHOULD CONSULT WITH THE MINING RECORDER, MINISTRY OF NORTHERN DEVELOPMENT AND MINES, FOR ADDITIONAL INFORMATION ON THE STATUS OF THE LANDS SHOWN HEREON.

MINING RECORDS OFFICE
 JUL 15 1988

TOWNSHIP
THISTLE
 M.N.R. ADMINISTRATIVE DISTRICT
 NORTH BAY
 MINING DIVISION
 SUDBURY
 LAND TITLES / REGISTRY DIVISION
 NIPISSING

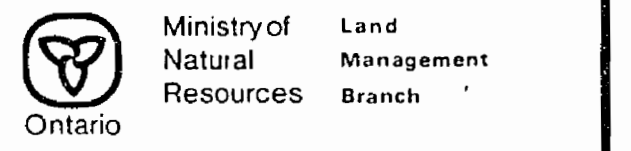

Original Completion MAY 1985
 Revised
 Number
G-2838

G-5838

THISTLE TWP.

G-5838

THISTLE

M. 1156

ONTARIO

MINISTRY OF NATURAL RESOURCES
SURVEYS AND MAPPING BRANCH

Township Closed to Staking
Effective Nov. 5, 1982,
Section 36(1)(a) The Mining
Act.


SUBBURY MINING DIVISION

DATE OF ISSUE
AUG 16 1976

OFFICE USE ONLY

Scale 40 Chains = 1 inch

TOWNSHIP CLOSED TO STAKING
EFFECTIVE MAY 8, 1978
SECTION 38(f) THE MINING ACT

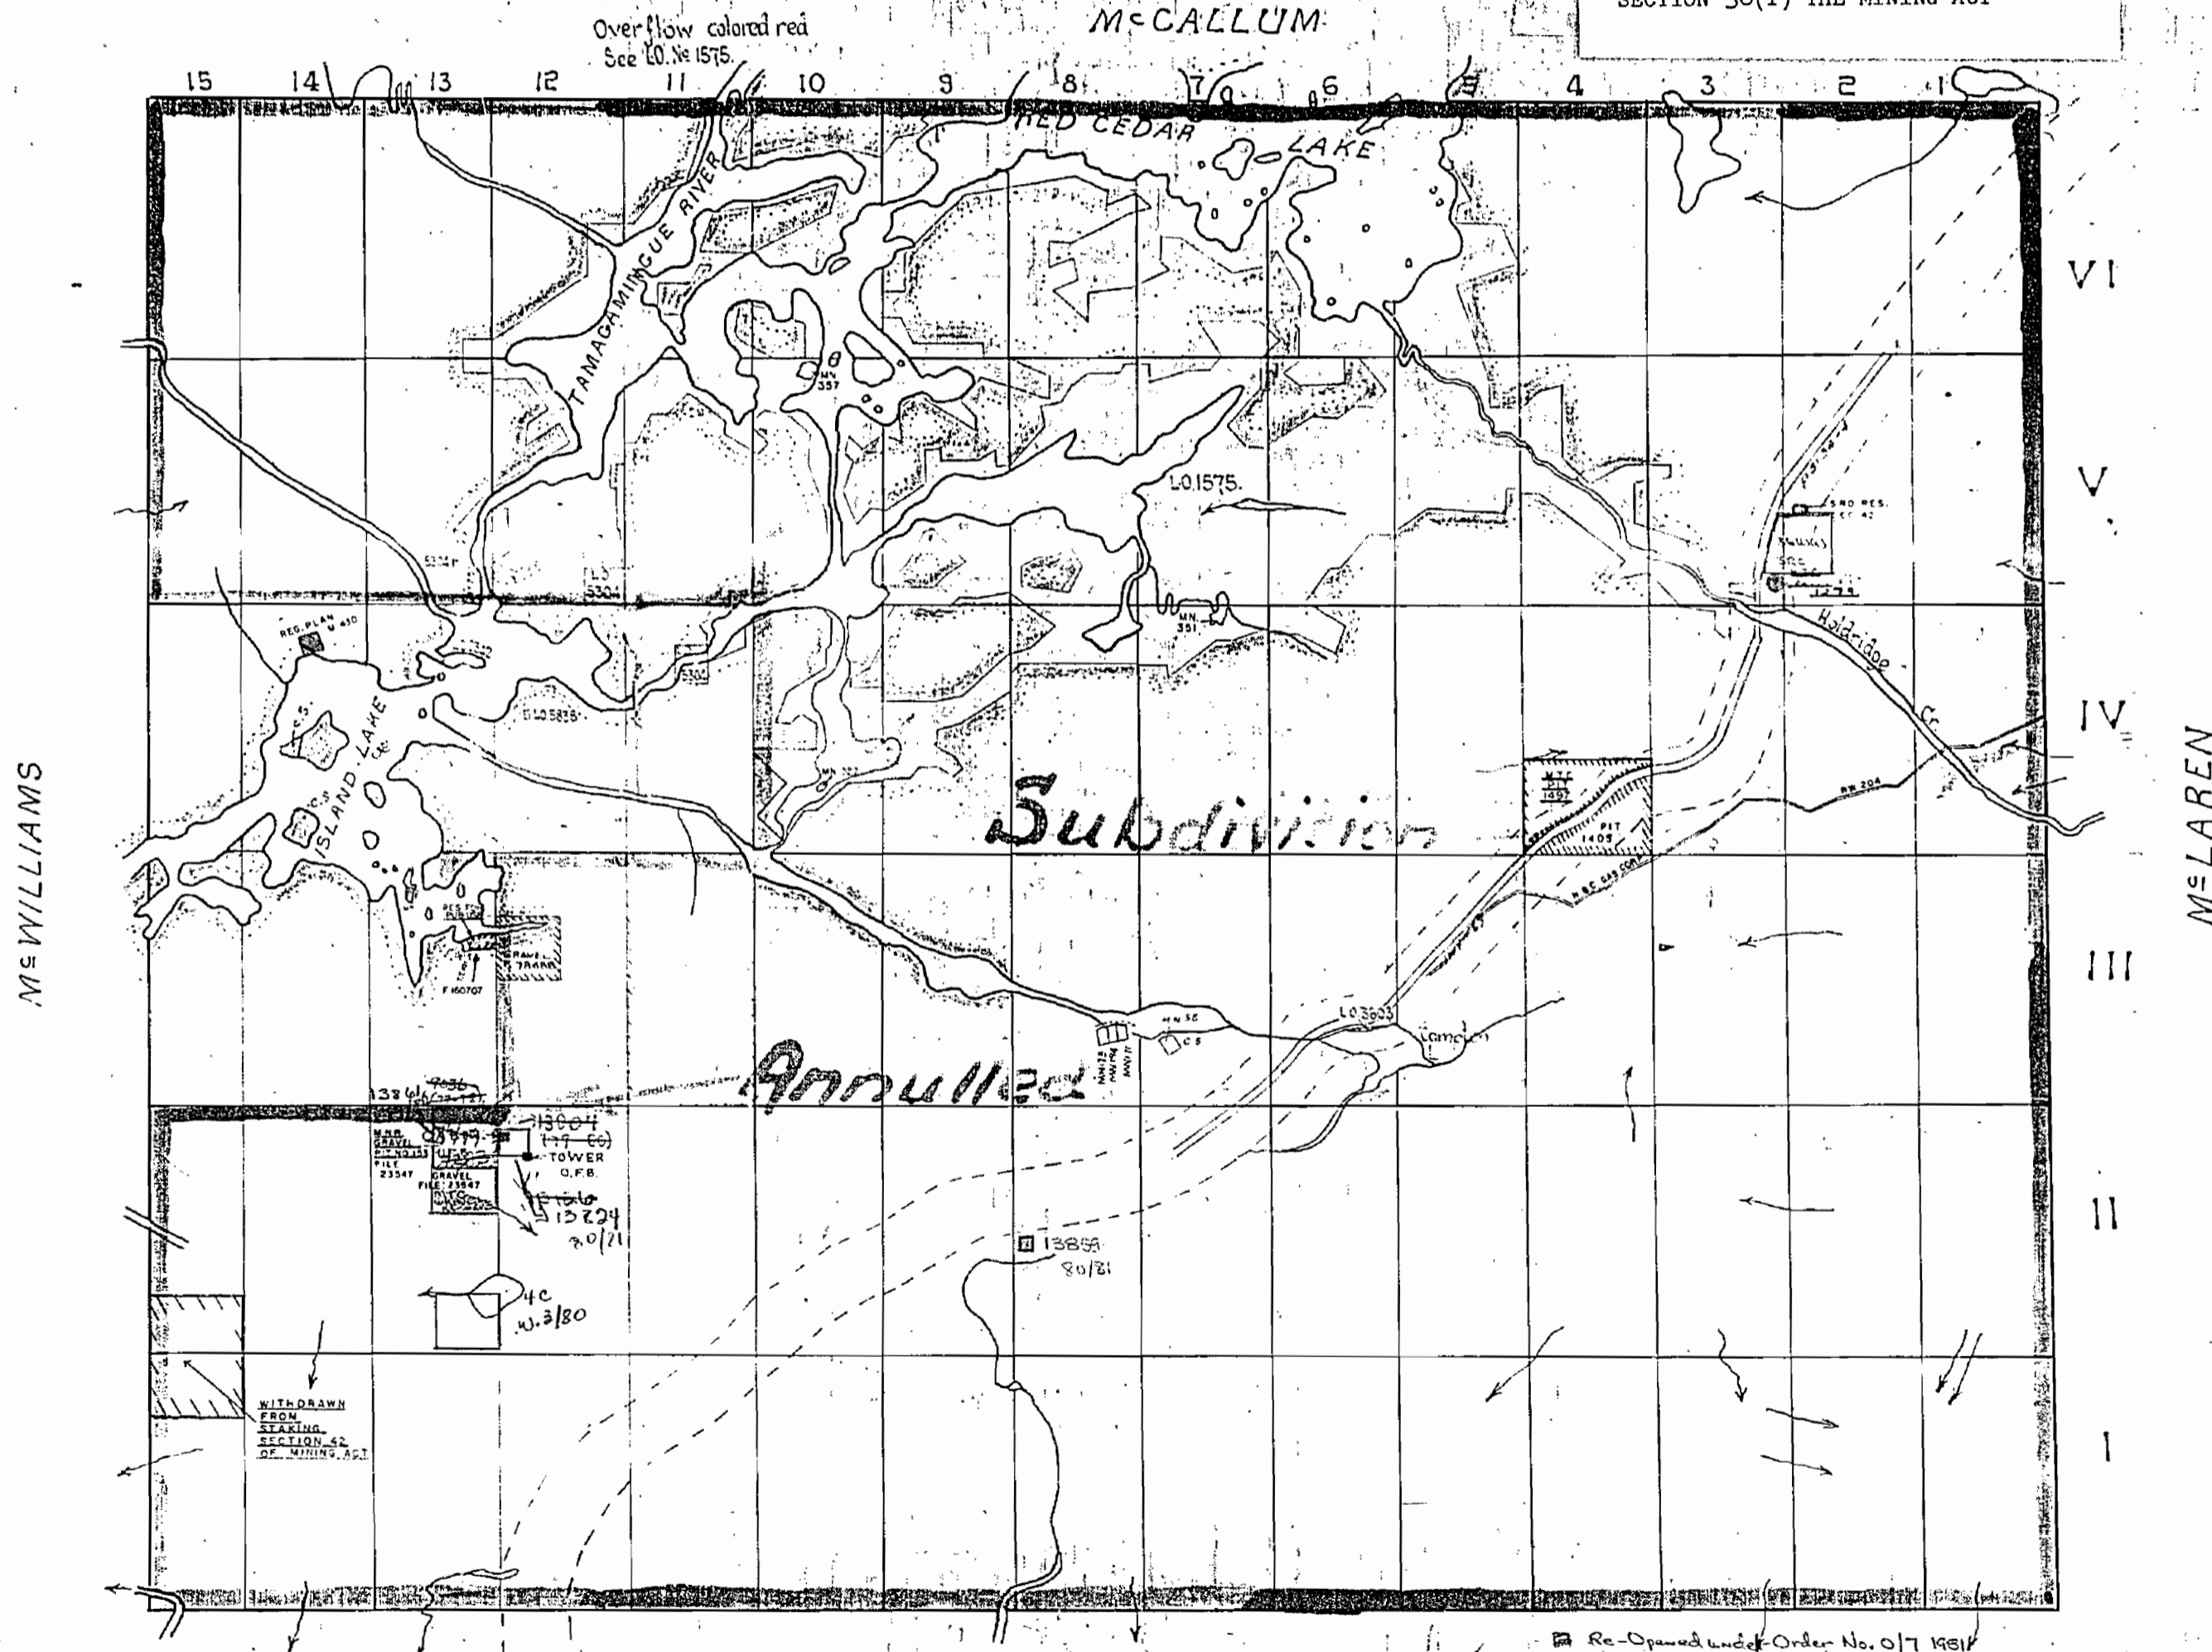

McWILLIAMS

McLAREN

Subdivision

Annulled

BASTEDO

THISTLE

Surface reservations 400' wide by Dept. of L & F
shown hereon thus

Re-Opened under Order No. O/7/1981
North Bay District Nov. 24 1981
Withdrawal Order No. W/7/81
North Bay December 9th 1981