OFFICE USE ONLY

# MANDAMIN Tp M. 1206

GEROW Tp M. 1209

SHIBANANING Tp M. 1202

TENNYSON TWP M. 1155

11 M 10 M 9 M 8 M 7 M 82°4' 46°27'10"

5M 4M 3M 2M 1M

OFB W.2/83

S S S 33 7146 3 622 34 9564

0.02/82 W.02/82

OFB

553

Riviere

East Bull Lake

CL. 3511

Goulding L.

Cutler Cr.

Tiplody L.

Novick L.

S.R. & M.R. WITHDRAWN

W.3-81

Parisien L

Sobies

SURFACE & MINING RIGHTS WITHDRAWN FROM STAKING
SEC. 36 of Mining Act RSO 1980 - Nov. 1/84
Order #0.1/84

M.T.C. GRAVEL PIT NO. 48-1

## NOTES

400' surface rights reservation along the shores of all lakes and rivers.

Order No.s 0.02/82 & W.2/82 (See Boon Twp. Land Rpt.)

Order No. W.2/83 - Expired (See Boon Twp. Land Rpt.)

DATE OF ISSUE
AUG 31 1971

## LEGEND

| | |
|---|---|
| PATENTED LAND | Ⓟ or ● |
| PATENTED FOR SURFACE RIGHTS ONLY | ◒* |
| LEASE | Ⓛ |
| LICENSE OF OCCUPATION | L.O. |
| CROWN LAND SALES | C.S. |
| LOCATED LAND | Loc. |
| CANCELLED | C. |
| MINING RIGHTS ONLY | M.R.O. |
| SURFACE RIGHTS ONLY | S.R.O. |
| HIGHWAY & ROUTE NO. | 17 |
| ROADS | |
| TRAILS | |
| RAILWAYS | |
| POWER LINES | |
| MARSH OR MUSKEG | |
| MINES | |

*used only with summer resort locations or when space is limited

TOWNSHIP OF

# BOON
(Tp. 123)

DISTRICT OF
ALGOMA

SUDBURY
MINING DIVISION


SCALE : 1 INCH = 40 CHAINS (1/2 MILE)

DR. JBK
DATE 1 May '72

PLAN NO. M. 1205

ONTARIO
MINISTRY OF NATURAL RESOURCES
SURVEYS AND MAPPING BRANCH

G-3180

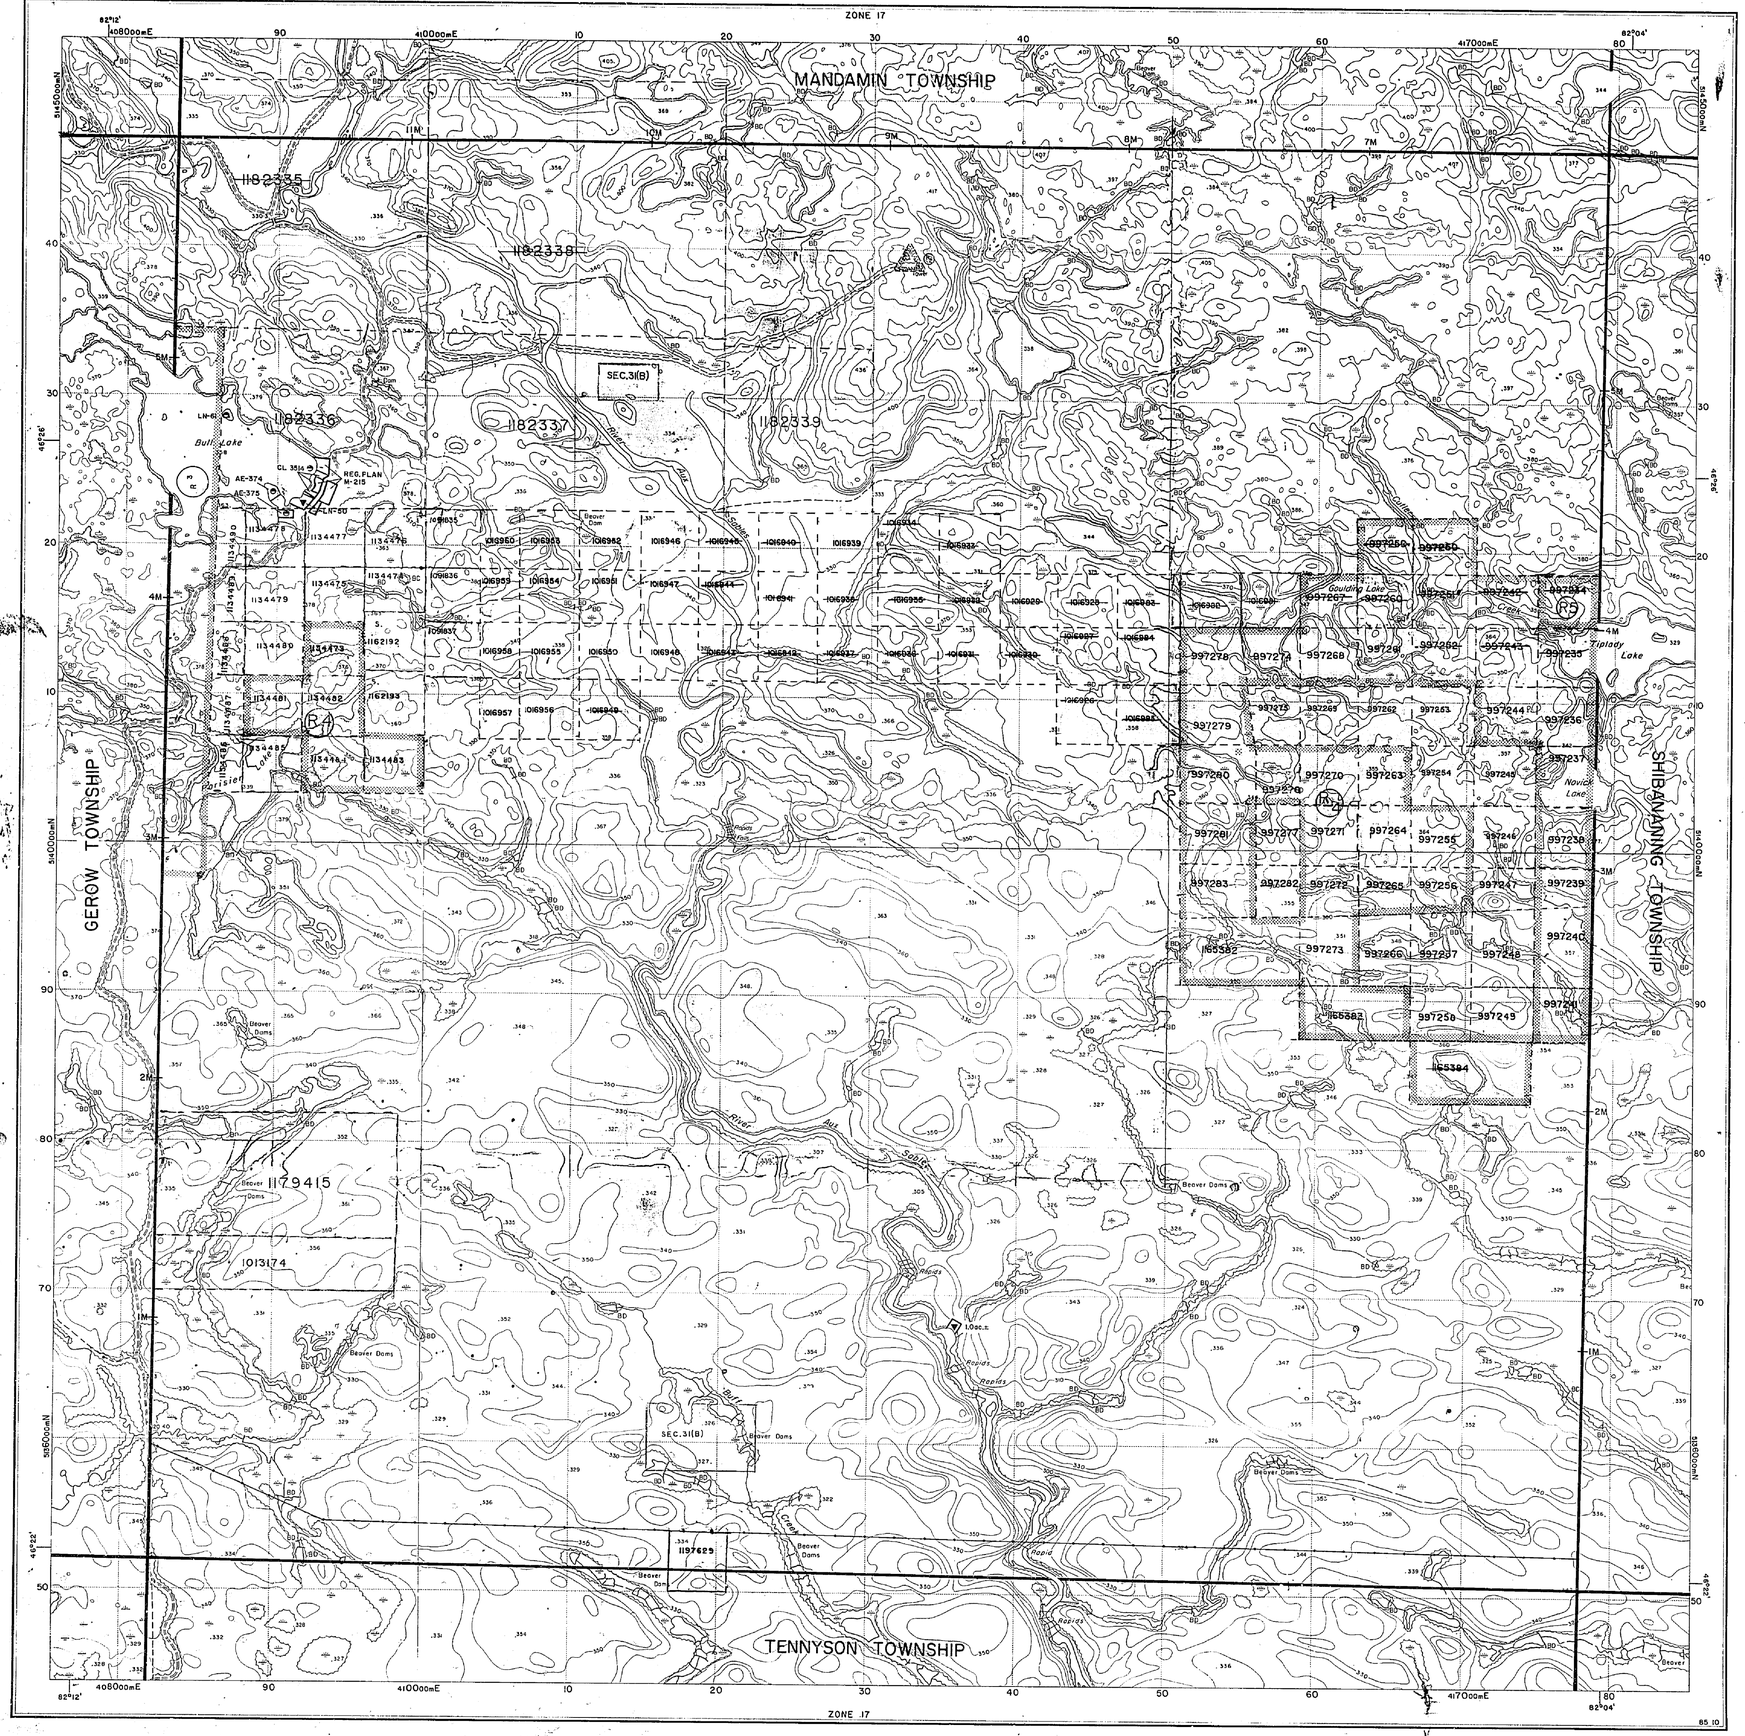
ZONE 17
MANDAMIN TOWNSHIP
GEROW TOWNSHIP
SHIBANING TOWNSHIP
TENNYSON TOWNSHIP
SEC.31(B)
SEC.31(B)
Bull Lake
Beaver Dams
Rapids
Novice Lake
Tiplady Lake
Goudreau Lake
Creek
River
REG.PLAN M-215
CL 3514
AE-374
AE-375
LM-50
LM-51
II82335
II82338
II82336
II82337
II82339
II79415
II97629
I013174
I65382
I65384
997250
997249
997240
997273
997206
997207
997248
997239
997247
997246
997238
997283
997282
997272
997265
997256
997255
997271
997264
997277
997270
997263
997254
997262
997253
997244
997236
997237
997279
997276
997274
997268
997267
997260
997243
997235
997229
997261
997258
997251
997244
997234
I016935
I016936
SUDBURY
RECEIVED
FEB 7 - 1955
MINING DIVISION

# TOWNSHIP 123

MISSISSAGI PROVINCIAL FOREST

SUDBURY MINING DIVISION

DISTRICT OF ALGOMA

Scale – 40 Chains = 1 Inch

Pine Shows Reserved

TP. 124.

TP. 130

TP. 118

TENNYSON

400' wide reservations on surface by Dept. of L. & F. shewn hereon thus

BOON TWP.
M-1205

Ministry of Natural Resources

Ministry of Northern Affairs and Mines

Ontario

January 1986

# INDEX TO LAND DISPOSITION

PLAN

G-3180

TOWNSHIP

BOON

M.N.R. ADMINISTRATIVE DISTRICT

ESPANOLA

MINING DIVISION

SUDBURY

LAND TITLES/REGISTRY DIVISION

ALGOMA

Scale 1:20 000

1000 Metres 0 1000 2000 Metres

1000 Feet 0 1000 2000 3000 4000 5000 6000 7000 8000 9000 10 000 Feet

Contour Interval 10 Metres

## SYMBOLS

Boundary
- Township, Meridian, Baseline
- Road allowance; surveyed
- shoreline
- Lot/Concession; surveyed
- unsurveyed
- Parcel; surveyed
- unsurveyed
- Right-of-way; road
- railway
- utility
- Reservation
- Cliff, Pit, Pile
- Contour (20)
- Interpolated
- Approximate
- Depression
- Control point (horizontal)
- Flooded land
- Mine head frame
- Pipeline (above ground)
- Railway; single track
- double track
- abandoned
- Road; highway, county, township
- access
- trail, bush
- Shoreline (original)
- Transmission line
- Wooded area

## DISPOSITION OF CROWN LANDS

Patent
- Surface & Mining Rights
- Surface Rights Only
- Mining Rights Only

Lease
- Surface & Mining Rights
- Surface Rights Only
- Mining Rights Only

Licence of Occupation

Order-in-Council (OC)

Cancelled

Reservation

Sand & Gravel

## AREAS WITHDRAWN FROM DISPOSITION

MRO - Mining Rights Only
SRO - Surface Rights Only
M+S - Mining and Surface Rights

| | Description | Order No. | Date | Disposition | File |
|---|---|---|---|---|---|
| R1 | ~~SEC.36/80~~ | ~~W.1/81~~ | ~~7/6/81~~ | ~~M & S~~ | ~~185114~~ = O-891/80, |
| R2 | SEC.36/80 | W.2/83 | 31/3/83 | S.R.O. | 77094 |
| R3 | ~~SEC.36/80~~ | ~~W96/86~~ | | ~~M & S~~ | |
| R4 | SEC.185(1) O-S-38/94 94/11/01 M & S 195150 | | | | |
| R5 | ~~SEC.185(1) W-S-50/93 93/09/02 M & S 195150~~ | | | | |
| R6 | SEC.185(1) O-S-38/94 94/11/01 M & S 195150 | | | | |
| R7 | ~~SEC.185(1) W-S-51/93 93/09/15 M & S 195150~~ | | | | |

DATE OF ISSUE

JUN 09 1998

PROVINCIAL RECORDING OFFICE - SUDBURY

THE INFORMATION THAT APPEARS ON THIS MAP HAS BEEN COMPILED FROM VARIOUS SOURCES, AND ACCURACY IS NOT GUARANTEED. THOSE WISHING TO STAKE MINING CLAIMS SHOULD CONSULT WITH THE MINING RECORDER, MINISTRY OF NORTHERN DEVELOPMENT AND MINES, FOR ADDITIONAL INFORMATION ON THE STATUS OF THE LANDS SHOWN HEREON.

Map base and land disposition drafting by Surveys and Mapping Branch, Ministry of Natural Resources.

The disposition of land, location of lot fabric and parcel boundaries on this index was compiled for administrative purposes only.

# Tp. 124 M. 1206

Tp. 130 M. 1209

Tp. 118 M. 1202

TENNYSON TWP. M. 1155

BOON

11 M 10 M 9 M 8 M 7 M 82°04' 46°27'10"

5 M 4 M 3 M 2 M 1 M

Riviere OFB

East Bull Lake

Goulding L.

Culler Cr.

Tiplady L.

Novick L.

Parisien L

Doux Falls

Sables L.

M.T.C. GRAVEL PIT

## NOTES

400' surface rights reservation along the shores of all lakes and rivers.

SUDBURY MINING DIV. RECEIVED JUL 9 1973 A.M. P.M. 7 8 9 10 11 12 1 2 3 4 5 6

## LEGEND

| | |
|---|---|
| PATENTED LAND | Ⓟ or ● |
| PATENTED FOR SURFACE RIGHTS ONLY | ◒ |
| LEASE | Ⓛ |
| LICENSE OF OCCUPATION | L.O. |
| CROWN LAND SALES | C.S. |
| LOCATED LAND | Loc. |
| CANCELLED | C. |
| MINING RIGHTS ONLY | M.R.O. |
| SURFACE RIGHTS ONLY | S.R.O. |
| HIGHWAY & ROUTE NO. | 17 |
| ROADS | |
| TRAILS | |
| RAILWAYS | |
| POWER LINES | |
| MARSH OR MUSKEG | |
| MINES | |

*used only with summer resort locations or when space is limited

TOWNSHIP OF

formerly Tp. 123

DISTRICT OF

ALGOMA

SUDBURY

MINING DIVISION

SCALE : 1 INCH -- 40 CHAINS (1/2 MILE)

DR. JBK

DATE 1 May '72

PLAN NO. M. 1205

ONTARIO

MINISTRY OF NATURAL RESOURCES

SURVEYS AND MAPPING BRANCH

G-3180 BOON TWP

ZONE 17

MANDAMIN TOWNSHIP

GEROW TOWNSHIP

SHIBANING TOWNSHIP

TENNYSON TOWNSHIP

Ontario

Ministry of Natural Resources

Ministry of Northern Affairs and Mines

January 1986

# INDEX TO LAND DISPOSITION

PLAN

G-3180

TOWNSHIP

BOON

M.N.R. ADMINISTRATIVE DISTRICT

ESPANOLA

MINING DIVISION

SUDBURY

LAND TITLES/REGISTRY DIVISION

ALGOMA

Scale 1:20 000

1000 Metres 0 1000 2000 Metres

1000 0 1000 2000 3000 4000 5000 6000 7000 8000 9000 10000 Feet

Contour Interval 10 Metres

DATE OF ISSUE
AUG 11 1995
SUDBURY
MINING RECORDER'S OFFICE

## SYMBOLS

Boundary
- Township, Meridian, Baseline
- Road allowance; surveyed / shoreline
- Lot/Concession; surveyed / unsurveyed
- Parcel; surveyed / unsurveyed
- Right-of-way; road / railway / utility
- Reservation
- Cliff, Pit, Pile
- Contour (20) / Interpolated / Approximate / Depression
- Control point (horizontal)
- Flooded land
- Mine head frame
- Pipeline (above ground)
- Railway; single track / double track / abandoned
- Road; highway, county, township / access / trail, bush
- Shoreline (original)
- Transmission line
- Wooded area

## DISPOSITION OF CROWN LANDS

Patent
- Surface & Mining Rights
- Surface Rights Only
- Mining Rights Only

Lease
- Surface & Mining Rights
- Surface Rights Only
- Mining Rights Only

Licence of Occupation

Order-in-Council (OC)

Cancelled

Reservation (R)

Sand & Gravel (S)

## AREAS WITHDRAWN FROM DISPOSITION

MRO - Mining Rights Only
SRO - Surface Rights Only
M + S - Mining and Surface Rights

| | Description | Order No. | Date | Disposition | File |
|---|---|---|---|---|---|
| R1 | ~~SEC.36/80~~ | ~~W-3/87~~ | ~~7/6/81~~ | ~~M & S~~ | ~~18834~~ - O-89/86, 21/11/96 |
| R2 | SEC.36/80 | W.2/83 | 31/3/83 | S.R.O. | 77094 |
| R3 | SEC.36/80 | W96/86 | | M&S | |
| R4 | SEC.185(1) O-3-38/94 94/11/01 M & S 195150 | | | | |
| R5 | ~~SEC.185(1) W-3-50/93 93/09/02 M & S 195150~~ SEC.185(1) O-3-38/94 94/11/01 M & S 195150 | | | | |
| R6 | ~~SEC.185(1) W-3-51/93 93/09/15 M & S 195150~~ | | | | |

"THE INFORMATION THAT APPEARS ON THIS MAP HAS BEEN COMPILED FROM VARIOUS SOURCES, AND ACCURACY IS NOT GUARANTEED. THOSE WISHING TO STAKE MINING CLAIMS SHOULD CONSULT WITH THE MINING RECORDER, MINISTRY OF NORTHERN DEVELOPMENT AND MINES, FOR ADDITIONAL INFORMATION ON THE STATUS OF THE LANDS SHOWN HEREON.

Map base and land disposition drafting by Surveys and Mapping Branch, Ministry of Natural Resources.

The disposition of land, location of lot fabric and parcel boundaries on this index was compiled for administrative purposes only.

G-3180 BOON TWP

G-3180 BOON TWP

Ministry of Natural Resources
Ontario

Ministry of Northern Affairs and Mines

January 1986

# INDEX TO LAND DISPOSITION

PLAN
G-3180

TOWNSHIP
BOON

M.N.R. ADMINISTRATIVE DISTRICT
ESPANOLA

MINING DIVISION
SUDBURY

LAND TITLES/REGISTRY DIVISION
ALGOMA

Scale 1:20 000

1000 Metres 0 1000 2000 Metres

1000 Feet 0 1000 2000 3000 4000 5000 6000 7000 8000 9000 10000 Feet

Contour Interval 10 Metres

## SYMBOLS

Boundary
- Township, Meridian, Baseline
- Road allowance; surveyed / shoreline
- Lot/Concession; surveyed / unsurveyed
- Parcel; surveyed / unsurveyed
- Right-of-way; road / railway / utility
- Reservation
- Cliff, Pit, Pile
- Contour / Interpolated / Approximate / Depression
- Control point (horizontal)
- Flooded land
- Mine head frame
- Pipeline (above ground)
- Railway; single track / double track / abandoned
- Road; highway, county, township / access / trail, bush
- Shoreline (original)
- Transmission line
- Wooded area

## DISPOSITION OF CROWN LANDS

Patent
- Surface & Mining Rights
- Surface Rights Only
- Mining Rights Only

Lease
- Surface & Mining Rights
- Surface Rights Only
- Mining Rights Only

- Licence of Occupation
- Order-in-Council — OC
- Cancelled
- Reservation
- Sand & Gravel

## AREAS WITHDRAWN FROM DISPOSITION

MRO - Mining Rights Only
SRO - Surface Rights Only
M+S - Mining and Surface Rights

| | Description | Order No. | Date | Disposition | File |
|---|---|---|---|---|---|
| R1 | ~~SEC.36/80~~ | ~~W-1-3/3~~ | ~~7/8/81~~ | ~~M R S~~ | ~~188514~~ |
| R2 | SEC.36/80 | W.2/83 | 31/3/83 | S.R.O. | 77094 |
| R3 | ~~SEC36/80~~ | ~~W96/86~~ | | ~~M R S~~ | |
| R4 | SEC.185(1) 0-S-38/94 94/11/01 M R S 195150 | | | | |
| R4 | ~~SEC.185(1) W-S-50/93 93/09/02 M R S 195150~~ | | | | |
| R4 | SEC.185(1) 0-S-38/94 94/11/01 M R S 195150 | | | | |
| R5 | ~~SEC.185(1) W-S-51/93 93/09/15 M R S 195150~~ | | | | |

~~0-89/86~~, 21/11/86

DATE OF ISSUE
SEP 09 1986
PROVINCIAL RECORDING OFFICE - SUDBURY

THE INFORMATION THAT APPEARS ON THIS MAP HAS BEEN COMPILED FROM VARIOUS SOURCES, AND ACCURACY IS NOT GUARANTEED. THOSE WISHING TO STAKE MINING CLAIMS SHOULD CONSULT WITH THE MINING RECORDER, MINISTRY OF NORTHERN DEVELOPMENT AND MINES, FOR ADDITIONAL INFORMATION ON THE STATUS OF THE LANDS SHOWN HEREON.

Map base and land disposition drafting by Surveys and Mapping Branch, Ministry of Natural Resources.

The disposition of land, location of lot fabric and parcel boundaries on this index was compiled for administrative purposes only.

G-3180

1205

# TOWNSHIP 123

MISSISSAGA PROVINCIAL FOREST

SUDBURY MINING DIVISION

DISTRICT OF ALGOMA

Scale—40 Chains = 1 Inch

TP. 124.

SUDBURY
MINING DIV.
RECEIVED
JUL 23 1970
A.M. 7 8 9 10 11 12 1 2 3 4 5 6 P.M.

North Ast.

11M 30 00 10M 30 00 WEST 9M AST 30 00 8M 30 00 7M 30 00

River

W. Br. Vahl's

To 60 Gate

5M

4M

3M

2M

1M

30 00

BULL LAKE

M 215

S

D.T.C. 1644

30125

31225

208509

208918

208510

208319

291717

291715

291712

291711

River

Sables

TP 150

TP 118

| | | | | | | | |
|---|---|---|---|---|---|---|---|
| 290178 | 290179 | 290182 | 290183 | 290184 | 290186 | 290189 | 290190 |
| 290181 | 290180 | 290177 | 290188 | 290185 | 290143 | 290192 | 290191 |

30 00

74 75 31 90 79 31 WEST 79 00 30 34

12 11 10 9 8 7 6 5 4 3 2 1

VI


TENNYSON

400' surface reservations on surface by Dept of L.N.R. shown thereon thus .....

Sand & Gravel on all unpatented mining claims in this Township reserved to the Crown.

BOON TWP.
M-1205

G-3180

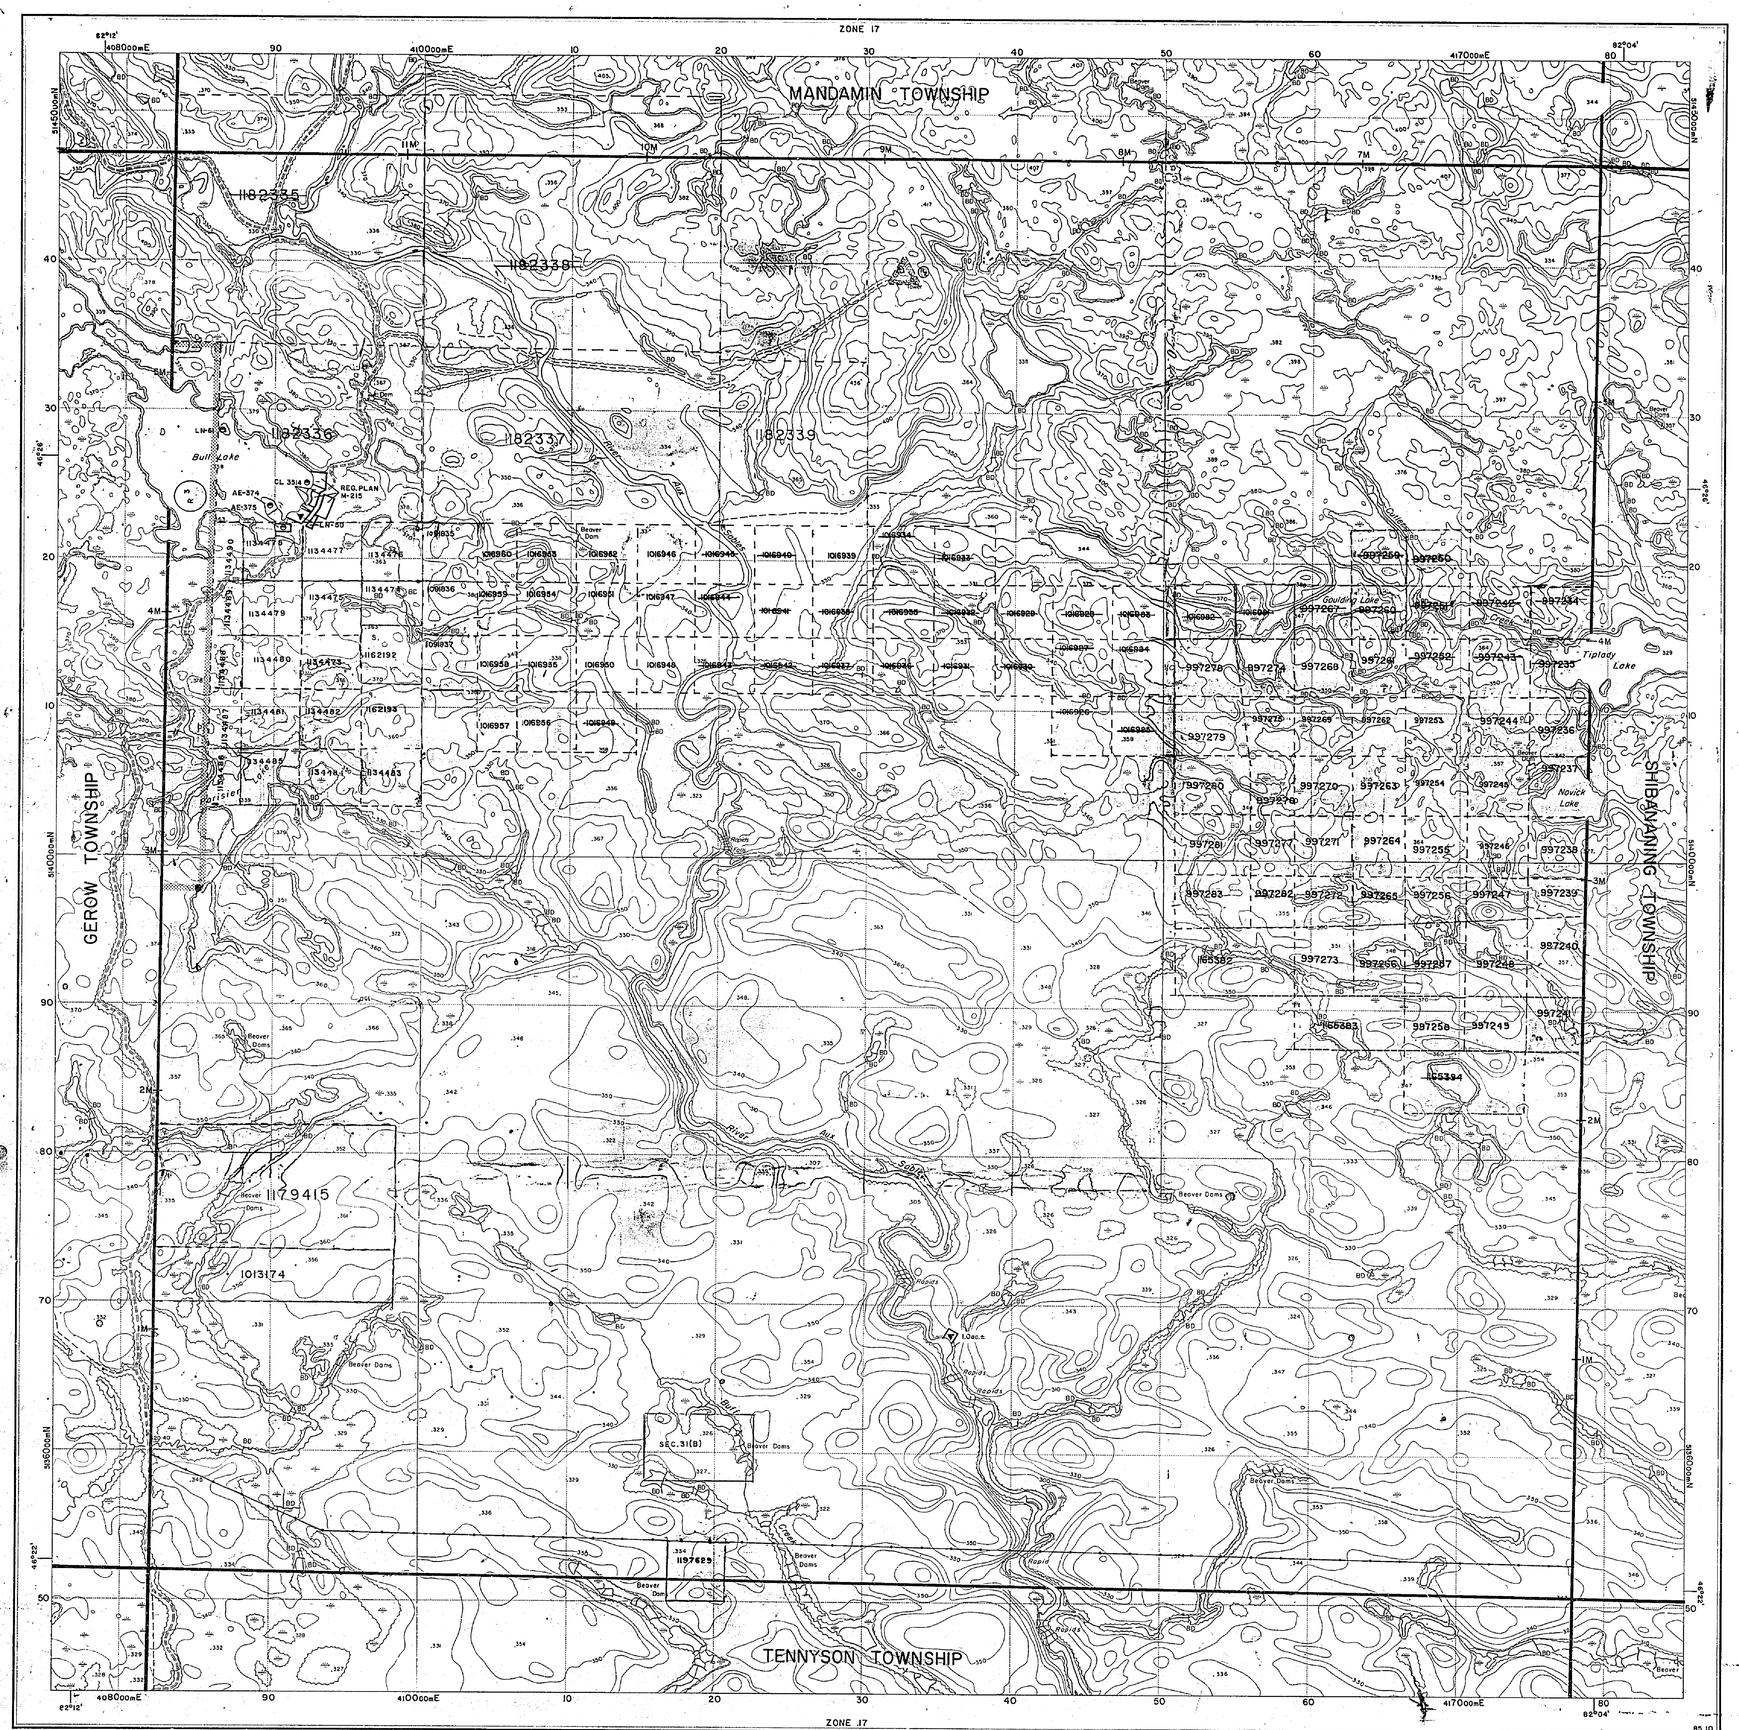


Ministry of Natural Resources / Ministry of Northern Affairs and Mines

Ontario

January 1986

# INDEX TO LAND DISPOSITION

PLAN

G-3180

TOWNSHIP

BOON

M.N.R. ADMINISTRATIVE DISTRICT

ESPANOLA

MINING DIVISION

SUDBURY

LAND TITLES/REGISTRY DIVISION

ALGOMA

DATE OF ISSUE
JUN 4 1985
SUDBURY
MINING RECORDER'S OFFICE

Scale 1:20 000

1000 Metres 0 1000 2000 Metres

1000 Feet 0 1000 2000 3000 4000 5000 6000 7000 8000 9000 10000 Feet

Contour Interval 10 Metres

## SYMBOLS

Boundary
- Township, Meridian, Baseline
- Road allowance; surveyed
  - shoreline
- Lot/Concession; surveyed
  - unsurveyed
- Parcel; surveyed
  - unsurveyed
- Right-of-way; road
  - railway
  - utility
- Reservation
- Cliff, Pit, Pile
- Contour (20)
  - Interpolated
  - Approximate
  - Depression
- Control point (horizontal)
- Flooded land
- Mine head frame
- Pipeline (above ground)
- Railway; single track
  - double track
  - abandoned
- Road; highway, county, township
  - access
  - trail, bush
- Shoreline (original)
- Transmission line
- Wooded area

## DISPOSITION OF CROWN LANDS

Patent
- Surface & Mining Rights
- Surface Rights Only
- Mining Rights Only

Lease
- Surface & Mining Rights
- Surface Rights Only
- Mining Rights Only

- Licence of Occupation
- Order-in-Council — OC
- Cancelled
- Reservation
- Sand & Gravel

## AREAS WITHDRAWN FROM DISPOSITION

MRO - Mining Rights Only
SRO - Surface Rights Only
M + S - Mining and Surface Rights

| | Description | Order No. | Date | Disposition | File |
|---|---|---|---|---|---|
| R | ~~SEC.36/80~~ | ~~W.1/83~~ | ~~7/07/83~~ | ~~M & S~~ | ~~195114~~ - 0-89/86, 21/11/8 |
| R | SEC.36/80 | W.2/83 | 31/3/83 | S.R.O. | 77094 |
| R3 | SEC36/80 | W96/86 | | M&S | |
| | SEC.185(1) 0-S-38/94 94/11/01 M & S 195150 | | | | |
| R4 | ~~SEC.185(1) W-S-50/93 93/09/02 M & S 195150~~ | | | | |
| AC | ~~SEC.185(1) W-S-51/93 93/09/15 M & S 195150~~ | | | | |


THE INFORMATION THAT APPEARS ON THIS MAP HAS BEEN COMPILED FROM VARIOUS SOURCES, AND ACCURACY IS NOT GUARANTEED. THOSE WISHING TO STAKE MINING CLAIMS SHOULD CONSULT WITH THE MINING RECORDER, MINISTRY OF NORTHERN DEVELOPMENT AND MINES, FOR ADDITIONAL INFORMATION ON THE STATUS OF THE LANDS SHOWN HEREON.

Map base and land disposition drafting by Survey's and Mapping Branch, Ministry of Natural Resources.

The disposition of land, location of lot fabric and parcel boundaries on this index was compiled for administrative purposes only.


G-3180
BOON TWP
G-3180
BOON TWP
G-3180

G-3180 BOON TWP

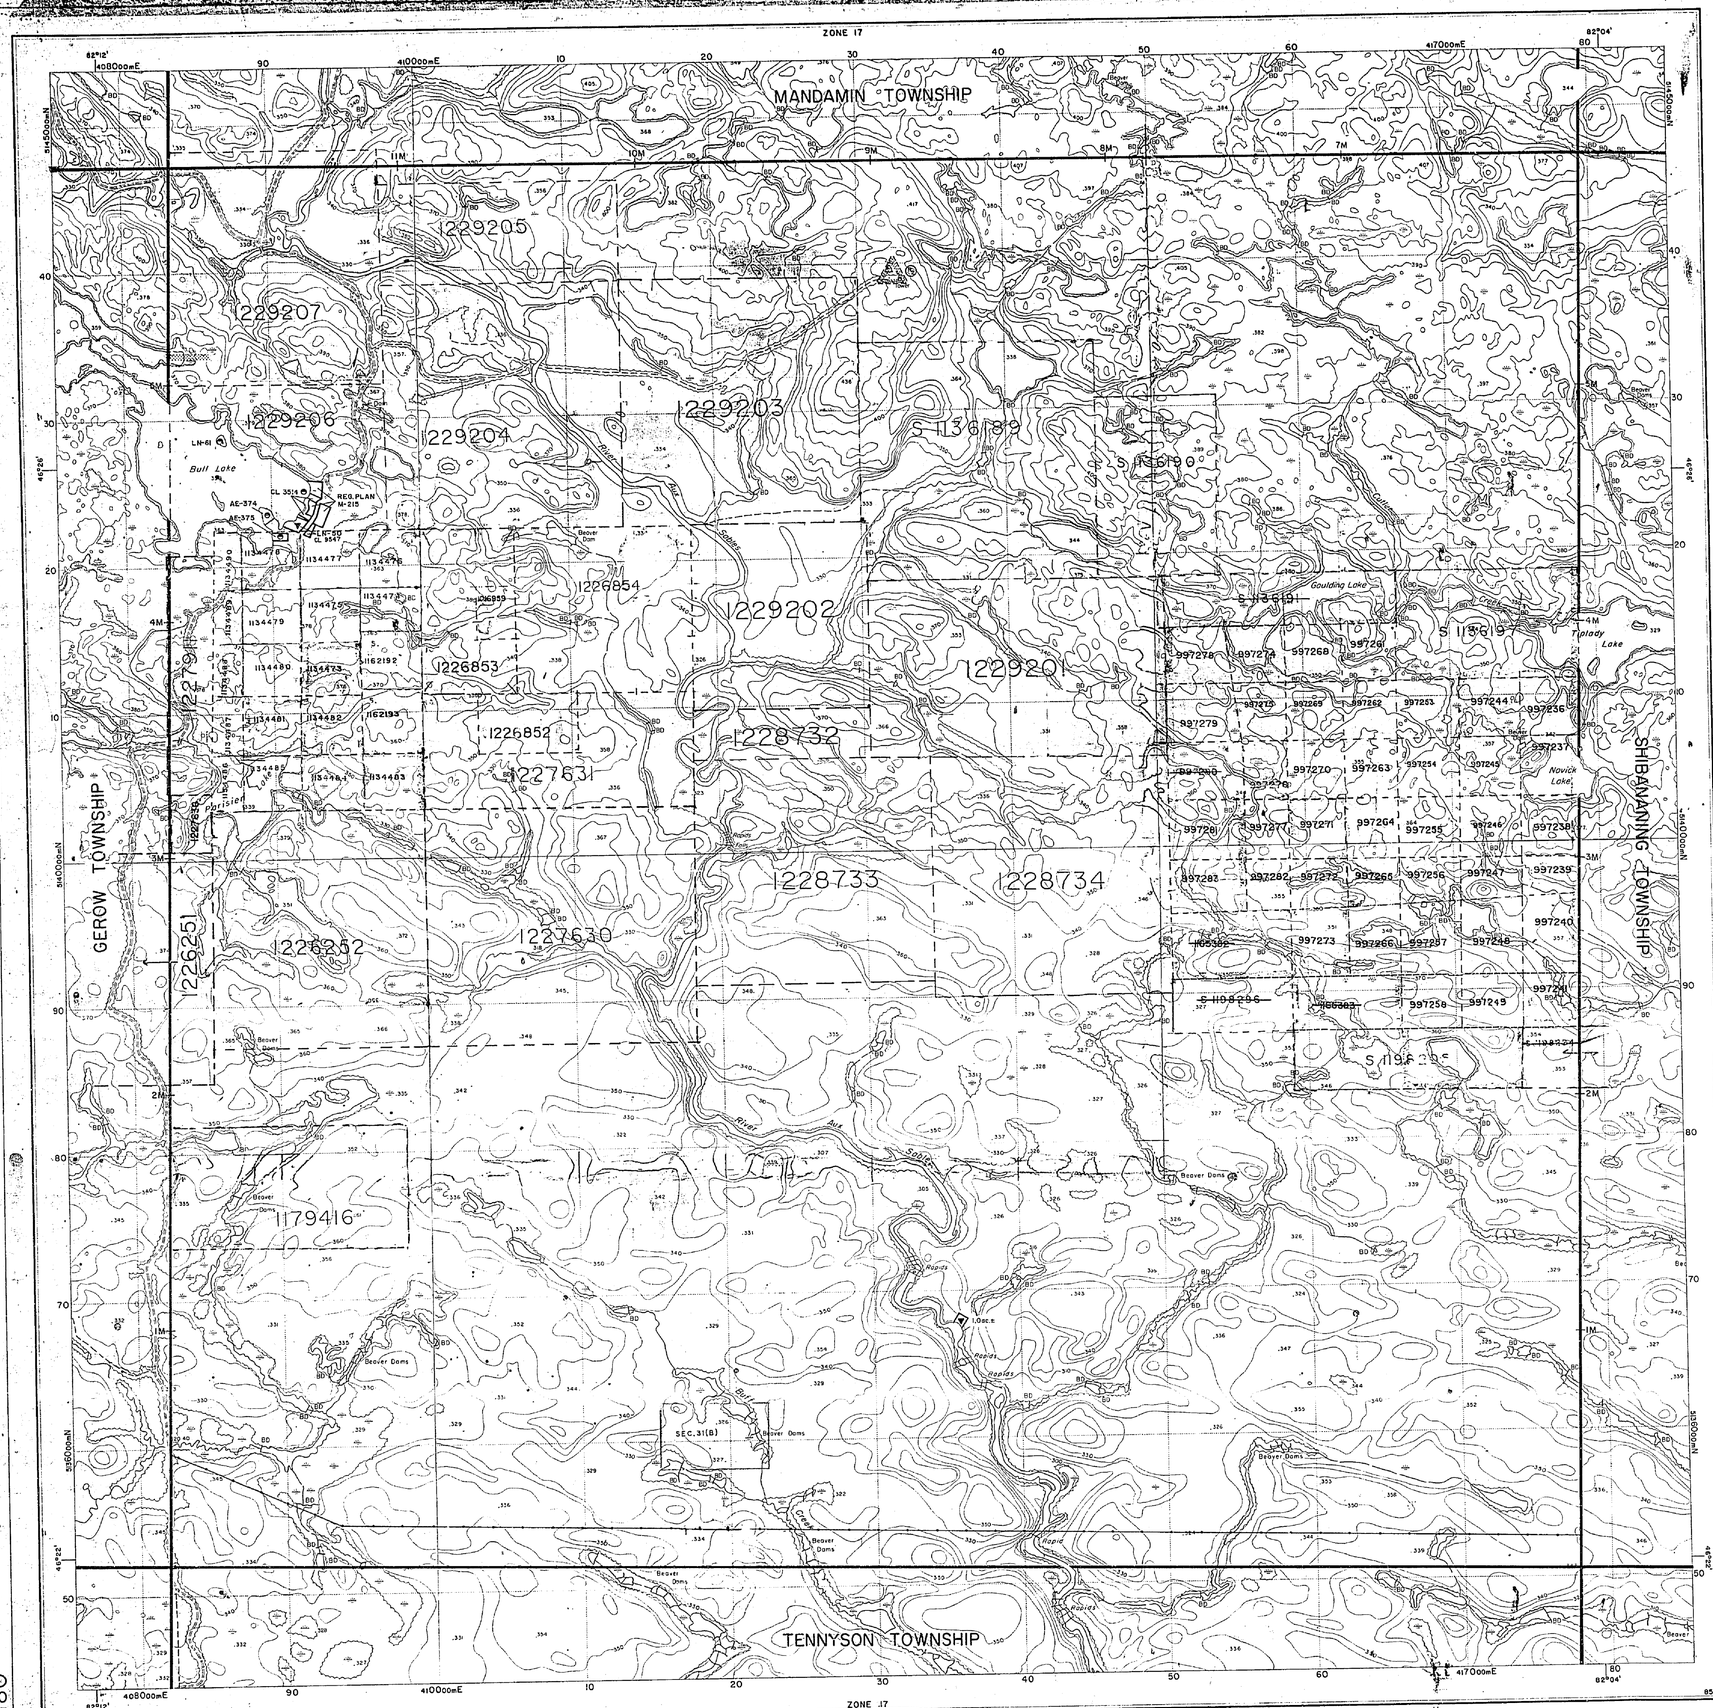

1205

MANDAMIN Tp M. 1206

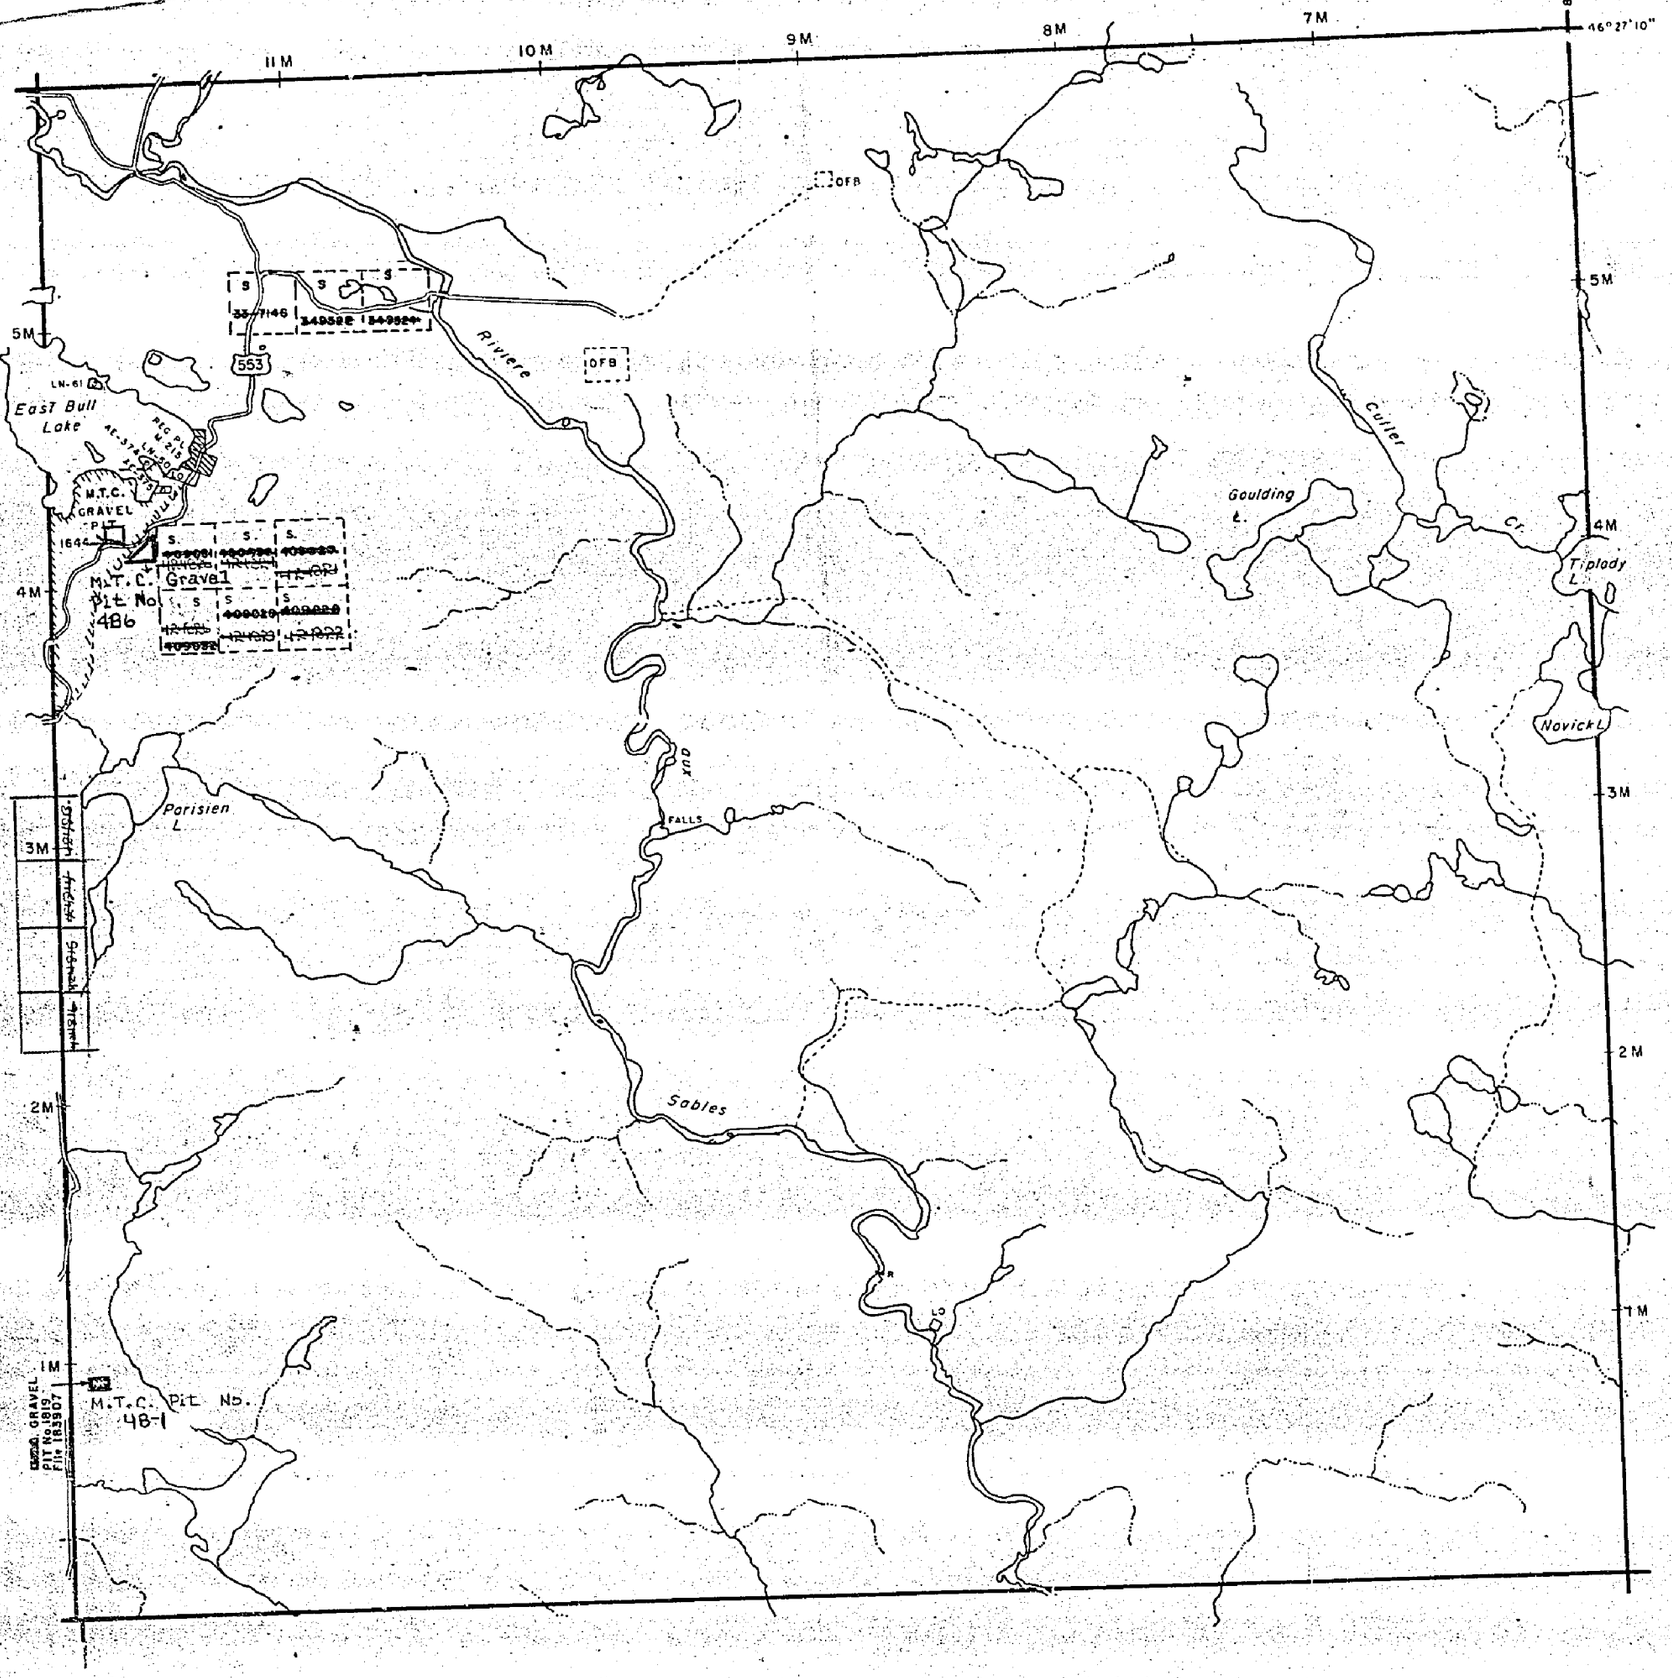


TENNYSON TWP. M. 1155

## NOTES

400' surface rights reservation along the shores of all lakes and rivers.

DATE OF ISSUE
FEB 12 1975

## LEGEND

| | |
|---|---|
| PATENTED LAND | P or ●* |
| PATENTED FOR SURFACE RIGHTS ONLY | ●* |
| LEASE | L |
| LICENSE OF OCCUPATION | L.O. |
| CROWN LAND SALES | C.S. |
| LOCATED LAND | Loc. |
| CANCELLED | C. |
| MINING RIGHTS ONLY | M.R.O. |
| SURFACE RIGHTS ONLY | S.R.O. |
| HIGHWAY & ROUTE NO. | 17 |
| ROADS | |
| TRAILS | |
| RAILWAYS | |
| POWER LINES | |
| MARSH OR MUSKEG | |
| MINES | |

*used only with summer resort locations or when space is limited

TOWNSHIP OF

# BOON
(Tp. 123)

DISTRICT OF
ALGOMA

SUDBURY
MINING DIVISION


SCALE : 1 INCH = 40 CHAINS (1/2 MILE)

DR. JSK
DATE 1May'72

PLAN NO. M. 1205

ONTARIO
MINISTRY OF NATURAL RESOURCES
SURVEYS AND MAPPING BRANCH

C-3180 BOON TWP

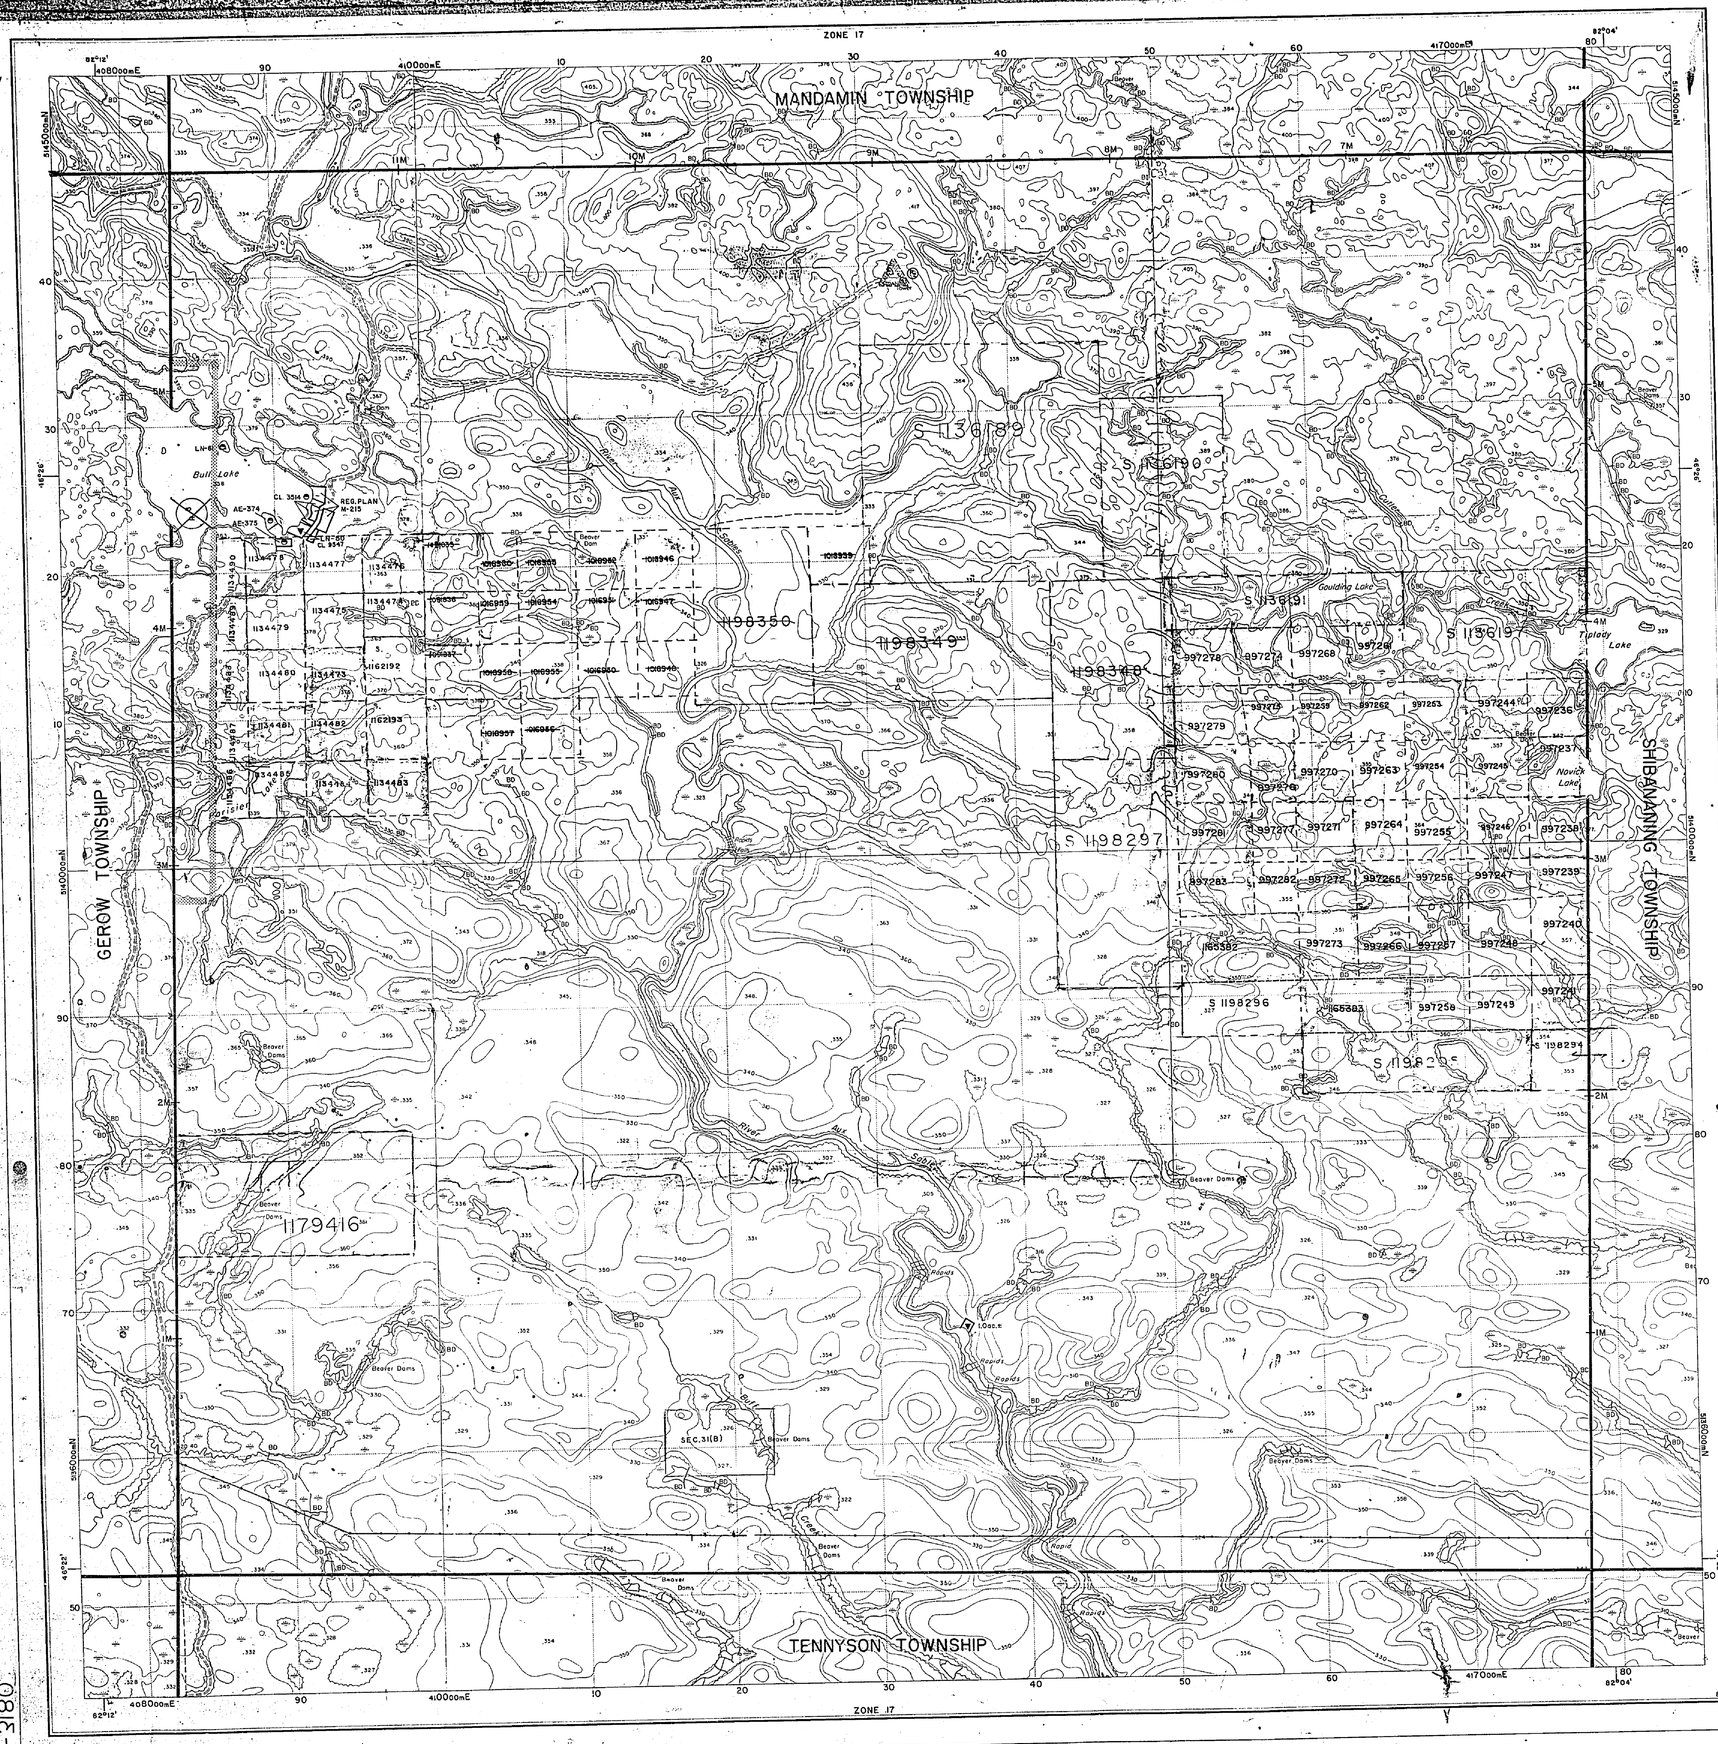


C-3180 BOON TWP

Ministry of Natural Resources
Ontario

Ministry of Northern Affairs and Mines

January 1986

# INDEX TO LAND DISPOSITION

PLAN
G-3180

TOWNSHIP
BOON

**DATE OF ISSUE**
MAY 2 5 1998
PROVINCIAL RECORDING OFFICE - SUDBURY

M.N.R. ADMINISTRATIVE DISTRICT
ESPANOLA

MINING DIVISION
SUDBURY

LAND TITLES/REGISTRY DIVISION
ALGOMA

Scale 1:20 000

1000 Metres 0 1000 2000 Metres

1000 Feet 0 1000 2000 3000 4000 5000 6000 7000 8000 9000 10000 Feet

Contour interval 10 Metres

## SYMBOLS

Boundary
- Township, Meridian, Baseline
- Road allowance; surveyed
- shoreline
- Lot/Concession; surveyed
- unsurveyed
- Parcel; surveyed
- unsurveyed
- Right-of-way; road
- railway
- utility
- Reservation
- Cliff, Pit, Pile
- Contour
- Interpolated
- Approximate
- Depression
- Control point (horizontal)
- Flooded land
- Mine head frame
- Pipeline (above ground)
- Railway; single track
- double track
- abandoned
- Road; highway, county, township
- access
- trail, bush
- Shoreline (original)
- Transmission line
- Wooded area

## DISPOSITION OF CROWN LANDS

Patent
- Surface & Mining Rights
- Surface Rights Only
- Mining Rights Only

Lease
- Surface & Mining Rights
- Surface Rights Only
- Mining Rights Only

- Licence of Occupation
- Order-in-Council — OC
- Cancelled
- Reservation
- Sand & Gravel

## AREAS WITHDRAWN FROM DISPOSITION

MRO - Mining Rights Only
SRO - Surface Rights Only
M+S - Mining and Surface Rights

| | Description | Order No. | Date | Disposition | File |
|---|---|---|---|---|---|
| (S) | ~~SEC.36/80~~ | ~~W-1/87~~ | ~~1/8/81~~ | ~~M & S~~ | ~~188514~~ - 0-89/86, 21/11/86 |
| (S) | SEC.36/80 | W.2/83 | 31/3/83 | S.R.O. | 77094 |
| (Ro) | ~~SEC.36/80~~ | ~~WDS/86~~ | | ~~M+S~~ | |
| (M+S) | SEC.185(1) O-S-38/94 94/11/01 M & S 195150 | | | | |
| (M+S) | ~~SEC.185(1) W-S-50/93 93/09/02 M & S 195150~~ | | | | |
| (M+S) | SEC.185(1) O-S-38/94 94/11/01 M & S 195150 | | | | |
| (M+S) | ~~SEC.185(1) W-S-51/93 93/09/15 M & S 195150~~ | | | | |

THE INFORMATION THAT APPEARS ON THIS MAP HAS BEEN COMPILED FROM VARIOUS SOURCES, AND ACCURACY IS NOT GUARANTEED. THOSE WISHING TO STAKE MINING CLAIMS SHOULD CONSULT WITH THE MINING RECORDER, MINISTRY OF NORTHERN DEVELOPMENT AND MINES, FOR ADDITIONAL INFORMATION ON THE STATUS OF THE LANDS SHOWN HEREON.

Map base and land disposition drafting by Surveys and Mapping Branch, Ministry of Natural Resources.

The disposition of land, location of lot fabric and parcel boundaries on this index was compiled for administrative purposes only.

C-3180

1205

# TOWNSHIP 123

MISSISSAGI PROVINCIAL FOREST
SUDBURY MINING DIVISION
DISTRICT OF ALGOMA

Scale – 40 Chains = 1 Inch

TP. 124.

North Asf.

TP. 130

TP. 118

VI

TENNYSON

400' wide reservations on surface by Dept of L & F. shewn hereon thus .....

Sand & Gravel on all unpatented mining claims in this Township reserved to the Crown.

BOON TWP.
M-1205

1205

SUDBURY RECEIVED FEB 7 - 1955 MINING DIVISION

# TOWNSHIP 123

MISSISSAGI PROVINCIAL FOREST

SUDBURY MINING DIVISION

DISTRICT OF ALGOMA

Scale—40 Chains = 1 Inch


TP. 124.

TP. 130

TP. 118

TENNYSON

400' wide reservations on surface by Dept. of L. & F. shewn thereon thus

BOON TWP.
M-1205

1205



SUDBURY MINING DIVISION

DISTRICT OF ALGOMA

Scale - 40 Chains = 1 Inch

TP. 124.

North Ast.

TP. 130

TP. 118

Sables River

Bull Lake

Sables

Boo Lake

TENNYSON

400' wide reservations on surface by Dept of L & F shown thereon thus

Sand & Gravel on all unpatented mining claims in this Township reserved to the Crown.

BOON TWP
M-1205

# 1205


Tp. 124 M. 1206

Tp. 130 M. 1209

Tp. 118 M. 1202

TENNYSON TWP. M. 1155

BOON

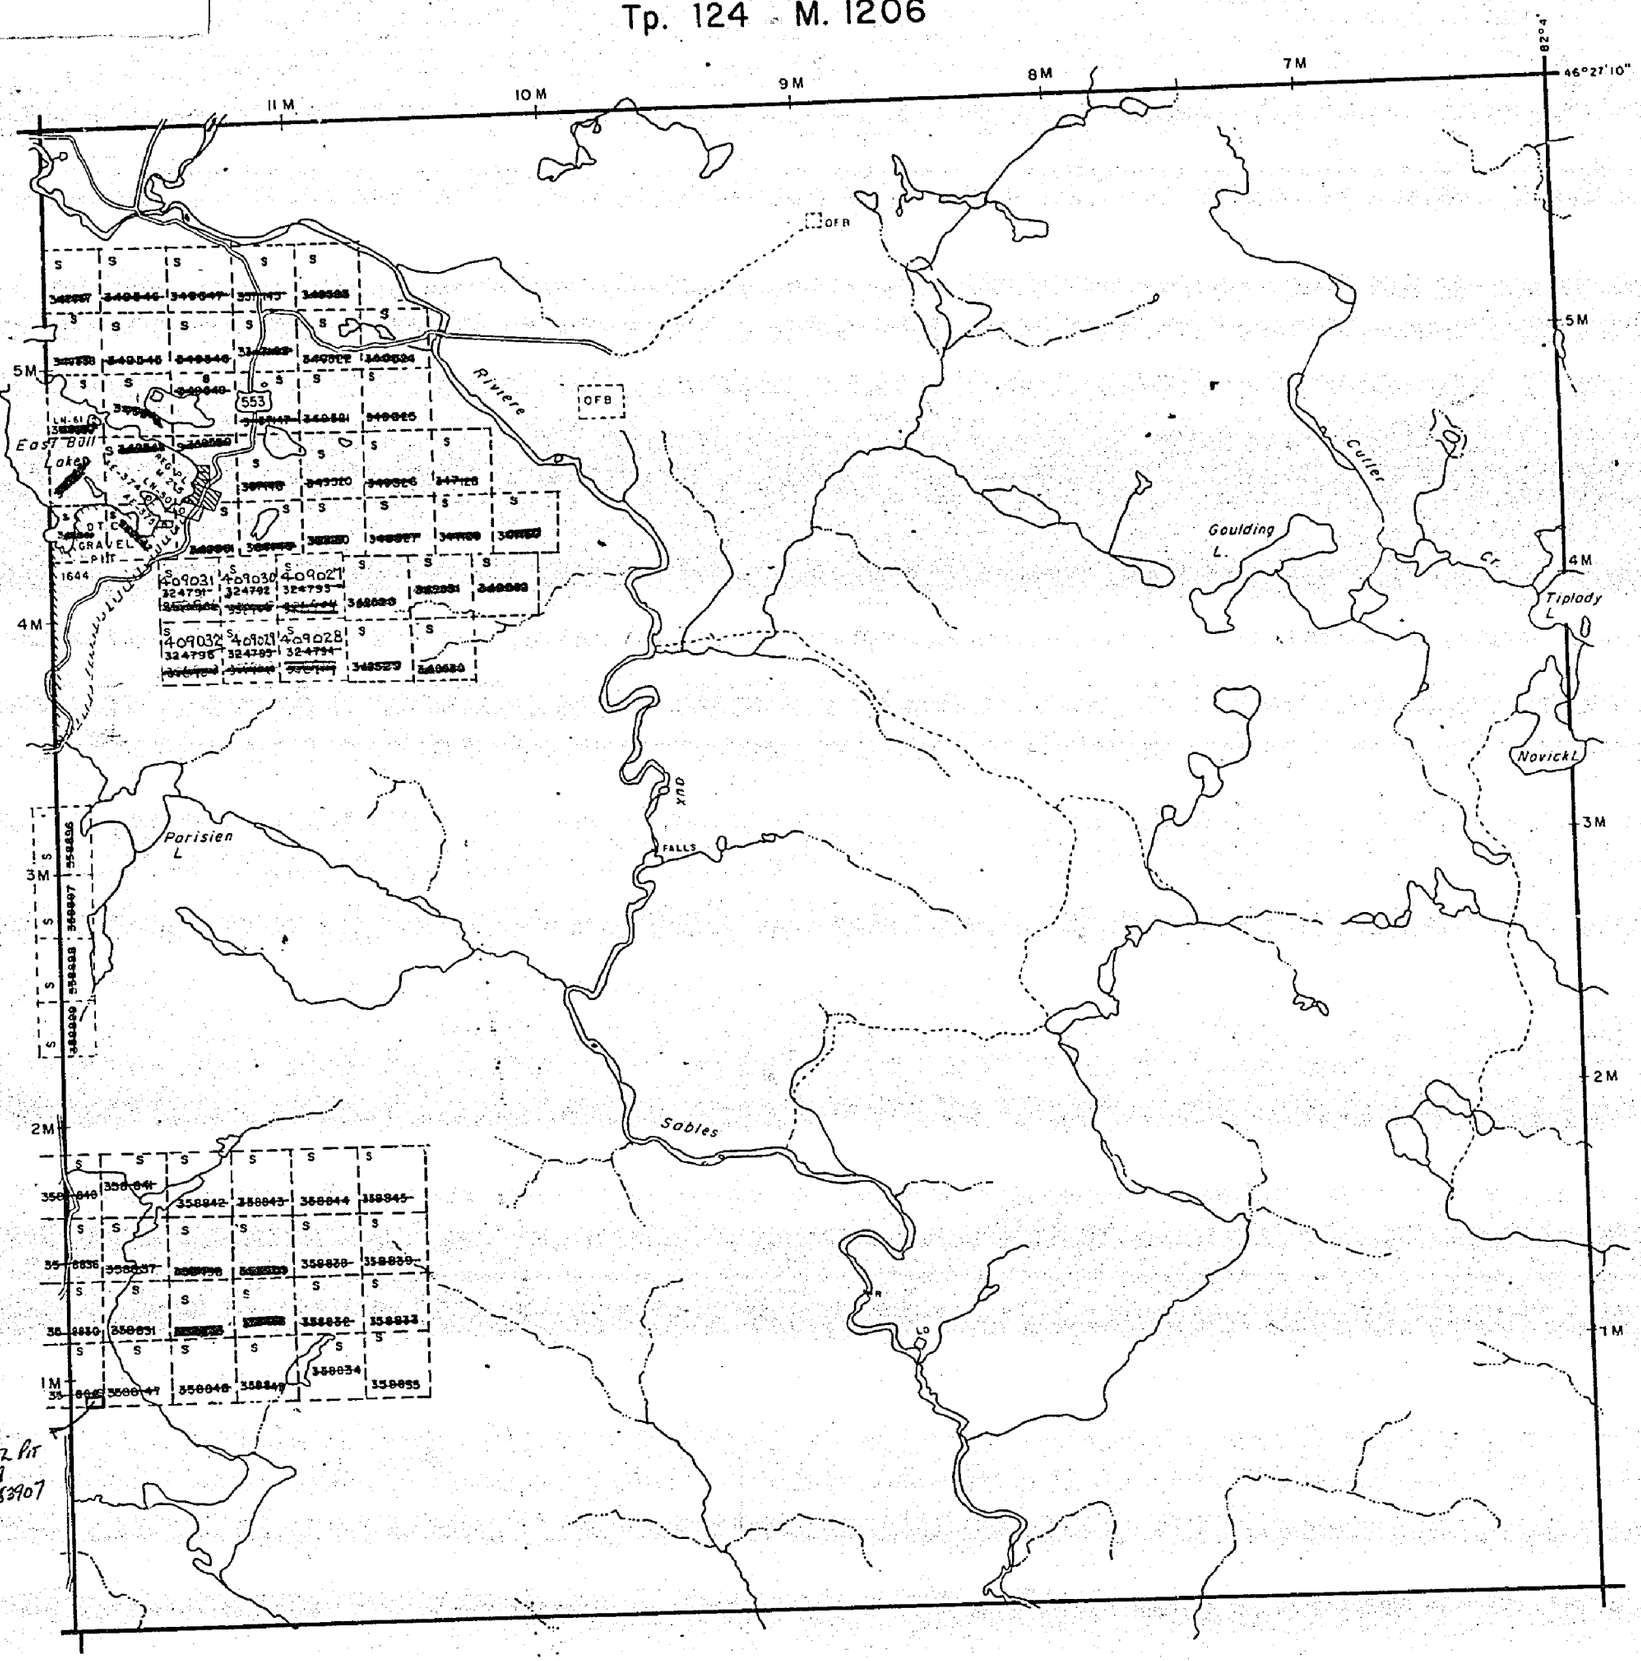


## NOTES

400' surface rights reservation along the shores of all lakes and rivers.

SUDBURY MINING DIV.
RECEIVED
JUL 9 1973
A.M. 7 8 9 10 11 12 1 2 3 4 5 6 P.M.

## LEGEND

| | |
|---|---|
| PATENTED LAND | Ⓟ or ● |
| PATENTED FOR SURFACE RIGHTS ONLY | ◑* |
| LEASE | Ⓛ |
| LICENSE OF OCCUPATION | L.O. |
| CROWN LAND SALES | C.S. |
| LOCATED LAND | Loc. |
| CANCELLED | C. |
| MINING RIGHTS ONLY | M.R.O. |
| SURFACE RIGHTS ONLY | S.R.O. |
| HIGHWAY & ROUTE NO. | (17) |
| ROADS | |
| TRAILS | |
| RAILWAYS | |
| POWER LINES | |
| MARSH OR MUSKEG | |
| MINES | |

*used only with summer resort locations or when space is limited

TOWNSHIP OF
formerly Tp. 123

DISTRICT OF
ALGOMA

SUDBURY
MINING DIVISION


SCALE : 1 INCH - 40 CHAINS (1/2 MILE)

| | |
|---|---|
| DR. JBK | PLAN NO. M. 1205 |
| DATE 1May '72 | |

ONTARIO
MINISTRY OF NATURAL RESOURCES
SURVEYS AND MAPPING BRANCH

1205

Tp. 124 M. 1206

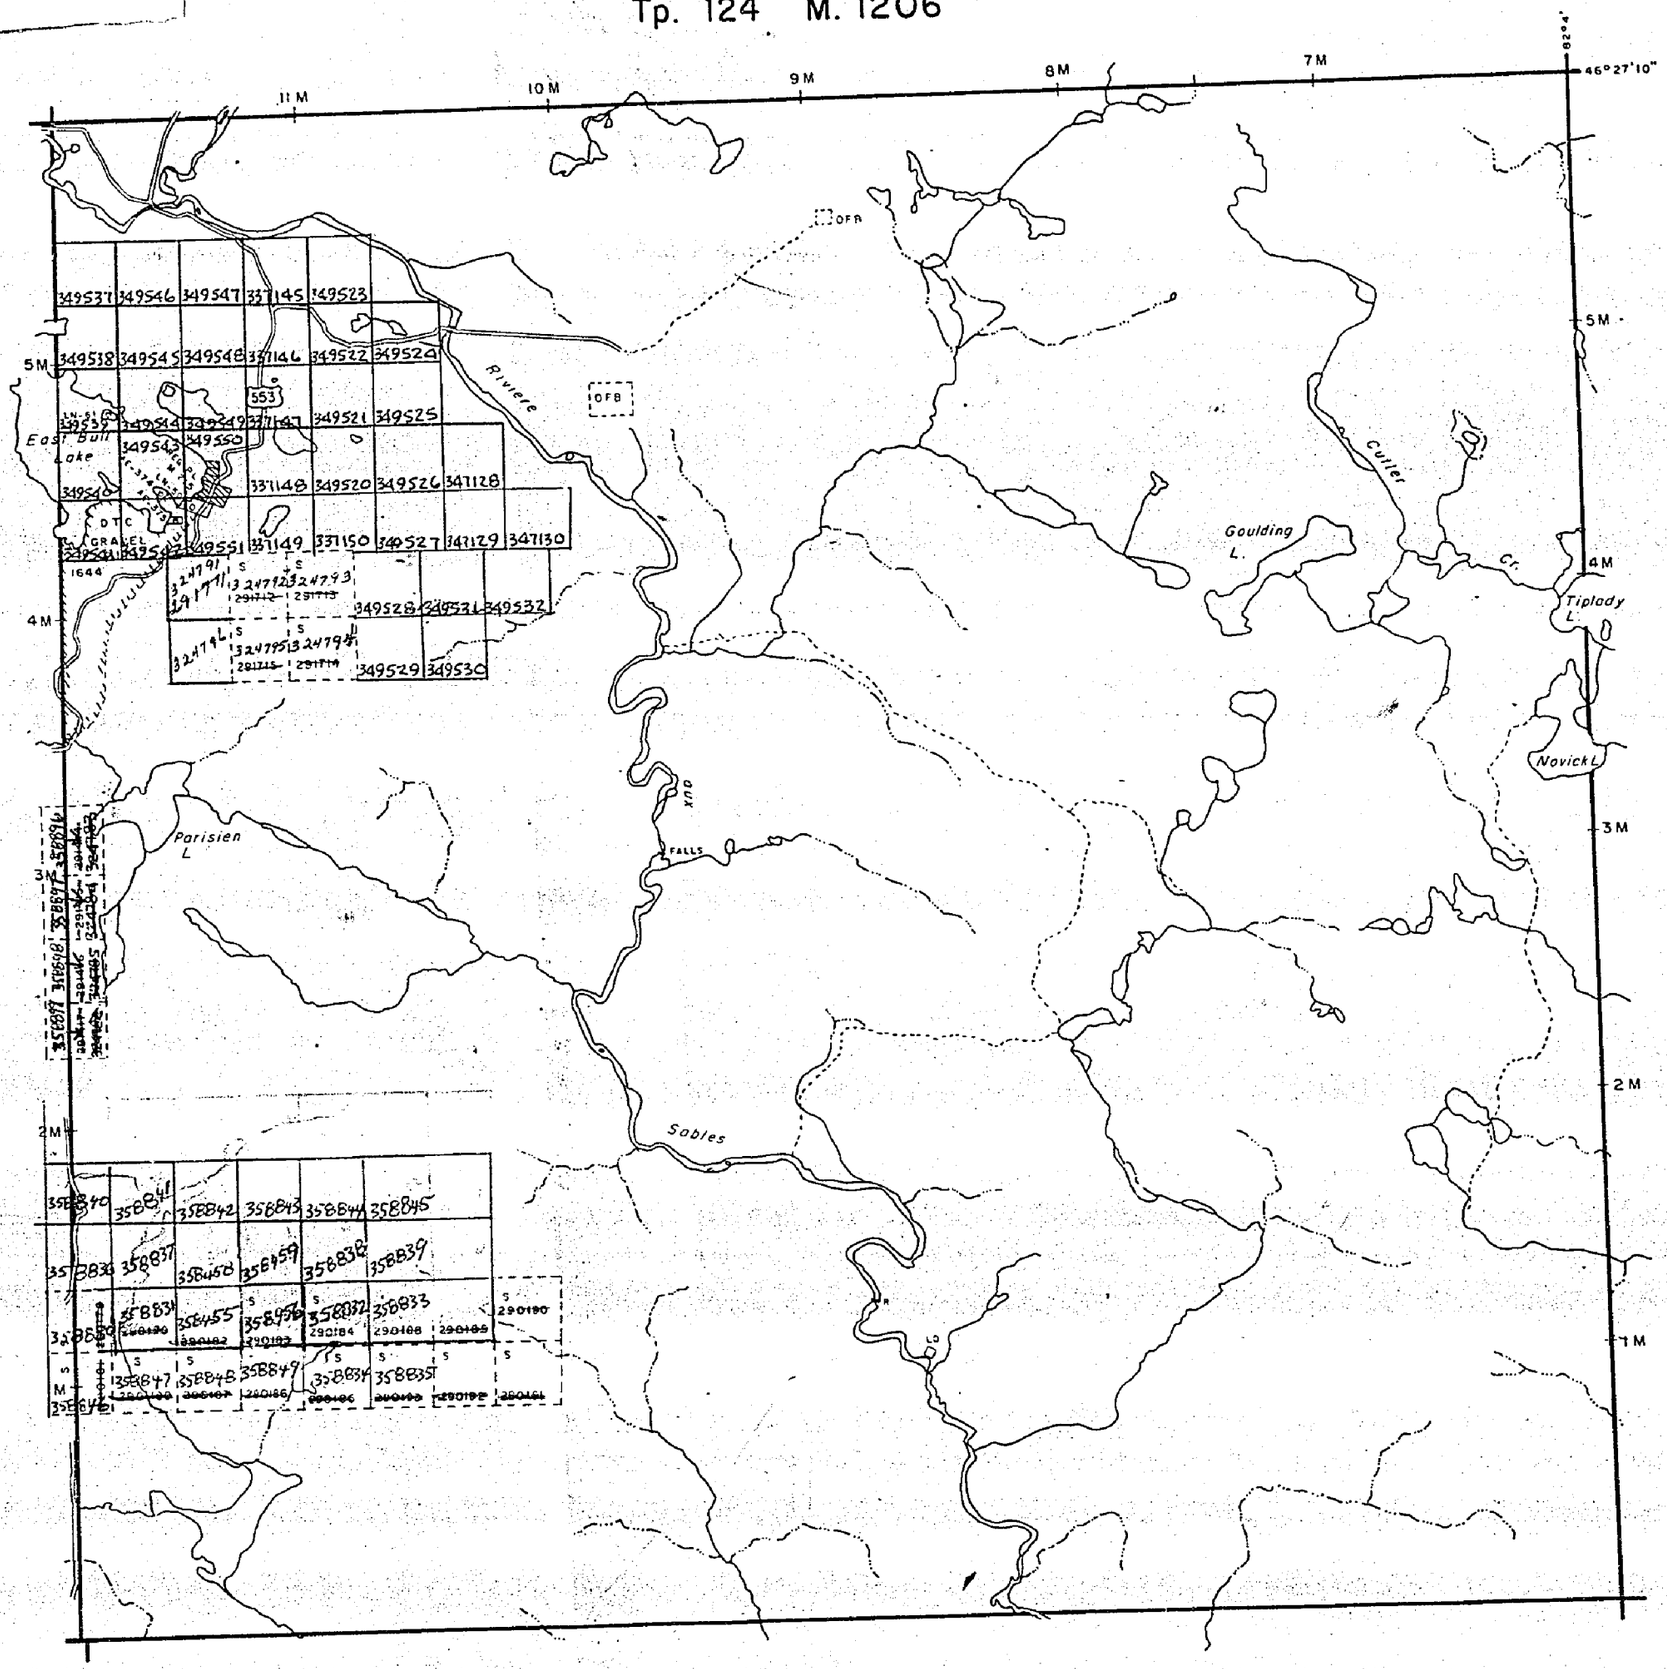


Tp. 130 M. 1209

Tp. 118 M. 1202

TENNYSON TWP. M. 1155

## NOTES

400' surface rights reservation along the shores of all lakes and rivers.

RECEIVED
JUN 5 1972
MINING LANDS BRANCH

## LEGEND

| | |
|---|---|
| PATENTED LAND | Ⓟ or ●* |
| PATENTED FOR SURFACE RIGHTS ONLY | ◑* |
| LEASE | Ⓛ |
| LICENSE OF OCCUPATION | L.O. |
| CROWN LAND SALES | C.S. |
| LOCATED LAND | Loc. |
| CANCELLED | C. |
| MINING RIGHTS ONLY | M.R.O. |
| SURFACE RIGHTS ONLY | S.R.O. |
| HIGHWAY & ROUTE NO. | (17) |
| ROADS | |
| TRAILS | |
| RAILWAYS | |
| POWER LINES | |
| MARSH OR MUSKEG | |
| MINES | |

*used only with summer resort locations or when space is limited

TOWNSHIP OF

# Tp. 123

DISTRICT OF
ALGOMA

SUDBURY
MINING DIVISION

SCALE : 1 INCH = 40 CHAINS (1/2 MILE)

| | |
|---|---|
| DR. JBK | PLAN NO. M. 1205 |
| DATE 1May '72 | |

MINISTRY OF
NATURAL RESOURCES
ONTARIO

1205

# TOWNSHIP 123

MISSISSAGI PROVINCIAL FOREST

SUDBURY MINING DIVISION

DISTRICT OF ALGOMA

Scale – 40 Chains = 1 Inch

TP. 124.

TP. 130

TP 118

Sables River

Sables River

Aux

BUIL LAKE

TENNYSON

400' wide reservations on surface by Dept of Lands & F. shewn hereon thus .....

Sand & Gravel on all unpatented mining claims in this Township reserved to the Crown.

BOON Twp.
M-1205

1205

# TOWNSHIP 123

MISSISSAGI PROVINCIAL FOREST

SUDBURY MINING DIVISION

DISTRICT OF ALGOMA

Scale – 40 Chains = 1 Inch

400 Res

TP. 124.

TP. 130

TP. 118

TENNYSON

200' wide reservations on surface by Dept of L & F shewn hereon thus

BOON TWP
M-1205

# TOWNSHIP 123

MISSISSAGI PROVINCIAL FOREST

SUDBURY MINING DIVISION

DISTRICT OF ALGOMA

Scale—40 Chains = 1 Inch

North Ast.

TP. 124.

TP. 130.

TP. 118.

River

W. Br. Sable

Sables

Aux

Co

Bull Lake

M 215

OFB 24

TENNYSON

400' wide reservations on surface by Dept of L. & F. shewn hereon thus .....

Sand & Gravel on all unpatented mining claims in this Township reserved to the Crown.

BOON TWP
M-1205

# TOWNSHIP 123

MISSISSAGI PROVINCIAL FOREST

SUDBURY MINING DIVISION


DISTRICT OF ALGOMA

Scale – 40 Chains = 1 Inch

TP. 124.

TP. 130.

TP. 118.

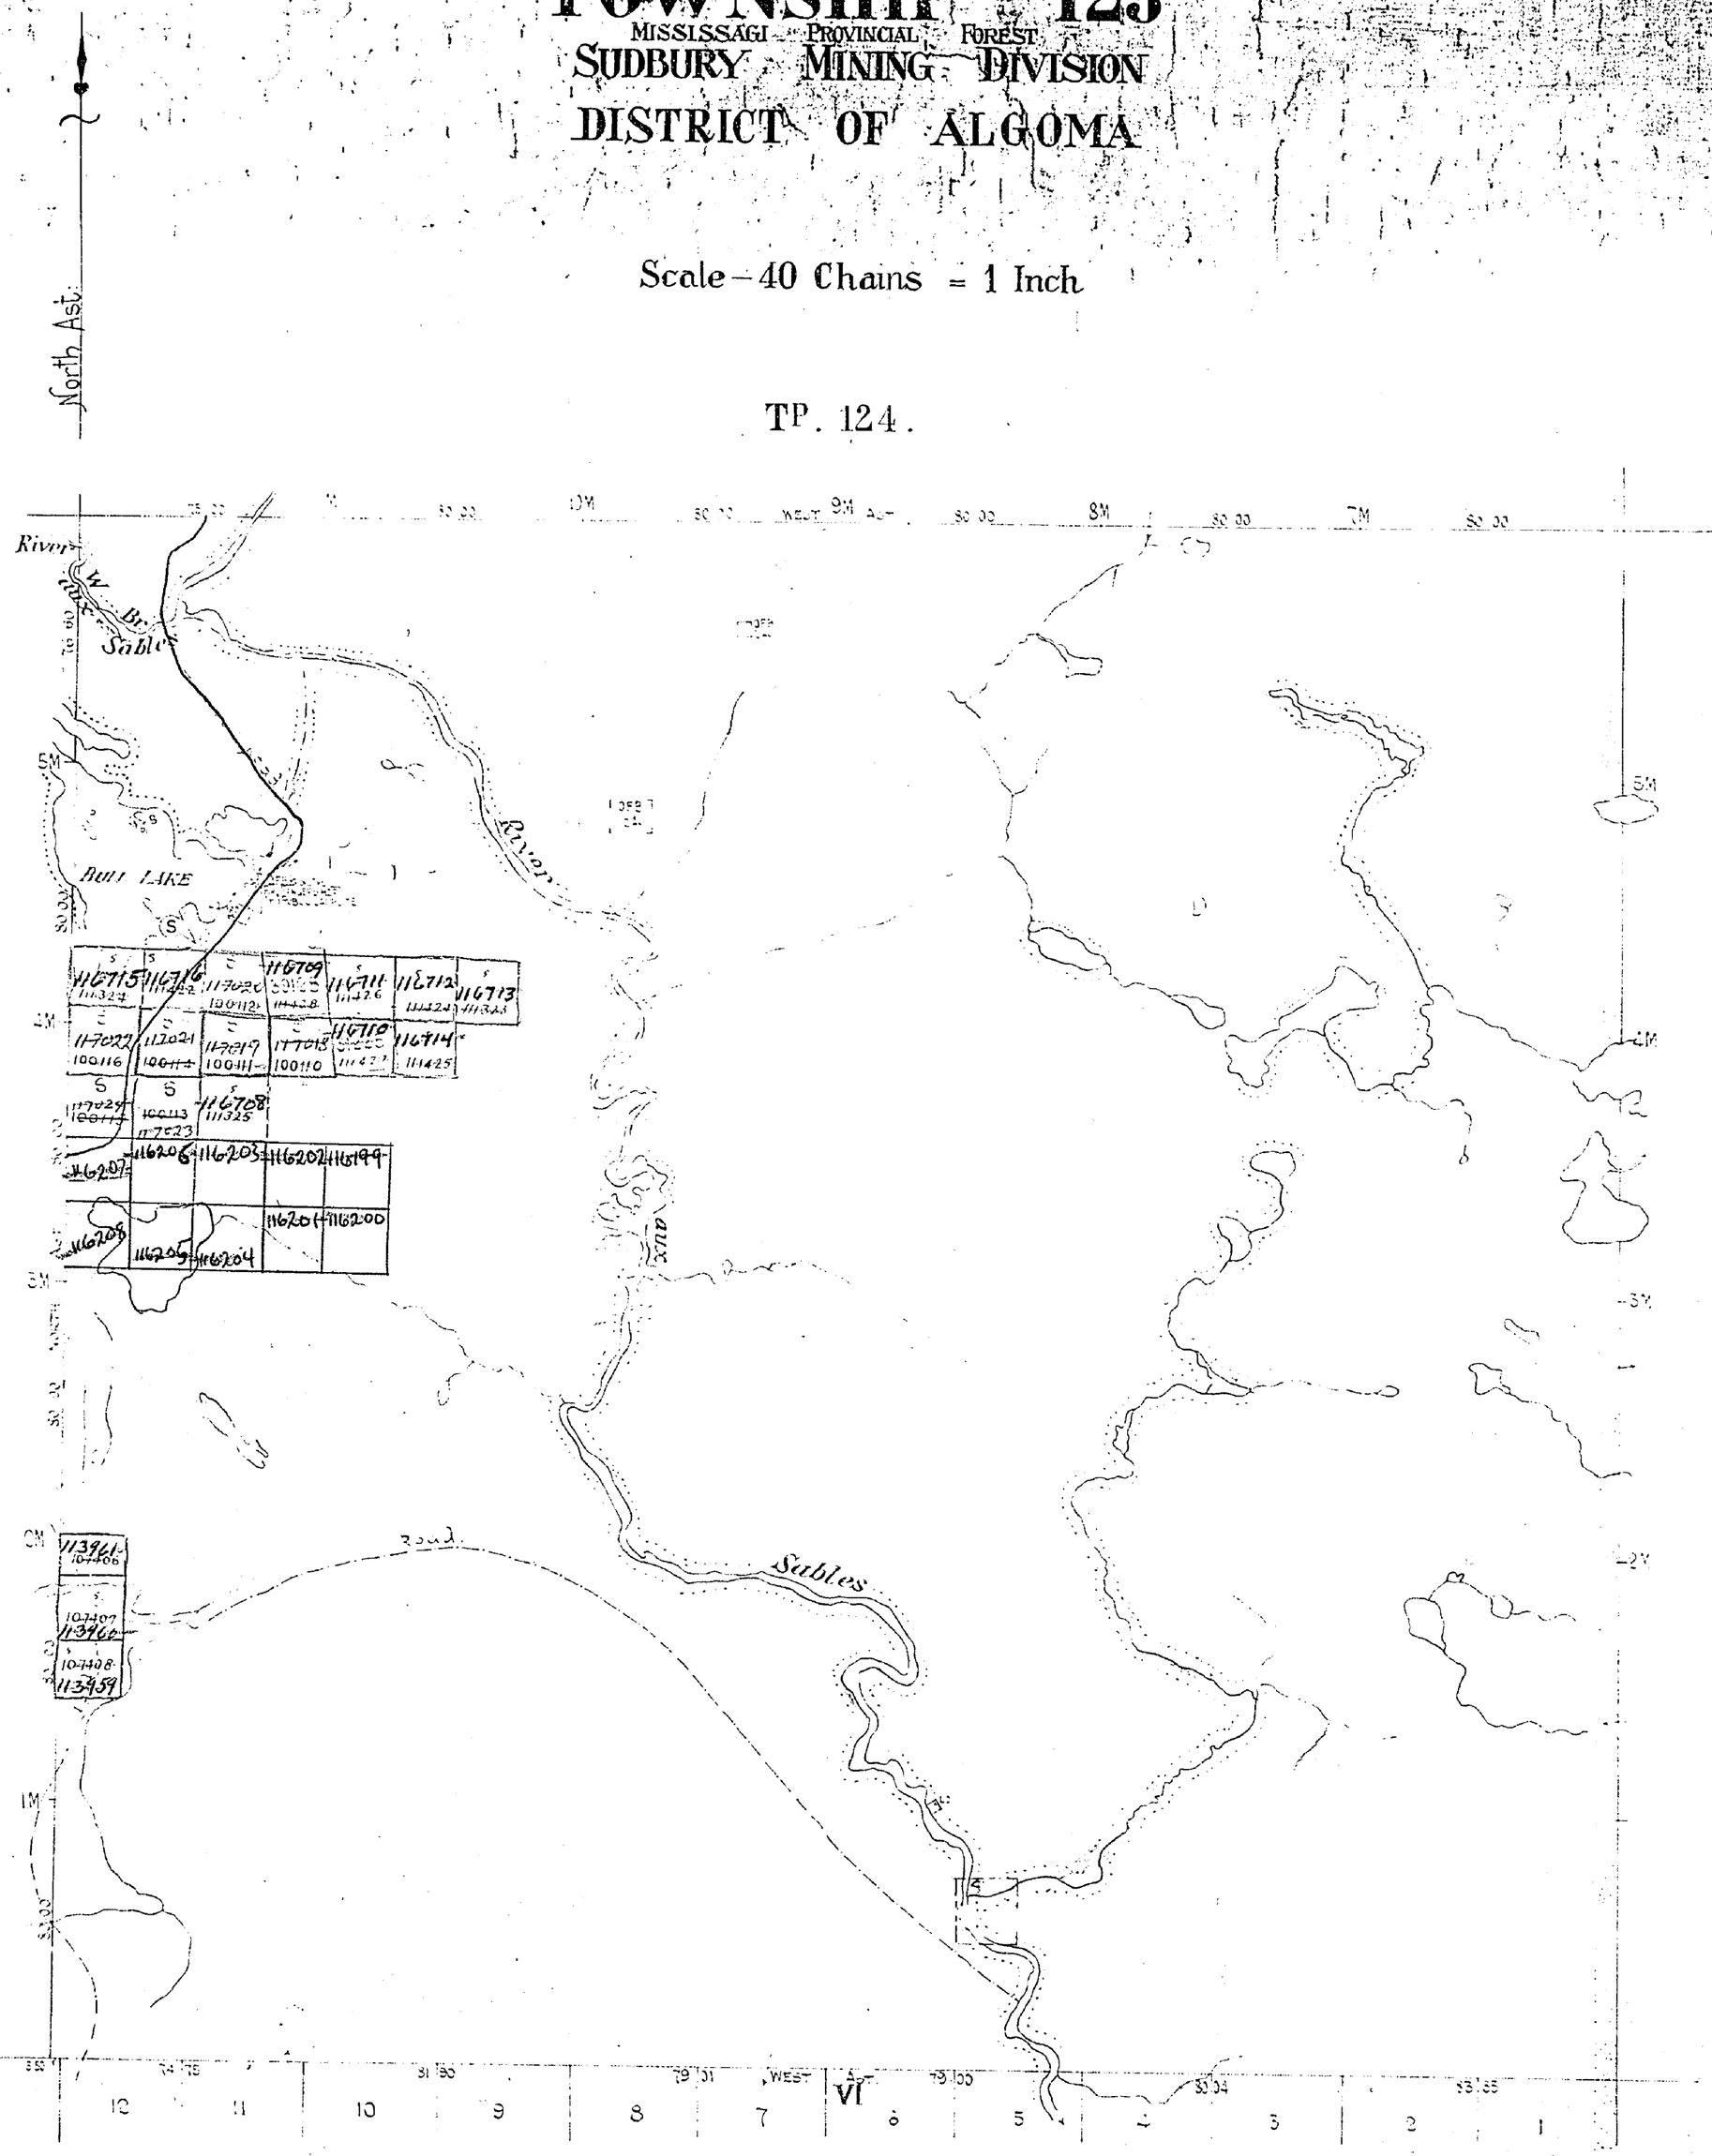


TENNYSON

400' wide reservations on surface by Dept of L & F shewn hereon thus .....

Sand & Gravel on all unpatented mining claims in this Township reserved to the Crown.

BOON TWP.
M-1205

# TOWNSHIP 123

MISSISSAGI PROVINCIAL FOREST

SUDBURY MINING DIVISION

DISTRICT OF ALGOMA

Scale – 40 Chains = 1 Inch

400 Res

TP. 124.

North Ast.

TP. 130.

TP. 118.

TENNYSON

200' wide reservations on surface by Dept. of L. & F. shewn hereon thus

BOON TWP
M-1205

# TOWNSHIP 123

MISSISSAGI PROVINCIAL FOREST

SUDBURY MINING DIVISION


DISTRICT OF ALGOMA

Scale—40 Chains = 1 Inch

TP. 124.

TP. 130.

TP. 118.

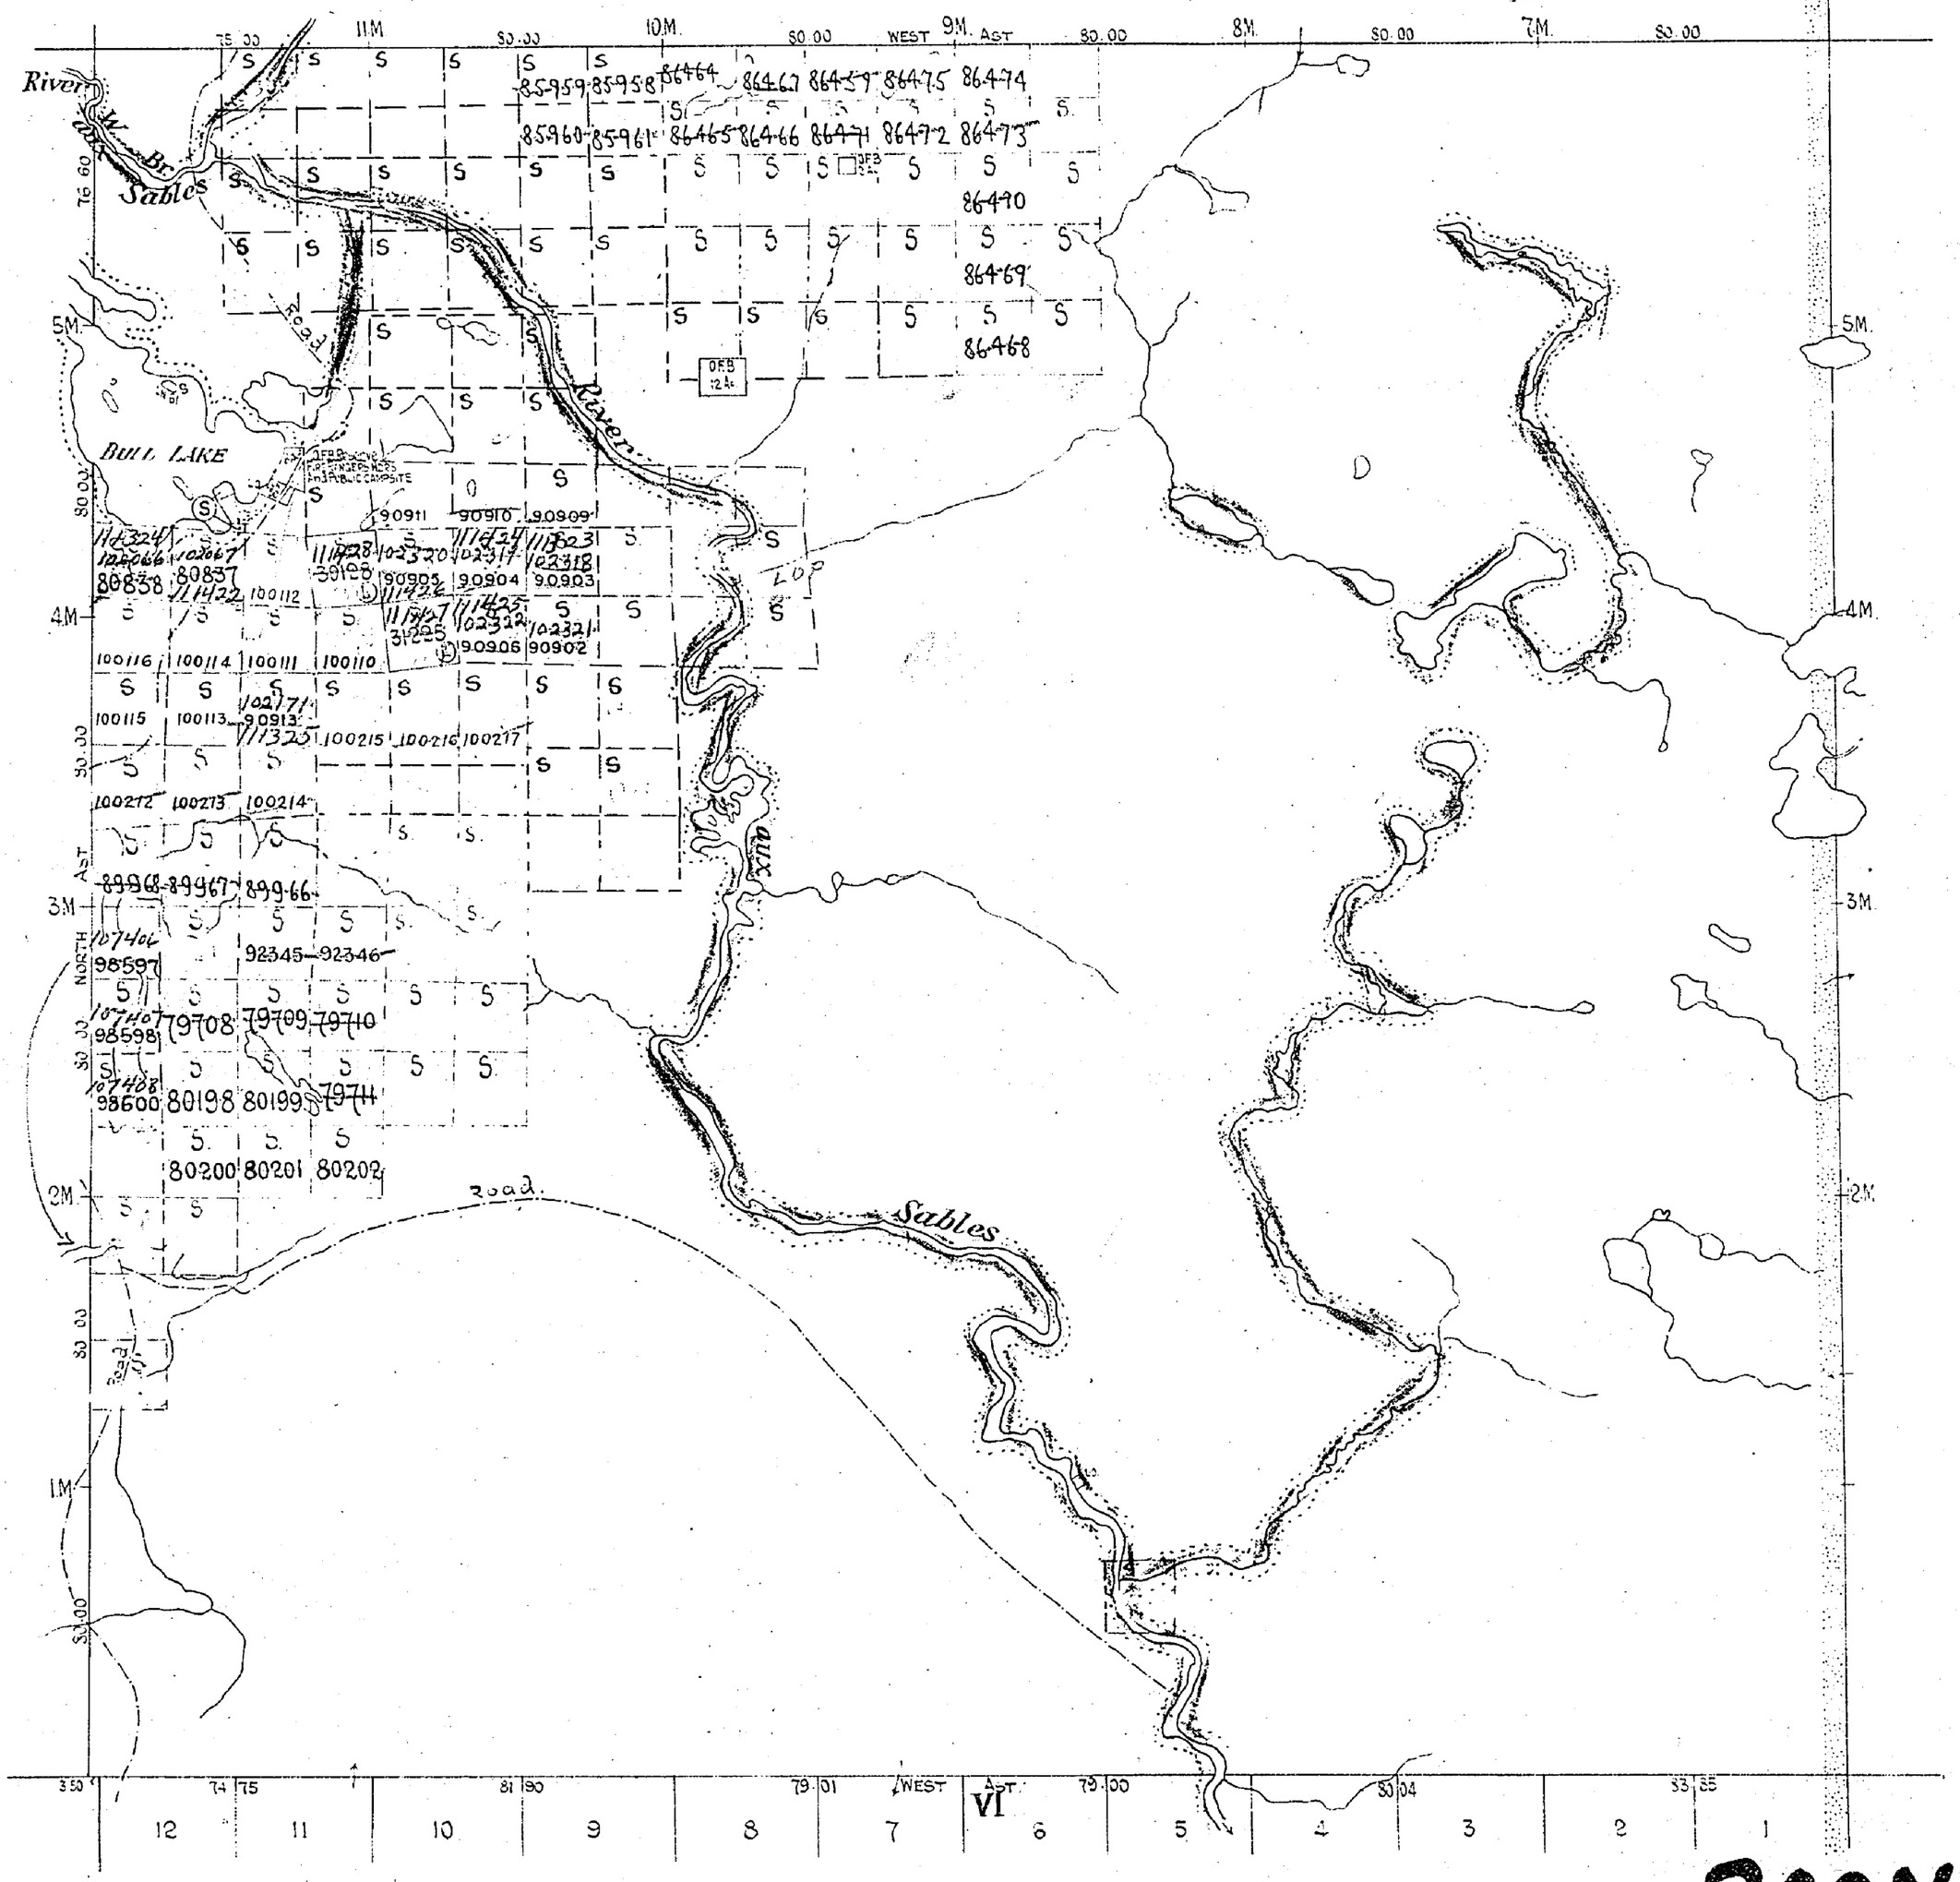


## TENNYSON

400' wide reservations on surface by Dept. of L. & F. shewn hereon thus

Sand & Gravel on all unpatented mining claims in this Township reserved to the Crown.

BOON TWP.
M-1205

# TOWNSHIP 123

MISSISSAGA PROVINCIAL FOREST

SUDBURY MINING DIVISION

DISTRICT OF ALGOMA

Scale – 40 Chains = 1 Inch

North Asr.

TP. 124.

SUDBURY MINING DIV.
RECEIVED
JUL 22 1970
A.M. 7 8 9 10 11 12 1 2 3 4 5 6 P.M.

TP. 130

TP. 118

River

W. Br. Sables

Sables

Sables

BULL LAKE

M 215

D.T.C. 1644


TENNYSON

400' wide reservations on surface by Dept of L. & F. shown thereon thus

Sand & Gravel on all unpatented mining claims in this Township reserved to the Crown.

BOON TWP.
M-1205

# Tp. 124 M. 1206

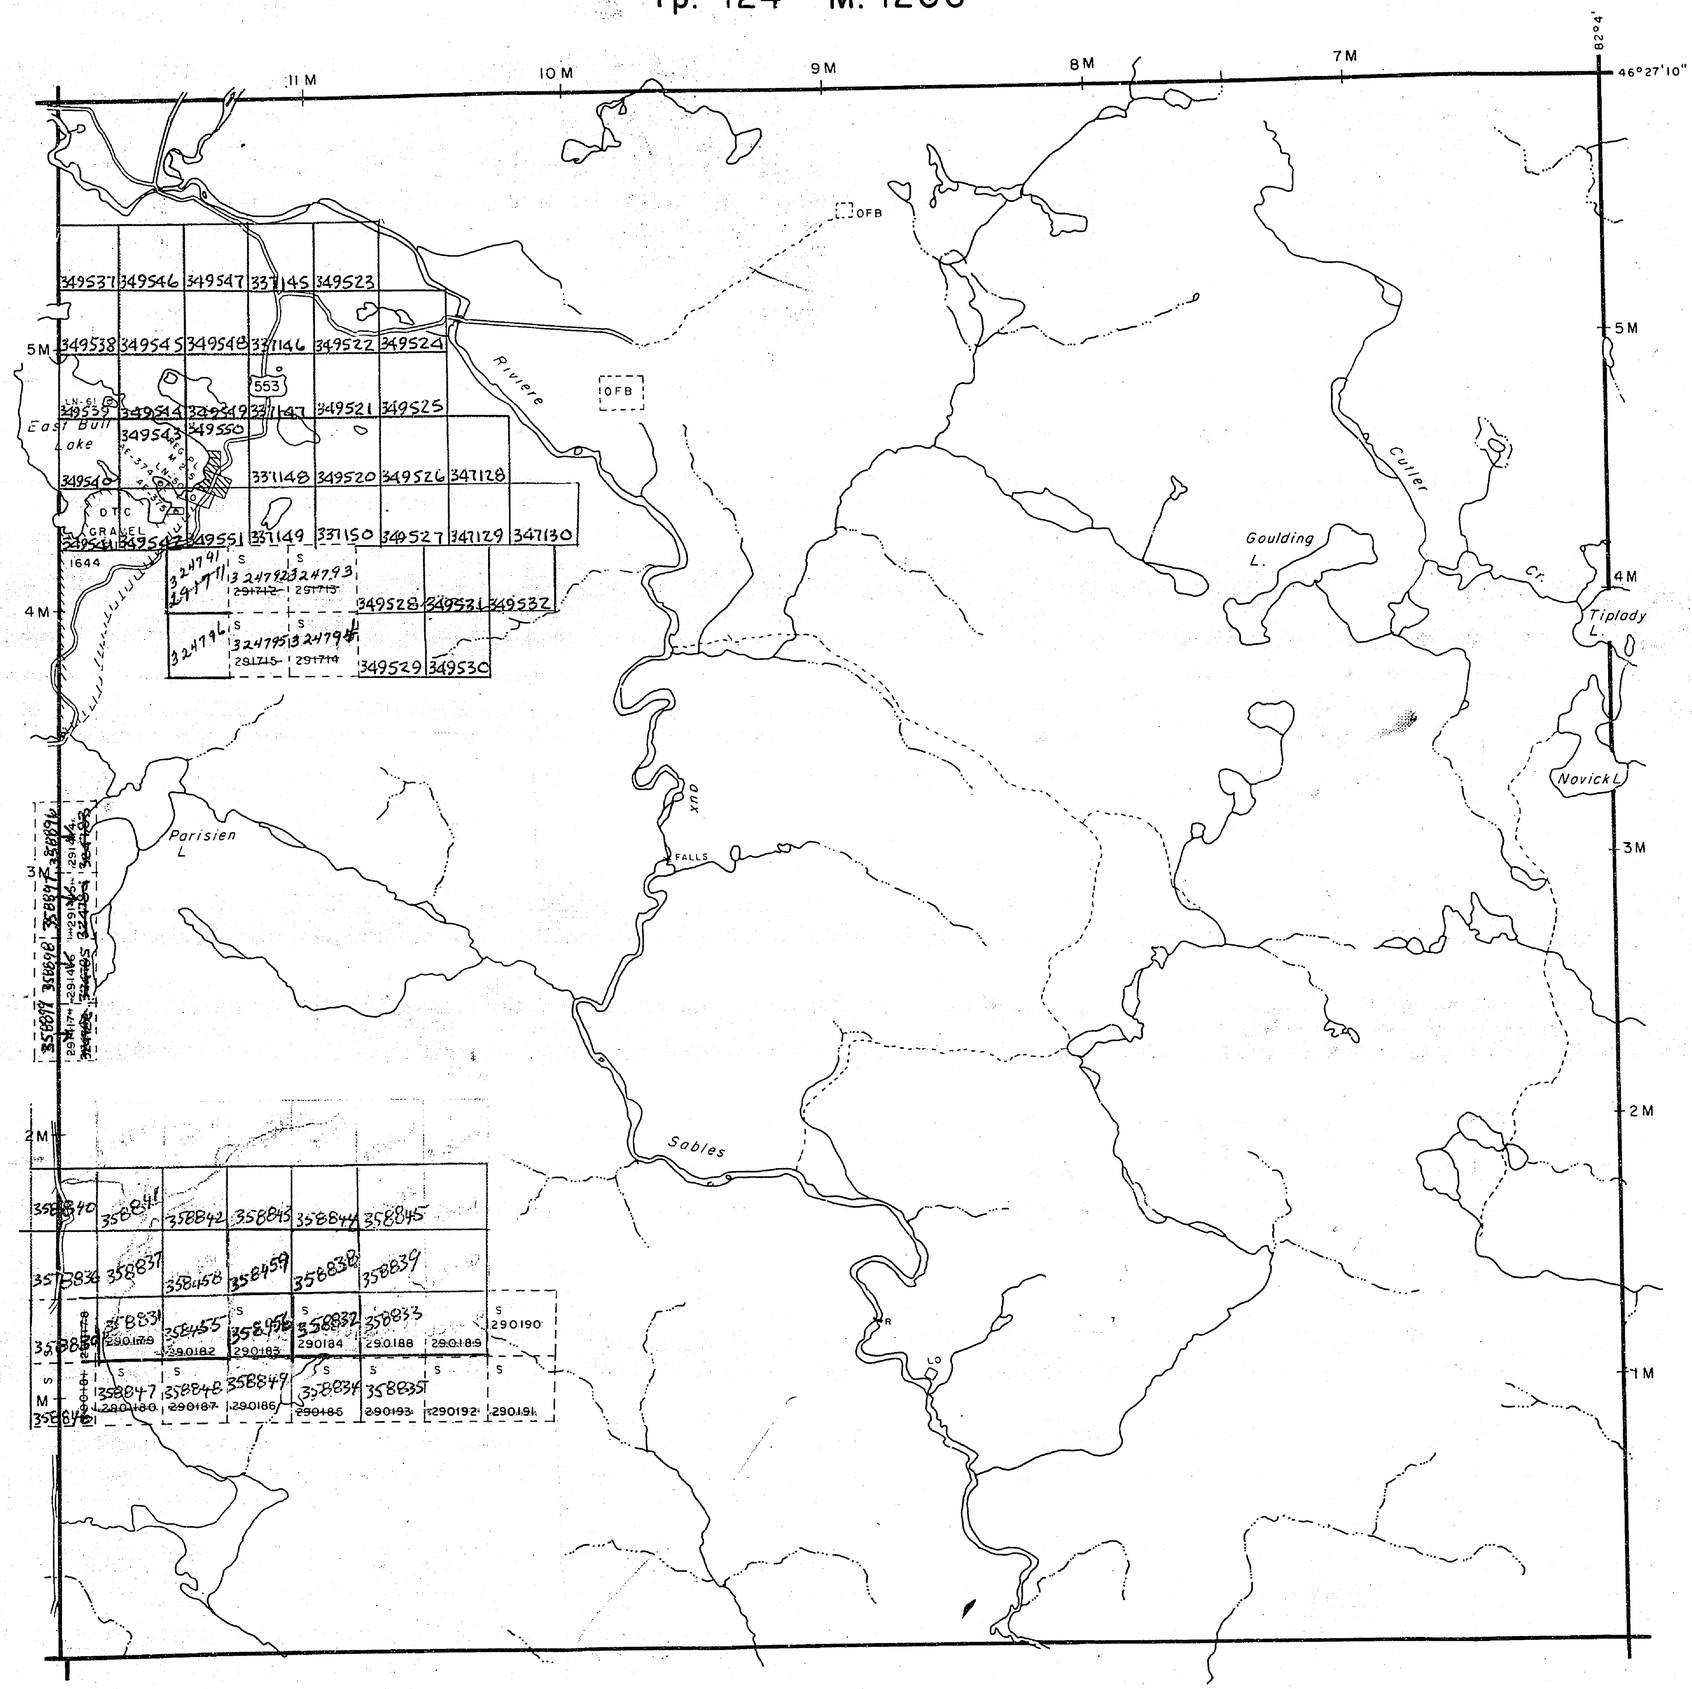


Tp. 130 M. 1209

Tp. 118 M. 1202

TENNYSON TWP. M. 1155

## NOTES

400' surface rights reservation along the shores of all lakes and rivers.

SURVEY RECEIVED JUN 5 1972 P.

7,8,9,10,11,12,13,14,15,16

A

## LEGEND

| | |
|---|---|
| PATENTED LAND | P or |
| PATENTED FOR SURFACE RIGHTS ONLY | |
| LEASE | L |
| LICENSE OF OCCUPATION | L.O. |
| CROWN LAND SALES | C.S. |
| LOCATED LAND | Loc. |
| CANCELLED | C. |
| MINING RIGHTS ONLY | M.R.O. |
| SURFACE RIGHTS ONLY | S.R.O. |
| HIGHWAY & ROUTE NO. | 17 |
| ROADS | |
| TRAILS | |
| RAILWAYS | |
| POWER LINES | |
| MARSH OR MUSKEG | |
| MINES | |

*used only with summer resort locations or when space is limited

TOWNSHIP OF

# Tp. 123

DISTRICT OF
ALGOMA

SUDBURY
MINING DIVISION

SCALE : 1 INCH = 40 CHAINS (1/2 MILE)

| | |
|---|---|
| DR. JBK | PLAN NO. M. 1205 |
| DATE 1May '72 | |

MINISTRY OF
NATURAL RESOURCES
ONTARIO


8 6 4 2 0 2 4 6 8

MANDAMIN Tp M. 1206

GEROW Tp M. 1209

SHIBANANING Tp M. 1202

TENNYSON TWP. M. 1155

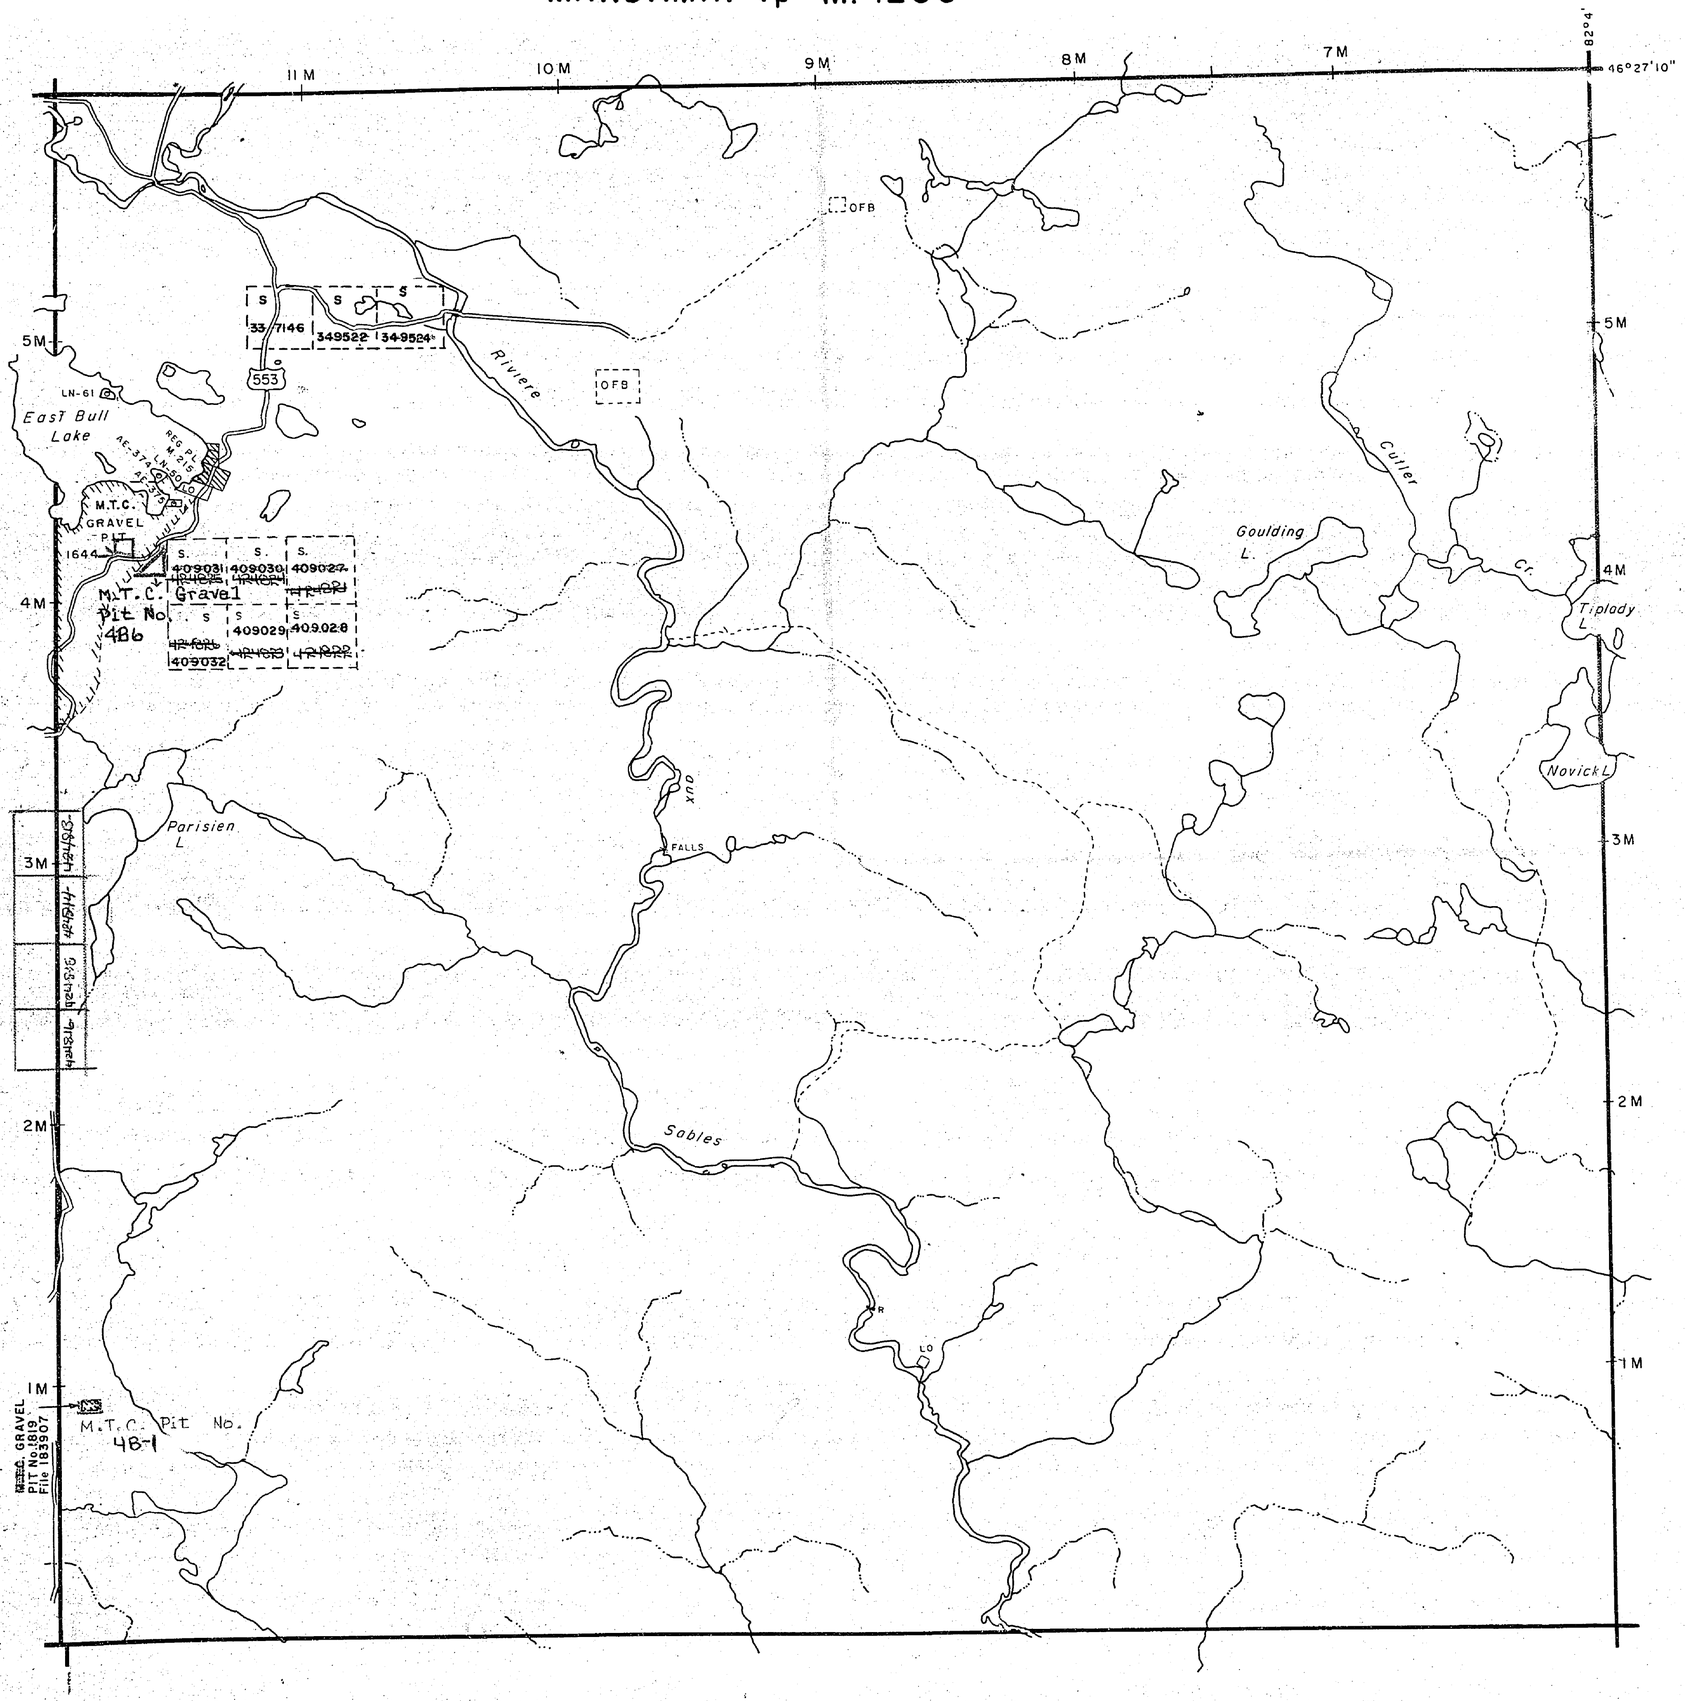


## NOTES

400' surface rights reservation along the shores of all lakes and rivers.

DATE OF ISSUE
FEB 12 1975

## LEGEND

| | |
|---|---|
| PATENTED LAND | Ⓟ or ● |
| PATENTED FOR SURFACE RIGHTS ONLY | ◒ |
| LEASE | Ⓛ |
| LICENSE OF OCCUPATION | L.O. |
| CROWN LAND SALES | C.S. |
| LOCATED LAND | Loc. |
| CANCELLED | C. |
| MINING RIGHTS ONLY | M.R.O. |
| SURFACE RIGHTS ONLY | S.R.O. |
| HIGHWAY & ROUTE NO. | 17 |
| ROADS | |
| TRAILS | |
| RAILWAYS | |
| POWER LINES | |
| MARSH OR MUSKEG | |
| MINES | |

*used only with summer resort locations or when space is limited

TOWNSHIP OF

# BOON
(Tp. 123)

DISTRICT OF

ALGOMA

SUDBURY

MINING DIVISION

SCALE : 1 INCH = 40 CHAINS (1/2 MILE)

| | |
|---|---|
| DR. JBK | PLAN NO. M. 1205 |
| DATE 1May '72 | |

ONTARIO


MINISTRY OF NATURAL RESOURCES

SURVEYS AND MAPPING BRANCH

8 6 4 2 0 2 4 6 8

OFFICE USE ONLY

# MANDAMIN Tp M. 1206

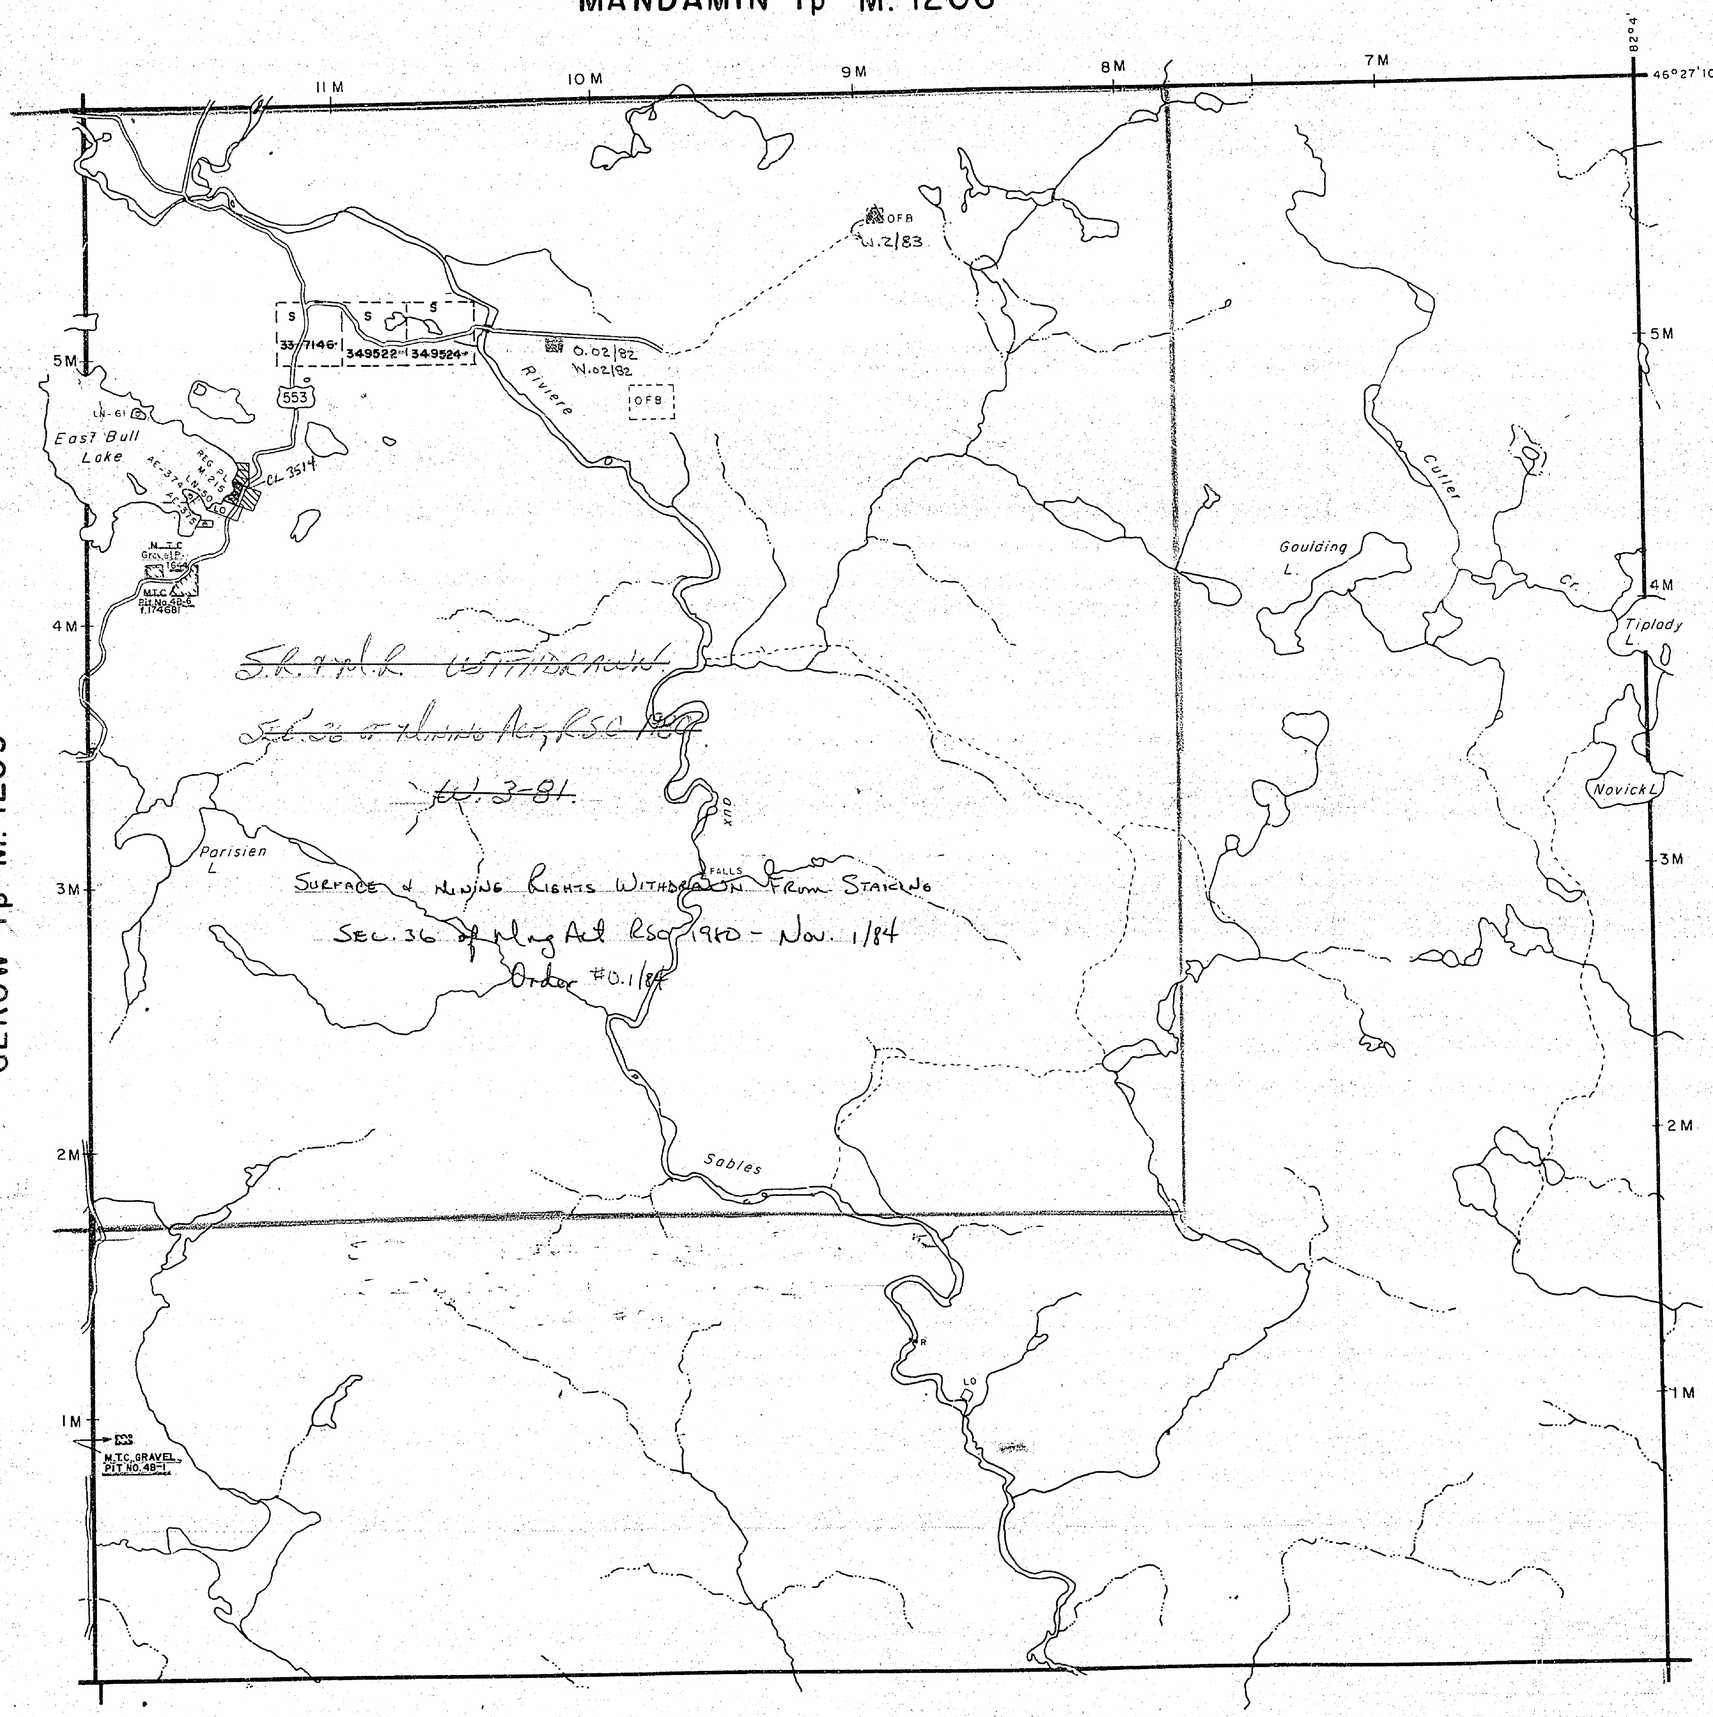


GEROW Tp M. 1209

SHIBANANING Tp M. 1202

TENNYSON TWP. M. 1155

## NOTES

400' surface rights reservation along the shores of all lakes and rivers.

Order No. 0.02/82 & W.2/82 (See Boon Twp. Land Rpt.)

Order No. W.2/83 – Expands (See Boon Twp. Land Rpt.)

DATE OF ISSUE
AUG 31 19

## LEGEND

| | |
|---|---|
| PATENTED LAND | P or * |
| PATENTED FOR SURFACE RIGHTS ONLY | * |
| LEASE | L |
| LICENSE OF OCCUPATION | L.O. |
| CROWN LAND SALES | C.S. |
| LOCATED LAND | Loc. |
| CANCELLED | C. |
| MINING RIGHTS ONLY | M.R.O. |
| SURFACE RIGHTS ONLY | S.R.O. |
| HIGHWAY & ROUTE NO. | 17 |
| ROADS | |
| TRAILS | |
| RAILWAYS | |
| POWER LINES | |
| MARSH OR MUSKEG | |
| MINES | |

*used only with summer resort locations or when space is limited

TOWNSHIP OF

# BOON
(Tp. 123)

DISTRICT OF
ALGOMA

SUDBURY
MINING DIVISION

SCALE : 1 INCH = 40 CHAINS (1/2 MILE)

DR. JBK
DATE 1May '72

PLAN NO. M. 1205

ONTARIO
MINISTRY OF NATURAL RESOURCES
SURVEYS AND MAPPING BRANCH

No. 184

## REFERENCES

### AREAS WITHDRAWN FROM DISPOSITION

M.R.O. – MINING RIGHTS ONLY
S.R.O. – SURFACE RIGHTS ONLY
M.+ S. – MINING AND SURFACE RIGHTS


| | Description | Order No. | Date | Disposition | File |
|---|---|---|---|---|---|
| R1 | SEC. 36/80 | | 7/8/81 | M.&S. | 188514 |
| R2 | SEC. 36/80 | W.2/83 | 31/3/83 | S.R.O. | 77094 |

### SAND and GRAVEL

| | | | |
|---|---|---|---|
| G1 | M.T.C. | PIT | 1644 |
| G2 | M.T.C. | PIT | 48-6 |
| G3 | M.T.C. | PIT | 48-1 |

Order No. O.16/85 NER.
Surface and Mining Rights
Re Opened See Boon Twp
Land Rote File.

# MANDAMIN TWP.

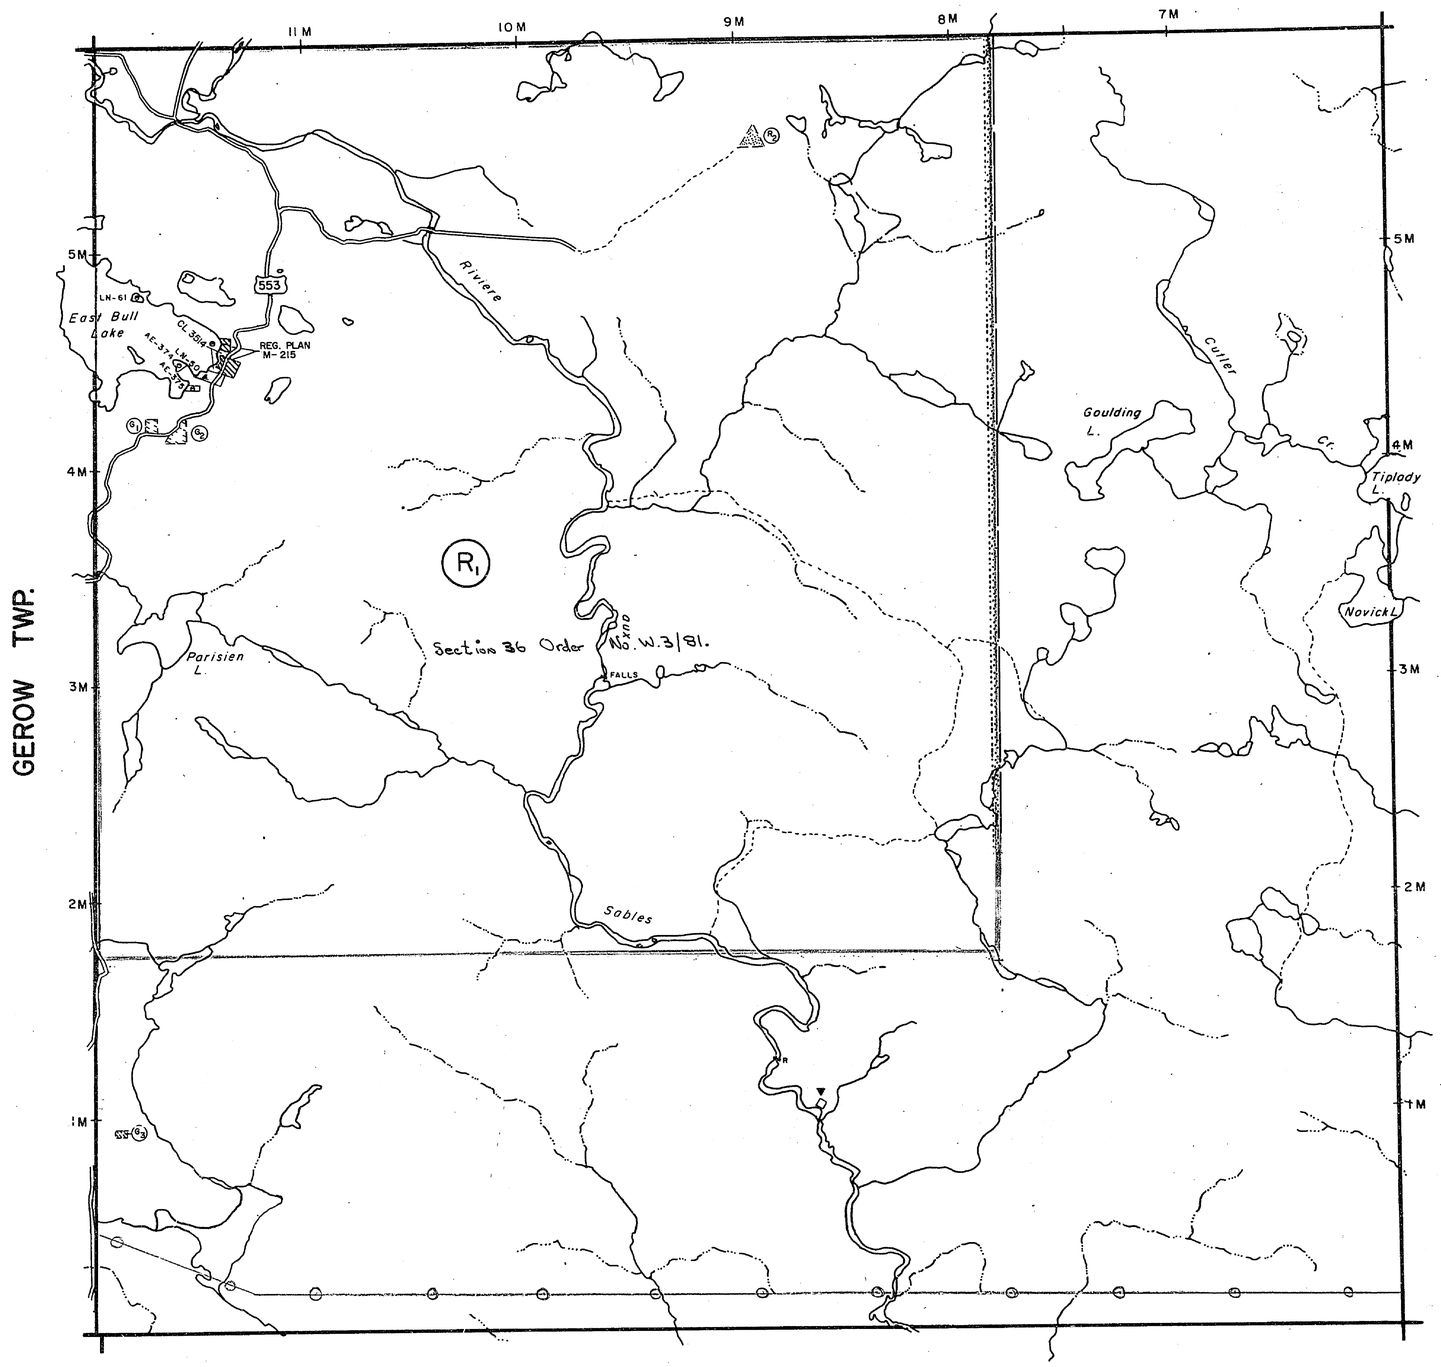


GEROW TWP.

SHIBANANING TWP.

TENNYSON TWP.

"Taken out of Use 19860123/vm"

## LEGEND

- HIGHWAY AND ROUTE No.
- OTHER ROADS
- TRAILS
- SURVEYED LINES:
  - TOWNSHIPS, BASE LINES, ETC.
  - LOTS, MINING CLAIMS, PARCELS, ETC.
- UNSURVEYED LINES:
  - LOT LINES
  - PARCEL BOUNDARY
  - MINING CLAIMS ETC.
- RAILWAY AND RIGHT OF WAY
- UTILITY LINES
- NON-PERENNIAL STREAM
- FLOODING OR FLOODING RIGHTS
- SUBDIVISION OR COMPOSITE PLAN
- RESERVATIONS
- ORIGINAL SHORELINE
- MARSH OR MUSKEG
- MINES
- TRAVERSE MONUMENT

## DISPOSITION OF CROWN LANDS

| TYPE OF DOCUMENT | SYMBOL |
|---|---|
| PATENT, SURFACE & MINING RIGHTS | |
| " , SURFACE RIGHTS ONLY | |
| " , MINING RIGHTS ONLY | |
| LEASE, SURFACE & MINING RIGHTS | |
| " , SURFACE RIGHTS ONLY | |
| " , MINING RIGHTS ONLY | |
| LICENCE OF OCCUPATION | |
| ORDER-IN-COUNCIL | OC |
| RESERVATION | R |
| CANCELLED | |
| SAND & GRAVEL | G |

NOTE: MINING RIGHTS IN PARCELS PATENTED PRIOR TO MAY 6, 1913, VESTED IN ORIGINAL PATENTEE BY THE PUBLIC LANDS ACT, R.S.O. 1970, CHAP. 380, SEC. 63, SUBSEC 1.

SCALE: 1 INCH = 40 CHAINS

FEET 0 1000 2000 4000 6000 8000
METRES 0 200 1000 (1 KM) 2000 (2 KM)

TOWNSHIP

# BOON

M.N.R. ADMINISTRATIVE DISTRICT

ESPANOLA

MINING DIVISION

SUDBURY


LAND TITLES / REGISTRY DIVISION

ALGOMA

Ontario Ministry of Natural Resources — Land Management Branch

Date OCTOBER 1984

Number G-3180

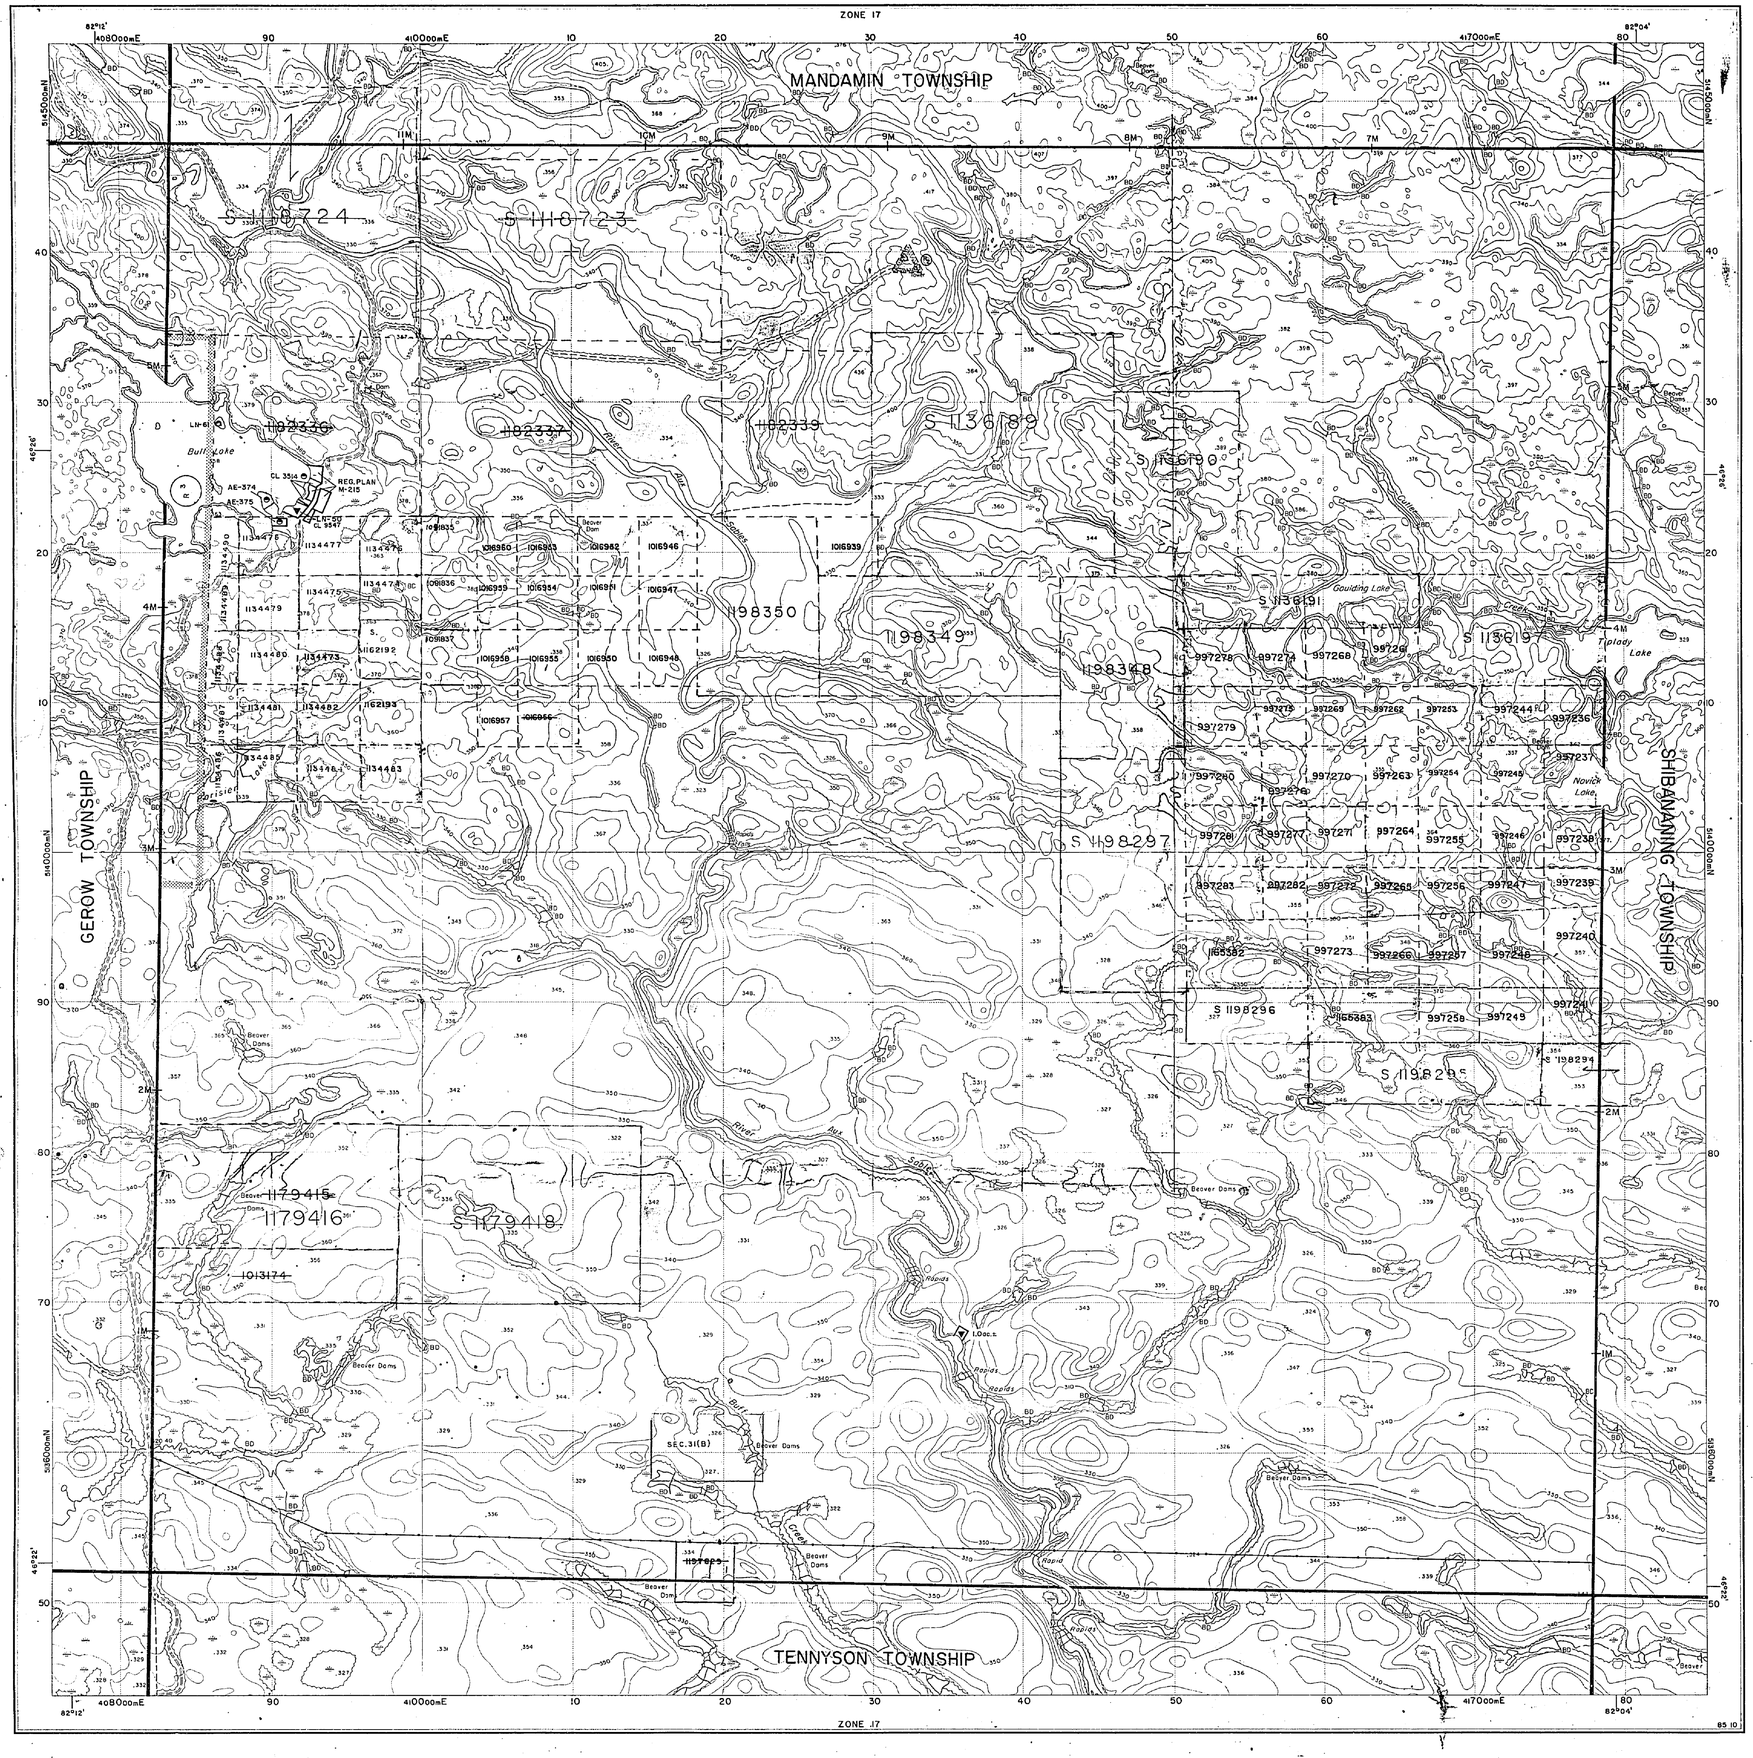


Ministry of Natural Resources

Ontario

Ministry of Northern Affairs and Mines

January 1986

# INDEX TO LAND DISPOSITION

PLAN

G-3180

TOWNSHIP

BOON

DATE OF ISSUE

SEP 04 1997

PROVINCIAL RECORDING OFFICE - SUDBURY

M.N.R. ADMINISTRATIVE DISTRICT

ESPANOLA

MINING DIVISION

SUDBURY

LAND TITLES/REGISTRY DIVISION

ALGOMA

Scale 1:20 000

1000 Metres 0 1000 2000 Metres

1000 Feet 0 1000 2000 3000 4000 5000 6000 7000 8000 9000 10000 Feet

Contour Interval 10 Metres

## SYMBOLS

- Boundary
  - Township, Meridian, Baseline
  - Road allowance; surveyed
    - shoreline
  - Lot/Concession; surveyed
    - unsurveyed
  - Parcel; surveyed
    - unsurveyed
  - Right-of-way; road
    - railway
    - utility
  - Reservation
  - Cliff, Pit, Pile
  - Contour (20)
    - Interpolated
    - Approximate
    - Depression
  - Control point (horizontal)
  - Flooded land
  - Mine head frame
  - Pipeline (above ground)
  - Railway; single track
    - double track
    - abandoned
  - Road; highway, county, township
    - access
    - trail, bush
  - Shoreline (original)
  - Transmission line
  - Wooded area

## DISPOSITION OF CROWN LANDS

- Patent
  - Surface & Mining Rights
  - Surface Rights Only
  - Mining Rights Only
- Lease
  - Surface & Mining Rights
  - Surface Rights Only
  - Mining Rights Only
- Licence of Occupation
- Order-in-Council (OC)
- Cancelled (C)
- Reservation (R)
- Sand & Gravel (S)

## AREAS WITHDRAWN FROM DISPOSITION

MRO - Mining Rights Only
SRO - Surface Rights Only
M+S - Mining and Surface Rights

| | Description | Order No. | Date | Disposition | File |
|---|---|---|---|---|---|
| W | ~~SEC.36/80~~ | ~~W.1/87~~ | ~~1/6/87~~ | ~~M & S~~ | ~~198150~~ |
| W | SEC. 36/80 | W.2/83 | 31/3/83 | S.R.O. | 77094 |
| R3 | SEC.36/80 | W96/86 | | M&S | |
| R4 | SEC.185(1) O-S-38/94 94/11/01 M & S 195150 | | | | |
| R4 | ~~SEC.185(1) W-S-50/93 93/09/02 M & S~~ | | | | ~~198150~~ |
| R5 | SEC.185(1) O-S-38/94 94/11/01 M & S 195150 | | | | |
| R5 | ~~SEC.185(1) W-S-51/93 93/09/15 M & S 195150~~ | | | | |

THE INFORMATION THAT APPEARS ON THIS MAP HAS BEEN COMPILED FROM VARIOUS SOURCES, AND ACCURACY IS NOT GUARANTEED. THOSE WISHING TO STAKE MINING CLAIMS SHOULD CONSULT WITH THE MINING RECORDER, MINISTRY OF NORTHERN DEVELOPMENT AND MINES, FOR ADDITIONAL INFORMATION ON THE STATUS OF THE LANDS SHOWN HEREON.

Map base and land disposition drafting by Surveys and Mapping Branch, Ministry of Natural Resources.

The disposition of land, location of lot fabric and parcel boundaries on this index was compiled for administrative purposes only.

G-3180-2

BOON

SWT

1205

# TOWNSHIP 125

MISSISSAGI PROVINCIAL FOREST

SUDBURY MINING DIVISION

DISTRICT OF ALGOMA

Scale—40 Chains = 1 Inch

40.0 Chains

TP. 124.

TP. 130

TP. 118

TENNYSON

200' wide reservations on surface by Dept of L. & F. shewn hereon thus

BOON TWP
M-1205

1205

SUDBURY RECEIVED FEB 7 - 1955 MINING DIVISION

# TOWNSHIP 123

MISSISSAGI PROVINCIAL FOREST

SUDBURY MINING DIVISION

DISTRICT OF ALGOMA

Scale – 40 Chains = 1 Inch

TP. 124.

TP. 130

TP. 118

BOON TWP.
M-1205

TENNYSON

400' wide reservations on surface by Dept of L & F shewn thereon thus

1205

# TOWNSHIP 125

MISSISSAGI PROVINCIAL FOREST
SUDBURY MINING DIVISION
DISTRICT OF ALGOMA

Scale – 40 Chains = 1 Inch

TP. 124.

North Ast.

400' res.

M. P. F.

Gravel Exc.

TP 130

TP 118

River

Sables

Road

BULL LAKE

Sables

Road

Sables

D

LOP

11M.

10M.

9M.

8M.

7M.

6M.

5M.

4M.

3M.

2M.

1M.

WEST

AST.

NORTH

80.00

VI

12 11 10 9 8 7 6 5 4 3 2 1

TENNYSON

400' wide reservations on surface by Dept of L & F shewn hereon thus .....

Sand & Gravel on all unpatented mining claims in this Township reserved to the Crown.

BOON TWP.
M-1205

1205

# TOWNSHIP 123

MISSISSAGI PROVINCIAL FOREST

SUDBURY MINING DIVISION


DISTRICT OF ALGOMA

Scale – 40 Chains = 1 Inch

TP. 124.

TP. 130.

TP. 118.

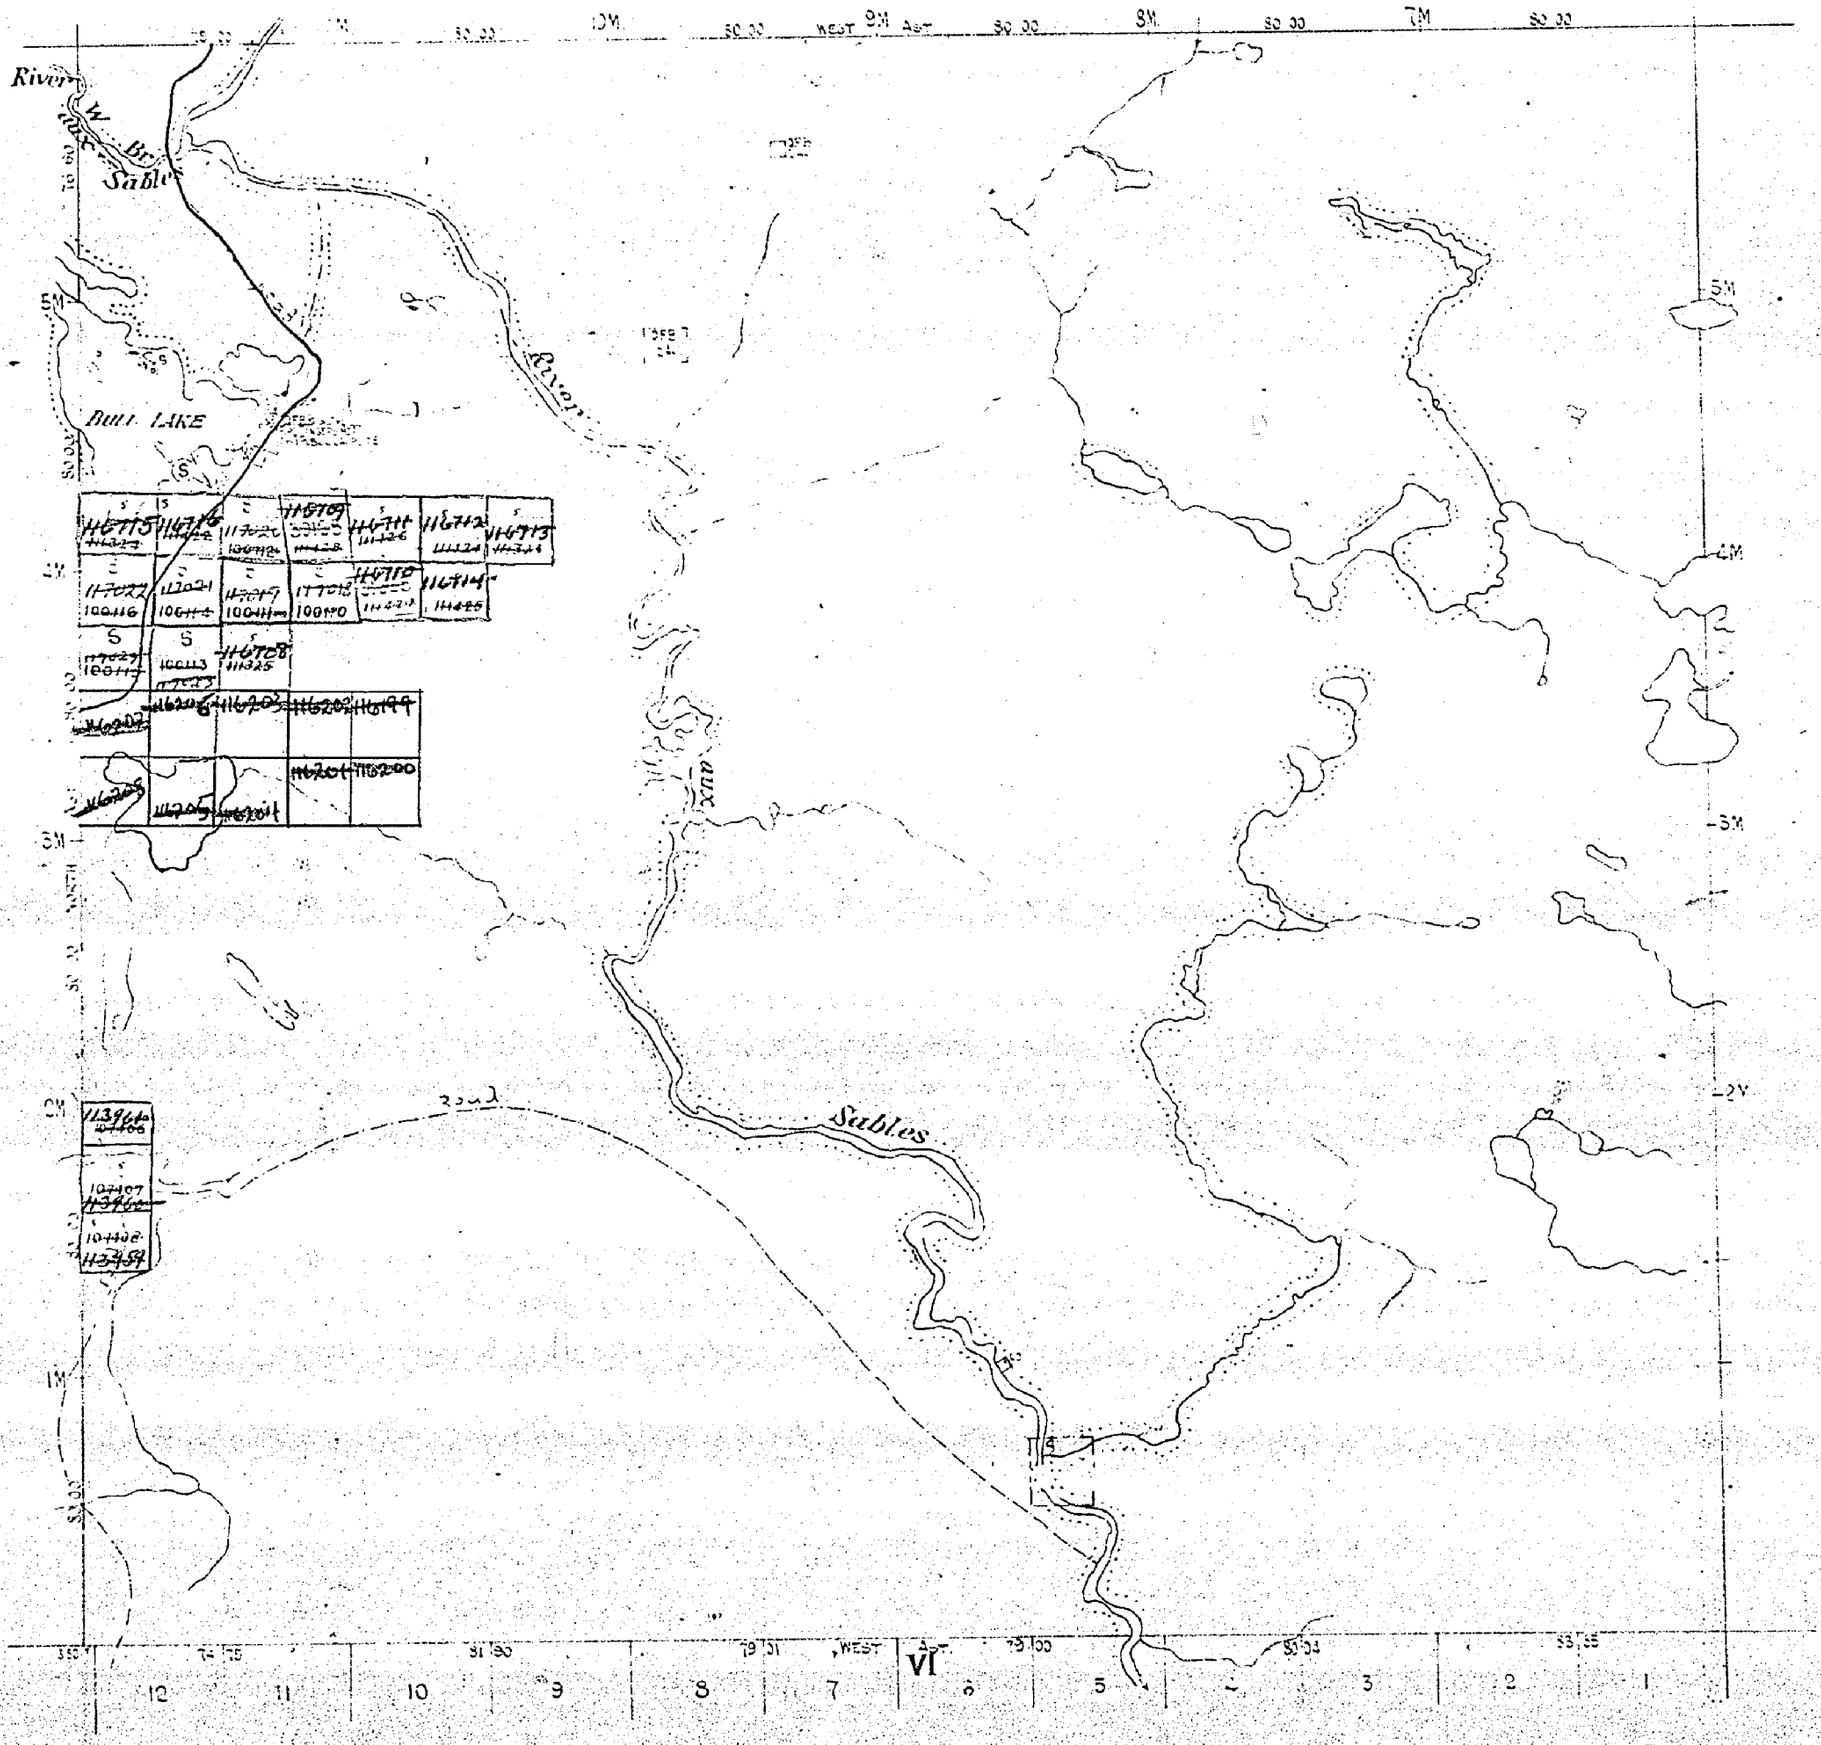


TENNYSON

400' wide reservations on surface by Dept of L.& F. shewn hereon thus .....

Sand & Gravel on all unpatented mining claims in this Township reserved to the Crown.

BOON TWP.
M-1205

1205

# TOWNSHIP 123

MISSISSAGI RIVER DIVISION

SUDBURY MINING DIVISION

DISTRICT OF ALGOMA

Scale – 40 Chains = 1 Inch

TP. 124.

TP. 130

TP. 118

Boon Twp
M-1205

TENNYSON

400' wide reservations on surface by Dept of L & F shewn hereon thus.

Sand & Gravel on all unpatented mining claims in this Township reserved to the Crown.

1205

# TOWNSHIP 125

MISSISSAGA PROVINCIAL FOREST

SUDBURY MINING DIVISION

DISTRICT OF ALGOMA

Scale – 40 Chains = 1 Inch

North Ast.

TP. 124.

SUDBURY MINING DIV.
RECEIVED
JUL 23 1970
A.M. 7 8 9 10 11 12 1 2 3 4 5 6 P.M.

11M 30.00 10M 80.00 WEST 9M. AST 80.00 8M 80.00 7M 80.00

River

W. Br. Sables

Sables River

Sauble

Sables

BULL LAKE

M 215

RE. 134

D.T.C. 1644

5M 4M 3M 2M 1M

80.00 80.00 80.00

TP. 130

TP. 118

350 74 75 80 81 79 01 WEST AST. 79 00 80 00

12 11 10 9 8 7 VI 6 5 4 3 2 1

TENNYSON


400' wide reservations on surface by Dept of Lands shown hereon thus

Sand & Gravel on all unpatented mining claims in this Township reserved to the Crown.

BOON TWP.
M-1205

1205

Tp. 124 M. 1206

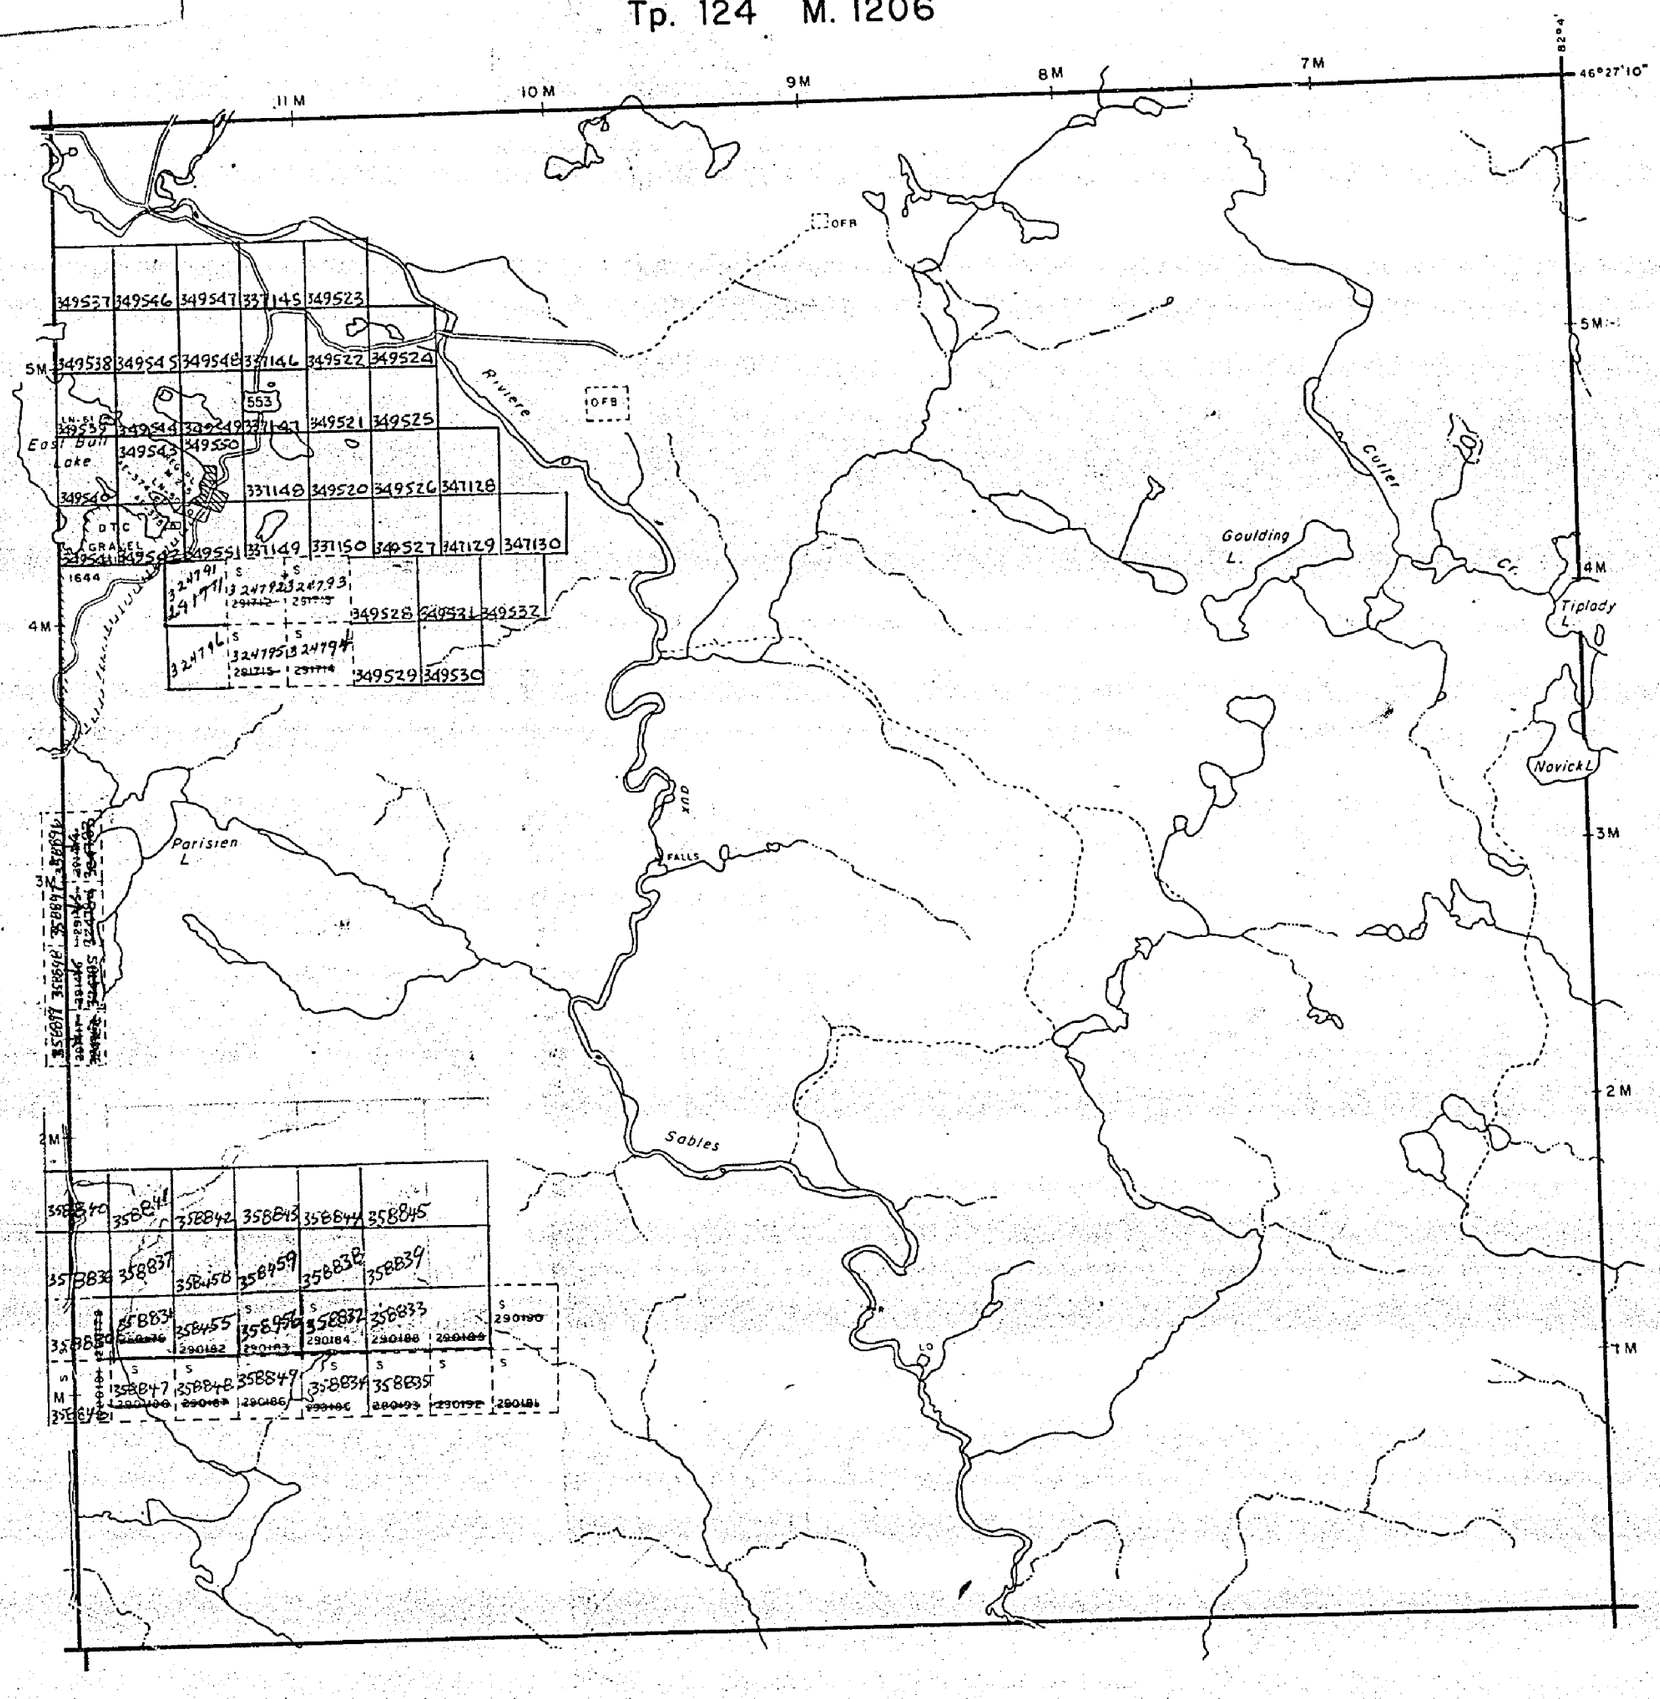


M. 1209

Tp. 130

Tp. 118 M. 1202

TENNYSON TWP. M. 1155

## NOTES

400' surface rights reservation along the shores of all lakes and rivers.

RECEIVED
JUN 5 1972

## LEGEND

| | |
|---|---|
| PATENTED LAND | Ⓟ or ● |
| PATENTED FOR SURFACE RIGHTS ONLY | ◔* |
| LEASE | Ⓛ |
| LICENSE OF OCCUPATION | L.O. |
| CROWN LAND SALES | C.S. |
| LOCATED LAND | Loc. |
| CANCELLED | C. |
| MINING RIGHTS ONLY | M.R.O. |
| SURFACE RIGHTS ONLY | S.R.O. |
| HIGHWAY & ROUTE NO. | (17) |
| ROADS | |
| TRAILS | |
| RAILWAYS | |
| POWER LINES | |
| MARSH OR MUSKEG | |
| MINES | |

*used only with summer resort locations or when space is limited

TOWNSHIP OF

# Tp. 123

DISTRICT OF

ALGOMA

SUDBURY

MINING DIVISION

SCALE : 1 INCH = 40 CHAINS (1/2 MILE)

DR. JBK


DATE 1May '72

PLAN NO. M. 1205

MINISTRY OF
NATURAL RESOURCES
ONTARIO

# 1205

Tp. 124 M. 1206

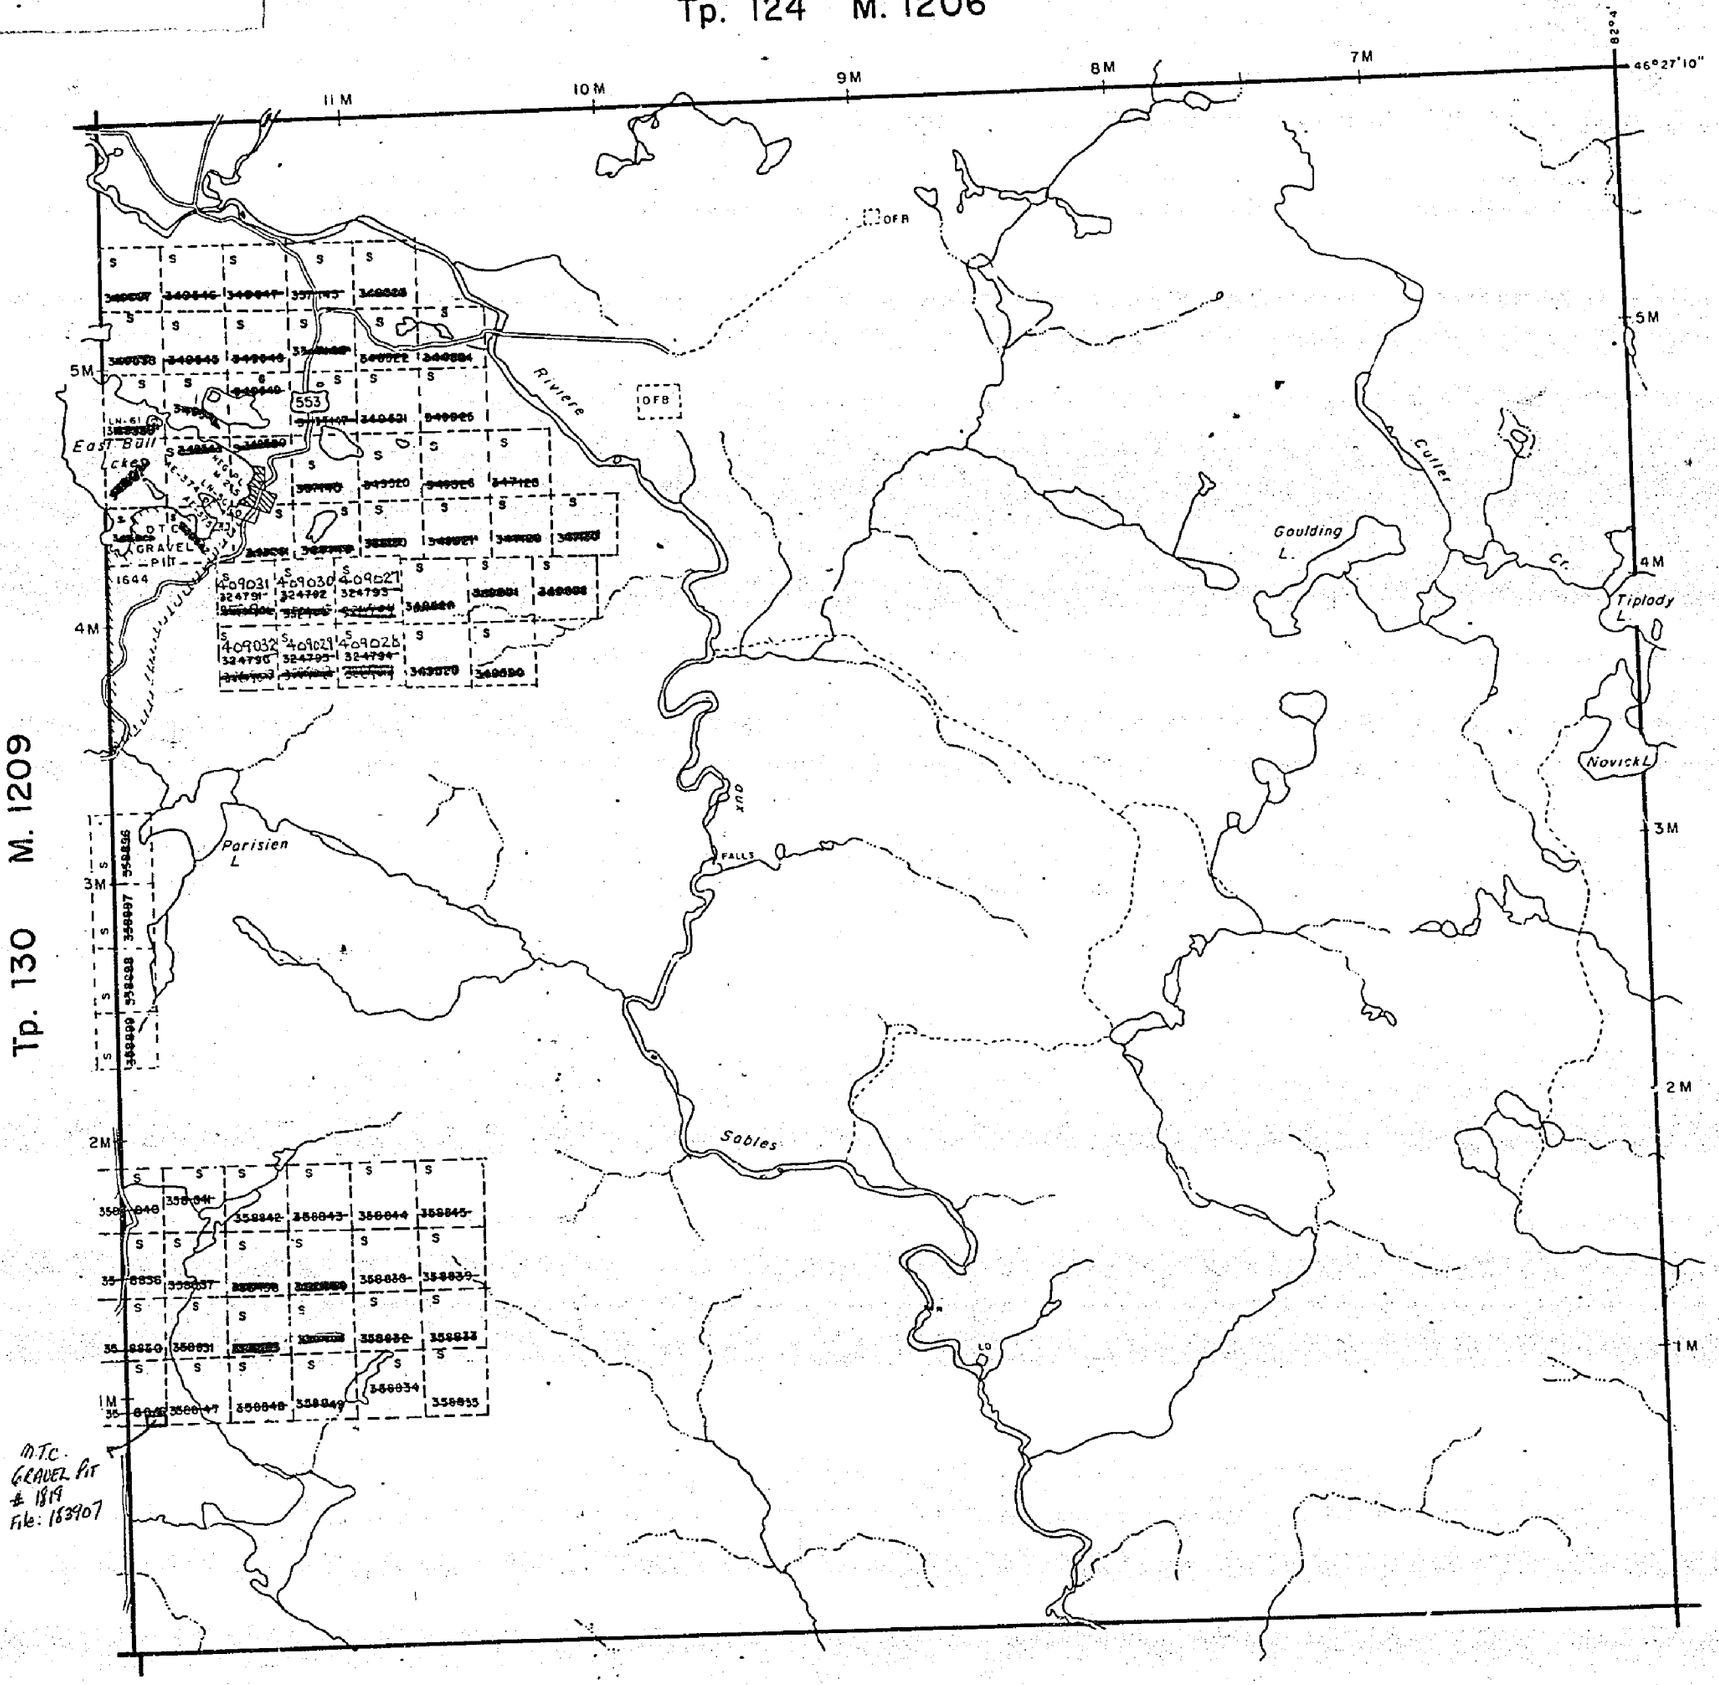


Tp. 130 M. 1209

Tp. 118 M. 1202

TENNYSON TWP. M. 1155

BOON

## NOTES

400' surface rights reservation along the shores of all lakes and rivers.

SUDBURY MINING DIV.
RECEIVED
JUL 9 1973
A.M. 7 8 9 10 11 12 1 2 3 4 5 6 P.M.

## LEGEND

| | |
|---|---|
| PATENTED LAND | Ⓟ or ● |
| PATENTED FOR SURFACE RIGHTS ONLY | ◒* |
| LEASE | Ⓛ |
| LICENSE OF OCCUPATION | L.O. |
| CROWN LAND SALES | C.S. |
| LOCATED LAND | Loc. |
| CANCELLED | C. |
| MINING RIGHTS ONLY | M.R.O. |
| SURFACE RIGHTS ONLY | S.R.O. |
| HIGHWAY & ROUTE NO. | (17) |
| ROADS | |
| TRAILS | |
| RAILWAYS | |
| POWER LINES | |
| MARSH OR MUSKEG | |
| MINES | |

*used only with summer resort locations or when space is limited

TOWNSHIP OF
formerly Tp. 123

DISTRICT OF
ALGOMA

SUDBURY
MINING DIVISION


SCALE : 1 INCH -- 40 CHAINS (1/2 MILE)

| | |
|---|---|
| DR. JBK | PLAN NO. M. 1205 |
| DATE 1 May '72 | |

ONTARIO
MINISTRY OF NATURAL RESOURCES
SURVEYS AND MAPPING BRANCH

1205

MANDAMIN Tp M. 1206

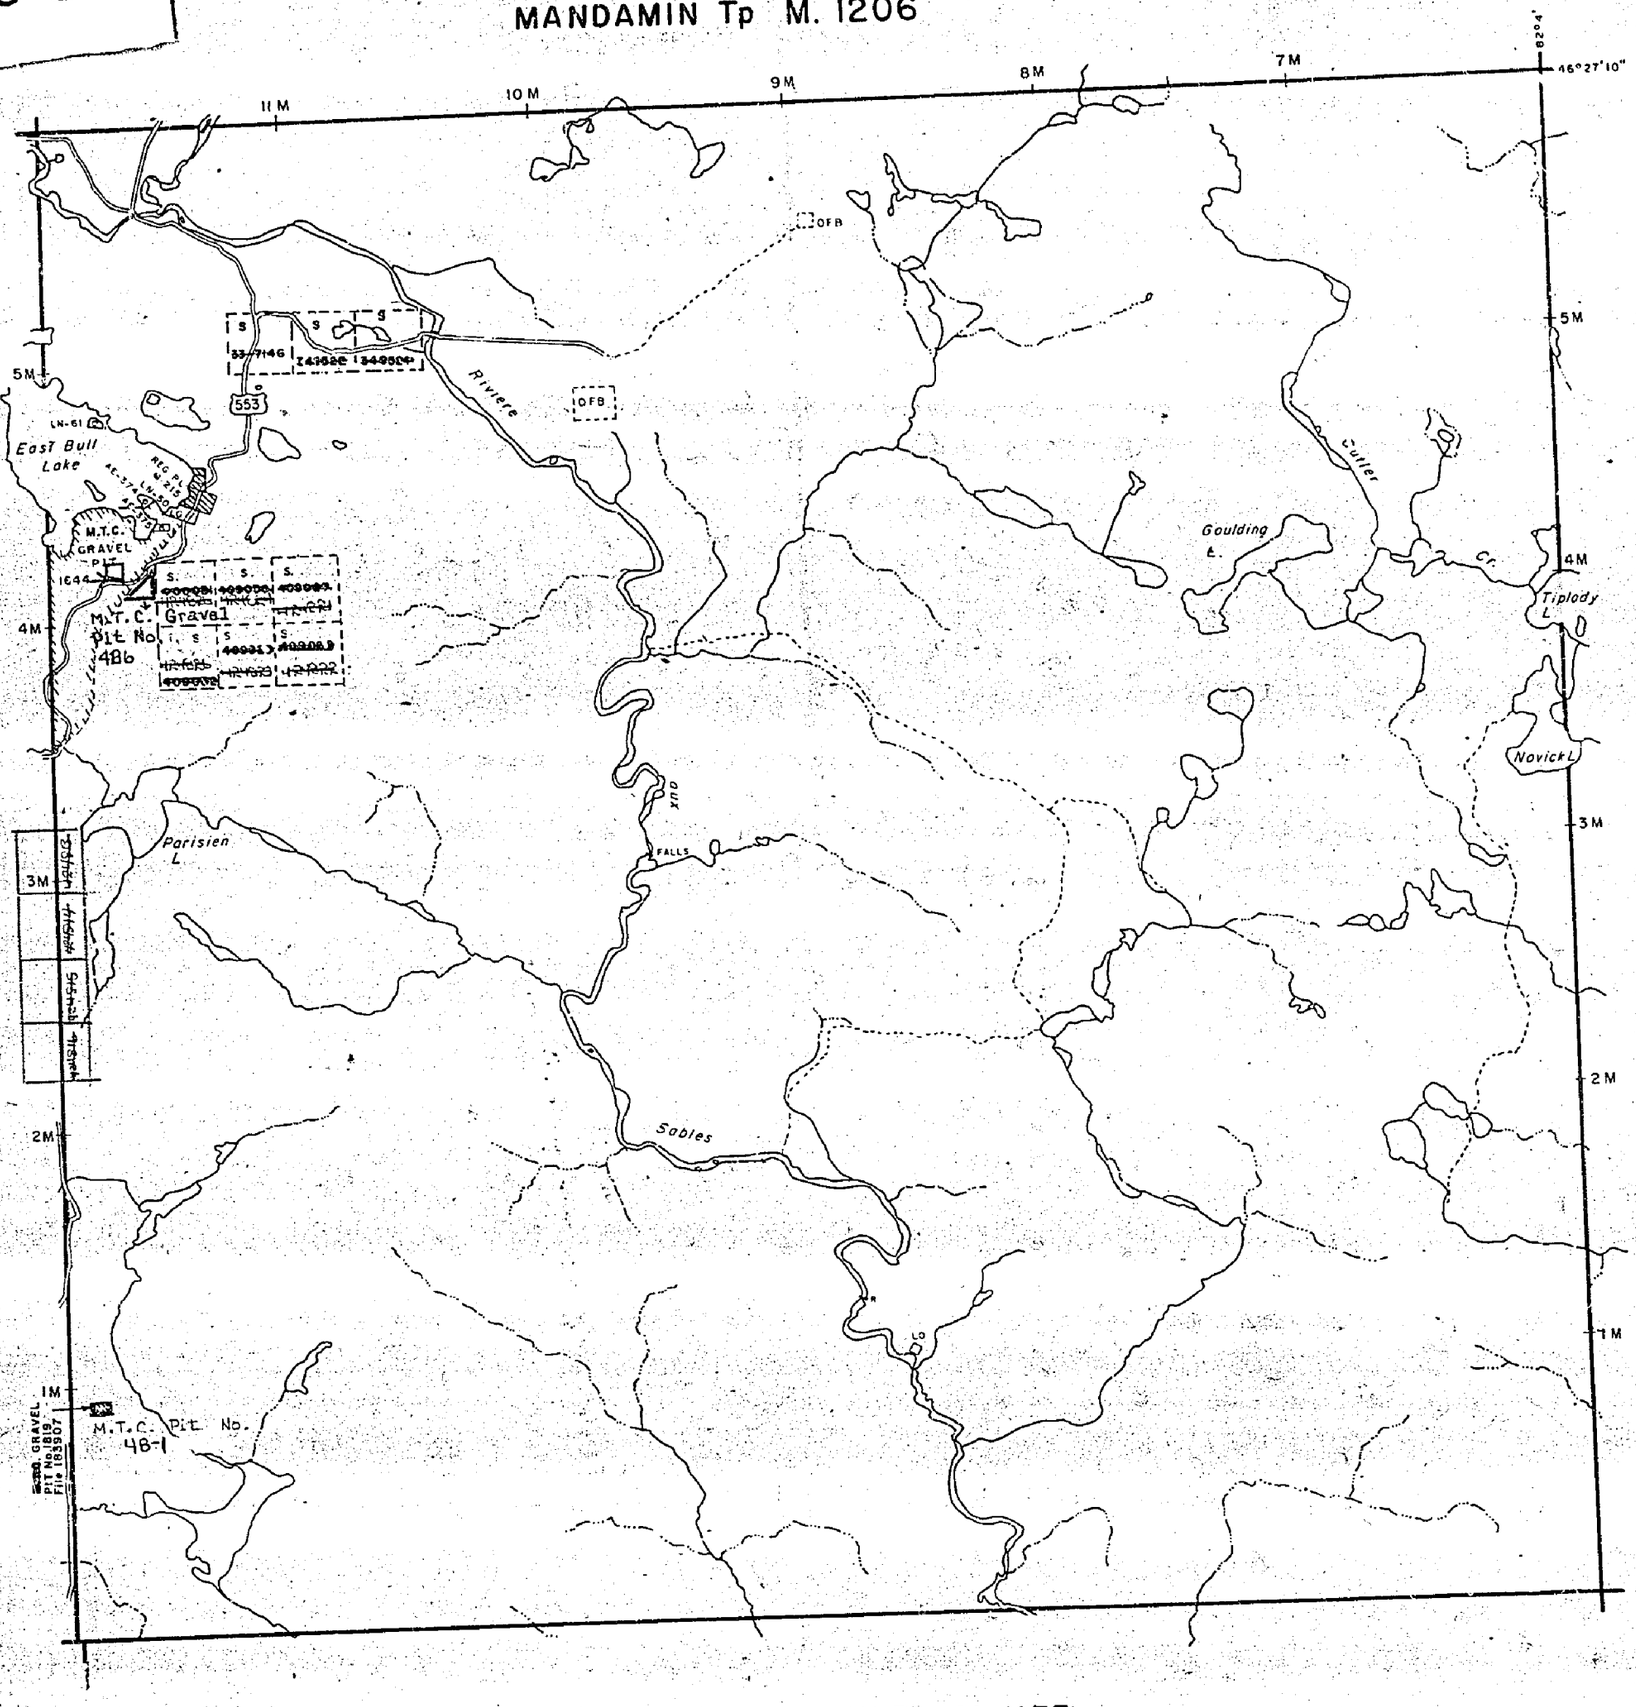


NOTES

400' surface rights reservation along the shores of all lakes and rivers.

DATE OF ISSUE
FEB 12 1975

LEGEND

| | |
|---|---|
| PATENTED LAND | Ⓟ or ● |
| PATENTED FOR SURFACE RIGHTS ONLY | ●* |
| LEASE | Ⓛ |
| LICENSE OF OCCUPATION | L.O. |
| CROWN LAND SALES | C.S. |
| LOCATED LAND | Loc. |
| CANCELLED | C. |
| MINING RIGHTS ONLY | M.R.O. |
| SURFACE RIGHTS ONLY | S.R.O. |
| HIGHWAY & ROUTE NO. | 17 |
| ROADS | |
| TRAILS | |
| RAILWAYS | |
| POWER LINES | |
| MARSH OR MUSKEG | |
| MINES | |

*used only with summer resort locations or when space is limited

TOWNSHIP OF

# BOON
(Tp. 123)

DISTRICT OF
ALGOMA

SUDBURY
MINING DIVISION

SCALE : 1 INCH = 40 CHAINS (1/2 MILE)

DR. JBK
DATE 1May '72

PLAN NO. M. 1205

ONTARIO
MINISTRY OF NATURAL RESOURCES
SURVEYS AND MAPPING BRANCH