444

Best Twp.M.417

Strathy Twp.M.596

South Lorrain Twp.M.591

Riddell Twp.M.578

Duncan

Monty L.

Pishabo Lake

Net Lake

Outlet Bay

Boot Bay

Bogie L.

Gosselin Lake

Souvé Lake

Friday Cr.

Obashkong Lake

Cassels Lake

Blueberry Lake

L.O. 6960

FILE No 119327

RW.42

RW.93

H.S. 2183

H.S. 2140

H.S. 2141

H.S. 2185

H.S. 2184

BOOMING AREA

J.C.264

PV-38

C.A.I

L"C"

L"D"

5898 74/75

5930 74-75

5M. 4M. 3M. 2M. 1M.

23M. 22M. 21M. 20M. 19M.

THE TOWNSHIP OF

CASSELS

DISTRICT OF NIPISSING

LARDER LAKE MINING DIVISION

SCALE: 1-INCH=40 CHAINS

LEGEND

PATENTED LAND	P
CROWN LAND SALE	C.S.
LEASES	L
LOCATED LAND	Loc.
LICENSE OF OCCUPATION	L.O.
MINING RIGHTS ONLY	M.R.O.
SURFACE RIGHTS ONLY	S.R.O.
ROADS	
IMPROVED ROADS	
KING'S HIGHWAYS	
RAILWAYS	
POWER LINES	
MARSH OR MUSKEG	
MINES	
CANCELLED	C.

NOTES

400' Surface rights reservation around all lakes and rivers.

LARDER LAKE MINING DIV. RECEIVED APR 2 1971 AM PM 7 8 9 10 11 12 1 2 3 4 5 6

CASSELS TWP. 444

CASSELS

PLAN NO. M-444

ONTARIO
DEPARTMENT OF MINES
AND NORTHERN AFFAIRS

444

Best Twp.M.417

Strathy Twp.M.596

South Lorrain Twp.M.591

Riddell Twp.M. 578

THE TOWNSHIP OF CASSELS

DISTRICT OF NIPISSING

SUDBURY MINING DIVISION

SCALE: 1-INCH=40 CHAINS

LEGEND

PATENTED LAND	● or Ⓟ
CROWN LAND SALE	C.S.
LEASES	Ⓛ
LOCATED LAND	Loc.
LICENSE OF OCCUPATION	L.O.
MINING RIGHTS ONLY	M.R.O.
SURFACE RIGHTS ONLY	S.R.O.
ROADS	
IMPROVED ROADS	
KING'S HIGHWAYS	
RAILWAYS	
POWER LINES	
MARSH OR MUSKEG	
MINES	
CANCELLED	C.

NOTES

400' Surface rights reservation around all lakes and rivers.

DATE OF ISSUE SEP 30 1974

CASSELS

PLAN NO.- M-444

ONTARIO

MINISTRY OF NATURAL RESOURCES

SURVEYS AND MAPPING BRANCH

OFFICE USE ONLY


Best Twp.-M.417

Strathy Twp.-M.596

Lorrain Twp.-M.591

South L

Riddell Twp.-M.578

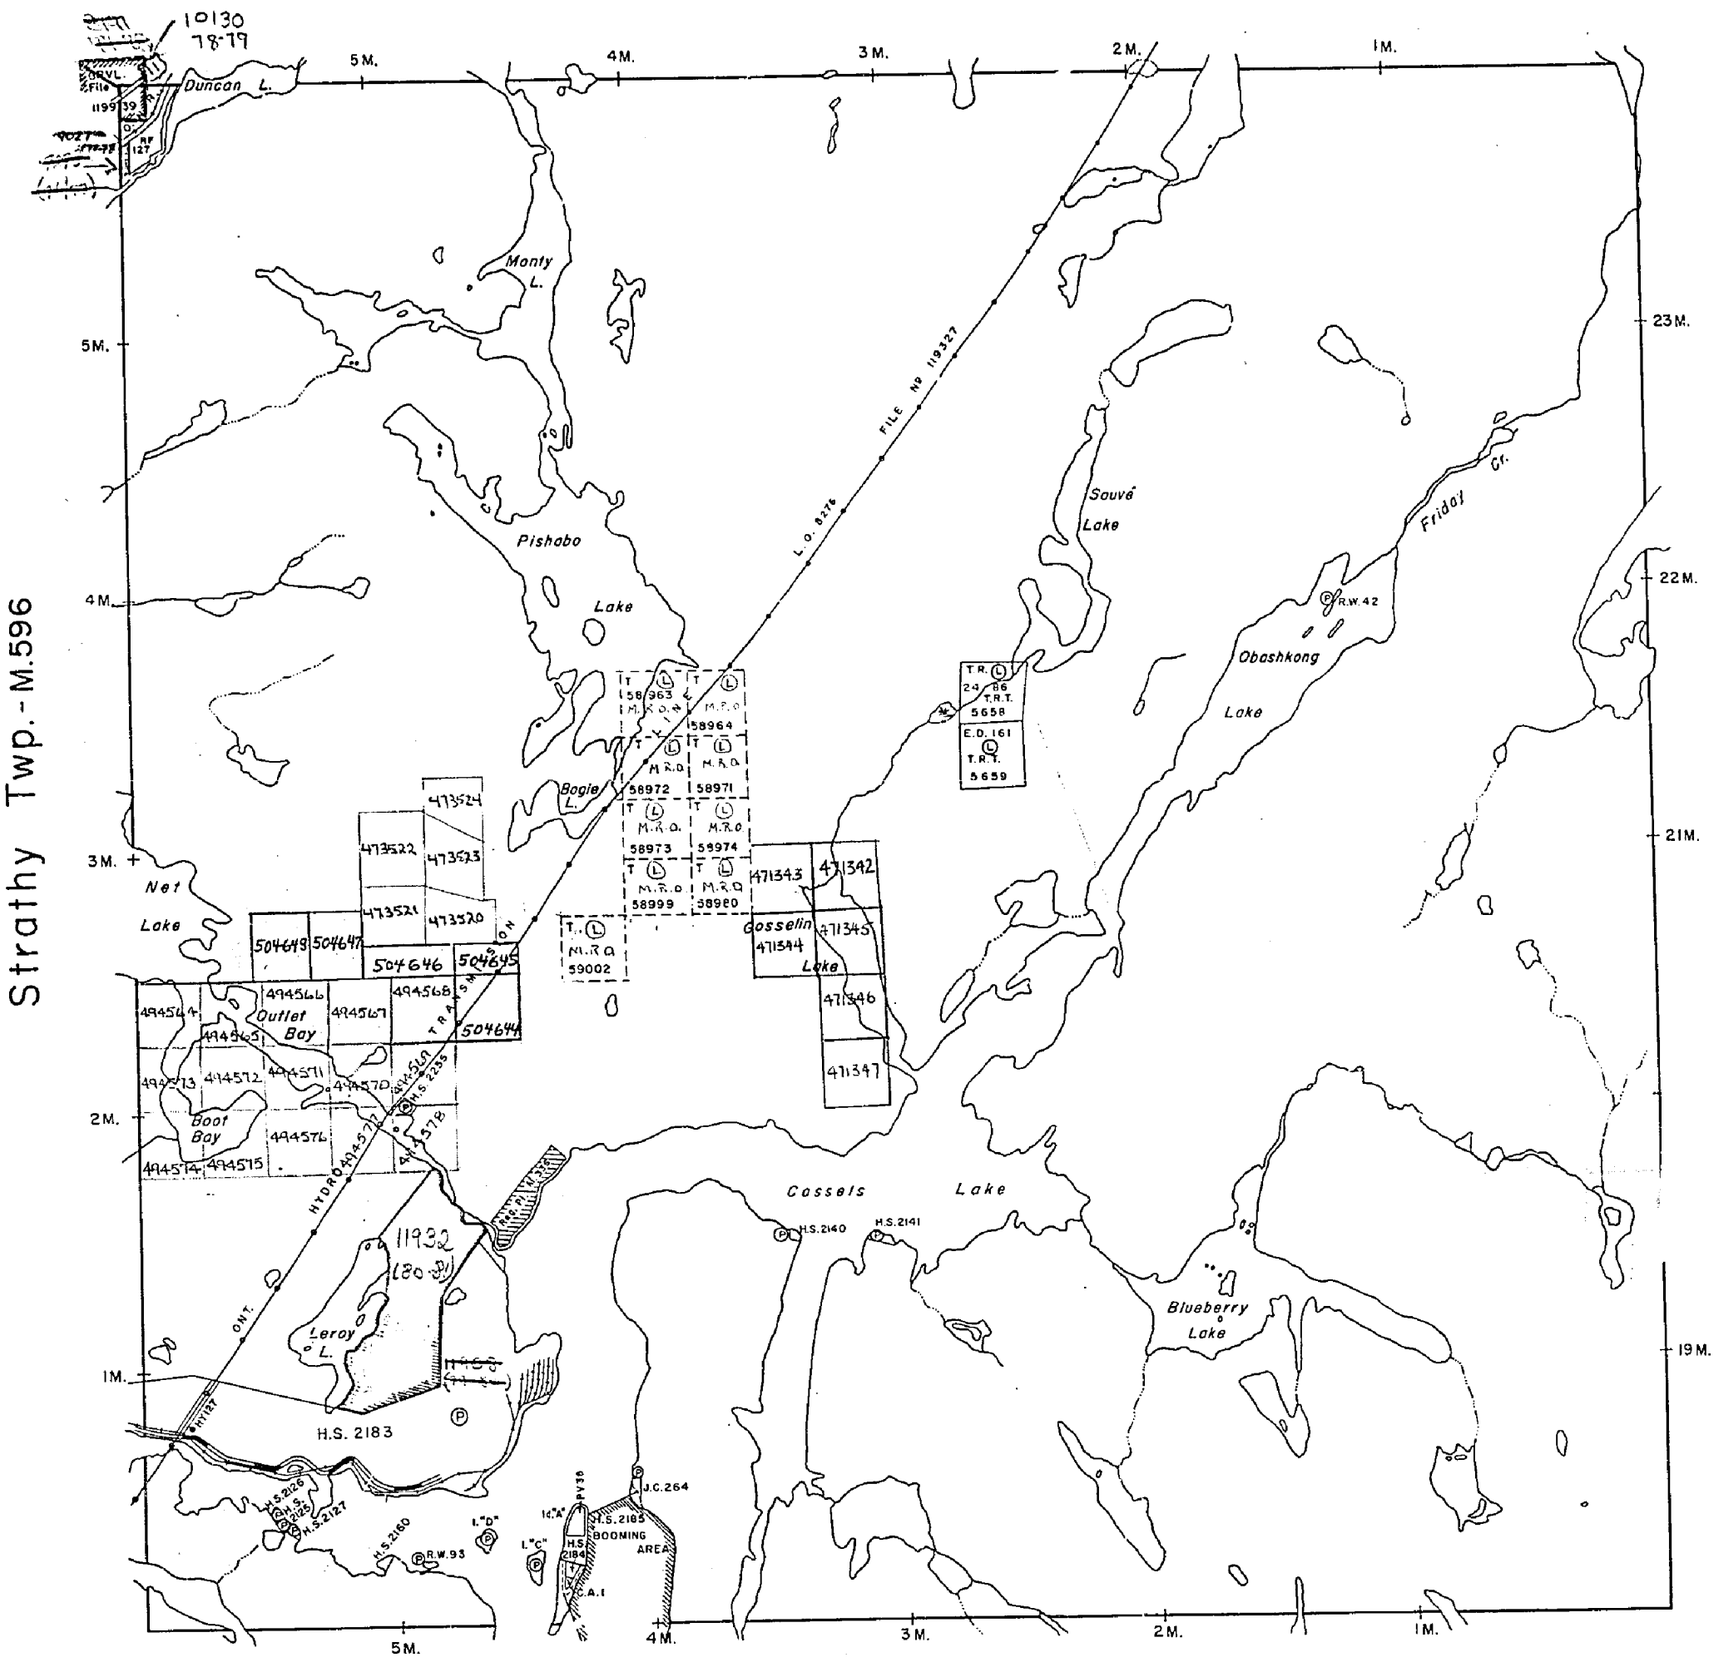

* Township closed to staking effective March 16, 1984 Section 36 of the Mining Act.

THE TOWNSHIP OF

CASSELS

DISTRICT OF NIPISSING

SUDBURY MINING DIVISION

SCALE: 1-INCH=40 CHAINS

LEGEND

PATENTED LAND	● or Ⓟ
CROWN LAND SALE	C.S.
LEASES	Ⓛ
LOCATED LAND	Loc.
LICENSE OF OCCUPATION	L.O.
MINING RIGHTS ONLY	M.R.O.
SURFACE RIGHTS ONLY	S.R.O.
ROADS	
IMPROVED ROADS	
KING'S HIGHWAYS	
RAILWAYS	
POWER LINES	
MARSH OR MUSKEG	
MINES	
CANCELLED	C.

NOTES

400' Surface rights reservation along the shores of all lakes and rivers.


TOWNSHIP CLOSED TO STAKING
EFFECTIVE MAY 8, 1978
SECTION 38(f) THE MINING ACT

DATE OF ISSUE
JAN 4 1977

CASSELS

PLAN NO.- M-444

ONTARIO
MINISTRY OF NATURAL RESOURCES
SURVEYS AND MAPPING BRANCH

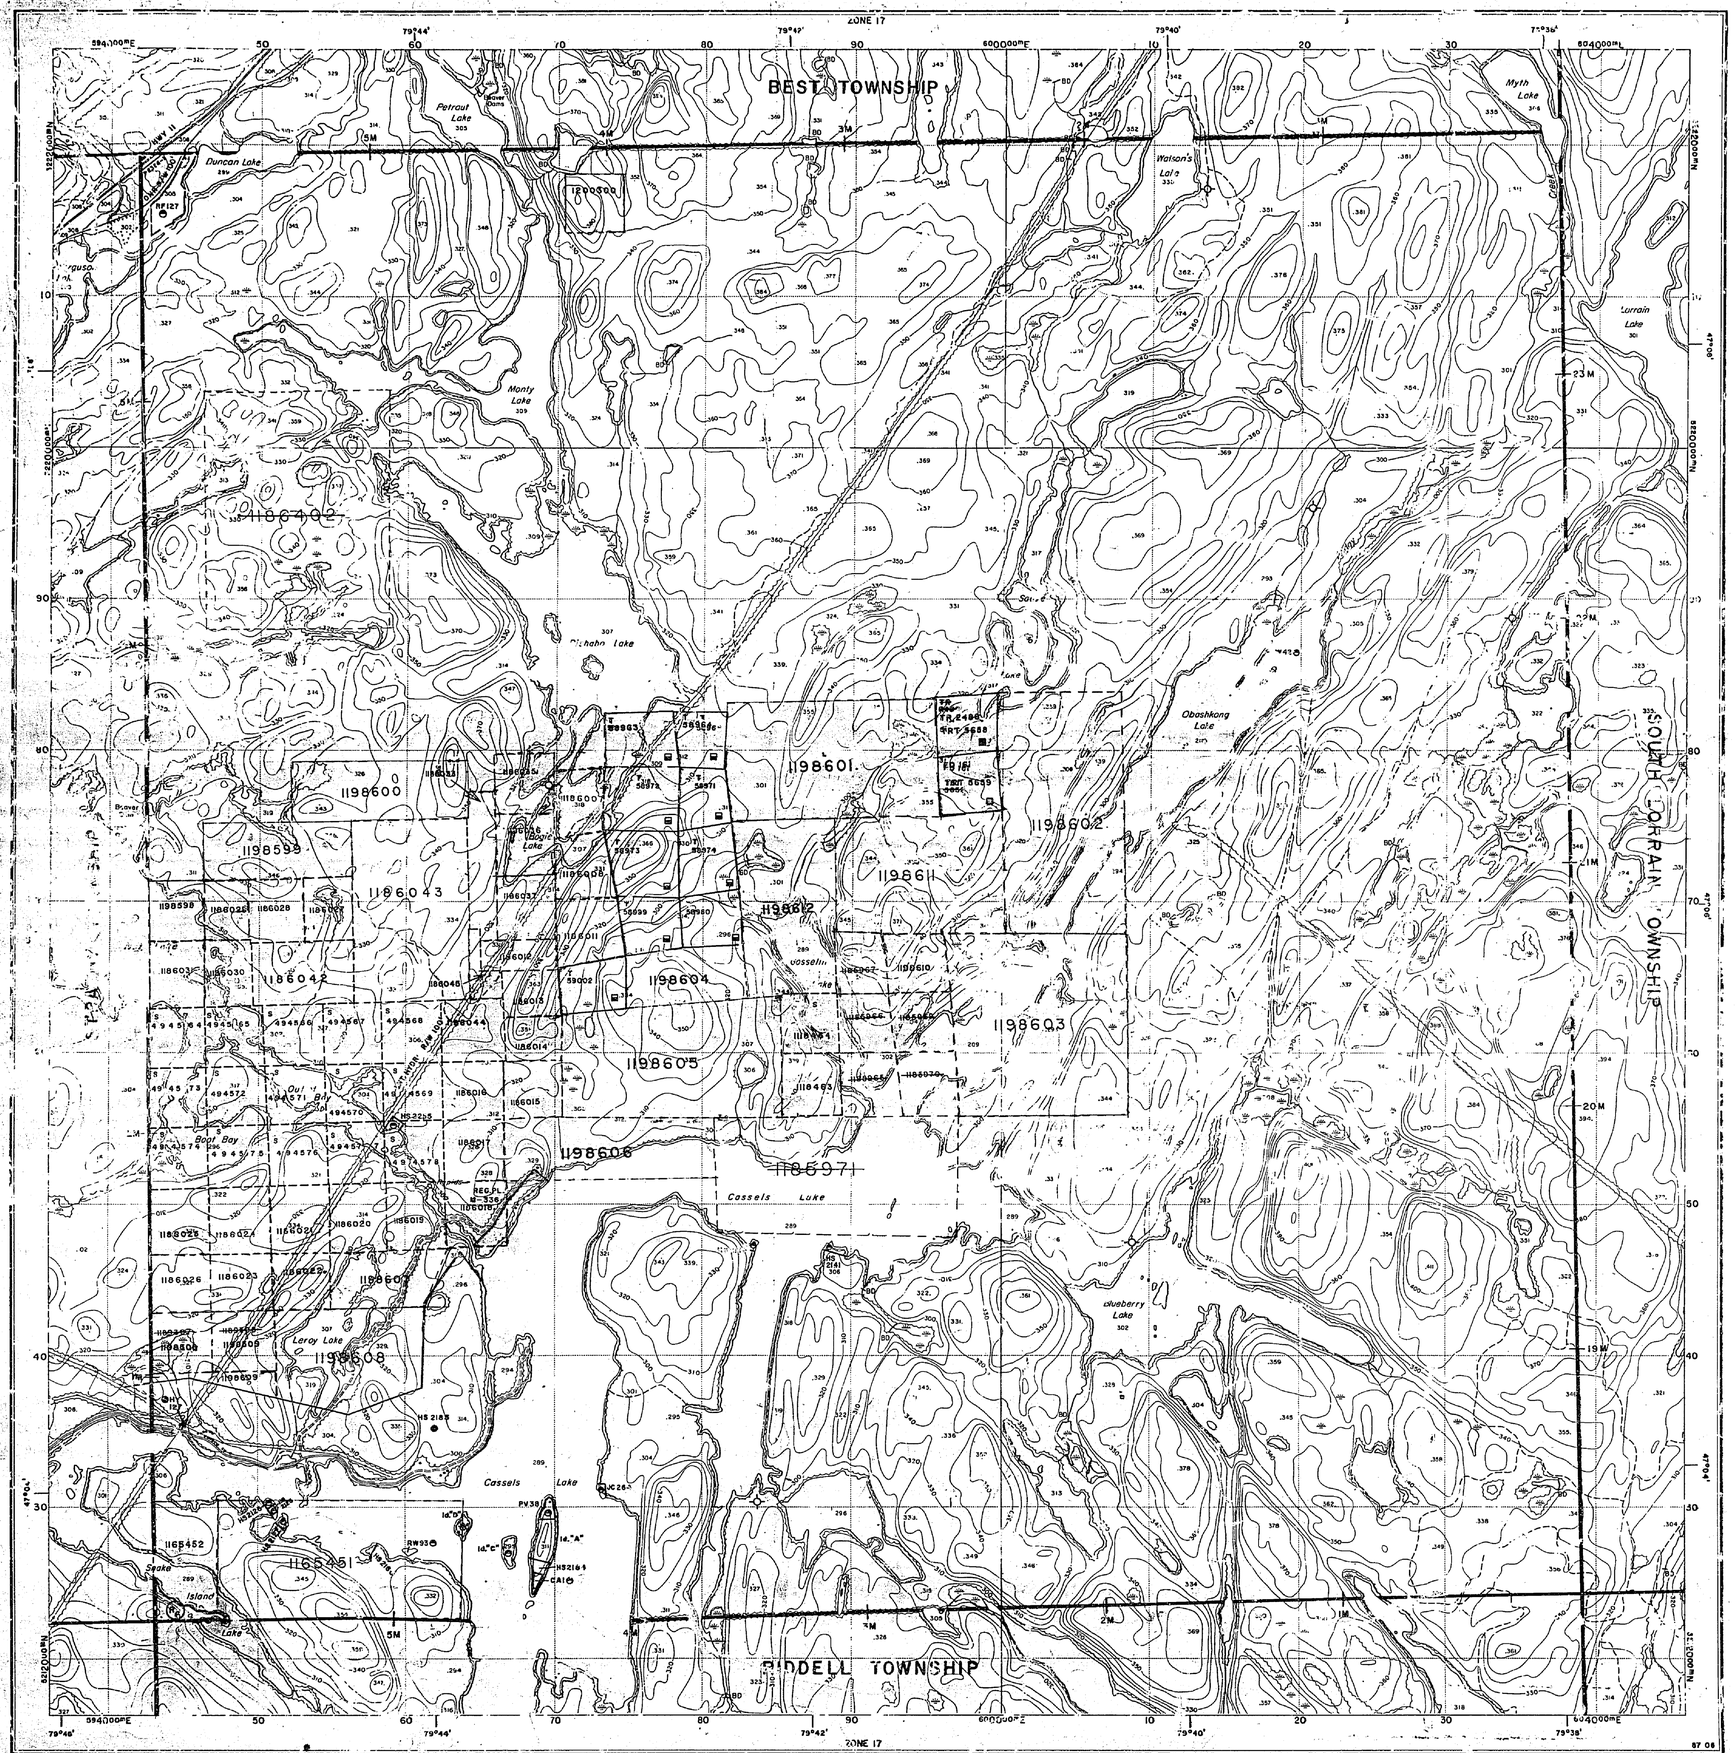

Ministry of Natural Resources
Ontario

Ministry of Northern Development and Mines

IN SERVICE FEBRUARY 10, 1989

INDEX TO LAND DISPOSITION

PLAN

G-3415

TOWNSHIP

CASSELS

DATE OF ISSUE
MAR 8 1995
SUDBURY
MINING RECORDER'S OFFICE

M.N.R. ADMINISTRATIVE DISTRICT
TEMAGAMI

MINING DIVISION
SUDBURY

LAND TITLES/REGISTRY DIVISION
NIPISSING

Scale 1:20 000

1000 Metres 0 1000 2000 Metres

1000 0 1000 2000 3000 4000 5000 6000 7000 8000 9000 10,000 Feet

Contour Interval 10 Metres

SYMBOLS

Boundary
- Township, Meridian, Baseline
- Road allowance; surveyed / shoreline
- Lot/Concession; surveyed / unsurveyed
- Parcel; surveyed / unsurveyed
- Right-of-way; road / railway / utility
- Reservation
- Cliff, Pit, Pile
- Contour (20)
- Interpolated
- Approximate
- Depression
- Control point (horizontal)
- Flooded land
- Mine shaft frame
- Pipeline (above ground)
- Railway, single track / double track / abandoned
- Road; highway, county, township / access / trail, bush
- Shoreline (original)
- Transmission line
- Wooded area

DISPOSITION OF CROWN LANDS

Patent
- Surface & Mining Rights
- Surface Rights Only
- Mining Rights Only

Lease
- Surface & Mining Rights
- Surface Rights Only
- Mining Rights Only

- Licence of Occupation
- Order-in-Council (OC)
- Cancelled
- Reservation
- Sand & Gravel
- LAND USE PERMIT

AREAS WITHDRAWN FROM DISPOSITION

MRO - Mining Rights Only
SRO - Surface Rights Only
M + S - Mining and Surface Rights

Description	Order No.	Date	Disposition	
~~Sec. 35/36~~	~~/84~~	~~15JUNE~~ 1987/92	~~M & S~~	~~1 888~~
~~(SRO)~~	~~order outdated~~	~~SEPTEMBER~~	~~M & S~~	~~195150~~
O-ONT-05/92 NER/CR	JUNE 1/92	M & S	195150	
O-ONT-07/92 NER/CR	JUNE 1/92	M & S	195150	

(PO) PENDING DISPOSITION UNDER THE PUBLIC LANDS ACT


LAND NOT OPEN FOR STAKING SUB-SECTION 30(8) of the Mining Act R.S.O. 1990

Notice received 92/JAN/06

THE INFORMATION THAT APPEARS ON THIS MAP HAS BEEN COMPILED FROM VARIOUS SOURCES, AND ACCURACY IS NOT GUARANTEED. THOSE WISHING TO STAKE MINING CLAIMS SHOULD CONSULT WITH THE MINING RECORDER, MINISTRY OF NORTHERN DEVELOPMENT AND MINES, FOR ADDITIONAL INFORMATION ON THE STATUS OF THE LANDS SHOWN HEREON.

Map base and land disposition drafting by Surveys and Mapping Branch, Ministry of Natural Resources.

The disposition of land, location of lot fabric and parcel boundaries on this index was compiled for administrative purposes only.

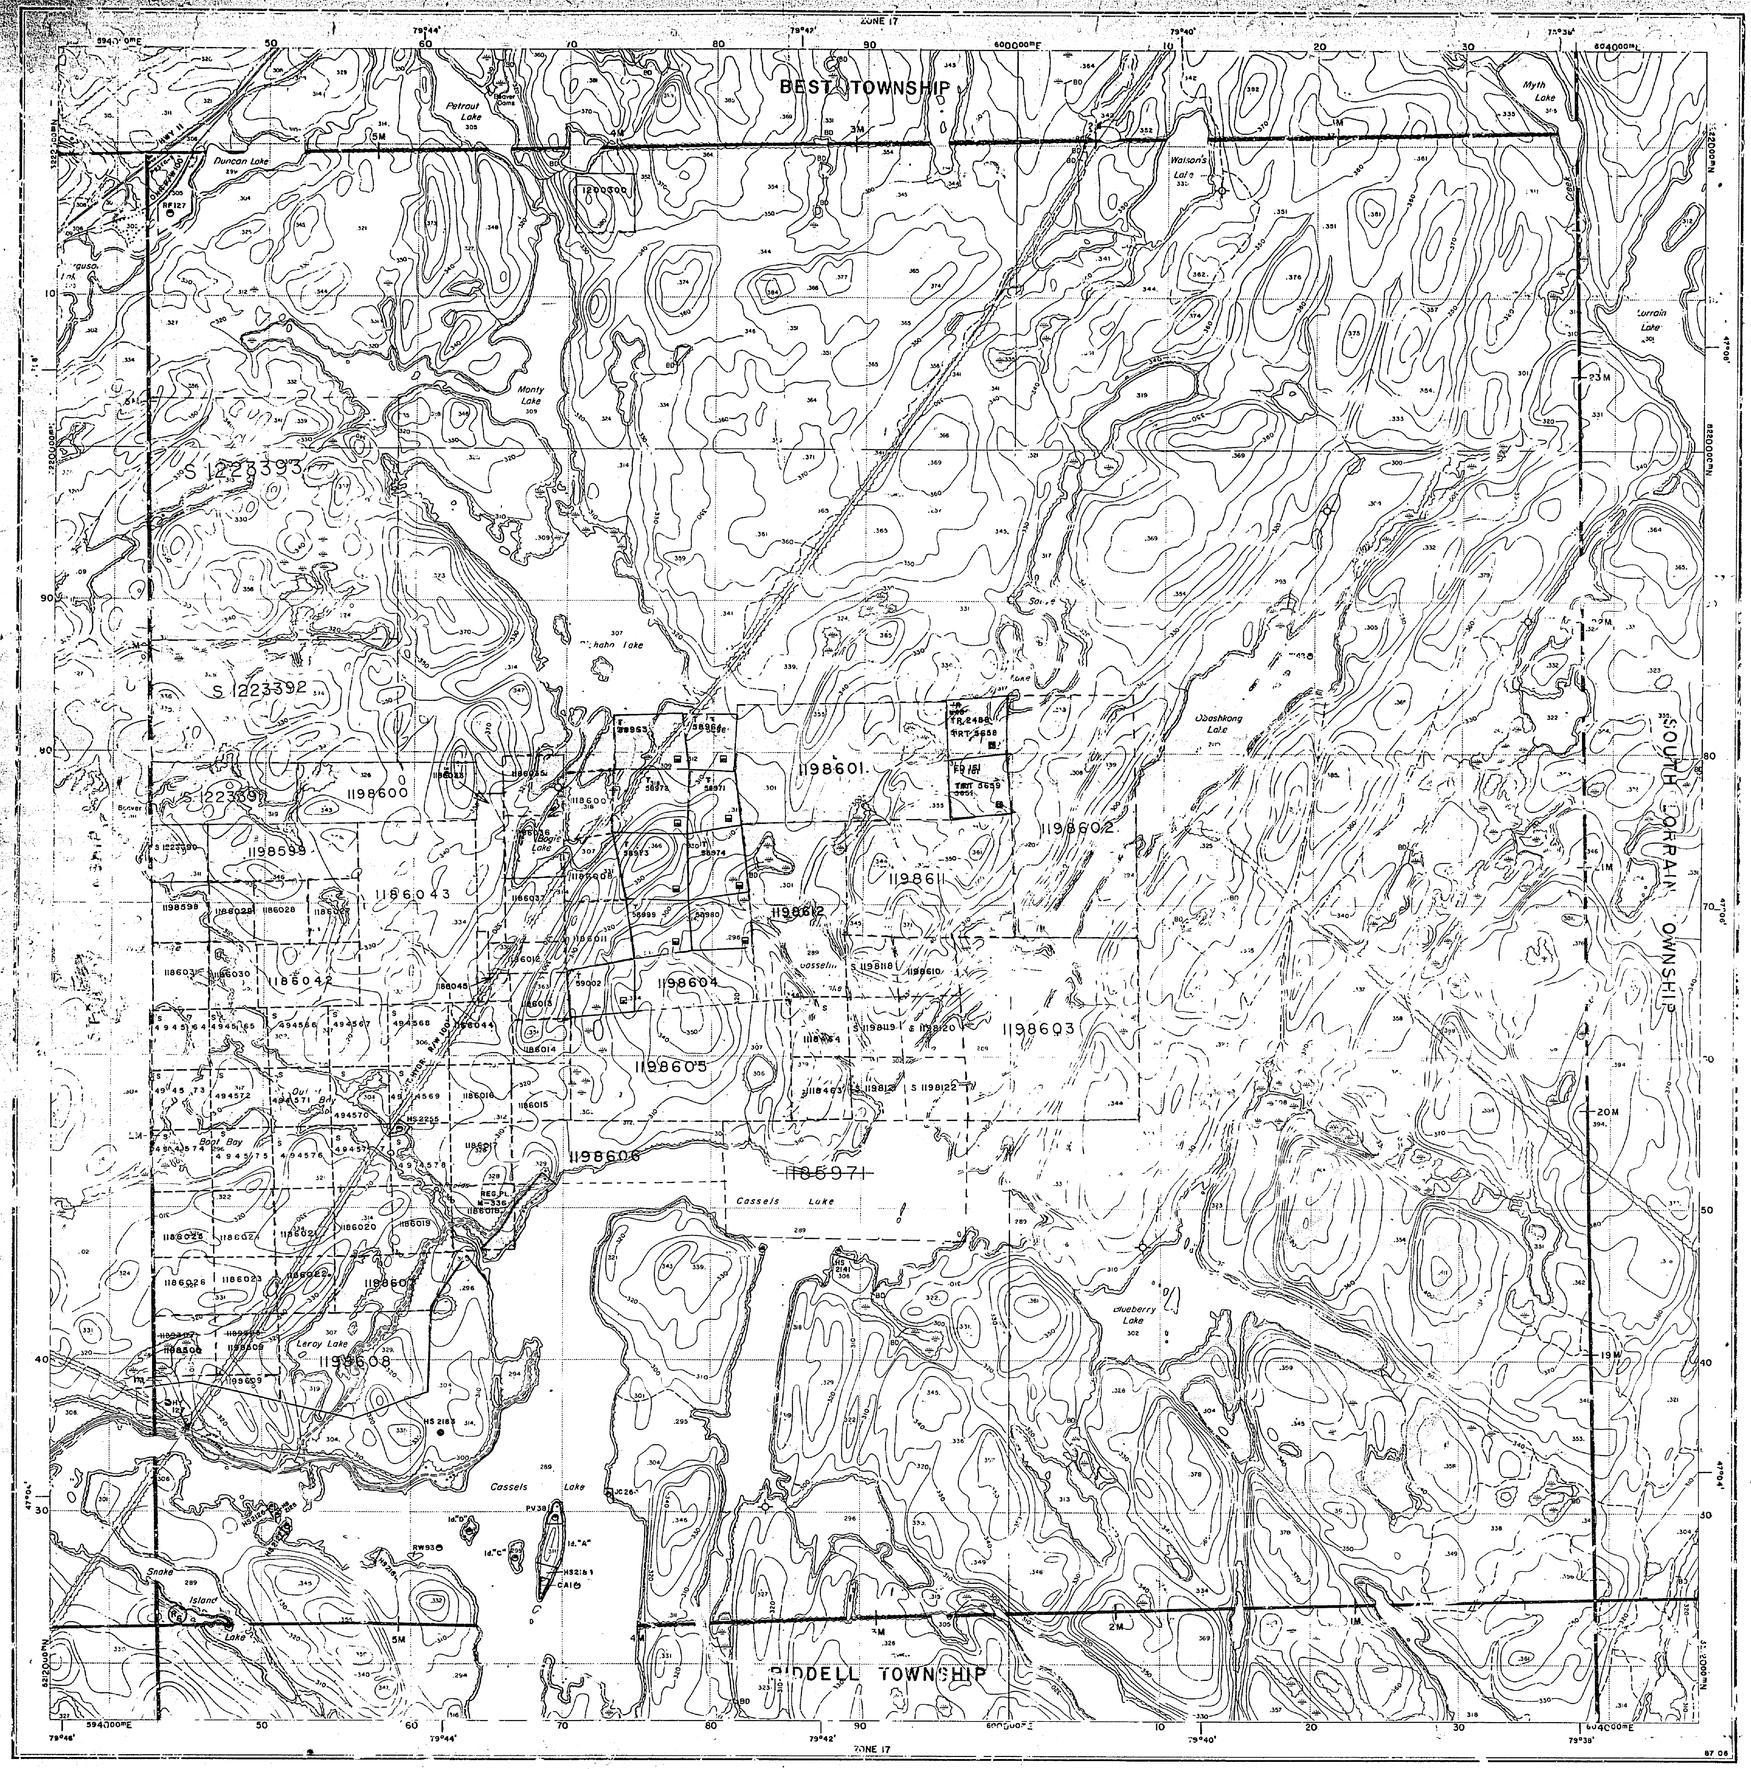
BEST TOWNSHIP
CASSELS
RIDDELL TOWNSHIP
Petrout Lake
Duncan Lake
Watson's Lake
Myth Lake
Monty Lake
Obashkang Lake
Cassels Lake
Blueberry Lake
Leroy Lake
Snake Island Lake
Boot Bay
Out Bay
Beggs Lake
Brower Lake
Vasselin
S 1223393
S 1223392
S 1223391
S 1223390
1198600
1198601
1198602
1198603
1198604
1198605
1198606
1198607
1198608
1198609
1198610
1198611
1198612

Ministry of Natural Resources
Ministry of Northern Development and Mines

IN SERVICE FEBRUARY 10, 1989

INDEX TO LAND DISPOSITION

PLAN
G-3415
TOWNSHIP
CASSELS

M.N.R. ADMINISTRATIVE DISTRICT
TEMAGAMI
MINING DIVISION
SUDBURY
LAND TITLES/REGISTRY DIVISION
NIPISSING

Scale 1:20 000
1000 Metres 0 1000
1000 0 1000 2000 3000 4000 5000 6000 7000 8000 9000 10000 Feet
Contour Interval 10 Metres

SYMBOLS

Boundary
- Township, Meridian, Baseline
- Road allowance; surveyed
- shoreline
- Lot/Concession; surveyed
- unsurveyed
- Parcel; surveyed
- unsurveyed
- Right-of-way; road
- railway
- utility
- Reservation
- Cliff, Pit, Pile
- Contour
- Interpolated
- Approximate
- Depression
- Control point (horizontal) △
- Flooded land
- Marshland
- Pipeline (below ground)
- Power line; right-of-way
- power line; track
- abandoned
- Road; highway, county, township
- access
- trail, bush
- Shoreline (original)
- Transmission line
- Wooded area

DISPOSITION OF CROWN LANDS

Patent
- Surface & Mining Rights
- Surface Rights Only
- Mining Rights Only

Lease
- Surface & Mining Rights
- Surface Rights Only
- Mining Rights Only

- Licence of Occupation
- Order-in-Council OC
- Cancelled
- Reservation
- Sand & Gravel
- LAND USE PERMIT

AREAS WITHDRAWN FROM DISPOSITION

MRO - Mining Rights Only
SRO - Surface Rights Only
M+S - Mining and Surface Rights

Description	Order No.	Date		
~~Sec. 35/90~~	~~W-84~~	~~JULY/92~~	~~M, S~~	
~~W-5-77/86~~	~~W-5-77/86~~	~~09/15/86~~		
MRO	O-ONT-08/92 NER/CR	MAR/1992	M & S	195150
	O-ONT-07/92 NER/CR	JUNE 1/92	M & S	195150
	~~PENDING DISPOSITION UNDER THE PUBLIC LANDS ACT/~~			
	~~LAND NOT OPEN FOR STAKING SUB SECTION 50(5) of the~~			
	~~Mining Act R.S.O. 1990.~~			
	~~Notice received 02/JAN/96~~			
SLS	SEC. 35/90	~~W-5-15/96~~ ~~APR/15/96~~	M & S	195150

JUNE 1, 1996 OPENINGS TR 2486
TRT 5658


THIS TOWNSHIP FALLS WITHIN THE TEMAGAMI COMPREHENSIVE PLANING AREA. SPEACIAL WORKING CONDITIONS MAY APPLY TO EXPLORATION ACTIVITIES. FOR MORE DETAILS PLEASE CONTACT:
DISTRICT MANAGER,
NORTH BAY DISTRICT
MINISTRY, NATURAL RESOURSES

DATE OF ISSUE
JUN 10 1998
PROVINCIAL RECORDING OFFICE - SUDBURY

THE INFORMATION THAT APPEARS ON THIS MAP HAS BEEN COMPILED FROM VARIOUS SOURCES, AND ACCURACY IS NOT GUARANTEED. THOSE WISHING TO STAKE MINING CLAIMS SHOULD CONSULT WITH THE MINING RECORDER, MINISTRY OF NORTHERN DEVELOPMENT AND MINES, FOR ADDITIONAL INFORMATION ON THE STATUS OF THE LANDS SHOWN HEREON.

Map base and land disposition drafting by Surveys and Mapping Branch, Ministry of Natural Resources.

The disposition of land, location of lot fabric and parcel boundaries on this index was compiled for administrative purposes only.

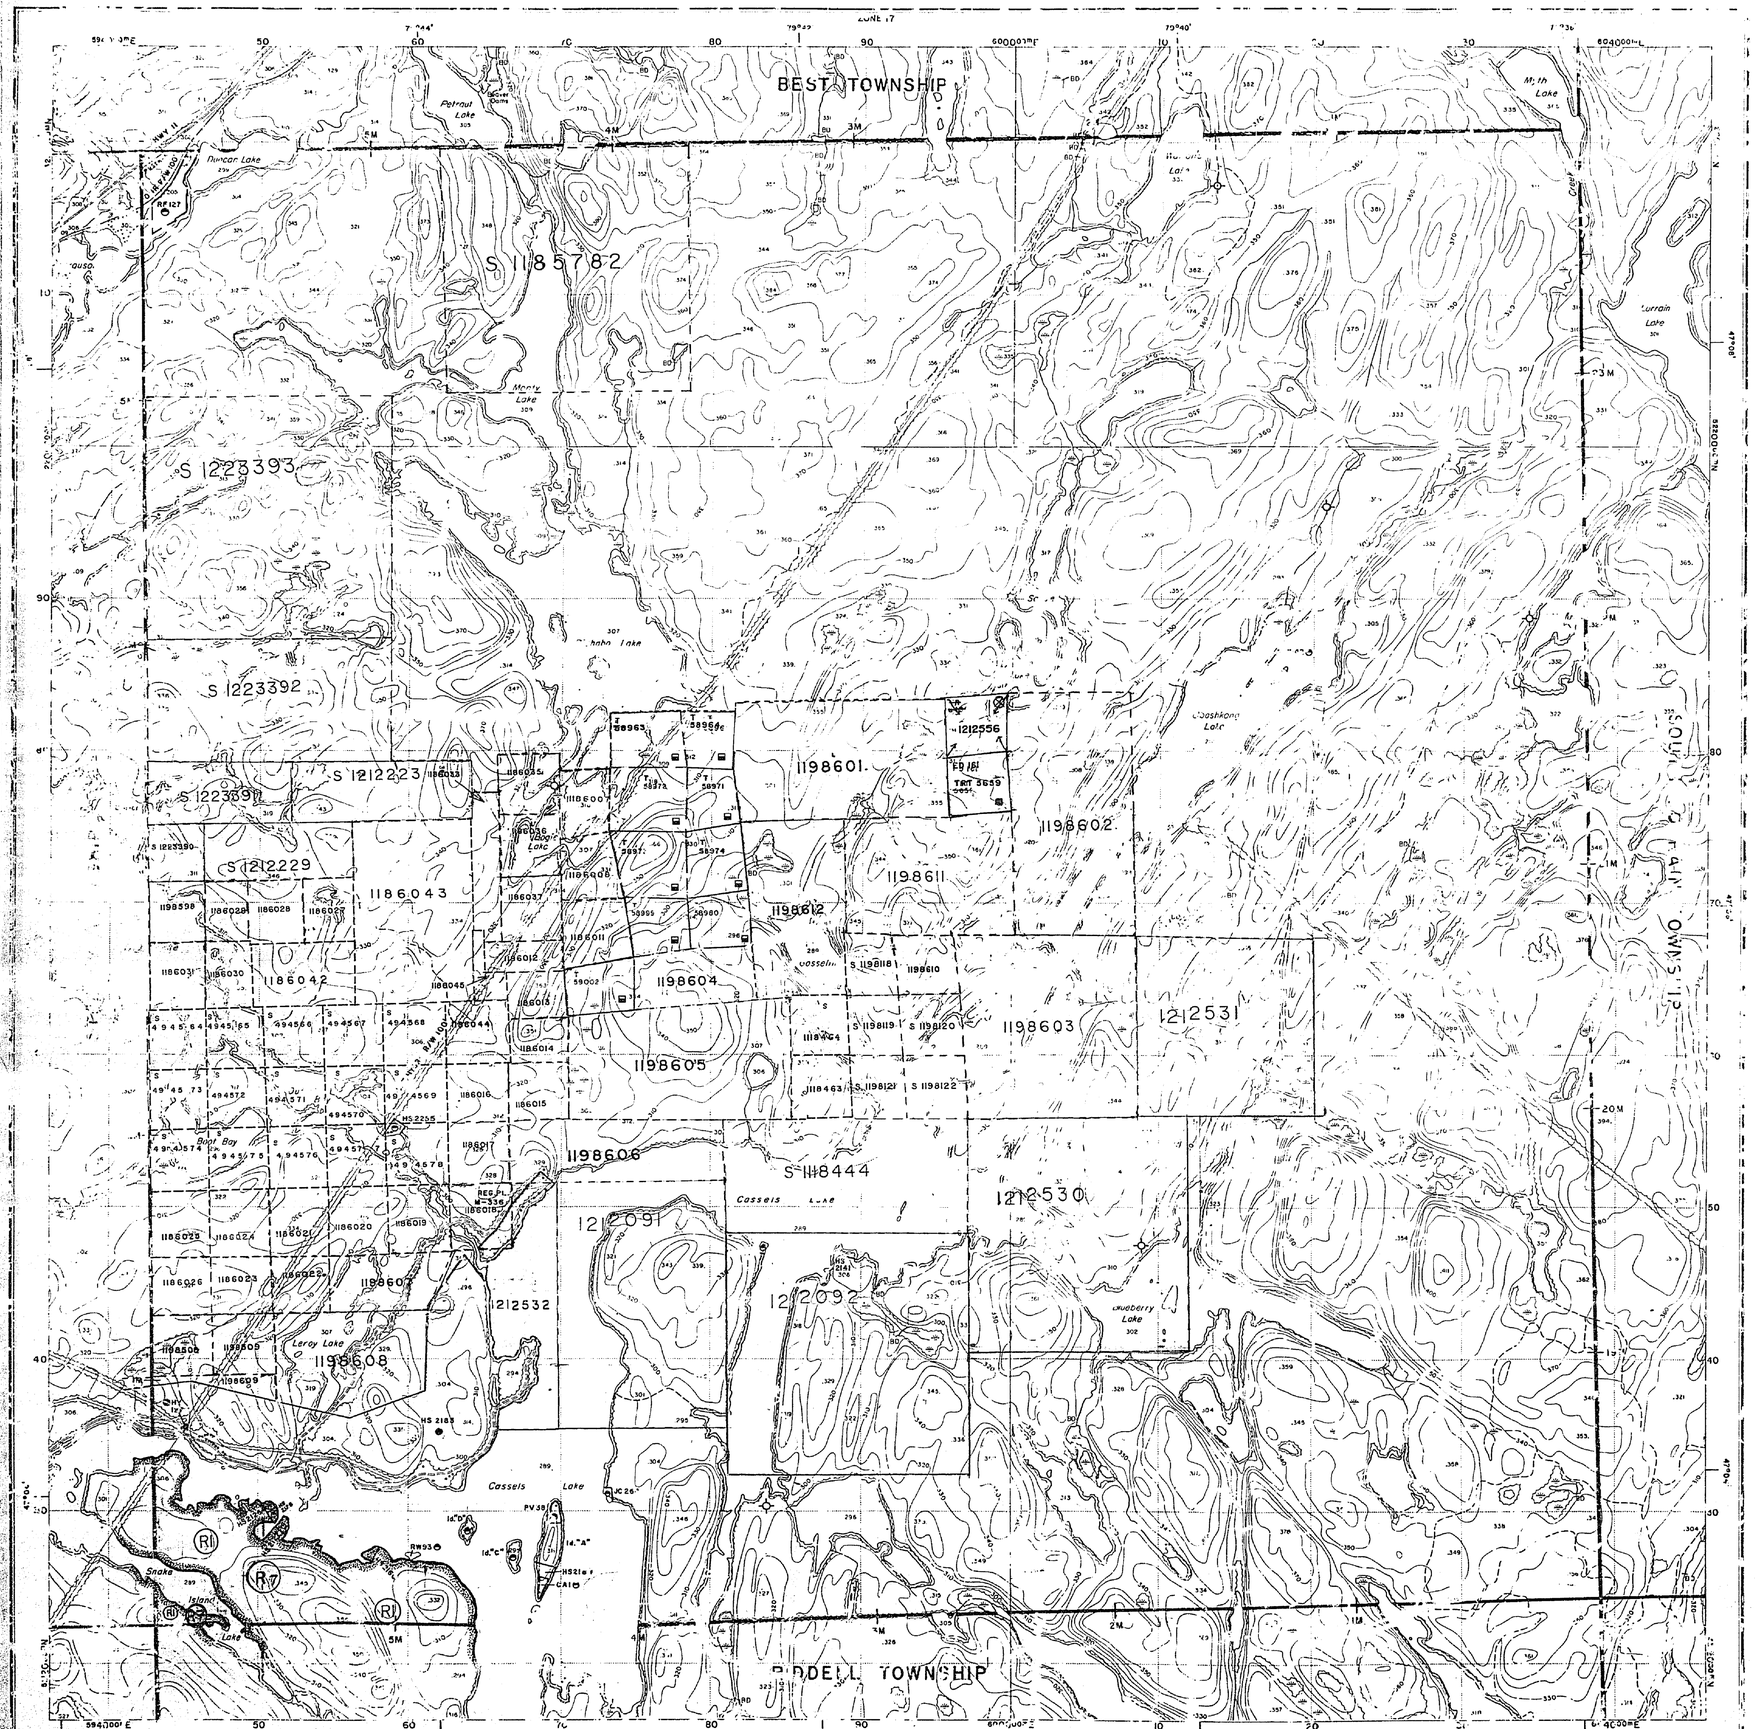

Ministry of Natural Resources
Ministry of Northern Development and Mines

IN SERVICE FEBRUARY 10, 1989

INDEX TO LAND DISPOSITION

PLAN

G-3415

TOWNSHIP

CASSELS

DATE OF ISSUE

M.N.R. ADMINISTRATIVE DISTRICT

TEMAGAMI

MINING DIVISION

SUDBURY

LAND TITLES/REGISTRY DIVISION

NIPISSING

Scale 1:20 000

1000 0 1000 2000 3000 4000 5000 6000 7000 8000 Metres

1000 0 1000 2000 3000 4000 5000 6000 7000 8000 Feet

Contour Interval 10 Metres

SYMBOLS

Boundary
- Township, Meridian, Baseline
- Road allowance; surveyed
- shoreline
- Unit/Concession; surveyed
- unsurveyed
- Patrol; surveyed
- unsurveyed
- Right-of-way; road
- railway
- utility
- Reservation
- Cliff, Pit, Pile
- Contour
- Interpolated
- Approximate
- Depression
- Spot elevation (horizontal)
- Elevation (bank)
- Monumented frame
- Mining claim
- Mining track
- claim post
- abandoned
- Road; highway, county, township
- access
- trail, bush
- Shoreline (original)
- Transmission line
- Flooded area

DISPOSITION OF CROWN LANDS

Patent
- Surface & Mining Rights
- Surface Rights Only
- Mining Rights Only

Lease
- Surface & Mining Rights
- Surface Rights Only
- Mining Rights Only

Licence of Occupation
Order-in-Council
Cancelled
Reservation
Sand & Gravel
LAND USE PERMIT

AREAS WITHDRAWN FROM DISPOSITION

MRO - Mining Act Only
SRO - Surface Rights Only
M+S - Mining and Surface Rights

Description	Order No.	Date	Man. Sec.
~~(R) Sec. 35/36 G-501/92 CR~~	~~W-5-77/96~~	~~JAN/92~~	~~M R S~~
(RO) O-ONT-06/92 NER/CR	W-5-15/96 APR/16/96	M & S	19515O
O-ONT-07/92 NER/CR	JUNE 1/92	M B S	19515O
~~PENDING DISPOSITION UNDER THE PUBLIC LANDS ACT~~			
~~LAND NOT OPEN FOR STAKING FOR SECTION 50(3) of the Mining Act R.S.O. 1990~~			
~~Notice received 05/JAN/96~~	~~W-5-77/96~~	~~09/05/96~~	
(R) SEC.35/90	~~W-5-15/96 APR/16/96~~	M B S	19515O

(R) NOT OPEN FOR STAKING - CONSERVATION RESERVE SECTION I OF THE MINING ACT

JUNE 1, 1996 OPENINGS TR 2486

TRT 5658

THIS TOWNSHIP FALLS WITHIN THE TEMAGAMI COMPREHENSIVE PLANING AREA. SPEACIAL WORKING CONDITIONS MAY APPLY TO EXPLORATION ACTIVITIES. FOR MORE DETAILS PLEASE CONTACT:
DISTRICT MANAGER,
NORTH BAY DISTRICT
MINISTRY, NATURAL RESOURSES

THE INFORMATION THAT APPEARS ON THIS MAP HAS BEEN COMPILED FROM VARIOUS SOURCES, AND ACCURACY IS NOT GUARANTEED. THOSE WISHING TO STAKE MINING CLAIMS SHOULD CONSULT WITH THE MINING RECORDER, MINISTRY OF NORTHERN DEVELOPMENT AND MINES, FOR ADDITIONAL INFORMATION ON THE STATUS OF THE LANDS SHOWN HEREON.

Map base and land disposition drafting by Surveys and Mapping Branch, Ministry of Natural Resources.

The disposition of land, location of lot fabric and parcel boundaries on this index was compiled for administrative purposes only.

Ministry of Natural Resources

Ministry of Northern Development and Mines

Ontario

IN SERVICE FEBRUARY 10, 1989

INDEX TO LAND DISPOSITION

PLAN

G-3415

TOWNSHIP

CASSELS

DATE OF ISSUE
JUN 21 1995
SUDBURY
MINING RECORDER'S OFFICE

M.N.R. ADMINISTRATIVE DISTRICT

TEMAGAMI

MINING DIVISION

SUDBURY

LAND TITLES/REGISTRY DIVISION

NIPISSING

Scale 1:20 000

1000 Metres 0 1000 2000 Metres

1000 Feet 0 1000 2000 3000 4000 5000 6000 7000 8000 9000 10 000 Feet

Contour Interval 10 Metres

SYMBOLS

Boundary
- Township, Meridian, Baseline
- Road allowance; surveyed
- shoreline
- Lot/Concession; surveyed
- unsurveyed
- Parcel; surveyed
- unsurveyed
- Right-of-way; road
- railway
- utility
- Reservation
- Cliff, Pit, Pile
- Contour — 20
- Interpolated
- Approximate
- Depression
- Control point (horizontal)
- Flooded land
- Mine head frame
- Pipeline (above ground)
- Railway, single track
- double track
- abandoned
- Road; highway, county, township
- access
- trail, bush
- Shoreline (original)
- Transmission line
- Wooded area

DISPOSITION OF CROWN LANDS

Patent
- Surface & Mining Rights
- Surface Rights Only
- Mining Rights Only

Lease
- Surface & Mining Rights
- Surface Rights Only
- Mining Rights Only

- Licence of Occupation
- Order-in-Council — OC
- Cancelled
- Reservation
- Sand & Gravel
- LAND USE PERMIT

AREAS WITHDRAWN FROM DISPOSITION

MRO - Mining Rights Only
SRO - Surface Rights Only
M + S - Mining and Surface Rights

Description	Order no.	Date	Disposition	
~~(W) Sec. 36, SS 01/92 CR~~	~~164~~	~~JAN/1/92~~	~~M, S, S~~	~~I 195150~~
(W) O-ONT-06/92 NER/CR	164	JAN/1/92	M & S	195150
O-ONT-07/92 NER/CR	JUNE 1/92	M & S	195150	

PENDING DISPOSITION UNDER THE PUBLIC LANDS ACT
LAND NOT OPEN FOR STAKING SUB-SECTION 30(8) of the Mining Act R.S.O. 1990.
Notice received 92/JAN/05

THE INFORMATION THAT APPEARS ON THIS MAP HAS BEEN COMPILED FROM VARIOUS SOURCES, AND ACCURACY IS NOT GUARANTEED. THOSE WISHING TO STAKE MINING CLAIMS SHOULD CONSULT WITH THE MINING RECORDER, MINISTRY OF NORTHERN DEVELOPMENT AND MINES, FOR ADDITIONAL INFORMATION ON THE STATUS OF THE LANDS SHOWN HEREON.

Map base and land disposition drafting by Surveys and Mapping Branch, Ministry of Natural Resources.

The disposition of land, location of lot fabric and parcel boundaries on this index was compiled for administrative purposes only.

Ministry of Natural Resources

Ministry of Northern Development and Mines

IN SERVICE FEBRUARY 10, 1989

INDEX TO LAND DISPOSITION

PLAN

G-3415

TOWNSHIP

CASSELS

DATE OF ISSUE FEB 6 1989 SUDBURY MINING RECORDER'S OFFICE

M.N.R. ADMINISTRATIVE DISTRICT

TEMAGAMI

MINING DIVISION

SUDBURY

LAND TITLES/REGISTRY DIVISION

NIPISSING

Scale 1:20 000

1000 0 1000 2000 Metres

1000 0 1000 2000 3000 4000 5000 6000 7000 8000 9000 10 000 Feet

Contour Interval 10 Metres

SYMBOLS

Boundary
- Township, Meridian, Baseline
- Road allowance; surveyed
- shoreline
- Lot/Concession; surveyed
- unsurveyed
- Patent; surveyed
- unsurveyed
- Right-of-way; road
- railway
- utility
- Reservation
- Cliff, Pit, Pile
- Contour — 20 —
- Interpolated
- Approximate
- Depression
- Control point (horizontal) △
- Flooded land
- Mine shaft or mine
- Pipeline (above ground)
- Railway; single track
- double track
- abandoned
- Road; highway, county, township
- access
- trail, bush
- Shoreline (original)
- Transmission line
- Wooded area

DISPOSITION OF CROWN LANDS

Patent
- Surface & Mining Rights ●
- Surface Rights Only ◓
- Mining Rights Only ◒

Lease
- Surface & Mining Rights ■
- Surface Rights Only ◨
- Mining Rights Only ◪

Licence of Occupation ▼

Order-in-Council OC

Cancelled ⊗

Reservation ⊘

Sand & Gravel ⊛

LAND USE PERMIT ✧

AREAS WITHDRAWN FROM DISPOSITION

MRO - Mining Rights Only

SRO - Surface Rights Only

M + S - Mining and Surface Rights

Description	Order No.	Date	Disposition	Plan
M 56/90/92 CR	64	JAN/92	M & S	49550
SRO 0-ONT-06/92 NER/CR	64	JAN/92	M & S	49550
0-ONT-07/92 NER/CR	JUNE 1/92	M & S	49550

PENDING DISPOSITION UNDER THE PUBLIC LANDS ACT

LAND NOT OPEN FOR STAKING SUB-SECTION 30(8) of the Mining Act R.S.O. 1990

Notice received 92/JAN/06

THE INFORMATION THAT APPEARS ON THIS MAP HAS BEEN COMPILED FROM VARIOUS SOURCES, AND ACCURACY IS NOT GUARANTEED. THOSE WISHING TO STAKE MINING CLAIMS SHOULD CONSULT WITH THE MINING RECORDER, MINISTRY OF NORTHERN DEVELOPMENT AND MINES, FOR ADDITIONAL INFORMATION ON THE STATUS OF THE LANDS SHOWN HEREON.

Map base and land disposition drafting by Surveys and Mapping Branch, Ministry of Natural Resources.

The disposition of land, location of lot fabric and parcel boundaries on this index was compiled for administrative purposes only.

Ministry of Natural Resources
Ontario

Ministry of Northern Development and Mines

IN SERVICE FEBRUARY 10, 1989

INDEX TO LAND DISPOSITION

PLAN
G-3415

TOWNSHIP
CASSELS

DATE OF ISSUE
JUL 02 1998
PROVINCIAL RECORDING OFFICE : SUDBURY
DATE

M.N.R. ADMINISTRATIVE DISTRICT
TEMAGAMI

MINING DIVISION
SUDBURY

LAND TITLES/REGISTRY DIVISION
NIPISSING

Scale 1:20 000

1000 0 1000 Metres

1000 0 1000 2000 3000 4000 5000 6000 7000 8000 9000 Feet

Contour Interval 10 Metres

SYMBOLS

Boundary
- Township, Meridian, Baseline
- Road allowance; surveyed
- shoreline
- Lot/Concession; surveyed
- unsurveyed
- Parcel; surveyed
- unsurveyed
- Right-of-way; road
- railway
- utility
- Reservation
- Cliff, Pit, Pile
- Contour
- Interpolated
- Approximate
- Depression
- Control point (horizontal)
- Flooded land
- Marshland or muskeg
- Escarpment (bedrock ground)
- Railway; track
- double track
- abandoned
- Road; highway, county, township
- access
- trail, bush
- Shoreline (original)
- Transmission line
- Flooded area

DISPOSITION OF CROWN LANDS

Patent
- Surface & Mining Rights
- Surface Rights Only
- Mining Rights Only

Lease
- Surface & Mining Rights
- Surface Rights Only
- Mining Rights Only

Licence of Occupation
Order-in-Council
Cancelled
Reservation
Sand & Gravel
LAND USE PERMIT

AREAS WITHDRAWN FROM DISPOSITION

MRO - Mining Rights Only
SRO - Surface Rights Only
M+S - Mining and Surface Rights

Description	Order No.	Date	Disposition		
Sec.35/98 CR	W-5-77/98	09/13/98	M&S		195150
O-ONT-06782 REINCR	W-5-15198	APR/16/98	M&S		195150
O-ONT-07782 REINCR		JUNE 1/82	M&S		195150

PENDING DISPOSITION UNDER THE PUBLIC LANDS ACT.
LAND NOT OPEN FOR STAKING SUB-SECTION 50(5) of the Mining Act R.S.O. 1990.

Notice received 92/JAN/06

SEC.35/98 W-5-15198 APR/16/98 M&S 195150

SEC.35 W-5-22/98 NE 24/06/98 M&S 195150

JUNE 1, 1996 OPENINGS TR 2486

TRT 5658

THIS TOWNSHIP FALLS WITHIN THE TEMAGAMI COMPREHENSIVE PLANING AREA (SPEACIAL WORKING) CONDITIONS MAY APPLY TO EXPLORATION ACTIVITIES. FOR MORE DETAILS PLEASE CONTACT:
DISTRICT MANAGER,
NORTH BAY DISTRICT,
MINISTRY, NATURAL RESOURSES

THE INFORMATION THAT APPEARS ON THIS MAP HAS BEEN COMPILED FROM VARIOUS SOURCES, AND ACCURACY IS NOT GUARANTEED. THOSE WISHING TO STAKE MINING CLAIMS SHOULD CONSULT WITH THE MINING RECORDER, MINISTRY OF NORTHERN DEVELOPMENT AND MINES, FOR ADDITIONAL INFORMATION ON THE STATUS OF THE LANDS SHOWN HEREON.

Map base and land disposition drafting by Surveys and Mapping Branch, Ministry of Natural Resources.

The disposition of land, location of lot fabric and parcel boundaries on this index was compiled for administrative purposes only.

444

Best Twp.M.417

Strathy Twp.M.596

South Lorrain Twp.M.591

Riddell Twp.M.578

Duncan

Monty L.

Pishabo Lake

Sauvé Lake

Friday Cr.

Obashkong Lake

Bogie L.

Net Lake

Outlet Bay

Boot Bay

Gosselin Lake

Cassels Lake

Blueberry Lake

L.O. 6960 FILE NO 119327

R.W. 42

R.W. 93

H.S. 2183

H.S. 2140

H.S. 2141

H.S. 2185 BOOMING AREA

J.C. 264

C.A.I

5930 74-95

5898 74/75

THE TOWNSHIP OF CASSELS

DISTRICT OF NIPISSING

LARDER LAKE MINING DIVISION

SCALE: 1-INCH=40 CHAINS

LEGEND

PATENTED LAND	Ⓟ
CROWN LAND SALE	C.S.
LEASES	Ⓛ
LOCATED LAND	Loc.
LICENSE OF OCCUPATION	L.O.
MINING RIGHTS ONLY	M.R.O.
SURFACE RIGHTS ONLY	S.R.O.
ROADS	
IMPROVED ROADS	
KING'S HIGHWAYS	11
RAILWAYS	
POWER LINES	
MARSH OR MUSKEG	
MINES	
CANCELLED	C.

NOTES

400' Surface rights reservation around all lakes and rivers.

LARDER LAKE MINING DIV.
RECEIVED
APR 2 1971
AM 7 8 9 10 11 12 1 2 3 4 5 6 PM

CASSELS TWP. 444

CASSELS

PLAN NO. M-444

ONTARIO
DEPARTMENT OF MINES
AND NORTHERN AFFAIRS



Ministry of Natural Resources
Ministère du Développement du Nord et des Mines
Ontario

IN SERVICE FEBRUARY 10, 1989

INDEX TO LAND DISPOSITION

PLAN

G-3415 Base

TOWNSHIP

CASSELS

DATE OF ISSUE

JUN 17 1992

SUDBURY

~~MINING RECORDER'S OFFICE~~

M.N.R. ADMINISTRATIVE DISTRICT

TEMAGAMI

MINING DIVISION

SUDBURY

LAND TITLES/REGISTRY DIVISION

NIPISSING

Scale 1:20 000

1000 Metres 0 1000 2000 Metres

1000 Feet 0 1000 2000 3000 4000 5000 6000 7000 8000 9000 10,000 Feet

Contour Interval 10 Metres

SYMBOLS

Boundary
- Township, Meridian, Baseline
- Road allowance; surveyed
- shoreline
- Lot/Concession; surveyed
- unsurveyed
- Parcel; surveyed
- unsurveyed
- Right-of-way; road
- railway
- utility
- Reservation
- Cliff, Pit, Pile
- Contour
- Interpolated
- Approximate
- Depression
- Control point (horizontal)
- Flooded land
- Marshland
- Pipeline (above ground)
- Railway; single track
- double track
- abandoned
- Road; highway, county, township
- access
- trail, bush
- Shoreline (original)
- Transmission line
- Wooded area

DISPOSITION OF CROWN LANDS

Patent
- Surface & Mining Rights
- Surface Rights Only
- Mining Rights Only

Lease
- Surface & Mining Rights
- Surface Rights Only
- Mining Rights Only

Licence of Occupation
Order-in-Council OC
Cancelled
Reservation
Sand & Gravel
LAND USE PERMIT

AREAS WITHDRAWN FROM DISPOSITION

MPO - Mineral Only,
SRO - Surface Rights Only
M & S - Mining and Surface Rights

Description	Order no.	Date	Disposition	
~~SEC.35/90~~	~~W-S-15/96~~	~~APR.16/96~~	~~M & S~~	~~195150~~
O-ONT-06/92 NERCR O-ONT-07/92 NERCR		MAR/1992 JUNE 1/92	M & S M & S	195150 195150
~~PENDING DISPOSITION UNDER THE PUBLIC LANDS ACT,~~ ~~AND NOT OPEN FOR STAKING SUB-SECTION 30(8) of the~~ ~~Mining Act R.S.O. 1990.~~ ~~Notice received 92/JAN/06~~				
SEC.35/90	W-S-15/96	APR.16/96	M & S	195150

JUNE 1, 1996 OPENINGS TR 2486


TRT 5658

THE INFORMATION THAT APPEARS ON THIS MAP HAS BEEN COMPILED FROM VARIOUS SOURCES, AND ACCURACY IS NOT GUARANTEED. THOSE WISHING TO STAKE MINING CLAIMS SHOULD CONSULT WITH THE MINING RECORDER, MINISTRY OF NORTHERN DEVELOPMENT AND MINES, FOR ADDITIONAL INFORMATION ON THE STATUS OF THE LANDS SHOWN HEREON.

Map base and land disposition drafting by Surveys and Mapping Branch, Ministry of Natural Resources.

The disposition of land, location of lot fabric and parcel boundaries on this index was compiled for administrative purposes only.

16 14 12 10 8 6 4 2 2 4 6 8 10 12 14 16

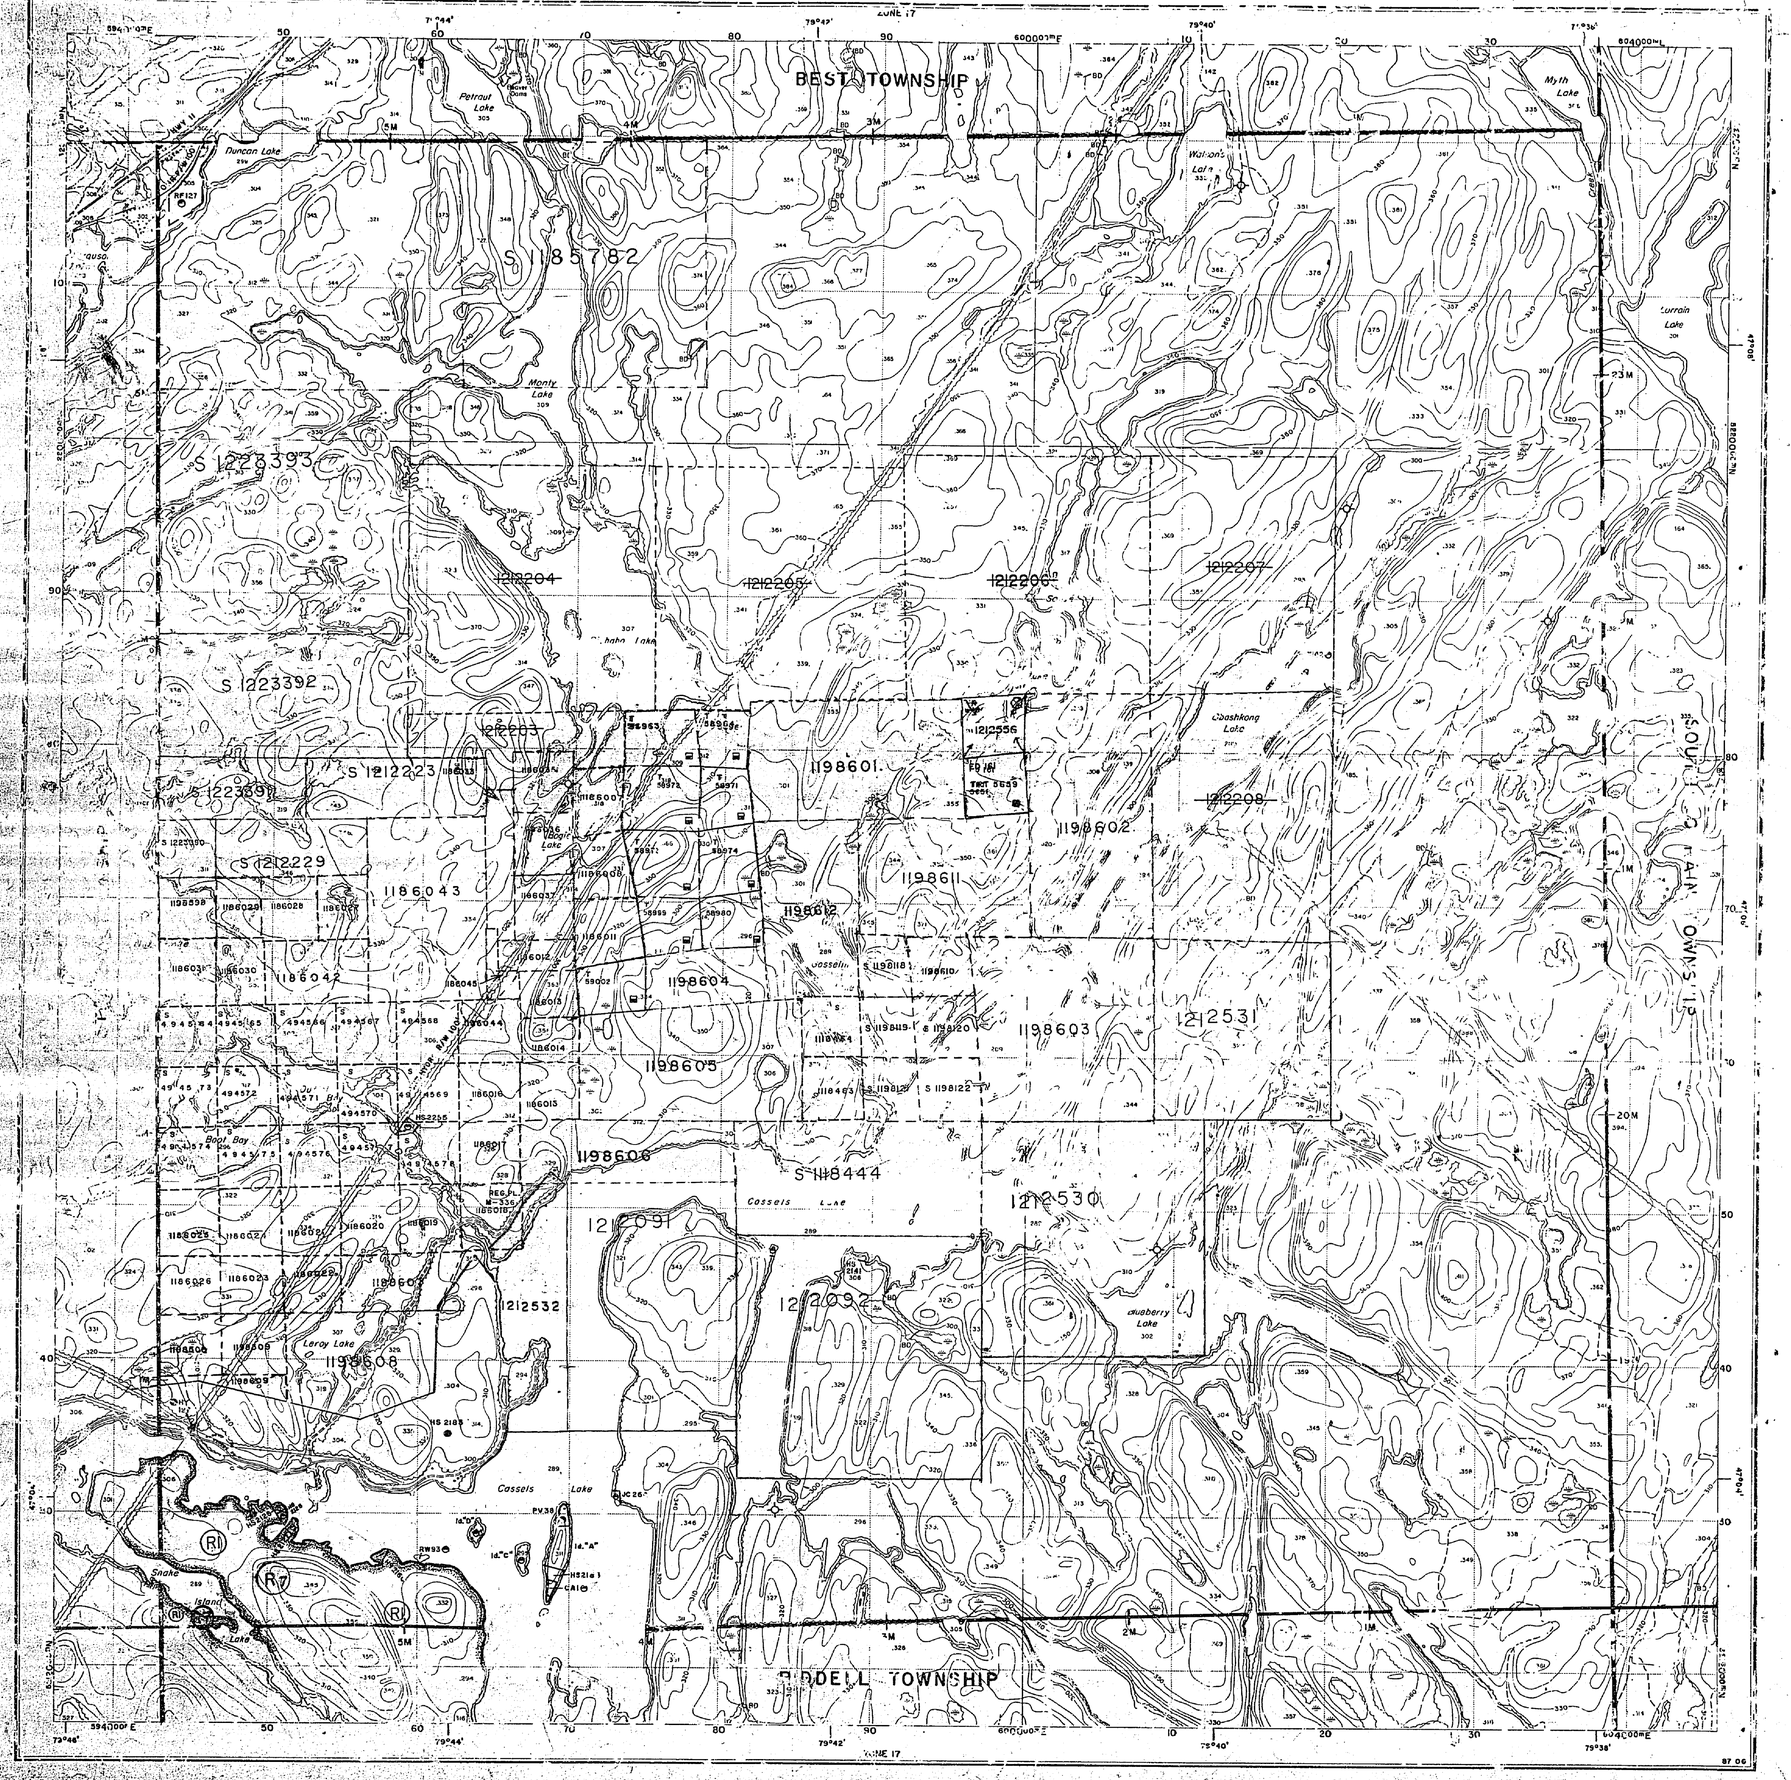
BEST TOWNSHIP
ZONE 17
Petrout Lake
Duncan Lake
Monty Lake
Watson's Lake
Myth Lake
Terrain Lake
Cassels Lake
Cashkong Lake
Boot Bay
Loroy Lake
Snake Island Lake
1212204
1212205
1212206
1212207
1212208
1212556
1212531
1212530
1212532
1212091
1212092
1198601
1198602
1198603
1198604
1198605
1198606
1198608
1198609
1198611
1198612
1186043
1186042
1186045
1186044
1186046
1186047
444

Best Twp.M.417

Strathy Twp.M.596

South Lorrain Twp.M.591

Riddell Twp.M.578

THE TOWNSHIP OF CASSELS

DISTRICT OF NIPISSING

LARDER LAKE MINING DIVISION

SCALE: 1-INCH=40 CHAINS

LEGEND

PATENTED LAND	(P)
CROWN LAND SALE	C.S.
LEASES	(L)
LOCATED LAND	Loc.
LICENSE OF OCCUPATION	L.O.
MINING RIGHTS ONLY	M.R.O.
SURFACE RIGHTS ONLY	S.R.O.
ROADS	
IMPROVED ROADS	
KING'S HIGHWAYS	
RAILWAYS	
POWER LINES	
MARSH OR MUSKEG	
MINES	
CANCELLED	C.

NOTES

400' Surface rights reservation around all lakes and rivers.

LARDER LAKE MINING DIV. RECEIVED MAR 6 - 1970 AM PM 7 8 9 10 11 12 1 2 3 4 5 6


PLAN NO. M-444

DEPARTMENT OF MINES

— ONTARIO —

444

4

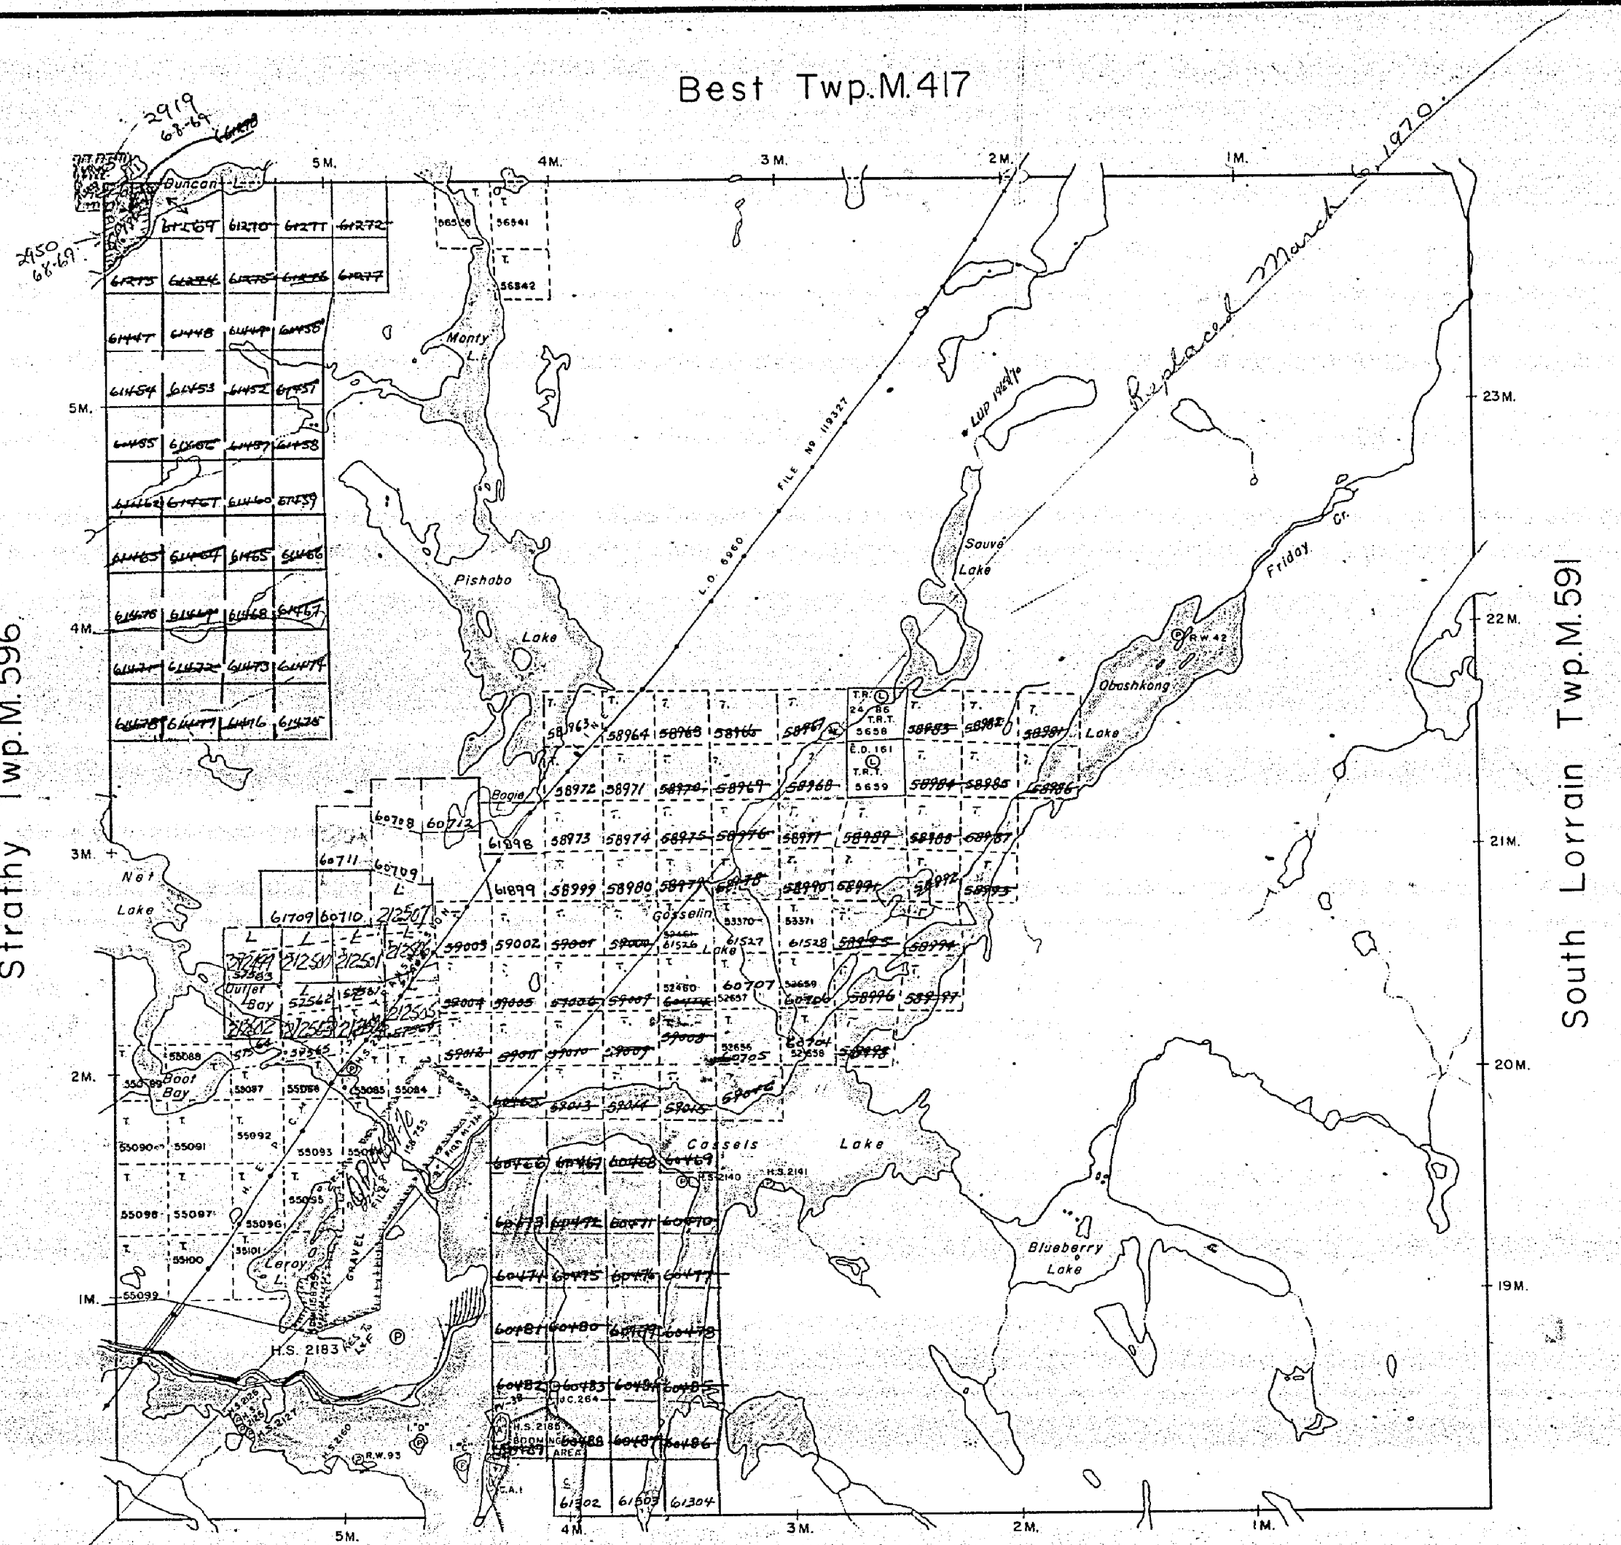

THE TOWNSHIP OF CASSELS

DISTRICT OF NIPISSING

TIMISKAMING MINING DIVISION

SCALE: 1-INCH=40 CHAINS

LEGEND

PATENTED LAND	P
CROWN LAND SALE	C.S.
LEASES	L
LOCATED LAND	Loc.
LICENSE OF OCCUPATION	L.O.
MINING RIGHTS ONLY	M.R.O.
SURFACE RIGHTS ONLY	S.R.O.
ROADS	
IMPROVED ROADS	
KING'S HIGHWAYS	
RAILWAYS	
POWER LINES	
MARSH OR MUSKEG	
MINES	
CANCELLED	C.

NOTES

400' Surface rights reservation around all lakes and rivers.

#13

RECEIVED
DEC 6 1966
TEMISKAMING
MINING DIVISION

PLAN NO.- M-444

DEPARTMENT OF MINES
— ONTARIO —

CASSELS TWP
M-444

444

Best Twp.M.417

Strathy Twp.M.596

South Lorrain Twp.M.591

Riddell Twp.M.578

7155 (76-77).
6818 (75-76)
Superior Oil

Duncan L.

Monty L.

Pishabo Lake

L.O. 6746

FILE NO 119327

Sauvé Lake

Friday Cr.

Obashkong Lake

R.W.42

T.R. L 24 86 T.R.T. 5658

E.D. 161 L T.R.T. 5659

58963 58964

Bogie L. 58972 58971 58973 58974

61798 61899 58999 58980 61769 59002

Net Lake

Gossehn Lake

Outlet Bay

Boot Bay

Cassels Lake

H.S.2140 H.S.2141

Blueberry Lake

Leroy L.

7208 (76-77) 138755

HY 127

H.S. 2183

H.S.2126 H.S.2125 H.S.2127 H.S.2160

R.W.93

PV-38 J.C.264

H.S.2185 BOOMING AREA

H.S. 2184

C.A.I.

L "C" L "D"

1M. 2M. 3M. 4M. 5M.

19M. 20M. 21M. 22M. 23M.

THE TOWNSHIP OF

CASSELS

DISTRICT OF NIPISSING

SUDBURY MINING DIVISION

SCALE: 1-INCH=40 CHAINS

LEGEND

PATENTED LAND	● or Ⓟ
CROWN LAND SALE	C.S.
LEASES	Ⓛ
LOCATED LAND	Loc.
LICENSE OF OCCUPATION	L.O.
MINING RIGHTS ONLY	M.R.O.
SURFACE RIGHTS ONLY	S.R.O.
ROADS	
IMPROVED ROADS	
KING'S HIGHWAYS	
RAILWAYS	
POWER LINES	
MARSH OR MUSKEG	
MINES	⚒
CANCELLED	C.

NOTES

400' Surface rights reservation around all lakes and rivers.

DATE OF ISSUE SEP 30 1974

CASSELS

PLAN NO. M-444

ONTARIO

MINISTRY OF NATURAL RESOURCES

SURVEYS AND MAPPING BRANCH

June, 1984


TRIM LINE

Best Twp.- M.417

Strathy Twp.- M.596

South Lorrain Twp.- M.591

Riddell Twp.- M.578

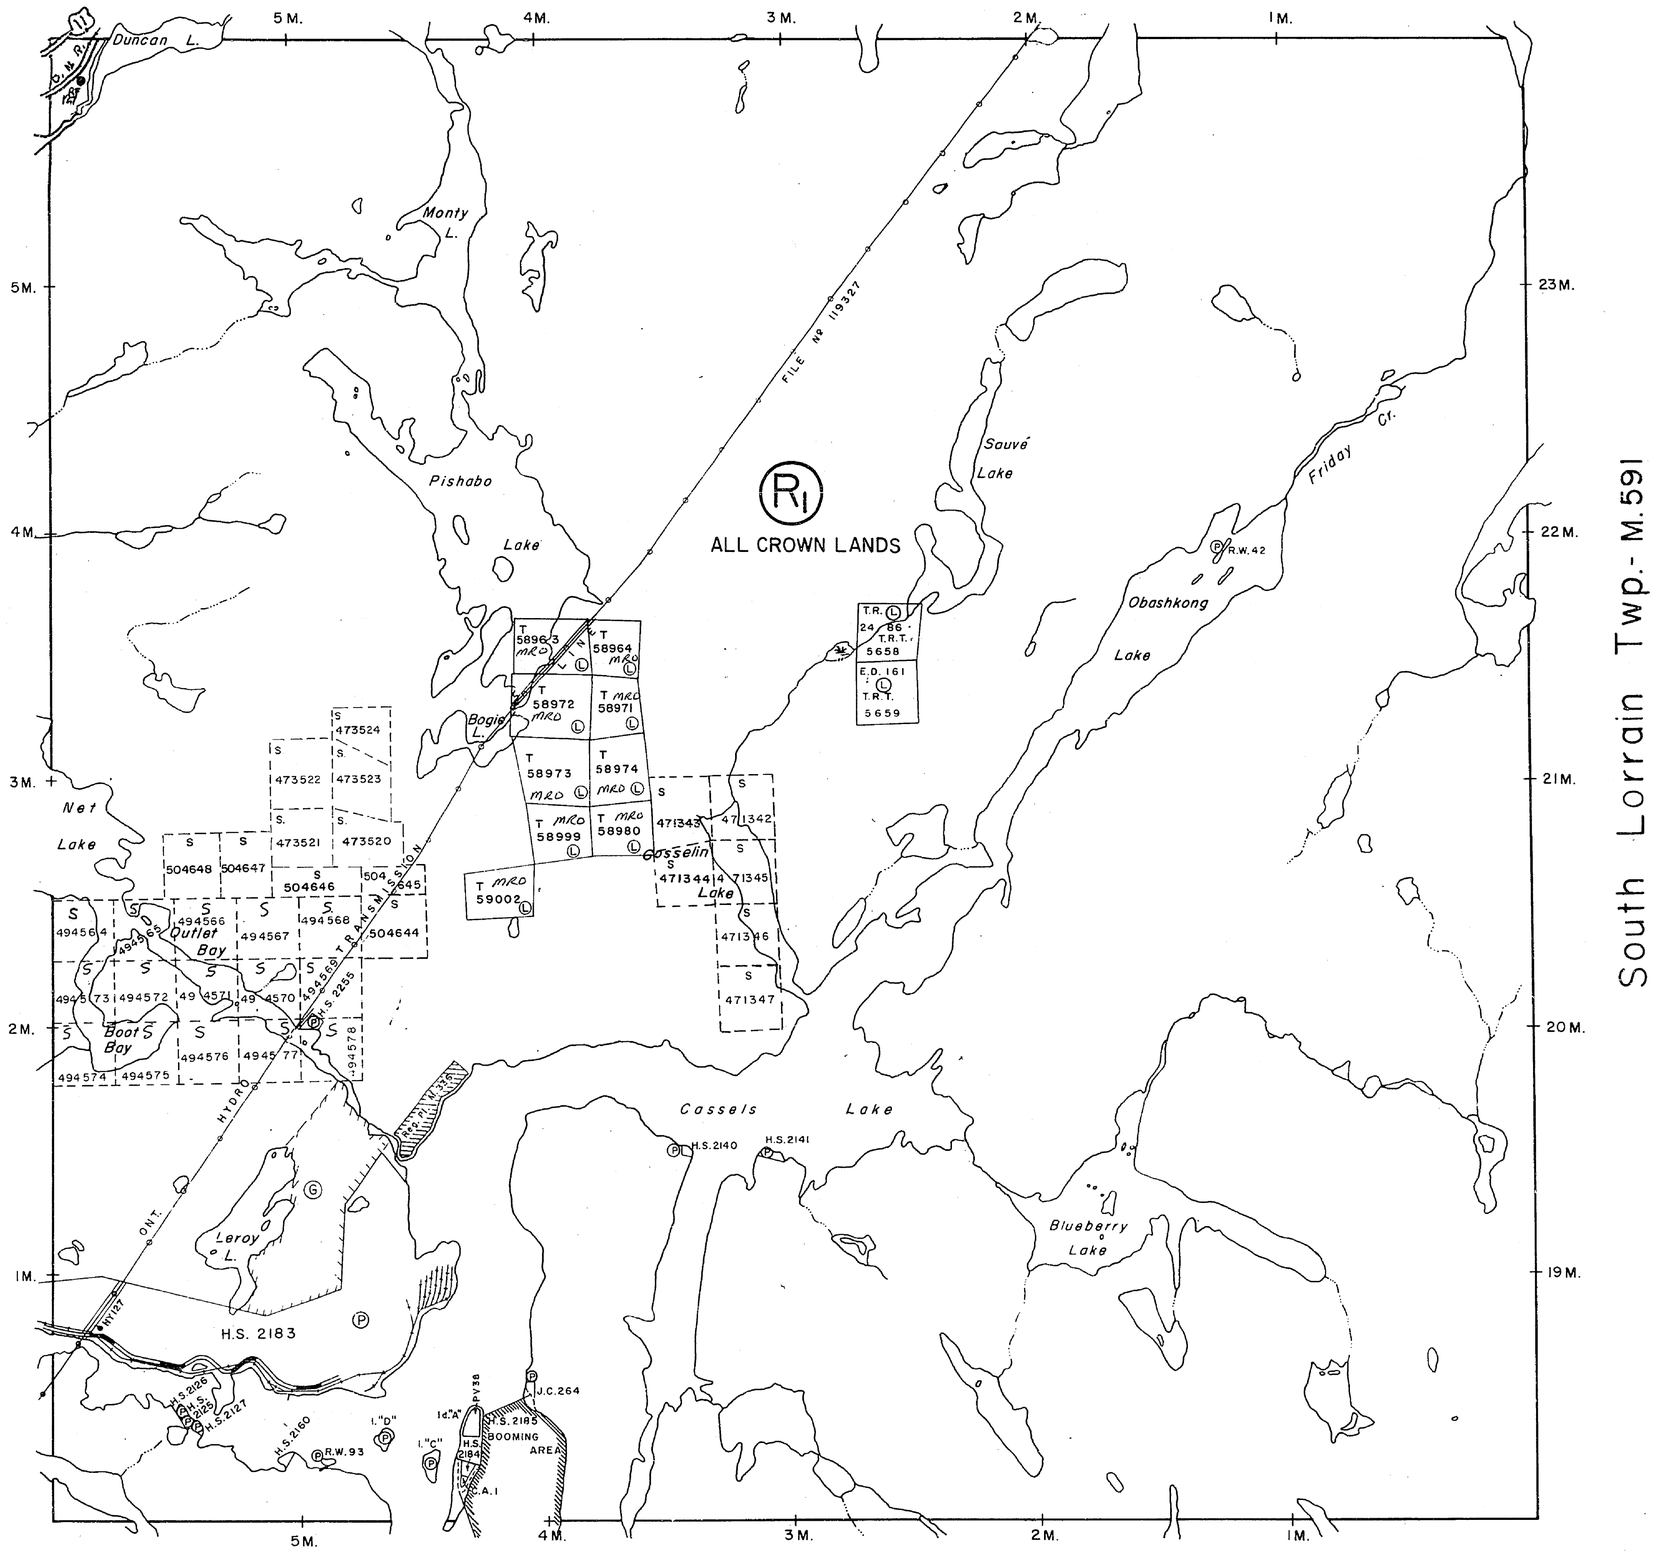

THE TOWNSHIP OF CASSELS

DISTRICT OF NIPISSING

SUDBURY MINING DIVISION

SCALE: 1-INCH=40 CHAINS

LEGEND

PATENTED LAND	● or Ⓟ
CROWN LAND SALE	C.S.
LEASES	Ⓛ
LOCATED LAND	Loc.
LICENSE OF OCCUPATION	L.O.
MINING RIGHTS ONLY	M.R.O.
SURFACE RIGHTS ONLY	S.R.O.
ROADS	
IMPROVED ROADS	
KING'S HIGHWAYS	
RAILWAYS	
POWER LINES	
MARSH OR MUSKEG	
MINES	
CANCELLED	C.
PATENTED S.R.O.	◓

NOTES

400' Surface rights reservation along the shores of all lakes and rivers.

AREAS WITHDRAWN FROM DISPOSITION

M.R.O. – MINING RIGHTS ONLY

S.R.O. – SURFACE RIGHTS ONLY

M.+ S. – MINING AND SURFACE RIGHTS

	Description	Order No.	Date	Disposition	File
(R1)	Sec. 36/80	W.1/84	16/3/84	M. & S.	188540

SAND AND GRAVEL

Ⓖ QUARRY PERMIT

Township closed to staking effective May 8 1978, Sec. 38 (f) of Mining Act.


PLAN NO.- M-444

ONTARIO

MINISTRY OF NATURAL RESOURCES

SURVEYS AND MAPPING BRANCH

CASSELS

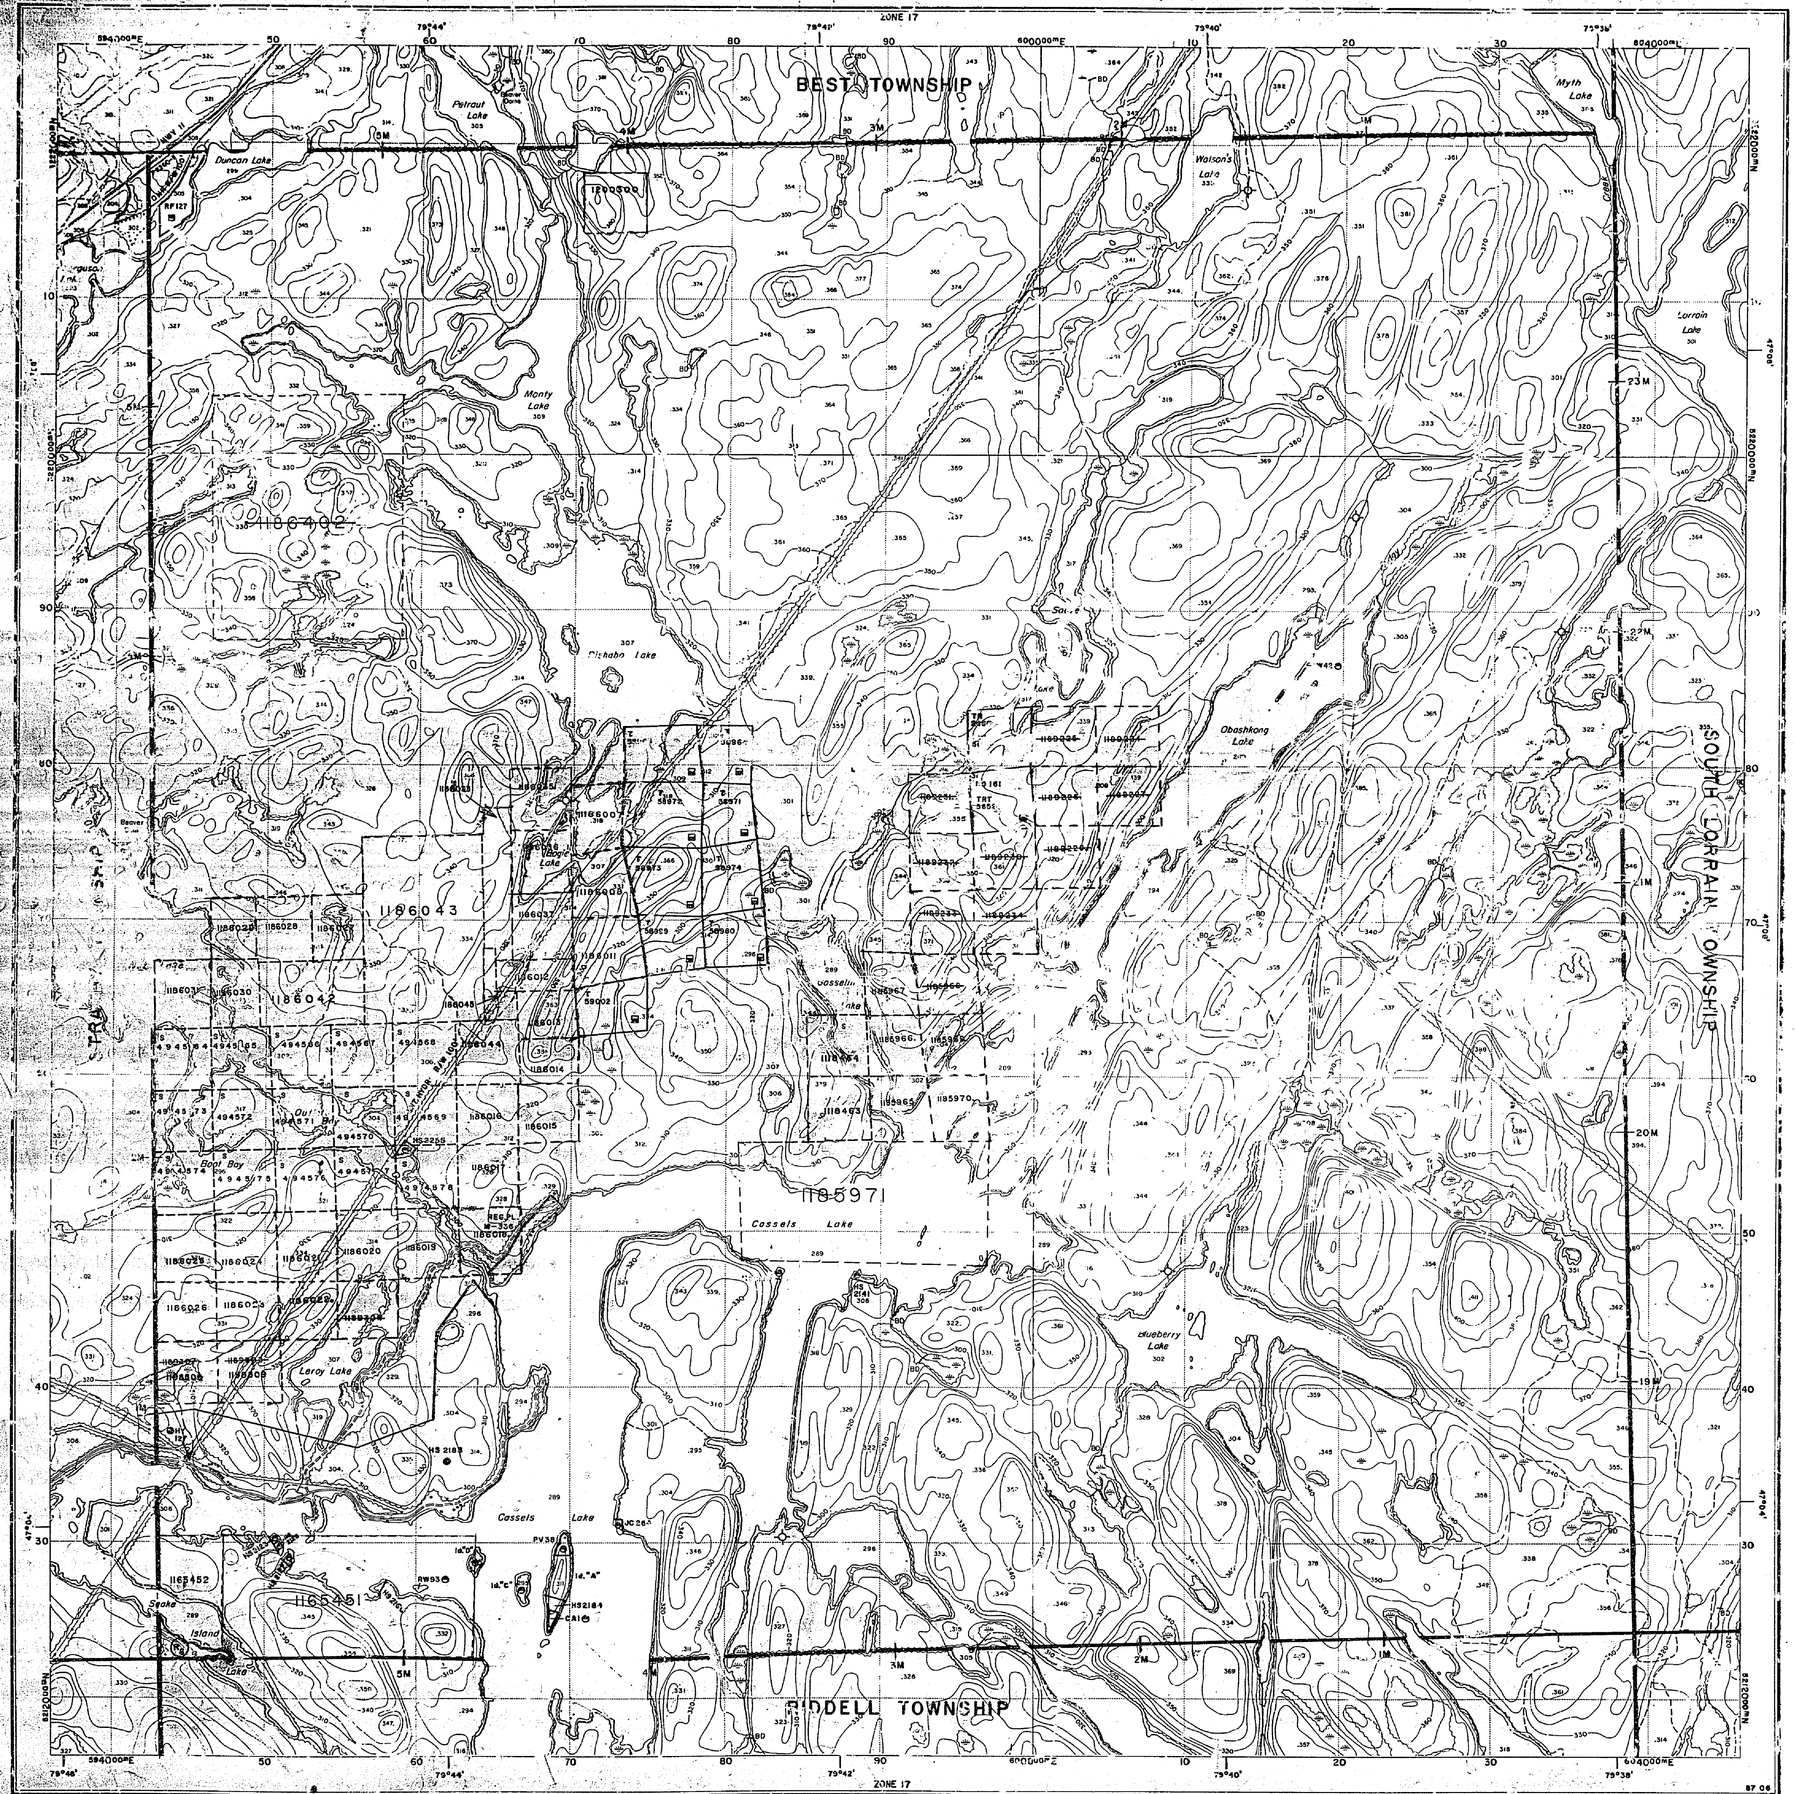
BEST TOWNSHIP
RIDDELL TOWNSHIP
CASSELS TOWNSHIP
LORRAIN TOWNSHIP
ZONE 17
584000mE
600000mE
604000mE
5320000mN
5300000mN
5280000mN
79°44'
79°42'
79°40'
79°38'
47°00'
47°10'
Petraut Lake
Duncan Lake
Monty Lake
Pichabo Lake
Myth Lake
Watson's Lake
Lorrain Lake
Obashkong Lake
Cassels Lake
Blueberry Lake
Leroy Lake
Gull Bay
Beaver Lake
Swake Island
Cassels Lake
Gasselin Lake
Trout Lake
Hwy 11
Hwy 17
Ontario
Quebec
II86402
II86043
II86042
II85971
II86452
II86451
II86007
II86008
II86009
II86010
II86011
II86012
II86013
II86014
II86015
II86016
II86017
II86018
II86019
II86020
II86021
II86022
II86023
II86024
II86025
II86026
II86027
II86028
II86029
II86030
II86031
II86032
II86033
II86034
II86035
II86036
II86037
II86038
II86039
II86040
II86041
II86044
II86045
II86046
II86047
II86048

Best Twp.M.417

Strathy Twp.M.596

South Lorrain Twp.M.591

Riddell Twp.M.578

Duncan L.

Monty L.

Pishabo Lake

Net Lake

Bogie L.

Outlet Bay

Boot Bay

Leroy L.

Gosselin Lake

Souvé Lake

Obashkong Lake

Cassels Lake

Blueberry Lake

Friday Cr.

Replaced March 6, 1970.

L.O. 6960 FILE No 19327

LUP 1467/70

5 M. 4 M. 3 M. 2 M. 1 M.

23 M. 22 M. 21 M. 20 M. 19 M.

THE TOWNSHIP OF CASSELS

DISTRICT OF NIPISSING

TIMISKAMING MINING DIVISION

SCALE: 1-INCH=40 CHAINS

LEGEND

PATENTED LAND	(P)
CROWN LAND SALE	C.S.
LEASES	(L)
LOCATED LAND	Loc.
LICENSE OF OCCUPATION	L.O.
MINING RIGHTS ONLY	M.R.O.
SURFACE RIGHTS ONLY	S.R.O.
ROADS	
IMPROVED ROADS	
KING'S HIGHWAYS	
RAILWAYS	
POWER LINES	
MARSH OR MUSKEG	
MINES	
CANCELLED	C.

NOTES

400' Surface rights reservation around all lakes and rivers.

RECEIVED
DEC 6 1966
TEMISKAMING
MINING DIVISION

PLAN NO.- M-444

DEPARTMENT OF MINES

— ONTARIO —

Best Twp.M.417

Strathy Twp.M.596

South Lorrain Twp.M.591

Riddell Twp.M.578

THE TOWNSHIP OF CASSELS

DISTRICT OF NIPISSING

LARDER LAKE MINING DIVISION

SCALE: 1-INCH=40 CHAINS

LEGEND

PATENTED LAND	(P)
CROWN LAND SALE	C.S.
LEASES	(L)
LOCATED LAND	Loc.
LICENSE OF OCCUPATION	L.O.
MINING RIGHTS ONLY	M.R.O.
SURFACE RIGHTS ONLY	S.R.O.
ROADS	
IMPROVED ROADS	
KING'S HIGHWAYS	
RAILWAYS	
POWER LINES	
MARSH OR MUSKEG	
MINES	
CANCELLED	C.

NOTES

400' Surface rights reservation around all lakes and rivers.

LARDER LAKE MINING DIV.
RECEIVED
MAR 6 - 1970
AM PM

PLAN NO.- M-444

DEPARTMENT OF MINES


— ONTARIO —

Best Twp.M.417

Strathy Twp.M.596

South Lorrain Twp.M.591

Riddell Twp.M.578

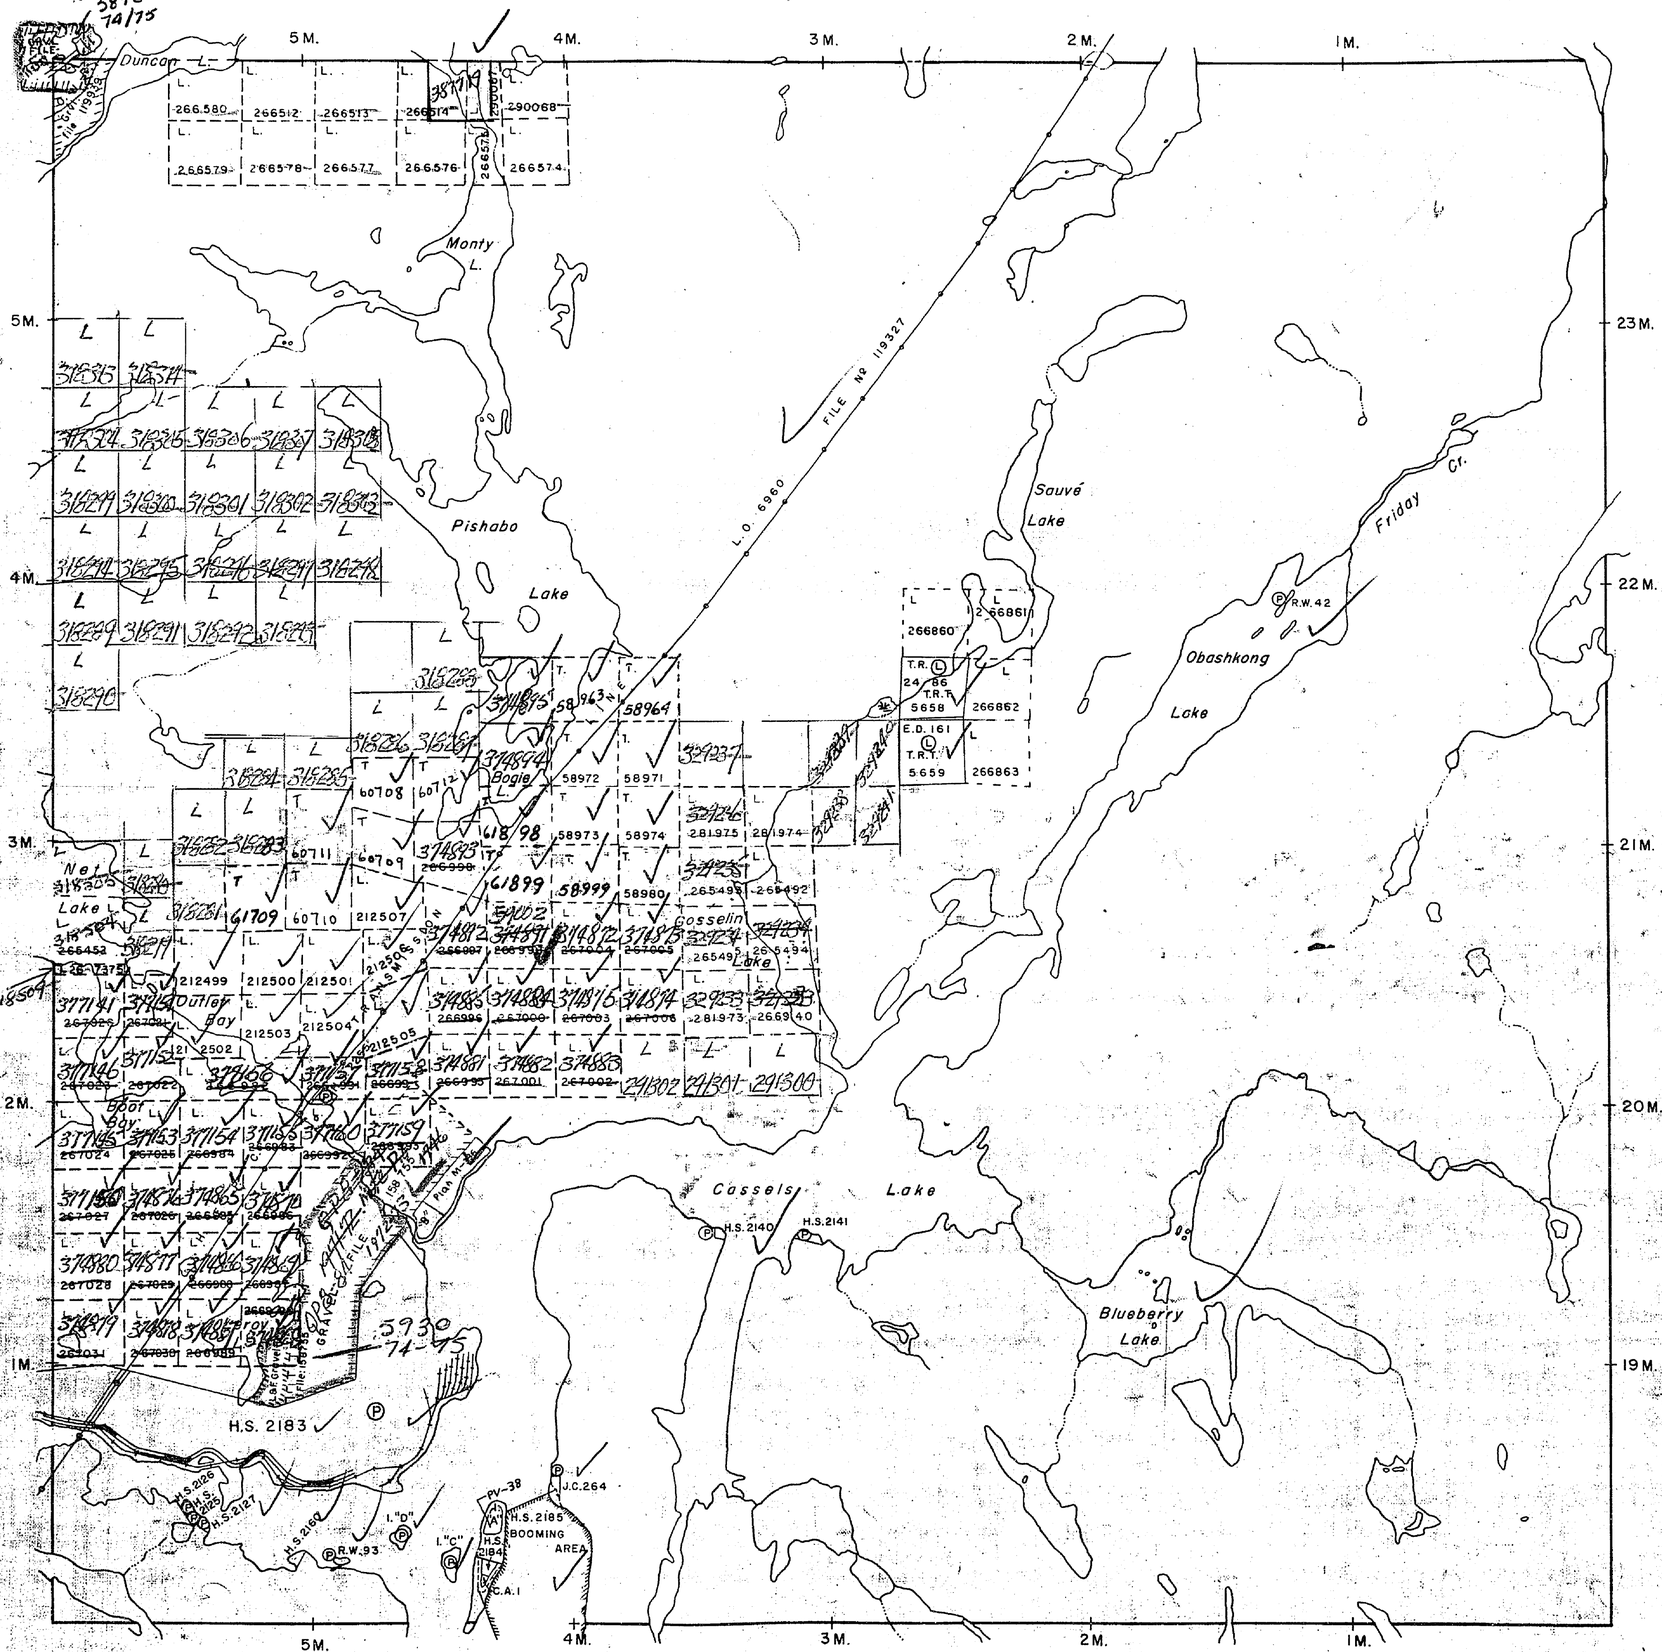

THE TOWNSHIP OF CASSELS

DISTRICT OF NIPISSING

LARDER LAKE MINING DIVISION

SCALE: 1-INCH=40 CHAINS

LEGEND

PATENTED LAND	P
CROWN LAND SALE	C.S.
LEASES	L
LOCATED LAND	Loc.
LICENSE OF OCCUPATION	L.O.
MINING RIGHTS ONLY	M.R.O.
SURFACE RIGHTS ONLY	S.R.O.
ROADS	
IMPROVED ROADS	
KING'S HIGHWAYS	11
RAILWAYS	
POWER LINES	
MARSH OR MUSKEG	
MINES	
CANCELLED	C.

NOTES

400' Surface rights reservation around all lakes and rivers.

LARDER LAKE MINING DIV.
RECEIVED
APR 2 1971
AM 7 8 9 10 11 12 1 2 3 4 5 6 PM

CASSELS

PLAN NO. M-444

ONTARIO
DEPARTMENT OF MINES
AND NORTHERN AFFAIRS

Best Twp.M.417

Strathy Twp.M.596

South Lorrain Twp.M.591

Riddell Twp.M.578

7155 (76-77).

Duncan L.

Monty L.

Pishabo Lake

Net Lake

Outlet Bay

Boot Bay

Leroy Lake

Sauvé Lake

Obashkong Lake

Friday Cr.

Gosselin Lake

Cassels Lake

Blueberry Lake

Bogie L.

L.O. 6946

FILE Nº 119327

R.W.42

R.W.93

HY 127

H.S. 2183

H.S.2140

H.S.2141

H.S.2185 BOOMING AREA

J.C.264

PV-38

C.A.1

Plan M-136

T.R. 24 86 T.R.T. 5656

E.D. 161 T.R.T. 5659

5M. 4M. 3M. 2M. 1M.

23M. 22M. 21M. 20M. 19M.

THE TOWNSHIP OF CASSELS

DISTRICT OF NIPISSING

SUDBURY MINING DIVISION

SCALE: 1-INCH=40 CHAINS

LEGEND

PATENTED LAND	● or Ⓟ
CROWN LAND SALE	C.S.
LEASES	Ⓛ
LOCATED LAND	Loc.
LICENSE OF OCCUPATION	L.O.
MINING RIGHTS ONLY	M.R.O.
SURFACE RIGHTS ONLY	S.R.O.
ROADS	
IMPROVED ROADS	
KING'S HIGHWAYS	
RAILWAYS	
POWER LINES	
MARSH OR MUSKEG	
MINES	⚒
CANCELLED	C.

NOTES

400' Surface rights reservation around all lakes and rivers.

DATE OF ISSUE SEP 30 1974

CASSELS

PLAN NO.- M-444

ONTARIO

MINISTRY OF NATURAL RESOURCES

SURVEYS AND MAPPING BRANCH

8 6 4 2 0 2 4 6 8

INDEX TO LAND DISPOSITION

PLAN
G-3415

TOWNSHIP
CASSELS

M.N.R. ADMINISTRATIVE DISTRICT
TEMAGAMI

MINING DIVISION
SUDBURY

LAND TITLES/REGISTRY DIVISION
NIPISSING

Scale 1:20 000

Metres 1000 0 1000 2000 Metres

Feet 1000 0 1000 2000 3000 4000 5000 6000 7000 8000 9000 10000 Feet

Contour Interval 10 Metres

AREAS WITHDRAWN FROM DISPOSITION

MRO - Mining Rights Only
SRO - Surface Rights Only
M + S - Mining and Surface Rights

	Description	Order No.	Date	Disposition	File
R1	Sec. 36/80	W.1/84	16/3/84	M.O.S.	188540

SYMBOLS

Boundary
- Township, Meridian, Baseline
- Road allowance; surveyed
  - shoreline
- Lot/Concession; surveyed
  - unsurveyed
- Parcel; surveyed
  - unsurveyed
- Right-of-way; road
  - railway
  - utility
- Reservation
- Cliff, Pit, Pile
- Contour
  - interpolated
  - Approximate
  - Depression
- Control point (horizontal)
- Flooded land
- Mine head frame
- Pipeline (above ground)
- Railway; single track
  - double track
  - abandoned
- Road; highway, county, township
  - access
  - trail, bush
- Shoreline (original)
- Transmission line
- Wooded area

DISPOSITION OF CROWN LANDS

Patent
- Surface & Mining Rights
- Surface Rights Only
- Mining Rights Only

Lease
- Surface & Mining Rights
- Surface Rights Only
- Mining Rights Only

Licence of Occupation
Order-in-Council — OC
Cancelled
Reservation
Sand & Gravel

THE INFORMATION THAT APPEARS ON THIS MAP HAS BEEN COMPILED FROM VARIOUS SOURCES, AND ACCURACY IS NOT GUARANTEED. THOSE WISHING TO STAKE MINING CLAIMS SHOULD CONSULT WITH THE MINING RECORDER, MINISTRY OF NORTHERN DEVELOPMENT AND MINES, FOR ADDITIONAL INFORMATION ON THE STATUS OF THE LANDS SHOWN HEREON.

SURVEY
MINING RECORDER'S OFFICE

G-3415



Ministry of Natural Resources

Ministry of Northern Development and Mines

IN SERVICE FEBRUARY 10, 1989

INDEX TO LAND DISPOSITION

PLAN

G-3415

TOWNSHIP

CASSELS

M.N.R. ADMINISTRATIVE DISTRICT

TEMAGAMI

MINING DIVISION

SUDBURY

LAND TITLES/REGISTRY DIVISION

NIPISSING

Scale 1:20 000

1000 Metres 0 1000 2000 Metres

1000 Feet 0 1000 2000 3000 4000 5000 6000 7000 8000 9000 10 000 Feet

Contour Interval 10 Metres

SYMBOLS

Boundary
- Township, Meridian, Baseline
- Road allowance; surveyed
- shoreline
- Lot/Concession; surveyed
- unsurveyed
- Parcel; surveyed
- unsurveyed
- Right-of-way; road
- railway
- utility
- Reservation
- Cliff, Pit, Pile
- Contour
- interpolated
- Approximate
- Depression
- Control point (horizontal)
- Flooded land
- Mine head frame
- Pipeline (above ground)
- Railway; single track
- double track
- abandoned
- Road; highway, county, township
- access
- trail, bush
- Shoreline (original)
- Transmission line
- Wooded area

DISPOSITION OF CROWN LANDS

Patent
- Surface & Mining Rights
- Surface Rights Only
- Mining Rights Only

Lease
- Surface & Mining Rights
- Surface Rights Only
- Mining Rights Only

- Licence of Occupation
- Order-in-Council: OC
- Cancelled
- Reservation
- Sand & Gravel

AREAS WITHDRAWN FROM DISPOSITION

MRO - Mineral Only
SRO - Surface Rights Only
M+S - Mining and Surface Rights

Description	Order No.	Date	Disposition	Act
~~R2~~ ~~See 36/00~~	~~W-1-91/92-CR~~	~~18/3/92~~	~~M.R.S~~	~~M.N.R.~~
~~R3~~	~~W-1-91/92-CR~~	~~92/JAN/21~~	~~M.R.S~~	~~195150~~
R4	PENDING DISPOSITION UNDER THE PUBLIC LANDS ACT LAND NOT OPEN FOR STAKING SUB-SECTION 30(8) of the Mining Act R.S.O. 1990. Notice received 92/JAN/06			
R5	O-ONT-06/92 NER/CR	MAR.16/92	M & S	195150
R5	O-ONT-07/92 NER/CR	JUNE 1/92	M & S	195150

DATE OF ISSUE
JUL 3 - 1992
SUDBURY
MINING RECORDER'S OFFICE

THE INFORMATION THAT APPEARS ON THIS MAP HAS BEEN COMPILED FROM VARIOUS SOURCES, AND ACCURACY IS NOT GUARANTEED. THOSE WISHING TO STAKE MINING CLAIMS SHOULD CONSULT WITH THE MINING RECORDER, MINISTRY OF NORTHERN DEVELOPMENT AND MINES, FOR ADDITIONAL INFORMATION ON THE STATUS OF THE LANDS SHOWN HEREON.

Map base and land disposition drafting by Surveys and Mapping Branch, Ministry of Natural Resources.

The disposition of land, location of lot fabric and parcel boundaries on this index was compiled for administrative purposes only.

Ministry of Natural Resources

Ministry of Northern Development and Mines

IN SERVICE FEBRUARY 10, 1989

INDEX TO LAND DISPOSITION

PLAN

G-3415

TOWNSHIP

CASSELS

M.N.R. ADMINISTRATIVE DISTRICT

TEMAGAMI

MINING DIVISION

SUDBURY

LAND TITLES/REGISTRY DIVISION

NIPISSING

Scale 1:20 000

Metres 1000 0 1000 2000 Metres

Feet 1000 0 1000 2000 3000 4000 5000 6000 7000 8000 9000 1 000 Feet

Contour Interval 10 Metres

SYMBOLS

Boundary
- Township, Meridian, Baseline
- Road allowance; surveyed
- shoreline
- Lot/Concession; surveyed
- unsurveyed
- Parcel; surveyed
- unsurveyed
- Right-of-way; road
- railway
- utility
- Reservation
- Cliff, Pit, Pile
- Contour
- Interpolated
- Approximate
- Depression
- Control point (horizontal)
- Flooded land
- Mine head frame
- Pipeline (above ground)
- Railway; single track
- double track
- abandoned
- Road; highway, county, township
- access
- trail, bush
- Shoreline (original)
- Transmission line
- Wooded area

DISPOSITION OF CROWN LANDS

Patent
- Surface & Mining Rights
- Surface Rights Only
- Mining Rights Only

Lease
- Surface & Mining Rights
- Surface Rights Only
- Mining Rights Only

Licence of Occupation

Order-in-Council — OC

Cancelled

Reservation

Sand & Gravel

AREAS WITHDRAWN FROM DISPOSITION

MRO - Mining Rights Only
SRO - Surface Rights Only
M+S - Mining and Surface Rights

	Description	Order No.	Date	Disposition	Ref.
~~M~~	~~Sec.35/FC~~	~~W-484~~	~~16/3/84~~	~~M.N.R.~~	~~L 5545~~
~~RS~~		~~W-S-01182-CR~~	~~92/JAN/17~~	~~M.N.R.~~	~~195150~~
RS	PENDING DISPOSITION UNDER THE PUBLIC LANDS ACT LAND NOT OPEN FOR STAKING SUB-SECTION 30(8) of the Mining Act R.S.O. 1990 Notice received 92/JAN/06				
RS	O-ONT-06/92 NER/CR	MAR.16/92	M & S	195150	
RS	O-ONT-07/92 NER/CR	JUNE 11/92	M & S	195150	

DATE OF ISSUE
DEC 2 9 1993
SUDBURY
MINING RECORDER'S OFFICE

THE INFORMATION THAT APPEARS ON THIS MAP HAS BEEN COMPILED FROM VARIOUS SOURCES, AND ACCURACY IS NOT GUARANTEED. THOSE WISHING TO STAKE MINING CLAIMS SHOULD CONSULT WITH THE MINING RECORDER, MINISTRY OF NORTHERN DEVELOPMENT AND MINES, FOR ADDITIONAL INFORMATION ON THE STATUS OF THE LANDS SHOWN HEREON.

Map base and land disposition drafting by Surveys and Mapping Branch, Ministry of Natural Resources.

The disposition of land, location of lot fabric and parcel boundaries on this index was compiled for administrative purposes only.

Ministry of Natural Resources
Ministry of Northern Development and Mines

IN SERVICE FEBRUARY 10, 1989

INDEX TO LAND DISPOSITION

PLAN
G-3415

TOWNSHIP
CASSELS

M.N.R. ADMINISTRATIVE DISTRICT
TEMAGAMI

MINING DIVISION
SUDBURY

LAND TITLES/REGISTRY DIVISION
NIPISSING

Scale 1:20 000

1000 Metres 0 1000 2000 Metres

1000 0 1000 2000 3000 4000 5000 6000 7000 8000 9000 1 000 Feet

Contour Interval 10 Metres

SYMBOLS

Boundary
- Township, Meridian, Baseline
- Road allowance; surveyed
- shoreline
- Lot/Concession; surveyed
- unsurveyed
- Parcel; surveyed
- unsurveyed
- Right-of-way; road
- railway
- utility
- Reservation
- Cliff, Pit, Pile
- Contour — 20 —
- Interpolated
- Approximate
- Depression
- Control point (horizontal) △
- Flooded land
- Mine head frame
- Pipeline (above ground)
- Railway, single track
- double track
- abandoned
- Road; highway, county, township
- access
- trail, bush
- Shoreline (original)
- Transmission line
- Wooded area

DISPOSITION OF CROWN LANDS

Patent
- Surface & Mining Rights
- Surface Rights Only
- Mining Rights Only

Lease
- Surface & Mining Rights
- Surface Rights Only
- Mining Rights Only
- Licence of Occupation
- Order-in-Council OC
- Cancelled
- Reservation
- Sand & Gravel

AREAS WITHDRAWN FROM DISPOSITION

MRO - Mining Rights Only
SRO - Surface Rights Only
M + S - Mining and Surface Rights

	Description	Order no.	Date	Disposition	
~~PW~~	~~Sec. 35/92~~	~~O-350/92 CR~~	~~JAN/92~~	~~M.R.O.~~	~~49541~~
RO	O-ONT-06/92 NER/CR O-ONT-07/92 NER/CR	JUNE/92 JUNE/92	M & S M & S	49550 49550
RO	PENDING DISPOSITION UNDER THE PUBLIC LANDS ACT LAND NOT OPEN FOR STAKING SUB-SECTION 30(8) of the Mining Act R.S.O. 1990 Notice received 92/JAN/06				

DATE OF ISSUE
FEB 1 1994
SUDBURY
MINING RECORDER'S OFFICE

THE INFORMATION THAT APPEARS ON THIS MAP HAS BEEN COMPILED FROM VARIOUS SOURCES, AND ACCURACY IS NOT GUARANTEED. THOSE WISHING TO STAKE MINING CLAIMS SHOULD CONSULT WITH THE MINING RECORDER, MINISTRY OF NORTHERN DEVELOPMENT AND MINES, FOR ADDITIONAL INFORMATION ON THE STATUS OF THE LANDS SHOWN HEREON.

Map base and land disposition drafting by Surveys and Mapping Branch, Ministry of Natural Resources.

The disposition of land, location of lot fabric and parcel boundaries on this index was compiled for administrative purposes only.

Ministry of Natural Resources
Ontario

Ministry of Northern Development and Mines

INDEX TO LAND DISPOSITION


PLAN
G-3415

TOWNSHIP
CASSELS

M.N.R. ADMINISTRATIVE DISTRICT
TEMAGAMI
MINING DIVISION
SUDBURY
LAND TITLES/REGISTRY DIVISION
NIPISSING

Scale 1:20 000

Contour Interval 10 Metres

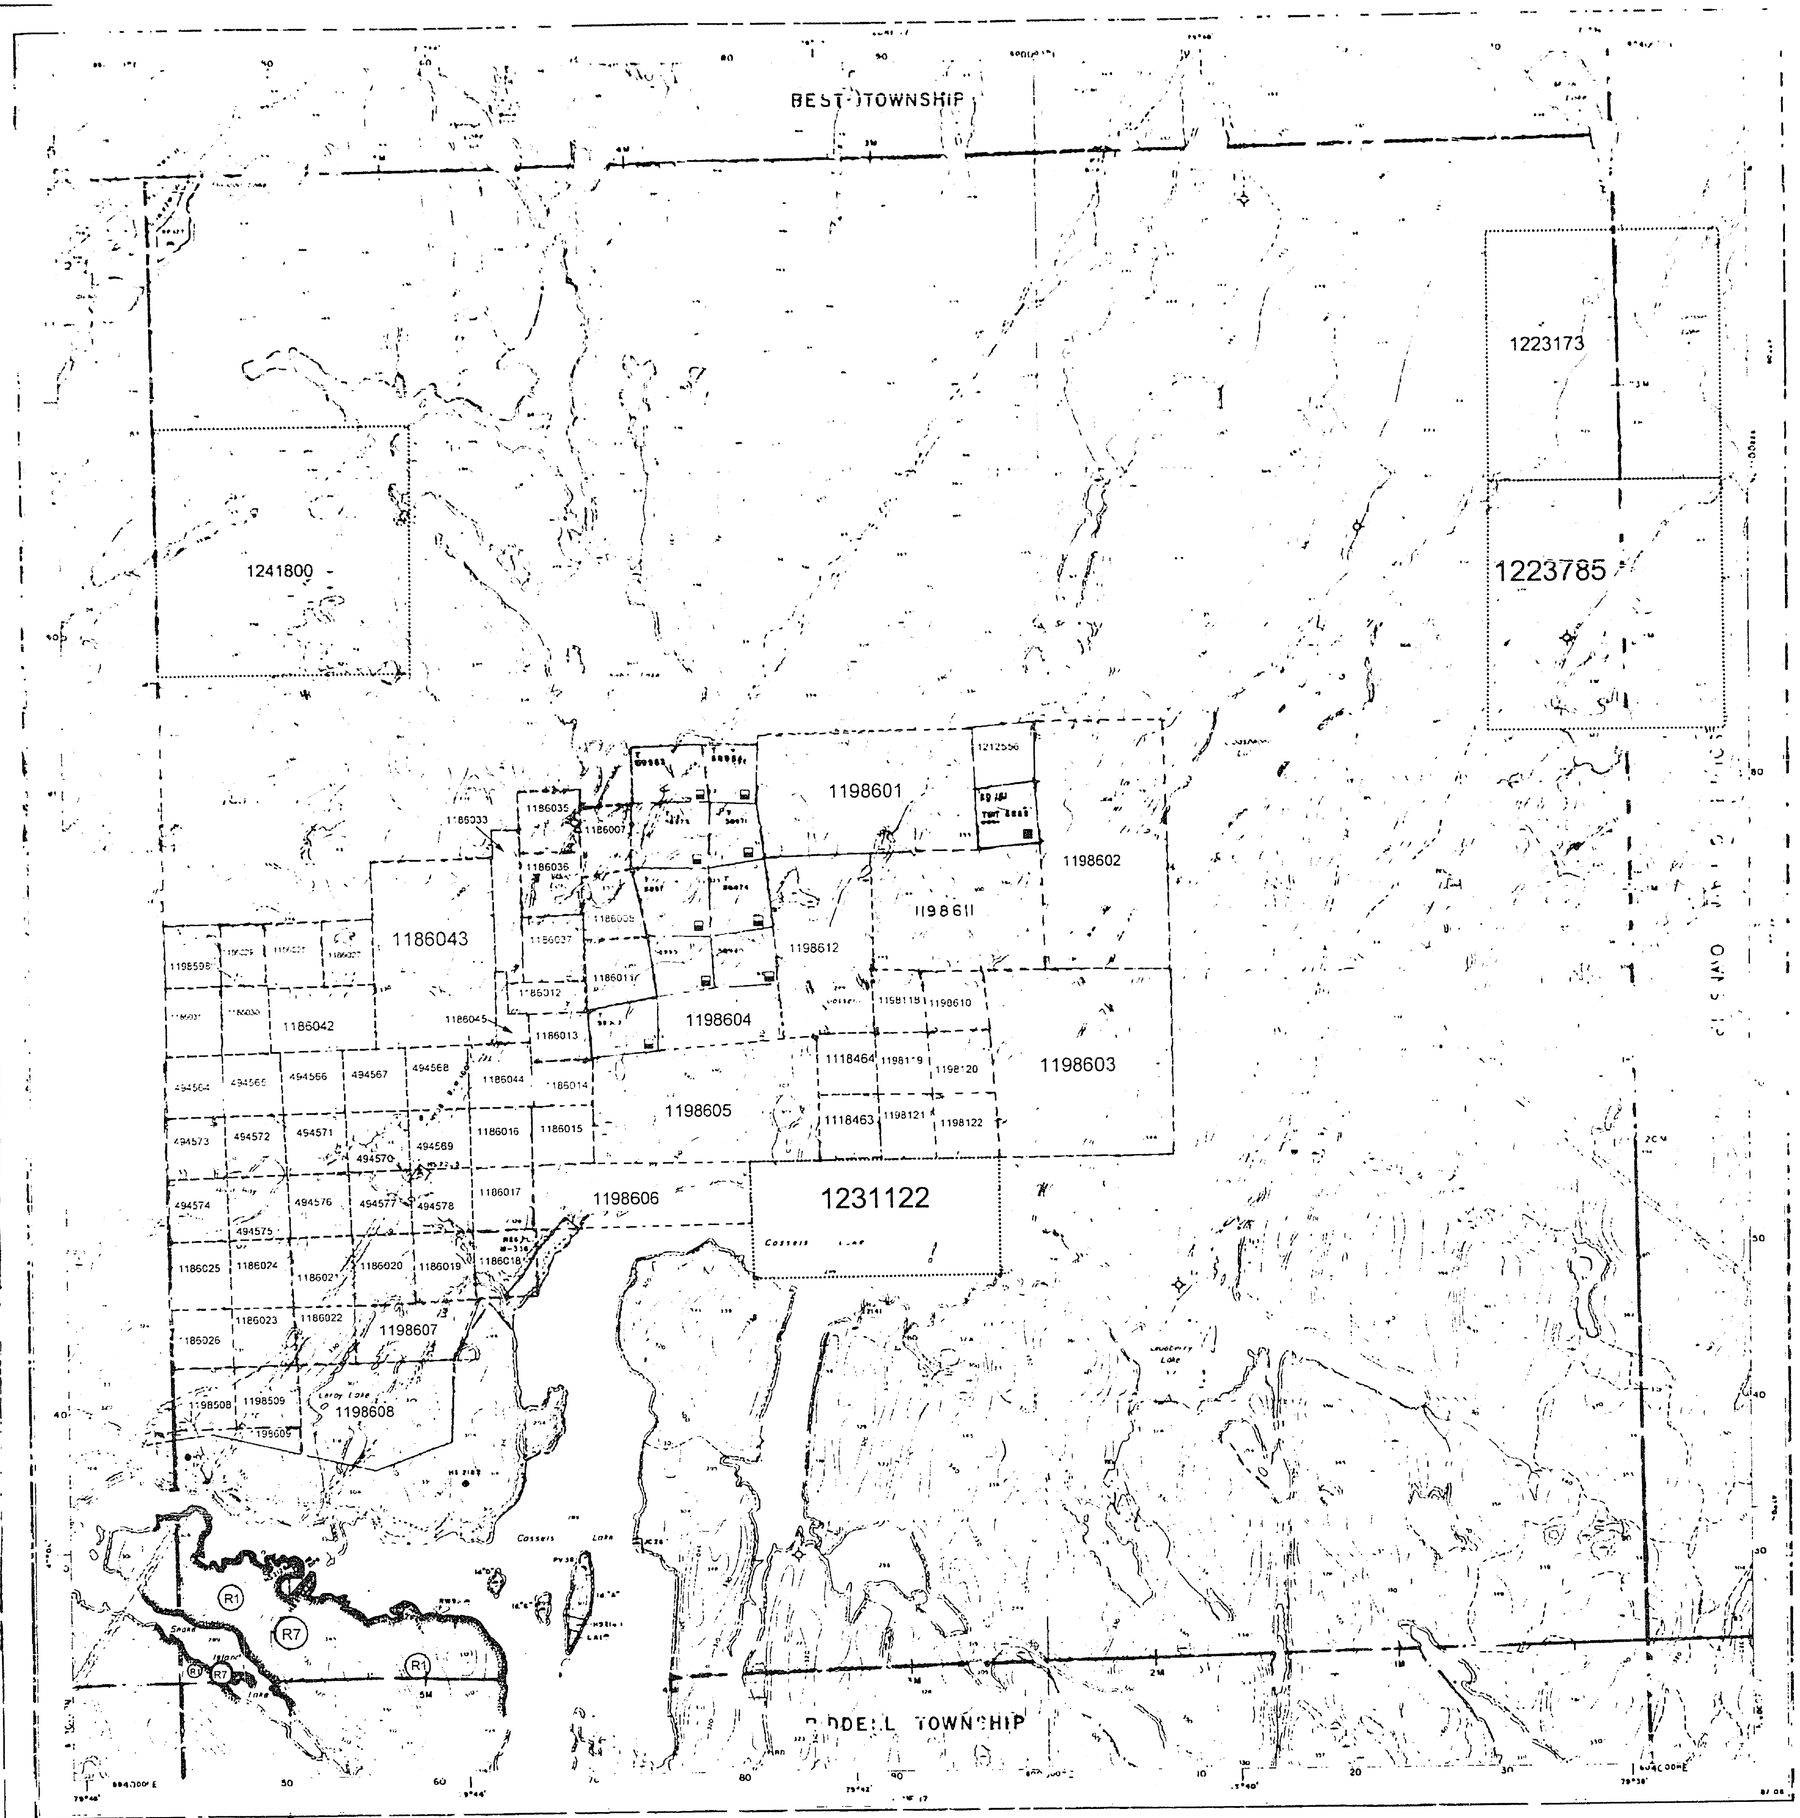

AREAS WITHDRAWN FROM DISPOSTION

M.R.O. - MINING RIGHTS ONLY
S.R.O. - SURFACE RIGHTS ONLY
M.+S. - MINING AND SURFACE RIGHTS

Description	Order No.	Date	Disposition	File
R1	NOT OPEN FOR STAKING - CONSERVATION RESERVE SECTION 1 OF THE MINING ACT			
R7	SEC 35(9)	05/12/96	99/12/96	M & S

SYMBOLS

Boundary
- Township, Meridian, Baseline
- Road allowance; surveyed
  - shoreline
- Lot/Concession; surveyed
  - unsurveyed
- Parcel; surveyed
  - unsurveyed
- Right-of-way; road
  - railway
  - utility
- Reservation
- Cliff, Pit, Pile
- Contour
  - interpolated
  - Approximate
  - Depression
- Control point (horizontal)
- Flooded land
- Mine head frame
- Pipeline (above ground)
- Railway; single track
  - double track
  - abandoned
- Road, highway, county, township
  - access
  - trail, bush
- Shoreline (original)
- Transmission line
- Wooded area

DISPOSITION OF CROWN LANDS

Patent
- Surface & Mining Rights
- Surface Rights Only
- Mining Rights Only

Lease
- Surface & Mining Rights
- Surface Rights Only
- Mining Rights Only

Licence of Occupation
Order-in-Council — OC
Cancelled
Reservation — R
Sand & Gravel — G
LAND USE PERMIT

JUNE 1, 1996 OPENINGS TR 2486
TRT 5658

THIS TOWNSHIP FALLS WITHIN THE TEMAGAMI COMPREHENSIVE PLANNING AREA. SPECIAL WORKING CONDITIONS MAY APPLY TO EXPLORATION ACTIVITIES FOR MORE DETAILS PLEASE CONTACT:
DISTRICT MANAGER,
NORTH BAY DISTRICT
MINISTRY, NATURAL RESOURCES

THE INFORMATION THAT APPEARS ON THIS MAP HAS BEEN COMPILED FROM VARIOUS SOURCES, AND ACCURACY IS NOT GUARANTEED. THOSE WISHING TO STAKE MINING CLAIMS SHOULD CONSULT WITH THE MINING RECORDER MINISTRY OF NORTHERN DEVELOPMENT AND MINES. FOR ADDITIONAL INFORMATION ON THE STATUS OF THE LANDS SHOWN HEREON.

Map base and land disposition drafting by Survey and Mapping Branch, Ministry of Natural Resources

The disposition of land, location of lot fabric and parcel boundaries on this index was compiled for administrative purposes only.