M-944

CREELMAN TWP.

SEP 7

VI

V

IV

TWP.

KITCHENER

TWP.

PARKIN

WISNER TWP.

12 11 10 9 8 7 6 5 4 3 2 1

THE TOWNSHIP OF

HUTTON

DISTRICT OF SUDBURY

SUDBURY MINING DIVISION

SCALE: 1-INCH=40 CHAINS

LEGEND

PATENTED LAND	(P)
CROWN LAND SALE	C.S.
LEASES	(L)
LOCATED LAND	Loc.
LICENSE OF OCCUPATION	L.O.
MINING RIGHTS ONLY	M.R.O
SURFACE RIGHTS ONLY	S.R.O.
ROADS	
IMPROVED ROADS	
KING'S HIGHWAYS	
RAILWAYS	
POWER LINES	
MARSH OR MUSKEG	
MINES	
CANCELLED	C.

NOTES

400' Surface Rights Reservation around all lakes and rivers.

Lots 1 to 6, concessions 1 to 6 may be staked in the same manner as mining claims in unsurveyed territory. May 16, 1946 — File 83.5 — Mining Act Sec. 53 (52 A 1946).

Land required for railway purposes shown thus: Files 4826 & 4841.

Dept. of Highways' gravel pits shown thus: In good Standing

Parts of the subdivision shown thus: are annulled under the authority of the Minister of Lands & Forests.

HUTTON

PLAN NO.- M-944

ONTARIO

MINISTRY OF NATURAL RESOURCES

SURVEYS AND MAPPING BRANCH

944

CREELMAN TWP. M.737

KITCHENER TWP. M.973

PARKIN TWP. M.1049

WISNER TWP. M.1185

VI

V

IV

12 11 10 9 8 7 6 5 4 3 2 1

THE TOWNSHIP OF HUTTON

DISTRICT OF SUDBURY

SUDBURY MINING DIVISION

SCALE: 1-INCH=40 CHAINS

LEGEND

PATENTED LAND	Ⓟ
CROWN LAND SALE	C.S.
LEASES	Ⓛ
LOCATED LAND	Loc.
LICENSE OF OCCUPATION	L.O.
MINING RIGHTS ONLY	M.R.O.
SURFACE RIGHTS ONLY	S.R.O.
ROADS	
IMPROVED ROADS	
KING'S HIGHWAYS	
RAILWAYS	
POWER LINES	
MARSH OR MUSKEG	
MINES	
CANCELLED	C.

NOTES

400' Surface Rights Reservation along the shores of all lakes and rivers.

Lots 1 to 6, concessions 1 to 6 may be staked in the same manner as mining claims in unsurveyed territory. May 16, 1946 — File 83.5 — Mining Act Sec. 53 (52 A 1946).

Land required for railway purposes shown thus:

Files 4826 & 4841.

Parts of Con. 1, 2, 4, 5 B6: Subdivision Annulled.

M.T.C. Gravel pits shown thus: IN GOOD STANDING

DATE OF ISSUE OCT 31 1974

HUTTON

PLAN NO.- M-944

ONTARIO

MINISTRY OF NATURAL RESOURCES

SURVEYS AND MAPPING BRANCH

CREELMAN TWP. M.737

KITCHENER TWP. M.973

PARKIN TWP. M.1049


WISNER TWP. M.1185

VI

V

IV

12 11 10 9 8 7 6 5 4 3 2 1

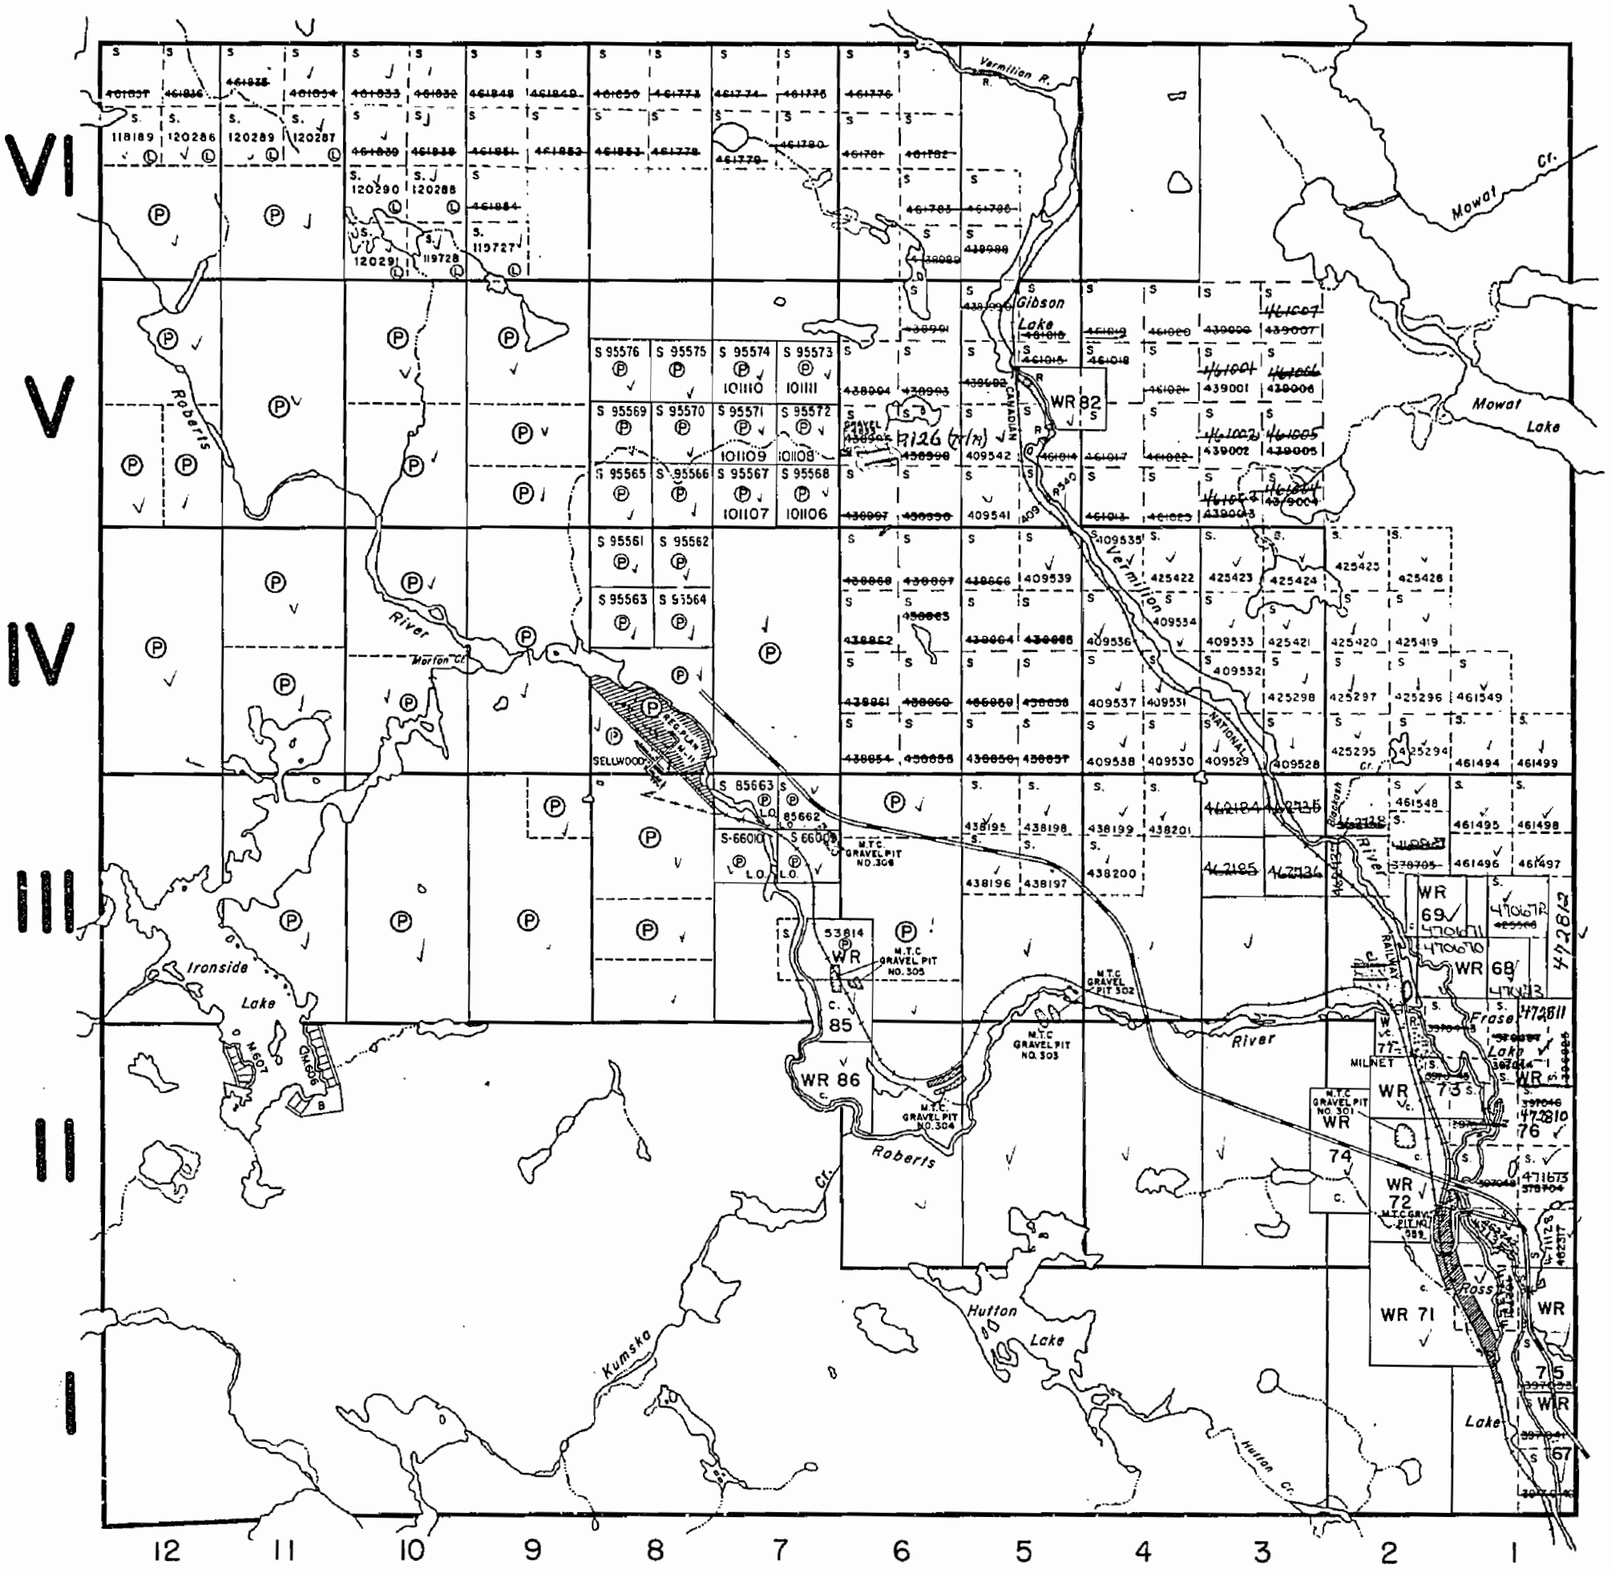

THE TOWNSHIP OF HUTTON

DISTRICT OF SUDBURY

SUDBURY MINING DIVISION

SCALE: 1-INCH=40 CHAINS

LEGEND

PATENTED LAND	(P)
CROWN LAND SALE	C.S.
LEASES	(L)
LOCATED LAND	Loc.
LICENSE OF OCCUPATION	L.O.
MINING RIGHTS ONLY	M.R.O.
SURFACE RIGHTS ONLY	S.R.O.
ROADS	
IMPROVED ROADS	
KING'S HIGHWAYS	
RAILWAYS	
POWER LINES	
MARSH OR MUSKEG	
MINES	C.
CANCELLED	

NOTES

400' Surface Rights Reservation along the shores of all lakes and rivers.

Lots 1 to 6, concessions 1 to 6 may be staked in the same manner as mining claims in unsurveyed territory. May 16, 1946 — File 83.5 — Mining Act Sec. 53 (52 A 1946).

Land required for railway purposes shown thus:

Files 4826 & 4841.

Parts of Con. 1, 2, 4, 5 & 6: Subdivision Annulled.

DATE OF ISSUE AUG 3 - 1976

HUTTON

PLAN NO.- M-944

ONTARIO

MINISTRY OF NATURAL RESOURCES

SURVEYS AND MAPPING BRANCH

CREELMAN TWP. M.737

KITCHENER TWP. M.973

PARKIN TWP. M.1049

WISNER TWP. M.1185

VI

V


IV

III

II

I

12 11 10 9 8 7 6 5 4 3 2 1

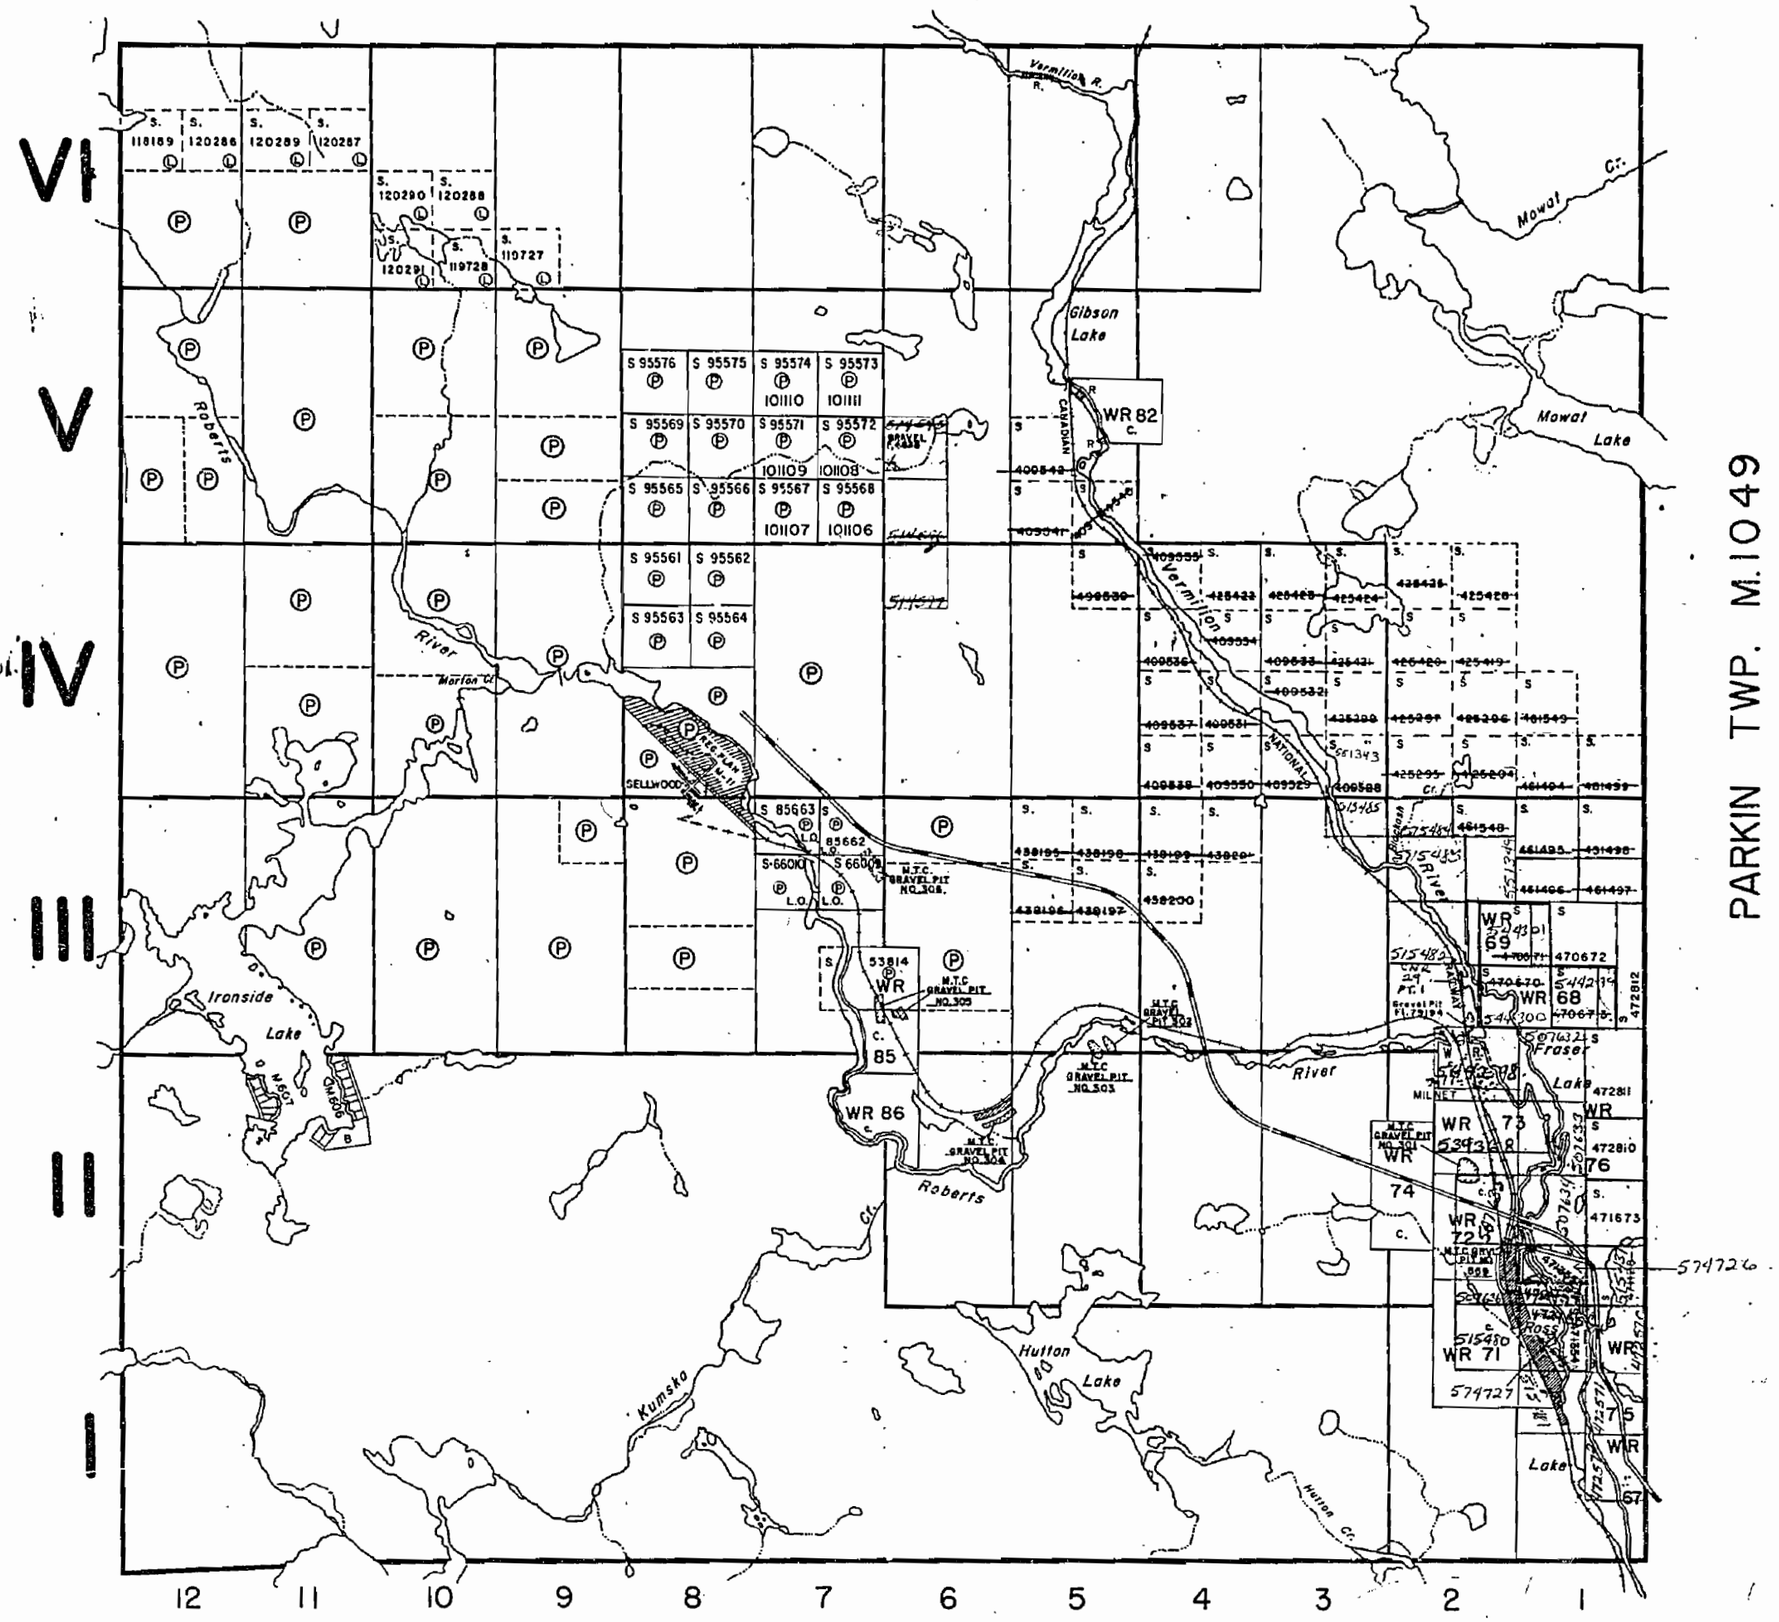

THE TOWNSHIP OF

HUTTON

DISTRICT OF SUDBURY

SUDBURY MINING DIVISION

SCALE: 1-INCH=40 CHAINS

LEGEND

PATENTED LAND	(P)
CROWN LAND SALE	C.S.
LEASES	(L)
LOCATED LAND	Loc.
LICENSE OF OCCUPATION	L.O.
MINING RIGHTS ONLY	M.R.O.
SURFACE RIGHTS ONLY	S.R.O.
ROADS	
IMPROVED ROADS	
KING'S HIGHWAYS	
RAILWAYS	
POWER LINES	
MARSH OR MUSKEG	
MINES	
CANCELLED	C.

NOTES

400' Surface Rights Reservation along the shores of all lakes and rivers.

Lots 1 to 6, concessions 1 to 6 may be staked in the same manner as mining claims in unsurveyed territory. May 16, 1946 — File 83.5 — Mining Act Sec.53 (52 A 1946).

Land required for railway purposes shown thus:

Files 4826 & 4841:

Parts of Con.1,2,4,5 & 6: Subdivision Annulled.

DATE OF ISSUE
JUN 2 1978

HUTTON

PLAN NO.- M-944

ONTARIO
MINISTRY OF NATURAL RESOURCES
SURVEYS AND MAPPING BRANCH

TRIM LINE

OFFICE USE ONLY

44e.M

Location CNR 65
Part 1 Plan 53R-9711
being Part of W.R.71.

CREELMAN TWP. M.737

KITCHENER TWP. M.973

PARKIN TWP. M.1049

WISNER TWP. M.1185

VI
V
IV
III
II
I

12 11 10 9 8 7 6 5 4 3 2 1

Vermilion R.
Gibson Lake
Mowat
Mowat Lake
Roberts
River
Morton Cr.
Vermilion River
Ironside Lake
Hutton Lake
Kumsko
Hutton Cr.
Milnet Lake
CANADIAN NATIONAL
SELLWOOD
WR 82
WR 86
WR 69
WR 68
WR 73
WR 74
WR 72
WR 71
M.T.C. GRAVEL PIT NO. 306
M.T.C. GRAVEL PIT NO. 305
M.T.C. GRAVEL PIT NO. 304
M.T.C. GRAVEL PIT NO. 303
M.T.C. GRAVEL PIT NO. 302
M.T.C. GRAVEL PIT NO. 301
M.T.C. GRAVEL PIT NO. 309

THE TOWNSHIP OF

HUTTON

DISTRICT OF SUDBURY

SUDBURY MINING DIVISION

SCALE: 1-INCH=40 CHAINS

LEGEND

PATENTED LAND	● or Ⓟ
CROWN LAND SALE	C.S.
LEASES	Ⓛ
LOCATED LAND	Loc.
LICENSE OF OCCUPATION	L.O.
MINING RIGHTS ONLY	M.R.O.
SURFACE RIGHTS ONLY	S.R.O.
ROADS	
IMPROVED ROADS	
KING'S HIGHWAYS	
RAILWAYS	
POWER LINES	
MARSH OR MUSKEG	
MINES	
CANCELLED	

NOTES

400' Surface Rights Reservation along the shores of all lakes and rivers.

Lots 1 to 6, concessions 1 to 6 may be staked in the same manner as mining claims in unsurveyed territory. May 16, 1946 – File 83.5 – Mining Act Sec. 53 (52 A 1946).

Land required for railway purposes shown thus:

Files 4826 4841

Parts of Con 1, 2, 4, 5 & 6 Subdivision Annulled.

DATE OF ISSUE NOV 12 1981

SAND AND GRAVEL

Ⓠ QUARRY PERMIT

HUTTON

PLAN NO.- M-944

ONTARIO

MINISTRY OF NATURAL RESOURCES

SURVEYS AND MAPPING BRANCH

Information transferred to Mylar June 21/83 - KM

TRIM LINE

44e.M

TRIM LINE

44e.M

+ Location CNR 65 Part 1 Plan 53R-9919 being Part of W.R. 71

CREELMAN TWP. M.737

KITCHENER TWP. M.973

PARKIN TWP. M.1049

WISNER TWP. M.1185

VI

V

IV

III

II

I

12 11 10 9 8 7 6 5 4 3 2 1

Vermilion R.

Gibson Lake

Mowat

Mowat Lake

Roberts

Marion Cr.

River

Vermilion River

Ironside Lake

Kumsko Lake

Hutton Lake

Hutton Cr.

Boston Cr.

Fraser Lake

Cross Lake

Gravel Pit Pl.73194

WR 82 C.

WR 86

WR 69

WR 68

WR 73

WR 74

WR 72

*WR 71

WR 76

WR 75

WR 67

M.T.C. GRAVEL PIT NO.306

M.T.C. GRAVEL PIT NO.305

M.T.C. GRAVEL PIT NO.303

M.T.C. GRAVEL PIT NO.304

M.T.C. GRAVEL PIT NO.301

M.T.C. GRAVEL PIT NO.302

SELLWOOD

MILNET

CANADIAN NATIONAL RAILWAY

THE TOWNSHIP OF

HUTTON

DISTRICT OF SUDBURY

SUDBURY MINING DIVISION

SCALE: 1-INCH=40 CHAINS

LEGEND

PATENTED LAND	● or (P)
CROWN LAND SALE	C.S.
LEASES	(L)
LOCATED LAND	Loc.
LICENSE OF OCCUPATION	L.O.
MINING RIGHTS ONLY	M.R.O.
SURFACE RIGHTS ONLY	S.R.O.
ROADS	
IMPROVED ROADS	
KING'S HIGHWAYS	
RAILWAYS	
POWER LINES	
MARSH OR MUSKEG	
MINES	
CANCELLED	

NOTES

400' Surface Rights Reservation along the shores of all lakes and rivers.

Lots 1 to 6, concessions 1 to 6 may be staked in the same manner as mining claims in unsurveyed territory. May 16, 1946 — File 83.5 — Mining Act Sec. 53 (52 A 1946).

Land required for railway purposes shown thus: ▨

Files 4826 & 4841.

Parts of Con. 1, 2, 4, 5 & 6: Subdivision Annulled.

* Updated 1983 05 21 - VCM

SAND AND GRAVEL

(G) QUARRY PERMIT

PLAN NO.- M-944

ONTARIO

MINISTRY OF NATURAL RESOURCES

SURVEYS AND MAPPING BRANCH

HUTTON

TRIM LINE

* Updated From Linen June 21/83 KM

44e.M

44e.M

TRIM LINE


* Aug. 5/83

CREELMAN TWP. M.737

KITCHENER TWP. M.973

PARKIN TWP. M.1049

WISNER TWP. M.1185

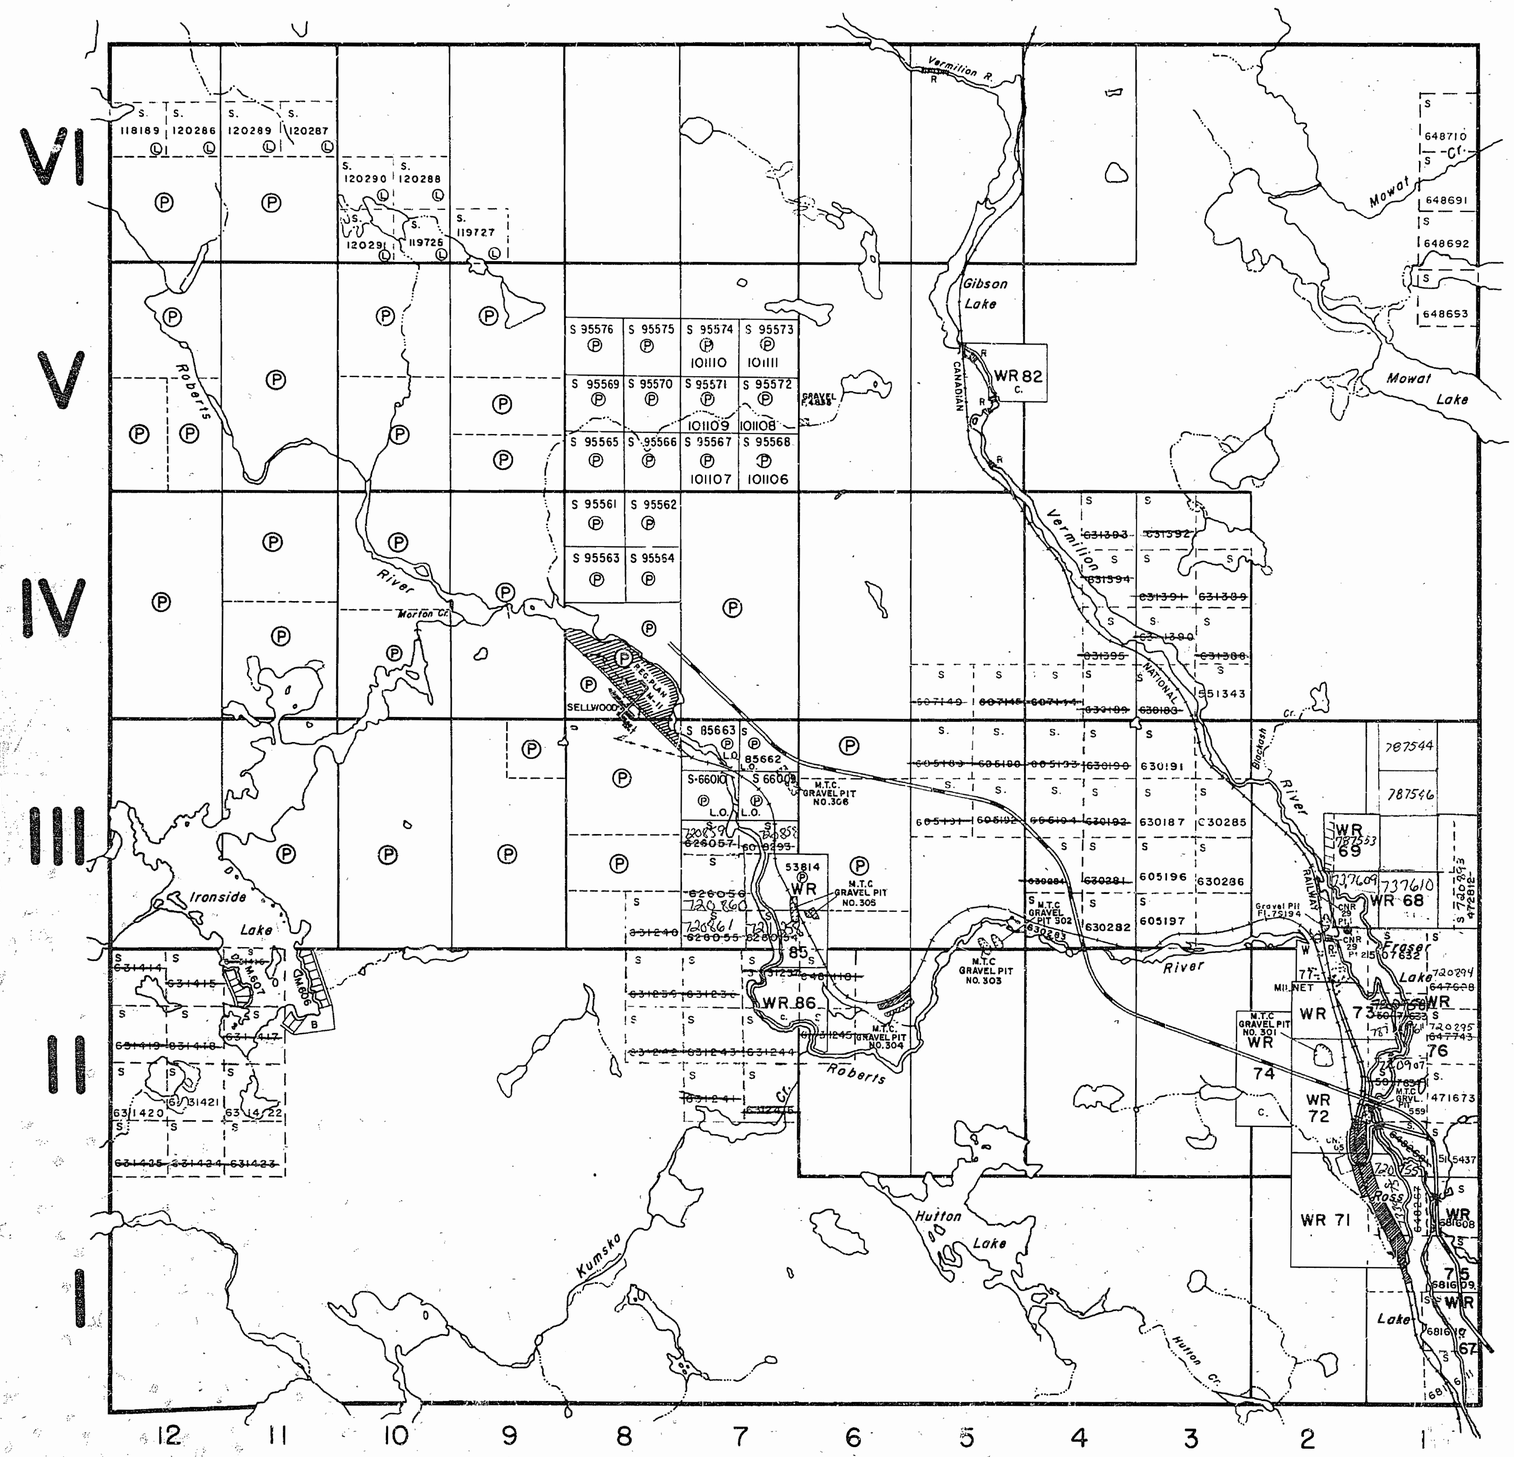

THE TOWNSHIP OF

HUTTON

DISTRICT OF SUDBURY

SUDBURY MINING DIVISION

SCALE: 1-INCH=40 CHAINS

LEGEND

PATENTED LAND	● or (P)
CROWN LAND SALE	C.S.
LEASES	(L)
LOCATED LAND	Loc.
LICENSE OF OCCUPATION	L.O.
MINING RIGHTS ONLY	M.R.O.
SURFACE RIGHTS ONLY	S.R.O.
ROADS	
IMPROVED ROADS	
KING'S HIGHWAYS	
RAILWAYS	
POWER LINES	
MARSH OR MUSKEG	
MINES	
CANCELLED	

NOTES

400' Surface Rights Reservation along the shores of all lakes and rivers.

Lots 1 to 6, concessions 1 to 6 may be staked in the same manner as mining claims in unsurveyed territory. May 16, 1946 — File 83.5 — Mining Act ~~Sec.53~~ SEC. 45 (52 A 1946). CMAP 268, RSD 1980

Land required for railway purposes shown thus: ▬▬▬

Files 4826 & 4841.

Parts of Con. 1,2,4,5 & 6: Subdivision Annulled.

* IN SERVICE 1983 08 05 - VM

SAND AND GRAVEL

(G) QUARRY PERMIT

HUTTON

PLAN NO. M-944

ONTARIO

MINISTRY OF NATURAL RESOURCES

SURVEYS AND MAPPING BRANCH

44e.M

TRIM LINE

TRIM LINE

44e.M

* Aug. 5/83

CREELMAN TWP. M.737

KITCHENER TWP. M.973

PARKIN TWP. M.1049

WISNER TWP. M.1185

VI

V


IV

III

II

I

12 11 10 9 8 7 6 5 4 3 2 1

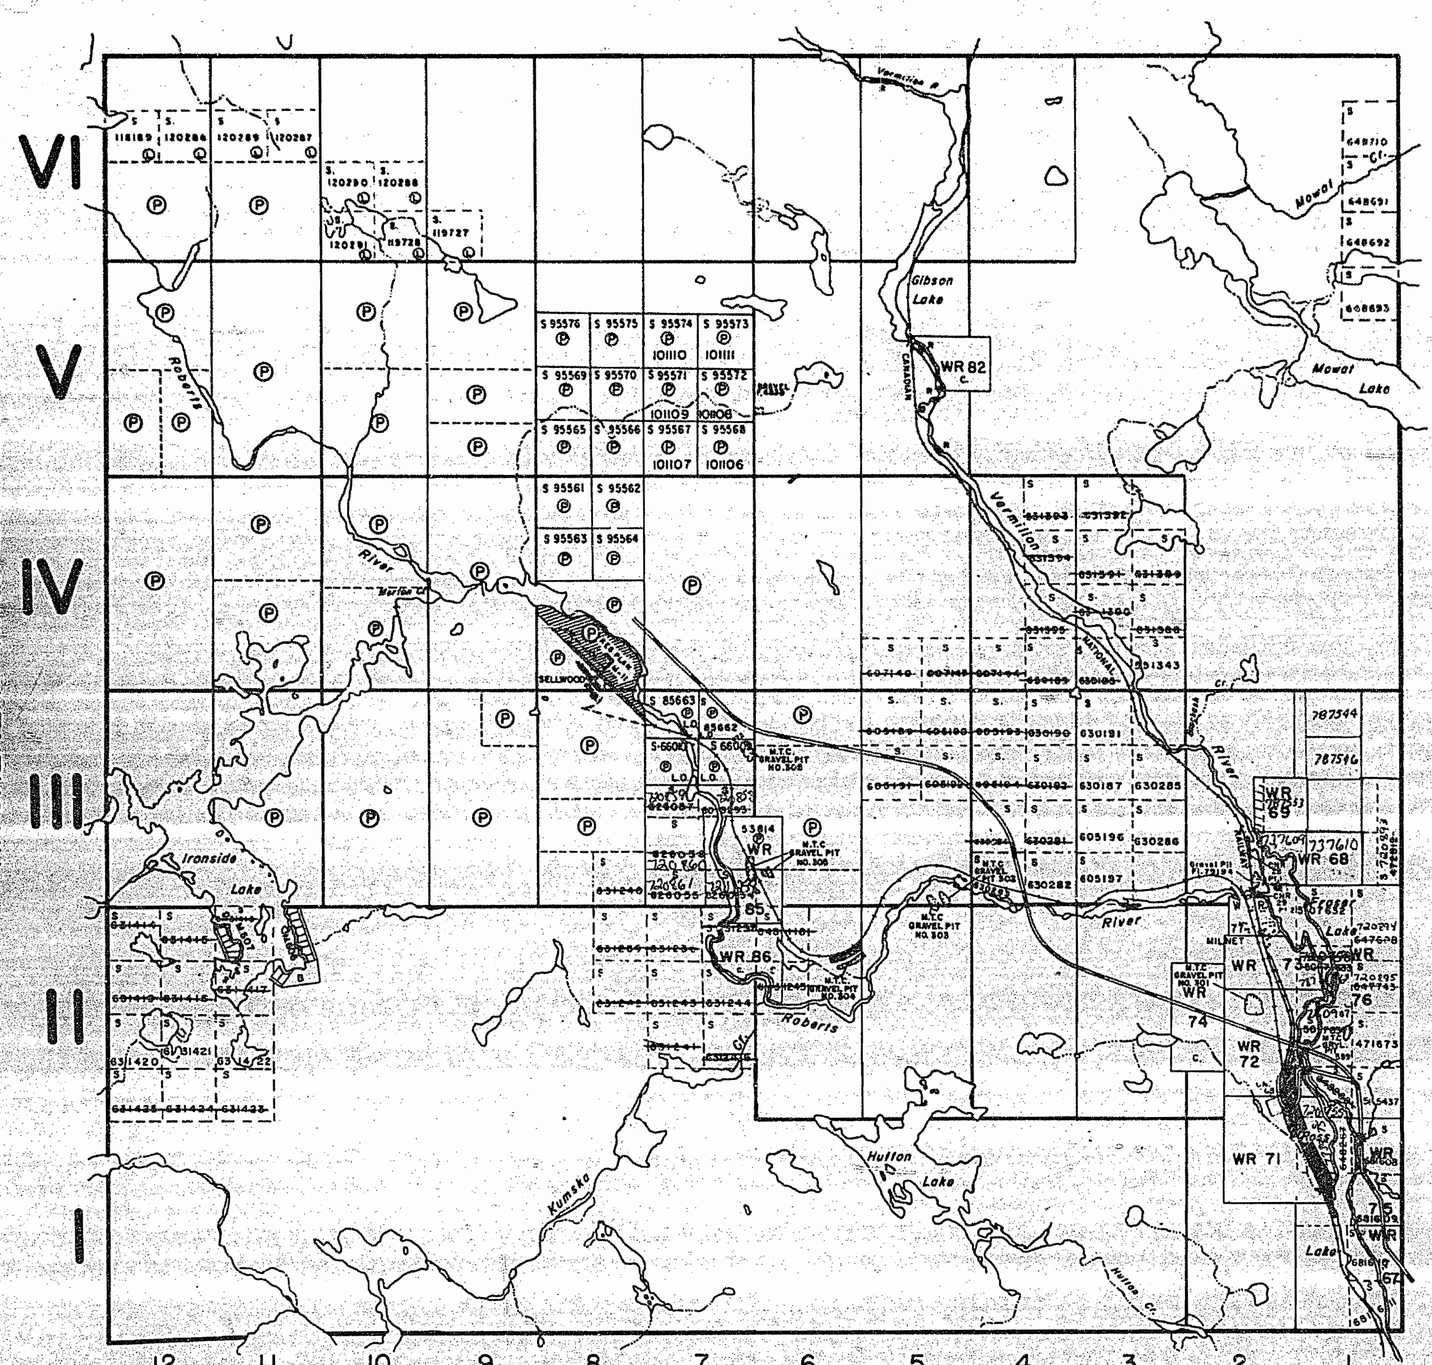

THE TOWNSHIP OF

HUTTON

DISTRICT OF SUDBURY

SUDBURY MINING DIVISION

SCALE: 1-INCH=40 CHAINS

LEGEND

PATENTED LAND	● or Ⓟ
CROWN LAND SALE	C.S.
LEASES	Ⓛ
LOCATED LAND	L.C.
LICENSE OF OCCUPATION	L.O.
MINING RIGHTS ONLY	M.R.O.
SURFACE RIGHTS ONLY	S.R.O.
ROADS	
IMPROVED ROADS	
KING'S HIGHWAYS	
RAILWAYS	
POWER LINES	
MARSH OR MUSKEG	
MINES	
CANCELLED	

NOTES

400' Surface Rights Reservation along the shores of all lakes and rivers.

Lots 1 to 6, concessions 1 to 6 may be staked in the same manner as mining claims in unsurveyed territory. May 16, 1946 — File 83.5 — Mining Act Sec. 55 (52 A 1946). SEC 45 CHAP 268 RSO 1980

Land required for railway purposes shown thus:

Files 4826 & 4841.

Parts of Con. 1,2,4,5 B6: Subdivision Annulled.

* INSERTED 1983 08 05 - VM

SAND AND GRAVEL

Ⓠ QUARRY PERMIT

HUTTON

PLAN NO.- M-944


ONTARIO

MINISTRY OF NATURAL RESOURCES

SURVEYS AND MAPPING BRANCH

44e.M

TRIM LINE

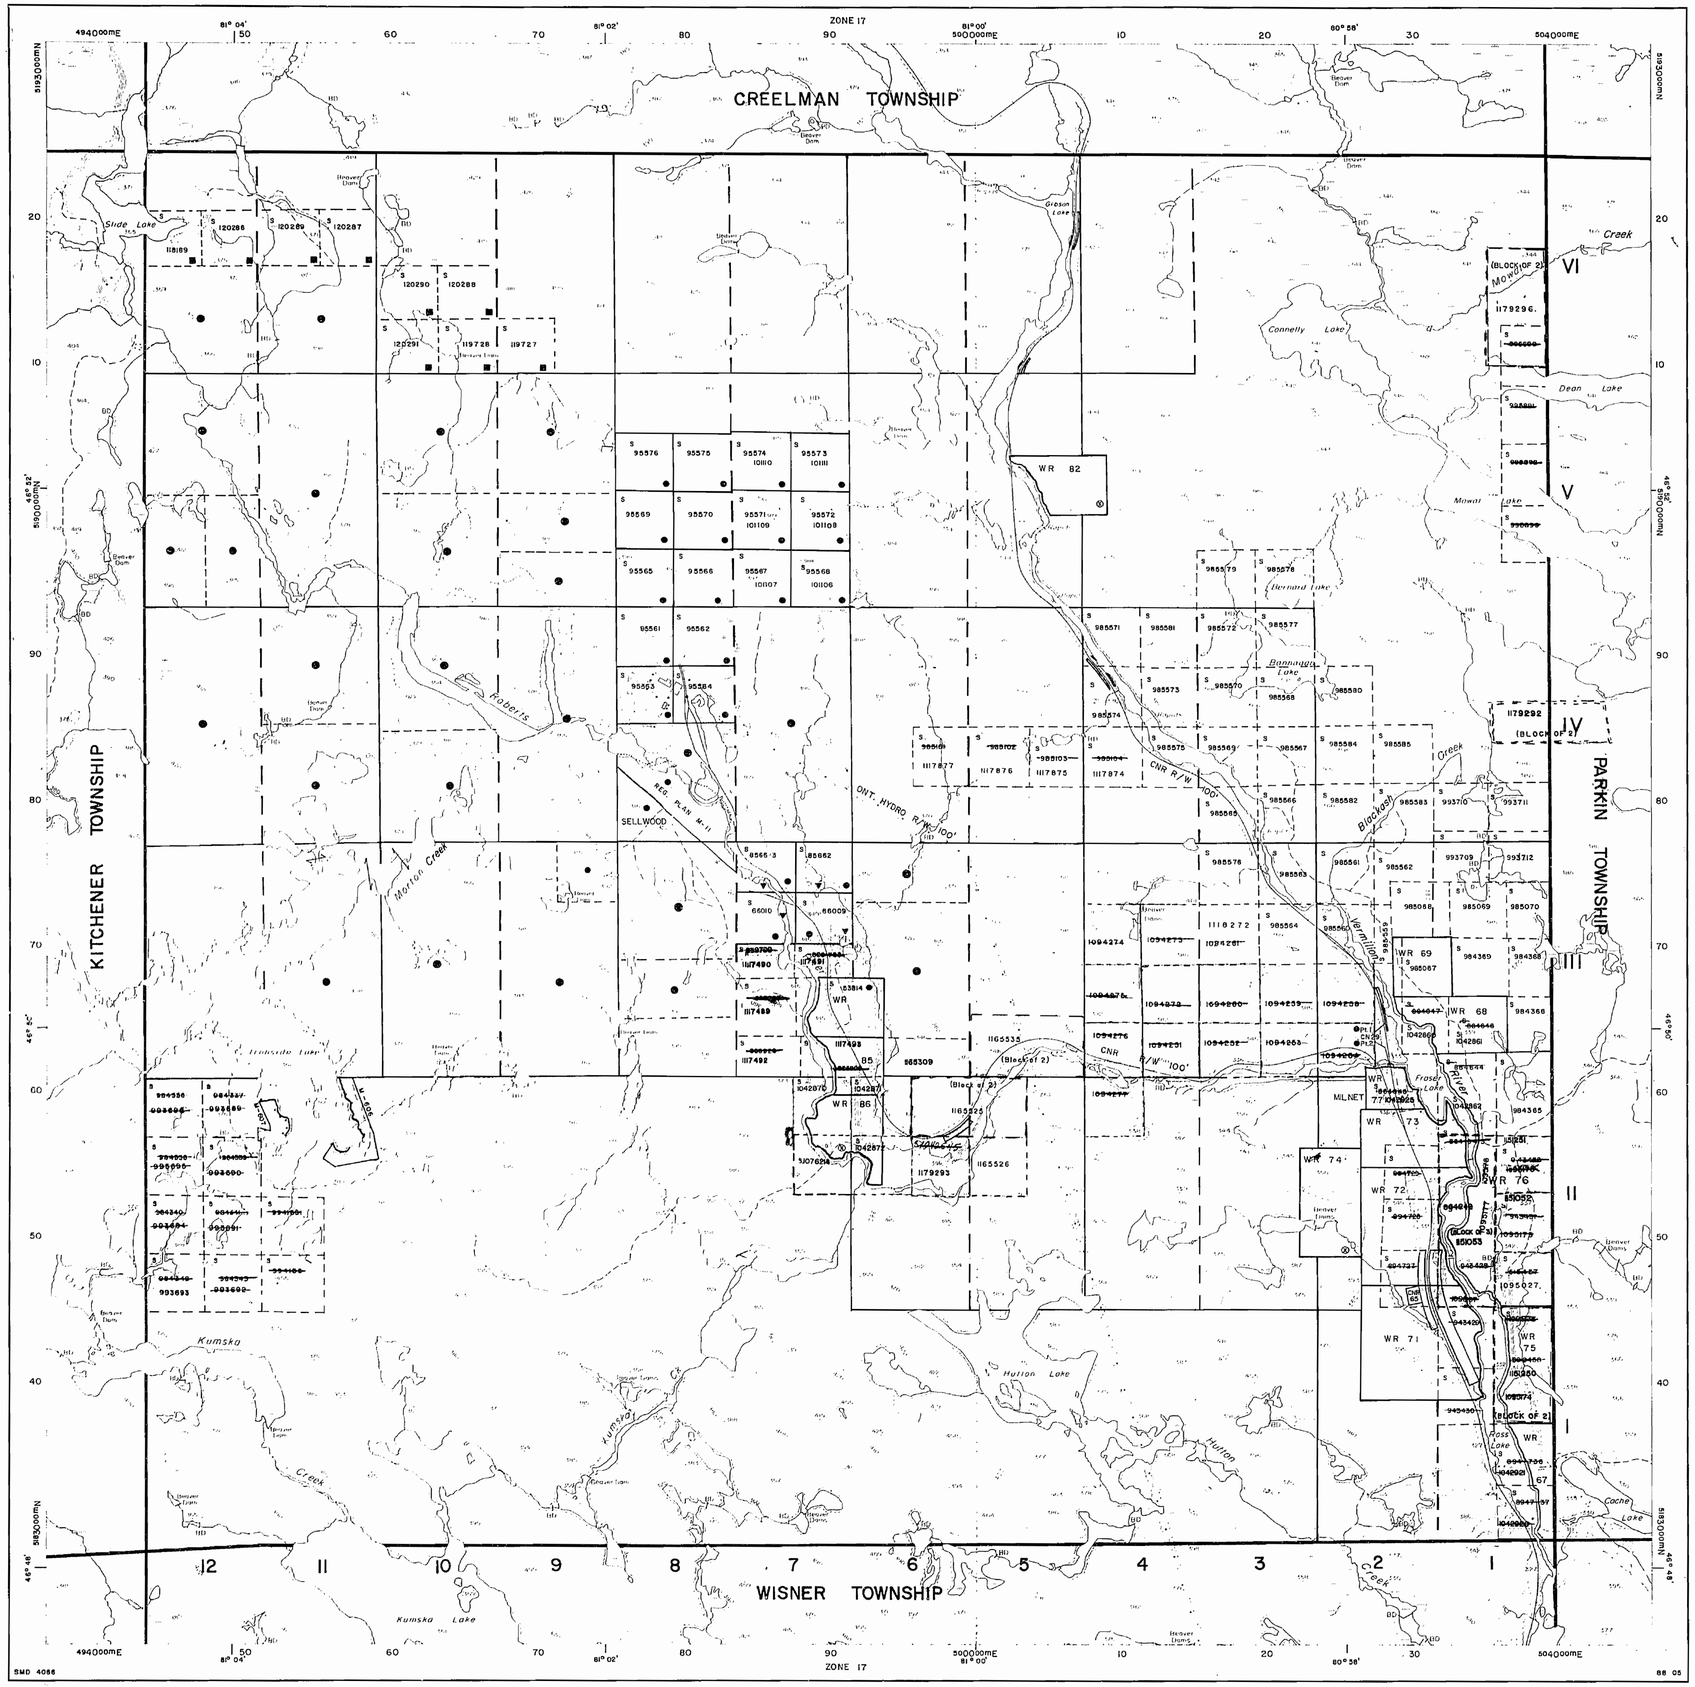

Ministry of Natural Resources
Ontario
Ministry of Northern Development and Mines

IN SERVICE FEBRUARY 10, 1989

INDEX TO LAND DISPOSITION

PLAN
G-4066

TOWNSHIP
HUTTON

M.N.R. ADMINISTRATIVE DISTRICT
SUDBURY
MINING DIVISION
SUDBURY
LAND TITLES/REGISTRY DIVISION
SUDBURY

Scale 1:20 000

1000 Metres 0 1000 2000 Metres

1000 Feet 0 1000 2000 3000 4000 5000 6000 7000 8000 9000 10000 Feet

Contour Interval 10 Metres

SYMBOLS

- Boundary
  - Township, Meridian, Baseline
  - Road allowance; surveyed
    - shoreline
  - Lot/Concession; surveyed
    - unsurveyed
  - Parcel; surveyed
    - unsurveyed
  - Right-of-way; road
    - railway
    - utility
  - Reservation
- Cliff, Pit, Pile
- Contour
  - Interpolated
  - Approximate
  - Depression
- Control point (horizontal) △
- Flooded land
- Mine head frame
- Pipeline (above ground)
- Railway; single track
  - double track
  - abandoned
- Road; highway, county, township
  - access
  - trail, bush
- Shoreline (original)
- Transmission line
- Wooded area

(BLOCK OF 2)

DISPOSITION OF CROWN LANDS

- Patent
  - Surface & Mining Rights ●
  - Surface Rights Only ◔
  - Mining Rights Only ◒
- Lease
  - Surface & Mining Rights ■
  - Surface Rights Only ◨
  - Mining Rights Only ◧
- Licence of Occupation ▼
- Order-in-Council OC
- Cancelled ⊗
- Reservation R
- Sand & Gravel G

AREAS WITHDRAWN FROM DISPOSITION

MRO - Mining Rights Only
SRO - Surface Rights Only
M + S - Mining and Surface Rights

Description	Order No.	Date	Disposition	File

NOTE

LOTS 1 TO 6, CONCESSIONS I TO 6 MAY BE STAKED IN THE SAME MANNER AS MINING CLAIMS IN UNSURVEYED TERRITORY. MAY 16,1946—FILE 83.5—MINING ACT SEC.45 R.S.O 1960 (52 & 1946)

LAND REQUIRED FOR RAILWAY PURPOSES SHOWN THUS:

FILES 4826 & 4841

PARTS OF CON. 1, 2, 4, 5 & 6 SUBDIVISION ANNULLED.


DATE OF ISSUE
JUN 3 1992
SUDBURY
MINING RECORDER'S OFFICE

THE INFORMATION THAT APPEARS ON THIS MAP HAS BEEN COMPILED FROM VARIOUS SOURCES, AND ACCURACY IS NOT GUARANTEED. THOSE WISHING TO STAKE MINING CLAIMS SHOULD CONSULT WITH THE MINING RECORDER, MINISTRY OF NORTHERN DEVELOPMENT AND MINES, FOR ADDITIONAL INFORMATION ON THE STATUS OF THE LANDS SHOWN HEREON.

Map base and land disposition drafting by Surveys and Mapping Branch, Ministry of Natural Resources.

The disposition of land, location of lot fabric and parcel boundaries on this index was compiled for administrative purposes only.

G-4066 HUTTON TWP.

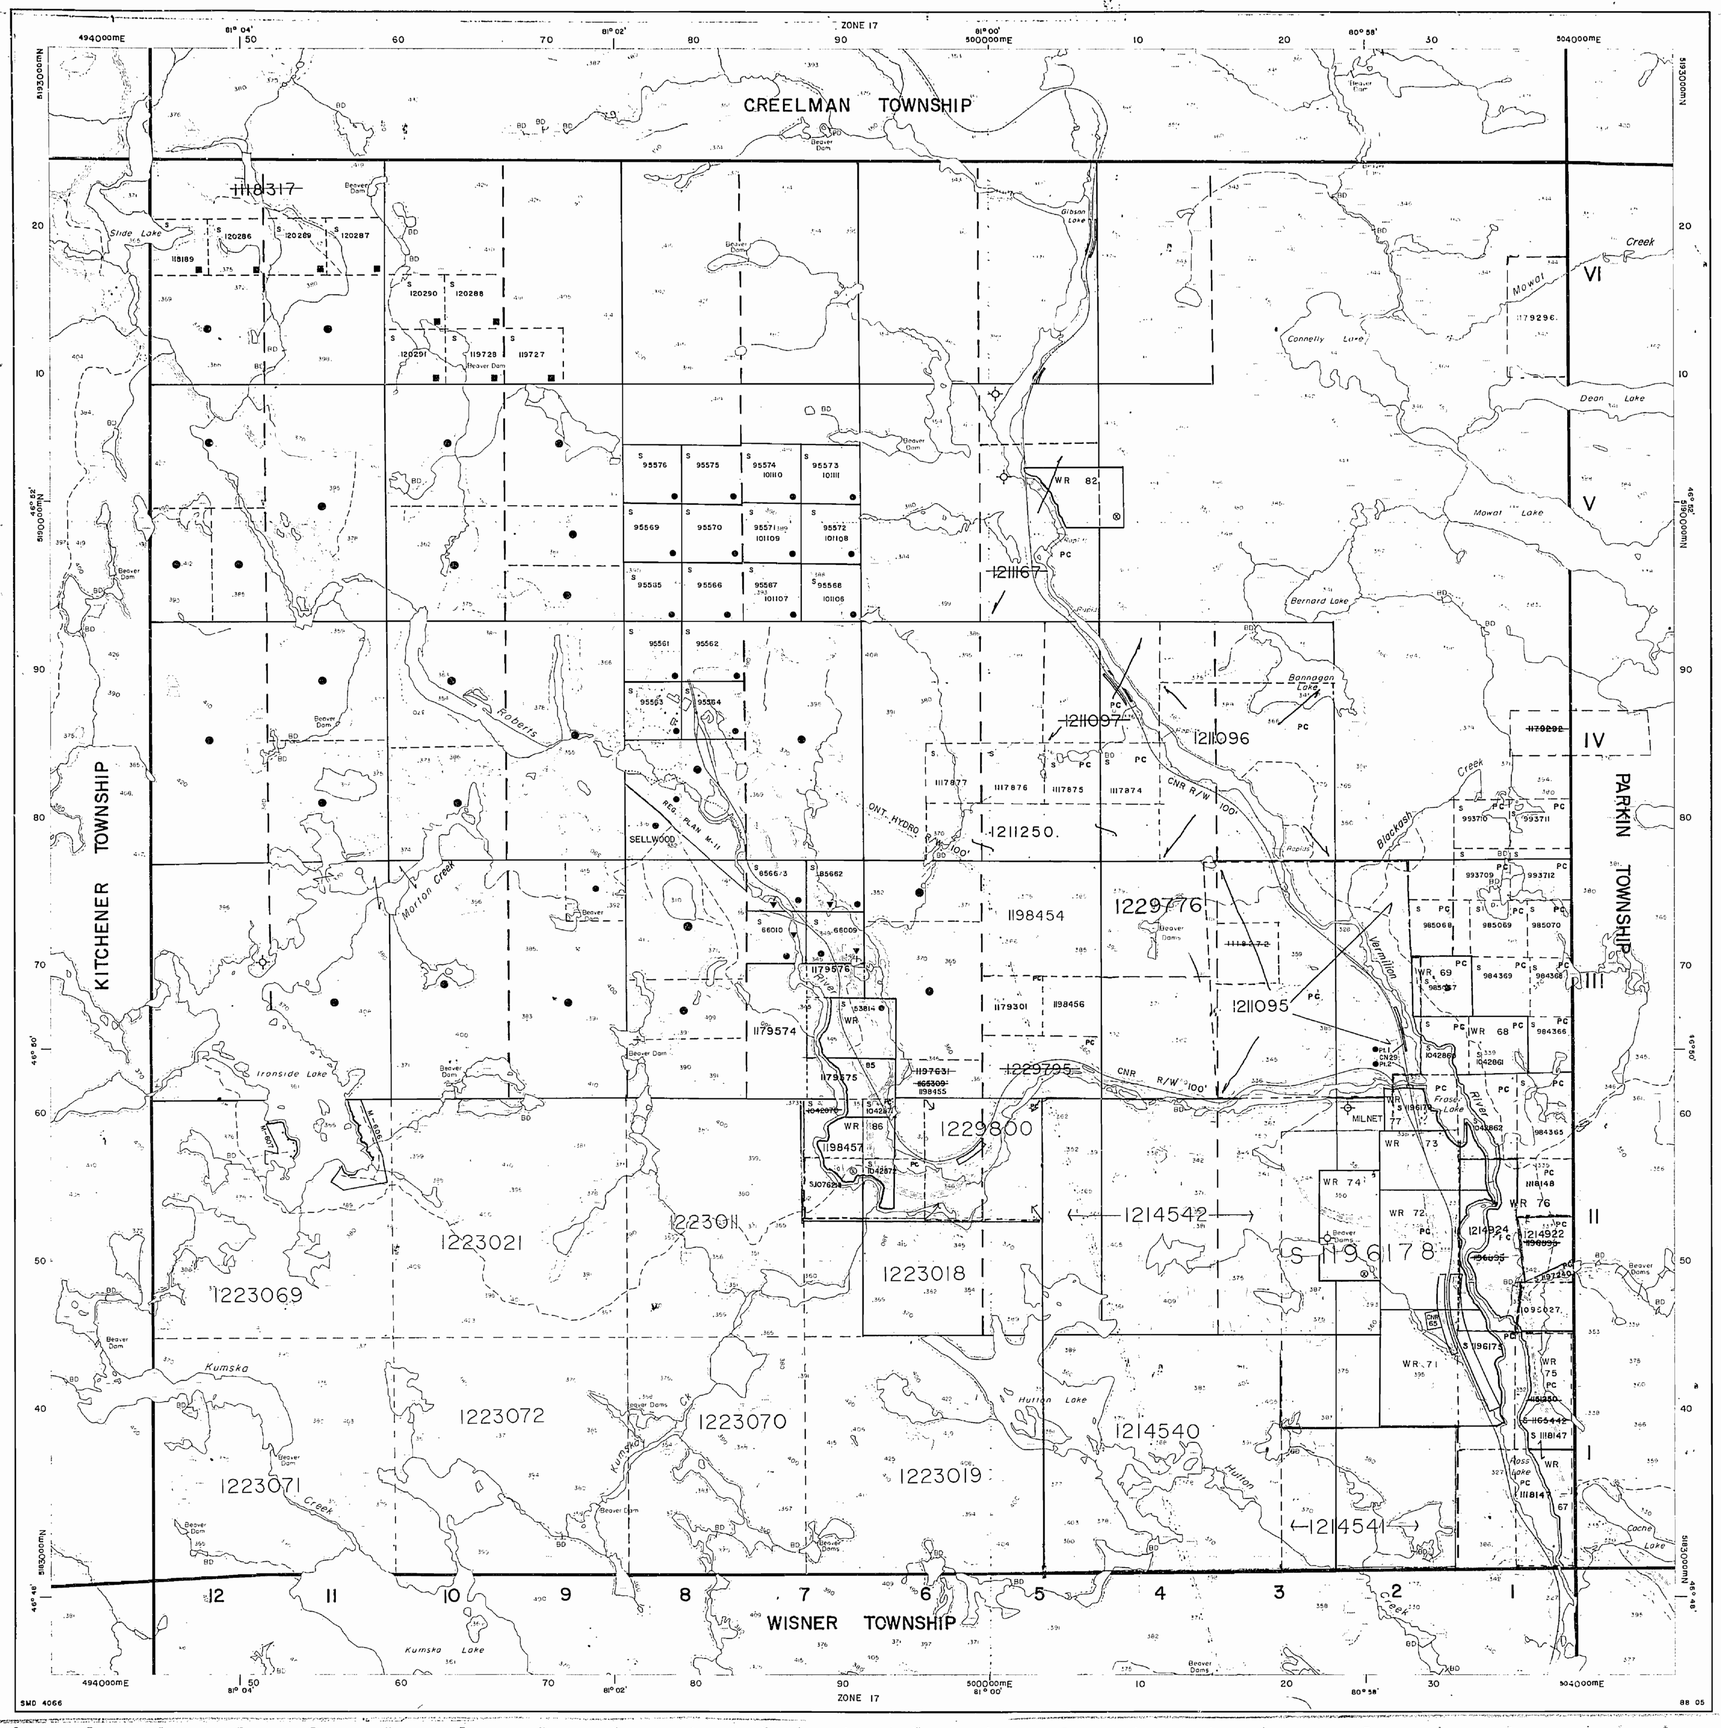

Ministry of Natural Resources

Ontario

Ministry of Northern Development and Mines

IN SERVICE FEBRUARY 10, 1989

INDEX TO LAND DISPOSITION

PLAN

G-4066

TOWNSHIP

HUTTON

M.N.R. ADMINISTRATIVE DISTRICT

SUDBURY

MINING DIVISION

SUDBURY

LAND TITLES/REGISTRY DIVISION

SUDBURY

Scale 1:20 000

1000 Metres 0 1000 2000 Metres

1000 Feet 0 1000 2000 3000 4000 5000 6000 7000 8000 9000 10000 Feet

Contour Interval 10 Metres

SYMBOLS

Boundary
- Township, Meridian, Baseline
- Road allowance; surveyed / shoreline
- Lot/Concession; surveyed / unsurveyed
- Parcel; surveyed / unsurveyed
- Right-of-way; road / railway / utility
- Reservation
- Cliff, Pit, Pile
- Contour (20) / Interpolated / Approximate / Depression
- Control point (horizontal)
- Flooded land
- Mine head frame
- Pipeline (above ground)
- Railway; single track / double track / abandoned
- Road; highway, county, township / access / trail, bush
- Shoreline (original)
- Transmission line
- Wooded area

(BLOCK OF 2)

DISPOSITION OF CROWN LANDS

Patent
- Surface & Mining Rights ●
- Surface Rights Only ◒
- Mining Rights Only ◒

Lease
- Surface & Mining Rights ■
- Surface Rights Only ■
- Mining Rights Only ■

- Licence of Occupation ▼
- Order-in-Council OC
- Cancelled ⊗
- Reservation (R)
- Sand & Gravel (S)
- LAND USE PERMIT ☼
- Placer Claim PC

AREAS WITHDRAWN FROM DISPOSITION

MRO - Mining Rights Only
SRO - Surface Rights Only
M + S - Mining and Surface Rights

Description	Order No.	Date	Disposition	File

DATE OF ISSUE

JUN 17 1998

PROVINCIAL RECORDING OFFICE - SUDBURY

NOTE

LOTS 1 TO 6, CONCESSIONS I TO 6 MAY BE STAKED IN THE SAME MANNER AS MINING CLAIMS IN UNSURVEYED TERRITORY. MAY 16,1946—FILE 63.5—MINING ACT SEC.45 R.S.O 1980 (52 A 1946)

LAND REQUIRED FOR RAILWAY PURPOSES SHOWN THUS

FILES 4826 & 4841

PARTS OF CON. 1,2,4,5 & 6 SUBDIVISION ANNULLED.

THE INFORMATION THAT APPEARS ON THIS MAP HAS BEEN COMPILED FROM VARIOUS SOURCES, AND ACCURACY IS NOT GUARANTEED. THOSE WISHING TO STAKE MINING CLAIMS SHOULD CONSULT WITH THE MINING RECORDER, MINISTRY OF NORTHERN DEVELOPMENT AND MINES, FOR ADDITIONAL INFORMATION ON THE STATUS OF THE LANDS SHOWN HEREON.

Map base and land disposition drafting by Surveys and Mapping Branch, Ministry of Natural Resources.

The disposition of land, location of lot fabric and parcel boundaries on this index was compiled for administrative purposes only.

SMD 4066

88 05

G-4066 HUTTON TWP.

944

THE TOWNSHIP OF HUTTON

DISTRICT OF SUDBURY

SUDBURY MINING DIVISION

SCALE 1 INCH TO 40 CHAINS

GREELMAN TWP.

KITCHENER TWP.

PARKIN TWP.

WISNER TWP.

VI

V

IV

III

II

I

12 11 10 9 8 7 6 5 4 3 2 1

Sellwood

Ironside L.

Roberts R.

Milnet

Frase L.

Hutton L.

Gibson L.

Ross

WR 82

WR 85

WR 69

WR 68

WR 74

WR 73

WR 72

WR 71

WR 67

WR 75

LEGEND

PATENTED LANDS	P
CROWN LAND SALES	S
LOCATED LANDS	L
LICENSE OF OCCUPATION	LO
ROADS	
CANADIAN NATIONAL RAILWAY	

NOTES

LOTS 1 TO 6 CONCESSIONS I TO 6 MAY BE STAKED IN THE SAME MANNER AS MINING CLAIMS IN UNSURVEYED TERRITORY.

MG. LEASE * 0687 ONWATIN PLACER GOLD LTD. SHOWN THUS:

100' wide reservations on surface by Dept of L. & F. shown hereon thus

M944

DEPARTMENT OF MINES
ONTARIO

TRIM LINE

44e.M

* Location CNR 65 Part 1 Plan 53R-9719 being Part of W.B. 71.

CREELMAN TWP. M.737

VI

V

IV

III

II

I

KITCHENER TWP. M.973

PARKIN TWP. M.1049

HUTTON TWP.

WISNER TWP. M.1185

12 11 10 9 8 7 6 5 4 3 2 1

Vermilion R.

Gibson Lake

Mowat

Mowat Lake

Roberts

Vermilion River

Ironside Lake

Kumsko Lake

Hutton Lake

Hutton Cr.

Sellwood Cr.

Mowat Cr.

WR 82

WR 69

WR 68

WR 73

WR 76

WR 74

WR 72

WR 71

WR 67

WR 86

THE TOWNSHIP OF

HUTTON

DISTRICT OF SUDBURY

SUDBURY MINING DIVISION

SCALE: 1-INCH=40 CHAINS

LEGEND

PATENTED LAND	● or Ⓟ
CROWN LAND SALE	C.S.
LEASES	Ⓛ
LOCATED LAND	Loc.
LICENSE OF OCCUPATION	L.O.
MINING RIGHTS ONLY	M.R.O.
SURFACE RIGHTS ONLY	S.R.O.
ROADS	
IMPROVED ROADS	
KING'S HIGHWAYS	
RAILWAYS	
POWER LINES	
MARSH OR MUSKEG	
MINES	
CANCELLED	

NOTES

400' Surface Rights Reservation along the shores of all lakes and rivers.

Lots 1 to 6, concessions 1 to 6 may be staked in the same manner as mining claims in unsurveyed territory. May 16, 1946 — File 83.5 — Mining Act Sec. 53 (52 A 1946).

Land required for railway purposes shown thus:

Files 4826 & 4841.

Parts of Con. 1, 2, 4, 5 & 6: Subdivision Annulled.

* Updated 1983 06 21 - KM

SAND AND GRAVEL

Ⓠ QUARRY PERMIT

PLAN NO.- M-944

ONTARIO
MINISTRY OF NATURAL RESOURCES
SURVEYS AND MAPPING BRANCH

44e.M

TRIM LINE

* Updated From Linen June 21/83 KM

HUTTON

G-4066

Ministry of Natural Resources
Ontario

Ministry of Northern Development and Mines

IN SERVICE FEBRUARY 10, 1989

INDEX TO LAND DISPOSITION

PLAN
G-4066

TOWNSHIP
HUTTON

M.N.R. ADMINISTRATIVE DISTRICT
SUDBURY
MINING DIVISION
SUDBURY
LAND TITLES/REGISTRY DIVISION
SUDBURY

DATE OF ISSUE
SEP 17 1992
SUDBURY
MINING RECORDER'S OFFICE

DATE OF ISSUE
SEP 17 1992
SUDBURY
MINING RECORDER'S OFFICE

Scale 1:20 000

1000 Metres 0 1000 2000 Metres

1000 Feet 0 1000 2000 3000 4000 5000 6000 7000 8000 9000 10000 Feet

Contour Interval 10 Metres

AREAS WITHDRAWN FROM DISPOSITION
MRO - Mining Rights Only
SRO - Surface Rights Only
M + S - Mining and Surface Rights

Description	Order No.	Date	Disposition	File

SYMBOLS

Boundary
- Township, Meridian, Baseline
- Road allowance; surveyed
- shoreline
- Lot/Concession; surveyed
- unsurveyed
- Parcel; surveyed
- unsurveyed
- Right-of-way; road
- railway
- utility
- Reservation
- Cliff, Pit, Pile
- Contour
- Interpolated
- Approximate
- Depression
- Control point (horizontal)
- Flooded land
- Mine head frame
- Pipeline (above ground)
- Railway; single track
- double track
- abandoned
- Road; highway, county, township
- access
- trail, bush
- Shoreline (original)
- Transmission line
- Wooded area

DISPOSITION OF CROWN LANDS

Patent
- Surface & Mining Rights
- Surface Rights Only
- Mining Rights Only

Lease
- Surface & Mining Rights
- Surface Rights Only
- Mining Rights Only

- Licence of Occupation
- Order-in-Council (OC)
- Cancelled
- Reservation
- Sand & Gravel

DATE OF ISSUE
SEP 17 1992
SUDBURY
MINING RECORDER'S OFFICE
SEPTEMBER 17, 1992

NOTE

LOTS 1 TO 6, CONCESSIONS I TO 6 MAY BE STAKED IN THE SAME MANNER AS MINING CLAIMS IN UNSURVEYED TERRITORY. MAY 16,1946—FILE 63.5—MINING ACT SEC.45 R.S.O 1980 (52 A 1946)

LAND REQUIRED FOR RAILWAY PURPOSES SHOWN THUS

FILES 4626 & 4841

PARTS OF CON. 1,2,4,5 & 6 SUBDIVISION ANNULLED.

(BLOCK OF 2)

THE INFORMATION THAT APPEARS ON THIS MAP HAS BEEN COMPILED FROM VARIOUS SOURCES, AND ACCURACY IS NOT GUARANTEED. THOSE WISHING TO STAKE MINING CLAIMS SHOULD CONSULT WITH THE MINING RECORDER, MINISTRY OF NORTHERN DEVELOPMENT AND MINES, FOR ADDITIONAL INFORMATION ON THE STATUS OF THE LANDS SHOWN HEREON.

Map base and land disposition drafting by Surveys and Mapping Branch, Ministry of Natural Resources.

The disposition of land, location of lot fabric and parcel boundaries on this index was compiled for administrative purposes only.

SMD. 4066

68 05

G-4066 HUTTON TWP.

G-4066

Ontario Ministry of Natural Resources

Ministry of Northern Development and Mines

IN SERVICE FEBRUARY 10, 1989

INDEX TO LAND DISPOSITION

PLAN
G-4066

TOWNSHIP
HUTTON

DATE OF ISSUE
OCT 23 1998
PROVINCIAL RECORDING OFFICE - SUDBURY

M.N.R. ADMINISTRATIVE DISTRICT
SUDBURY

MINING DIVISION
SUDBURY

LAND TITLES/REGISTRY DIVISION
SUDBURY

Scale 1:20 000

1000 Metres 0 1000 2000 Metres

1000 Feet 0 1000 2000 3000 4000 5000 6000 7000 8000 9000 10000 Feet

Contour Interval 10 Metres

AREAS WITHDRAWN FROM DISPOSITION

MRO - Mining Rights Only
SRO - Surface Rights Only
M + S - Mining and Surface Rights

Description	Order No.	Date	Disposition	File

SYMBOLS

Boundary
- Township, Meridian, Baseline
- Road allowance; surveyed
- shoreline
- Lot/Concession; surveyed
- unsurveyed
- Parcel; surveyed
- unsurveyed
- Right-of-way; road
- railway
- utility
- Reservation
- Cliff, Pit, Pile
- Contour (20)
- Interpolated
- Approximate
- Depression
- Control point (horizontal) △
- Flooded land
- Mine head frame
- Pipeline (above ground)
- Railway; single track
- double track
- abandoned
- Road; highway, county, township
- access
- trail, bush
- Shoreline (original)
- Transmission line
- Wooded area

(BLOCK OF 2)

DISPOSITION OF CROWN LANDS

Patent
- Surface & Mining Rights ●
- Surface Rights Only ◒
- Mining Rights Only ◒

Lease
- Surface & Mining Rights ■
- Surface Rights Only ▣
- Mining Rights Only ▣

- Licence of Occupation ▼
- Order-in-Council OC
- Cancelled ⊘
- Reservation Ⓡ
- Sand & Gravel Ⓢ
- LAND USE PERMIT ⊹
- Placer Claim PC

NOTE

LOTS 1 TO 6, CONCESSIONS I TO 6 MAY BE STAKED IN THE SAME MANNER AS MINING CLAIMS IN UNSURVEYED TERRITORY. MAY 16, 1946—FILE 83.5—MINING ACT SEC. 45 R.S.O 1980 (52 A 1946)

LAND REQUIRED FOR RAILWAY PURPOSES SHOWN THUS

FILES 4826 & 4841

PARTS OF CON. 1, 2, 4, 5 & 6 SUBDIVISION ANNULLED.

THE INFORMATION THAT APPEARS ON THIS MAP HAS BEEN COMPILED FROM VARIOUS SOURCES, AND ACCURACY IS NOT GUARANTEED. THOSE WISHING TO STAKE MINING CLAIMS SHOULD CONSULT WITH THE MINING RECORDER, MINISTRY OF NORTHERN DEVELOPMENT AND MINES, FOR ADDITIONAL INFORMATION ON THE STATUS OF THE LANDS SHOWN HEREON.

Map base and land disposition drafting by Surveys and Mapping Branch, Ministry of Natural Resources.

The disposition of land, location of lot fabric and parcel boundaries on this index was compiled for administrative purposes only.

SMD 4066

88 05

G-4066 HUTTON TWP. G-4066

944

GREELMAN TWP.

N

KITCHENER TWP.

Gibson

Vermilion

Sellwood

Ironside L.

Fraser

Roberts R.

Milnet

Hutton L.

Ross

PARKIN TWP.

VI

V

IV

III

II

I

12 11 10 9 8 7 6 5 4 3 2 1

WISNER TWP.

200' wide reservations on surface by Dept of L. & F. shewn hereon thus

J.O.

THE TOWNSHIP OF

HUTTON

DISTRICT OF SUDBURY

SUDBURY MINING DIVISION

SCALE 1 INCH TO 40 CHAINS

LEGEND

PATENTED LANDS	(P)
CROWN LAND SALES	(S)
LOCATED LANDS	Loc.
LICENSE OF OCCUPATION	L.O.
ROADS	
CANADIAN NATIONAL RAILWAY	


NOTES

LOTS 1 TO 6, CONCESSIONS I TO 6 MAY BE STAKED IN THE SAME MANNER AS MINING CLAIMS IN UNSURVEYED TERRITORY.

MG. LEASE # 10687 ONWATER PLACER GOLD LTD. SHOWN THUS: ———

M944

DEPARTMENT OF MINES
ONTARIO

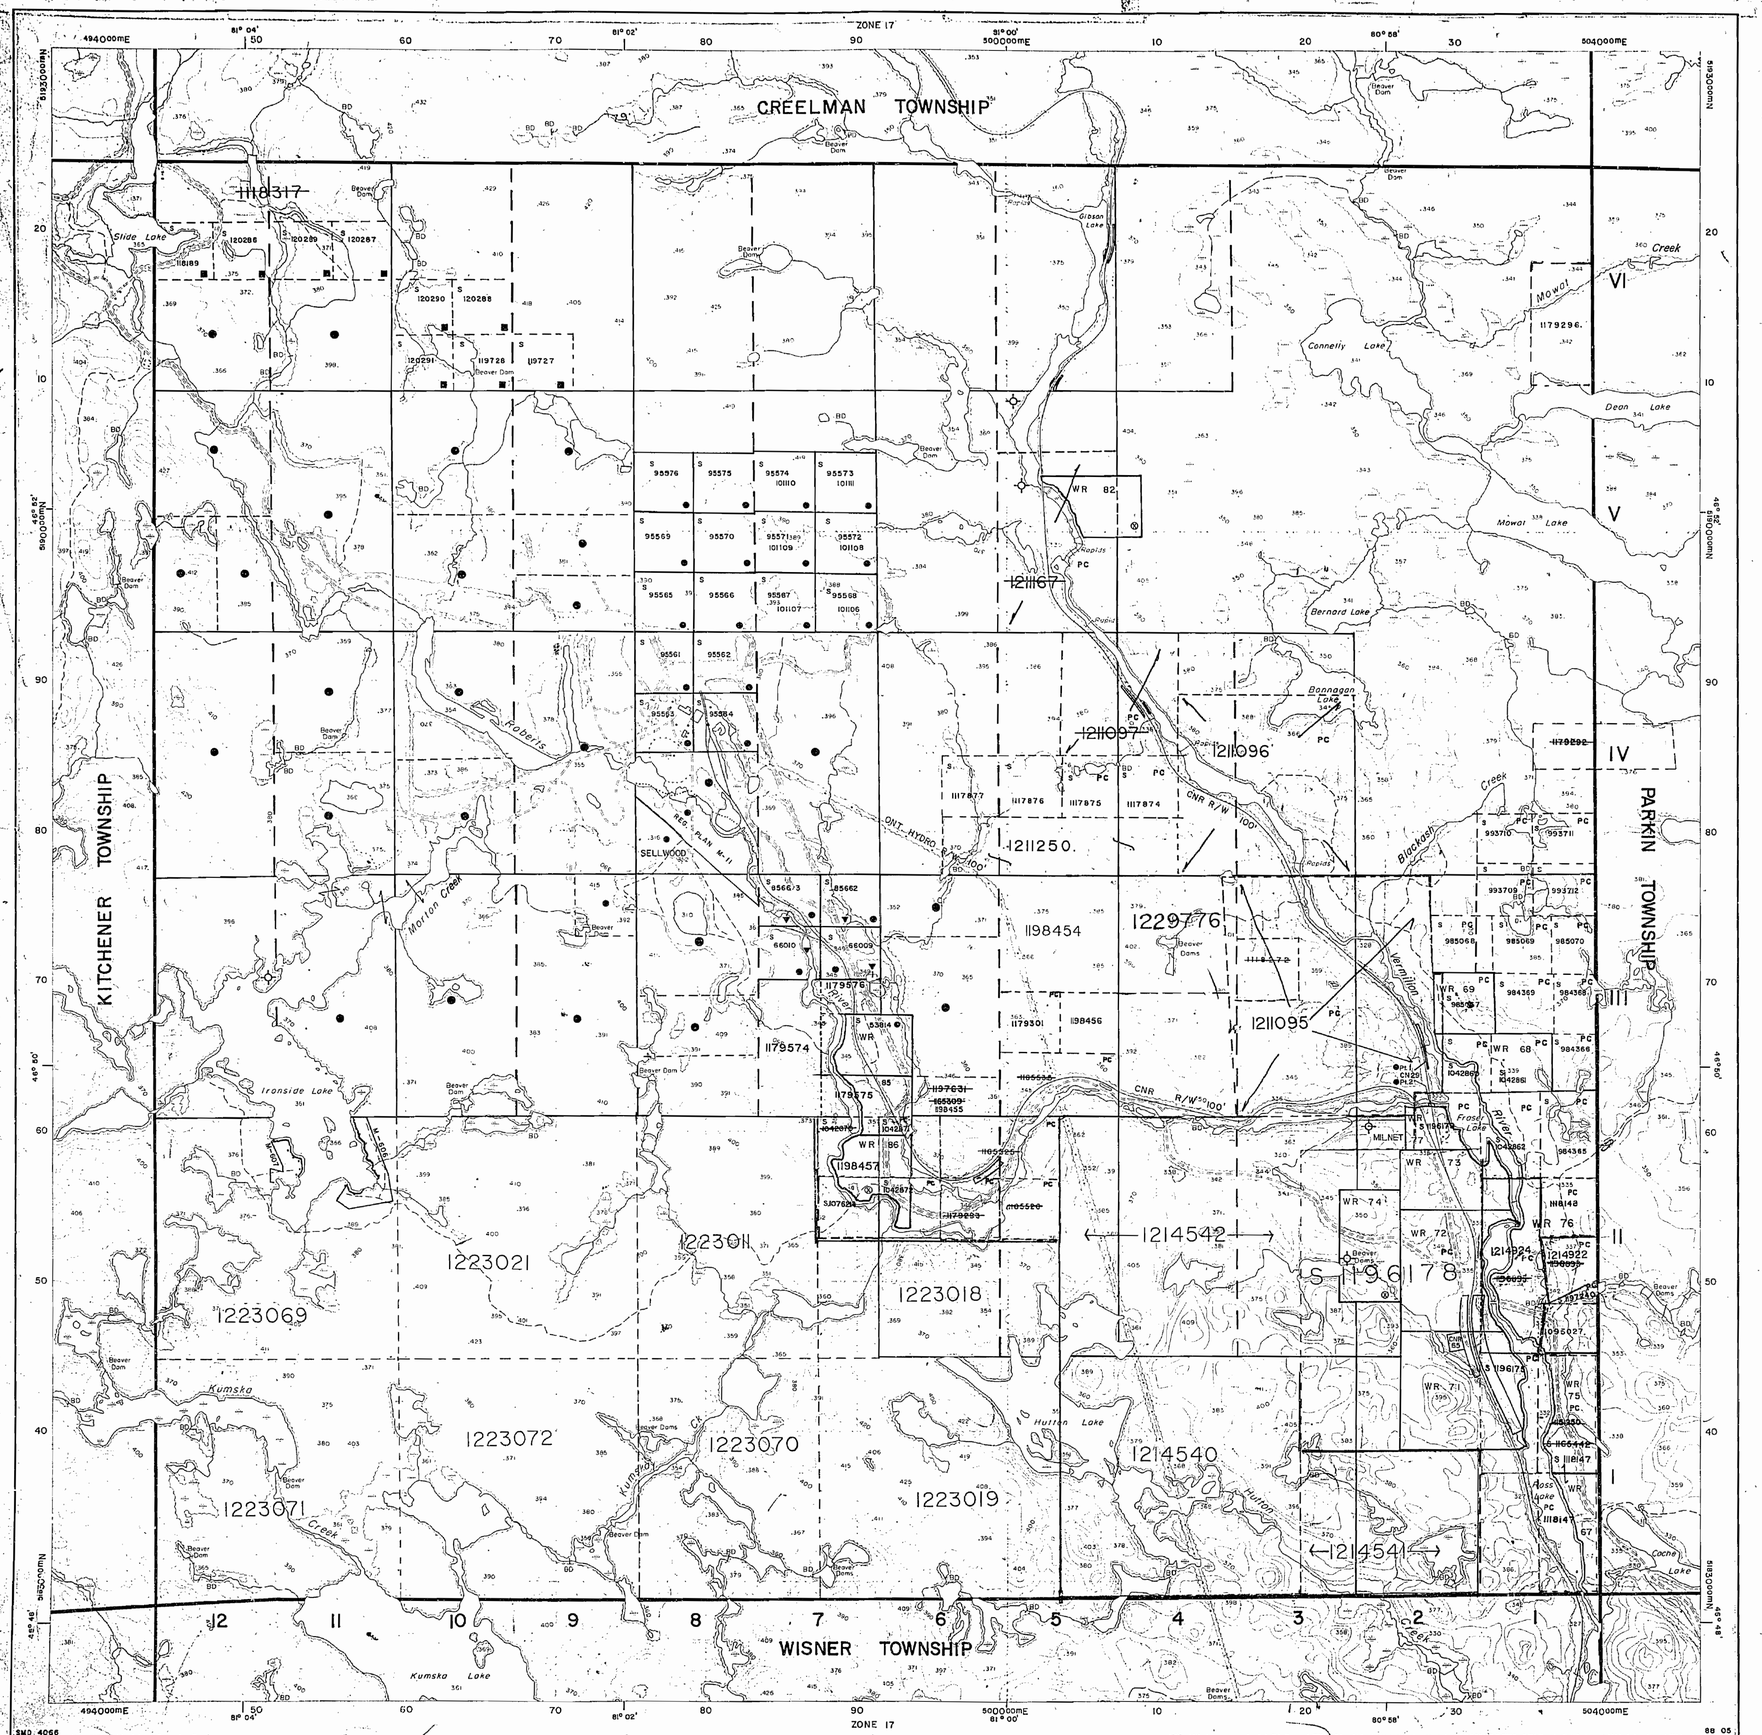

Ministry of Natural Resources
Ontario

Ministry of Northern Development and Mines

IN SERVICE FEBRUARY 10, 1989

INDEX TO LAND DISPOSITION

PLAN
G-4066

TOWNSHIP
HUTTON

M.N.R. ADMINISTRATIVE DISTRICT
SUDBURY

MINING DIVISION
SUDBURY

LAND TITLES/REGISTRY DIVISION
SUDBURY

Scale 1:20 000

1000 Metres 0 1000 2000 Metres

1000 Feet 0 1000 2000 3000 4000 5000 6000 7000 8000 9000 10000 Feet

Contour Interval 10 Metres

SYMBOLS

- Boundary
  - Township, Meridian, Baseline
  - Road allowance; surveyed
    - shoreline
  - Lot/Concession; surveyed
    - unsurveyed
  - Parcel; surveyed
    - unsurveyed
  - Right-of-way; road
    - railway
    - utility
  - Reservation
- Cliff, Pit, Pile
- Contour
  - Interpolated
  - Approximate
  - Depression
- Control point (horizontal)
- Flooded land
- Mine head frame
- Pipeline (above ground)
- Railway; single track
  - double track
  - abandoned
- Road; highway, county, township
  - access
  - trail, bush
- Shoreline (original)
- Transmission line
- Wooded area

(BLOCK OF 2)

DISPOSITION OF CROWN LANDS

- Patent
  - Surface & Mining Rights
  - Surface Rights Only
  - Mining Rights Only
- Lease
  - Surface & Mining Rights
  - Surface Rights Only
  - Mining Rights Only
- Licence of Occupation
- Order-in-Council — OC
- Cancelled
- Reservation
- Sand & Gravel
- LAND USE PERMIT
  - Placer Claim — PC

AREAS WITHDRAWN FROM DISPOSITION

MRO - Mining Rights Only
SRO - Surface Rights Only
M+S - Mining and Surface Rights

Description	Order No.	Date	Disposition	File

DATE OF ISSUE
MAY 01 1998
PROVINCIAL RECORDING OFFICE - SUDBURY

NOTE

LOTS 1 TO 6, CONCESSIONS I TO 6 MAY BE STAKED IN THE SAME MANNER AS MINING CLAIMS IN UNSURVEYED TERRITORY. MAY 16,1946—FILE 63.5-MINING ACT SEC.45 R.S.O 1980 (52 A 1946)

LAND REQUIRED FOR RAILWAY PURPOSES SHOWN THUS

FILES 4626 & 4641

PARTS OF CON. 1,2,4,5 & 6 SUBDIVISION ANNULLED.

THE INFORMATION THAT APPEARS ON THIS MAP HAS BEEN COMPILED FROM VARIOUS SOURCES, AND ACCURACY IS NOT GUARANTEED. THOSE WISHING TO STAKE MINING CLAIMS SHOULD CONSULT WITH THE MINING RECORDER, MINISTRY OF NORTHERN DEVELOPMENT AND MINES, FOR ADDITIONAL INFORMATION ON THE STATUS OF THE LANDS SHOWN HEREON.

Map base and land disposition drafting by Surveys and Mapping Branch, Ministry of Natural Resources.

The disposition of land, location of lot fabric and parcel boundaries on this index was compiled for administrative purposes only.

SM0 4066

88 05

G-4066

HUTTON

TWP

944

CREELMAN TWP.

N

KITCHENER TWP.

PARKIN TWP.

VI

V

IV

III

II

I

Sellwood

Ironside L.

Roberts R.

Fraser L.

Milnet

Hutton L.

Ross

12 11 10 9 8 7 6 5 4 3 2 1

WISNER TWP.

200' wide reservations on surface by Dept of L.& F. shewn hereon thus

THE TOWNSHIP OF

HUTTON

DISTRICT OF SUDBURY

SUDBURY MINING DIVISION

SCALE 1 INCH TO 40 CHAINS

LEGEND

PATENTED LANDS	(P)
CROWN LAND SALES	(S)
LOCATED LANDS	Loc.
LICENSE OF OCCUPATION	L.O.
ROADS	═══
CANADIAN NATIONAL RAILWAY	═══

NOTES

LOTS 1 TO 6, CONCESSIONS I TO 6 MAY BE STAKED IN THE SAME MANNER AS MINING CLAIMS IN UNSURVEYED TERRITORY.

MG. LEASE # 10887 ONWATIN PLACER GOLD LTD. SHOWN THUS: ———

200' Fr.

66' Road allowance in front of W.R. 85 & 86 Opn. June 1/54 C.S. Reg'd June 15/54

M944

DEPARTMENT OF MINES
ONTARIO

944

No 2 R

CREELMAN TWP.

N

KITCHENER TWP.

PARKIN TWP.

WISNER TWP.

Gibson L.

WR 82

Mowat L.

Vermilion R.

Sellwood

Iron side L.

Fraser

Roberts R.

Milnet

Hutton L.

Ross

VI

V

IV

III

II

I

12 11 10 9 8 7 6 5 4 3 2 1

THE TOWNSHIP OF

HUTTON

DISTRICT OF SUDBURY

SUDBURY MINING DIVISION

SCALE 1 INCH TO 40 CHAINS

LEGEND

PATENTED LANDS	(P)
CROWN LAND SALES	(S)
LOCATED LANDS	Loc.
LICENSE OF OCCUPATION	L.O.
ROADS	═══
CANADIAN NATIONAL RAILWAY	———

NOTES

LOTS 1 TO 6, CONCESSIONS I. TO 6 MAY BE STAKED IN THE SAME MANNER AS MINING CLAIMS IN UNSURVEYED TERRITORY.

Area covered by Lease 10887 for Gold only. Does not grant title to Surface Rights or other minerals. D.F.R. letter Feb. 17/48. File 4839; 131.1

Canadian Placer

Lease 10887

NOTE: N½ of N½ of Lot 7, Con 3 open [illegible] in May 1948 File 4822 D. Stevens letter June 6/51

SUDBURY RECEIVED SEP 4 - 1947 MINING DIVISION

M944

DEPARTMENT OF MINES ONTARIO

Hutton Tp

J.C.

944

GREELMAN TWP.

Sel. 53

tag file

OLD

THE
TOWNSHIP OF

HUTTON

DISTRICT OF SUDBURY

SUDBURY MINING
DIVISION

SCALE 1 INCH TO 40 CHAINS

LEGEND

PATENTED LANDS	(P)
CROWN LAND SALES	(S)
LOCATED LANDS	Loc.
LICENSE OF OCCUPATION	L.O.
ROADS	═══
CANADIAN NATIONAL RAILWAY	═══

NOTES

LOTS 1 TO 6 CONCESSIONS I TO 6 MAY BE STAKED IN THE SAME MANNER AS MINING CLAIMS IN UNSURVEYED TERRITORY.

MG. LEASE # 10887 ONWATIN PLACER GOLD LTD. SHOWN THUS:

N

KITCHENER TWP.

PARKIN TWP.

Gibson L.

Sellwood

Iron side L.

Roberts R

Milnet

Hutton L.

Mowat L.

Vermilion R.

Ross

VI

V

IV

III

II

I

12 11 10 9 8 7 6 5 4 3 2 1

WISNER TWP.

200' wide reservations on surface by Dept of L. & F. shown hereon thus

M944

DEPARTMENT OF MINES
ONTARIO

M-944

CREELMAN TWP.

KITCHENER TWP.

PARKIN TWP.

WISNER TWP.

VI

V

IV

III

12 11 10 9 8 7 6 5 4 3 2 1

Roberts

Ironside Lake

Morton Cr.

Sellwood

Kumsko

Hutton Lake

Hutton Cr.

Gibson Lake

Vermilion River

Fraser Lake

Ross Lake

Roberts

WR 86

WR 85

WR 74

WR 73

WR 72

WR 71

WR 69

WR 68

WR 67

WR 76

WR 75

July 30/68

THE TOWNSHIP OF HUTTON

DISTRICT OF SUDBURY

SUDBURY MINING DIVISION

SCALE: 1-INCH=40 CHAINS

LEGEND

PATENTED LAND	(P)
CROWN LAND SALE	C.S.
LEASES	(L)
LOCATED LAND	Loc.
LICENSE OF OCCUPATION	L.O.
MINING RIGHTS ONLY	M.R.O.
SURFACE RIGHTS ONLY	S.R.O.
ROADS	
IMPROVED ROADS	
KING'S HIGHWAYS	
RAILWAYS	
POWER LINES	
MARSH OR MUSKEG	
MINES	
CANCELLED	C.

NOTES

400' Surface Rights Reservation around all lakes and rivers.

~~Lots 1 to 6, concessions I to 6 may be staked in the same manner as mining claims in unsurveyed territory. May 16, 1946 — File 83.5 — Mining Act Sec 53 (52 A 1946).~~

Land required for railway purposes shown thus:

Files 4826 & 4841.

Dept of Highways' gravel pits shown thus:

Parts of the subdivision shown thus: ////// are annulled under the authority of the Minister of Lands & Forests

PLAN NO.- M-944

DEPARTMENT OF MINES

— ONTARIO —

944

CREELMAN TWP.

KITCHENER TWP.

PARKIN TWP.

WISNER T.WP.

VI

V

IV

III

12 11 10 9 8 7 6 5 4 3 2 1

Vermilion R.

Gibson Lake

Roberts

Ironside Lake

Hutton Lake

Kumsko

Ross

Lake

WR 82

WR 85

WR 86

WR 69

WR 68

WR 73

WR 74

WR 72

WR 71

WR 75

WR 67

THE TOWNSHIP OF HUTTON

DISTRICT OF SUDBURY

SUDBURY MINING DIVISION

SCALE: 1-INCH=40 CHAINS

LEGEND

PATENTED LAND	(P)
CROWN LAND SALE	C.S.
LEASES	(L)
LOCATED LAND	Loc.
LICENSE OF OCCUPATION	L.O.
MINING RIGHTS ONLY	M.R.O.
SURFACE RIGHTS ONLY	S.R.O.
ROADS	
IMPROVED ROADS	
KING'S HIGHWAYS	
RAILWAYS	
POWER LINES	
MARSH OR MUSKEG	
MINES	
CANCELLED	C.

NOTES

400' Surface Rights Reservation around all lakes and rivers.

Lots 1 to 6, concessions I to 6 may be staked in the same manner as mining claims in unsurveyed territory. May 16, 1946 — File 83.5 — Mining Act Sec. 53 (52 A 1946).

Land required for railway purposes shown thus:

Files 4826 & 4841.

Dept of Highways' gravel pits shown thus:

Parts of the subdivision shown thus: are annulled under the authority of the Minister of Lands & Forests

PLAN NO.- M-944

DEPARTMENT OF MINES

— ONTARIO —

M 944

CREELMAN TWP.


VI

V

IV

KITCHENER TWP.

PARKIN TWP.

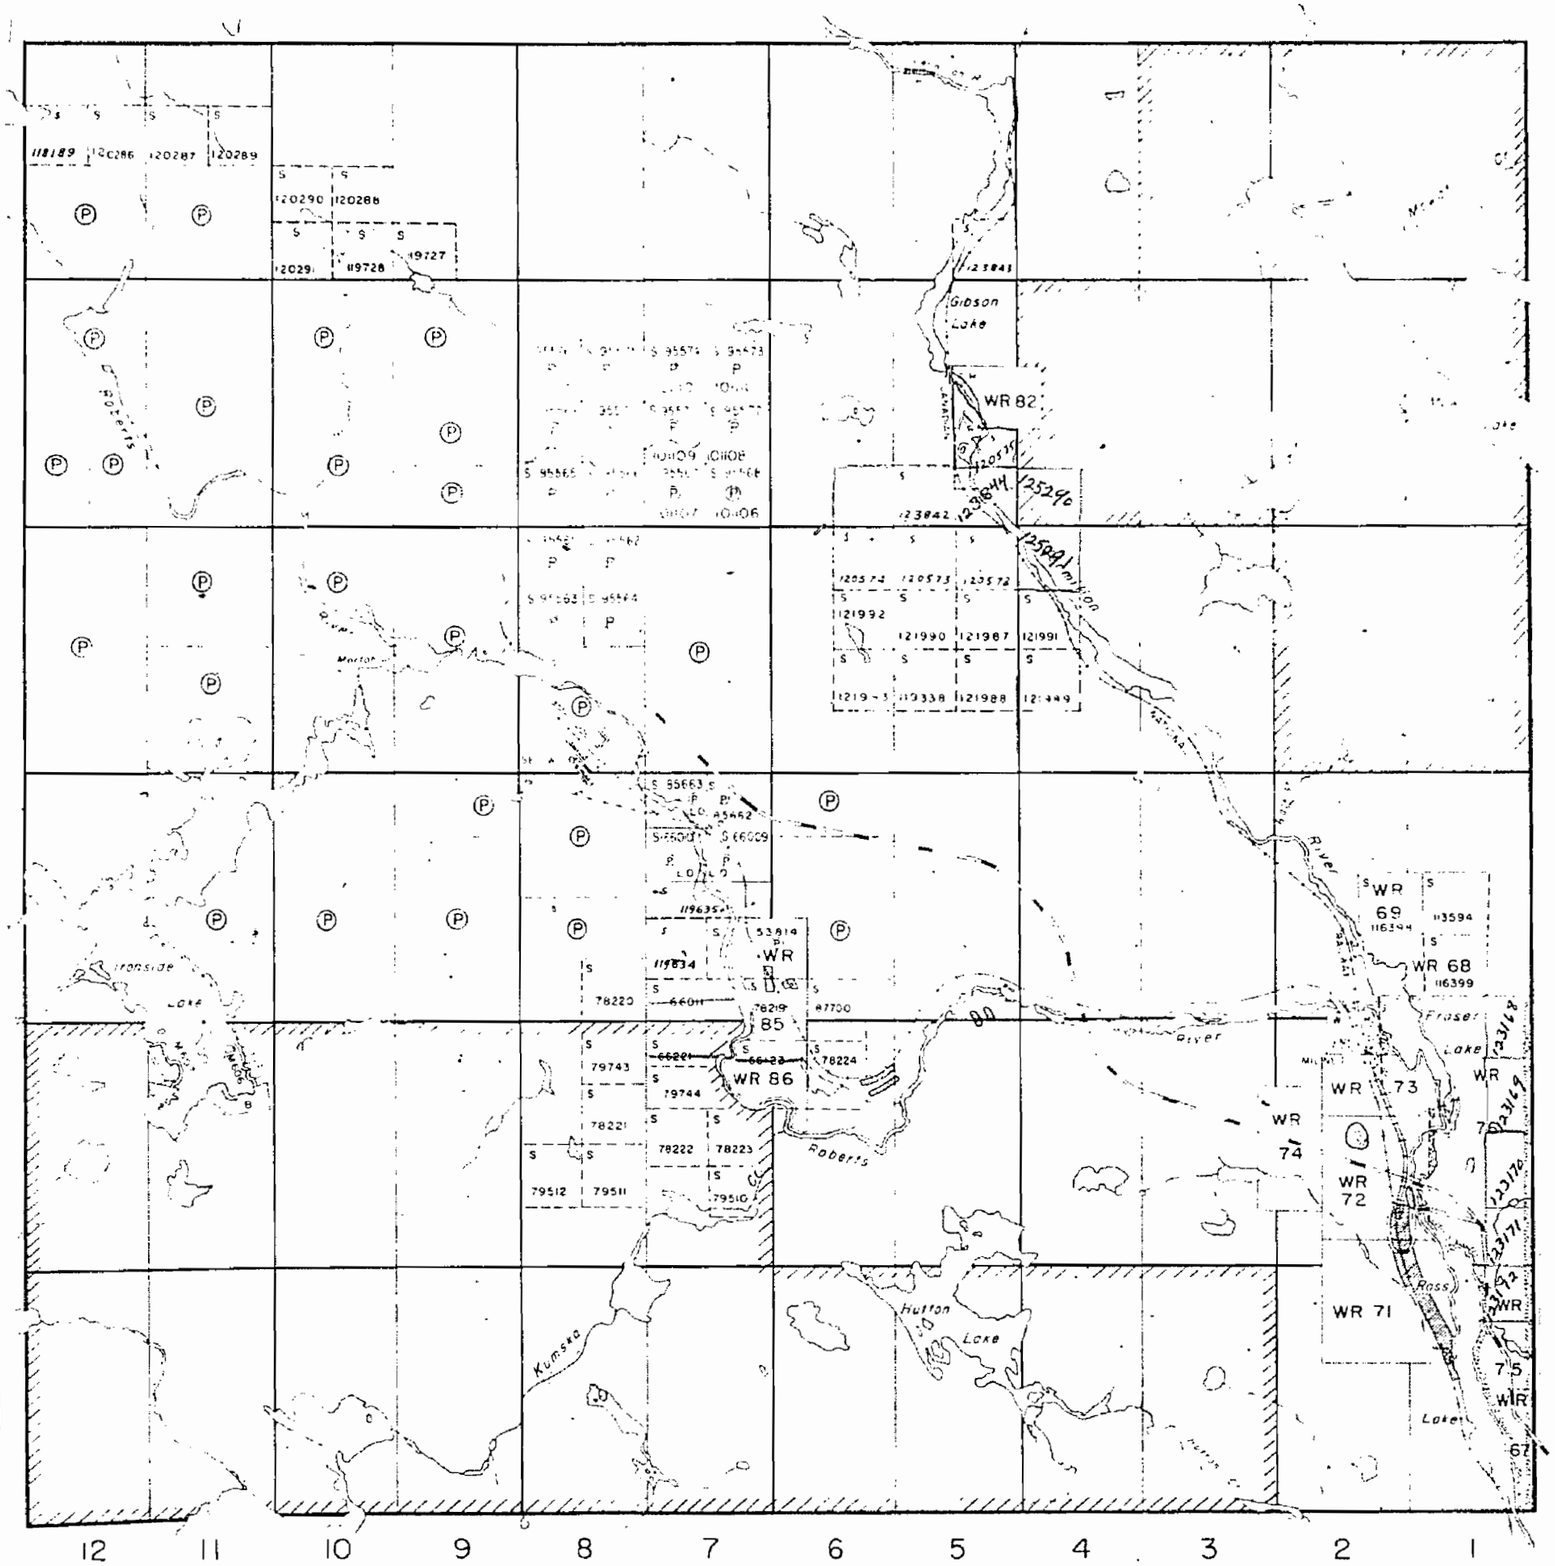

WISNER TWP.

THE TOWNSHIP OF HUTTON

DISTRICT OF SUDBURY

SUDBURY MINING DIVISION

SCALE: 1-INCH = 40 CHAINS

LEGEND

PATENTED LAND	(P)
CROWN LAND SALE	C.S.
LEASES	(L)
LOCATED LAND	Loc
LICENSE OF OCCUPATION	L.O.
MINING RIGHTS ONLY	M.R.O.
SURFACE RIGHTS ONLY	S.R.O.
ROADS	
IMPROVED ROADS	
KING'S HIGHWAYS	
RAILWAYS	
POWER LINES	
MARSH OR MUSKEG	
MINES	
CANCELLED	C.

NOTES

400' Surface Rights Reservation around all lakes and rivers

Lots 1 to 6, concessions 1 to 6 may be staked in the same manner as mining claims in unsurveyed territory. May 16, 1946 — File 83.5 — Mining Act Sec. 53 (52 A 1946)

Land required for railway purposes shown thus:

Files 4826 & 4841.

Dept of Highways' gravel pits shown thus:

Staking may be carried out for any other mineral other than alluvial mineral under Sec. 36(d) of the Mining Act shown thus: Now covered by Mg. Lease 13544 — Placer Only.

Parts of the subdivision shown thus: are annulled under the authority of the Minister of Lands & Forests

PLAN NO.- M-944

DEPARTMENT OF MINES

— ONTARIO —

M-944

CREELMAN TWP.


VI

V

IV

KITCHENER TWP.

PARKIN TWP.

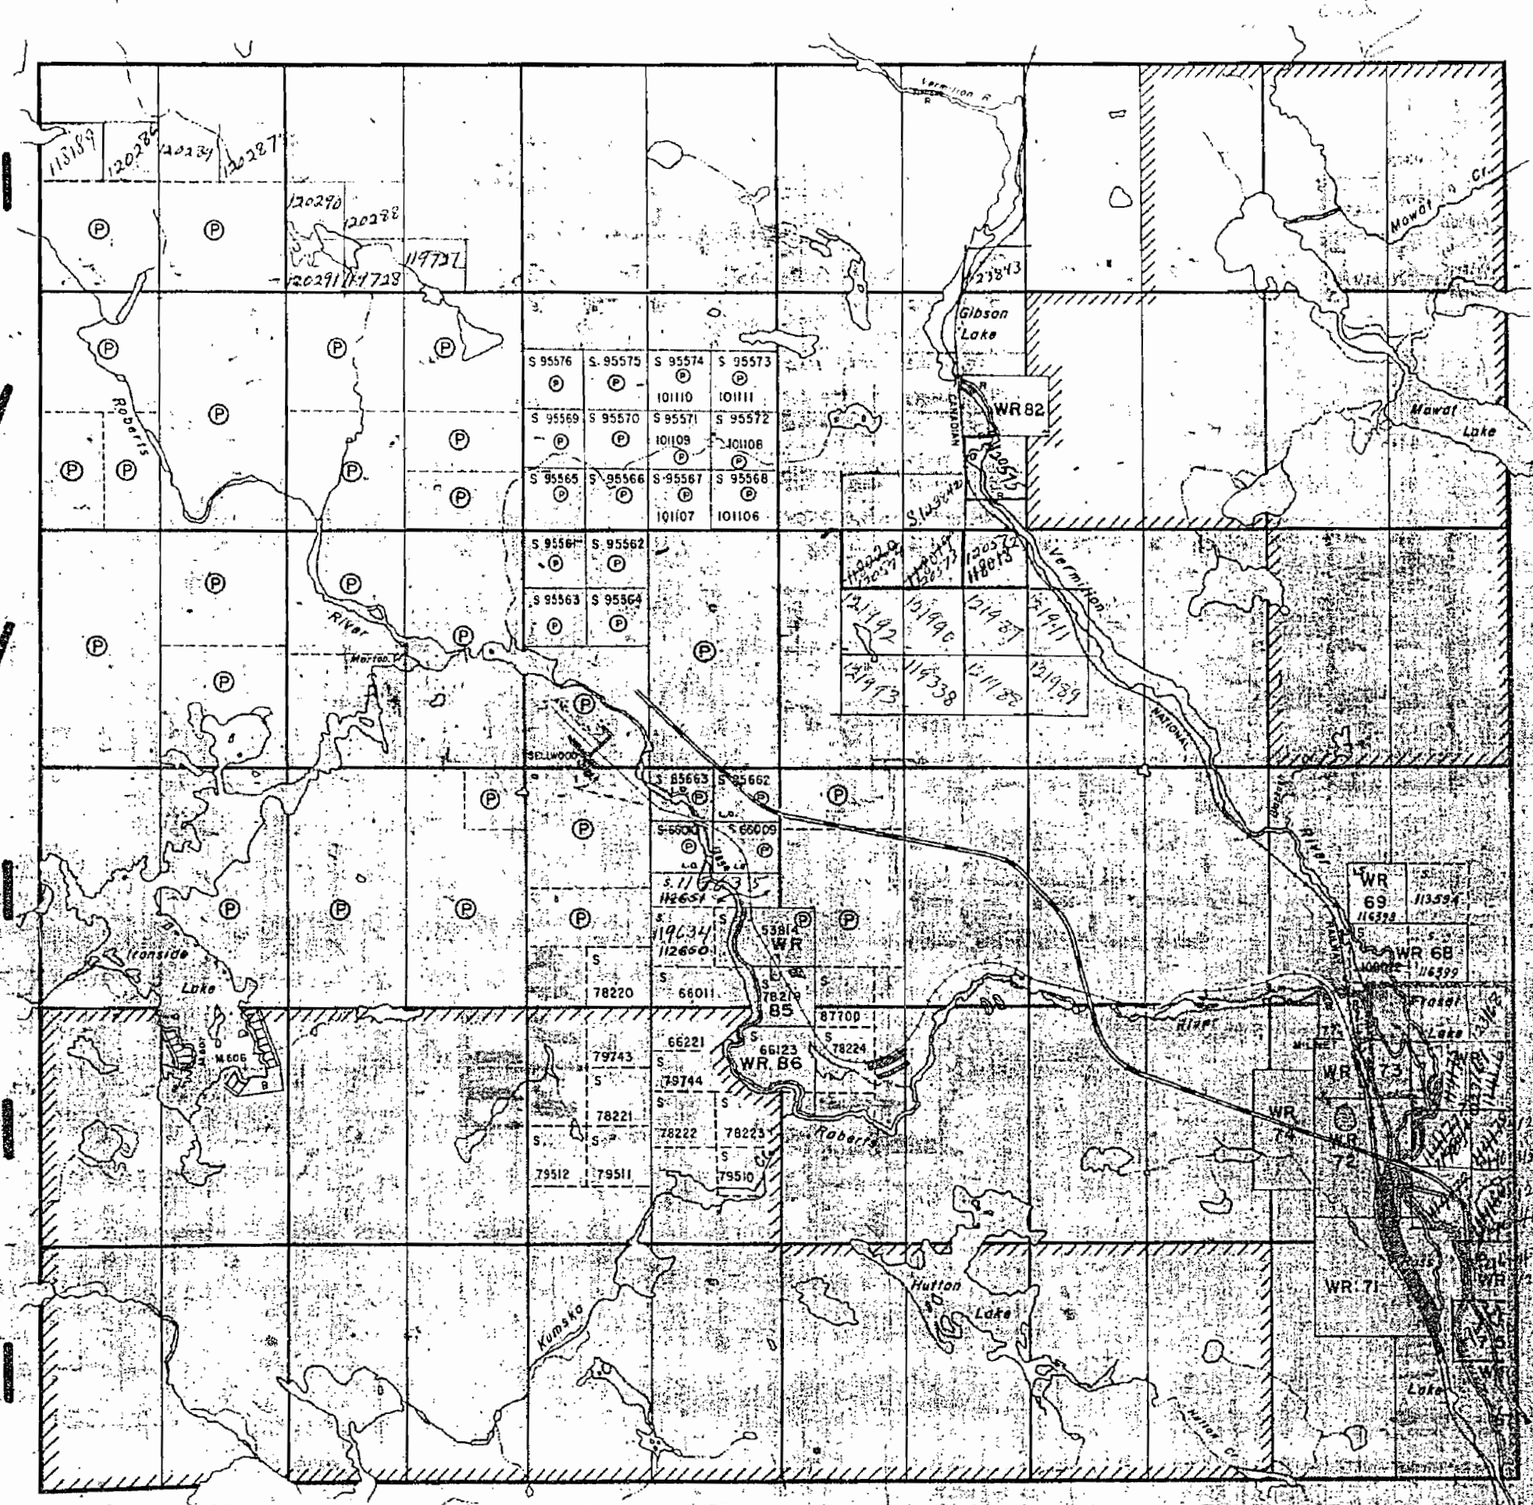

M-944

CREELMAN TWP.

annulled portion

THE TOWNSHIP OF HUTTON TWP.

DISTRICT OF SUDBURY

SUDBURY MINING DIVISION

SCALE: 1-INCH=40 CHAINS

LEGEND

PATENTED LAND	(P)
CROWN LAND SALE	C.S.
LEASES	(L)
LOCATED LAND	Loc.
LICENSE OF OCCUPATION	L.O.
MINING RIGHTS ONLY	M.R.O.
SURFACE RIGHTS ONLY	S.R.O.
ROADS	
IMPROVED ROADS	
KING'S HIGHWAYS	
RAILWAYS	
POWER LINES	
MARSH OR MUSKEG	
MINES	
CANCELLED	C.

NOTES

400' Reserve around all Lakes and Rivers to Dept. of Lands & Forests.

Lots 1 to 6, concessions 1 to 6 may be staked in the same manner as mining claims in unsurveyed territory. May 16, 1946 — File 83.5 — Mining Act 52 part 2 — 53

Land required for railway purposes shown thus:

Files 4326 & 4841.

Dept. of Highways' gravel pit shown thus:

PLAN NO. M-944

DEPARTMENT OF MINES

— ONTARIO —

VI

V

IV

KITCHENER TWP.

PARKIN TWP.

WISNER TWP.

annulled portion

12 11 10 9 8 7 6 5 4 3 2 1

Vermilion R.

Gibson Lake

Mowat Cr.

Mowat Lake

WR 82

Roberts River

Marion Cr.

Ironside Lake

Kumska

Hutton Lake

Fraser Lake

WR 86

WR 85

WR 74

WR 73

WR 72

WR 71

WR 68

WR 67

Application for Exploring & Plan Permit

M 944

CREELMAN TWP.

N

KITCHENER TWP.

PARKIN TWP.

Gibson L.

Mowat L.

Sellwood

Iron side L.

Fraser L.

Milnet

Roberts R.

Hutton L.

Ross

WR 82

WR 69

WR 68

WR 73

WR 74

WR 72

WR 76

WR 75

WR 67

WR 71

DEVELOPMENT PIT

VI

V

IV

III

II

I

12 11 10 9 8 7 6 5 4 3 2 1

WISNER TWP.

66' wide reservations on surface by Dept of L. & F. shewn hereon thus .....

THE TOWNSHIP OF

HUTTON

DISTRICT OF SUDBURY

SUDBURY MINING DIVISION

SCALE 1 INCH TO 40 CHAINS

LEGEND

PATENTED LANDS	(P)
CROWN LAND SALES	(S)
LOCATED LANDS	Loc.
LICENSE OF OCCUPATION	L.O.
ROADS	═══
CANADIAN NATIONAL RAILWAY	═══

NOTES

LOTS 1 TO 6, CONCESSIONS 7 TO 6 MAY BE STAKED IN THE SAME MANNER AS MINING CLAIMS IN UNSURVEYED TERRITORY.

MG LEASE # 10887 CNWA TIN PLACER GOLD LTD. SHOWN THUS: — — —

Notice of determination on mining lease # 10887 Sept. 5/57

See page file

over flat - established and extends from C.N.R. on 3 easterly to T.P. line

M944

DEPARTMENT OF MINES
ONTARIO

M-944

CREELMAN TWP. M.737

KITCHENER TWP. M.973

PARKIN TWP. M.1049

WISNER TWP. M.1185

VI

V


IV

III

II

I

12 11 10 9 8 7 6 5 4 3 2 1

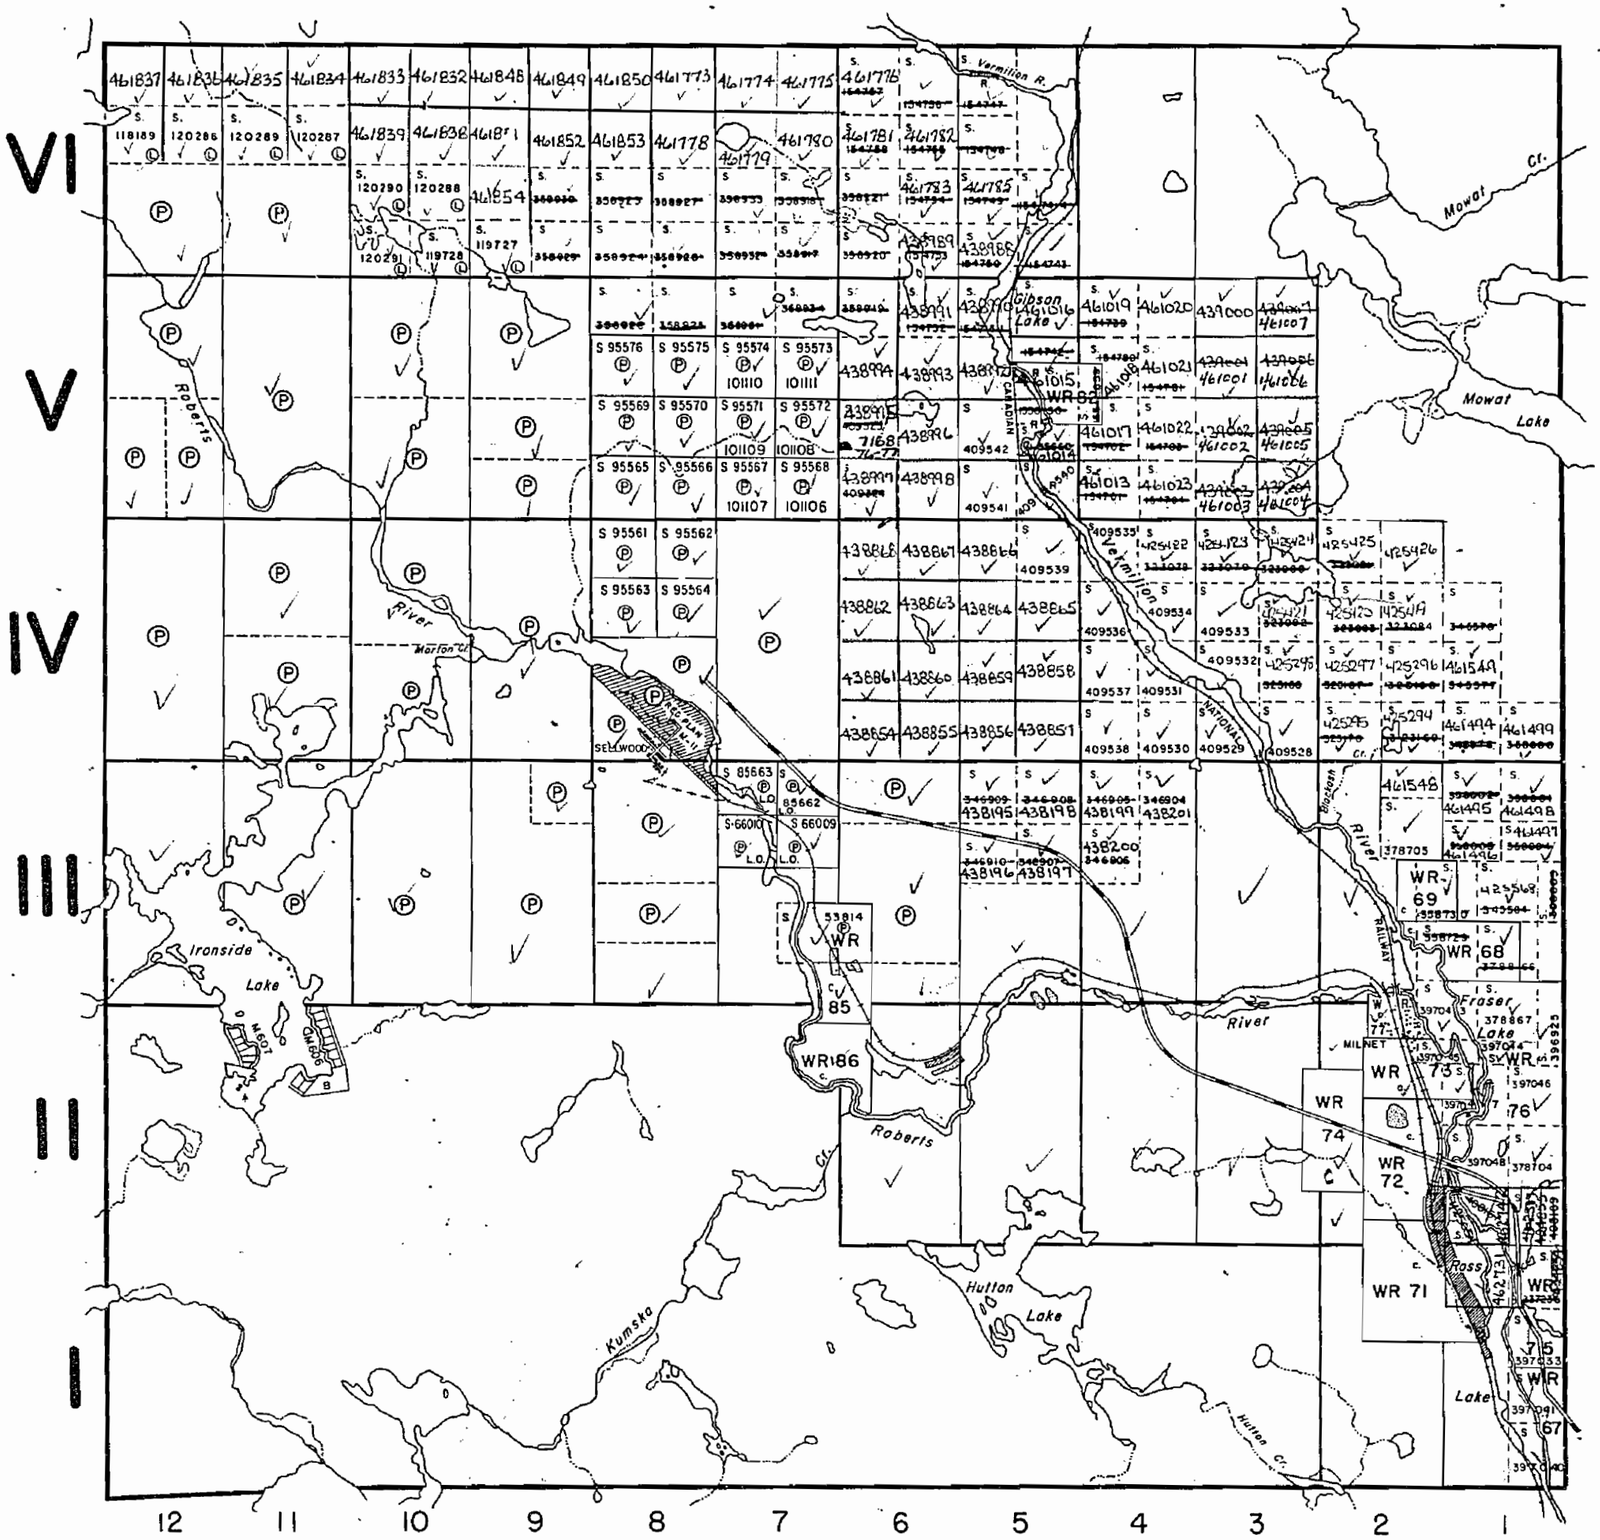

THE TOWNSHIP OF

HUTTON

DISTRICT OF SUDBURY

SUDBURY MINING DIVISION

SCALE: 1-INCH=40 CHAINS

LEGEND

PATENTED LAND	(P)
CROWN LAND SALE	C.S.
LEASES	(L)
LOCATED LAND	Loc.
LICENSE OF OCCUPATION	L.O.
MINING RIGHTS ONLY	M.R.O.
SURFACE RIGHTS ONLY	S.R.O.
ROADS	
IMPROVED ROADS	
KING'S HIGHWAYS	
RAILWAYS	
POWER LINES	
MARSH OR MUSKEG	
MINES	
CANCELLED	C.

NOTES

400' Surface Rights Reservation along the shores of all lakes and rivers.

Lots 1 to 6, concessions 1 to 6 may be staked in the same manner as mining claims in unsurveyed territory. May 16, 1946 — File 83.5 — Mining Act Sec.53 (52 A 1946).

Land required for railway purposes shown thus: Files 4826 & 4841.

Parts of Con. 1, 2, 4, 5 B6: Subdivision Annulled.

M.T.C. Gravel pits shown thus: IN GOOD STANDING

DATE OF ISSUE OCT 31 1974

HUTTON

PLAN NO.- M-944

ONTARIO

MINISTRY OF NATURAL RESOURCES

SURVEYS AND MAPPING BRANCH

944

CREELMAN TWP.

SEP 7

VI

V

IV

TWP.

KITCHENER

PARKIN TWP.

Vermilion R.

Gibson Lake

Mowat Cr.

Mowat Lake

Roberts

Iron Ide Lake

Roberts River

Hutton Lake

Kumsko

Hutton Cr.

Foss Lake

WR 85

WR 86

WR 74

WR 72

WR 71

WR 69

WR 68

12 11 10 9 8 7 6 5 4 3 2 1

WISNER TWP.

THE TOWNSHIP OF

HUTTON

DISTRICT OF SUDBURY

SUDBURY MINING DIVISION

SCALE: 1-INCH=40 CHAINS

LEGEND

PATENTED LAND	(P)
CROWN LAND SALE	C.S.
LEASES	(L)
LOCATED LAND	Loc.
LICENSE OF OCCUPATION	L.O.
MINING RIGHTS ONLY	M.R.O.
SURFACE RIGHTS ONLY	S.R.O.
ROADS	
IMPROVED ROADS	
KING'S HIGHWAYS	
RAILWAYS	
POWER LINES	
MARSH OR MUSKEG	
MINES	
CANCELLED	C.

NOTES

400' Surface Rights Reservation around all lakes and rivers.

Lots 1 to 6, concessions 1 to 6 may be staked in the same manner as mining claims in unsurveyed territory. May 16, 1946 — File 83.5 — Mining Act Sec. 53 (52 A 1946).

Land required for railway purposes shown thus: ▬▬▬

Files 4826 & 4841.

Dept. of Highways' gravel pits shown thus: ▬▬ ◎ In good Standing

Parts of the subdivision shown thus: ▨ are annulled under the authority of the Minister of Lands & Forests.

HUTTON

PLAN NO.- M-944

ONTARIO

MINISTRY OF NATURAL RESOURCES

SURVEYS AND MAPPING BRANCH

M 944

CREELMAN TWP.

KITCHENER TWP.

PARKIN TWP.


WISNER TWP.

VI

V

IV

12 11 10 9 8 7 6 5 4 3 2 1

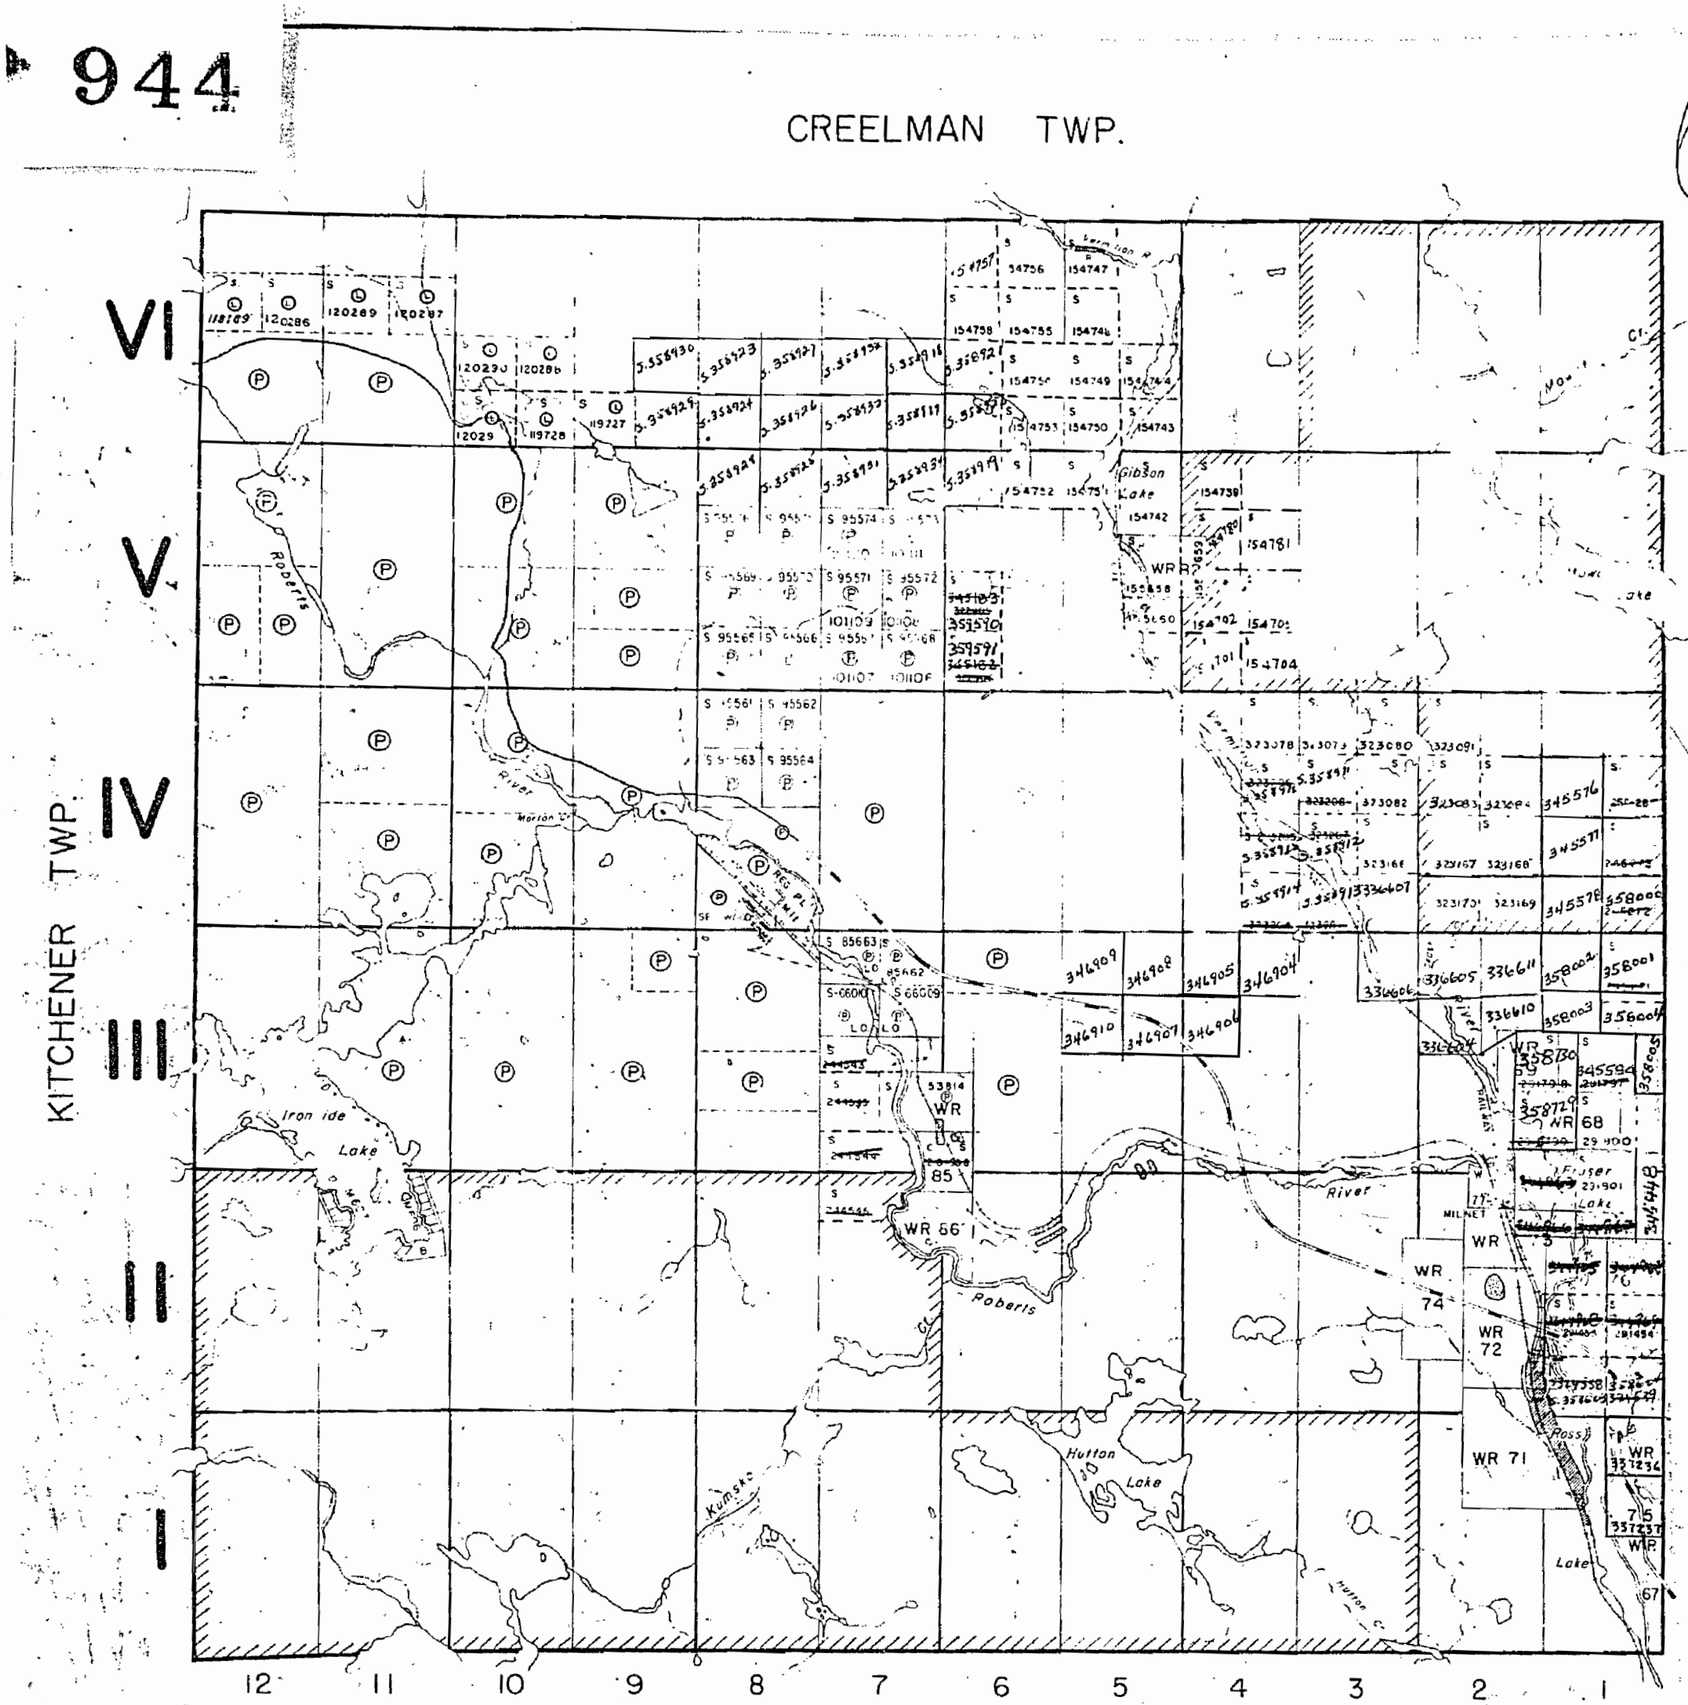

THE TOWNSHIP OF HUTTON

DISTRICT OF SUDBURY

SUDBURY MINING DIVISION

SCALE: 1-INCH=40 CHAINS

LEGEND

PATENTED LAND	(P)
CROWN LAND SALE	C.S.
LEASES	(L)
LOCATED LAND	Loc.
LICENSE OF OCCUPATION	L.O.
MINING RIGHTS ONLY	M.R.O.
SURFACE RIGHTS ONLY	S.R.O.
ROADS	
IMPROVED ROADS	
KING'S HIGHWAYS	
RAILWAYS	
POWER LINES	
MARSH OR MUSKEG	
MINES	
CANCELLED	C.

NOTES

400' Surface Rights Reservation around all lakes and rivers.

Lots 1 to 6, concessions 1 to 6 may be staked in the same manner as mining claims in unsurveyed territory. May 16, 1946 — File 83.5 — Mining Act Sec. 53 S 4, 19 (52 A 1946).

Land required for railway purposes shown thus:

Files 4826 & 4841.

Dept of Highways' gravel pits shown thus:

Parts of the subdivision shown thus: are annulled under the authority of the Minister of Lands & Forests.

PLAN NO.- M-944

ONTARIO DEPARTMENT OF MINES AND NORTHERN AFFAIRS

M 944

CREELMAN TWP.

VI

V

IV

KITCHENER TWP.

PARKIN TWP.

WISNER TWP.

12 11 10 9 8 7 6 5 4 3 2 1

Vermilion R.

Gibson Lake

Mowat Cr.

Mowat Lake

Roberts

Morison L.

River

Sellwood

Ironside Lake

Hutton Lake

Kumsko

Fraser Lake

Ross Lake

Hutton Cr.

WR 69 29179 29179 8

WR 68 29180 268566

WR 73

WR 74

WR 72

WR 71

WR 75

WR 67

WR 86

WR 85

THE TOWNSHIP OF

HUTTON

DISTRICT OF SUDBURY

SUDBURY MINING DIVISION

SCALE 1-INCH=40 CHAINS

LEGEND

PATENTED LAND	P
CROWN LAND SALE	C.S.
LEASES	L
LOCATED LAND	Loc.
LICENSE OF OCCUPATION	L.O.
MINING RIGHTS ONLY	M.R.O.
SURFACE RIGHTS ONLY	S.R.O.
ROADS	
IMPROVED ROADS	
KING'S HIGHWAYS	
RAILWAYS	
POWER LINES	
MARSH OR MUSKEG	
MINES	
CANCELLED	C.

NOTES

400' Surface Rights Reservation around all lakes and rivers.

Lots 1 to 6, concessions I to 6 may be staked in the same manner as mining claims in unsurveyed territory. May 16, 1946 — File 83.5 — Mining Act Sec. 53 54 (52 A 1946).

Land required for railway purposes shown thus: Files 4826 & 4841.

Dept of Highways' gravel pits shown thus:

Parts of the subdivision shown thus: are annulled under the authority of the Minister of Lands & Forests.

PLAN NO.- M-944

DEPARTMENT OF MINES

— ONTARIO —

M-944

CREELMAN TWP.

KITCHENER TWP.

PARKIN TWP.

WISNER TWP.

VI

V

IV

III

12 11 10 9 8 7 6 5 4 3 2 1

Roberts River

Vermilion River

Gibson Lake

Mowat Lake

Ironside Lake

Fraser Lake

Hutton Lake

Kumsto Lake

Roberts Cr.

Hutton Cr.

Vermilion River

WR 66

WR 68

WR 69

WR 71

WR 72

WR 73

WR 74

WR 75

WR 76

WR 85

THE TOWNSHIP OF

HUTTON

DISTRICT OF SUDBURY

SUDBURY MINING DIVISION

SCALE: 1-INCH=40 CHAINS

LEGEND

PATENTED LAND	P
CROWN LAND SALE	C.S.
LEASES	L
LOCATED LAND	Loc.
LICENSE OF OCCUPATION	L.O.
MINING RIGHTS ONLY	M.R.O.
SURFACE RIGHTS ONLY	S.R.O.
ROADS	
IMPROVED ROADS	
KING'S HIGHWAYS	
RAILWAYS	
POWER LINES	
MARSH OR MUSKEG	
MINES	
CANCELLED	C.

NOTES

400' Surface Rights Reservation around all lakes and rivers.

Lots 1 to 6, concessions 1 to 6 may be staked in the same manner as mining claims in unsurveyed territory. May 16, 1946 — File 83.5 — Mining Act Sec. 53 (52 A 1946).

Land required for railway purposes shown thus:

Files 4826 & 4841.

Dept of Highways' gravel pits shown thus:


Parts of the subdivision shown thus: are annulled under the authority of the Minister of Lands & Forests.

PLAN NO.- M-944

DEPARTMENT OF MINES

— ONTARIO —

SUDBURY MINING DIV. RECEIVED MAR 19 1969

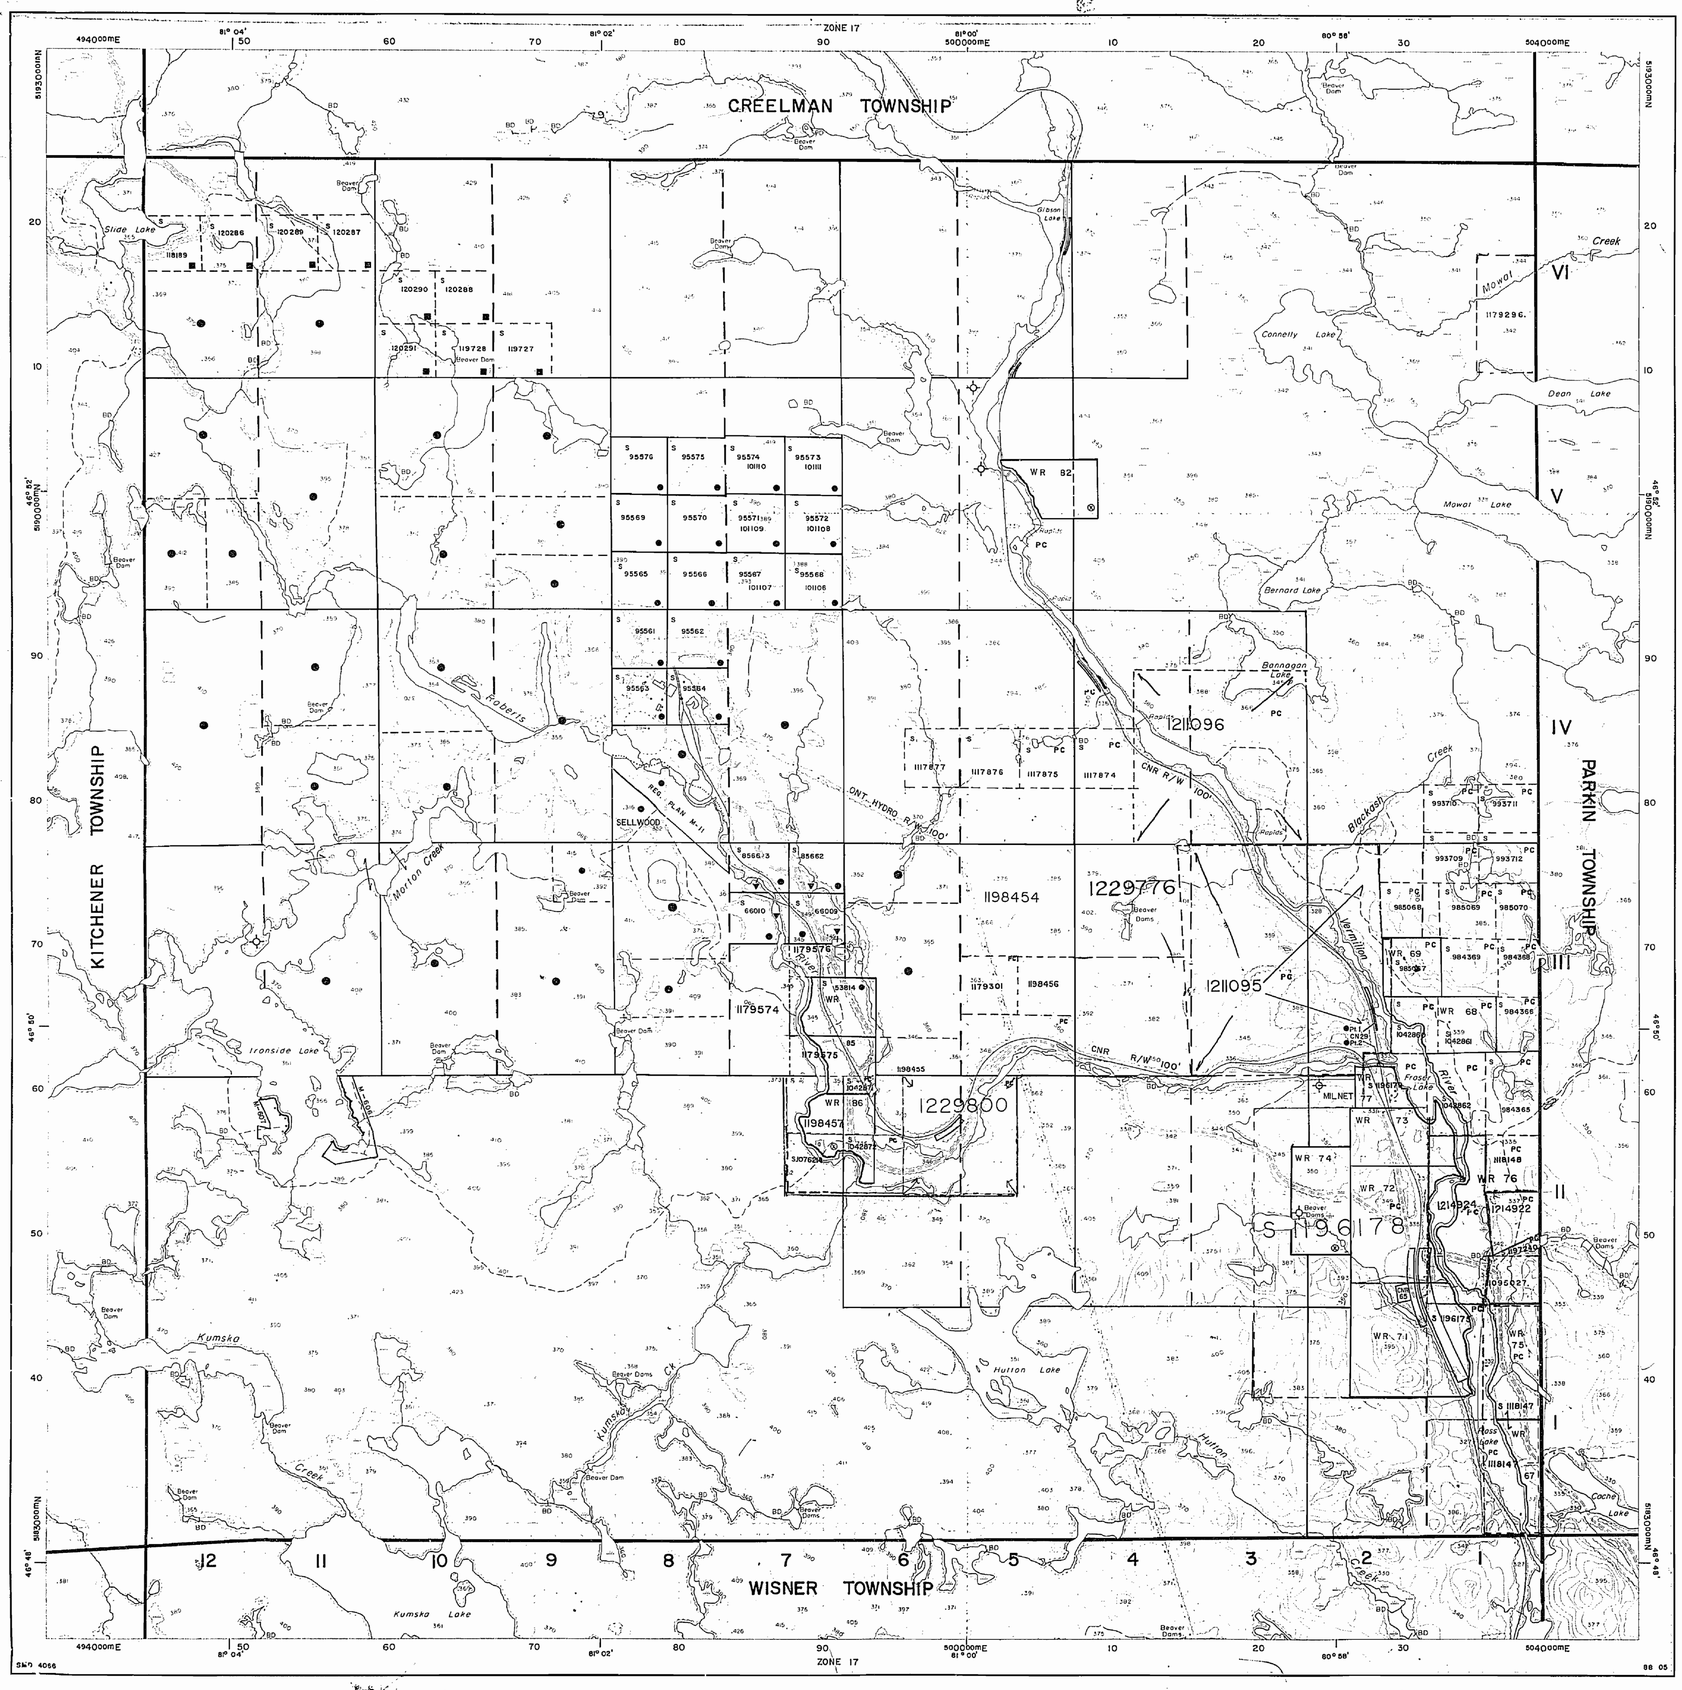
CREELMAN TOWNSHIP
KITCHENER TOWNSHIP
PARKIN TOWNSHIP
WISNER TOWNSHIP
ZONE 17
494000mE
500000mE
504000mE
5930000mN
5920000mN
5910000mN
5900000mN
5890000mN
81° 04'
81° 02'
81° 00'
80° 58'
46° 52'
46° 50'
46° 48'
Slide Lake
Glasson Lake
Connelly Lake
Mowat Lake
Dean Lake
Bernard Lake
Bonnagon Lake
Roberts Creek
Morton Creek
Ironside Lake
Kumsko Creek
Hutton Lake
Blackstone Creek
Cache Lake
Loss Lake
Fraser Lake
Beaver Dam
CNR R/W 100'
ONT. HYDRO R/W 100'
PLAN M-11
SELLWOOD
WR 82
WR 86
WR 69
WR 68
WR 73
WR 74
WR 72
WR 71
WR 77
WR 76
WR 75
WR 67
MIL NET
CN 29
CP 21
I 042862
I 042877
I 042861
I 042860
I 042863
I 042864
I

CREELMAN TWP.

KITCHENER TWP.

PARKIN T.W.P.

WISNER TWP.

VI

V

IV

III

II

I

12 11 10 9 8 7 6 5 4 3 2 1

THE TOWNSHIP OF HUTTON TWP.

DISTRICT OF SUDBURY

SUDBURY MINING DIVISION

SCALE: 1-INCH=40 CHAINS

LEGEND

PATENTED LAND	(P)
CROWN LAND SALE	C.S.
LEASES	(L)
LOCATED LAND	Loc.
LICENSE OF OCCUPATION	L.O.
MINING RIGHTS ONLY	M.R.O.
SURFACE RIGHTS ONLY	S.R.O.
ROADS	
IMPROVED ROADS	
KING'S HIGHWAYS	
RAILWAYS	
POWER LINES	
MARSH OR MUSKEG	
MINES	
CANCELLED	C.

NOTES

400' Reserve around all Lakes and Rivers to Dept of Lands & Forests.

Lots 1 to 6, concessions 1 to 8 may be staked in the same manner as mining claims in unsurveyed territory. -May 16, 1946. -File 83.5 - Mining Act Sec. 53 - (52 A 1946)

Land required for railway purposes shown thus: Files 4826 & 4841

Dept of Highways' gravel pit shown thus:

Staking may be carried out for any other mineral other than alluvial mineral under sec. 36 (d) of the Mining Act shown thus: Now Covered By Mg. Lease 13544. Placer Only

Parts of the Subdivision shown outlined thus: are annulled under the authority of the Minister of Lands & Forests.

PLAN NO.- M-944

DEPARTMENT OF MINES

— ONTARIO —

THE TOWNSHIP OF HUTTON

DISTRICT OF SUDBURY

SUDBURY MINING DIVISION

SCALE 1 INCH TO 40 CHAINS

GREELMAN TWP.

WISNER TWP.

KITCHENER TWP.

PARKIN TWP.

VI

V

IV

III

II

I

12 11 10 9 8 7 6 5 4 3 2 1

10 8 6 4 2 | 2 4 6 8 10

Gibson

Sellwood

Ironside L.

Roberts R.

Milnet

Hutton L.

Frisken L.

Ross L.

Mowat L.

Mississagi R.

WR 82

WR 69

WR 68

WR 74

WR 73

WR 72

WR 71

WR 75

WR 76

WR 67

LEGEND

PATENTED LANDS (P)
CROWN LAND SALES (S)
LOCATED LANDS L.O.
LICENSE OF OCCUPATION
ROADS
CANADIAN NATIONAL RAILWAY

NOTES

LOTS 1 TO 6 CONCESSIONS I TO 6 MAY BE STAKED IN THE SAME MANNER AS MINING CLAIMS IN UNSURVEYED TERRITORY.

MG. LEASE * 0687 ONWATIN PLACER GOLD LTD. SHOWN THUS ———

400' wide reservations on surface by Dept of L. & F. shown hereon thus ———

M944

DEPARTMENT OF MINES
ONTARIO

52A

CREELMAN TWP.

KITCHENER TWP.

PARKIN TWP.

WISNER TWP.

VI

V

IV

12 11 10 9 8 7 6 5 4 3 2 1

Vermilion R.

Gibson Lake

Mowat Lake

Roberts

Marion River

Iron ide Lake

Hutton Lake

Kumske

Ross

Fraser Lake

Hutton C.

WR 66

WR 68

WR 71

WR 72

WR 74

THE TOWNSHIP OF HUTTON

DISTRICT OF SUDBURY

SUDBURY MINING DIVISION

SCALE: 1-INCH=40 CHAINS

LEGEND

PATENTED LAND	P
CROWN LAND SALE	C.S.
LEASES	L
LOCATED LAND	Loc.
LICENSE OF OCCUPATION	L.O.
MINING RIGHTS ONLY	M.R.O.
SURFACE RIGHTS ONLY	S.R.O.
ROADS	
IMPROVED ROADS	
KING'S HIGHWAYS	
RAILWAYS	
POWER LINES	
MARSH OR MUSKEG	
MINES	
CANCELLED	C.

NOTES

400' Surface Rights Reservation around all lakes and rivers.

Lots 1 to 6, concessions I to 6 may be staked in the same manner as mining claims in unsurveyed territory. May 16, 1946 — File 83.5 — Mining Act Sec. 53 S 4, 19 (52 A 1946).

Land required for railway purposes shown thus:

Files 4826 & 4841.

Dept. of Highways' gravel pits shown thus:

Parts of the subdivision shown thus: are annulled under the authority of the Minister of Lands & Forests.

PLAN NO.- M-944

ONTARIO DEPARTMENT OF MINES AND NORTHERN AFFAIRS

TOWNSHIP OF
HUTTON
DISTRICT OF SUDBURY
SUDBURY MINING DIVISION

SCALE 1 INCH TO 40 CHAINS

CREELMAN TWP.

KITCHENER TWP.

PARKIN TWP.

WISNER TWP.

Sellwood

Ironside L.

Roberts R.

Fraser

Milnet

Hutton L.

Ross

VI V IV III II I

12 11 10 9 8 7 6 5 4 3 2 1

LEGEND

PATENTED LANDS	(P)
CROWN LAND SALES	(S)
LOCATED LANDS	Loc.
LICENSE OF OCCUPATION	L.O.
ROADS	═══
CANADIAN NATIONAL RAILWAY	═══

NOTES

LOTS 1 TO 6, CONCESSIONS I TO 6 MAY BE STAKED IN THE SAME MANNER AS MINING CLAIMS IN UNSURVEYED TERRITORY.

MG. LEASE # 10887 ONWATIN PLACER GOLD LTD. SHOWN THUS: ———

400' Rd

66' Road allowance in front of W.R. 85186 Opn. June 1/54 Cl. Aug 10/54 Aug 10/54

200' wide reservations on surface by Dept of L.F.R. shewn hereon thus ▨▨▨▨

M944

DEPARTMENT OF MINES
ONTARIO

10 8 6 4 2 1 2 4

CREELMAN TWP.

SEP 7 19[illegible]

VI

V

IV

KITCHENER TWP.

PARKIN TWP.

12 11 10 9 8 7 6 5 4 3 2 1

WISNER TWP.

THE TOWNSHIP OF

HUTTON

DISTRICT OF SUDBURY

SUDBURY MINING DIVISION

SCALE: 1-INCH=40 CHAINS

LEGEND

PATENTED LAND	(P)
CROWN LAND SALE	C.S.
LEASES	(L)
LOCATED LAND	Loc.
LICENSE OF OCCUPATION	L.O.
MINING RIGHTS ONLY	M.R.O.
SURFACE RIGHTS ONLY	S.R.O.
ROADS	
IMPROVED ROADS	
KING'S HIGHWAYS	
RAILWAYS	
POWER LINES	
MARSH OR MUSKEG	
MINES	
CANCELLED	C.

NOTES

400' Surface Rights Reservation around all lakes and rivers.

Lots 1 to 6, concessions 1 to 6 may be staked in the same manner as mining claims in unsurveyed territory. May 16, 1946 — File 83.5 — Mining Act Sec. 53 (52 A. 1946).

Land required for railway purposes shown thus:

Files 4826 & 4841.

Dept. of Highways' gravel pits shown thus: In good Standing

Parts of the subdivision shown thus: are annulled under the authority of the Minister of Lands & Forests.

HUTTON

PLAN NO.- M-944

ONTARIO

MINISTRY OF NATURAL RESOURCES

SURVEYS AND MAPPING BRANCH

CREELMAN TWP.

VI

V

IV

KITCHENER TWP.

PARKIN TWP.

WISNER TWP.

12 11 10 9 8 7 6 5 4 3 2 1

Vermilion R.

Gibson Lake

Roberts

Morton Cr.

River

Sellwood

Ironside Lake

Kumsko

Hutton Lake

Hutton Cr.

Ross

Lake

Mowat Lake

Mowat

Milnet

Railway

WR 82

WR 85

WR 86

WR 69

WR 68

WR 73

WR 74

WR 72

WR 71

WR 75

WR 67

THE TOWNSHIP OF

HUTTON

DISTRICT OF SUDBURY

SUDBURY MINING DIVISION

SCALE: 1-INCH=40 CHAINS

LEGEND

PATENTED LAND	(P)
CROWN LAND SALE	C.S.
LEASES	(L)
LOCATED LAND	Loc.
LICENSE OF OCCUPATION	L.O.
MINING RIGHTS ONLY	M.R.O.
SURFACE RIGHTS ONLY	S.R.O.
ROADS	
IMPROVED ROADS	
KING'S HIGHWAYS	
RAILWAYS	
POWER LINES	
MARSH OR MUSKEG	
MINES	C.
CANCELLED	

NOTES

400' Surface Rights Reservation around all lakes and rivers.

Lots 1 to 6, concessions 1 to 6 may be staked in the same manner as mining claims in unsurveyed territory. May 16, 1946 — File 83.5 — Mining Act Sec. 53 (52 A 1946).

Land required for railway purposes shown thus:

Files 4826 & 4841.

Dept of Highways' gravel pits shown thus:

Parts of the subdivision shown thus: are annulled under the authority of the Minister of Lands & Forests.

PLAN NO.- M-944

DEPARTMENT OF MINES

— ONTARIO —

CREELMAN TWP.

VI

V

IV

KITCHENER TWP.

PARKIN TWP.

WISNER TWP.

12 11 10 9 8 7 6 5 4 3 2 1

THE TOWNSHIP OF HUTTON

DISTRICT OF SUDBURY

SUDBURY MINING DIVISION

SCALE: 1-INCH=40 CHAINS

LEGEND

PATENTED LAND	P
CROWN LAND SALE	C.S.
LEASES	L
LOCATED LAND	Loc.
LICENSE OF OCCUPATION	L.O.
MINING RIGHTS ONLY	M.R.O.
SURFACE RIGHTS ONLY	S.R.O.
ROADS	
IMPROVED ROADS	
KING'S HIGHWAYS	
RAILWAYS	
POWER LINES	
MARSH OR MUSKEG	
MINES	
CANCELLED	C.

NOTES

400' Surface Rights Reservation around all lakes and rivers.

Lots 1 to 6, concessions 1 to 6 may be staked in the same manner as mining claims in unsurveyed territory. May 16 1946. — File 83.5 — Mining Act Sec. 53 54 (52 A 1946)

Land required for railway purposes shown thus:

Files 4826 & 4841

Dept of Highways' gravel pits shown thus:

Parts of the subdivision shown thus: are annulled under the authority of the Minister of Lands & Forests.

PLAN NO.- M-944

DEPARTMENT OF MINES

— ONTARIO —

CREELMAN TWP.

KITCHENER TWP.

PARKIN TWP.

VI

V

IV

WISNER TWP.

12 11 10 9 8 7 6 5 4 3 2 1

THE TOWNSHIP OF

HUTTON

DISTRICT OF SUDBURY

SUDBURY MINING DIVISION

SCALE: 1-INCH=40 CHAINS

LEGEND

PATENTED LAND	(P)
CROWN LAND SALE	C.S.
LEASES	(L)
LOCATED LAND	Loc.
LICENSE OF OCCUPATION	L.O.
MINING RIGHTS ONLY	M.R.O.
SURFACE RIGHTS ONLY	S.R.O.
ROADS	
IMPROVED ROADS	
KING'S HIGHWAYS	
RAILWAYS	
POWER LINES	
MARSH OR MUSKEG	
MINES	
CANCELLED	C.

NOTES

400' Surface Rights Reservation around all lakes and rivers

Lots 1 to 6, concessions I to 6 may be staked in the same manner as mining claims in unsurveyed territory. May 16, 1946 — File 83.5 — Mining Act Sec. 53 (52 A 1946)

Land required for railway purposes shown thus:

Files 4826 & 4841.

Dept of Highways' gravel pits shown thus:

Staking may be carried out for any other mineral other than alluvial mineral under Sec. 36(d) of the Mining Act shown thus: Now covered by Mg Lease 3544 Placer Only.

Parts of the subdivision shown thus: are annulled under the authority of the Minister of Lands & Forests

PLAN NO.- M-944

DEPARTMENT OF MINES

— ONTARIO —


THE TOWNSHIP OF

HUTTON

DISTRICT OF SUDBURY

SUDBURY MINING DIVISION

SCALE 1 INCH TO 40 CHAINS

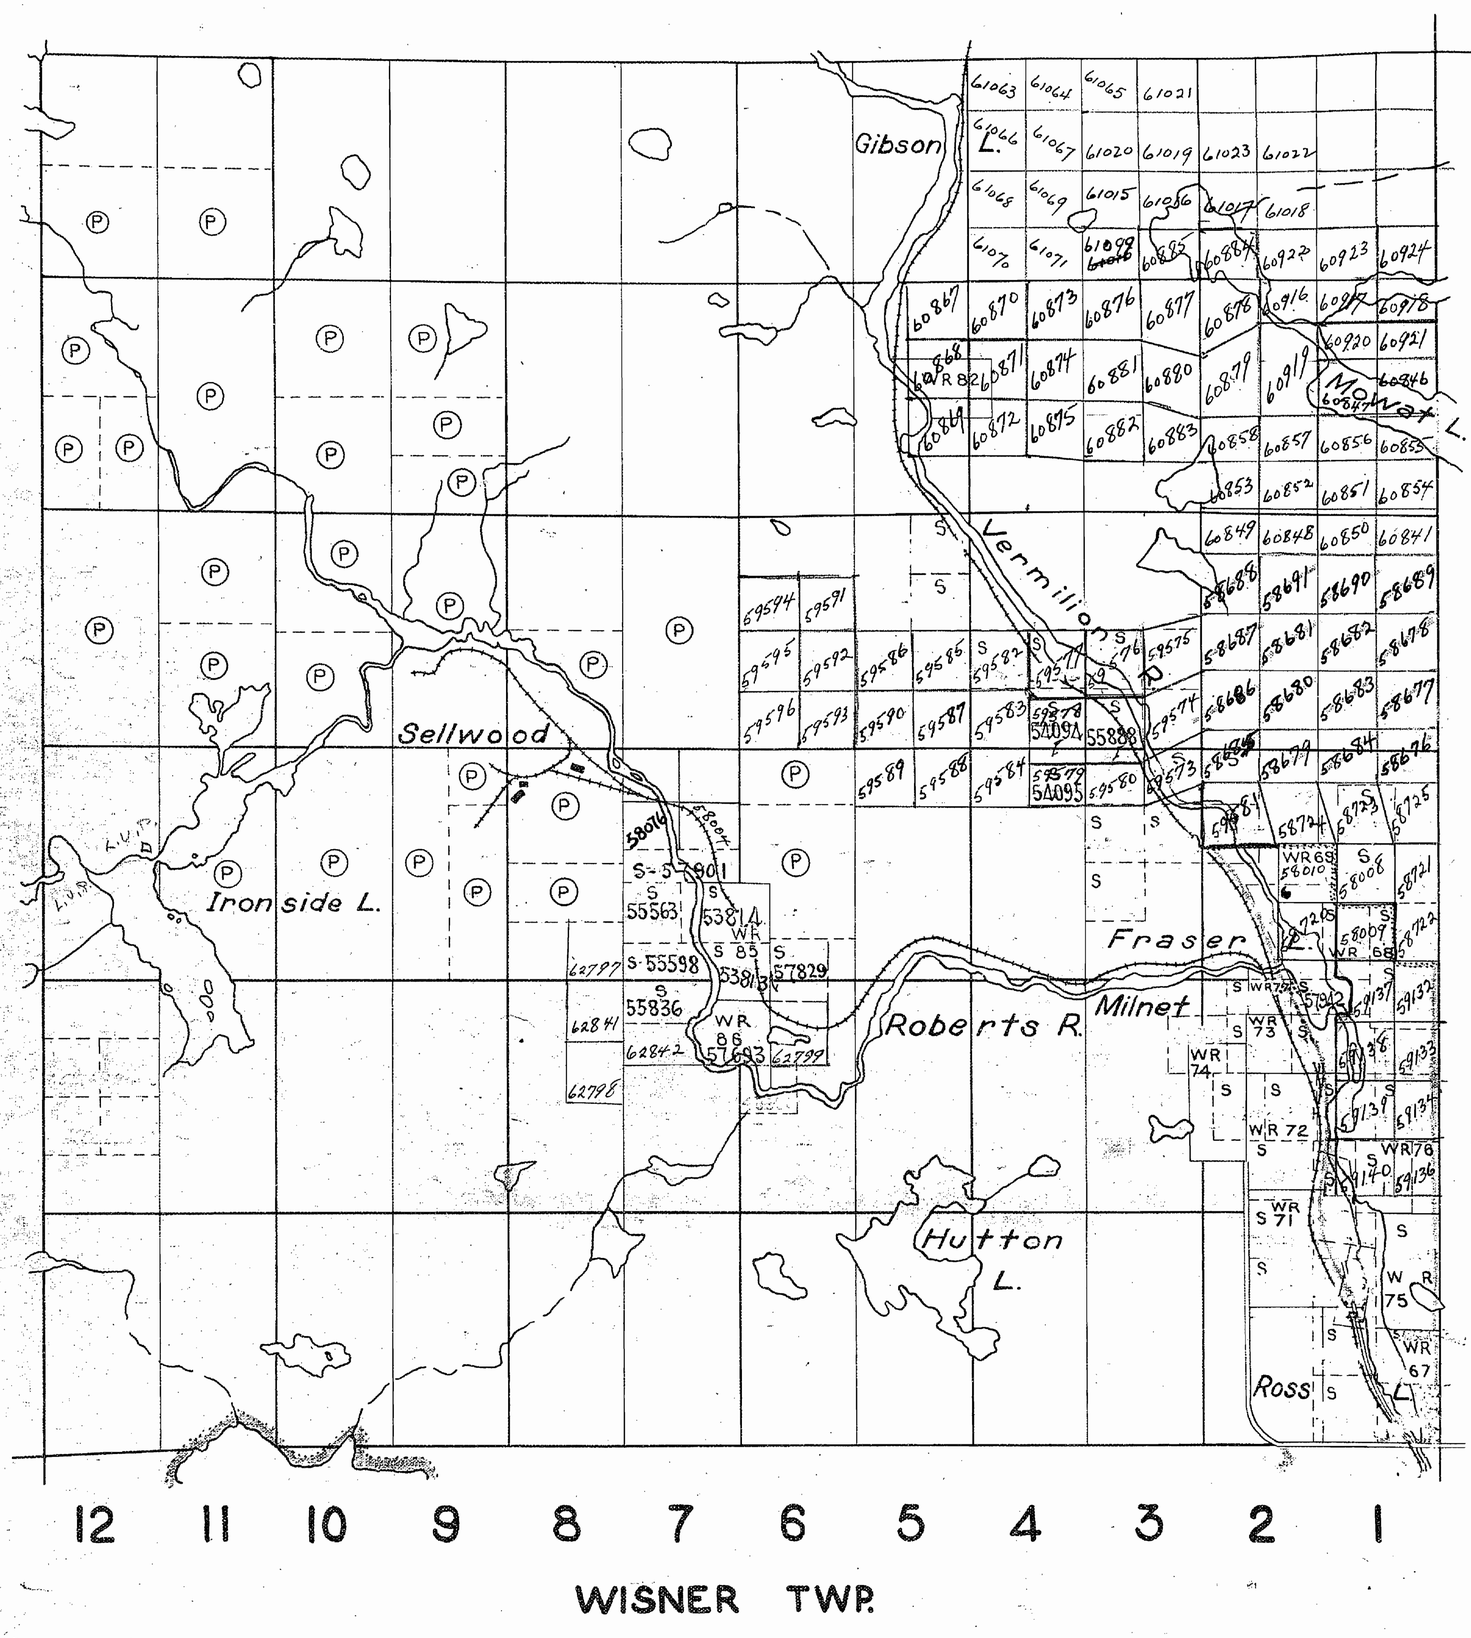

200' wide reservations on surface by Dept of L. & F. shewn hereon thus

LEGEND

PATENTED LANDS	(P)
CROWN LAND SALES	(S)
LOCATED LANDS	Loc.
LICENSE OF OCCUPATION	L.O.
ROADS	═══
CANADIAN NATIONAL RAILWAY	———

NOTES

LOTS 1 TO 6, CONCESSIONS I TO 6 MAY BE STAKED IN THE SAME MANNER AS MINING CLAIMS IN UNSURVEYED TERRITORY.

MG. LEASE # 10887 ONWATER PLACER GOLD LTD. SHOWN THUS: ———

M944

DEPARTMENT OF MINES
ONTARIO


THE
TOWNSHIP OF

HUTTON

DISTRICT OF SUDBURY

SUDBURY MINING DIVISION

SCALE 1 INCH TO 40 CHAINS

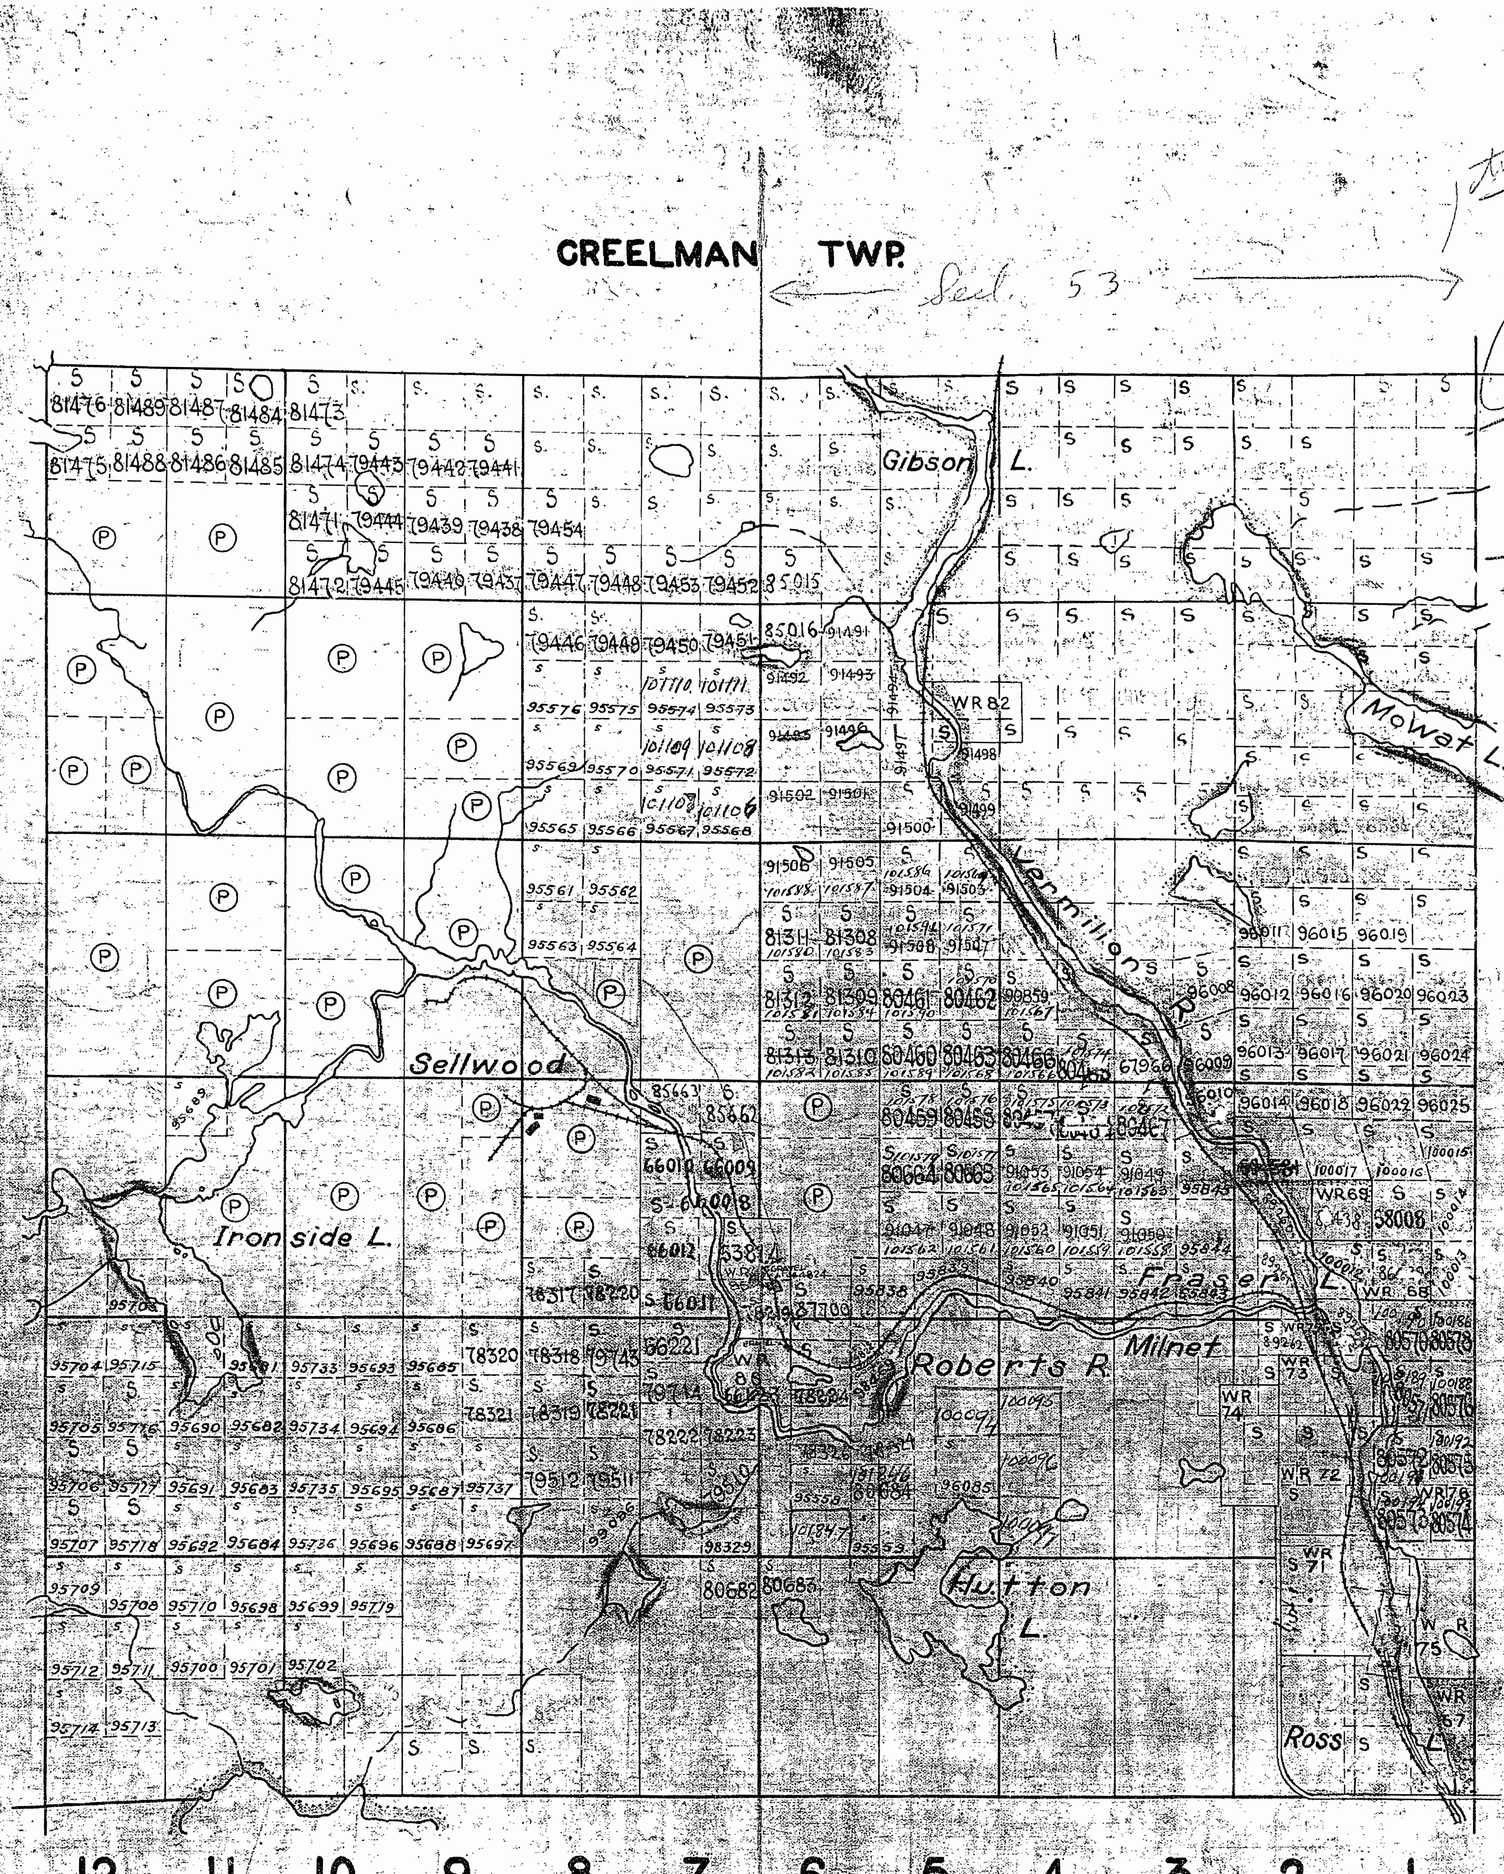

LEGEND

PATENTED LANDS	(P)
CROWN LAND SALES	(S)
LOCATED LANDS	Loc.
LICENSE OF OCCUPATION	L.O.
ROADS	
CANADIAN NATIONAL RAILWAY	

NOTES

LOTS 1 TO 6 CONCESSIONS I TO 6 MAY BE STAKED IN THE SAME MANNER AS MINING CLAIMS IN UNSURVEYED TERRITORY.

MG LEASE # 10687 ONWATIN PLACER GOLD LTD. SHOWN THUS:

Wide reservations on surface by Dept of L.N.R. shown hereon thus

M944


DEPARTMENT OF MINES
ONTARIO

THE TOWNSHIP OF HUTTON

DISTRICT OF SUDBURY

SUDBURY MINING DIVISION

SCALE 1 INCH TO 40 CHAINS

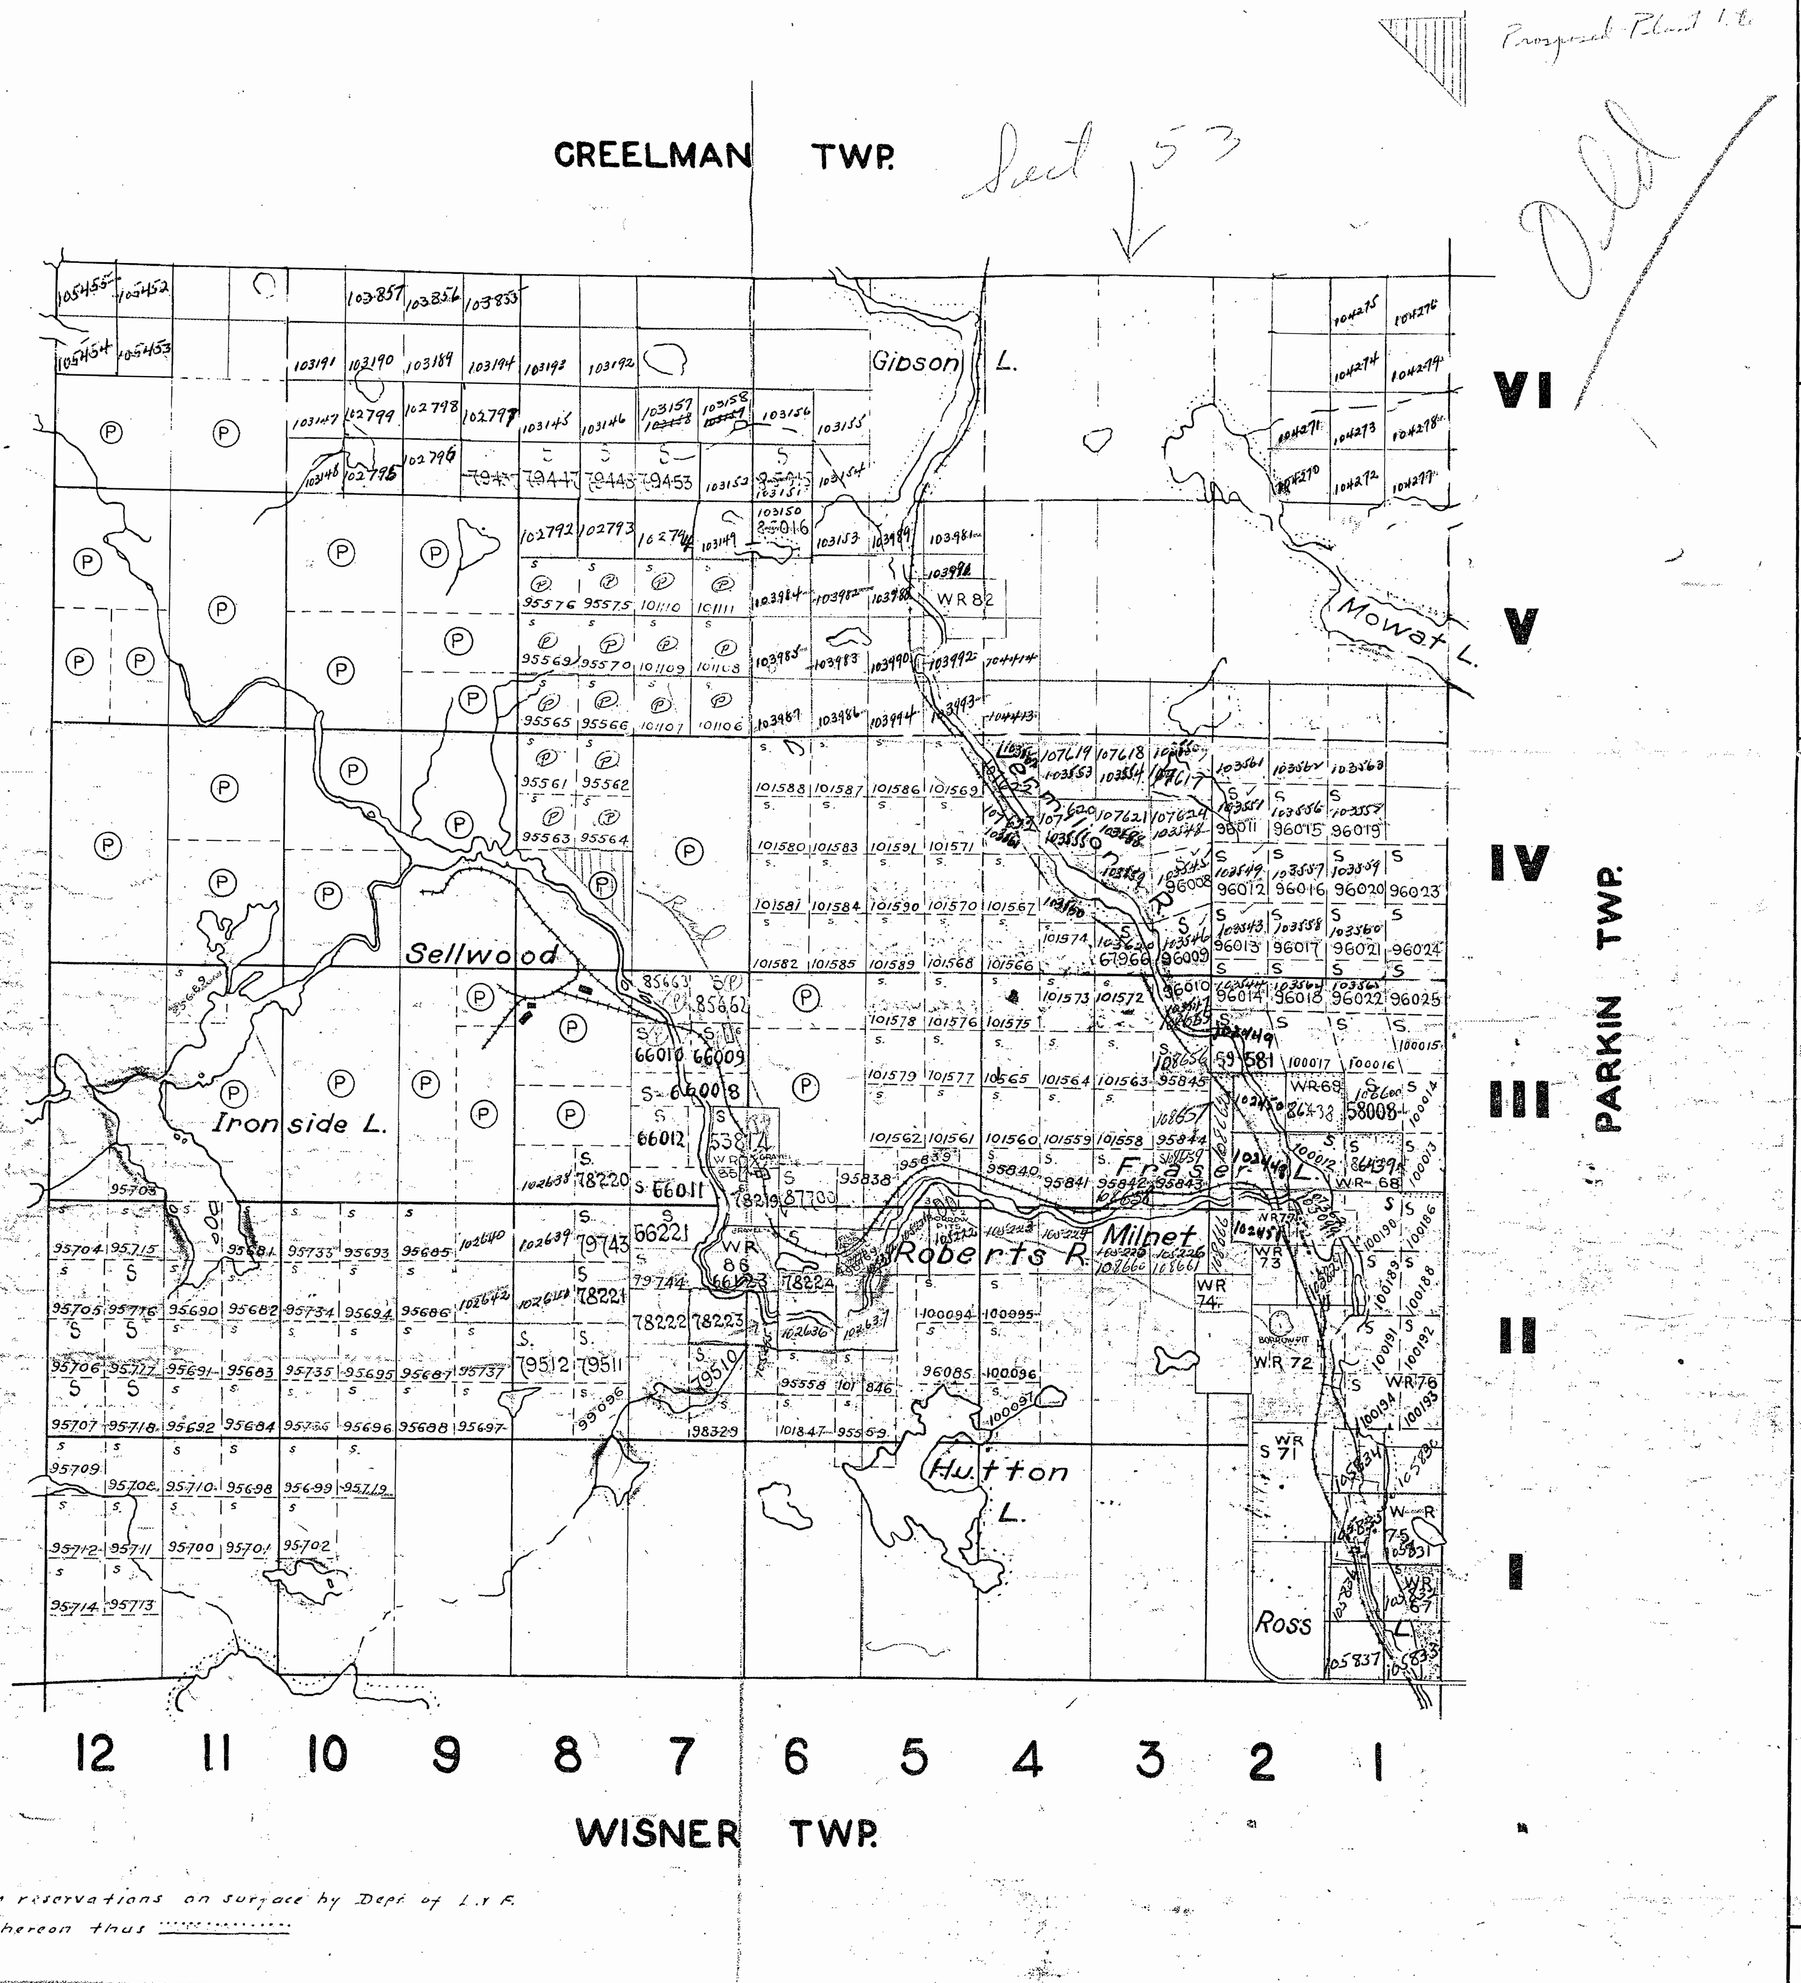

Proposed Plan 1.6

Dec 53

see twp file

LEGEND

PATENTED LANDS	(P)
CROWN LAND SALES	(S)
LOCATED LANDS	Loc.
LICENSE OF OCCUPATION	L.O.
ROADS	
CANADIAN NATIONAL RAILWAY	

NOTES

LOTS 1 TO 5 CONCESSIONS I TO 6 MAY BE STAKED IN THE SAME MANNER AS MINING CLAIMS IN UNSURVEYED TERRITORY.

MG. LEASE # 10887 ONWATIN PLACER GOLD LTD. SHOWN THUS: ———

Notice of Determination on mining lease #10887 Sept 7/52 see twp file

area affected is outlined in red and extends from C.N.R. in Con. 3 entirely to E.B. line

400' wide reservations on surface by Dept of L.N.R. shewn hereon thus .....

M944

DEPARTMENT OF MINES
ONTARIO

CREELMAN TWP.

annulled Portion

THE TOWNSHIP OF HUTTON TWP.

DISTRICT OF SUDBURY

SUDBURY MINING DIVISION

SCALE: 1-INCH=40 CHAINS

VI

V

IV

III

II

I

KITCHENER TWP.

PARKIN TWP.

WISNER TWP.

annulled portion

12 11 10 9 8 7 6 5 4 3 2 1

Vermilion R.

Gibson Lake

Mowat Cr.

Mowat Lake

Canadian National Railway

WR 82

Roberts

River

Morton Cr.

SELLWOOD

Ironside Lake

Roberts

Hutton Lake

Kumska

Hutton Cr.

Fraser Lake

Ross

WR 56

WR 68

WR 69

WR 73

WR 74

WR 72

WR 71

WR 67

WR 75

LEGEND

PATENTED LAND	(P)
CROWN LAND SALE	C.S.
LEASES	(L)
LOCATED LAND	Loc.
LICENSE OF OCCUPATION	L.O.
MINING RIGHTS ONLY	M.R.O.
SURFACE RIGHTS ONLY	S.R.O.
ROADS	
IMPROVED ROADS	
KING'S HIGHWAYS	
RAILWAYS	
POWER LINES	
MARSH OR MUSKEG	
MINES	
CANCELLED	C.

NOTES

400' Reserve around all Lakes and Rivers to Dept. of Lands & Forests.

Lots 1 to 6, concessions 1 to 6 may be staked in the same manner as mining claims in unsurveyed territory. May 16, 1946 — File 83.5 — Mining Act 52 part 2

Land required for railway purposes shown thus:

Files 4326 & 4841.

Dept. of Highways' gravel pit shown thus:

PLAN NO.- M-944

DEPARTMENT OF MINES

— ONTARIO —

CREELMAN TWP. M.737

KITCHENER TWP. M.973

PARKIN TWP. M.1049

WISNER TWP. M.1185

VI

V


IV

III

II

I

12 11 10 9 8 7 6 5 4 3 2 1

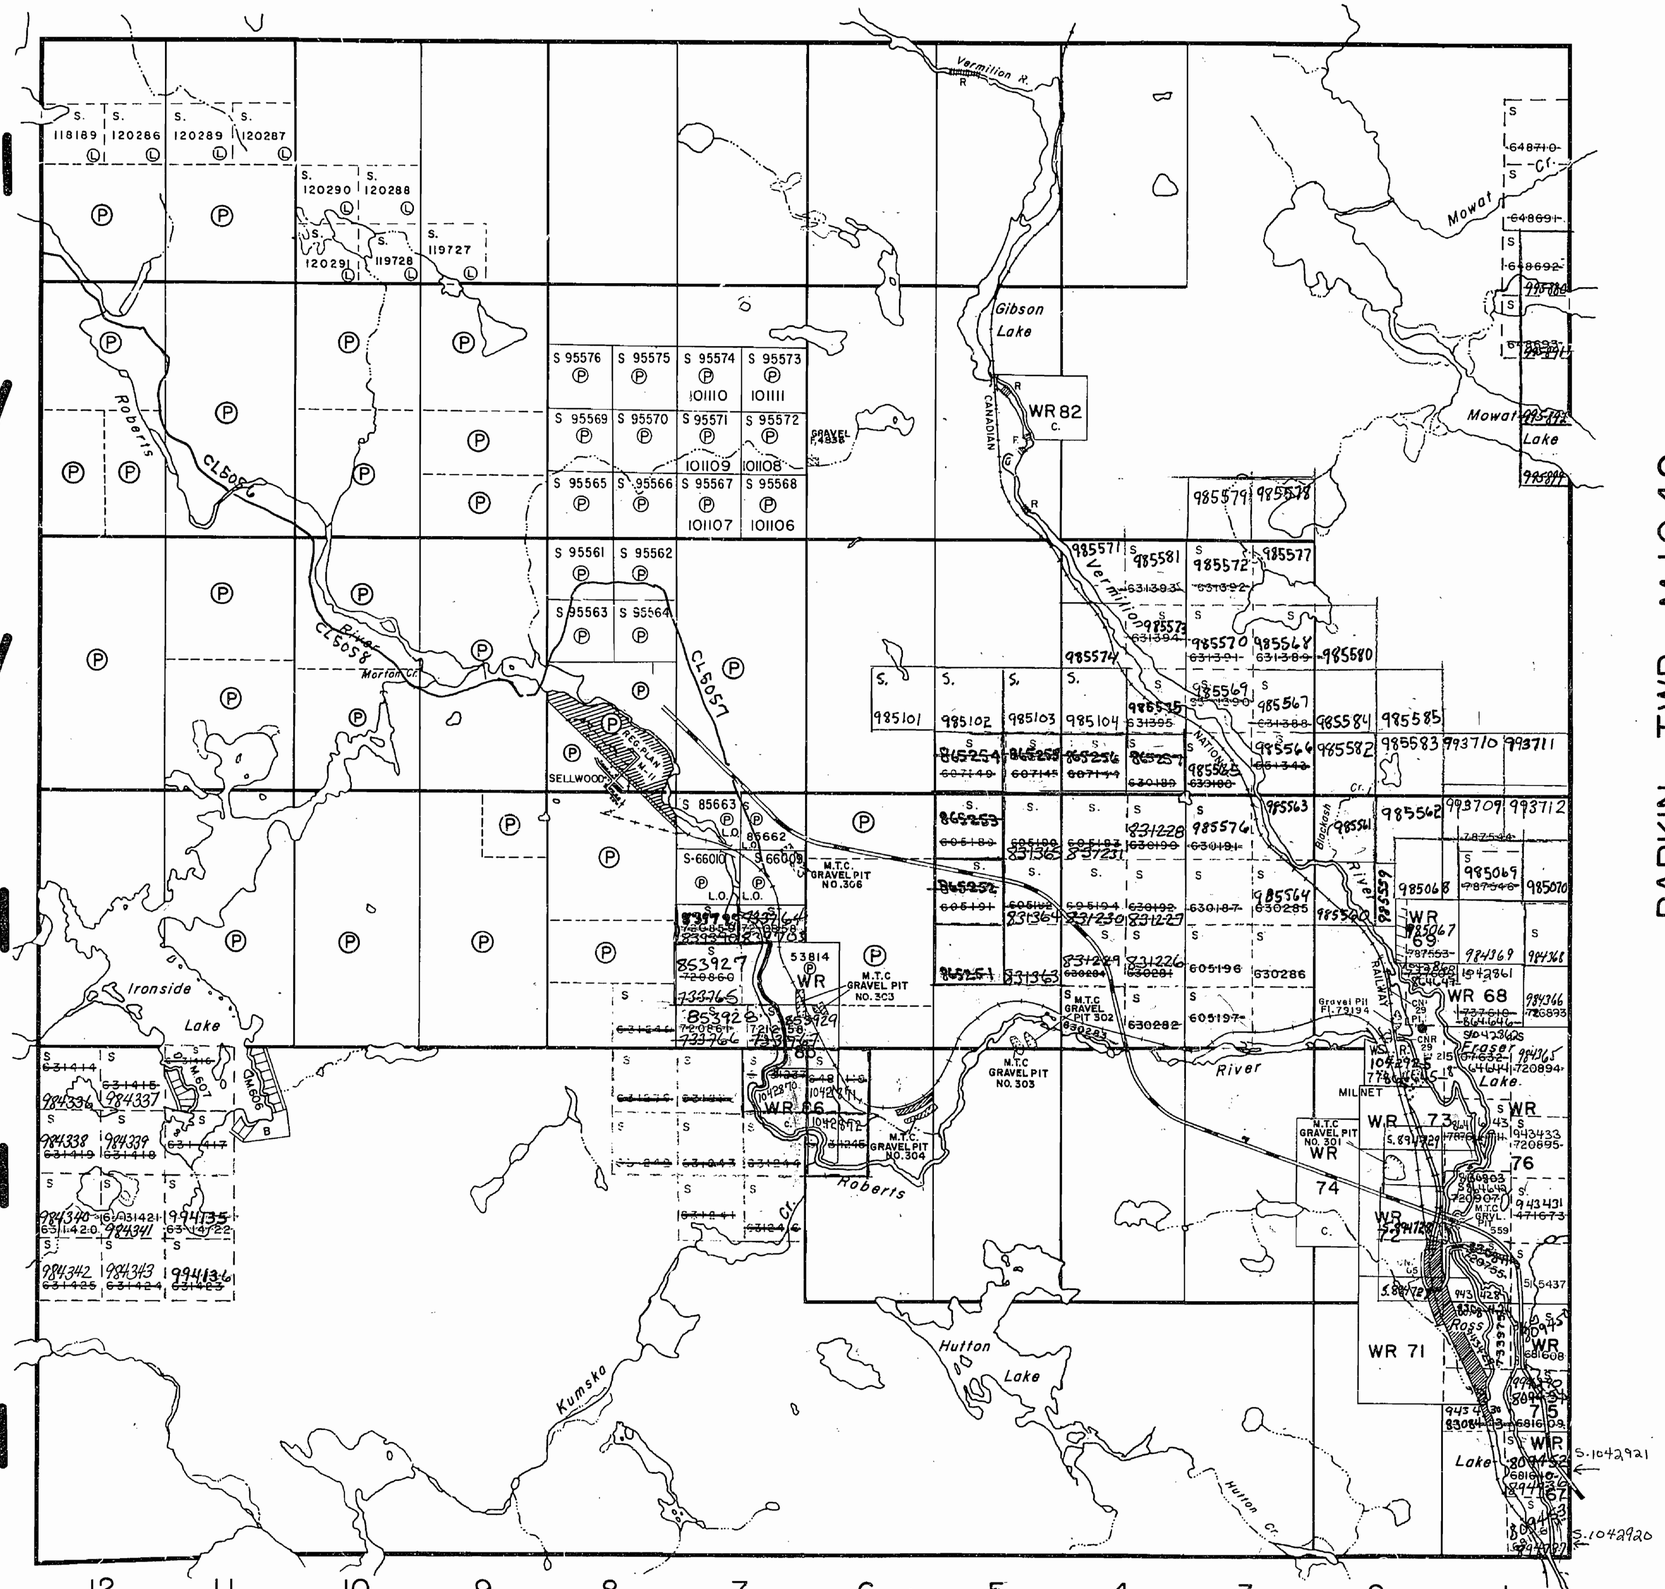

THE TOWNSHIP OF

HUTTON

DISTRICT OF SUDBURY

SUDBURY MINING DIVISION

SCALE: 1-INCH=40 CHAINS

LEGEND

PATENTED LAND	℗ or (P)
CROWN LAND SALE	C.S.
LEASES	(L)
LOCATED LAND	Loc.
LICENSE OF OCCUPATION	L.O.
MINING RIGHTS ONLY	M.R.O.
SURFACE RIGHTS ONLY	S.R.O.
ROADS	
IMPROVED ROADS	
KING'S HIGHWAYS	
RAILWAYS	
POWER LINES	
MARSH OR MUSKEG	
MINES	
CANCELLED	

NOTES

400' Surface Rights Reservation along the shores of all lakes and rivers.

Lots 1 to 6, concessions 1 to 6 may be staked in the same manner as mining claims in unsurveyed territory. May 16, 1946 — File 83.5 — Mining Act Sec. 53 (52 A 1946).

R.S.O. 1980

Land required for railway purposes shown thus:

Files 4826 & 4841.

Parts of Con. 1, 2, 4, 5 & 6: Subdivision Annulled.

SAND AND GRAVEL

(G) QUARRY PERMIT

HUTTON

PLAN NO.- M-944

ONTARIO

MINISTRY OF NATURAL RESOURCES

SURVEYS AND MAPPING BRANCH


944

HUTTON

Scale 40 Chains to an Inch.

See new map

CREELMAN

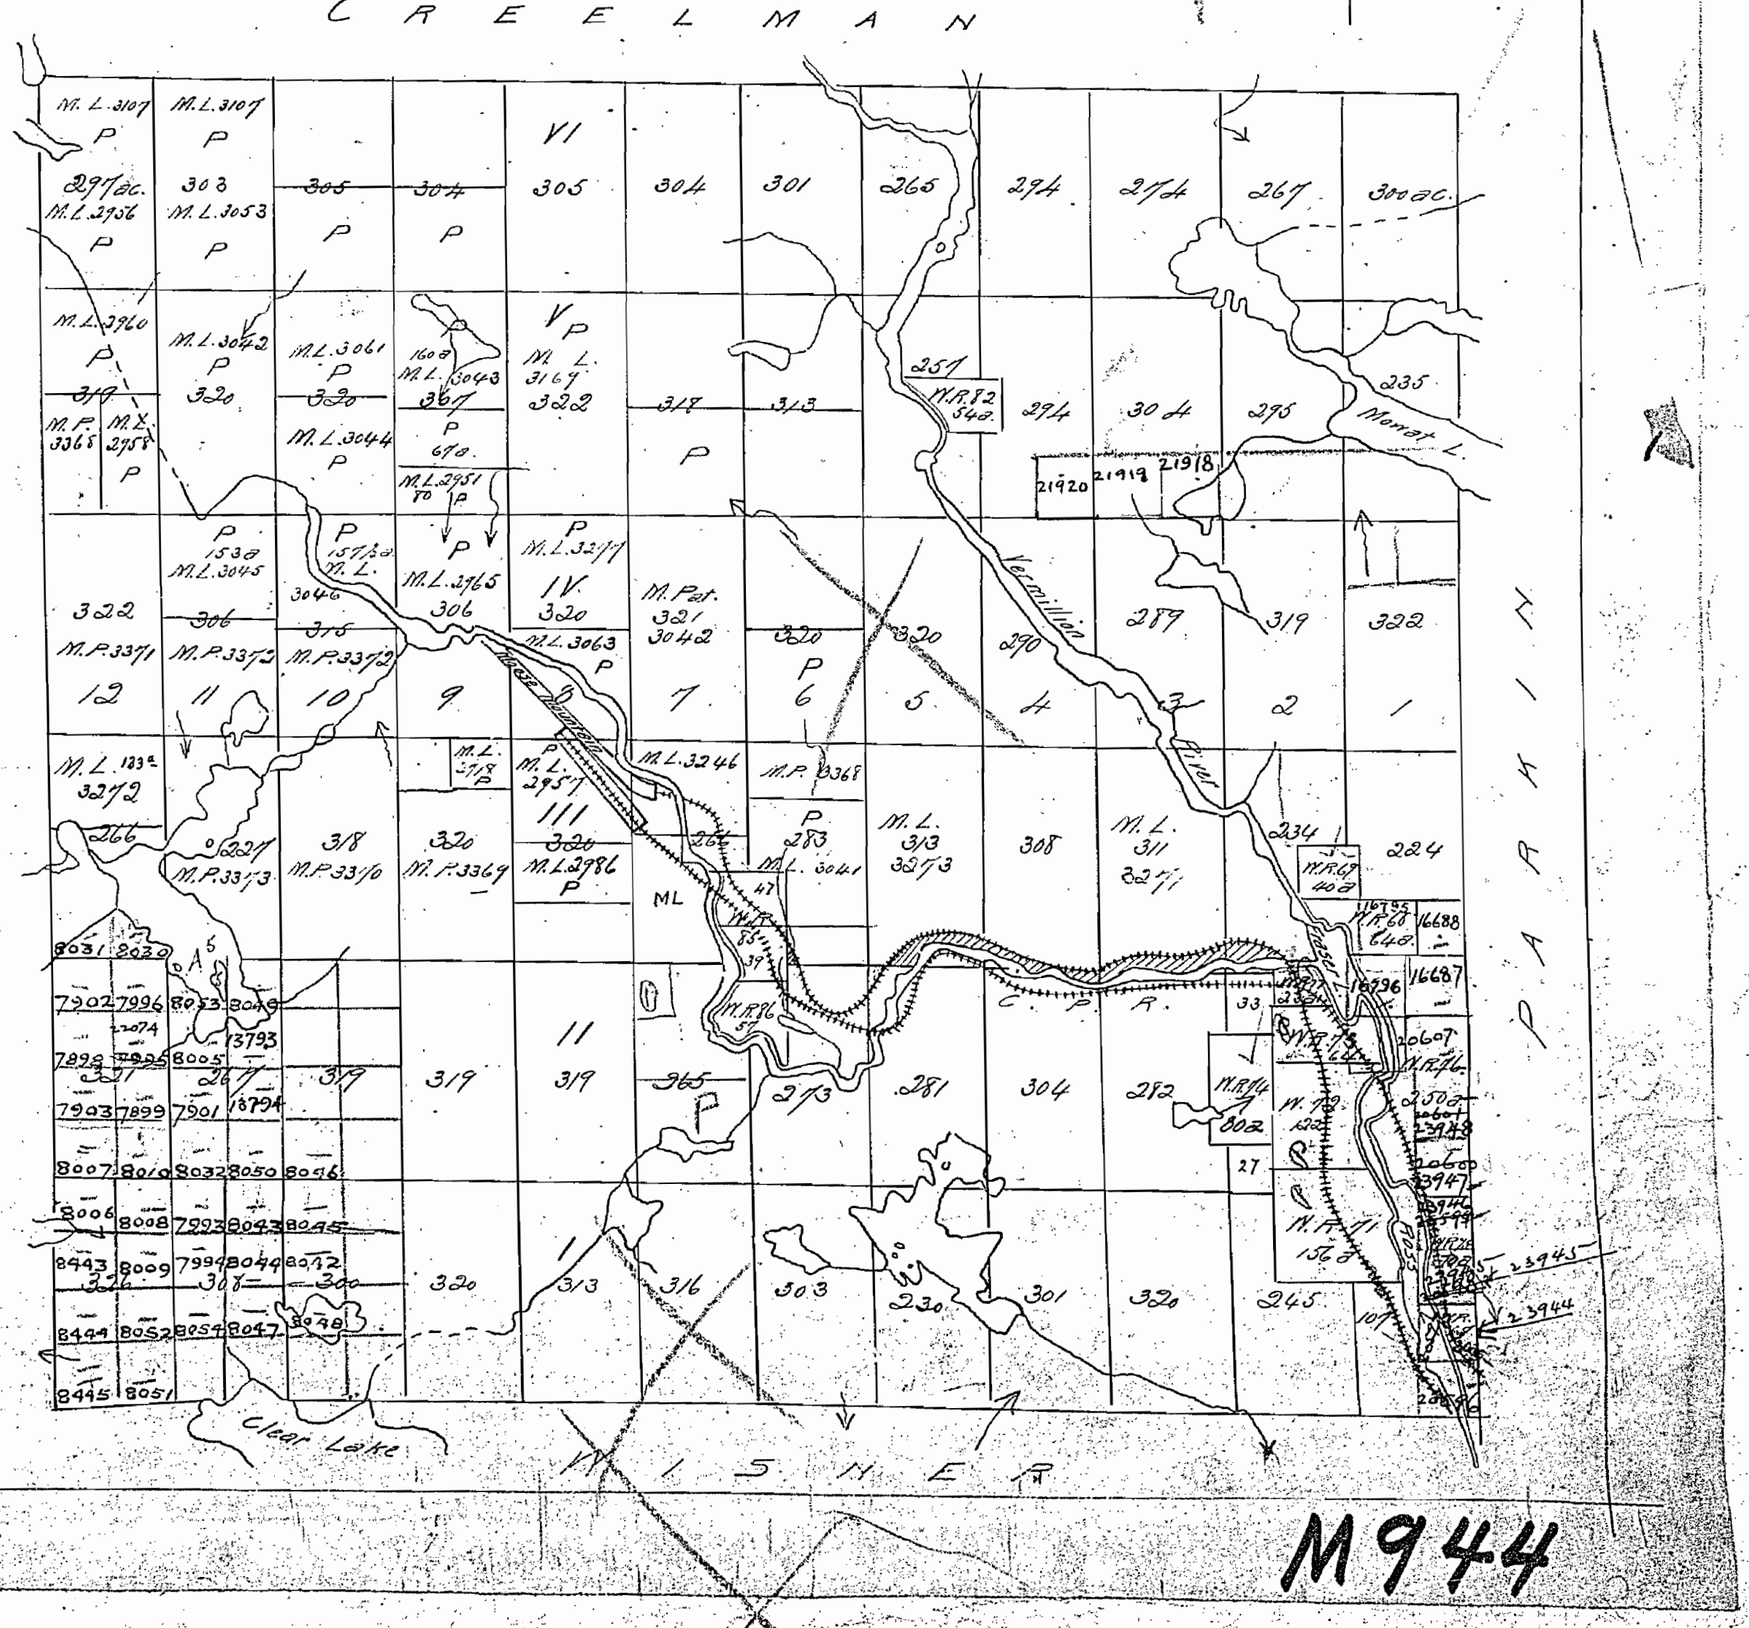

M944

No 2 R

CREELMAN TWP.

N

KITCHENER TWP.

PARKIN TWP.

Gibson L.

WR 82

Mowat L.

Vermilion R.

Sellwood

Ironside L.

Fraser

Milnet

Roberts R.

Hutton L.

Ross

VI

V

IV

III

II

I

12 11 10 9 8 7 6 5 4 3 2 1

WISNER TWP.

12 10 8 6 4 2 | 2 4 6 8 10 12

THE TOWNSHIP OF HUTTON

DISTRICT OF SUDBURY

SUDBURY MINING DIVISION

SCALE 1 INCH TO [illegible] S

M 944

LEGEND

PATENTED LANDS
CROWN LAND SALES
LOCATED LANDS
LICENSE OF OCCUPATION
ROADS
CANADIAN NATIONAL RAILWAY

NOTES

LOTS 1 TO 6, CONCESSIONS I TO 6 MAY BE STAKED IN THE SAME MANNER AS MINING CLAIMS IN UNSURVEYED TERRITORY.

Area covered by Lease 1087 for all ores [illegible] Title to surface rights [illegible] mineral rights [illegible] File 4822 - 1951 Crown Timber

NOTE: N ½ of N ½ of Lot 3 open in May 1948 File 4822 D. Stevens letter June 8/51

Lease 1087

SUDBURY RECEIVED SEP 4 - 1947 MINING DIVISION

M944

DEPARTMENT OF MINES

CREELMAN TWP.

KITCHENER TWP.

PARKIN TWP.

WISNER TWP.

VI

V

IV

12 11 10 9 8 7 6 5 4 3 2 1

Roberts

River

Marion Cr.

SELLWOOD

Ironside Lake

Gibson Lake

Vermilion River

Bigwash River

Fraser Lake

Roberts

Hutton Lake

Kumsko

Ross

Lake

Hutton Cr.

CANADIAN NATIONAL RAILWAY

MILNET

WR 86

WR 85

WR 74

WR 73

WR 72

WR 71

WR 69

WR 68

WR 67

WR 76

WR 75

July 30/68

THE TOWNSHIP OF

HUTTON

DISTRICT OF SUDBURY

SUDBURY MINING DIVISION

SCALE: 1-INCH=40 CHAINS

LEGEND

PATENTED LAND	(P)
CROWN LAND SALE	C.S.
LEASES	(L)
LOCATED LAND	Loc.
LICENSE OF OCCUPATION	L.O.
MINING RIGHTS ONLY	M.R.O.
SURFACE RIGHTS ONLY	S.R.O.
ROADS	
IMPROVED ROADS	
KING'S HIGHWAYS	
RAILWAYS	
POWER LINES	
MARSH OR MUSKEG	
MINES	
CANCELLED	C.

NOTES

400' Surface Rights Reservation around all lakes and rivers.

~~Lots 1 to 6, concessions I to 6 may be staked in the same manner as mining claims in unsurveyed territory. May 16, 1946 — File 83.5 — Mining Act Sec. 53 (52 A 1946).~~

Land required for railway purposes shown thus:

Files 4826 & 4841.

Dept of Highways' gravel pits shown thus:

Parts of the subdivision shown thus: are annulled under the authority of the Minister of Lands & Forests.

PLAN NO.- M-944

DEPARTMENT OF MINES

— ONTARIO —

CREELMAN TWP.

KITCHENER TWP.

PARKIN TWP.

WISNER TWP.

VI

V

IV

III

II

I

12 11 10 9 8 7 6 5 4 3 2 1

Vermilion R.

Gibson Lake

Roberts

Ironside Lake

Morton Cr.

Sellwood

Canadian

Vermilion River

Blagdon River

Mowat

Fraser Lake

Hutton Lake

Kumsko

Ross

Hutton Cr.

Milnet

Railway

WR 68

WR 69

WR 71

WR 72

WR 73

WR 74

WR 75

WR 76

WR 85

WR 86

THE TOWNSHIP OF

HUTTON

DISTRICT OF SUDBURY

SUDBURY MINING DIVISION

SCALE: 1-INCH=40 CHAINS

LEGEND

PATENTED LAND	P
CROWN LAND SALE	C.S.
LEASES	L
LOCATED LAND	Loc.
LICENSE OF OCCUPATION	L.O.
MINING RIGHTS ONLY	M.R.O.
SURFACE RIGHTS ONLY	S.R.O.
ROADS	
IMPROVED ROADS	
KING'S HIGHWAYS	
RAILWAYS	
POWER LINES	
MARSH OR MUSKEG	
MINES	
CANCELLED	C.

NOTES

400' Surface Rights Reservation around all lakes and rivers.

Lots 1 to 6, concessions I to 6 may be staked in the same manner as mining claims in unsurveyed territory. May 16, 1946 — File 83.5 — Mining Act Sec. 53 (52 A 1946).

Land required for railway purposes shown thus:

Files 4826 & 4841.

Dept of Highways' gravel pits shown thus:

Parts of the subdivision shown thus: are annulled under the authority of the Minister of Lands & Forests.

SUDBURY MINING DIV. RECEIVED MAR 19 1969 AM PM

PLAN NO.- M-944

DEPARTMENT OF MINES

— ONTARIO —

CREELMAN TWP. M.737

KITCHENER TWP. M.973

PARKIN TWP. M.1049

WISNER TWP. M.1185

VI

V

IV

III

II

I

12 11 10 9 8 7 6 5 4 3 2 1

Roberts

Marion Cr.

River

Ironside Lake

Mowat Cr.

Mowat Lake

Vermilion R.

Gibson Lake

Vermilion River

Roberts Cr.

Hutton Lake

Kumska

Hutton Cr.

Fraser Lake

Ross Lake

Blackish River

SELLWOOD

CANADIAN NATIONAL RAILWAY

MILNET

WR 69

WR 68

WR 74

WR 73

WR 72

WR 71

WR 76

WR 75

WR 67

WR 86

WR 85

WR 01015

THE TOWNSHIP OF

HUTTON

DISTRICT OF SUDBURY

SUDBURY MINING DIVISION

SCALE: 1-INCH=40 CHAINS

LEGEND

PATENTED LAND	P
CROWN LAND SALE	C.S.
LEASES	L
LOCATED LAND	Loc.
LICENSE OF OCCUPATION	L.O.
MINING RIGHTS ONLY	M.R.O.
SURFACE RIGHTS ONLY	S.R.O.
ROADS	
IMPROVED ROADS	
KING'S HIGHWAYS	
RAILWAYS	
POWER LINES	
MARSH OR MUSKEG	
MINES	
CANCELLED	C.

NOTES

400' Surface Rights Reservation along the shores of all lakes and rivers.

Lots 1 to 6, concessions 1 to 6 may be staked in the same manner as mining claims in unsurveyed territory. May 16, 1946 — File 83.5 — Mining Act Sec. 53 (52 A 1946).

Land required for railway purposes shown thus:

Files 4826 & 4841.

Parts of Con. 1, 2, 4, 5 & 6: Subdivision Annulled.

M.T.C. Gravel pits shown thus: IN GOOD STANDING

DATE OF ISSUE OCT 31 1974


HUTTON

PLAN NO.- M-944

ONTARIO

MINISTRY OF NATURAL RESOURCES

SURVEYS AND MAPPING BRANCH

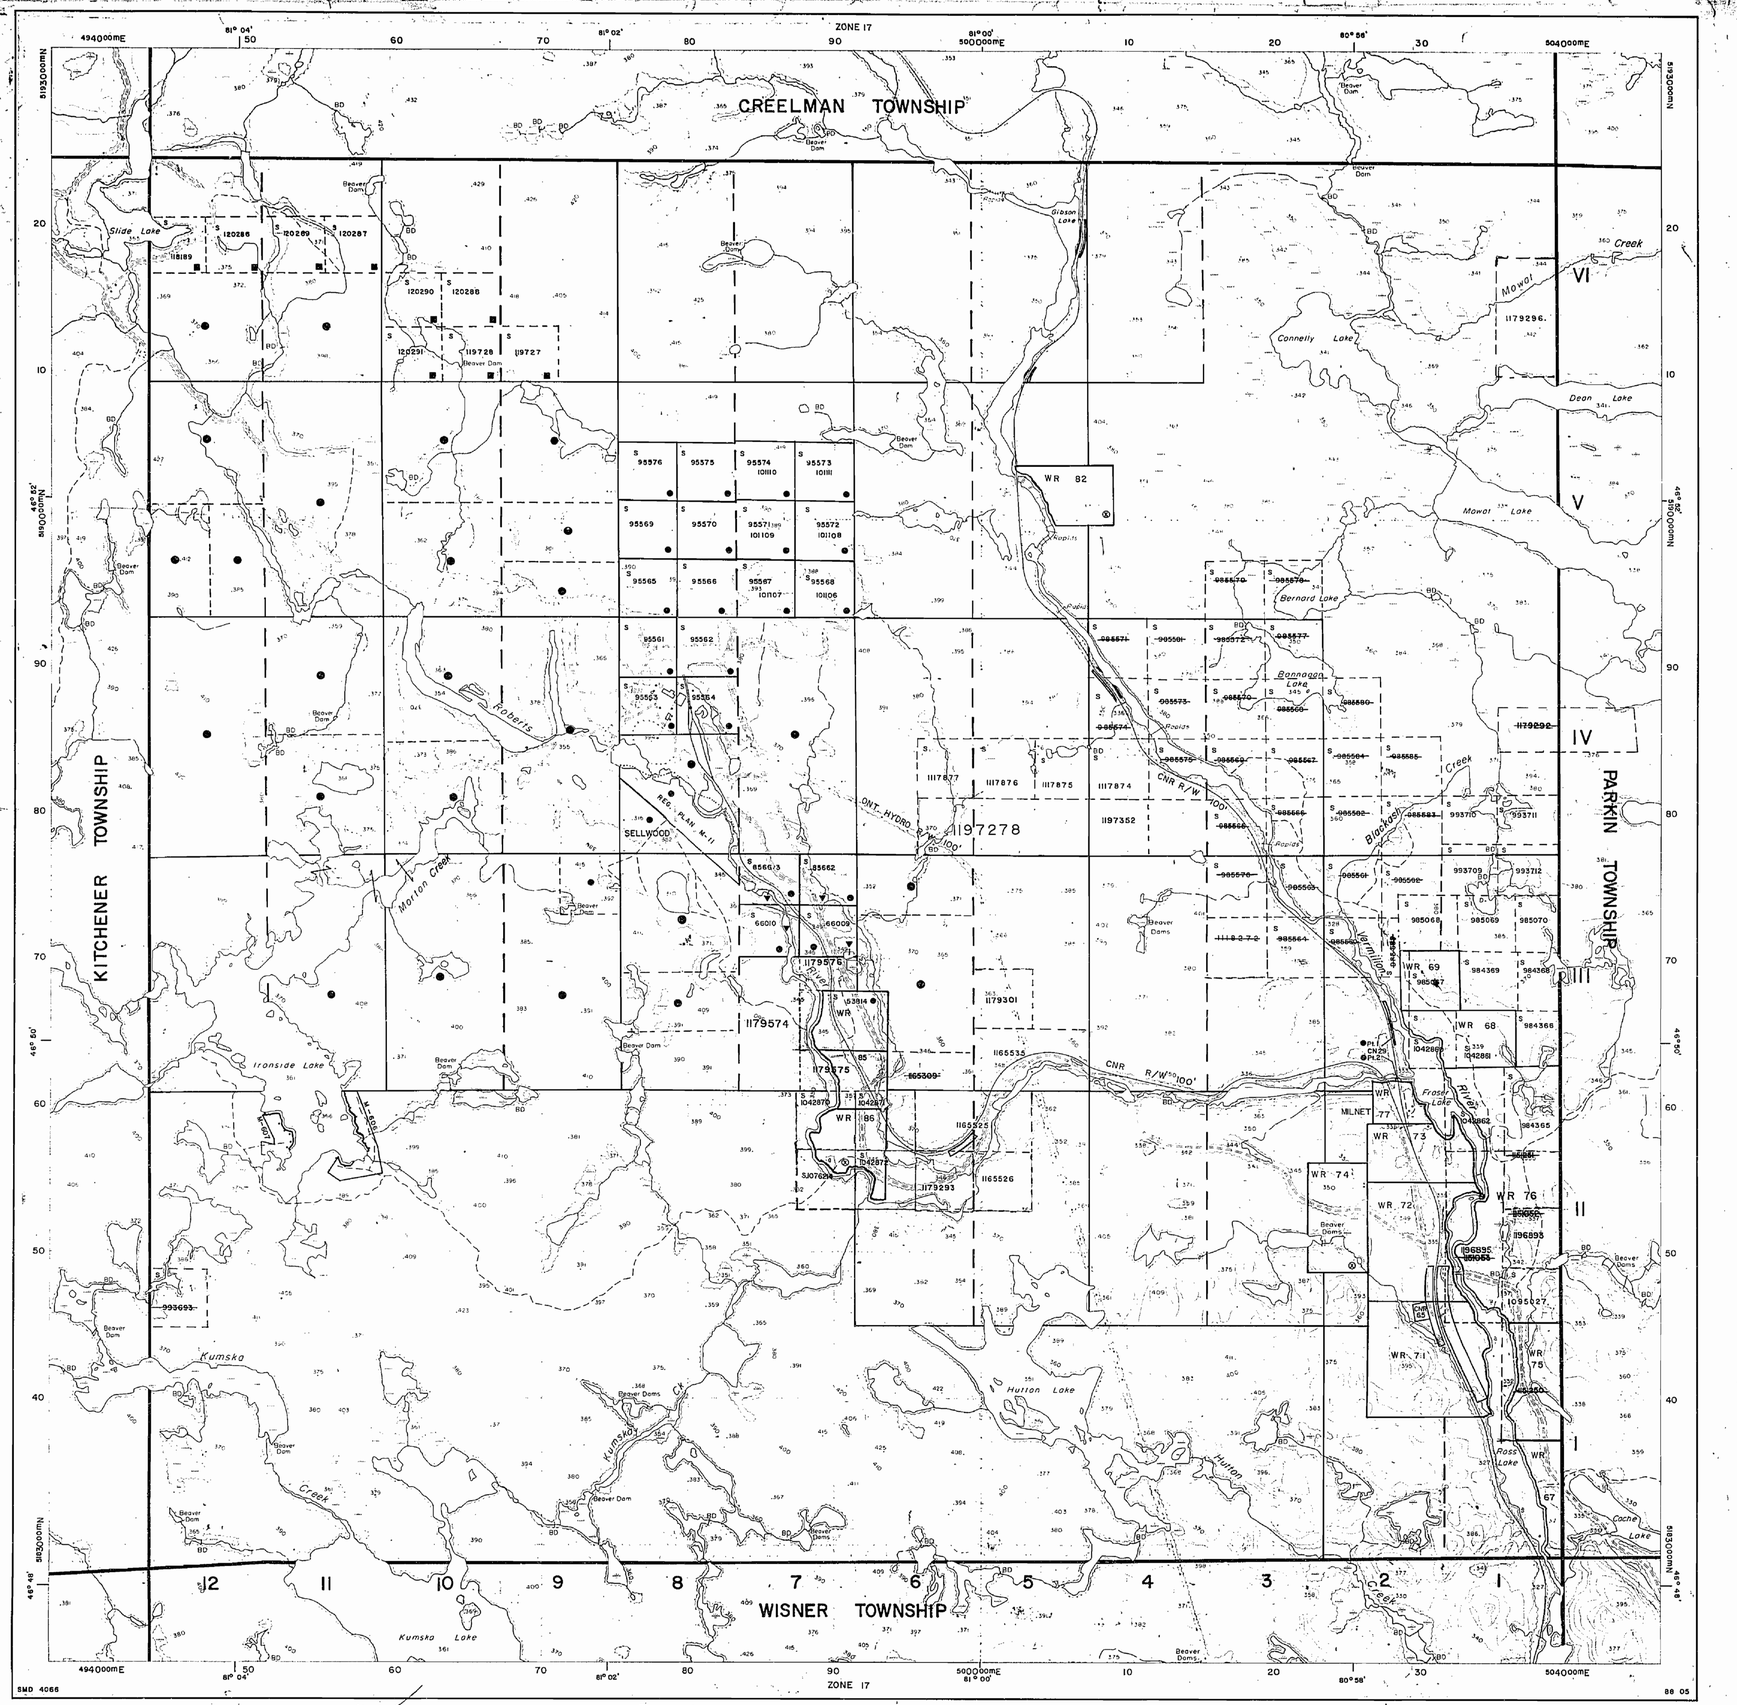
CREELMAN TOWNSHIP
KITCHENER TOWNSHIP
PARKIN TOWNSHIP
WISNER TOWNSHIP
ZONE 17
494000mE
500000mE
504000mE
5193000mN
5189000mN
5185000mN
5181000mN
81° 04'
81° 02'
81° 00'
80° 58'
46° 52'
46° 50'
46° 48'
Slide Lake
Gibson Lake
Connelly Lake
Mowat Lake
Dean Lake
Bernard Lake
Bonnaga Lake
Frost River
Hutton Lake
Ross Lake
Cache Lake
Ironside Lake
Kumska Lake
Roberts Creek
Morton Creek
Kumska Creek
Blackstone Rapids
Hutton Creek
Mowat Creek
SELLWOOD
REG. PLAN M-11
ONT. HYDRO 100'
CNR R/W 100'
WR 82
WR 69
WR 68
WR 77
WR 73
WR 74
WR 72
WR 76
WR 71
WR 75
WR 67
MILNET
I179278
I179352
I179576
I179574
I178575
I179301
I165535
I165525
I165526
I179293
I179296.
I179292
I117877
I117876
I117875
I117874
I120286
I120289
I120287
I120290
I120288
I120291
I119728
I119727
95576
95575
95574
101110
95573
101111
95569
95570
95571
101109
95572
101108
95565
95566
95567
101107
95568
101106
95561
95562
95563
95564
Ministry of Natural Resources — Ministry of Northern Development and Mines

Ontario

IN SERVICE FEBRUARY 10, 1989

INDEX TO LAND DISPOSITION

PLAN

G-4066

TOWNSHIP

HUTTON

M.N.R. ADMINISTRATIVE DISTRICT

SUDBURY

MINING DIVISION

SUDBURY

LAND TITLES/REGISTRY DIVISION

SUDBURY

Scale 1:20 000

1000 Metres 0 1000 2000 Metres

1000 Feet 0 1000 2000 3000 4000 5000 6000 7000 8000 9000 10000 Feet

Contour Interval 10 Metres

DATE OF ISSUE
MAR 10 1989
SUDBURY
MINING RECORDER'S OFFICE

AREAS WITHDRAWN FROM DISPOSITION

MRO - Mining Rights Only
SRO - Surface Rights Only
M + S - Mining and Surface Rights

Description | Order No. | Date | Disposition | File

SYMBOLS

- Boundary
  - Township, Meridian, Baseline
  - Road allowance; surveyed
    - shoreline
  - Lot/Concession; surveyed
    - unsurveyed
  - Parcel; surveyed
    - unsurveyed
  - Right-of-way; road
    - railway
    - utility
  - Reservation
  - Cliff, Pit, Pile
  - Contour (20)
    - Interpolated
    - Approximate
    - Depression
  - Control point (horizontal)
  - Flooded land
  - Mine head frame
  - Pipeline (above ground)
  - Railway; single track
    - double track
    - abandoned
  - Road; highway, county, township
    - access
    - trail, bush
  - Shoreline (original)
  - Transmission line
  - Wooded area

(BLOCK OF 2)

DISPOSITION OF CROWN LANDS

- Patent
  - Surface & Mining Rights
  - Surface Rights Only
  - Mining Rights Only
- Lease
  - Surface & Mining Rights
  - Surface Rights Only
  - Mining Rights Only
- Licence of Occupation
- Order-in-Council — OC
- Cancelled
- Reservation — R
- Sand & Gravel — S
- LAND USE PERMIT
- Placer Claim — PC

NOTE

LOTS 1 TO 6, CONCESSIONS I TO 6 MAY BE STAKED IN THE SAME MANNER AS MINING CLAIMS IN UNSURVEYED TERRITORY. MAY 16,1946—FILE 83.5—MINING ACT SEC.45 R.S.O 1980 (52 A 1946)

LAND REQUIRED FOR RAILWAY PURPOSES SHOWN THUS

FILES 4826 & 4841 T

PARTS OF CON. 1, 2, 4, 5 & 6 SUBDIVISION ANNULLED.

THE INFORMATION THAT APPEARS ON THIS MAP HAS BEEN COMPILED FROM VARIOUS SOURCES, AND ACCURACY IS NOT GUARANTEED. THOSE WISHING TO STAKE MINING CLAIMS SHOULD CONSULT WITH THE MINING RECORDER, MINISTRY OF NORTHERN DEVELOPMENT AND MINES, FOR ADDITIONAL INFORMATION ON THE STATUS OF THE LANDS SHOWN HEREON.

Map base and land disposition drafting by Surveys and Mapping Branch, Ministry of Natural Resources.

The disposition of land, location of lot fabric and parcel boundaries on this index was compiled for administrative purposes only.

SMD 4066

88 05

HUTTON TWP. G-4066

Ministry of Natural Resources
Ontario

Ministry of Northern Development and Mines

IN SERVICE FEBRUARY 10, 1989

INDEX TO LAND DISPOSITION

PLAN
G-4066

TOWNSHIP
HUTTON

M.N.R. ADMINISTRATIVE DISTRICT
SUDBURY

MINING DIVISION
SUDBURY

LAND TITLES/REGISTRY DIVISION
SUDBURY

Scale 1:20 000

1000 Metres 0 1000 2000 Metres

1000 0 1000 2000 3000 4000 5000 6000 7000 8000 9000 10000 Feet

Contour Interval 10 Metres

AREAS WITHDRAWN FROM DISPOSITION

MRO - Mining Rights Only
SRO - Surface Rights Only
M + S - Mining and Surface Rights

Description	Order No.	Date	Disposition	File

SYMBOLS

Boundary
- Township, Meridian, Baseline
- Road allowance; surveyed
- shoreline
- Lot/Concession; surveyed
- unsurveyed
- Parcel; surveyed
- unsurveyed
- Right-of-way; road
- railway
- utility
- Reservation
- Cliff, Pit, Pile
- Contour
- Interpolated
- Approximate
- Depression
- Control point (horizontal) △
- Flooded land
- Mine head frame
- Pipeline (above ground)
- Railway; single track
- double track
- abandoned
- Road; highway, county, township
- access
- trail, bush
- Shoreline (original)
- Transmission line
- Wooded area

(BLOCK OF 2)

DISPOSITION OF CROWN LANDS

Patent
- Surface & Mining Rights ●
- Surface Rights Only ◓
- Mining Rights Only ◒

Lease
- Surface & Mining Rights ■
- Surface Rights Only ◨
- Mining Rights Only ◪
- Licence of Occupation ▼
- Order-in-Council OC
- Cancelled ⊖
- Reservation Ⓡ
- Sand & Gravel Ⓒ
- LAND USE PERMIT ☼
- Placer Claim PC

DATE OF ISSUE
JUL 10 1996
SUDBURY
MINING RECORDER'S OFFICE

NOTE

LOTS 1 TO 6, CONCESSIONS I TO 6 MAY BE STAKED IN THE SAME MANNER AS MINING CLAIMS IN UNSURVEYED TERRITORY. MAY 16,1946—FILE 85.5—MINING ACT SEC.45 R.S.O 1980 (52 A 1946)

LAND REQUIRED FOR RAILWAY PURPOSES SHOWN THUS:

FILES 4826 & 4841

PARTS OF CON. 1, 2, 4, 5 & 6 SUBDIVISION ANNULLED.

THE INFORMATION THAT APPEARS ON THIS MAP HAS BEEN COMPILED FROM VARIOUS SOURCES, AND ACCURACY IS NOT GUARANTEED. THOSE WISHING TO STAKE MINING CLAIMS SHOULD CONSULT WITH THE MINING RECORDER, MINISTRY OF NORTHERN DEVELOPMENT AND MINES, FOR ADDITIONAL INFORMATION ON THE STATUS OF THE LANDS SHOWN HEREON.

Map base and land disposition drafting by Surveys and Mapping Branch, Ministry of Natural Resources.

The disposition of land, location of lot fabric and parcel boundaries on this index was compiled for administrative purposes only.

SMD 4066

88 05

G-4066 HUTTON TWP. G-4066

Ministry of Natural Resources
Ontario

Ministry of Northern Development and Mines

INDEX TO LAND DISPOSITION

PLAN
G-4066

TOWNSHIP
HUTTON

M.N.R. ADMINISTRATIVE DISTRICT
SUDBURY

MINING DIVISION
SUDBURY

LAND TITLES/REGISTRY DIVISION
SUDBURY

Scale 1:20 000

Contour Interval 10 Metres

AREAS WITHDRAWN FROM DISPOSITION

M.R.O. - MINING RIGHTS ONLY
S.R.O. - SURFACE RIGHTS ONLY
M.+S. - MINING AND SURFACE RIGHTS

Description	Order No.	Date	Disposition	Plan

SYMBOLS

Boundary
- Township, Meridian, Baseline
- Road allowance; surveyed
- shoreline
- Lot/Concession, surveyed
- unsurveyed
- Parcel surveyed
- unsurveyed
- Right-of-way, road
- railway
- utility
- Reservation
- Clirt, Pit, Pile
- Contour
  - interpolated
  - Approximate
  - Depression
- Control point (horizontal)
- Flooded land
- Mine head frame
- Pipeline (above ground)
- Railway; single track
  - double track
  - abandoned
- Road, highway, county, township
  - access
  - trail; bush
- Shoreline (original)
- Transmission line
- Wooded area

DISPOSITION OF CROWN LANDS

Patent
- Surface & Mining Rights
- Surface Rights Only
- Mining Rights Only

Lease
- Surface & Mining Rights
- Surface Rights Only
- Mining Rights Only

- Licence of Occupation
- Order-In-Council
- Cancelled
- Reservation
- Sand & Gravel
- LAND USE PERMIT

NOTE

LOTS 1 TO 6, CONCESSIONS I TO V MAY BE STAKED IN THE SAME MANNER AS MINING CLAIMS IN UNSURVEYED TERRITORY MAY 16,1940—PLE 0S S—MINING ACT SEC 46 O.S.O 1960 (82 A 9461

LAND REQUIRED FOR RAILWAY PURPOSES SHOWN THUS-

PLES 4886 S 4841

METES OF CON. 1, 2, 4, 5 & 6 SUBDIVISION ANNULLED

THE INFORMATION THAT APPEARS ON THIS MAP HAS BEEN COMPILED FROM VARIOUS SOURCES. AND ACCURACY IS NOT GUARANTEED. THOSE WISHING TO STAKE MINING CLAIMS SHOULD CONSULT WITH THE MINING RECORDER MINISTRY OF NORTHERN DEVELOPMENT AND MINES. FOR ADDITIONAL INFORMATION ON THE STATUS OF THE LANDS SHOWN HEREON.

Map base and land disposition drafting by Surveys and Mapping Branch, Ministry of Natural Resources.

This disposition of land, location of lot fabric and parcel boundaries on this index was compiled for administrative purposes only.

944

CREELMAN TWP.

KITCHENER TWP.

PARKIN TWP.

WISNER TWP.

VI

V

IV

12 11 10 9 8 7 6 5 4 3 2 1

THE TOWNSHIP OF

HUTTON TWP.

DISTRICT OF SUDBURY

SUDBURY MINING DIVISION

SCALE: 1-INCH=40 CHAINS

LEGEND

PATENTED LAND	(P)
CROWN LAND SALE	C.S.
LEASES	(L)
LOCATED LAND	Loc.
LICENSE OF OCCUPATION	L.O.
MINING RIGHTS ONLY	M.R.O.
SURFACE RIGHTS ONLY	S.R.O.
ROADS	
IMPROVED ROADS	
KING'S HIGHWAYS	
RAILWAYS	
POWER LINES	
MARSH OR MUSKEG	
MINES	
CANCELLED	C.

NOTES

400' Reserve around all Lakes and Rivers to Dept. of Lands & Forests.

Lots 1 to 6 concessions 1 to 6 may be staked in the same manner as mining claims in unsurveyed territory - May 16, 1946 - File 83.5 - Mining Act Sect. 53 (52 A. 1946)

Land required for railway purposes shown thus:

Files 4826 & 4841

Dept. of Highways gravel pit shown thus:

Staking may be carried out for any other mineral other than alluvial mineral under sec. 36(1) of the Mining Act shown thus: Now Covered By Mc Lease 13544 Placer Only

Parts of the Subdivision shown outlined thus: are annulled under the authority of the Minister of Lands & Forests.


PLAN NO. M-944

DEPARTMENT OF MINES

— ONTARIO —

M 944

CREELMAN TWP.

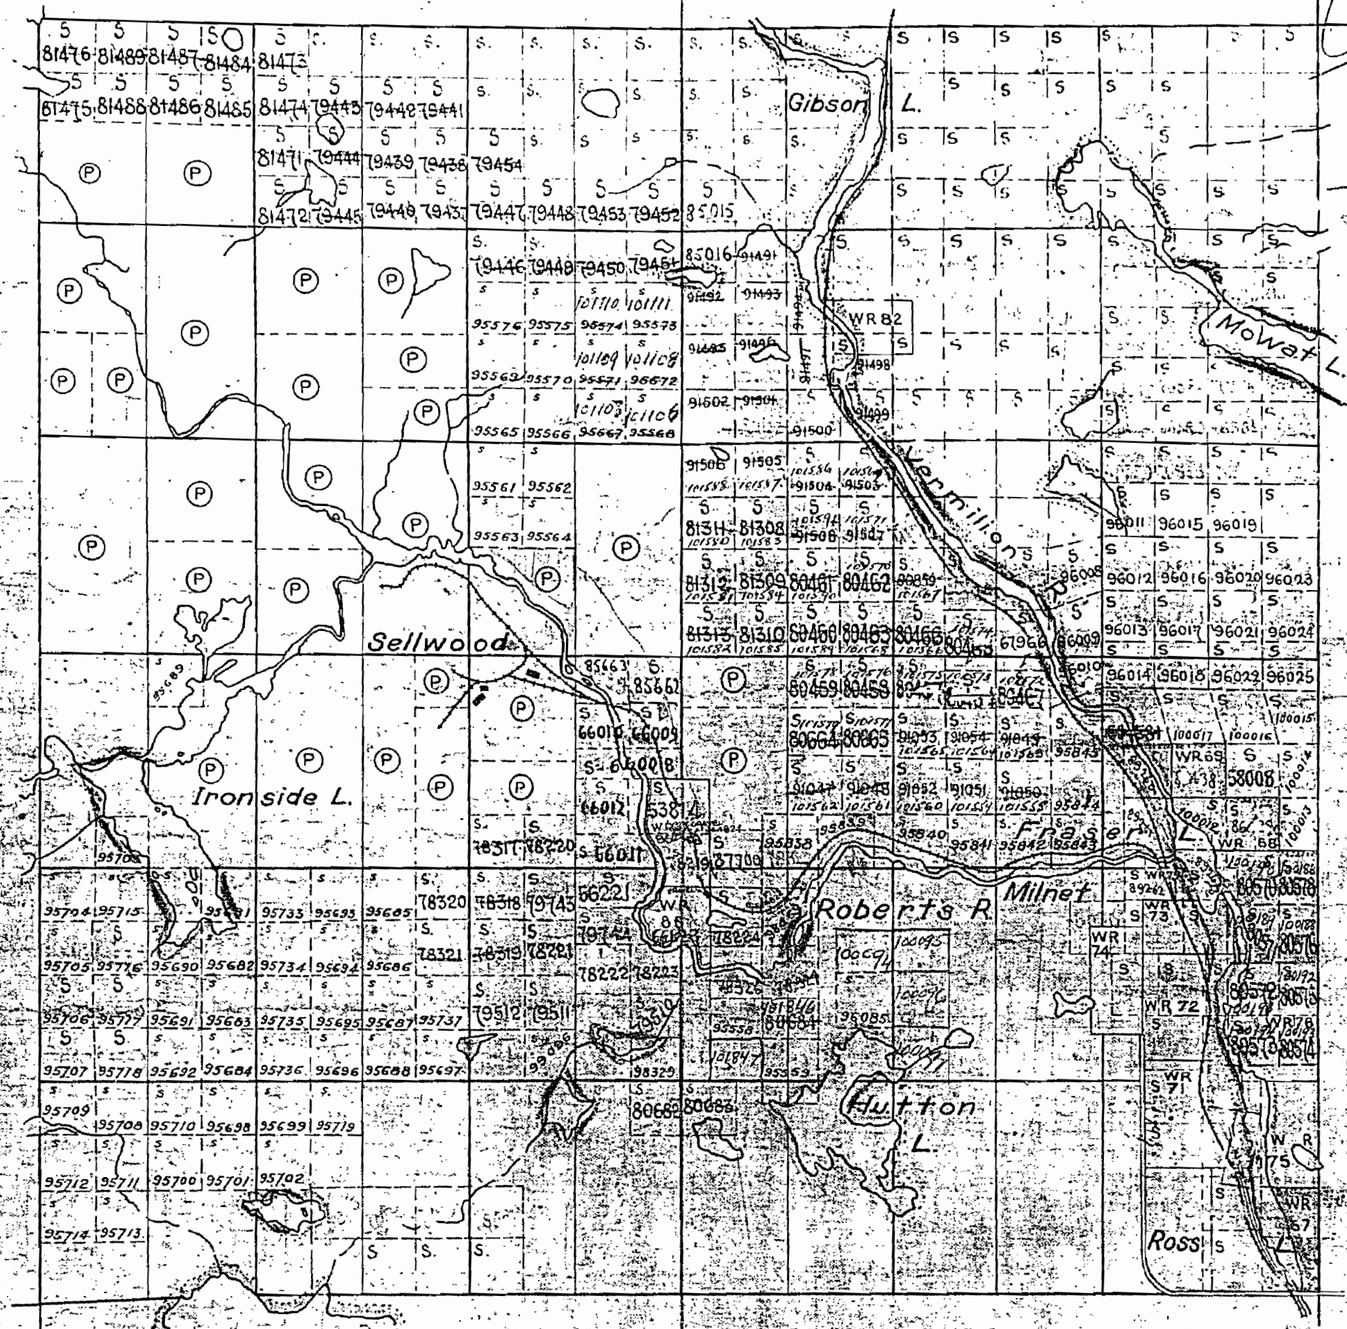

Coal and mineral reservations on surface by Dept of Lands & Forests shown hereon thus

THE TOWNSHIP OF

HUTTON

DISTRICT OF SUDBURY

SUDBURY MINING DIVISION

SCALE 1 INCH TO 40 CHAINS

LEGEND

PATENTED LANDS	(P)
CROWN LAND SALES	(S)
LOCATED LANDS	Loc.
LICENSE OF OCCUPATION	L.O.
ROADS	
CANADIAN NATIONAL RAILWAY	

NOTES

LOTS 1 TO 6 CONCESSIONS I TO 6 MAY BE STAKED IN THE SAME MANNER AS MINING CLAIMS IN UNSURVEYED TERRITORY.

MG. LEASE # 10887 ONWATIN PLACER GOLD LTD. SHOWN THUS

M 944

DEPARTMENT OF MINES
ONTARIO

M-944

CREELMAN TWP.


VI

V

IV

KITCHENER TWP.

PARKIN TWP.

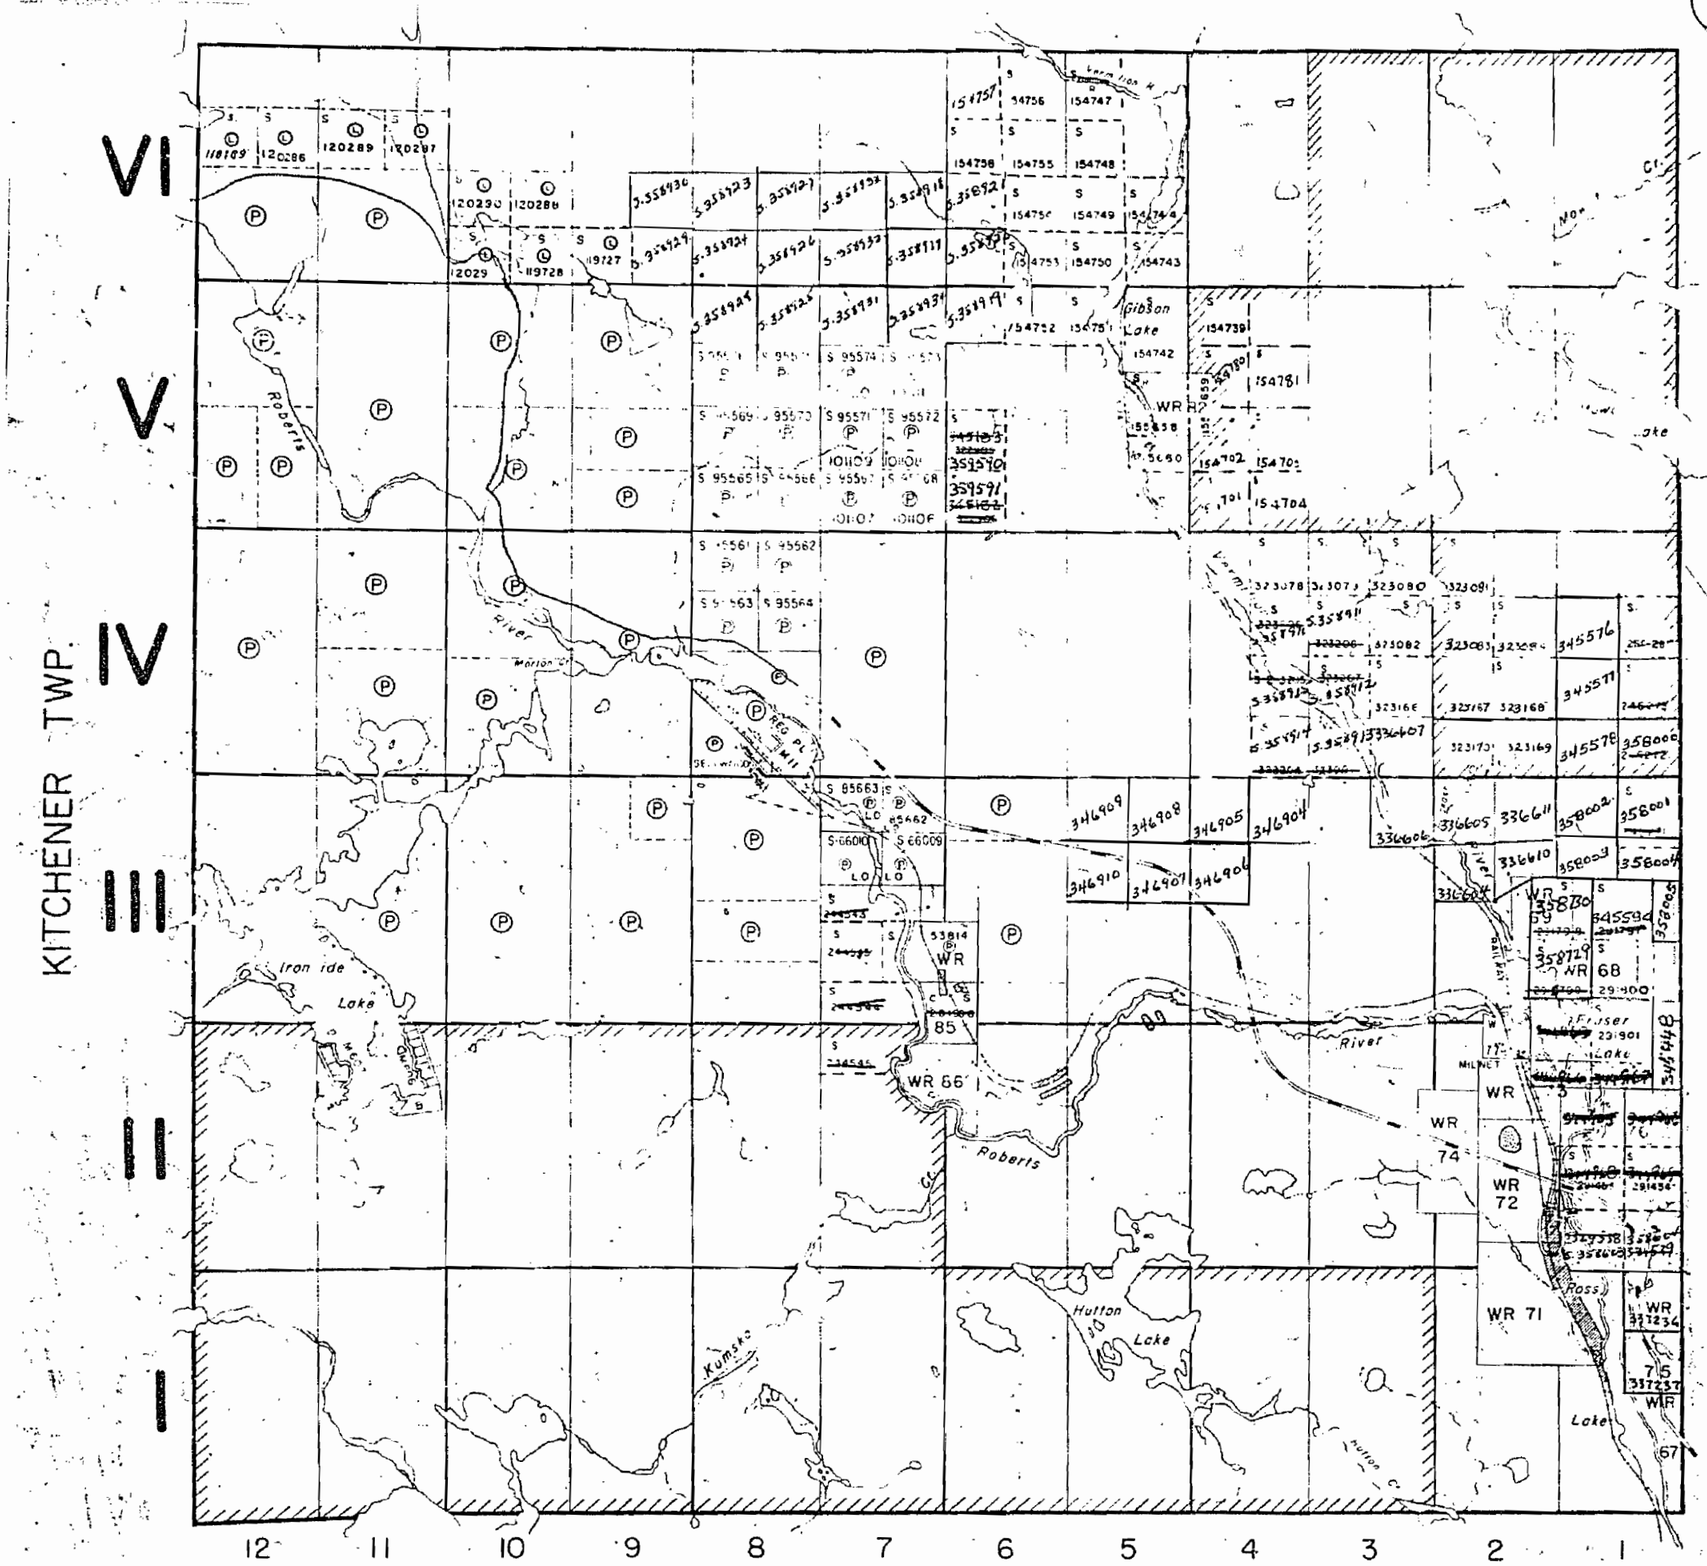

WISNER TWP.

THE TOWNSHIP OF HUTTON

DISTRICT OF SUDBURY

SUDBURY MINING DIVISION

SCALE: 1-INCH=40 CHAINS

LEGEND

PATENTED LAND	(P)
CROWN LAND SALE	C.S.
LEASES	(L)
LOCATED LAND	Loc.
LICENSE OF OCCUPATION	L.O.
MINING RIGHTS ONLY	M.R.O.
SURFACE RIGHTS ONLY	S.R.O.
ROADS	
IMPROVED ROADS	
KING'S HIGHWAYS	
RAILWAYS	
POWER LINES	
MARSH OR MUSKEG	
MINES	
CANCELLED	C.

NOTES

400' Surface Rights Reservation around all lakes and rivers.

Lots 1 to 6, concessions 1 to 6 may be staked in the same manner as mining claims in unsurveyed territory. May 16, 1946 — File 83.5 — Mining Act Sec. 53 S 4, 19 (52 A 1946).

Land required for railway purposes shown thus:

Files 4826 & 4841.

Dept of Highways' gravel pits shown thus:

Parts of the subdivision shown thus: are annulled under the authority of the Minister of Lands & Forests.

PLAN NO.- M-944

ONTARIO DEPARTMENT OF MINES AND NORTHERN AFFAIRS

944

CREELMAN TWP.

Gibson L.

Mowat L.

Sellwood

Ironside L.

Roberts R.

Milnet

Fraser L.

Hutton L.

Ross

KITCHENER TWP.

PARKIN TWP.

WISNER TWP.

I II III IV V VI

12 11 10 9 8 7 6 5 4 3 2 1

100' wide reservations on surface by Dept of L. & F. shewn hereon thus .....

THE TOWNSHIP OF HUTTON

DISTRICT OF SUDBURY
SUDBURY MINING DIVISION

SCALE 1 INCH TO 40 CHAINS

LEGEND

PATENTED LANDS	(P)
CROWN LAND SALES	(S)
LOCATED LANDS	Loc.
LICENSE OF OCCUPATION	L.O.
ROADS	
CANADIAN NATIONAL RAILWAY	

NOTES

LOTS 1 TO 5 CONCESSIONS 7 TO 6 MAY BE STAKED IN THE SAME MANNER AS MINING CLAIMS IN UNSURVEYED TERRITORY.

MG LEASE # 10887 ONWATIN PLACER GOLD LTD. SHOWN THUS: ——

Notice of determination on mining lease # 10887 Sept 7/57

See twp file

over flooded - collection and refuse from C.N.R. in con 3 entirely 7 ft. 2 ins

M944

DEPARTMENT OF MINES
ONTARIO

M 944

CREELMAN TWP.

annulled Portion

VI

V

IV

KITCHENER TWP.

PARKIN TWP.

WISNER TWP.

annulled portion

12 11 10 9 8 7 6 5 4 3 2 1

Vermilion R.

Gibson Lake

Mawat Lake

Roberts

Marion R.

Ironside Lake

Kumska Lake

Hutton Lake

Fraser Lake

Ross Lake

WR 82

WR 74

WR 73

WR 72

WR 71

WR 68

WR 86

WR 85

THE TOWNSHIP OF

HUTTON TWP.

DISTRICT OF SUDBURY

SUDBURY MINING DIVISION

SCALE: 1-INCH = 40 CHAINS

LEGEND

PATENTED LAND	(P)
CROWN LAND SALE	C.S.
LEASES	(L)
LOCATED LAND	Loc.
LICENSE OF OCCUPATION	L.O.
MINING RIGHTS ONLY	M.R.O.
SURFACE RIGHTS ONLY	S.R.O.
ROADS	
IMPROVED ROADS	
KING'S HIGHWAYS	
RAILWAYS	
POWER LINES	
MARSH OR MUSKEG	
MINES	
CANCELLED	C.

NOTES

400' Reserve around all Lakes and Rivers to Dept. of Lands & Forests.

Lots 1 to 6, concessions 1 to 6 may be staked in the same manner as mining claims in unsurveyed territory. May 16, 1946 — File 83.5 — Mining Act ~~52 part 2~~ 53

Land required for railway purposes shown thus:

Files 4326 & 4841.

Dept. of Highways' gravel pit shown thus:

PLAN NO. M-944

DEPARTMENT OF MINES

— ONTARIO —

M-944

CREELMAN TWP.

KITCHENER TWP.

PARKIN TWP.

WISNER TWP.

VI

V

IV

III

12 11 10 9 8 7 6 5 4 3 2 1

Vermilion R.

Gibson Lake

Roberts

Marion Cr.

Sellwood

Ironside Lake

Hutton Lake

Kumsac

Fraser Lake

Ross Lake

Mowatt Lake

Vermilion River

Wisconsin Central Railway

WR 66

WR 69

WR 68

WR 73

WR 74

WR 72

WR 71

WR 75

WR 67

WR 76

THE TOWNSHIP OF

HUTTON

DISTRICT OF SUDBURY

SUDBURY MINING DIVISION

SCALE: 1-INCH=40 CHAINS

LEGEND

PATENTED LAND	P
CROWN LAND SALE	C.S.
LEASES	L
LOCATED LAND	Loc.
LICENSE OF OCCUPATION	L.O.
MINING RIGHTS ONLY	M.R.O.
SURFACE RIGHTS ONLY	S.R.O.
ROADS	
IMPROVED ROADS	
KING'S HIGHWAYS	
RAILWAYS	
POWER LINES	
MARSH OR MUSKEG	
MINES	
CANCELLED	C.

NOTES

400' Surface Rights Reservation around all lakes and rivers.

Lots 1 to 6, concessions 1 to 6 may be staked in the same manner as mining claims in unsurveyed territory. May 16, 1946 — File 83.5 — Mining Act Sec. 53 (52 A 1946).

Land required for railway purposes shown thus:

Files 4826 & 4841.

Dept of Highways' gravel pits shown thus:

Parts of the subdivision shown thus: are annulled under the authority of the Minister of Lands & Forests.

SUDBURY LANDS DIV. RECEIVED JAN 19 1969 AM PM

PLAN NO.- M-944

DEPARTMENT OF MINES

— ONTARIO —

944

35

HUTTON

Scale 40 Chains to an Inch.

See plan

CREELMAN

M.L. 3107 P 297 ac. M.L. 2956 P

M.L. 3107 P 308 M.L. 3053 P

305 P

304 P

VI 305

304

301

265

294

274

267

300 ac.

M.L. 2960 P 319 M.P. 3368 M.L. 2958 P

M.L. 3042 P 320

M.L. 3061 P 320 M.L. 3044 P

160 a M.L. 3043 317 P 678

V P M.L. 3169 322

318

313

251 M.R. 82 348

294

304

295

235 Monat L

21920 21919 21918

322

306

P 153 a M.L. 3045

P 157.2 a M.L. 3046 315

P M.L. 2965 306

P M.L. 3211 IV. 320

M.P. 3371 12

M.P. 3372 11

M.P. 3372 10

9

M.L. 3063 P

M.P. 3368

M.P. 3368

M.L. 3246

M.P. 3368

M.L. 3063 P

M.P. 3368

M.P. 3368

M.P. 3368

944

CREELMAN TWP.

VI

V


IV

KITCHENER TWP.

PARKIN TWP.

WISNER T.WP.

12 11 10 9 8 7 6 5 4 3 2 1

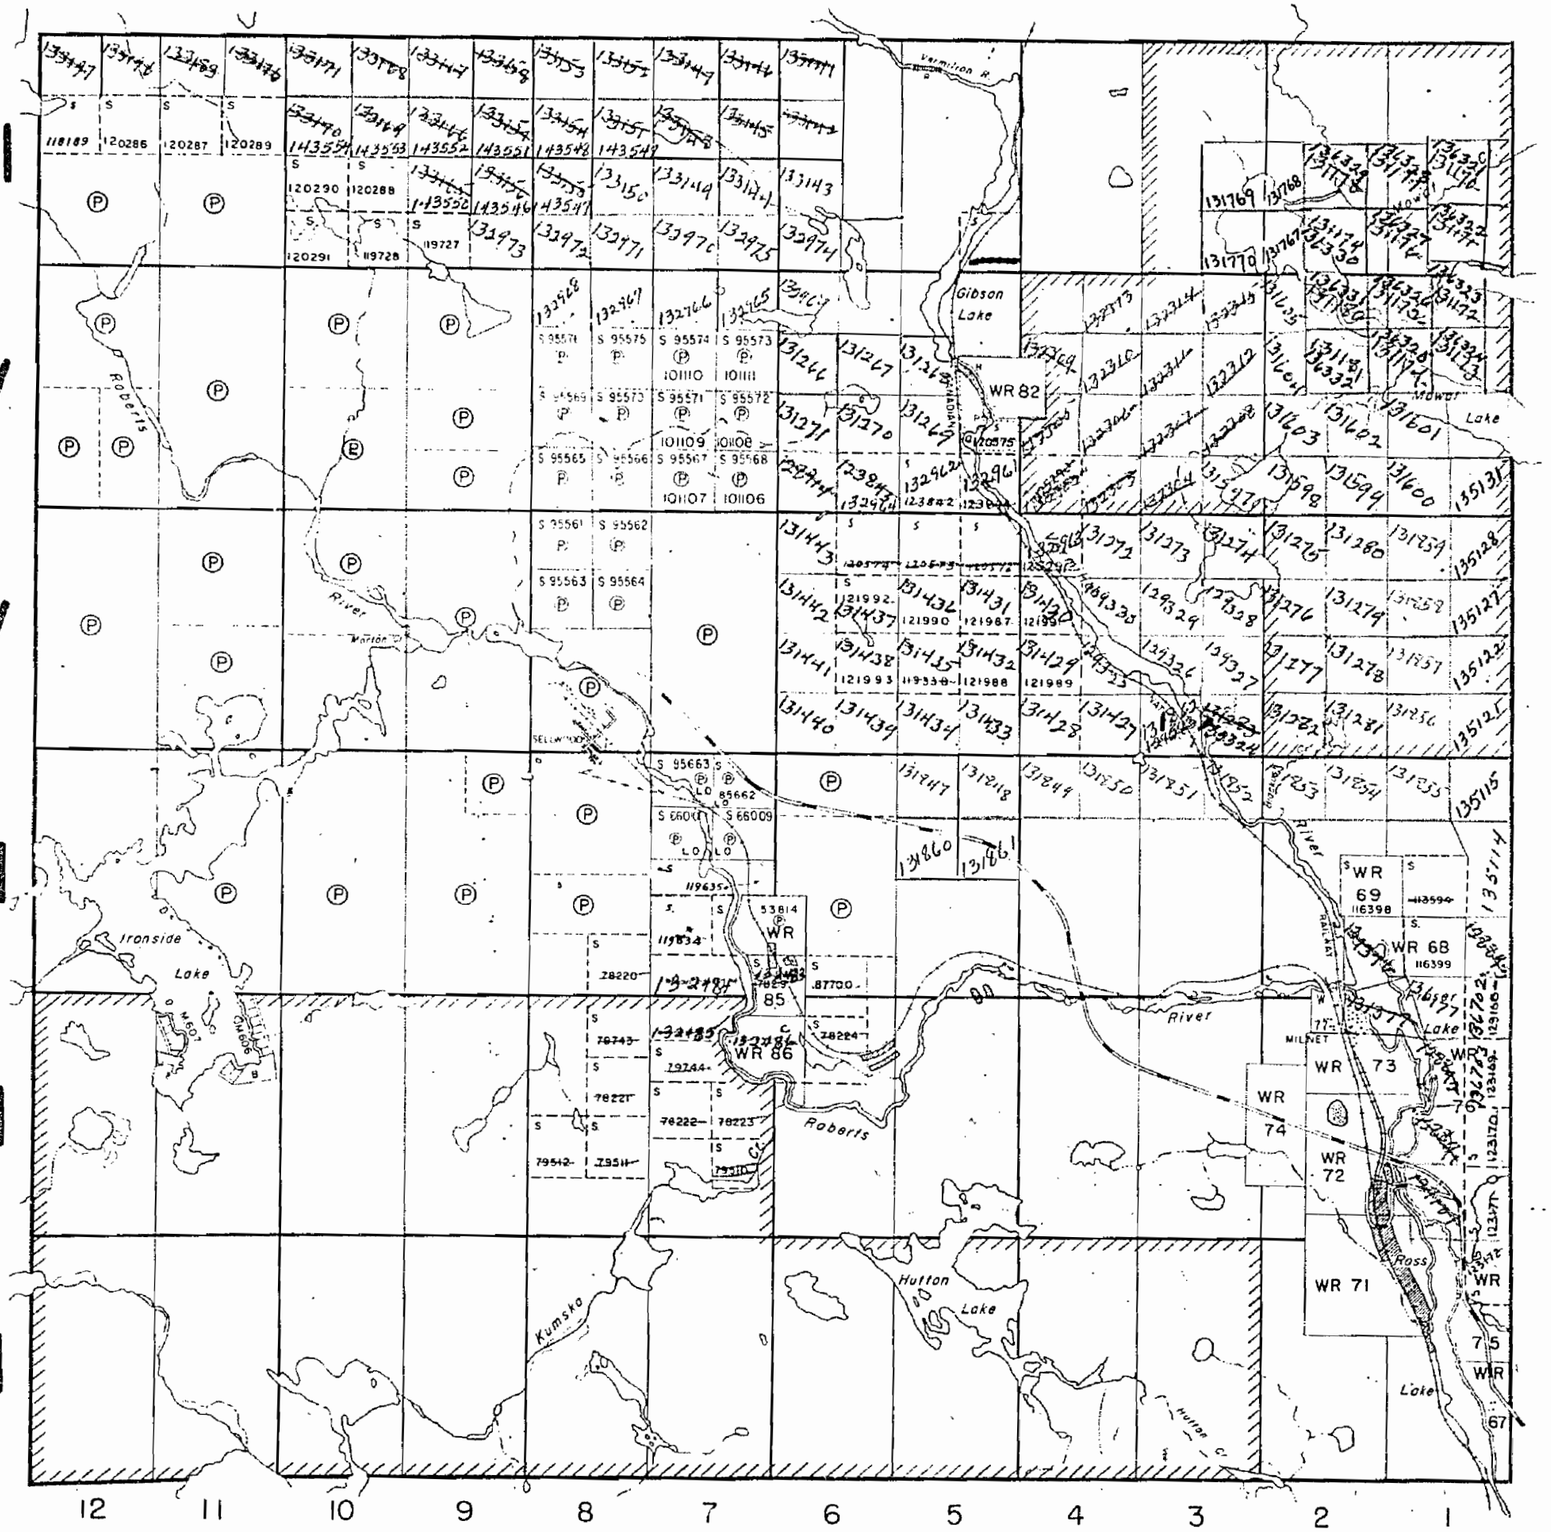

THE TOWNSHIP OF HUTTON

DISTRICT OF SUDBURY

SUDBURY MINING DIVISION

SCALE: 1-INCH=40 CHAINS

LEGEND

PATENTED LAND	(P)
CROWN LAND SALE	C.S.
LEASES	(L)
LOCATED LAND	Loc.
LICENSE OF OCCUPATION	L.O.
MINING RIGHTS ONLY	M.R.O.
SURFACE RIGHTS ONLY	S.R.O.
ROADS	
IMPROVED ROADS	
KING'S HIGHWAYS	
RAILWAYS	
POWER LINES	
MARSH OR MUSKEG	
MINES	
CANCELLED	C.

NOTES

400' Surface Rights Reservation around all lakes and rivers.

Lots 1 to 6, concessions 1 to 6 may be staked in the same manner as mining claims in unsurveyed territory. May 16, 1946 — File 83.5 — Mining Act Sec. 53 (52 A 1946).

Land required for railway purposes shown thus:

Files 4826 & 4841.

Dept of Highways' gravel pits shown thus:

Parts of the subdivision shown thus: are annulled under the authority of the Minister of Lands & Forests

PLAN NO.- M-944

DEPARTMENT OF MINES

— ONTARIO —

944

No 28

CREELMAN TWP.

N

KITCHENER TWP.

PARKIN TWP.

Gibson L.

WR 82

Mowat L.

Vermilion R.

Sellwood

Ironside L.

Fraser

Roberts R.

Milnet

Hutton L.

Ross

VI

V

IV

III

II

I

12 11 10 9 8 7 6 5 4 3 2 1

WISNER TWP.

THE TOWNSHIP OF

HUTTON

DISTRICT OF SUDBURY

SUDBURY MINING DIVISION

SCALE 1 INCH TO 40 CHAINS

LEGEND

PATENTED LANDS	(P)
CROWN LAND SALES	(S)
LOCATED LANDS	Loc.
LICENSE OF OCCUPATION	L.O.
ROADS	═══
CANADIAN NATIONAL RAILWAY	———

NOTES

-LOTS 1 TO 6 CONCESSIONS I TO 6 MAY BE STAKED IN THE SAME MANNER AS MINING CLAIMS IN UNSURVEYED TERRITORY.

Area covered by Lease 10887 for Gold only. Does not grant title to Surface Rights or other minerals. J.F.S. letter Feb. 17/51 File 4829; 137.1

Conservation Placer

NOTE: N½ of N½ of Lot 7, Con 3 open for staking in May 1948 File 4822 D. Stevens letter June 6/51

SUDBURY RECEIVED SEP 4 - 1947 MINING DIVISION

M944

DEPARTMENT OF MINES ONTARIO

J.C.

944

CREELMAN TWP.

N

KITCHENER TWP.

PARKIN TWP.

VI

V

IV

III

II

I

Gibson L.

Vermilion R.

Sellwood

Ironside L.

Fraser L.

Milnet

Roberts R.

Hutton L.

Ross

Mowat L.

12 11 10 9 8 7 6 5 4 3 2 1

WISNER TWP.

200' wide reservations on surface by Dept of L. & R. shewn hereon thus

J.C.

THE TOWNSHIP OF

HUTTON

DISTRICT OF SUDBURY

SUDBURY MINING DIVISION

SCALE 1 INCH TO 40 CHAINS

LEGEND

PATENTED LANDS	(P)
CROWN LAND SALES	(S)
LOCATED LANDS	Loc.
LICENSE OF OCCUPATION	L.O.
ROADS	
CANADIAN NATIONAL RAILWAY	

NOTES

LOTS 1 TO 6 CONCESSIONS 1 TO 6 MAY BE STAKED IN THE SAME MANNER AS MINING CLAIMS IN UNSURVEYED TERRITORY.

MG. LEASE # 10887 ONWATER PLACER GOLD LTD. SHOWN THUS: ———

M944

DEPARTMENT OF MINES
ONTARIO

M 944

CREELMAN TWP.

KITCHENER TWP.

PARKIN TWP.

WISNER TWP.

Sellwood

Ironside L.

Roberts R.

Milnet

Fraser L.

Hutton L.

Ross

VI

V

IV

III

II

I

12 11 10 9 8 7 6 5 4 3 2 1

200' wide reservations on surface by Dept of L. & R. shewn hereon thus

THE TOWNSHIP OF

HUTTON

DISTRICT OF SUDBURY

SUDBURY MINING DIVISION

SCALE 1 INCH TO 40 CHAINS

LEGEND

PATENTED LANDS	(P)
CROWN LAND SALES	(S)
LOCATED LANDS	Loc.
LICENSE OF OCCUPATION	L.O.
ROADS	═══
CANADIAN NATIONAL RAILWAY	═══

NOTES

LOTS 1 TO 6, CONCESSIONS I TO 6 MAY BE STAKED IN THE SAME MANNER AS MINING CLAIMS IN UNSURVEYED TERRITORY.

MG. LEASE # 10887 ONWATIN PLACER GOLD LTD. SHOWN THUS: ———

66' Road allowance in front of W.R. 85 & 86 Open June 1/54 Cl. Aug 16/54

M 944

DEPARTMENT OF MINES
ONTARIO

M 944

THE TOWNSHIP OF HUTTON

DISTRICT OF SUDBURY

SUDBURY MINING DIVISION

SCALE 1 INCH TO 40 CHAINS

LEGEND

PATENTED LANDS (P)
CROWN LAND SALES (S)
LOCATED LANDS L.L.
LICENSE OF OCCUPATION L.O.
ROADS
CANADIAN NATIONAL RAILWAY

NOTES

LOTS 1 TO 6 CONCESSIONS I TO 6 MAY BE STAKED IN THE SAME MANNER AS MINING CLAIMS IN UNSURVEYED TERRITORY.

MG. LEASE # 0887 ONWATIN PLACER GOLD LTD. SHOWN THUS:

CREELMAN TWP.

KITCHENER TWP.

PARKIN TWP.

WISNER TWP.

VI

V

IV

Gibson L.

Sellwood

Iron side L.

Roberts R.

Milnet

Frasle R.

Hutton L.

Ross

12 11 10 9 8 7 6 5 4 3 2 1

100' wide reservations on surface by Dept of L. & F. shown hereon thus

52A

M944

DEPARTMENT OF MINES
ONTARIO

M-944

CREELMAN TWP.

KITCHENER TWP.

PARKIN TWP.

WISNER TWP.

VI

V

IV

12 11 10 9 8 7 6 5 4 3 2 1

Roberts

Vermilion River

Ironside Lake

Kumsko Lake

Hutton Lake

Gibson Lake

Fraser Lake

Ross Lake

Roberts

Kumsko

Hutton

Lake

Ross

Lake

Fraser

Lake

River

Vermilion River

Vermilion Cr.

Huron Cr.

WR 86

WR 85

WR 74

WR 73

WR 72

WR 71

WR 69

WR 68

WR 67

WR 76

WR 75

THE TOWNSHIP OF

HUTTON

DISTRICT OF SUDBURY

SUDBURY MINING DIVISION

SCALE: 1-INCH=40 CHAINS

LEGEND

PATENTED LAND	Ⓟ
CROWN LAND SALE	C.S.
LEASES	Ⓛ
LOCATED LAND	Loc.
LICENSE OF OCCUPATION	L.O.
MINING RIGHTS ONLY	M.R.O.
SURFACE RIGHTS ONLY	S.R.O.
ROADS	
IMPROVED ROADS	
KING'S HIGHWAYS	
RAILWAYS	
POWER LINES	
MARSH OR MUSKEG	
MINES	
CANCELLED	C.

NOTES

400' Surface Rights Reservation around all lakes and rivers.

~~Lots 1 to 6, concessions I to 6 may be staked in the same manner as mining claims in unsurveyed territory. May 16, 1946 — File 83.5 — Mining Act Sec. 53. (52 A 1946).~~

Land required for railway purposes shown thus:

Files 4826 & 4841.

Dept of Highways' gravel pits shown thus:

Parts of the subdivision shown thus: are annulled under the authority of the Minister of Lands & Forests

PLAN NO.- M-944

DEPARTMENT OF MINES

— ONTARIO —

M 944

CREELMAN TWP.


VI

V

IV

KITCHENER TWP.

PARKIN TWP.

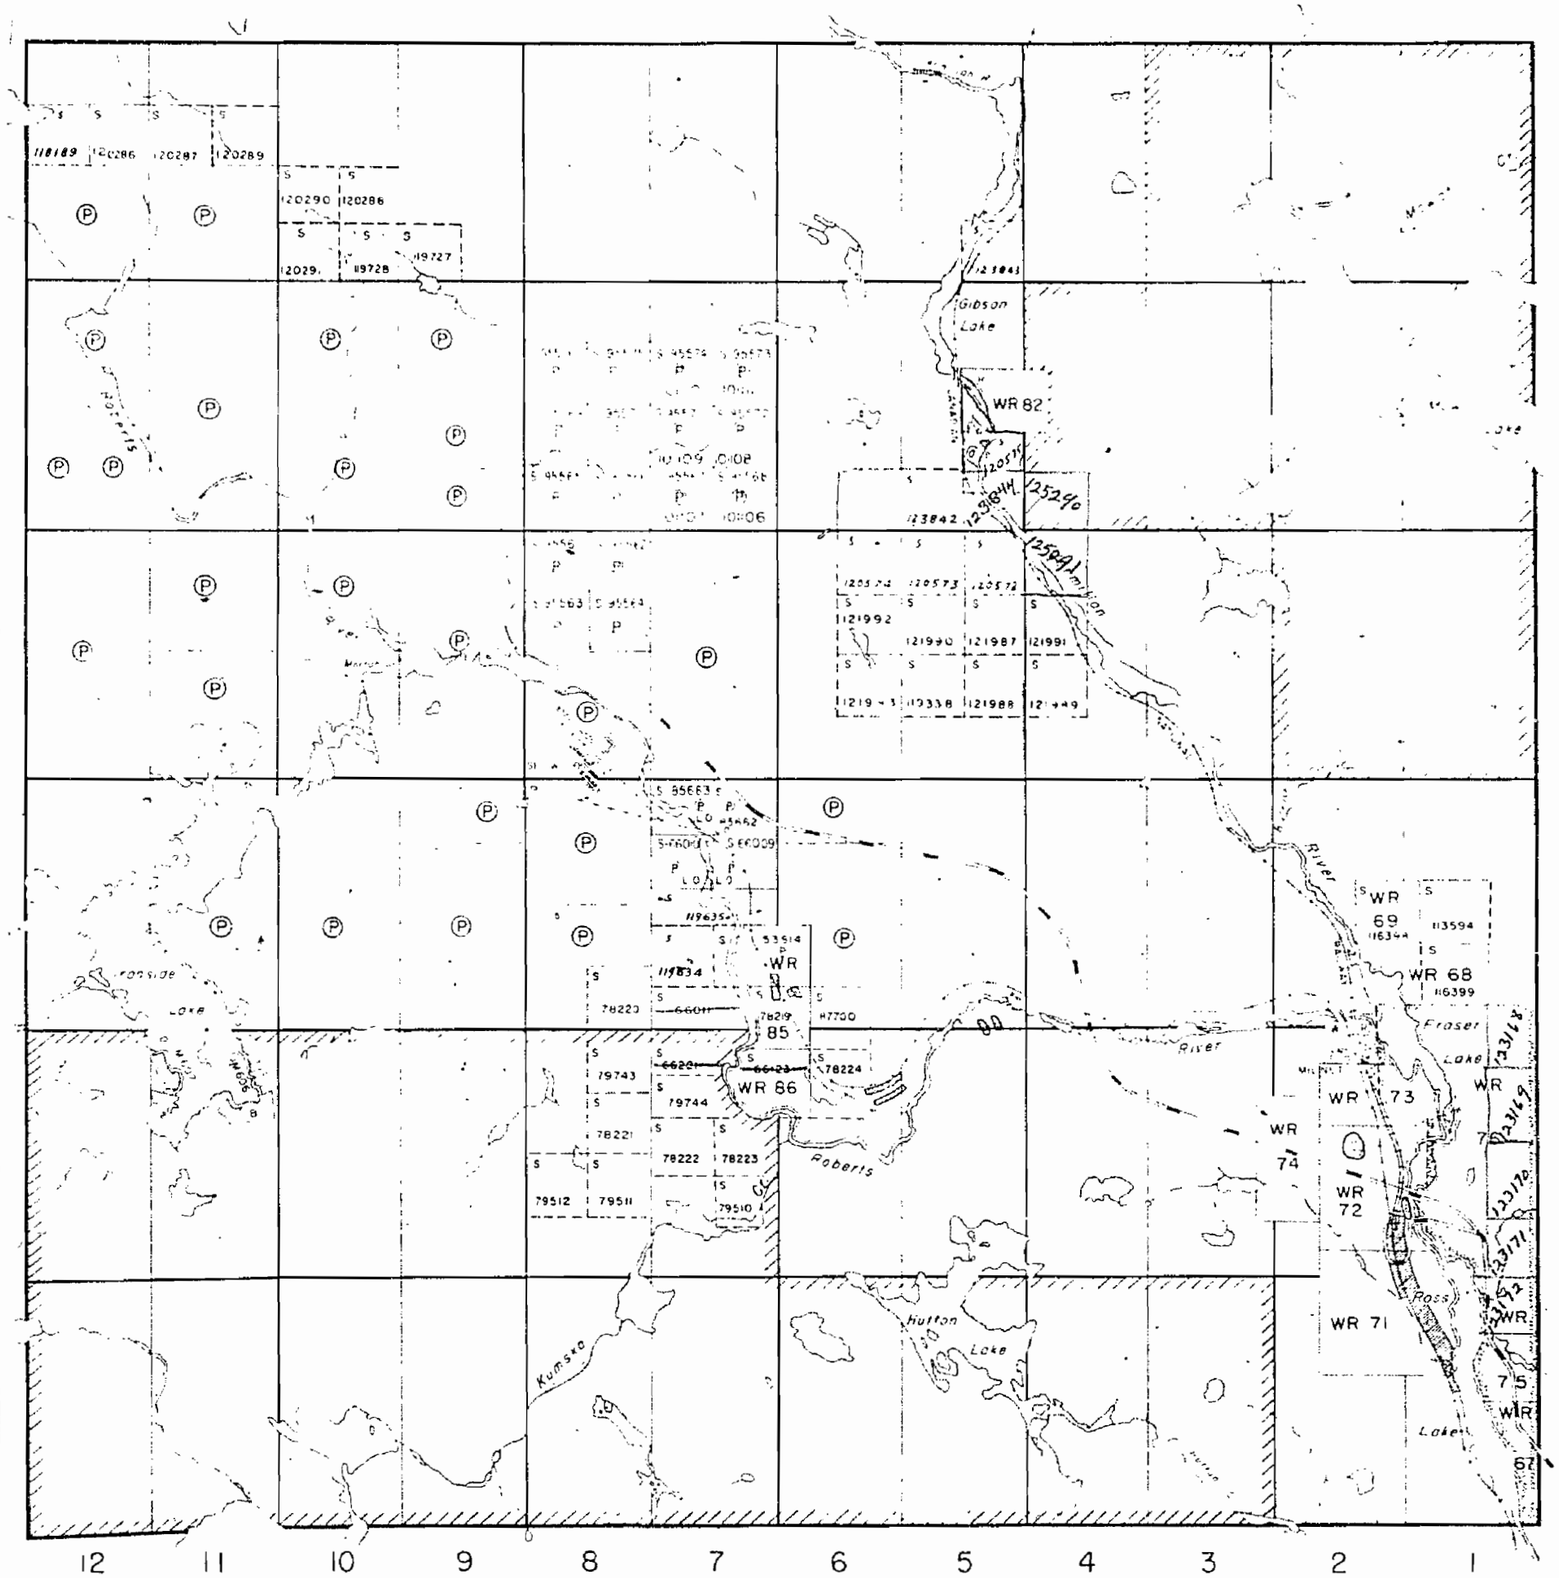

WISNER TWP.

THE TOWNSHIP OF

HUTTON

DISTRICT OF SUDBURY

SUDBURY MINING DIVISION

SCALE: 1-INCH=40 CHAINS

LEGEND

PATENTED LAND	(P)
CROWN LAND SALE	C.S.
LEASES	(L)
LOCATED LAND	Loc.
LICENSE OF OCCUPATION	L.O.
MINING RIGHTS ONLY	M.R.O.
SURFACE RIGHTS ONLY	S.R.O.
ROADS	
IMPROVED ROADS	
KING'S HIGHWAYS	
RAILWAYS	
POWER LINES	
MARSH OR MUSKEG	
MINES	
CANCELLED	C.

NOTES

400' Surface Rights Reservation around all lakes and rivers

Lots 1 to 6, concessions I to 6 may be staked in the same manner as mining claims in unsurveyed territory. May 16, 1946 – File 83.5 – Mining Act Sec. 53 (52 A 1946)

Land required for railway purposes shown thus:

Files 4826 & 4841.

Dept of Highways' gravel pits shown thus:

Staking may be carried out for any other mineral other than alluvial mineral under Sec. 36(d) of the Mining Act shown thus: Now covered by Mg Lease 1544 – Placer Only.

Parts of the subdivision shown thus: are annulled under the authority of the Minister of Lands & Forests

PLAN NO.- M-944

DEPARTMENT OF MINES

— ONTARIO —

M-944

CREELMAN TWP.

VI

V

IV

KITCHENER TWP.

PARKIN TWP.

WISNER TWP.

12 11 10 9 8 7 6 5 4 3 2 1

THE TOWNSHIP OF HUTTON

DISTRICT OF SUDBURY

SUDBURY MINING DIVISION

SCALE 1-INCH=40 CHAINS

LEGEND

PATENTED LAND	(P)
CROWN LAND SALE	C.S.
LEASES	(L)
LOCATED LAND	Loc.
LICENSE OF OCCUPATION	L.O.
MINING RIGHTS ONLY	M.R.O.
SURFACE RIGHTS ONLY	S.R.O.
ROADS	
IMPROVED ROADS	
KING'S HIGHWAYS	
RAILWAYS	
POWER LINES	
MARSH OR MUSKEG	
MINES	
CANCELLED	C.

NOTES

400' Surface Rights Reservation around all lakes and rivers.

Lots 1 to 6, concessions 1 to 6 may be staked in the same manner as mining claims in unsurveyed territory. May 16, 1946 — File 83.5 — Mining Act Sec. 53 - 54 (52 A 1946)

Land required for railway purposes shown thus: Files 4826 & 4841.

Dept of Highways' gravel pits shown thus:

Parts of the subdivision shown thus: are annulled under the authority of the Minister of Lands & Forests.

PLAN NO.- M-944

DEPARTMENT OF MINES

— ONTARIO —