PLAN OF
JAFFRAY TWP.
KENORA MINING DIVISION.
DISTRICT OF KENORA.

Scale, 40 chains to an inch.

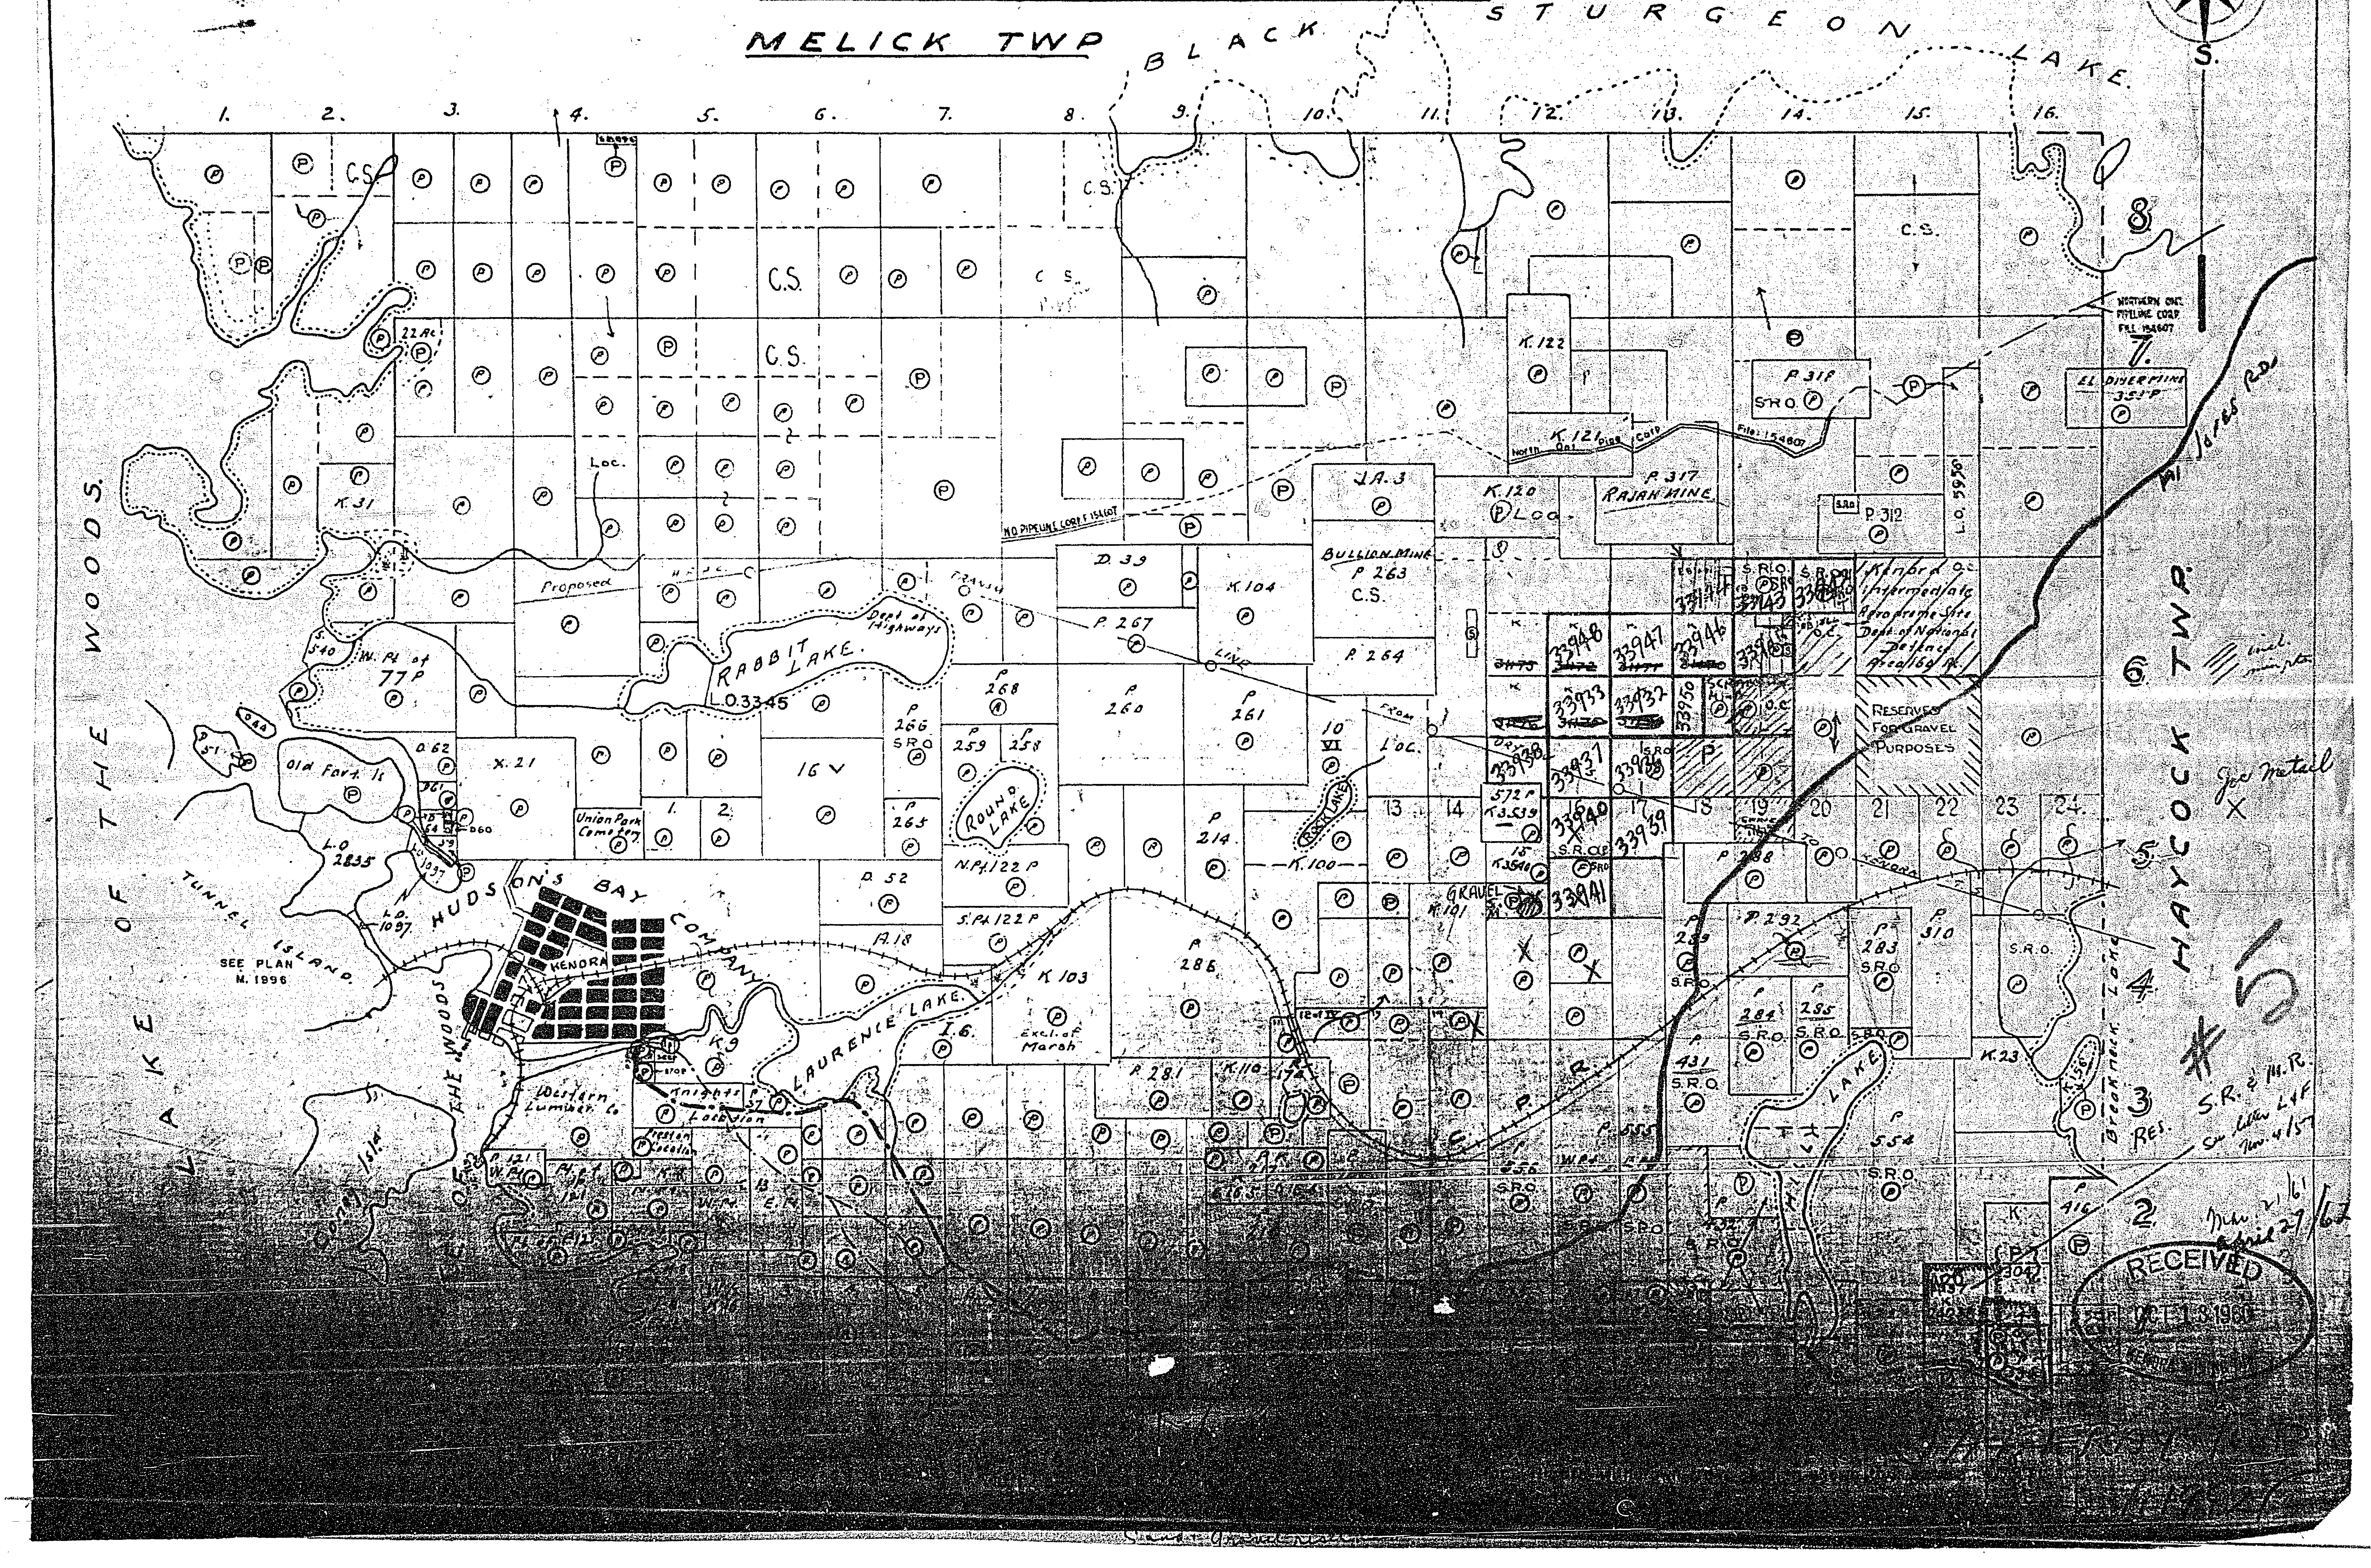

Ast. North
N.
W.
E.
S.
MELICK TWP
BLACK STURGEON LAKE
1. 2. 3. 4. 5. 6. 7. 8. 9. 10. 11. 12. 13. 14. 15. 16.
8
7.
6
5.
4
3
2
C.S.
22 Ac
K.31
Loc.
NORTHERN ONT. PIPELINE CORP. FILE 154607
K.122
K.121
P.318
S.R.O.
EL DIVERMINE 353P
P.317
RAJAH MINE
K.120
Loc.
P.312
L.O. 5950
J.A.3
BULLION MINE P.263 C.S.
D.39
K.104
P.267
P.264
NO PIPELINE CORP. F. 154607
Proposed
Dept of Highways
RABBIT LAKE
L.O. 3345
268
260
261
266 S.R.O.
259
258
ROUND LAKE
Kenora D.O.C. Intermediate Aerodrome Site Dept. of National Defence Area 164 Ac.
RESERVED FOR GRAVEL PURPOSES
33948
33947
33946
33933
33932
33950
33938
33937
33940
33939
33941
MAYCOCK TWP
Mt. Jones Rd.
W. Pt. of 77P
Old Fort Is.
X.21
16
Union Park Cemetery
LO 2835
1097
L.O. 1097
D.52
N.Pt. 122 P
S.Pt. 122 P
P.265
214
K.100
572 P
K.3539
K.3540
GRAVEL K.101
P.288
P.292
283 S.R.O.
310
284 S.R.O.
285 S.R.O.
431 S.R.O.
554 S.R.O.
K.23
K.1561
Brook Neck Lake
Res.
13 14 15 16 17 18 19 20 21 22 23 24
A.18
K.103
286
Excl. of Marsh
K.9
HUDSON'S BAY COMPANY
KENORA
TUNNEL ISLAND
SEE PLAN M.1996
LAKE OF THE WOODS
Western Lumber Co.
Knights Location
LAURENCE LAKE
P.281
K.110
C.P.R.
S.R.O.
P.555
P.416
C.P. 3042
K
Joe Metail
S.R. & M.R.
Nov 2/61
April 27/62

RECEIVED
OCT 18 1960

PLAN OF
JAFFRAY TWP.
KENORA MINING DIVISION.
DISTRICT OF KENORA.

Scale, 40 chains to an inch.

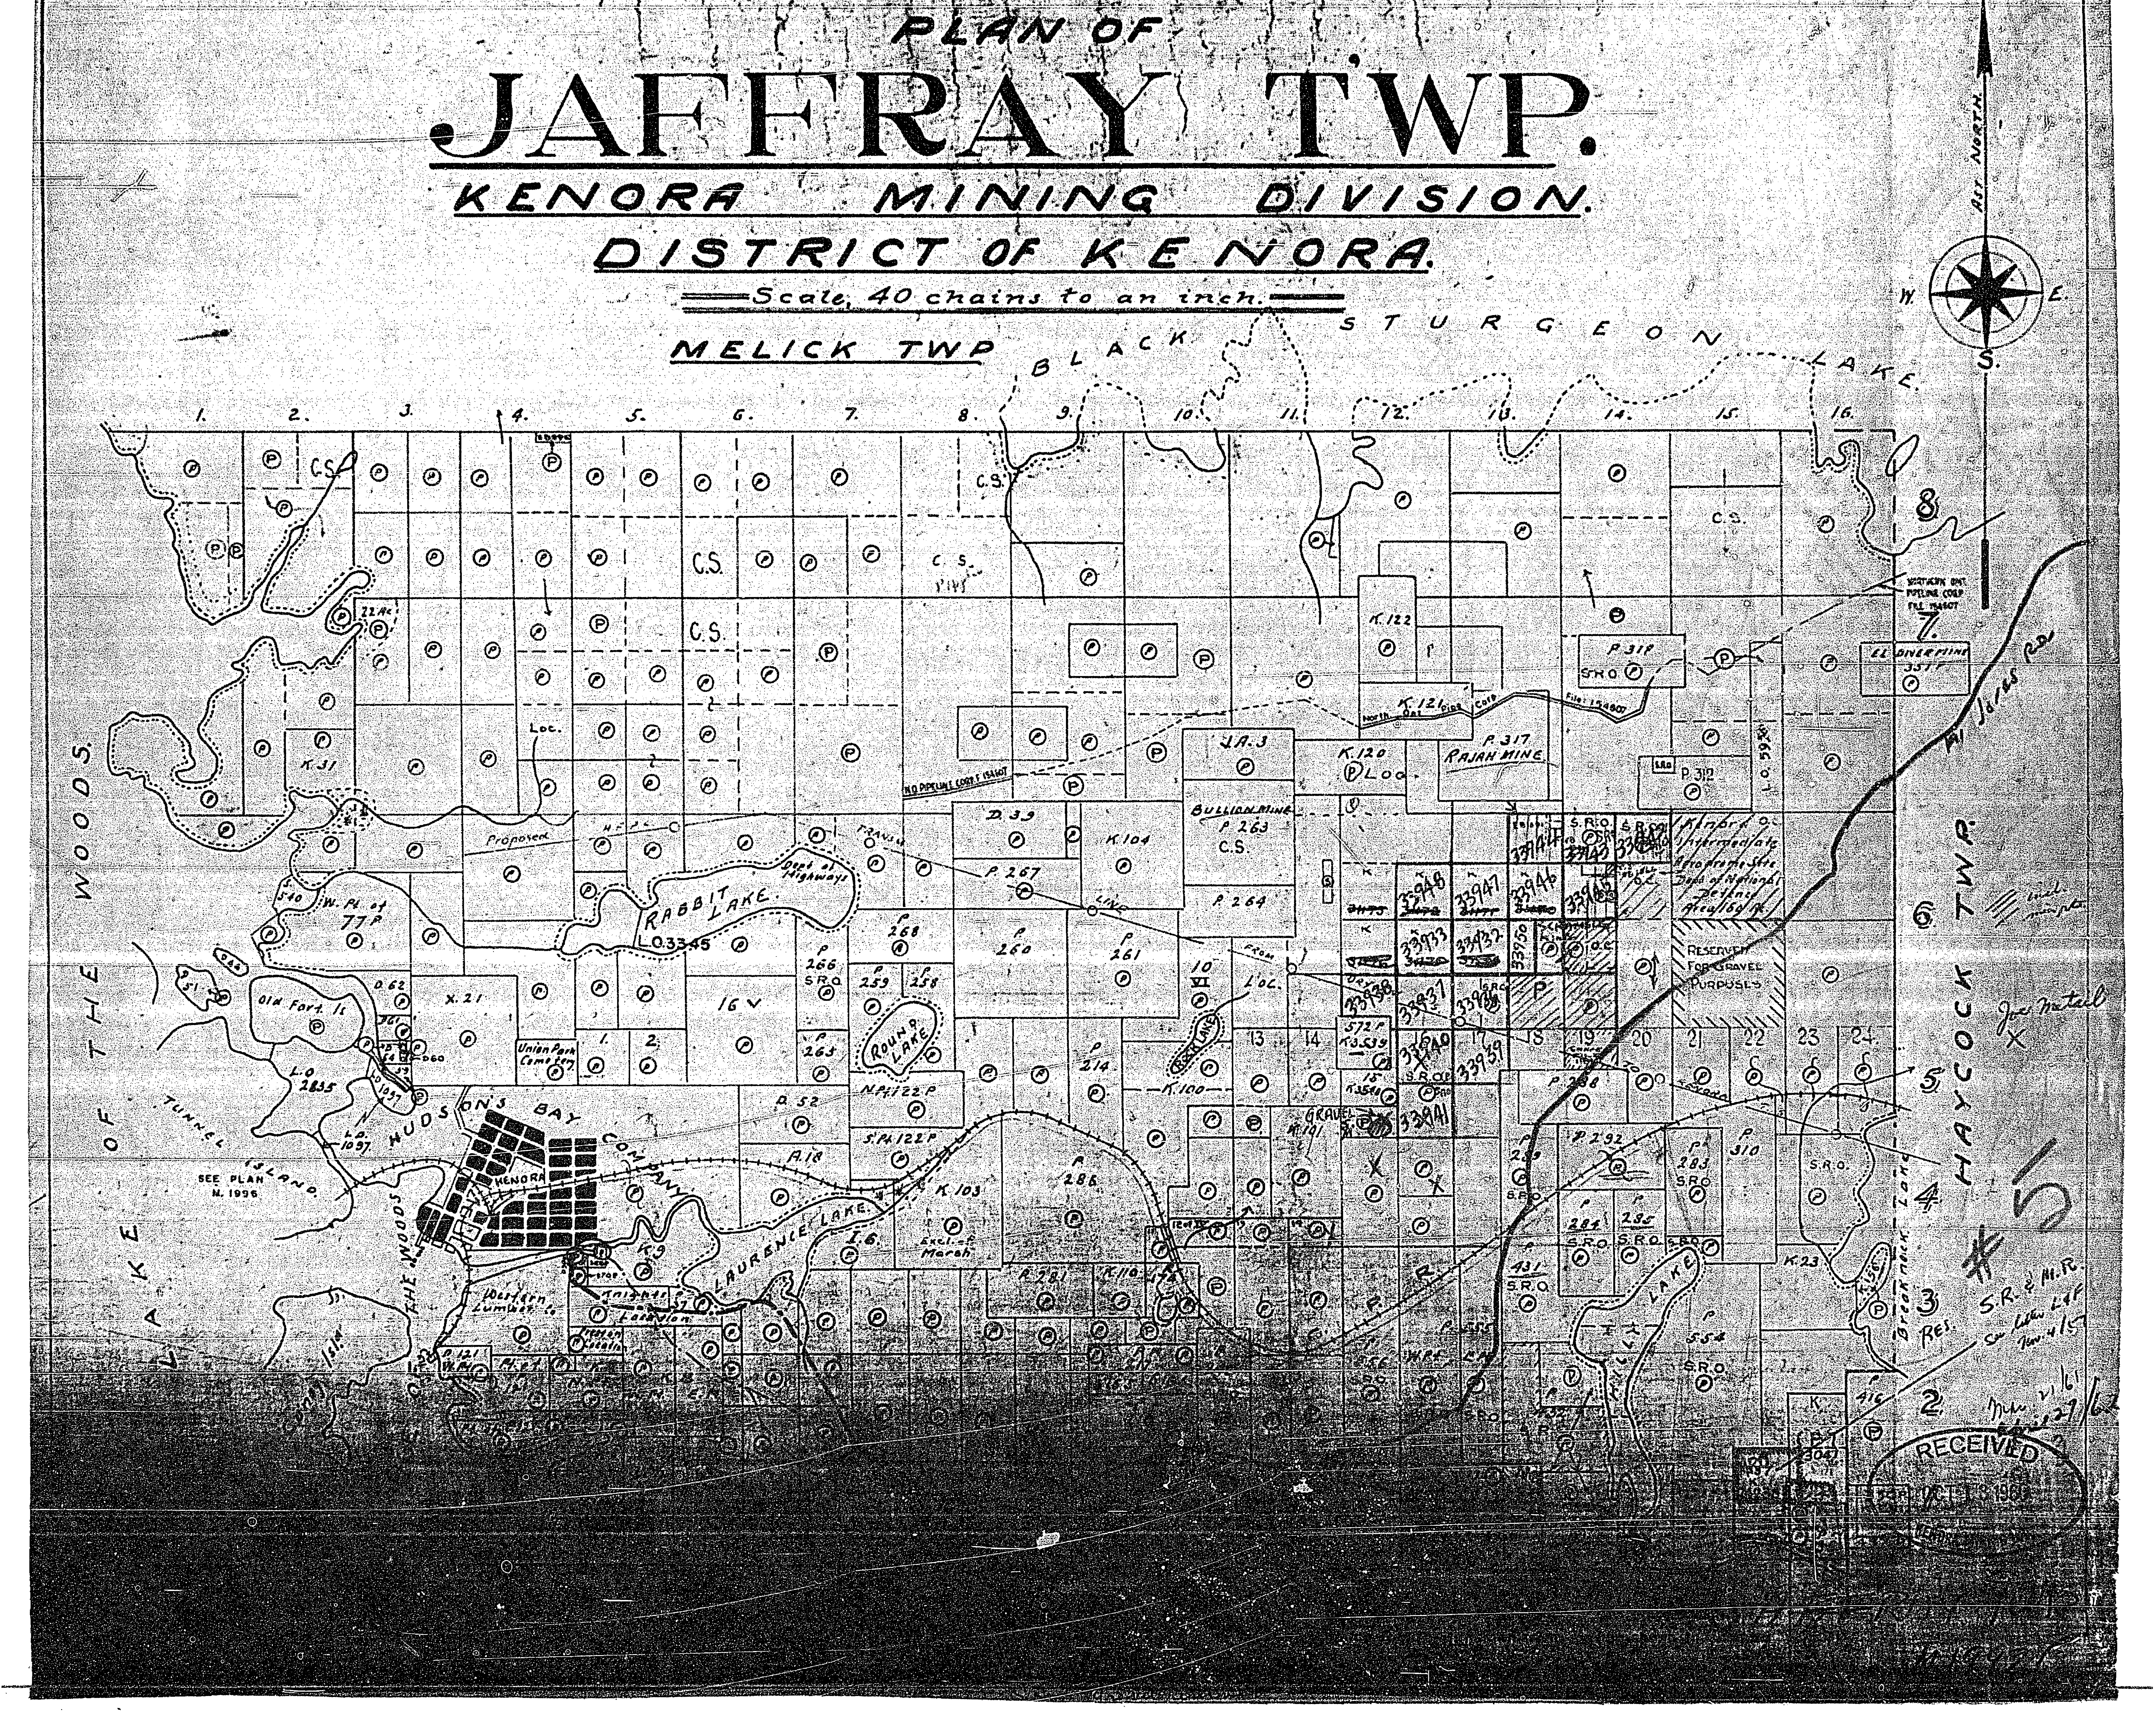

AST. NORTH
N.
W.
E.
S.
MELICK TWP
BLACK STURGEON LAKE
1. 2. 3. 4. 5. 6. 7. 8. 9. 10. 11. 12. 13. 14. 15. 16.
C.S.
K.31
K.122
K.121
North Ont. Pipe Corp. File: 154607
Northern Ont. Pipeline Corp File 154607
P.318
S.R.O.
EL DIVER MINE 357 P
J.A.3
K.120
LOC.
P.317
RAJAH MINE
P.312
L.O. 5938
N.O. PIPELINE CORP. F. 154607
Proposed
D.39
K.104
BULLION MINE
P.263
P.264
P.267
Line
From
Kenora Intermediate Aerodrome Site Dept of National Defence Area 160 Ac.
Reserved for Gravel Purposes
33944
33943
33942
33948
33947
33946
33945
33933
33932
33950
33938
33937
33936
33940
33939
33941
W. Pt. of 77 P
Rabbit Lake
Dept. of Highways
L.O. 3345
P 266 S.R.O.
P 268
P 260
P 261
P 259
P 258
Round Lake
10 VI
Loc.
Rock Lake
D.62
X.21
16 V
Old Fort Is.
L.O. 2835
L.O. 1097
Union Park Cemetery
1. 2.
P 265
13 14 15 16 17 18 19 20 21 22 23 24
572 P K 3539
K 3540
GRAVEL K.191
K.100
P 214
P.288
P.292
P 289
P 283 S.R.O.
P 310
P 284 S.R.O.
P 285 S.R.O.
P 431 S.R.O.
P 554 S.R.O.
K.23
K.156
P 416
K
P 304
Lily Lake
Brecknock Lake
Res.
N.P. 122 P
S.P. 122 P
D.52
A.18
K.103
P 286
I.6
Excl. of Marsh
P 281
K.110
Laurence Lake
C.P.R.
K.9
Knight's Location
Western Lumber Co.
HUDSON'S BAY COMPANY
KENORA
Tunnel Island
SEE PLAN M. 1996
LAKE OF THE WOODS
P 121 W.R.
W.P.R.
HAYCOCK TWP.
8 7 6 5 4 3 2
Al Jales Rd
Trail Mine pits
Joe Metail
S.R. & M.R. See letter L & F Nov 4/5
#5
Nov 21/61
RECEIVED
OCT 1 8 196

PLAN OF
JAFFRAY TWP.

M-1992

KENORA MINING DIVISION.
DISTRICT OF KENORA.

Scale, 40 chains to an inch.

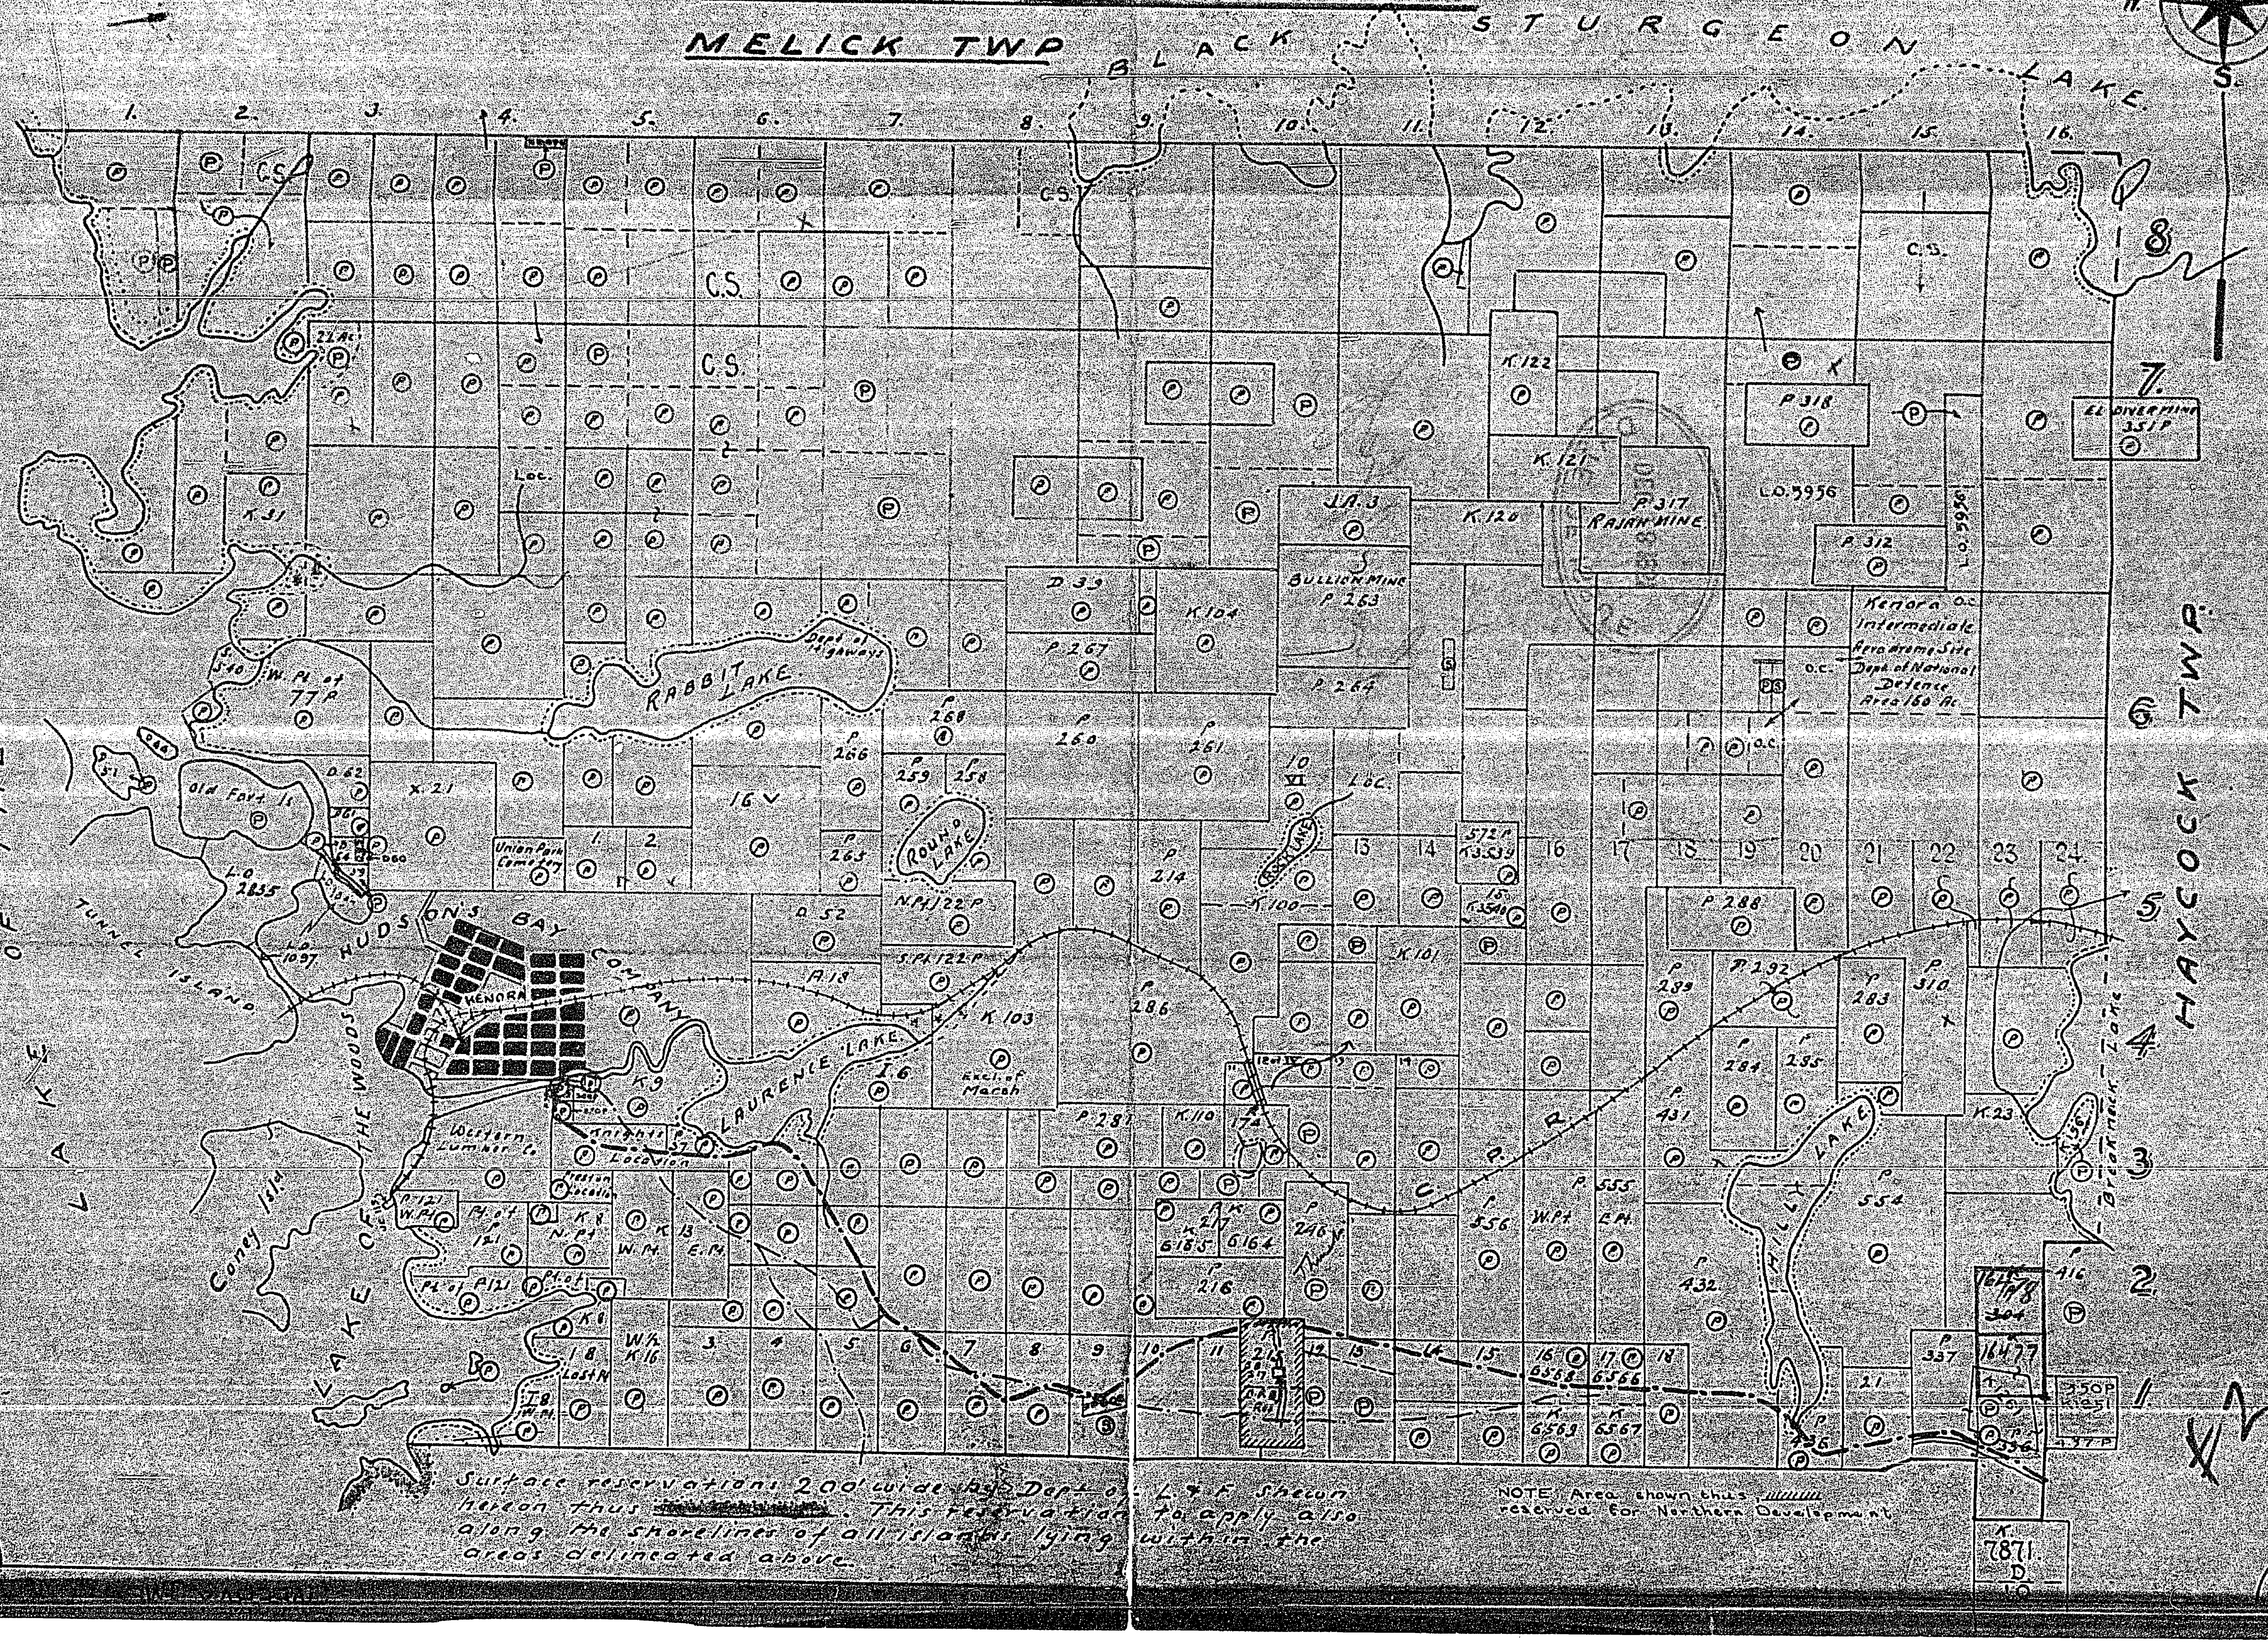

MELICK TWP
BLACK STURGEON LAKE
HAYCOCK TWP
LAKE OF THE WOODS
TUNNEL ISLAND
Coney Isld
HUDSONS BAY COMPANY
KENORA
RABBIT LAKE
Dept of Highways
ROUND LAKE
LAURENCE LAKE
HILLY LAKE
C.P.R.
Old Fort
W.H. of 77 P
Union Park Cemetery
Western Lumber Co.
Knights Location
Preston Location
BULLION MINE P 263
RAJAH MINE P 317
EL DIVER MINE 351 P
Kenora O.C. Intermediate Aero Drome Site Dept of National Defence Area 160 Ac.
L.O. 5956
L.O. 2855
L.O. 1097
K.31
K.21
K.120
K.121
K.122
K.104
K.101
K.103
K.100
K.110
K.23
K.7871 D
D 39
D 52
P 267
P 264
P 266
P 268
P 259
P 258
P 260
P 261
P 263
P 214
P 286
P 281
P 288
P 289
P 292
P 283
P 284
P 285
P 310
P 431
P 432
P 556
P 555
P 554
P 416
P 337
P 318
P 312
P 246
P 216
J.A.3
16.V
Loc.
C.S.
Breakneck Lake
N
W.
E.
S.
Ast. North
1. 2. 3. 4. 5. 6. 7. 8. 9. 10. 11. 12. 13. 14. 15. 16.
1 2 3 4 5 6 7 8

Surface reservations 200' wide by Dept of L & F shown hereon thus ______. This reservation to apply also along the shorelines of all islands lying within the areas delineated above.

NOTE: Area shown thus ////// reserved for Northern Development

JAFFRAY TWP.

KENORA MINING DIVISION.

DISTRICT OF KENORA.

Scale 40 chains to an inch.

FEB -2 1965

NOTE:

Area marked thus withdrawn from staking under section 39(d) of the Mg. Act.

Also gravel in the same area, reserved from disposition.

[illegible]

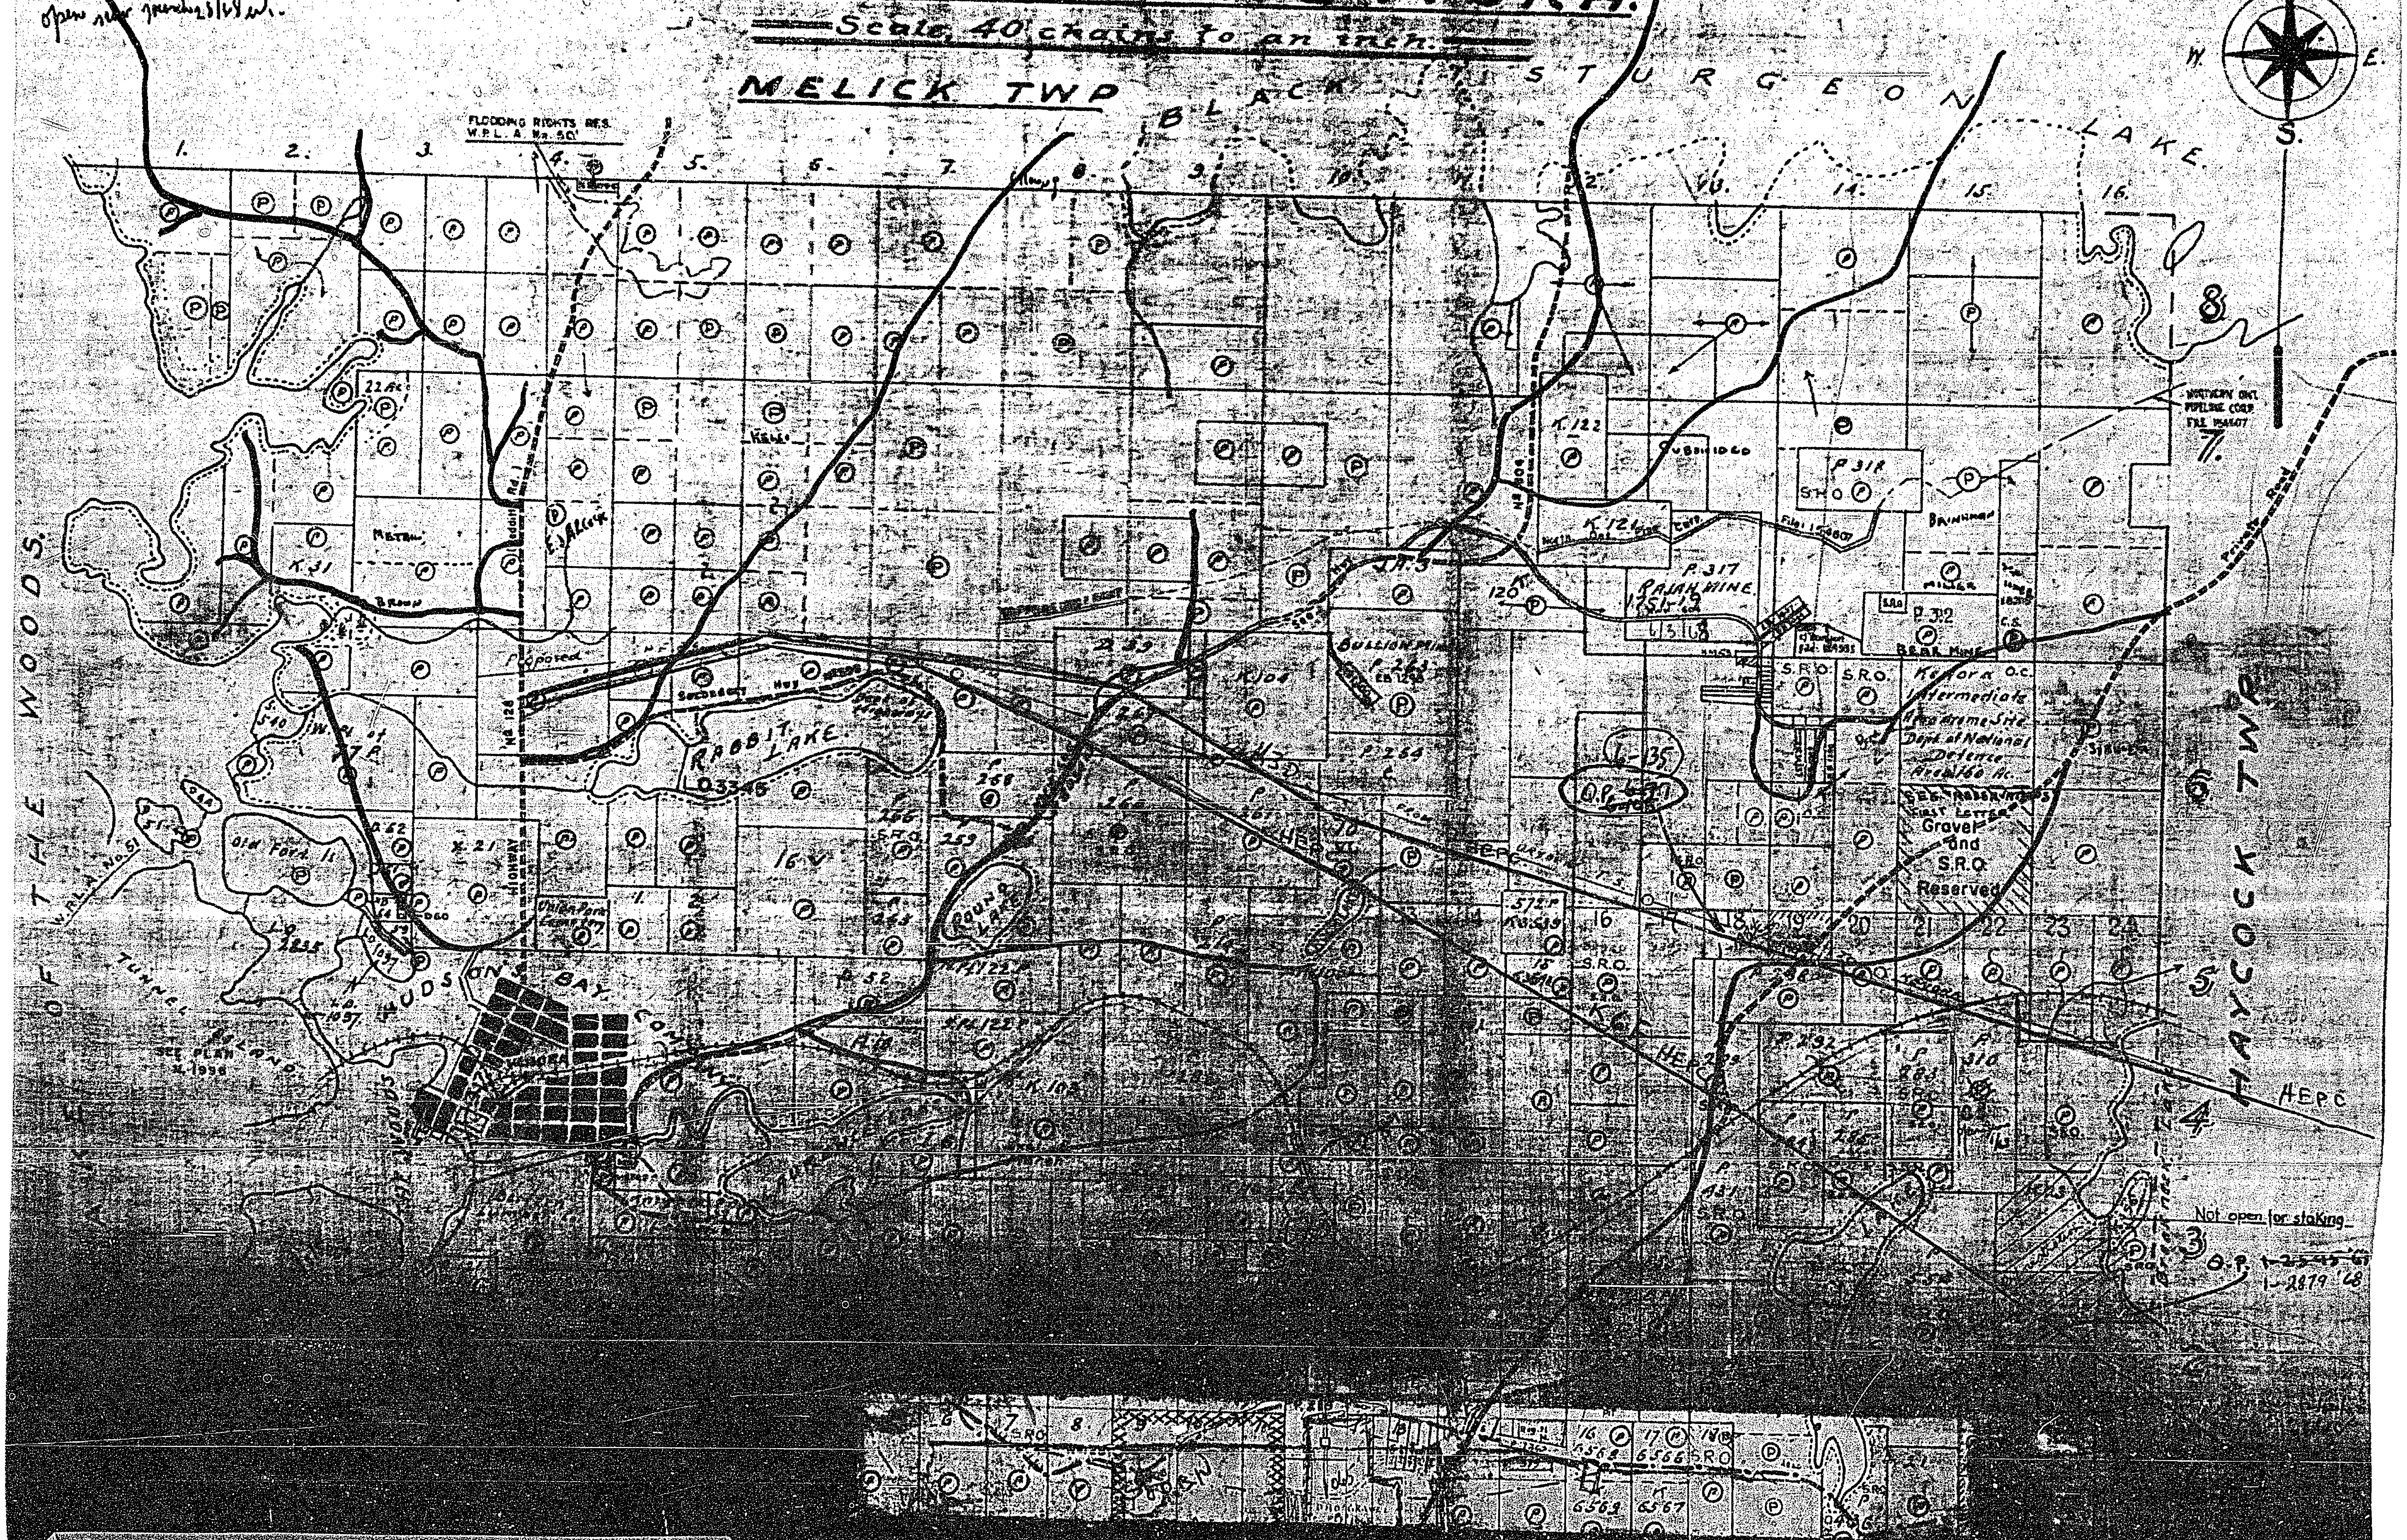
MELICK TWP
BLACK STURGEON LAKE
FLOODING RIGHTS RES. W.P.L.A. No. 50
1.
2.
3.
4.
5.
6.
7.
8.
9.
10.
12.
13.
14.
15.
16.
Air North
W.
E.
S.
NORTHERN ONT. PIPELINE CORP.
8
7.
6
5
4
3
HAYCOCK TWP
OF THE WOODS
RABBIT LAKE
HUDSONS BAY COMPANY
RAJAH MINE
BULLION MINE
BEAR MINE
Kenora O.C. Intermediate Aerodrome Site Dept of National Defence
Gravel and S.R.O. Reserved
16
18
19
20
21
22
23
24
HEPC
Private Road
Proposed
Secondary Hwy
K.31
K.21
P.317
P.318
P.312
S.R.O.
Not open for staking
O.P. 1-2879 '68

S.½ Lot 15, Con. 6 Reforestation SRO withdrawn from staking Sec. 39 (d) No QP 7/18/55 RES. -A-

337P and part of 304P L & F Reservation removed.
See Res. J. 12/10/63

Gravel and staking reservation on Lots 9, 10, 11, Con. 1 - Reservation continued until Jan. 1/63.
See RES. J. 7/23/62 (121394

JAFFRAY 1992

PLAN OF
JAFFRAY TWP.

#M-1992

KENORA MINING DIVISION.
DISTRICT OF KENORA.

Scale, 40 chains to an inch.

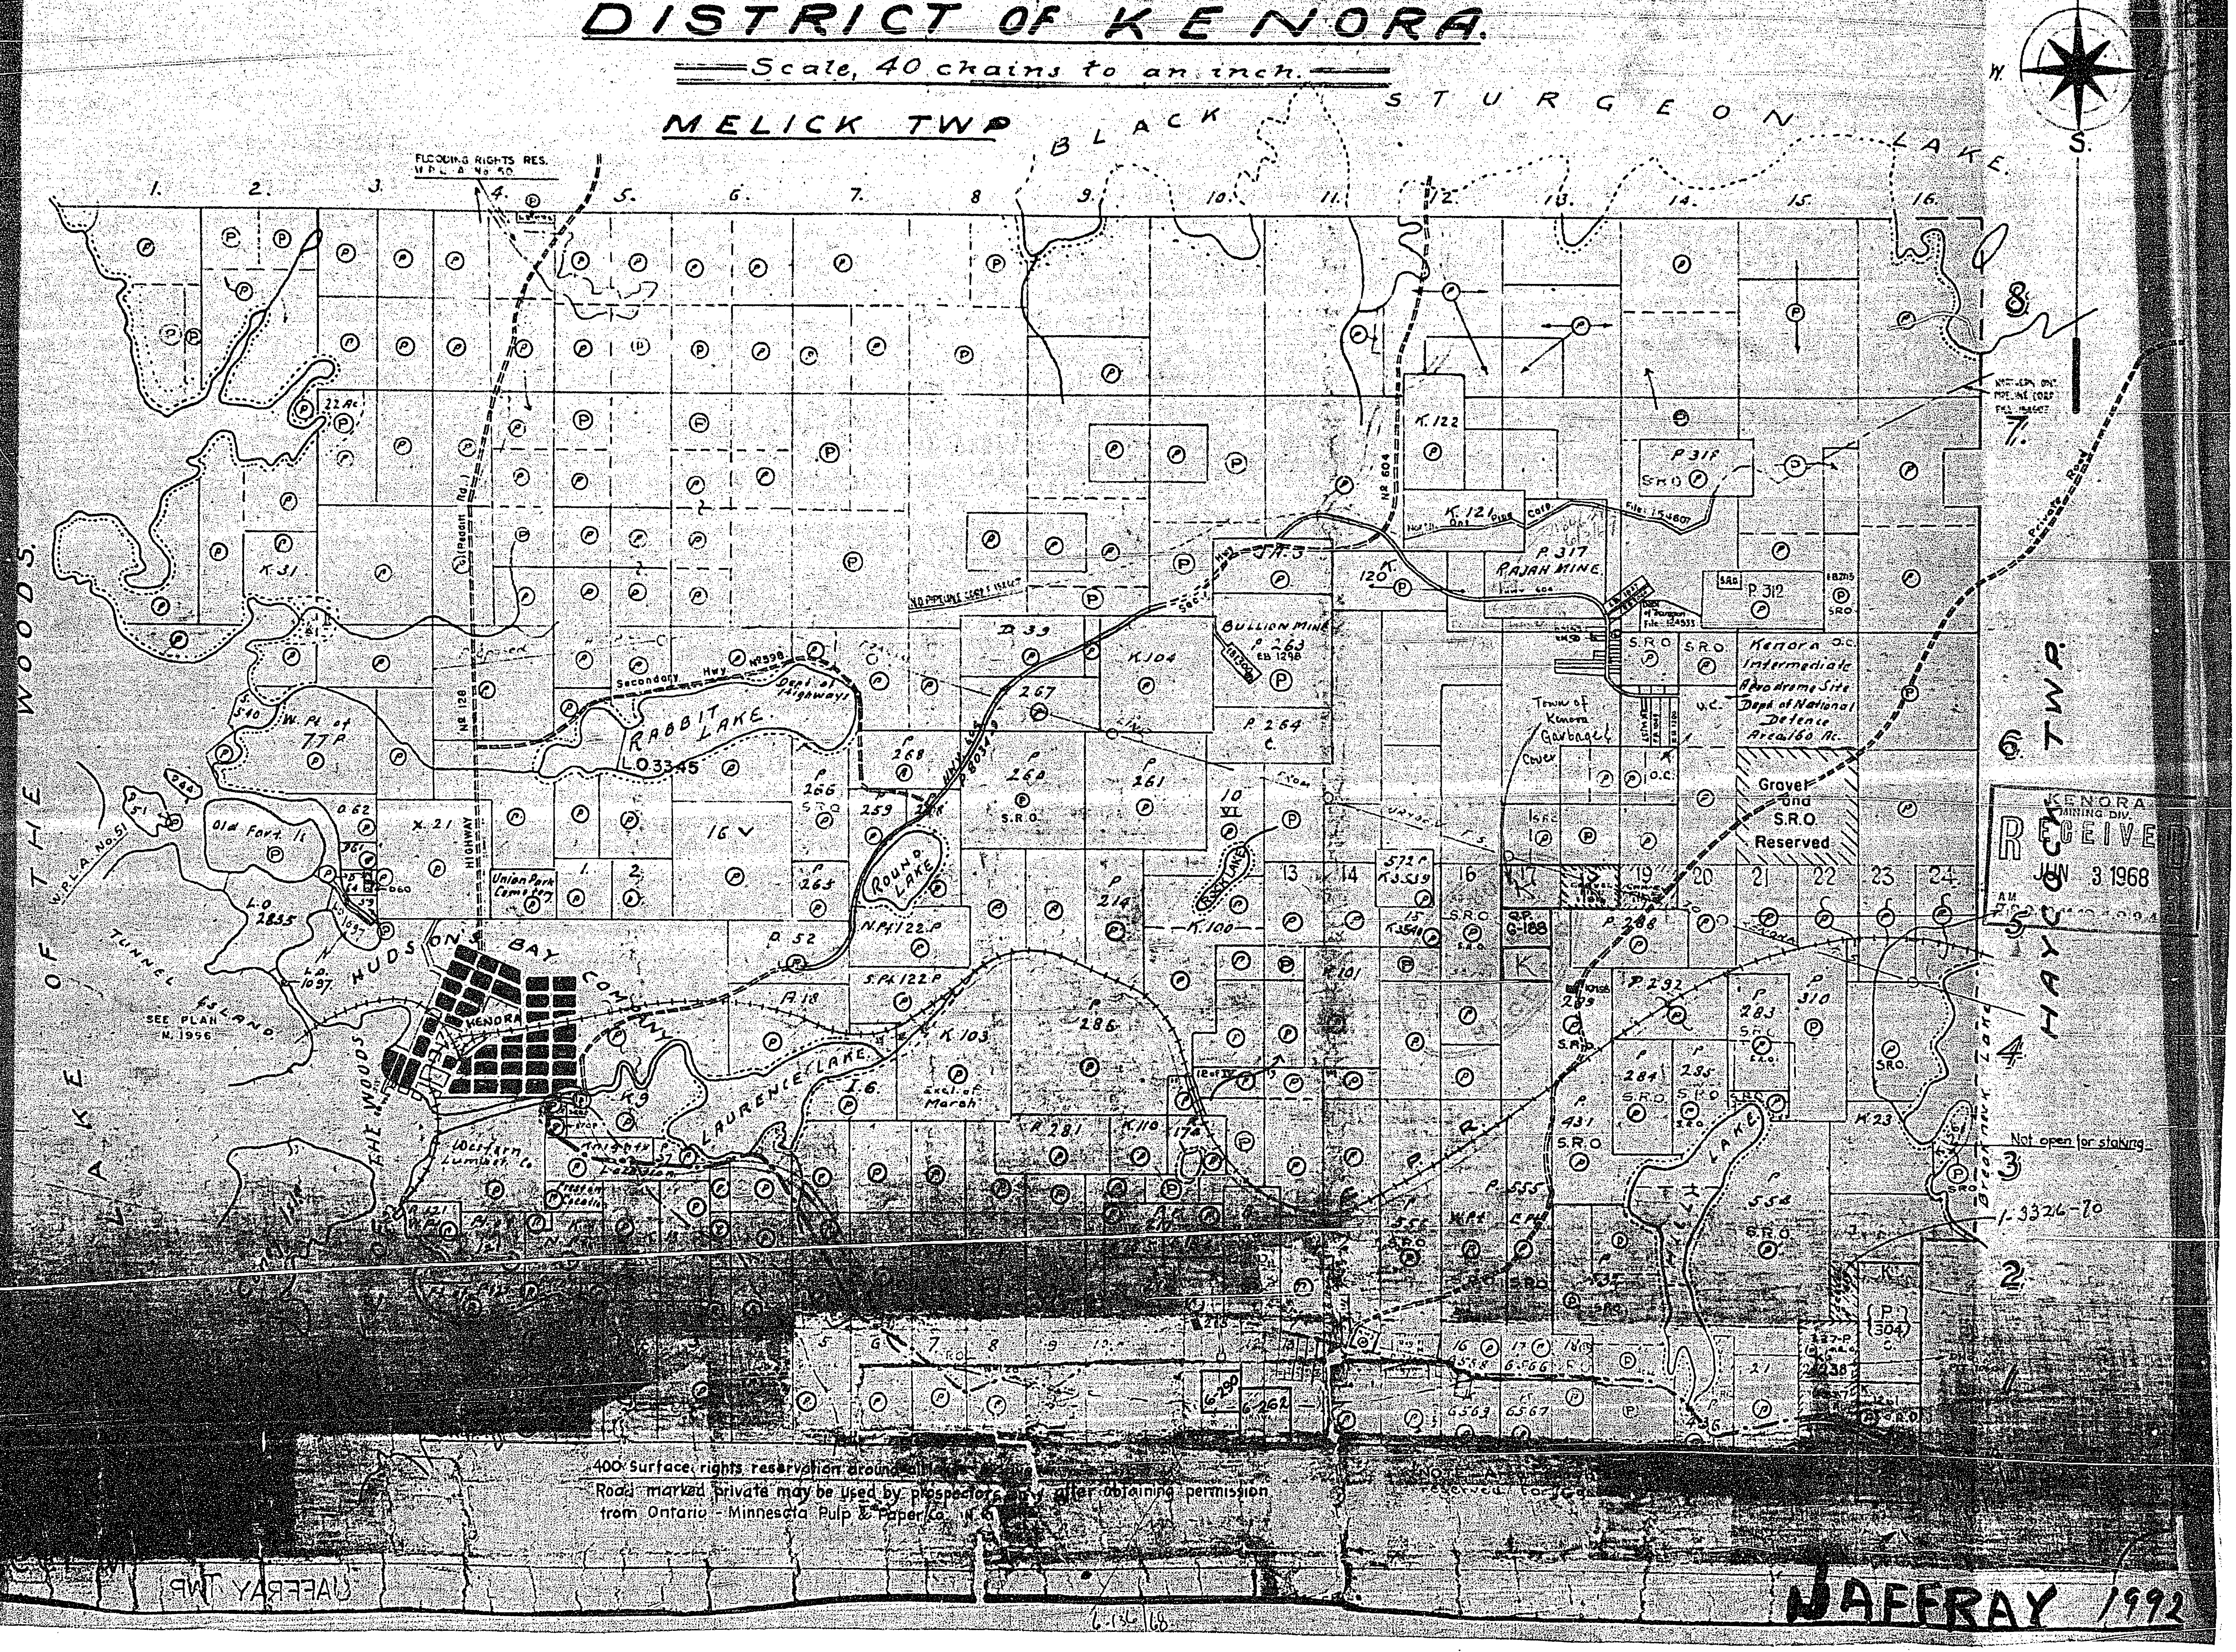

MELICK TWP
BLACK STURGEON LAKE
Ast. North
W.
S.
FLOODING RIGHTS RES. W.P.L.A. No. 50
1. 2. 3. 4. 5. 6. 7. 8. 9. 10. 11. 12. 13. 14. 15. 16.
8 7 6 5 4 3 2
LAKE OF THE WOODS
W.P.L.A. No. 51
TUNNEL ISLAND
SEE PLAN M. 1996
Old Fort Is.
L.O. 2855
HUDSONS BAY COMPANY
KENORA
Western Lumber Co.
RABBIT LAKE
L.O. 3345
Secondary Hwy. No. 598
Dept. of Highways
HIGHWAY
NR 128
Union Park Cemetery
ROUND LAKE
LAURENCE LAKE
Excl. of Marsh
K. 31
K. 103
K. 104
K. 110
K. 122
K. 121
K. 100
K. 23
BULLION MINE P. 263
RAJAH MINE P. 317
P. 318 S.R.O.
P. 312
P. 264
P. 292
P. 283 S.R.O.
P. 284 S.R.O.
P. 285 S.R.O.
P. 310
P. 431 S.R.O.
P. 552 S.R.O.
P. 555
P. 304
S.R.O.
Town of Kenora Garbage Cover
Kenora Intermediate Aerodrome Site Dept. of National Defence Area 160 Ac.
Grovel and S.R.O. Reserved
Northern Ont. Pipe Line Corp.
NO PIPELINE SEC. 1 ISSUED
Private Road
HAYCOCK TWP.
Not open for staking
1. 3326-70
Brechin Lake
TRAIL LAKE
13 14 15 16 17 18 19 20 21 22 23 24
5 6 7 8 9 10
6-280 6-262 6-563 6-567 6-566

KENORA MINING DIV.
RECEIVED
JUN 3 1968

400' Surface rights reservation around all lakes [illegible]
Road marked private may be used by prospectors only after obtaining permission from Ontario - Minnesota Pulp & Paper Co. N.G.

6.136 68

JAFFRAY TWP

JAFFRAY 1992

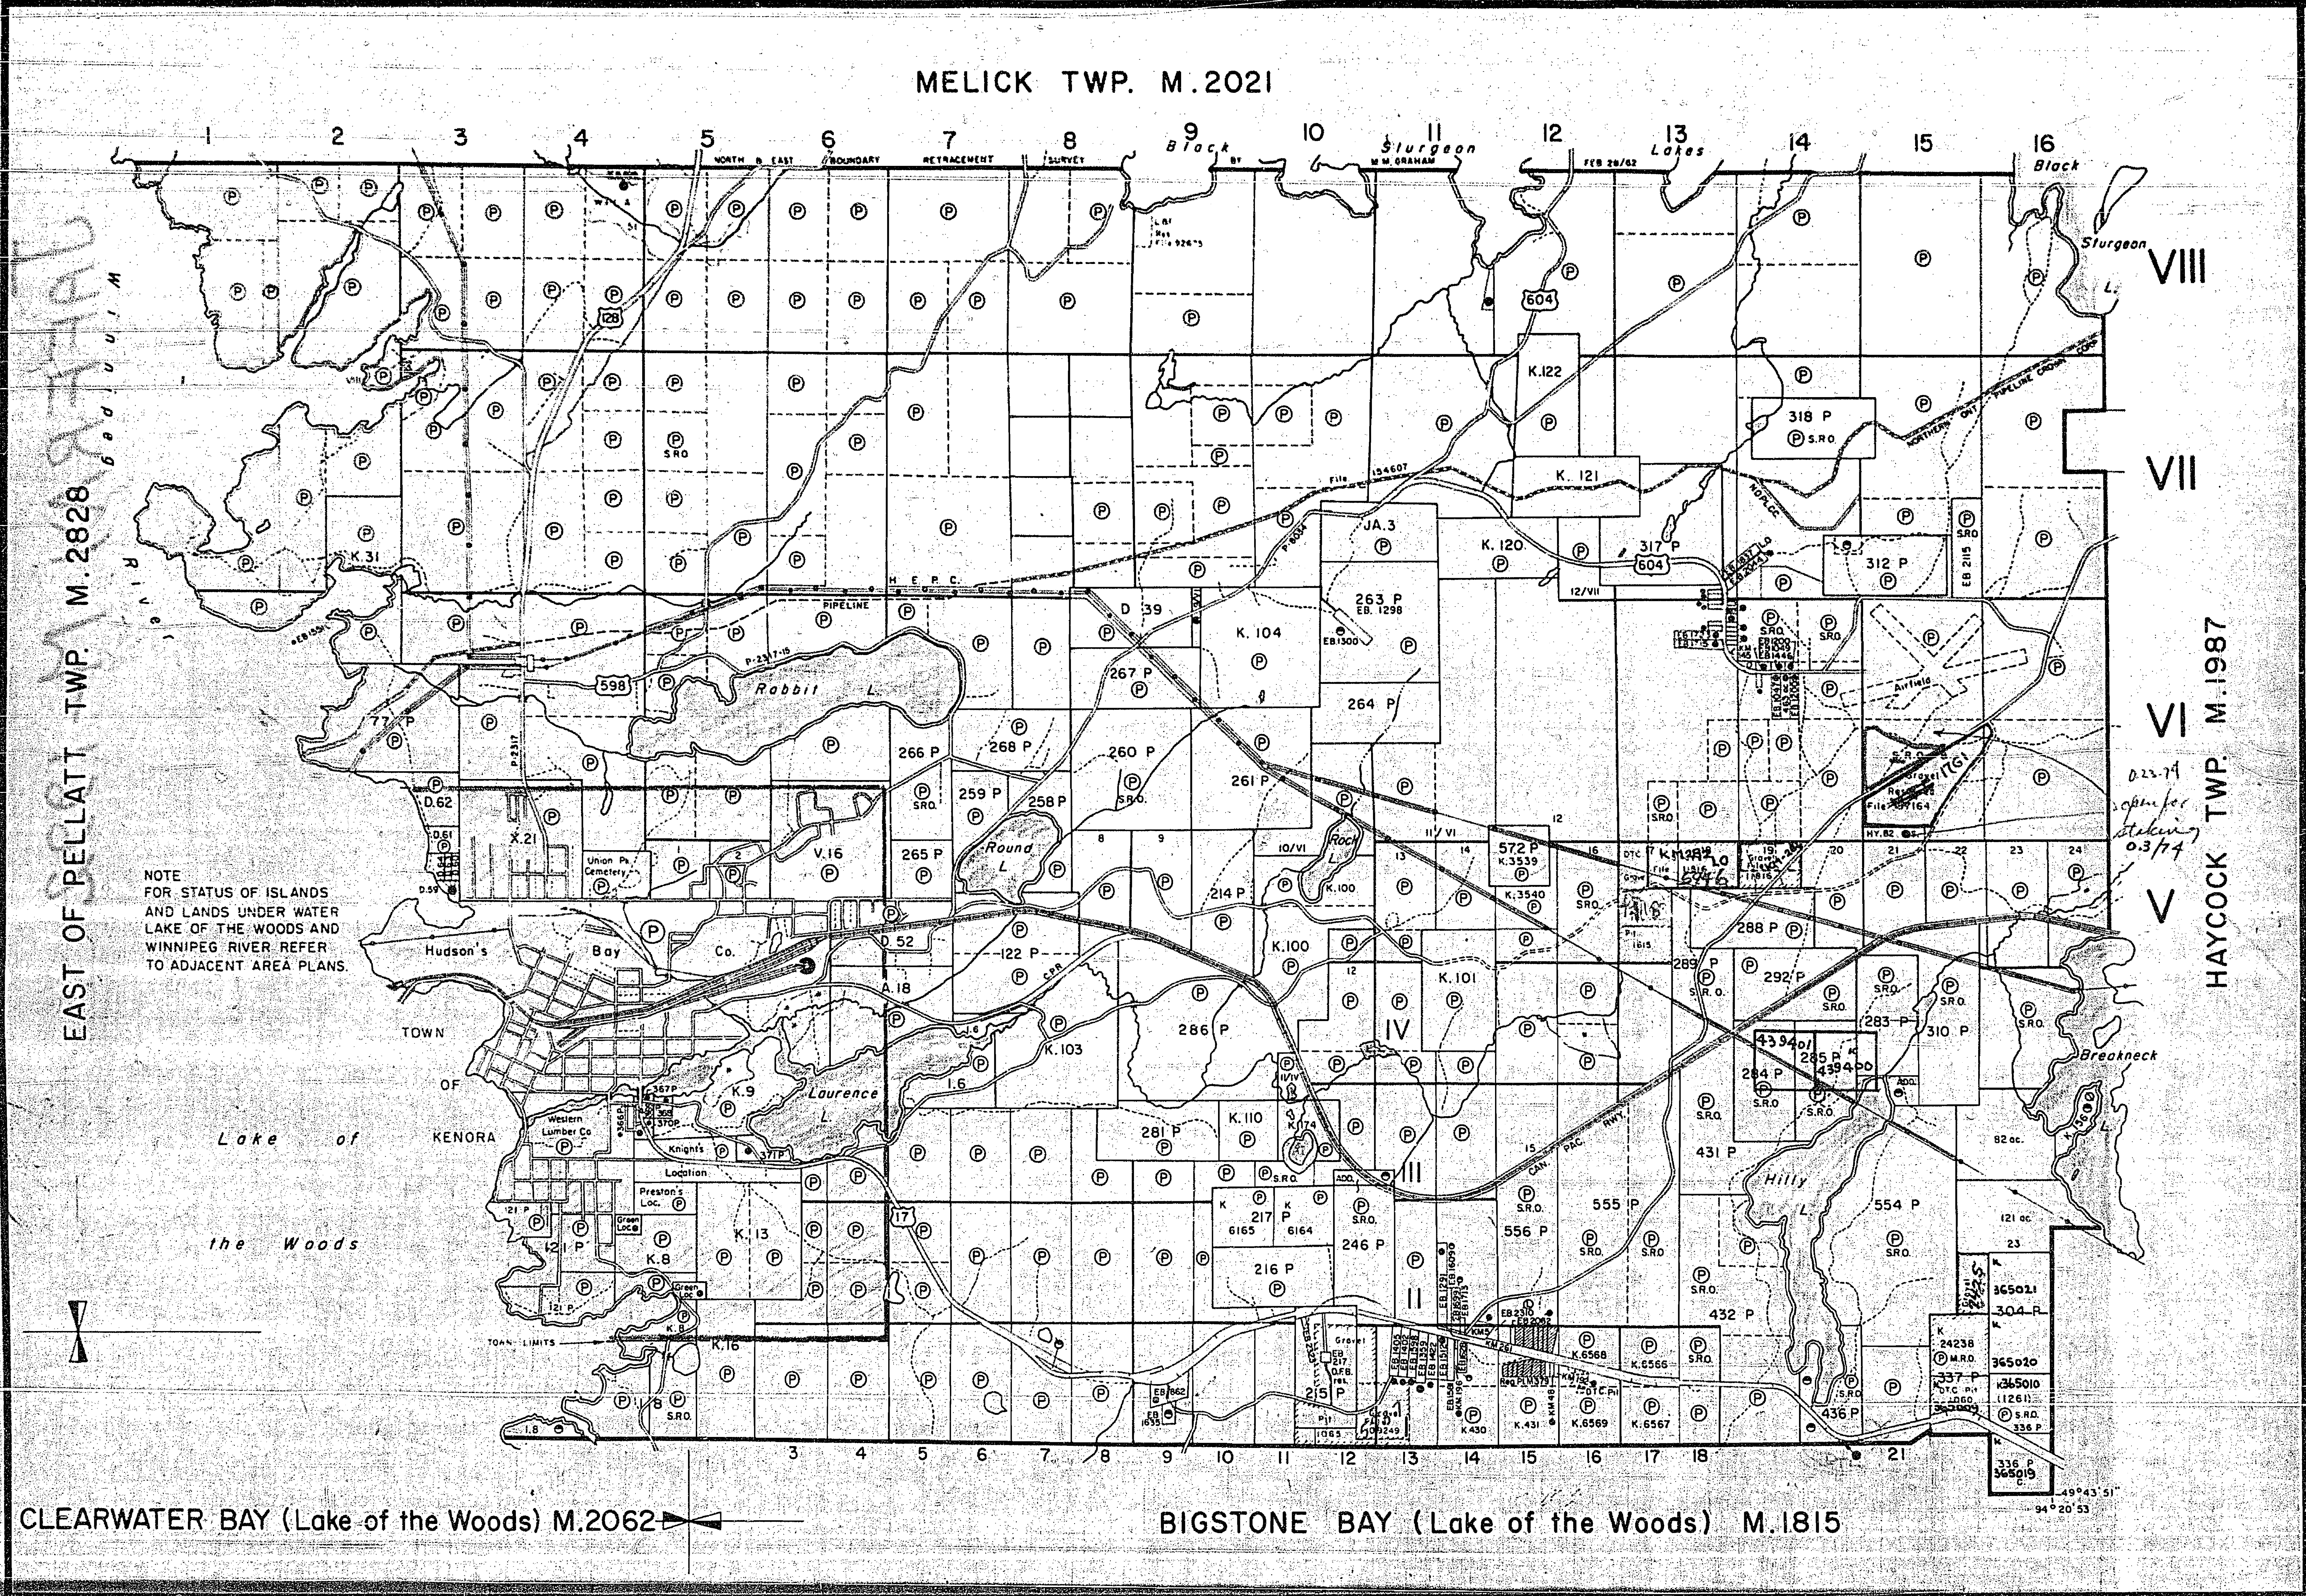
MELICK TWP. M.2021
1
2
3
4
5
6
7
8
9
10
11
12
13
14
15
16
NORTH & EAST BOUNDARY RETRACEMENT SURVEY
Black Sturgeon Lakes
Black
Sturgeon L.
VIII
VII
VI
V
IV
III
II
EAST OF PELLATT TWP. M.2828
HAYCOCK TWP. M.1987
Winnipeg River
Robbit L.
Round L.
Rock L.
Laurence L.
Hilly L.
Breakneck
Hudson's Bay Co.
TOWN OF KENORA
Lake of the Woods
Union Pr. Cemetery
Western Lumber Co.
Knight's Location
Preston's Loc.
Green Loc.
TOWN LIMITS
H.E.P.C. PIPELINE
NORTHERN ONT. PIPELINE CROWN CORP.
CAN. PAC. RWY.
C.P.R.
Airfield
604
598
17
128
K.122
K.121
K.120
K.104
K.100
K.101
K.103
K.110
K.9
K.13
K.8
K.16
K.31
JA.3
D 39
D.62
D 52
X.21
V.16
A.18
318 P
317 P
312 P
263 P
264 P
267 P
266 P
268 P
260 P
261 P
259 P
258 P
265 P
214 P
572 P
288 P
289 P
292 P
283 P
310 P
284 P
285 P
286 P
281 P
217 P
216 P
246 P
555 P
556 P
431 P
432 P
554 P
436 P
337 P
215 P
122 P
121 P
77 P
P
S.R.O.
M.R.O.
CLEARWATER BAY (Lake of the Woods) M.2062
BIGSTONE BAY (Lake of the Woods) M.1815
49°43'51"
94°20'53"

NOTE
FOR STATUS OF ISLANDS
AND LANDS UNDER WATER
LAKE OF THE WOODS AND
WINNIPEG RIVER REFER
TO ADJACENT AREA PLANS.

0.23-74
open for
staking
0.3/74

NOTES

400' surface rights reservation along the shores of all lakes and rivers.

Flooding rights reserved on Winnipeg River and Alcock Lake to contour elev. 1051.20' GSC.
Jan. 23/40. File 4922 vol. 5

H.E.P.C. flooding rights on Winnipeg River and Alcock Lake to contour elev. 1045' GSC.
W.P.L.A. 51 File 12999

KENORA
MINING DIV.
RECEIVED
AUG 16 1971
AM 7,8,9,10,11,12,1,2,3,4,5,6 PM

LEGEND

PATENTED LAND	Ⓟ or ●†
PATENTED FOR SURFACE RIGHTS ONLY	◓†
LEASE	Ⓛ
LICENSE OF OCCUPATION	L.O.
CROWN LAND SALES	C.S.
LOCATED LAND	Loc.
CANCELLED	C.
NOT THROWN OPEN FOR STAKING	⊘
MINING RIGHTS ONLY	M.R.O.
SURFACE RIGHTS ONLY	S.R.O.
HIGHWAY & ROUTE NO.	17
ROADS	═
TRAILS	----
RAILWAYS	┼┼┼
POWER LINES	—•—
MARSH OR MUSKEG	
MINES	⚒

† used only with summer resort locations or when space is limited

TOWNSHIP OF

JAFFRAY

Feb 19/74

DISTRICT OF
KENORA

#9

52 E/6

KENORA
MINING DIVISION

SCALE : 1 INCH = 40 CHAINS (1/2 MILE)

DR. D.T.	PLAN NO.	M.1992
DATE JULY/71		

ONTARIO
DEPARTMENT OF MINES
AND NORTHERN AFFAIRS

JAFFRAY

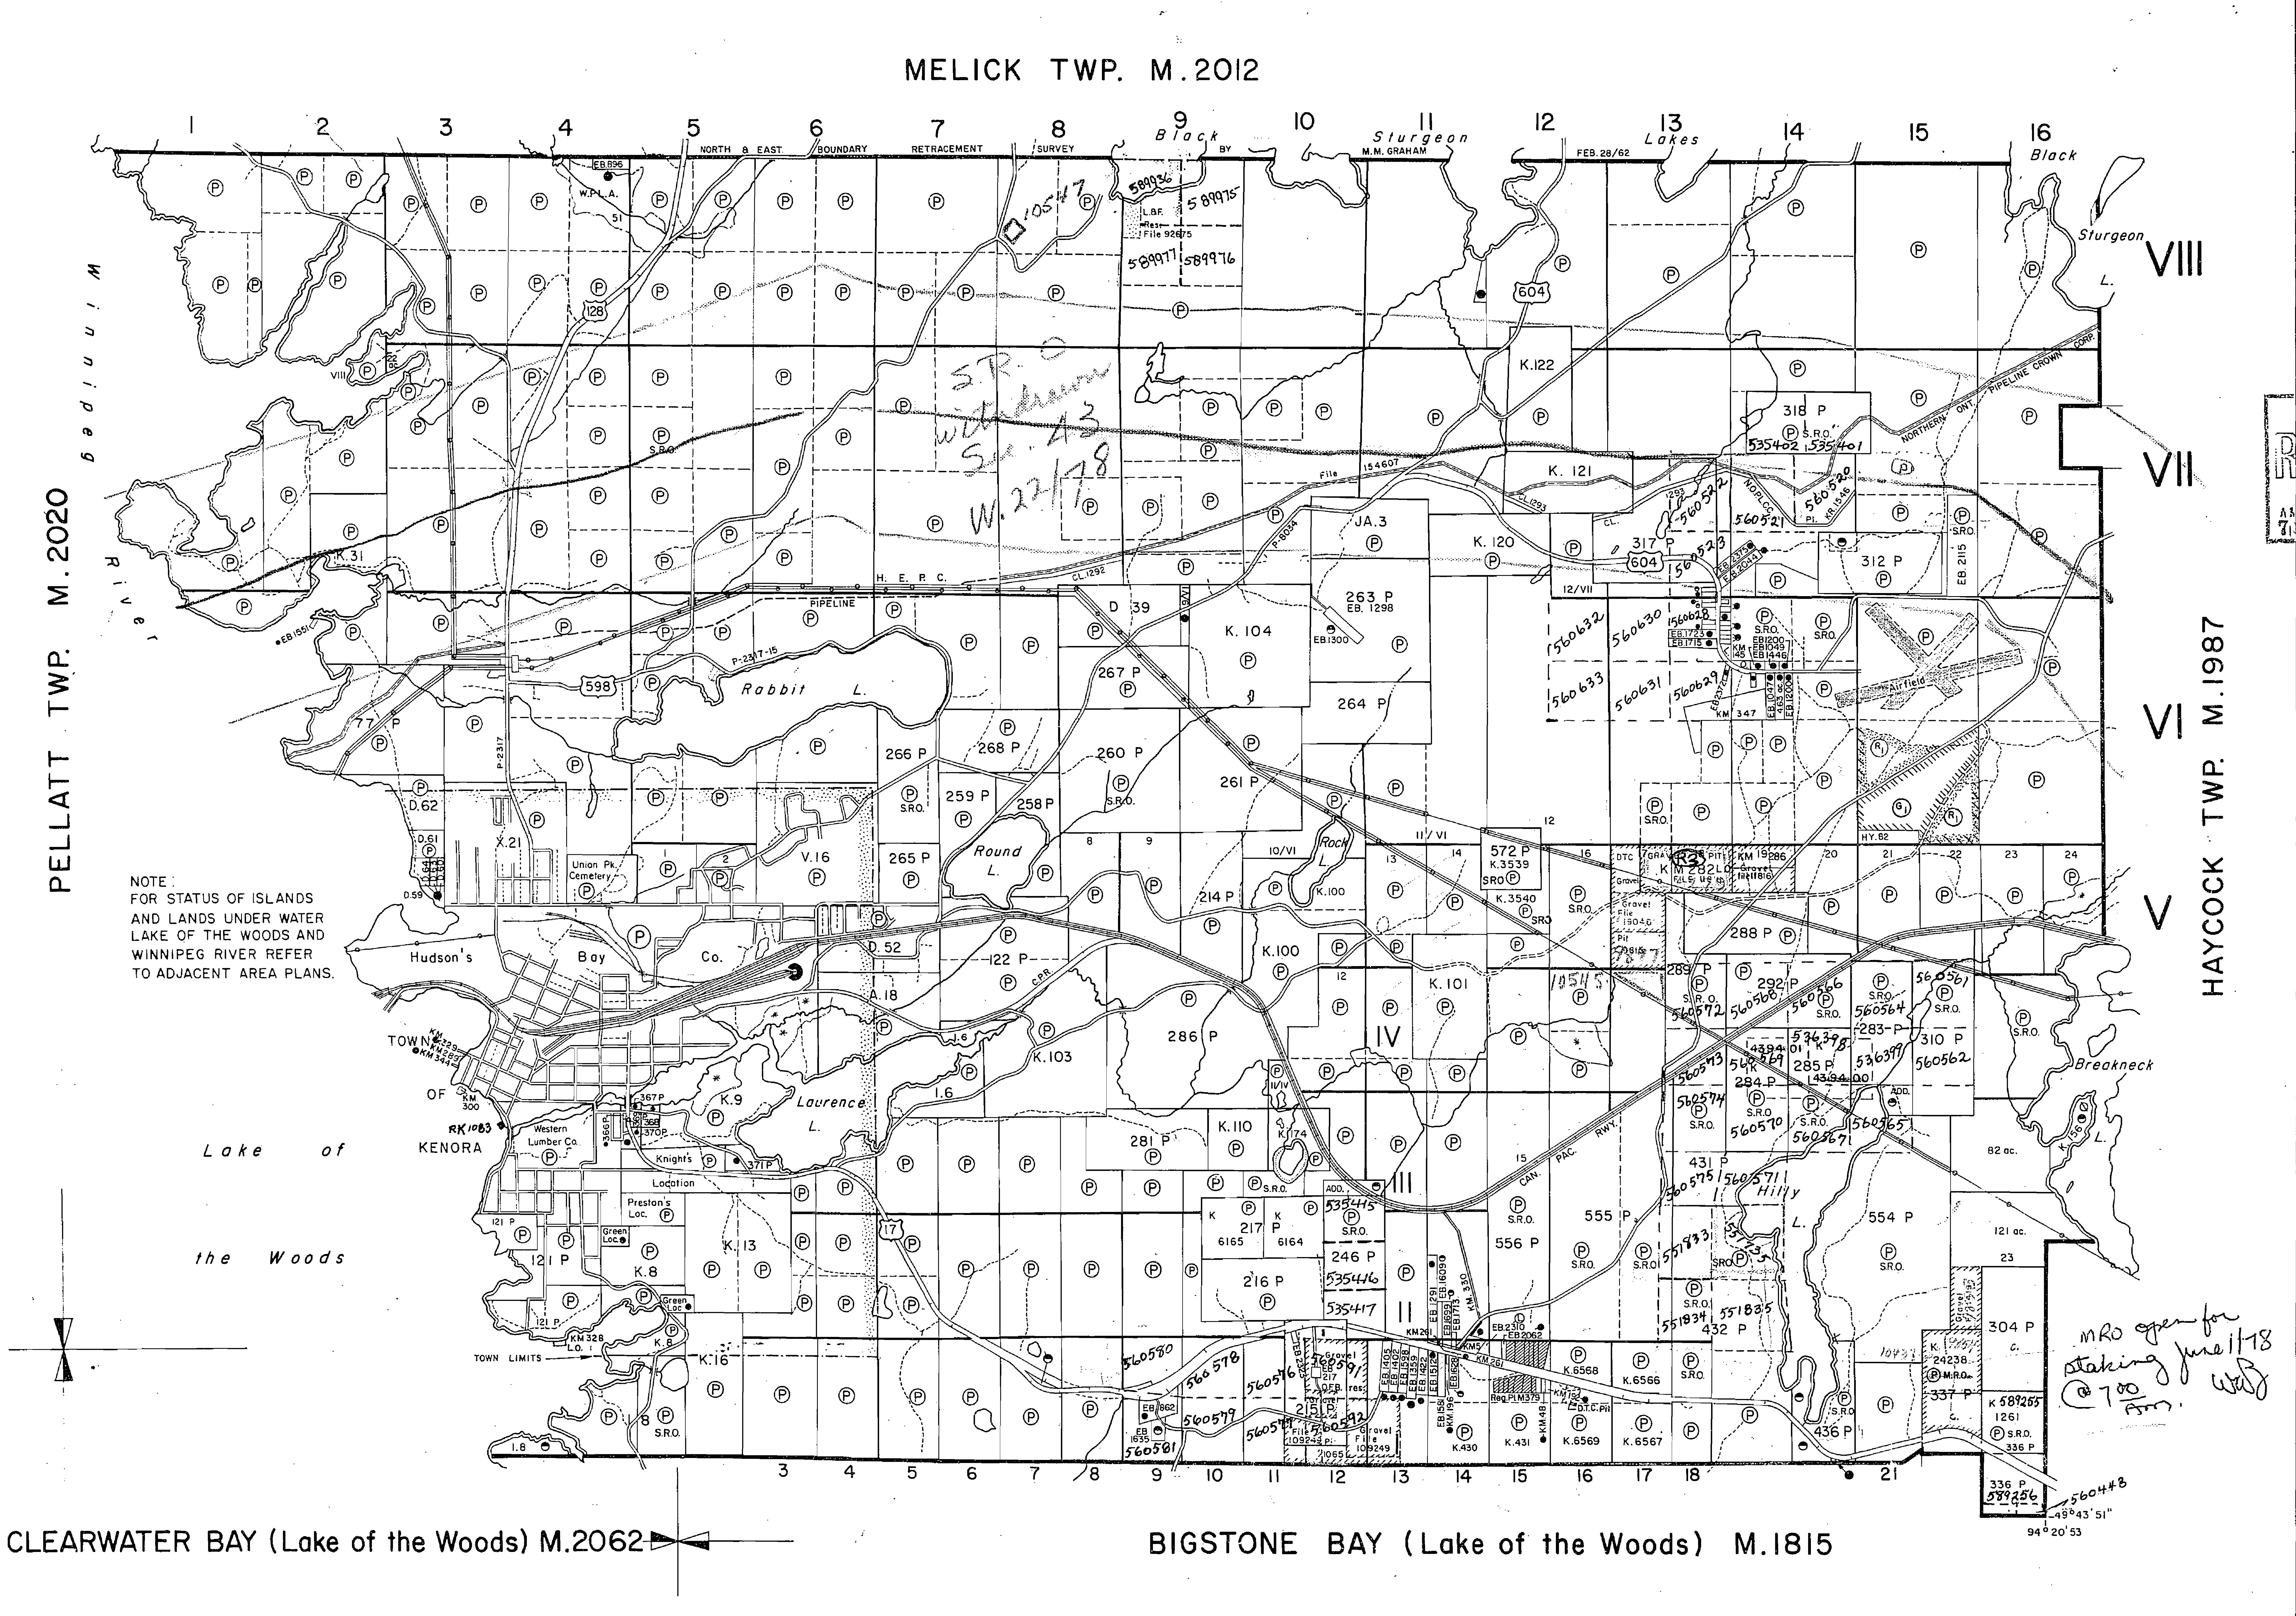
MELICK TWP. M.2012
PELLATT TWP. M.2020
HAYCOCK TWP. M.1987
CLEARWATER BAY (Lake of the Woods) M.2062
BIGSTONE BAY (Lake of the Woods) M.1815
Winnipeg River
Black Sturgeon Lakes
Sturgeon L.
Rabbit L.
Round L.
Rock L.
Laurence L.
Hilly L.
Breakneck L.
Lake of the Woods
Hudson's Bay Co.
TOWN OF KENORA
Western Lumber Co.
Union Pk. Cemetery
Knight's Location
Preston's Loc.
Airfield
NORTH & EAST BOUNDARY RETRACEMENT SURVEY BY M.M. GRAHAM FEB. 28/62
NORTHERN ONT. PIPELINE CROWN CORP.
H. E. P. C.
PIPELINE
CAN. PAC. RWY.
TOWN LIMITS
VIII
VII
VI
V
IV
III
II
1
2
3
4
5
6
7
8
9
10
11
12
13
14
15
16
94°20'53"
49°43'51"

NOTE:
FOR STATUS OF ISLANDS AND LANDS UNDER WATER LAKE OF THE WOODS AND WINNIPEG RIVER REFER TO ADJACENT AREA PLANS.

S.R.O. withdrawn Sr. 43 W.22/78

MRO open for staking June 1/78 @ 7⁰⁰ Am. WB

NOTES

400' surface rights reservation along the shores of all lakes and rivers.

Flooding rights reserved on Winnipeg River and Alcock Lake to contour elev. 1051.20' G.S.C. Jan. 23/40. File 4922 vol. 5

H.E.P.C. flooding rights on Winnipeg River and Alcock Lake to contour elev. 1045' G.S.C. W.P.L.A. 51 File 12999

(R1) S.R.O. RESERVED FOR REFORESTATION FILE: 97164.
(G1) M.T.C. Gravel Pit No. ID-5, File 97164
(R/3) S.R. & M.R. RESERVED W.01/81

June 30/77

KENORA MINING DIV.
RECEIVED
JUN 15 1977
AM 7 8 9 10 11 12 1 2 3 4 5 6 PM

DATE OF ISSUE
JUN 9 1977

LEGEND

PATENTED LAND	Ⓟ or ● †
PATENTED FOR SURFACE RIGHTS ONLY	◓ †
LEASE	Ⓛ
LICENSE OF OCCUPATION	L.O.
CROWN LAND SALES	C.S.
LOCATED LAND	Loc.
CANCELLED	C.
NOT THROWN OPEN FOR STAKING	⊘
MINING RIGHTS ONLY	M.R.O.
SURFACE RIGHTS ONLY	S.R.O.
HIGHWAY & ROUTE NO.	17
ROADS	═
TRAILS	----
RAILWAYS	┼┼┼
POWER LINES	─o─
MARSH OR MUSKEG	✱
MINES	⚒

† used only with summer resort locations or when space is limited.

TOWNSHIP OF

JAFFRAY

DISTRICT OF KENORA #11

KENORA MINING DIVISION

SCALE : 1 INCH = 40 CHAINS (1/2 MILE)

DR.	D.T.	PLAN NO.	M.1992
DATE	JULY/71		

ONTARIO
MINISTRY OF NATURAL RESOURCES
SURVEYS AND MAPPING BRANCH

JAFFRAY

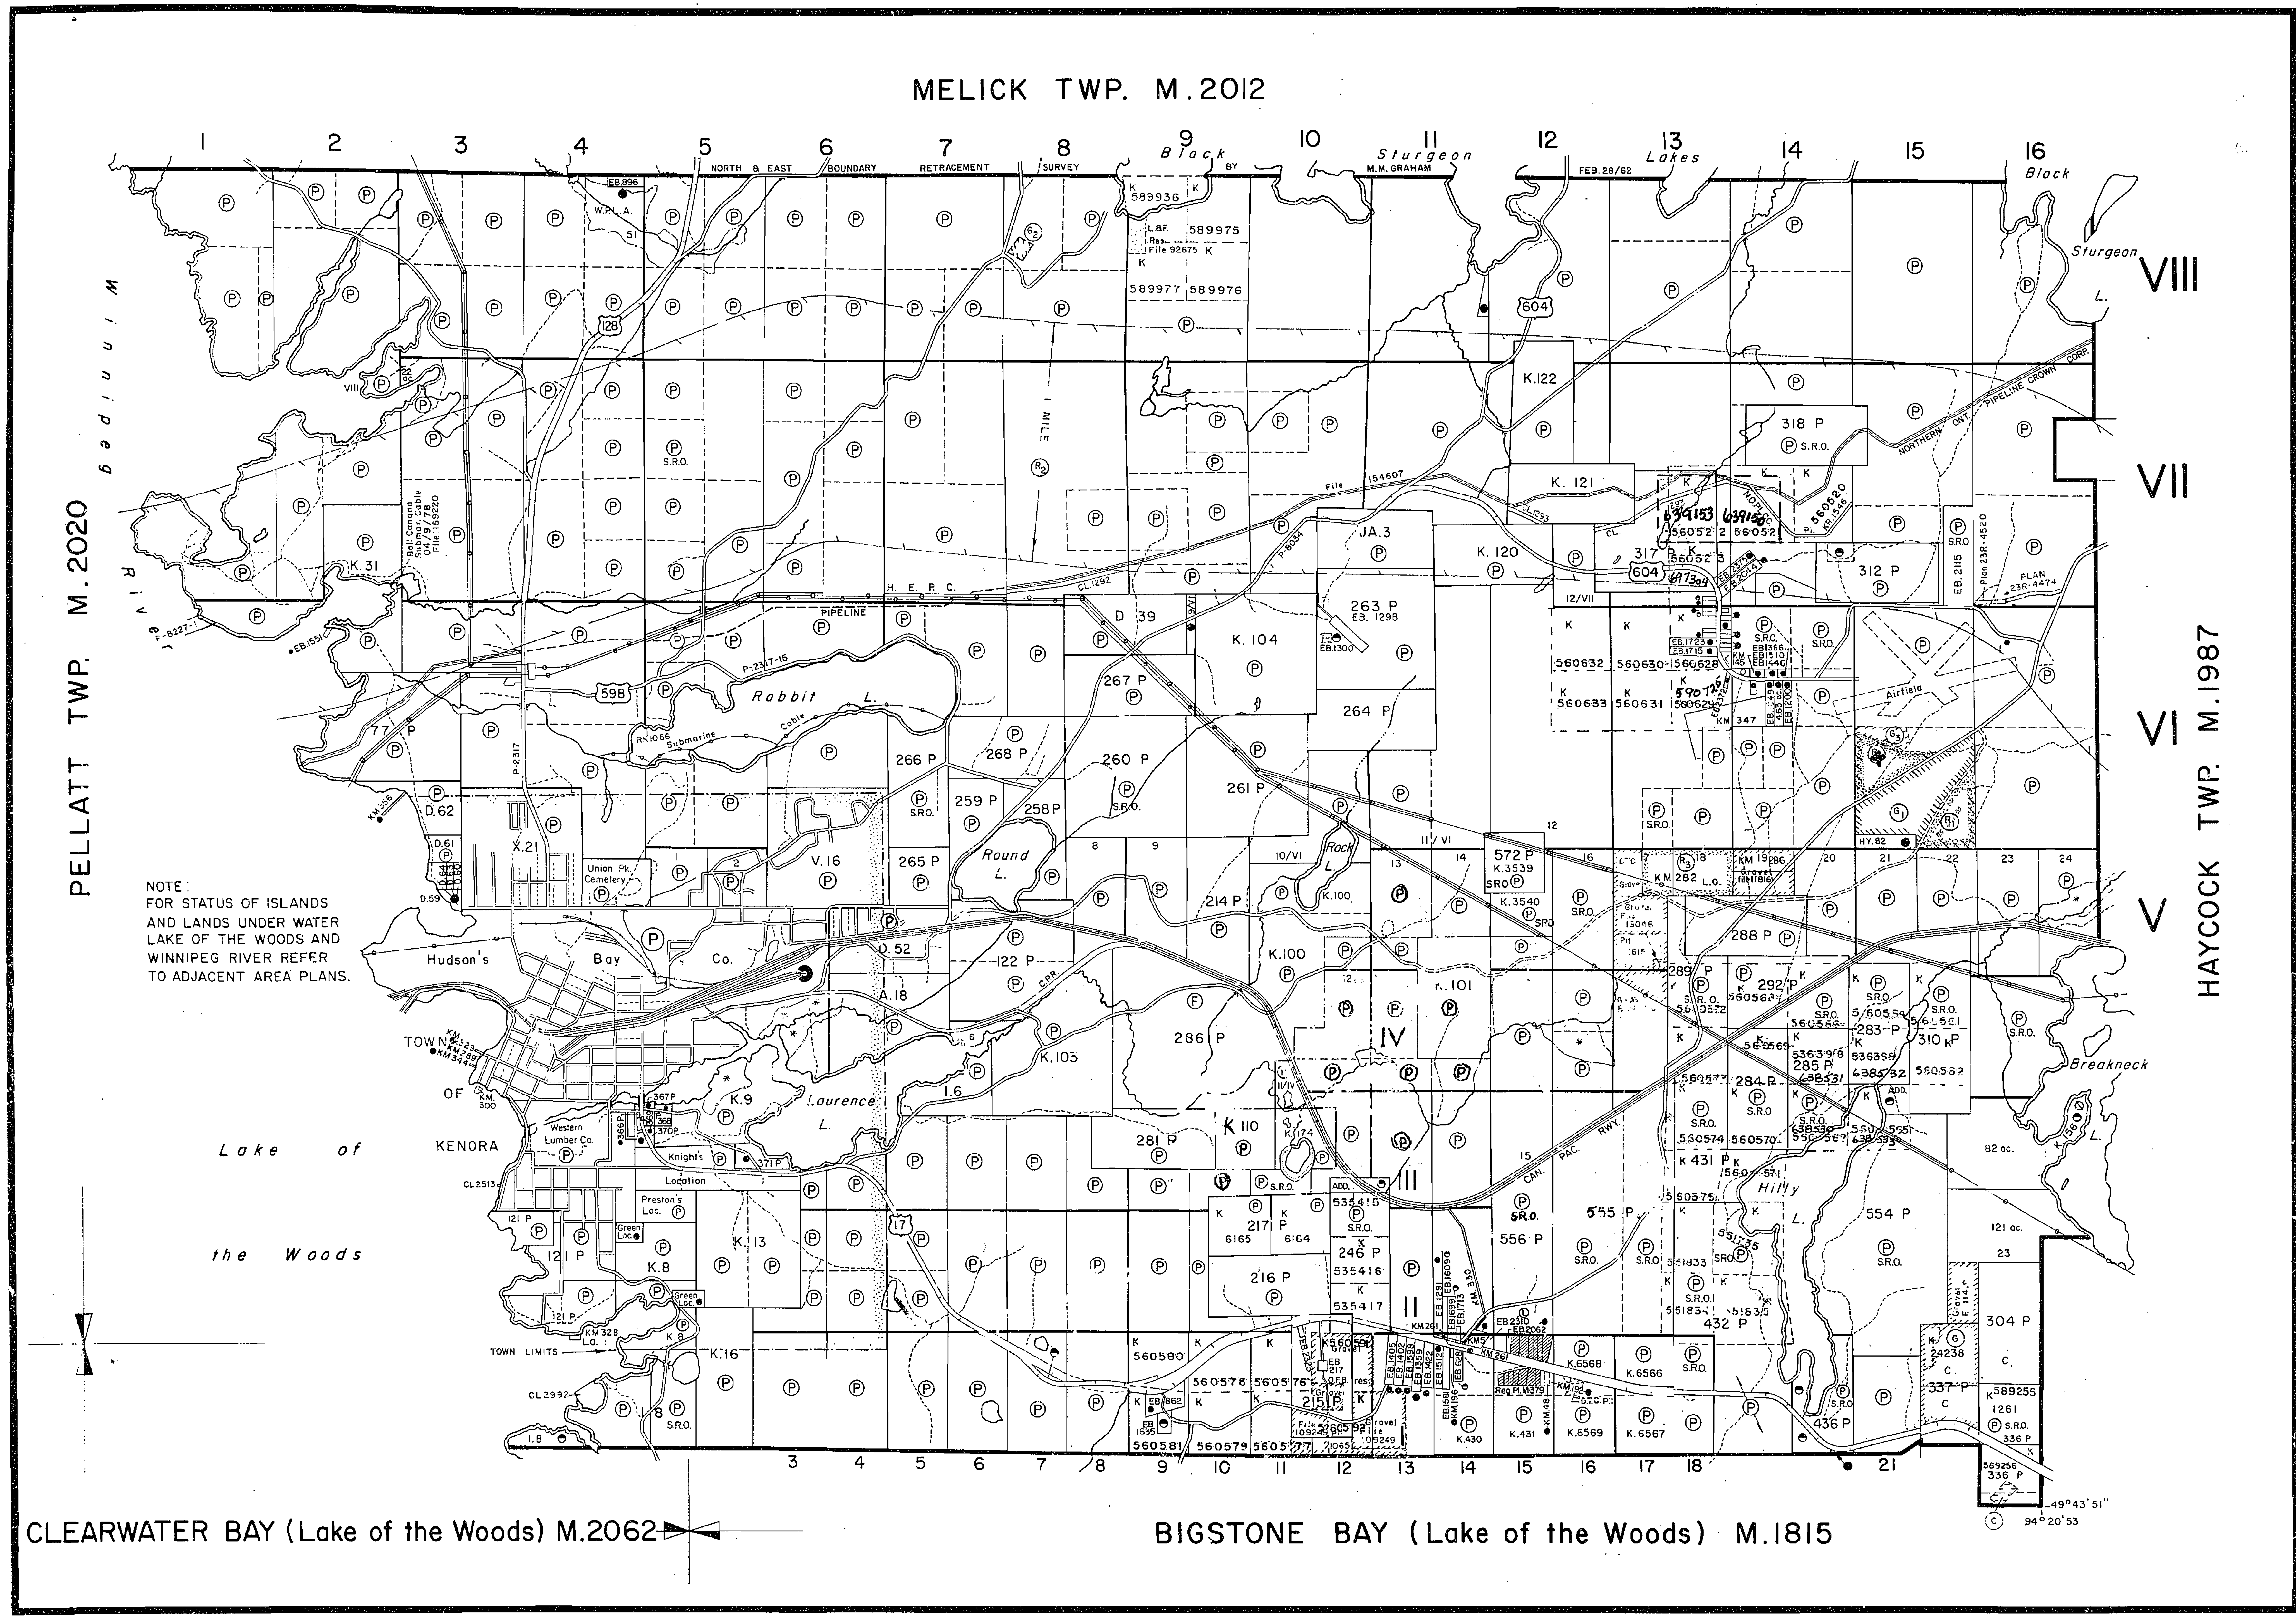
MELICK TWP. M.2012
PELLATT TWP. M.2020
HAYCOCK TWP. M.1987
CLEARWATER BAY (Lake of the Woods) M.2062
BIGSTONE BAY (Lake of the Woods) M.1815
1 2 3 4 5 6 7 8 9 10 11 12 13 14 15 16
VIII
VII
VI
V
IV
III
II
NORTH & EAST BOUNDARY RETRACEMENT SURVEY BLOCK BY M.M. GRAHAM FEB. 28/62
Sturgeon Lakes
Black Sturgeon L.
Winnipeg River
Rabbit L.
Round L.
Rock L.
Laurence L.
Hilly L.
Breakneck L.
Lake of the Woods
TOWN OF KENORA
Hudson's Bay Co.
Union Pk. Cemetery
Western Lumber Co.
Knight's Location
Preston's Loc.
TOWN LIMITS
H.E.P.C.
PIPELINE
NORTHERN ONT. PIPELINE CROWN CORP.
C.P.R.
CAN. PAC. RWY.
Airfield
Submarine Cable
1 MILE
598
604
128
17
K.122
K.121
K.120
K.104
JA.3
263 P
267 P
264 P
260 P
261 P
268 P
266 P
259 P
258 P
265 P
214 P
286 P
281 P
217 P
216 P
246 P
572 P
288 P
292 P
283 P
285 P
284 P
310 P
431 P
432 P
555 P
556 P
554 P
304 P
337 P
436 P
318 P
317 P
312 P
122 P
121 P
K.31
K.100
K.101
K.103
K.110
K.13
K.8
K.9
K.16
V.16
X.21
D.39
D.52
D.62
A.18
1.6
1.8
589936
589975
589977
589976
560632
560630
560633
560631
560580
560578
560581
560579
535415
535416
535417
K.6568
K.6566
K.6569
K.6567
K.430
K.431
589255
589256
49°43'51"
94°20'53"
82 ac.
121 ac.

NOTE:
FOR STATUS OF ISLANDS
AND LANDS UNDER WATER
LAKE OF THE WOODS AND
WINNIPEG RIVER REFER
TO ADJACENT AREA PLANS.

NOTES

400' surface rights reservation along the shores of all lakes and rivers.

Flooding rights reserved on Winnipeg River and Alcock Lake to contour elev. 1051.20' G.S.C. Jan.23/40. File 4922 vol.5

H.E.P.C. flooding rights on Winnipeg River and Alcock Lake to contour elev. 1045' G.S.C. W.P.L.A. 51 File 12999

SAND and GRAVEL

Ⓖ1 - M.T.C. Gravel Pit ID-5, File 97164
Ⓖ3 M.T.C. GRAVEL PIT ID-42
Ⓖ2 Gravel File 57027
Ⓖ QUARRY PERMIT

AREAS WITHDRAWN FROM STAKING

S.R. - SURFACE RIGHTS M.R. - MINING RIGHTS

	Section	Order No.	Date	Disposition	File
Ⓡ1	~~For Reforestation~~			~~S.R.~~	~~97164~~
Ⓡ2	43 (R.S.O. 1970)	W.22/78	11/5/78	S.R.	188521
Ⓡ3	43 (R.S.O. 1970)	W.1/81	22/1/81	S.R. & M.R.	11816
R4		W.25/83	5/04/83	S.R.	

LEGEND

PATENTED LAND	Ⓟ or ●†
PATENTED FOR SURFACE RIGHTS ONLY	◓†
LEASE	Ⓛ
LICENSE OF OCCUPATION	L.O.
CROWN LAND SALES	C.S.
LOCATED LAND	Loc.
CANCELLED	C.
NOT THROWN OPEN FOR STAKING	⊘
MINING RIGHTS ONLY	M.R.O.
SURFACE RIGHTS ONLY	S.R.O.
HIGHWAY & ROUTE NO.	═(17)═
ROADS	═══
TRAILS	- - - -
RAILWAYS	—+—+—+—
POWER LINES	—o— —o—
MARSH OR MUSKEG	* *
MINES	⚒

† used only with summer resort locations or when space is limited.

DATE OF ISSUE
OCT 20 1982
Ministry of Natural Resources
TORONTO

TOWNSHIP OF

JAFFRAY

DISTRICT OF
KENORA

#12

KENORA
MINING DIVISION

SCALE : 1 INCH = 40 CHAINS (1/2 MILE)

DR. D.T.
DATE JULY/71

PLAN NO. M.1992

ONTARIO
MINISTRY OF NATURAL RESOURCES
SURVEYS AND MAPPING BRANCH

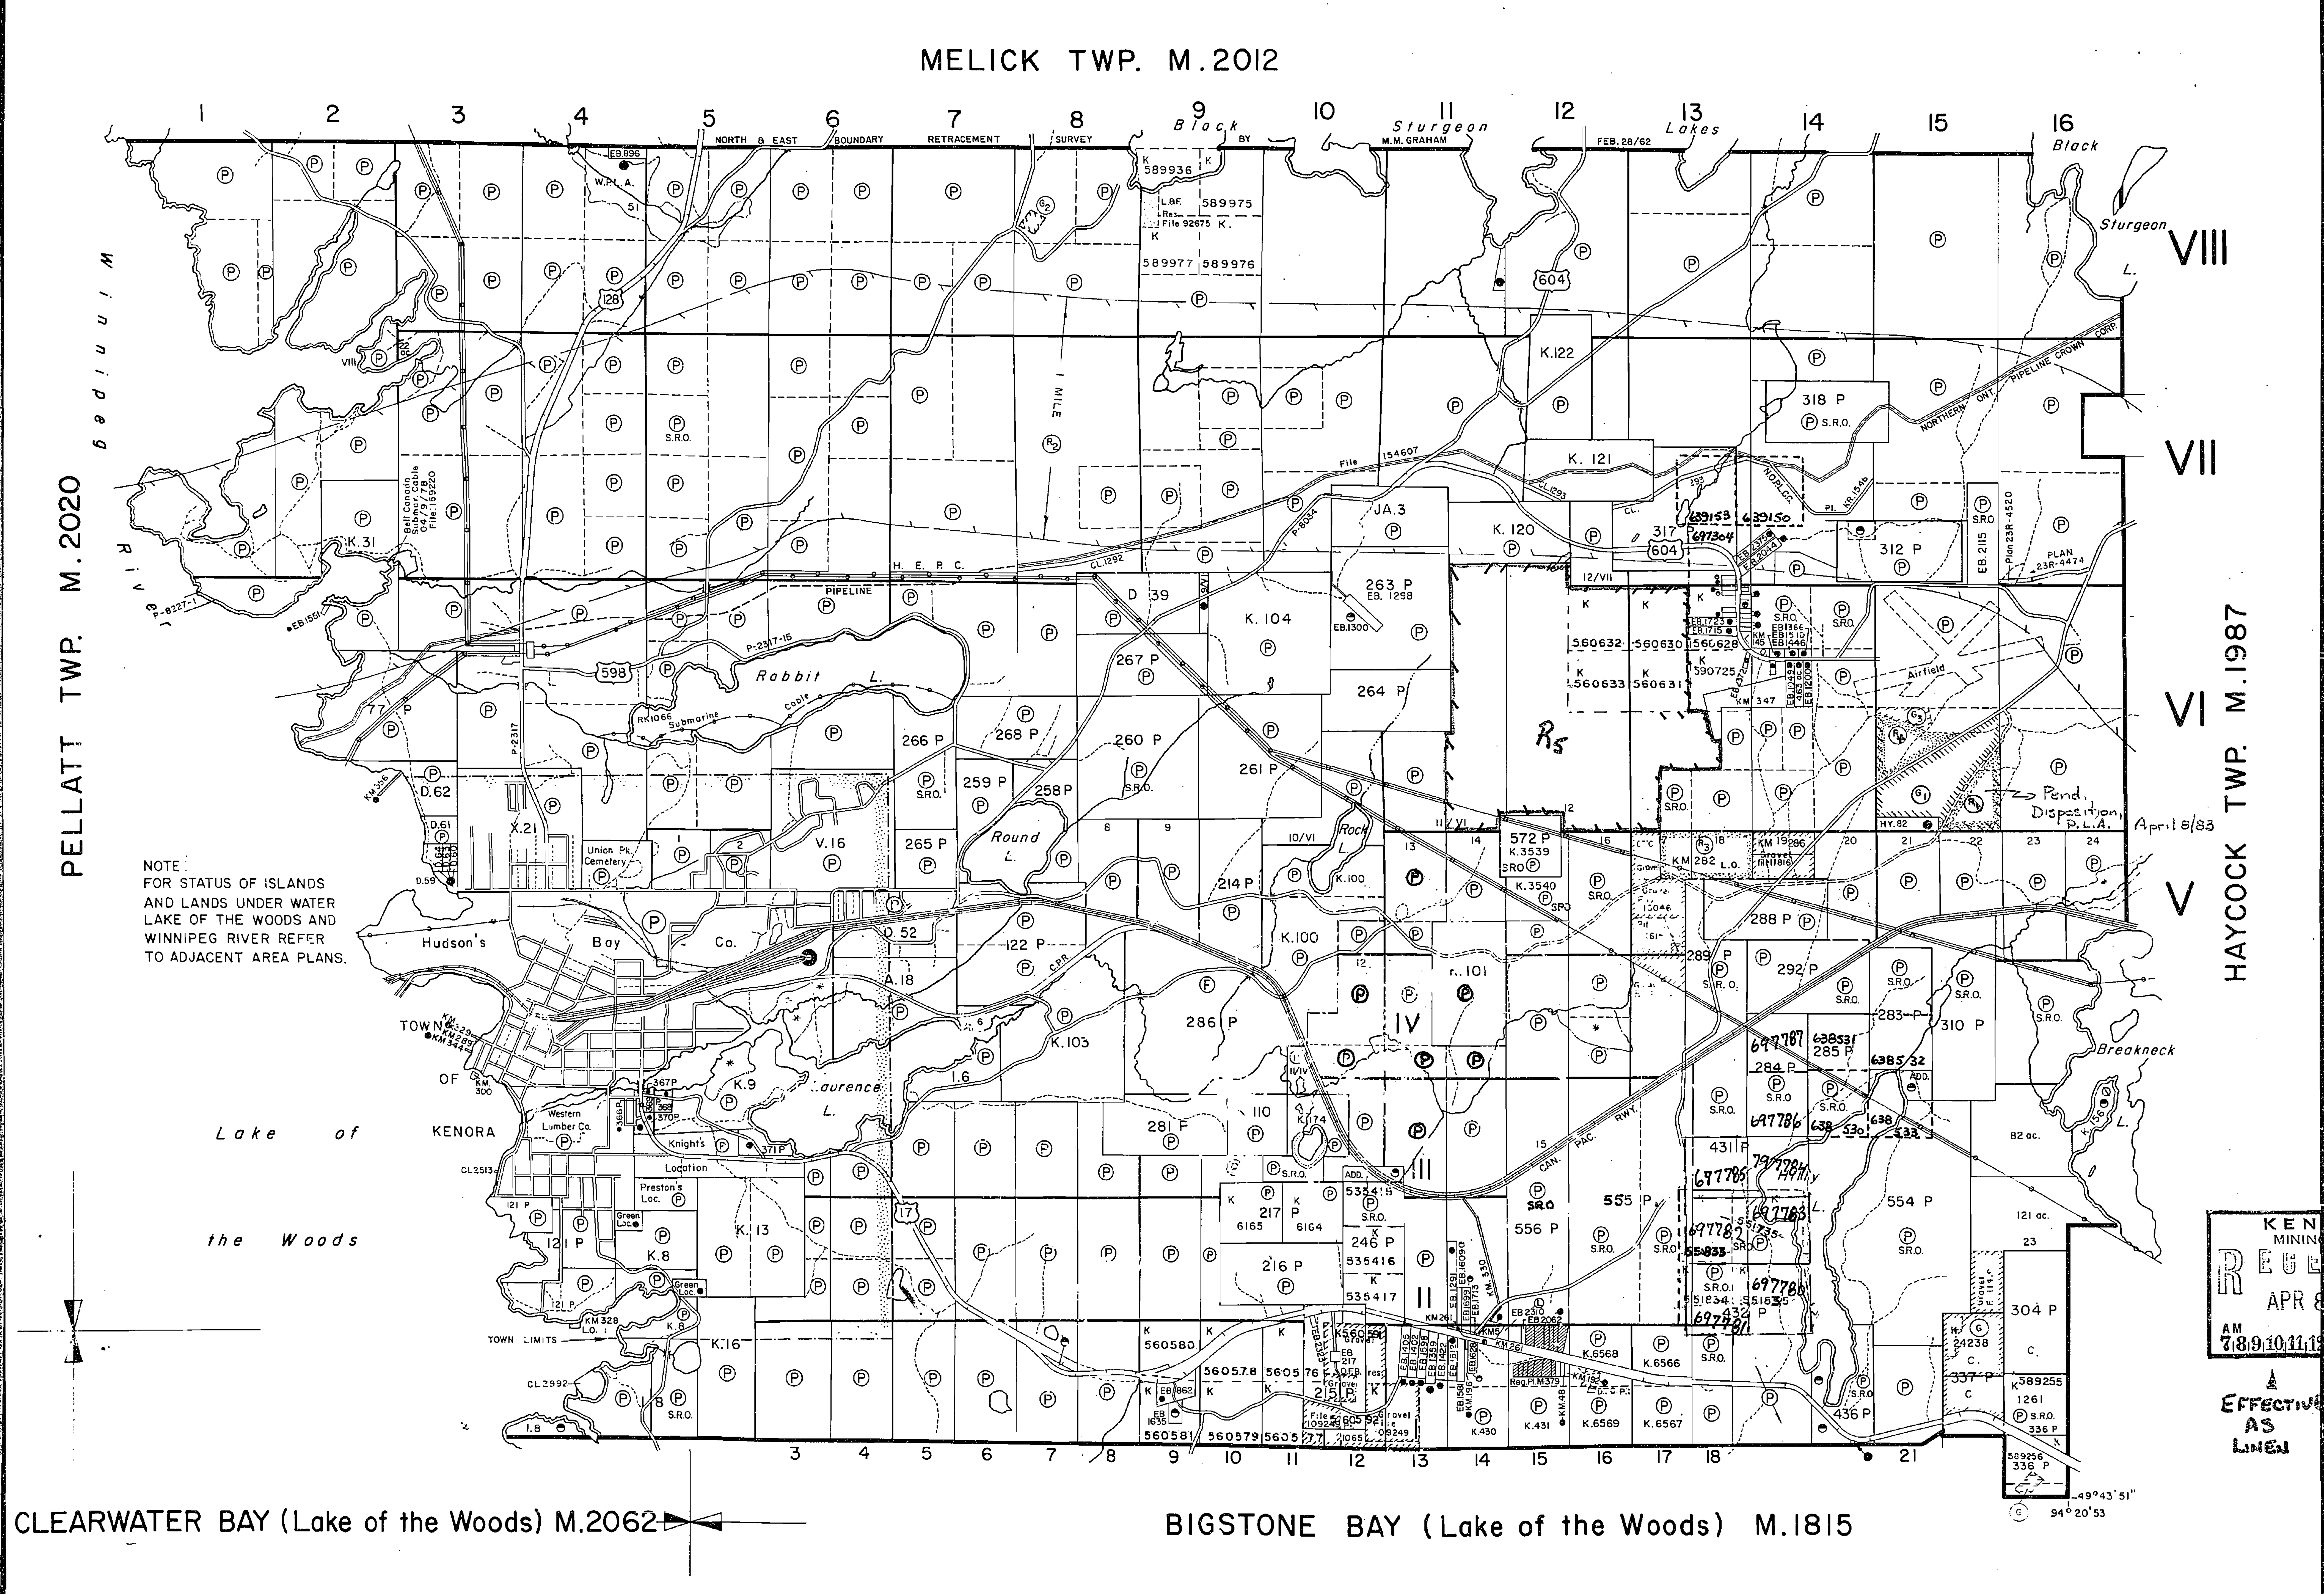
MELICK TWP. M.2012
PELLATT TWP. M.2020
HAYCOCK TWP. M.1987
CLEARWATER BAY (Lake of the Woods) M.2062
BIGSTONE BAY (Lake of the Woods) M.1815
Winnipeg River
Black Sturgeon Lakes
Black Sturgeon L.
Rabbit L.
Round L.
Laurence L.
Rock L.
Breakneck L.
Lake of the Woods
TOWN OF KENORA
Hudson's Bay Co.
Union Pk. Cemetery
Western Lumber Co.
Knight's Location
Preston's Loc.
Airfield
CAN. PAC. RWY.
NORTHERN ONT. PIPELINE CROWN CORP.
H.E.P.C.
PIPELINE
NORTH & EAST BOUNDARY RETRACEMENT SURVEY BY M.M. GRAHAM FEB. 28/62
TOWN LIMITS
1 MILE
VIII
VII
VI
V
IV
III
II
R5
Pend. Disposition, P.L.A. April 8/83
49°43'51"
94°20'53

NOTE:
FOR STATUS OF ISLANDS AND LANDS UNDER WATER LAKE OF THE WOODS AND WINNIPEG RIVER REFER TO ADJACENT AREA PLANS.

NOTES

400' surface rights reservation along the shores of all lakes and rivers.

Flooding rights reserved on Winnipeg River and Alcock Lake to contour elev. 1051.20' G.S.C. Jan. 23/40. File 4922 vol.5

H.E.P.C. flooding rights on Winnipeg River and Alcock Lake to contour elev. 1045' G.S.C. W.P.L.A. 51 File 12999

SAND and GRAVEL

(G1) M.T.C. Gravel Pit ID-5, File 97164 (G3) M.T.C. GRAVEL PIT ID-42
(G2) Gravel File 57027
(G) QUARRY PERMIT

AREAS WITHDRAWN FROM STAKING

S.R. – SURFACE RIGHTS M.R. – MINING RIGHTS

	Section	Order No.	Date	Disposition	File
~~(R1)~~	~~For Reforestation~~	ONWR 4/83	83·04·05	~~S.R.~~	~~97164~~
(R2)	43 (R.S.O. 1970)	W.22/78	11/5/78	S.R.	188521
(R3)	43 (R.S.O. 1970)	W.1/81	22/1/81	S.R.& M.R.	11816
R4		WNWR 5/83	83/04/05	S.R.	
R5	W1/83	Dep. Min.	07/04/83	S&MR.	

LEGEND

PATENTED LAND	Ⓟ or ●†
PATENTED FOR SURFACE RIGHTS ONLY	◒†
LEASE	Ⓛ
LICENSE OF OCCUPATION	L.O.
CROWN LAND SALES	C.S.
LOCATED LAND	Loc.
CANCELLED	C
NOT THROWN OPEN FOR STAKING	⊘
MINING RIGHTS ONLY	M.R.O.
SURFACE RIGHTS ONLY	S.R.O.
HIGHWAY & ROUTE NO.	17
ROADS	═
TRAILS	------
RAILWAYS	-+-+-+-
POWER LINES	-o-o-
MARSH OR MUSKEG	*
MINES	⚒

† used only with summer resort locations or when space is limited.

DATE OF ISSUE
FEB 11 1983
Ministry of Natural Resources
TORONTO

TOWNSHIP OF

JAFFRAY

DISTRICT OF
KENORA

KENORA
MINING DIVISION

#13

KENORA MINING DIV.
RECEIVED
APR 8 1983
AM 7 8 9 10 11 12 1 2 3 4 5 6 PM

Effective as Linen

SCALE : 1 INCH = 40 CHAINS (1/2 MILE)

DR.	D.T.	PLAN NO. M.1992
DATE	JULY/71	

ONTARIO
MINISTRY OF NATURAL RESOURCES
SURVEYS AND MAPPING BRANCH

NOTICE: THE SURFACE RIGHTS LYING WITHIN 40.25m OF THE CENTRE LINE OF THE TRANSCANADA PIPELINE RIGHT OF WAY ARE WITHDRAWN FROM STAKING OUT, PROSPECTING, SALE OR LEASE BY ORDER W.01.91 ONT. DATED SEPT.30, 1991, SECTION 112 OF THE NATIONAL ENERGY BOARD ACT APPLIES.

SYMBOLS

Boundary
- Township, Meridian, Baseline
- Road allowance; surveyed
  - shoreline
- Lot/Concession; surveyed
  - unsurveyed
- Parcel; surveyed
  - unsurveyed
- Right-of-way; road
  - railway
  - utility

- Reservation ▨
- Cliff, Pit, Pile
- Contour
  - Interpolated
  - Approximate
  - Depression
- Control point (horizontal)
- Flooded land
- Mine head frame
- Pipeline (above ground)

- Railway; single track
  - double track
  - abandoned
- Road; highway, county, township
  - access
  - trail, bush
- Shoreline (original)
- Transmission line
- Wooded area

DISPOSITION OF CROWN LANDS

Patent
- Surface & Mining Rights ●
- Surface Rights Only ◓
- Mining Rights Only ◒

Lease
- Surface & Mining Rights ■
- Surface Rights Only ⬒
- Mining Rights Only ⬓

- Licence of Occupation ▼
- Order-in-Council OC
- Cancelled ⊗
- Reservation Ⓡ
- Sand & Gravel ⓢ

THE INFORMATION THAT APPEARS ON THIS MAP HAS BEEN COMPILED FROM VARIOUS SOURCES, AND ACCURACY IS NOT GUARANTEED. THOSE WISHING TO STAKE MINING CLAIMS SHOULD CONSULT WITH THE MINING RECORDER, MINISTRY OF NORTHERN DEVELOPMENT AND MINES, FOR ADDITIONAL INFORMATION ON THE STATUS OF THE LANDS SHOWN HEREON.

Ontario
Ministry of Natural Resources
Ministry of Northern Development and Mines

INDEX TO LAND DISPOSITION

PLAN G-1338

TOWNSHIP JAFFRAY

M.N.R. ADMINISTRATIVE DISTRICT
KENORA
MINING DIVISION
KENORA
LAND TITLES/REGISTRY DIVISION
KENORA

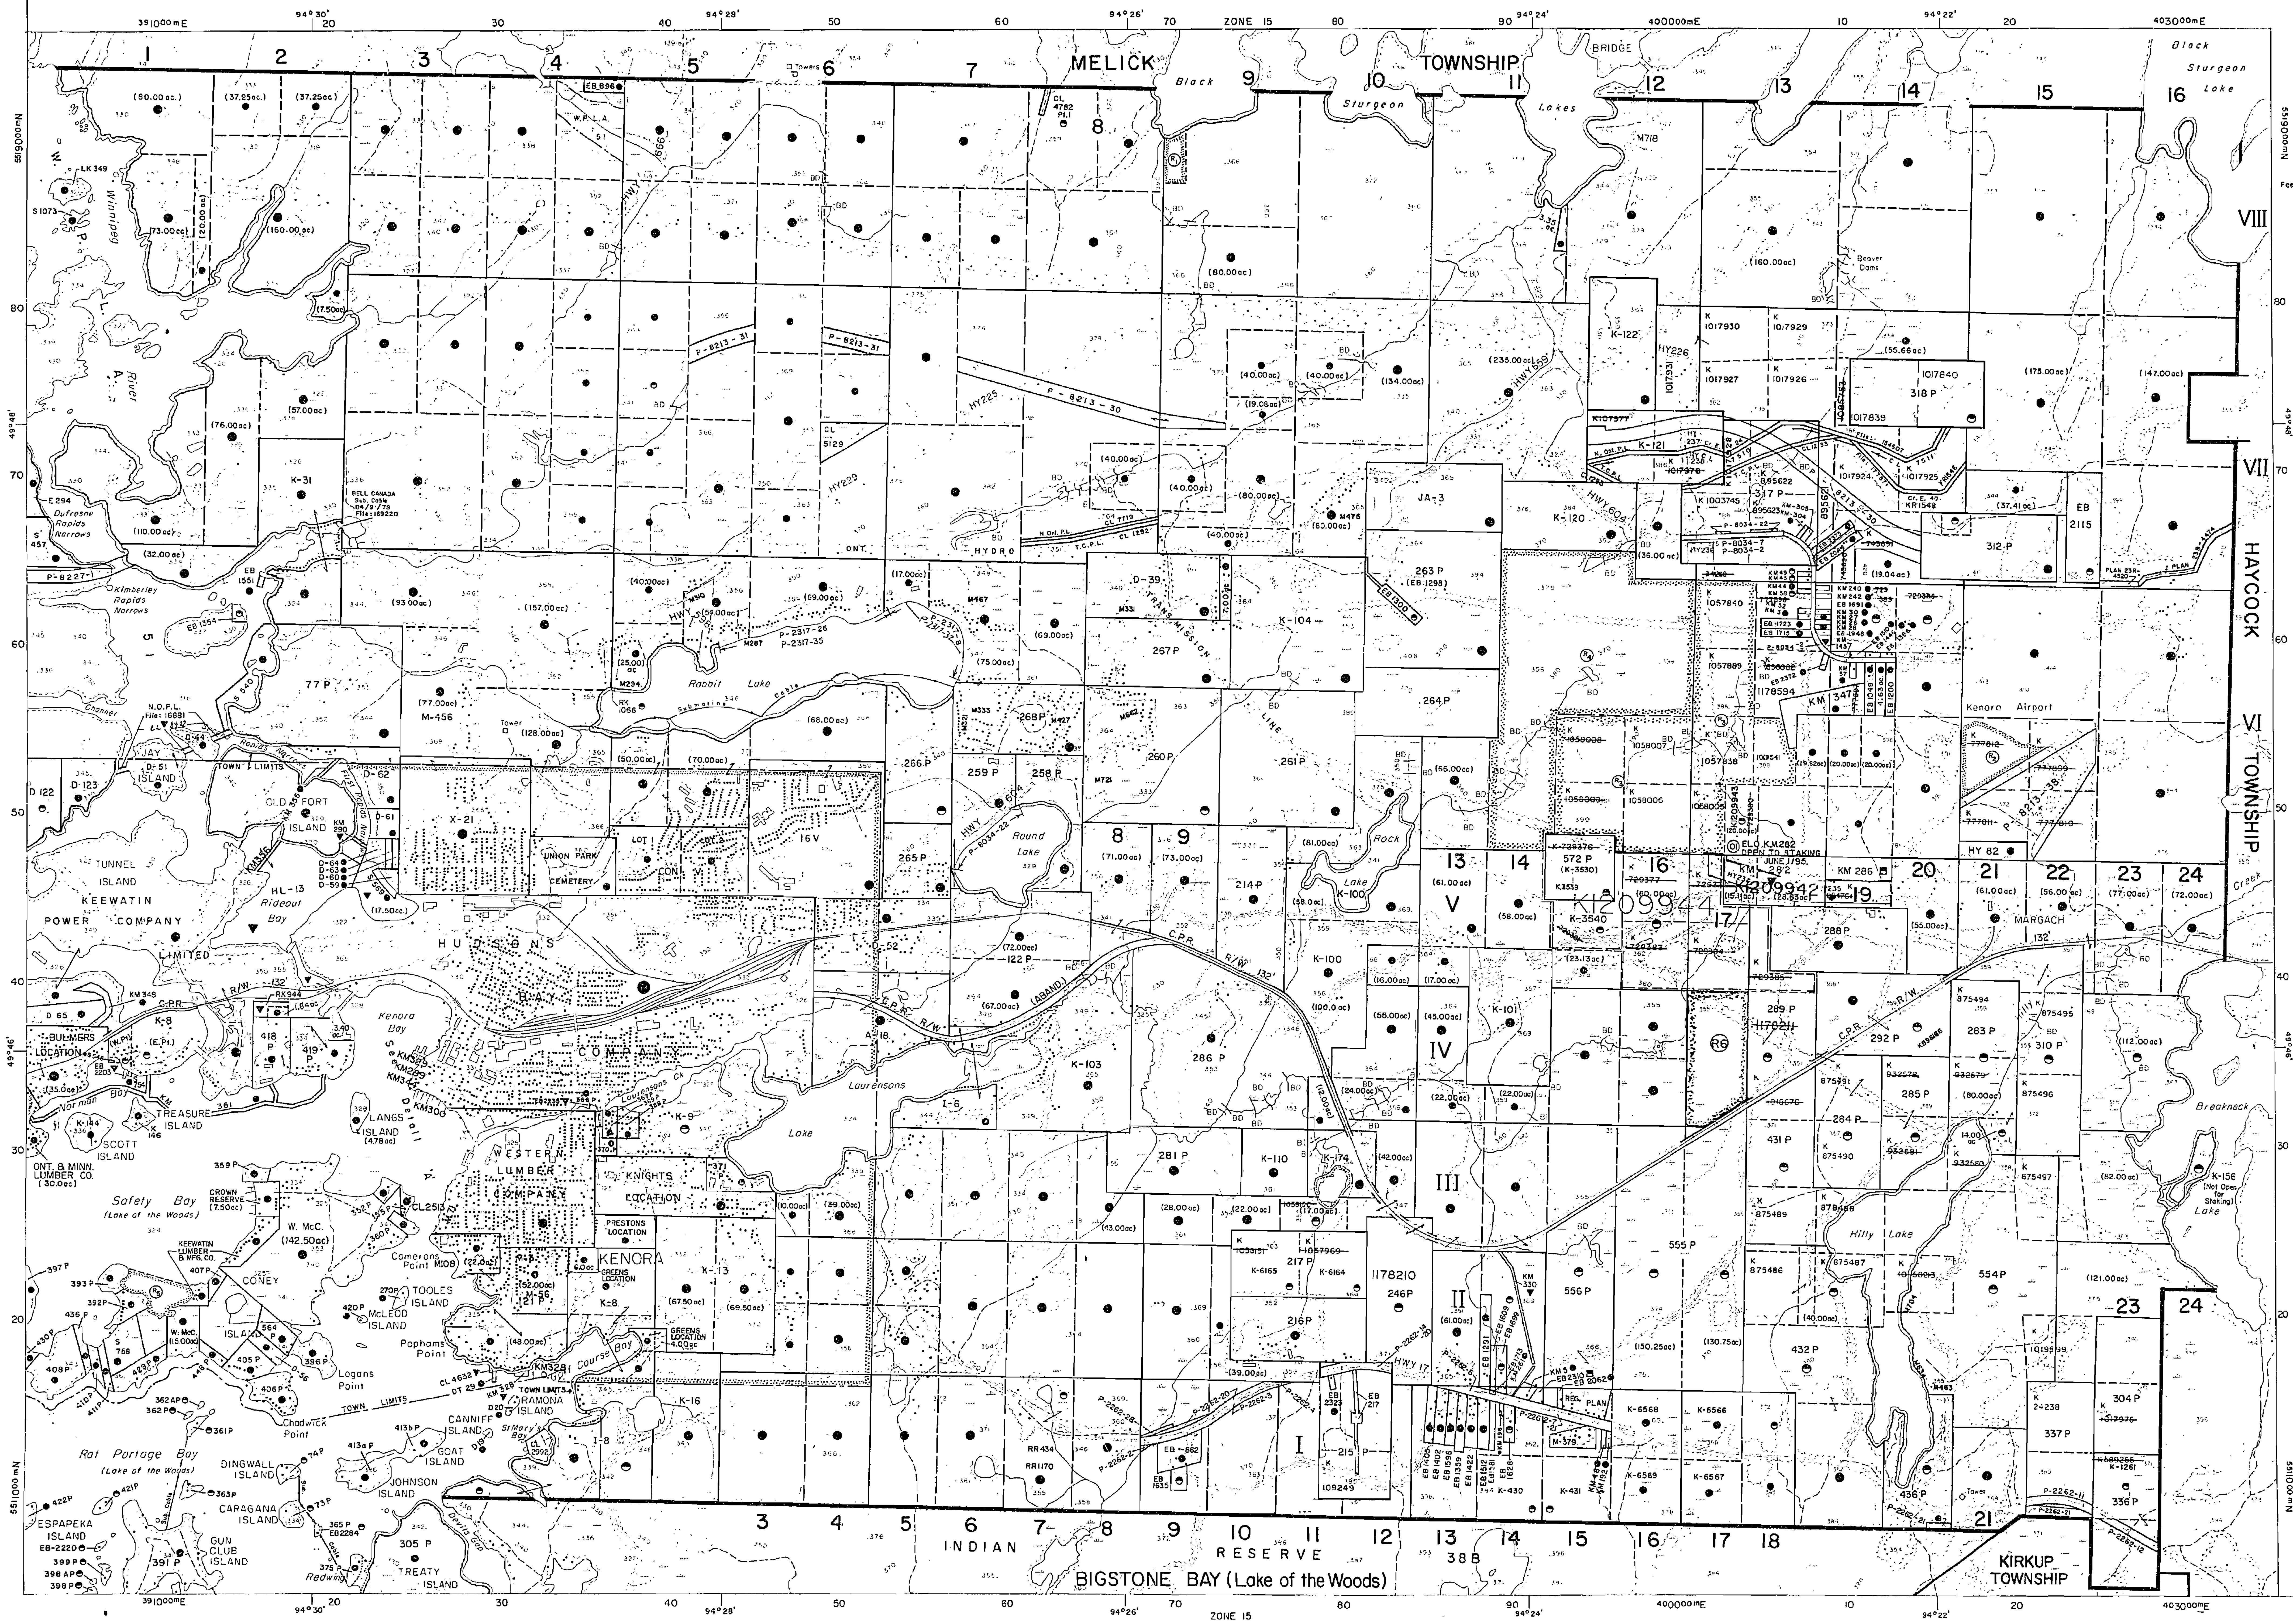
MELICK TOWNSHIP
HAYCOCK TOWNSHIP
KIRKUP TOWNSHIP
INDIAN RESERVE 38 B
BIGSTONE BAY (Lake of the Woods)
Black Sturgeon Lakes
Winnipeg River
Rabbit Lake
Round Lake
Laurensons Lake
Hilly Lake
Kenora Airport
HUDSONS BAY COMPANY
WESTERN LUMBER COMPANY
KEEWATIN POWER COMPANY LIMITED
KENORA
KNIGHTS LOCATION
PRESTONS LOCATION
UNION PARK
CEMETERY
OLD FORT ISLAND
TUNNEL ISLAND
SCOTT ISLAND
TREASURE ISLAND
CONEY ISLAND
TOOLES ISLAND
McLEOD ISLAND
GOAT ISLAND
RAMONA ISLAND
CANNIFF ISLAND
DINGWALL ISLAND
JOHNSON ISLAND
CARAGANA ISLAND
GUN CLUB ISLAND
ESPAPEKA ISLAND
TREATY ISLAND
Safety Bay (Lake of the Woods)
Rat Portage Bay (Lake of the Woods)
Kenora Bay
Rideout Bay
Norman Bay
Breakneck Lake
C.P.R.
TRANSMISSION LINE
391000mE
400000mE
403000mE
ZONE 15
94°30'
94°28'
94°26'
94°24'
94°22'
5519000mN
5511000mN
49°48'
49°46'
I
II
III
IV
V
VI
VII
VIII

Scale 1:20 000

Metres	1000	0	1 000
Feet	1000 0 1000 2000 3000 4000 5000 6000		

Contour Interval 10 Metres

AREAS WITHDRAWN FROM DISPOSITION

MRO - Mining Rights Only
SRO - Surface Rights Only
M + S - Mining and Surface Rights

Description	Order No.	Date	Disposition	File
Ⓡ1 MNR RESERVE				92675
Ⓡ2 SEC. 36/80	W.5/83	5/4/83	SRO	97164
Ⓡ3 SEC. 36/80	W.36/88	30/5/88	SRO	188555 Vol.I
Ⓡ4 SEC. 36/80	W.37/88	30/5/88	M+S	188555 Vol.I
Ⓡ5 MNR RESERVE				77094 Vol.I
R6 MNR RESERVE	W.K-1/95 NWR	19/01/95	M&S	195150

DATE OF ISSUE

SEP 0 9 1997

PROVINCIAL RECORDING OFFICE - SUDBURY

FLOODING:

ONT. HYDRO FLOODING ON THE WINNIPEG RIVER AND ALCOCK LAKE TO CONTOUR ELEVATION 1045' G.S.C.
W.P.L.A. 51 FILE: 12999

NOTES

ISLANDS AND WATER LOTS, TO THE WEST OF JAFFRAY TWP., IN THE WINNIPEG RIVER AND LAKE OF THE WOODS ARE CLASSIFIED AS UNSURVEYED TERRITORY AND AS SUCH ARE NOT GEOGRAPHICALLY PART OF JAFFRAY TWP.

THE SOUTH, EAST AND WEST BOUNDARIES OF THE TOWNSHIP OF JAFFRAY, BEING PART OF THE CORPORATION OF THE TOWNSHIP OF JAFFRAY AND MELICK, REGULATED BY MUNICIPAL CORPORATIONS QUIETING ORDER DATED JAN. 6, 1956. P.F.C. 7296
(now the TOWN OF JAFFRAY and MELICK)

THE NORTH, EAST AND SOUTH BOUNDARIES OF THE TOWN OF KENORA. REGULATED BY MUNICIPAL CORPORATIONS QUIETING ORDER DATED JUNE 15, 1959. P.F.M. 6508

ISLANDS IN THE WINNIPEG RIVER AND LAKE OF THE WOODS ARE 'NOT OPEN FOR STAKING'

◄---- EFFECTIVE AS LINEN

Map base and land disposition drafting by Surveys and Mapping Branch, Ministry of Natural Resources.

The disposition of land, location of lot fabric and parcel boundaries on this index was compiled for administrative purposes only.

JAFFRAY TWP.

FEB - 2 1963

KENORA MINING DIVISION.

DISTRICT OF KENORA.

Scale 40 chains to an inch.

NOTE:

Area marked thus withdrawn from staking under section 39(d) of the Mg. Act.
Also gravel in the same area, reserved from disposition.

Open [illegible]

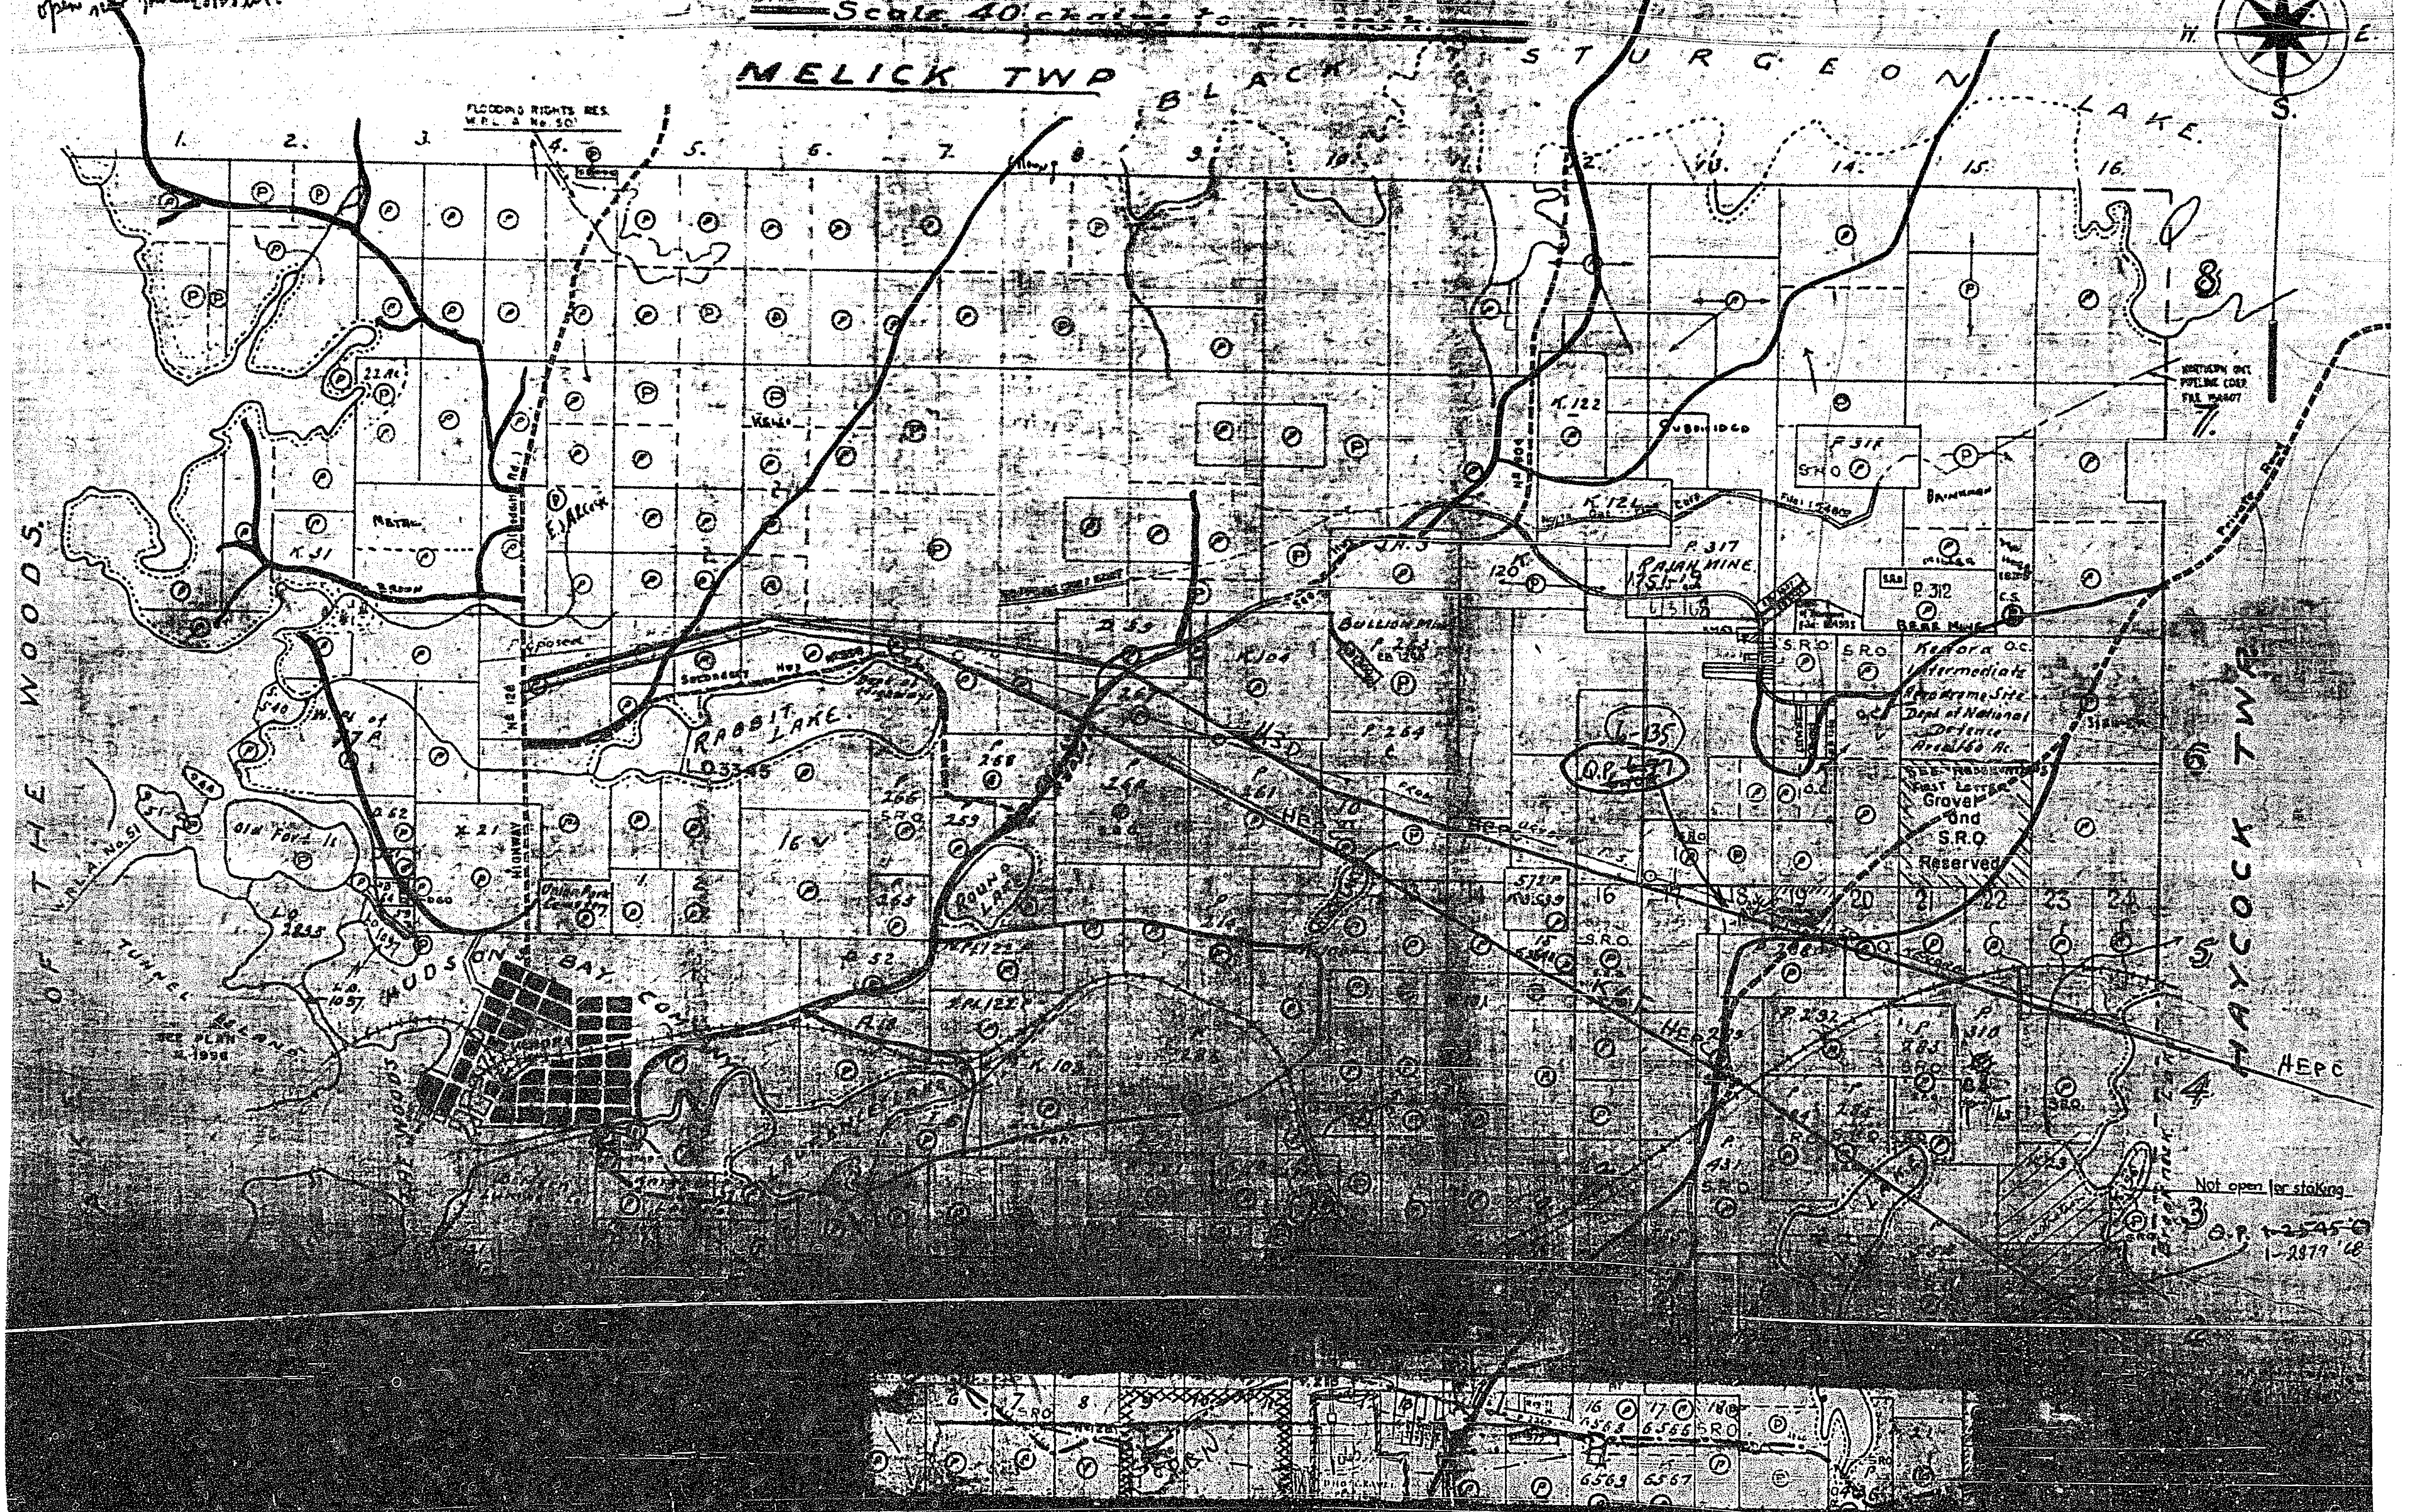

MELICK TWP
BLACK STURGEON LAKE
FLOODING RIGHTS RES. W.P.L. A No. 501
N.
S.
W.
E.
1. 2. 3. 4. 5. 6. 7. 8. 9. 10. 12. 13. 14. 15. 16.
8
7.
6
5
4
3
K.31
K.122
K.124
P.317
P.318
P.312
RAJAH MINE
BULLION MINE
RABBIT LAKE
ROUND LAKE
Old Fort Is.
Kenora
Kenora Intermediate Aerodrome Site Dept. of National Defence
Gravel and S.R.O. Reserved
S.R.O.
HEPC
HAYCOCK TWP
LAKE OF THE WOODS
HUDSON BAY COMPANY
Secondary Hwy
Private Road
Not open for staking
O.P. 1-2545 '63
1-2879 '68
16 17 18
6565 6566 6563 6567

S. ½ Lot 15, Con. 6 Reforestation SRO withdrawn from staking Sec. 39 (d) No. QP 7/18/55 RES. -A-

337P and part of 304P L & F Reservation removed.
~~See Res. J. 12/10/63~~

Gravel and staking reservation on Lots 9, 10, 11, Con. 1 - Reservation continued until Jan. 1/63
See RES. J. 7/23/62 (121394

JAFFRAY 1992

1992

JAFFRAY 1992

PLAN OF

JAFFRAY TWP.

KENORA MINING DIVISION.

DISTRICT OF KENORA.

Scale, 40 chains to an inch.

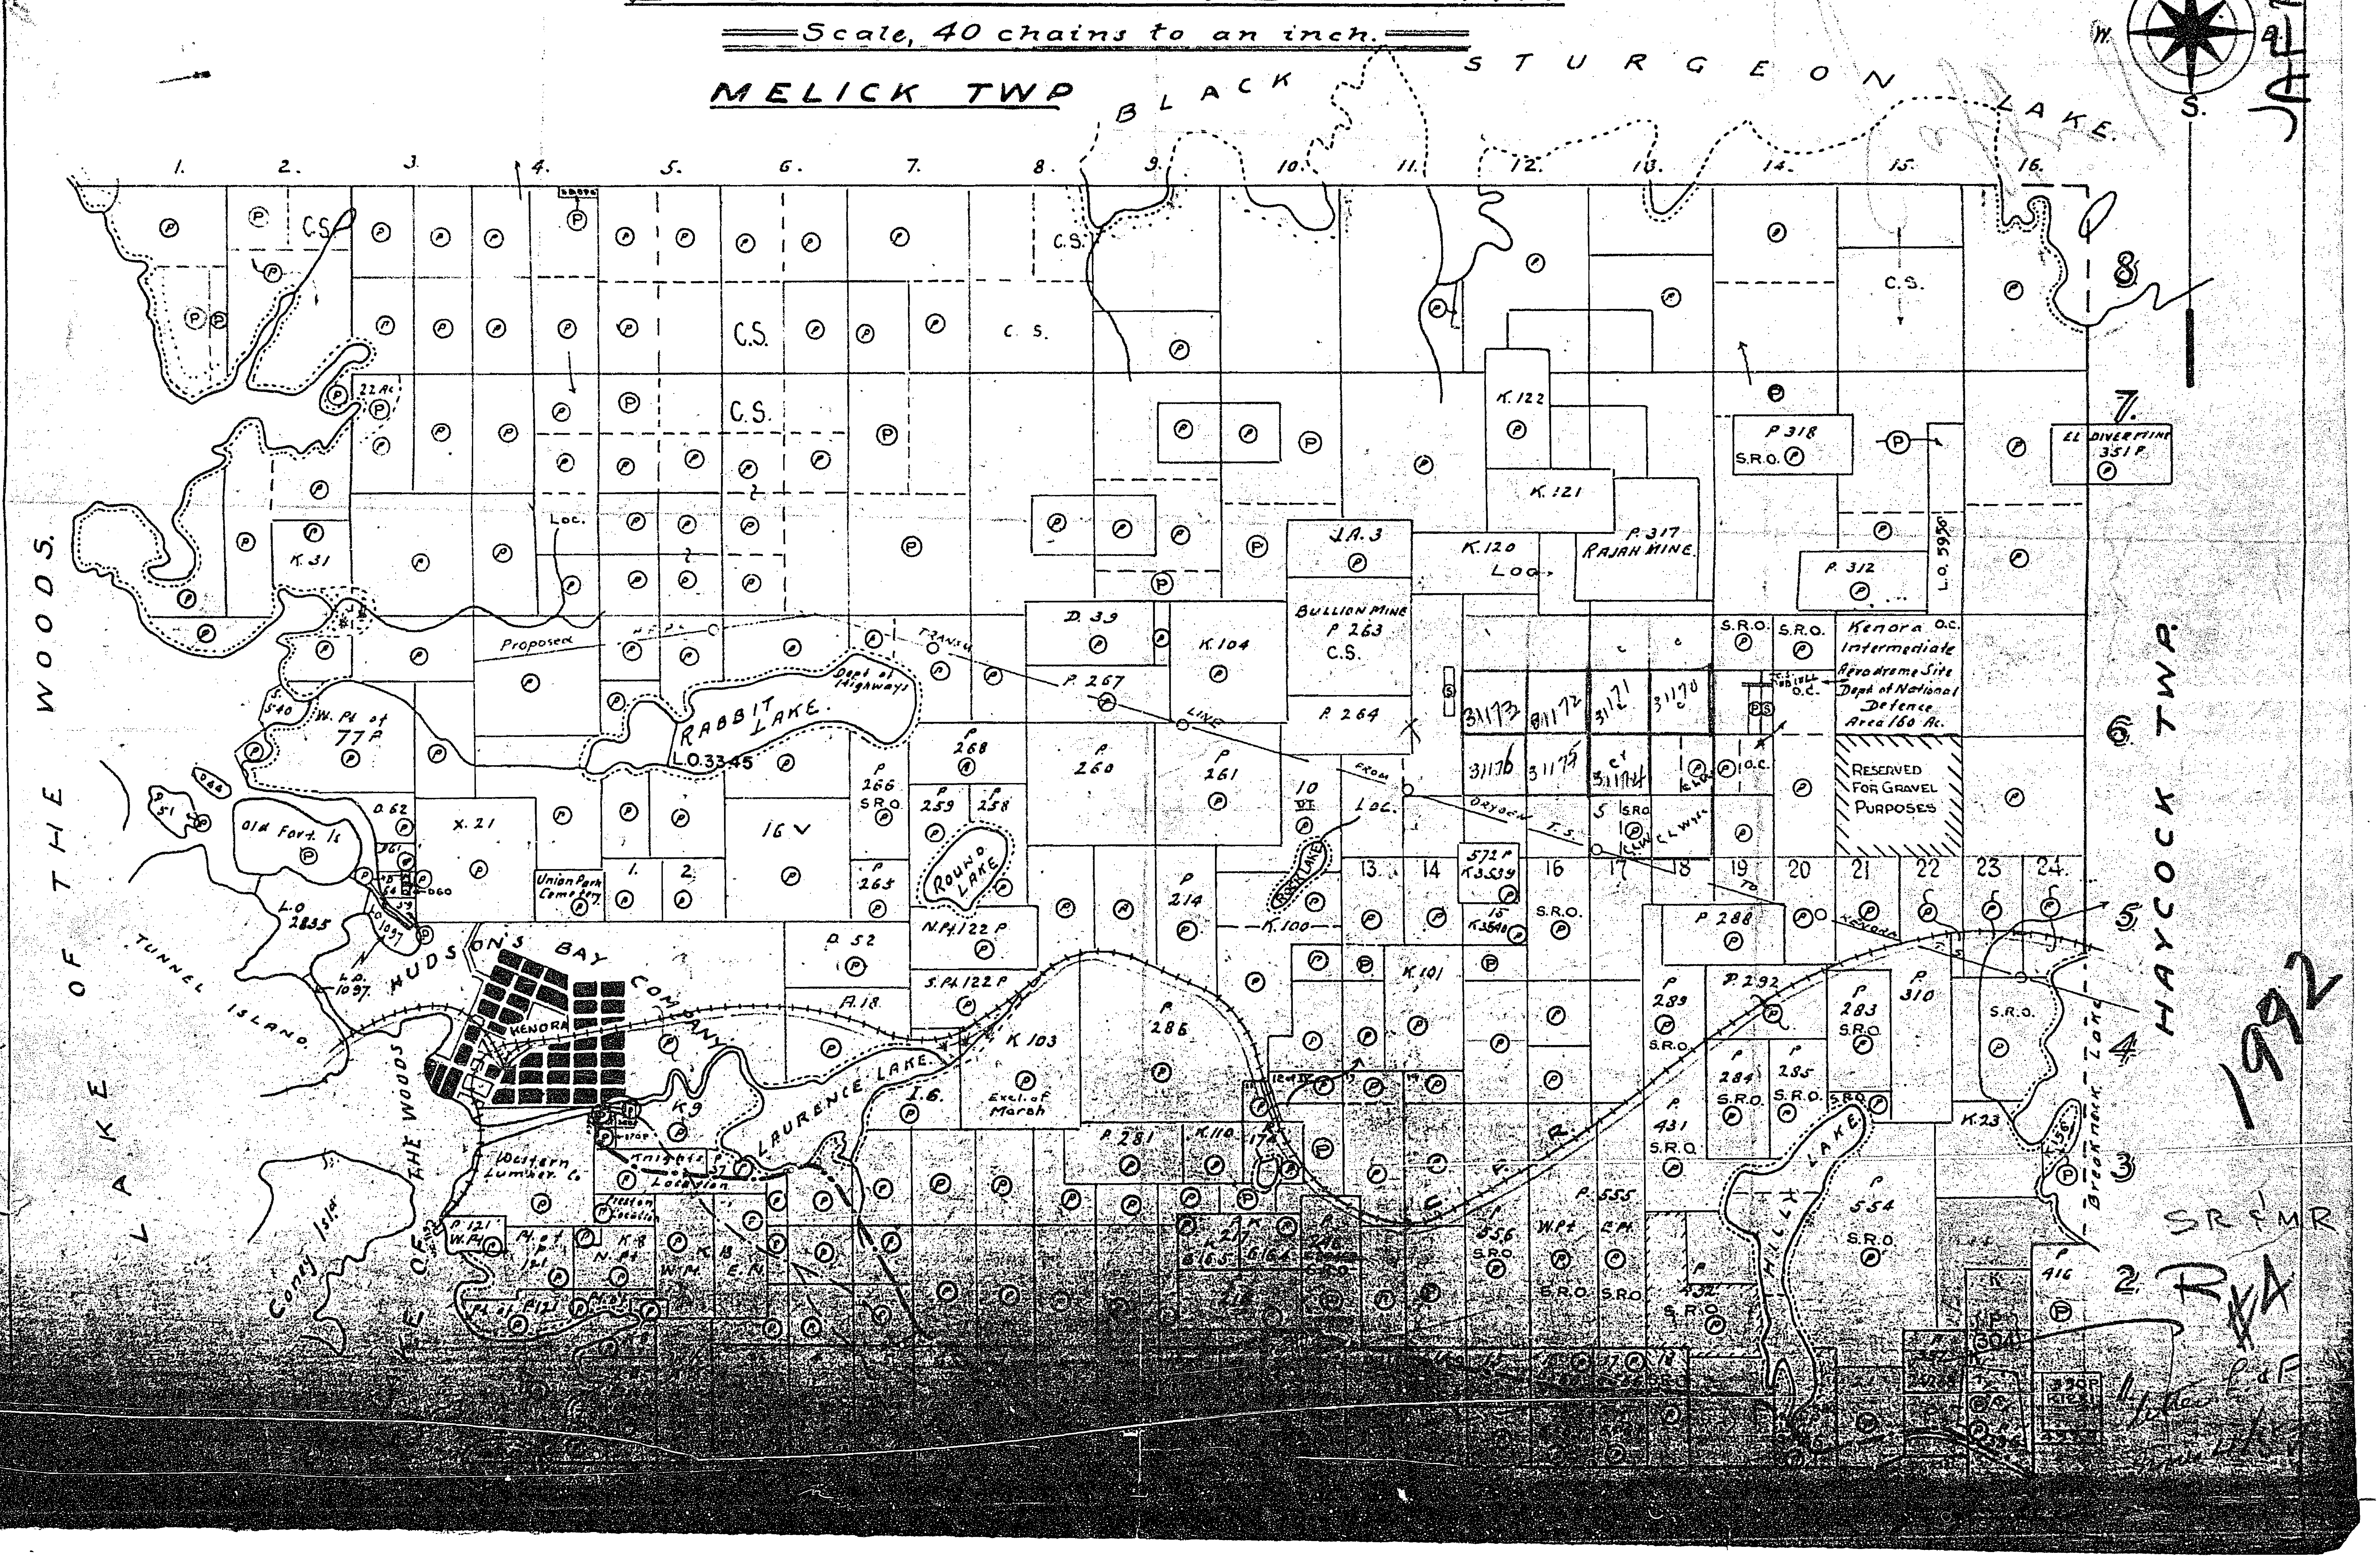

Ast. NORTH
N.
S.
W.
E.
MELICK TWP
BLACK STURGEON LAKE
LAKE OF THE WOODS
HAYCOCK TWP.
TUNNEL ISLAND
HUDSON'S BAY COMPANY
KENORA
RABBIT LAKE
Dept. of Highways
L.O. 3345
ROUND LAKE
LAURENCE LAKE
Old Fort Is.
Coney Island
Western Lumber Co.
Union Park Cemetery
Proposed
TRANS. LINE
FROM ORYOCK T.S.
BULLION MINE P.263 C.S.
RAJAH MINE P.317
EL DIVERTIMINE 351 P.
Kenora O.C. Intermediate Aerodrome Site Dept. of National Defence Area 160 Ac.
RESERVED FOR GRAVEL PURPOSES
Excl. of Marsh
W. Pt. of 77 P.
L.O. 2835
L.O. 1097
L.O. 5990
K.31
K.120
K.121
K.122
K.104
K.100
K.101
K.103
K.23
J.A.3
D.39
D.52
D.62
X.21
P.267
P.264
P.260
P.261
P.268
P.259
P.258
P.266 S.R.O.
P.265
P.214
P.286
P.281
P.288
P.289 S.R.O.
P.292
P.283 S.R.O.
P.284 S.R.O.
P.285 S.R.O.
P.310
P.312
P.318 S.R.O.
P.431 S.R.O.
P.554 S.R.O.
P.555
P.416
N.Pt.122 P
S.Pt.122 P
A.18
I.6.
C.S.
Loc.
S.R.O.
1. 2. 3. 4. 5. 6. 7. 8. 9. 10. 11. 12. 13. 14. 15. 16.
1 2 3 4 5 6 7 8
13 14 15 16 17 18 19 20 21 22 23 24
31173 31172 31171 31170 31176 31175

SR & MR

NOTICE: THE SURFACE RIGHTS LYING WITHIN 40.25m OF THE CENTRE LINE OF THE TRANSCANADA PIPELINE ~~RIGHT-OF-WAY ARE WITHDRAWN FROM~~ STAKING OUT, PROSPECTING, SALE OR LEASE BY ORDER W.01.91 ONT. DATED SEPT. 30, 1991. SECTION 112 OF THE NATIONAL ENERGY BOARD ACT APPLIES.

KENORA MINING DIV.
RECEIVED
MAY 31 1993
AM PM
7 8 9 10 11 12 1 2 3 4 5 6

←OBSOLETE

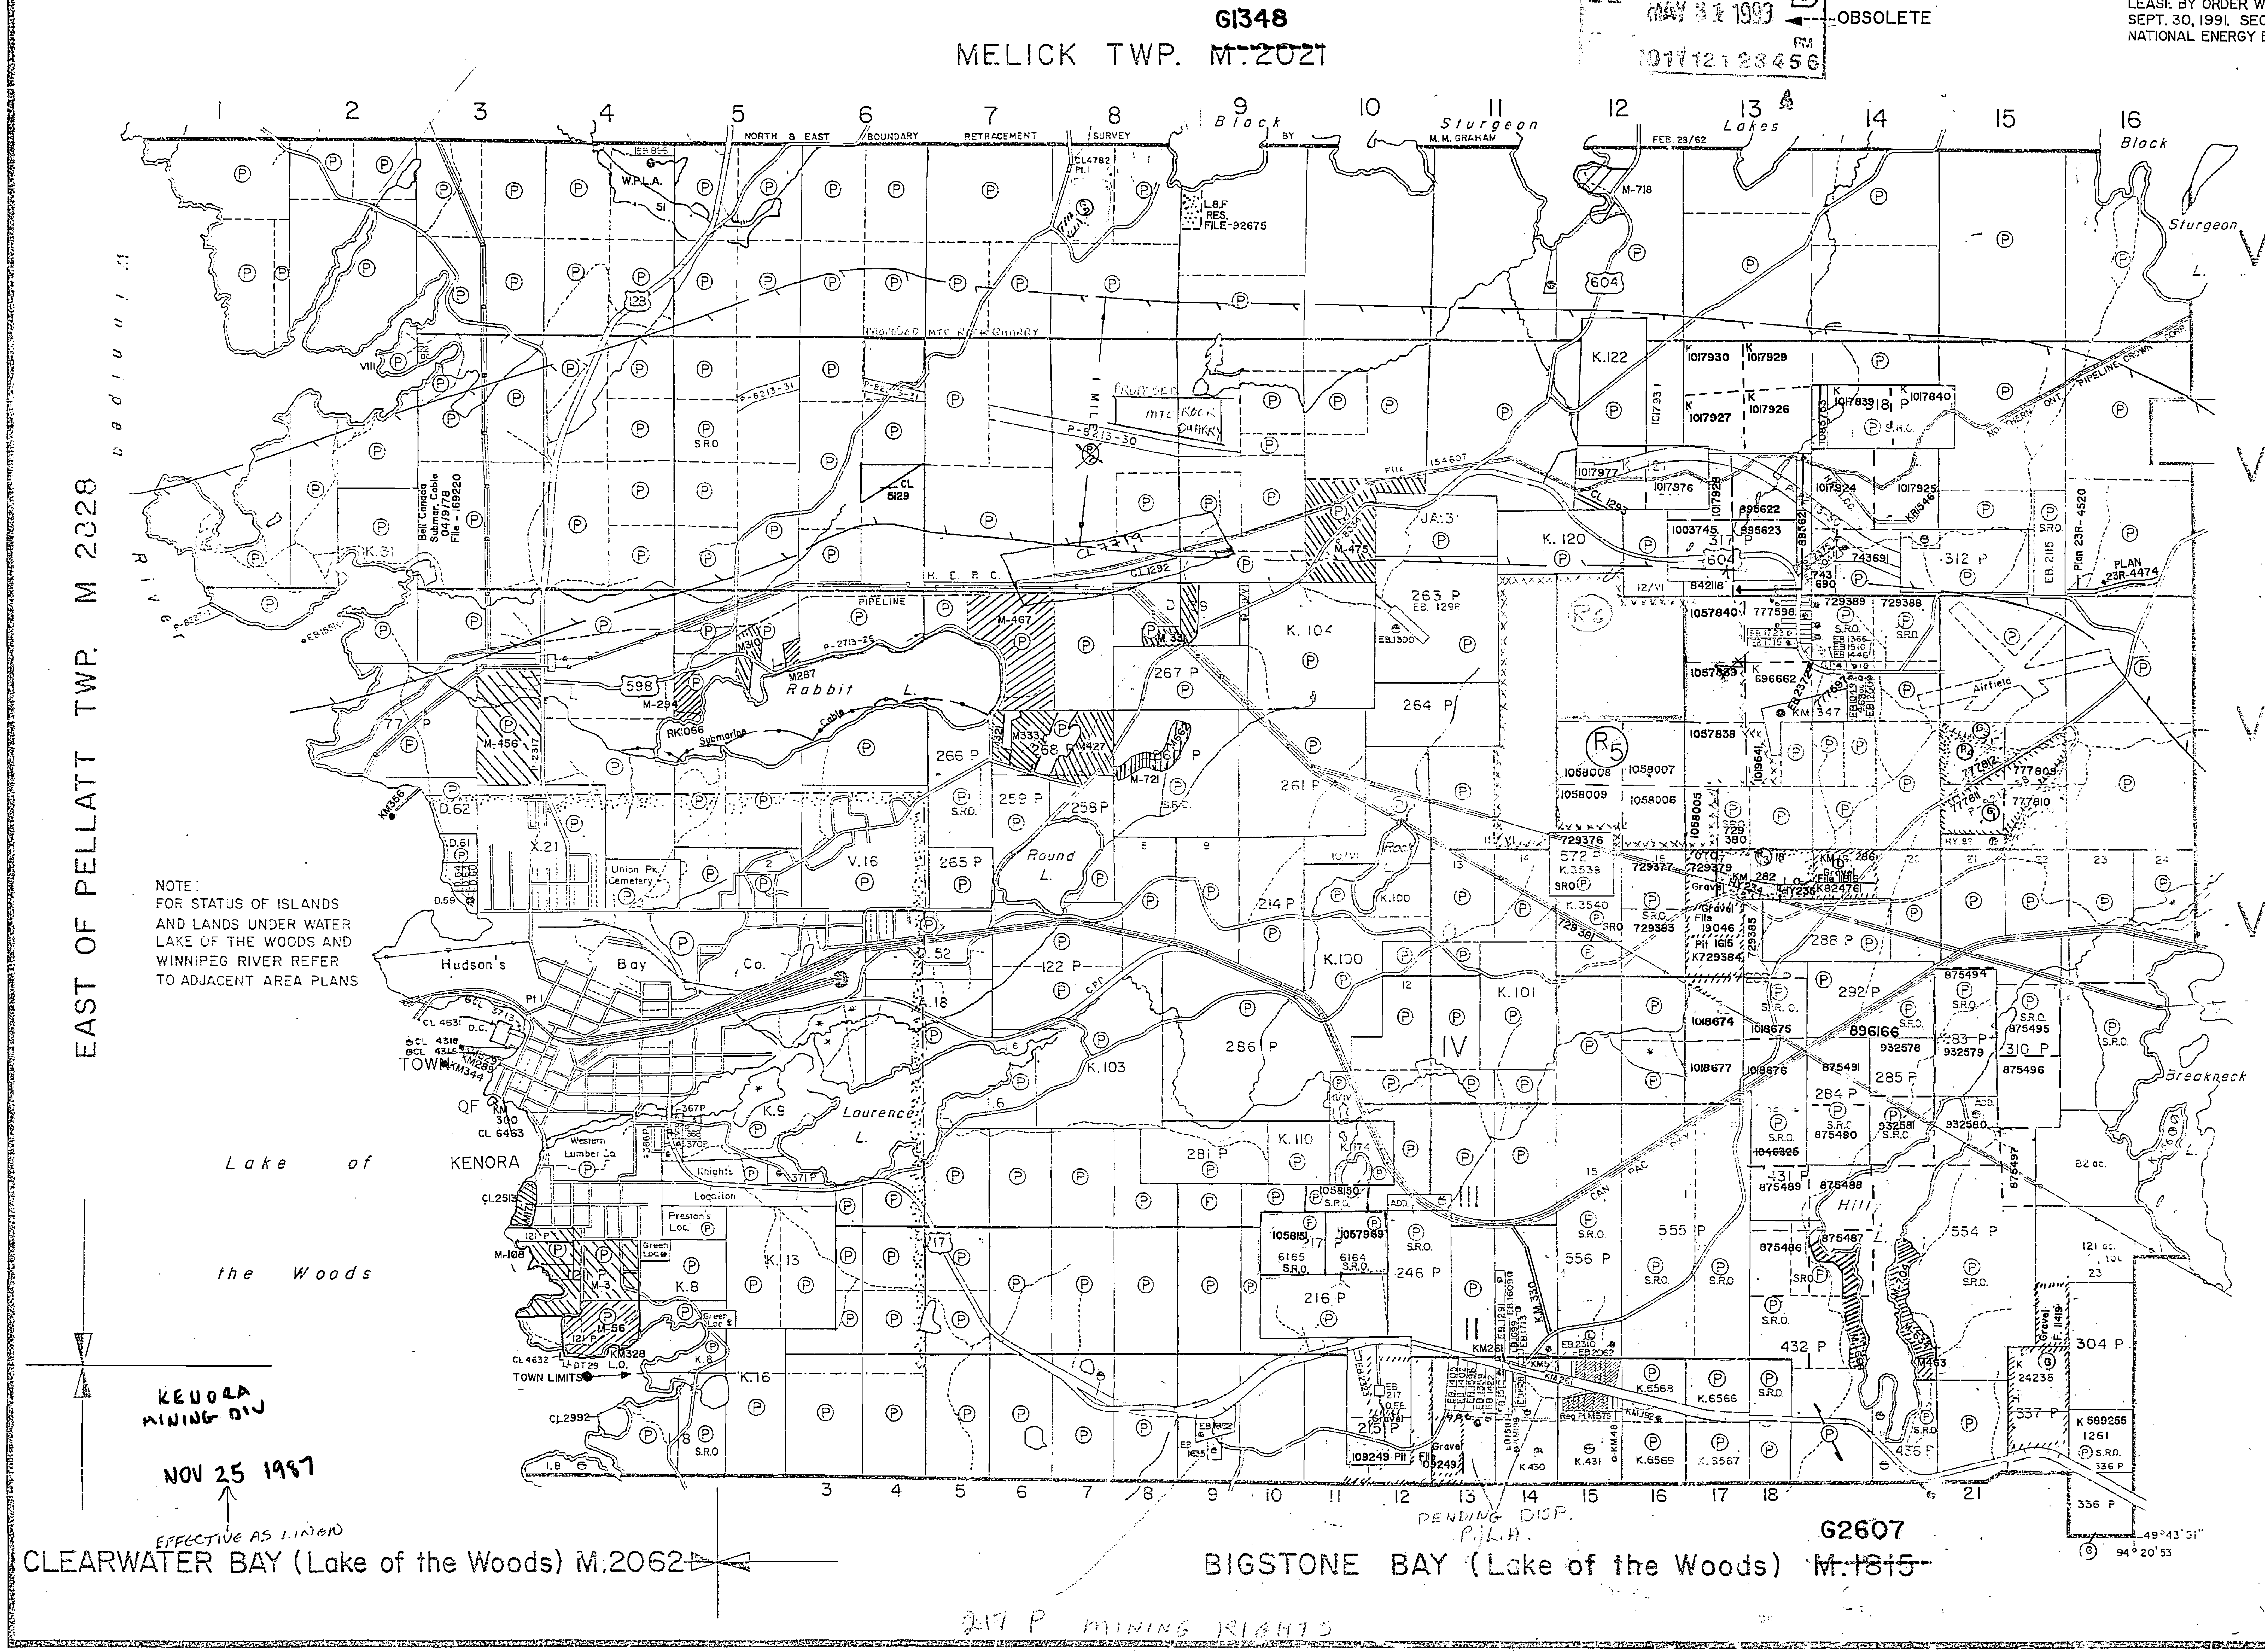
G1348
MELICK TWP. ~~M.2021~~
1
2
3
4
5
6
7
8
9
10
11
12
13
14
15
16
NORTH & EAST BOUNDARY RETRACEMENT SURVEY BY M.M. GRAHAM
FEB. 28/62
Black Sturgeon Lakes
Block
Sturgeon L.
VIII
VII
VI
V
IV
III
II
EAST OF PELLATT TWP. M 2328
Winnipeg River
G1336
HAYCOCK TWP. ~~M.1967~~
Rabbit L.
Round L.
Laurence L.
Hudson's Bay Co.
Lake of the Woods
KENORA
TOWN LIMITS
Union Pk. Cemetery
Western Lumber Co.
Preston's Loc.
Knight's Loc.
Green Loc.
Airfield
PIPELINE
H.E.P.C.
Breakneck
Hill
CAN. PAC. RY.
Proposed MTC Rock Quarry
W.P.L.A. 51
L.&F. RES. FILE-92675
3
4
5
6
7
8
9
10
11
12
13
14
16
17
18
21
49°43'31"
94°20'53
G2607
BIGSTONE BAY (Lake of the Woods) ~~M.1815~~
CLEARWATER BAY (Lake of the Woods) M.2062

NOTE:
FOR STATUS OF ISLANDS AND LANDS UNDER WATER LAKE OF THE WOODS AND WINNIPEG RIVER REFER TO ADJACENT AREA PLANS

PENDING DISP.
P.L.A.

KENORA
MINING DIV

NOV 25 1987
↑
EFFECTIVE AS LINEN

217 P MINING RIGHTS
OPEN FOR STAKING
JUNE 1, 1988 @ 8.00 am CDST

NOTES

400' surface rights reservation along the shores of all lakes and rivers.

FLOODING RIGHTS RESERVED ON WINNIPEG RIVER AND ALCOCK LAKE TO CONTOUR ELEV. 1031.20 G.S.C.
JAN. 23/40 FILE- 4922 vol. 5

H.E.P.C flooding rights on Winnipeg River and Alcock Lake to contour elev. 1045 G.S.C.
W.P.L.A. 51 File 12 999

SAND and GRAVEL

- Ⓖ1 M.T.C. Gravel Pit I D-5, File 97164
- Ⓖ2 Gravel File 57027
- Ⓖ3 M.T.C. GRAVEL PIT I D - 42
- Ⓖ QUARRY PERMIT

AREAS WITHDRAWN FROM STAKING

S.R. - SURFACE RIGHTS
M.R. - MINING RIGHTS

	Section	Order No.	Date	Disposition	File
~~R2~~	~~43(R.S.O. 1970)~~	~~W.22/78~~	~~11/5/78~~	~~S.R.~~	~~188521~~ RE-OPENED OK-01/91 MAR. 1/91
R3	43(R.S.O. 1970)	W. 1/81	22/1/81	S.R.& M.R.	11816
R4		W.N.W.R.5/83	83/04/05	S.R.	
R5	36(R.S.O. 1980)	W.36/88	05/30/88	S.R.	188555
R6	36(R.S.O. 1980)	W.37/88	05/30/88	S.R.& M.R.	188555

LEGEND

PATENTED LAND	Ⓟ or Ⓟ†
PATENTED FOR SURFACE RIGHTS ONLY	Ⓟ†
LEASE	Ⓛ
LICENSE OF OCCUPATION	L.O.
CROWN LAND SALES	C.S.
ORDER IN COUNCIL	O.C.
CANCELLED	C.
NOT THROWN OPEN FOR STAKING	⊘
MINING RIGHTS ONLY	M.R.O.
SURFACE RIGHTS ONLY	S.R.O.
HIGHWAY & ROUTE NO	17
ROADS	═ ═
TRAILS	------
RAILWAYS	─┼─┼─
POWER LINES	─•─•─
MARSH OR MUSKEG	*
MINES	⚒

† used only with summer resort locations or when space is limited.

THE INFORMATION THAT APPEARS ON THIS MAP HAS BEEN COMPILED FROM VARIOUS SOURCES, AND ACCURACY IS NOT GUARANTEED. THOSE WISHING TO STAKE MINING CLAIMS SHOULD CONSULT WITH THE MINING RECORDER, MINISTRY OF NORTHERN DEVELOPMENT AND MINES, FOR ADDITIONAL INFORMATION ON THE STATUS OF THE LANDS SHOWN HEREON.

TOWNSHIP OF
JAFFRAY
DISTRICT OF
KENORA

KENORA
MINING DIVISION

SCALE : 1 INCH = 40 CHAINS (1/2 MILE)

DR. D.T.
DATE JULY/71

PLAN NO. M.1992

ONTARIO
DEPARTMENT OF MINES
AND NORTHERN AFFAIRS

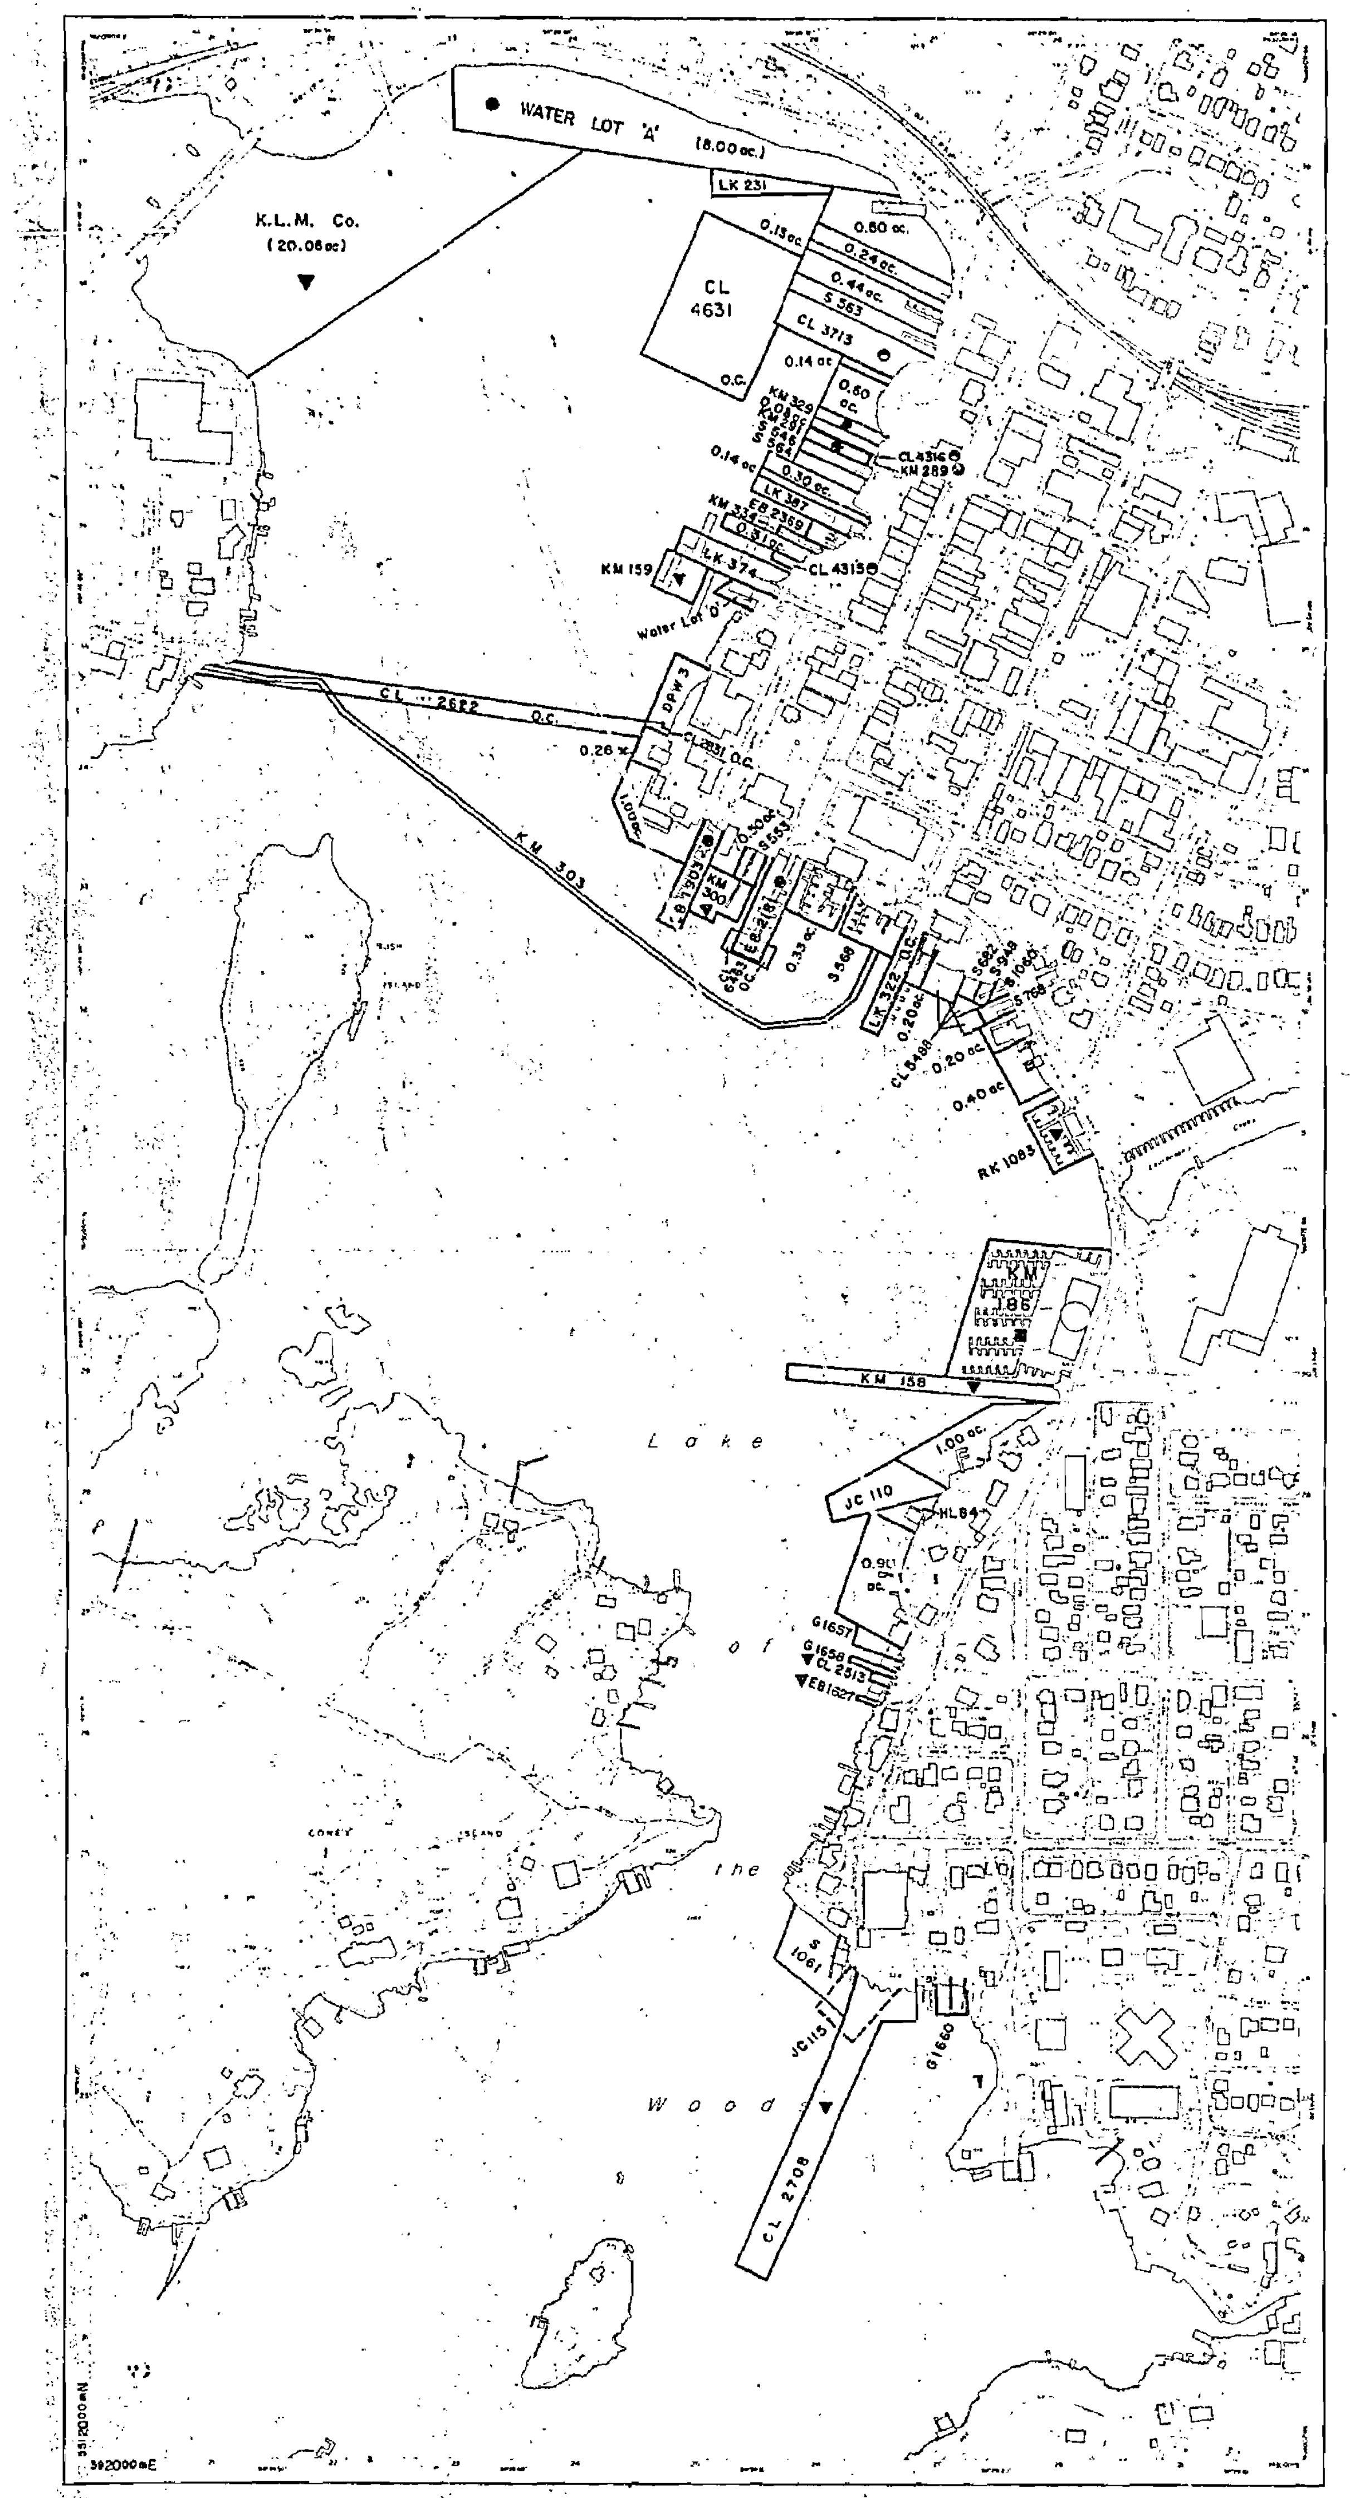

DETAIL 'A'

"Water Lots Fronting The Townsite of Kenora"
(Scale 1 : 5000)

NOTICE: THE SURFACE RIGHTS LYING WITHIN 40.25m OF THE CENTRE LINE OF THE TRANSCANADA PIPELINE RIGHT OF WAY ARE WITHDRAWN FROM STAKING OUT, PROSPECTING, SALE OR LEASE BY ORDER W.O1.91 ONT. DATED SEPT.30, 1991. SECTION 82 OF THE NATIONAL ENERGY BOARD ACT APPLIES.

SYMBOLS

Boundary
- Township, Meridian, Baseline
- Road allowance; surveyed
  - shoreline
- Lot/Concession; surveyed
  - unsurveyed
- Parcel; surveyed
  - unsurveyed
- Right-of-way; road
  - railway
  - utility

- Reservation ▨
- Cliff, Pit, Pile
- Contour
  - Interpolated
  - Approximate
  - Depression
- Control point (horizontal) △
- Flooded land
- Mine head frame
- Pipeline (above ground)

- Railway; single track
  - double track
  - abandoned
- Road; highway, county, township
  - access
  - trail, bush
- Shoreline (original)
- Transmission line
- Wooded area

DISPOSITION OF CROWN LANDS

Patent
- Surface & Mining Rights ●
- Surface Rights Only ◓
- Mining Rights Only ◒

Lease
- Surface & Mining Rights ■
- Surface Rights Only ⬒
- Mining Rights Only ⬓

- Licence of Occupation ▼
- Order-In-Council OC
- Cancelled ⊗
- Reservation Ⓡ
- Sand & Gravel Ⓢ

THE INFORMATION THAT APPEARS ON THIS MAP HAS BEEN COMPILED FROM VARIOUS SOURCES, AND ACCURACY IS NOT GUARANTEED. THOSE WISHING TO STAKE MINING CLAIMS SHOULD CONSULT WITH THE MINING RECORDER, MINISTRY OF NORTHERN DEVELOPMENT AND MINES, FOR ADDITIONAL INFORMATION ON THE STATUS OF THE LANDS SHOWN HEREON.

Ontario
Ministry of Natural Resources
Ministry of Northern Development and Mines

INDEX TO LAND DISPOSITION

PLAN G-1338

TOWNSHIP **JAFFRAY**

M.N.R. ADMINISTRATIVE
KENORA
MINING DIVISION
KENORA
LAND TITLES/REGISTRY
KENORA

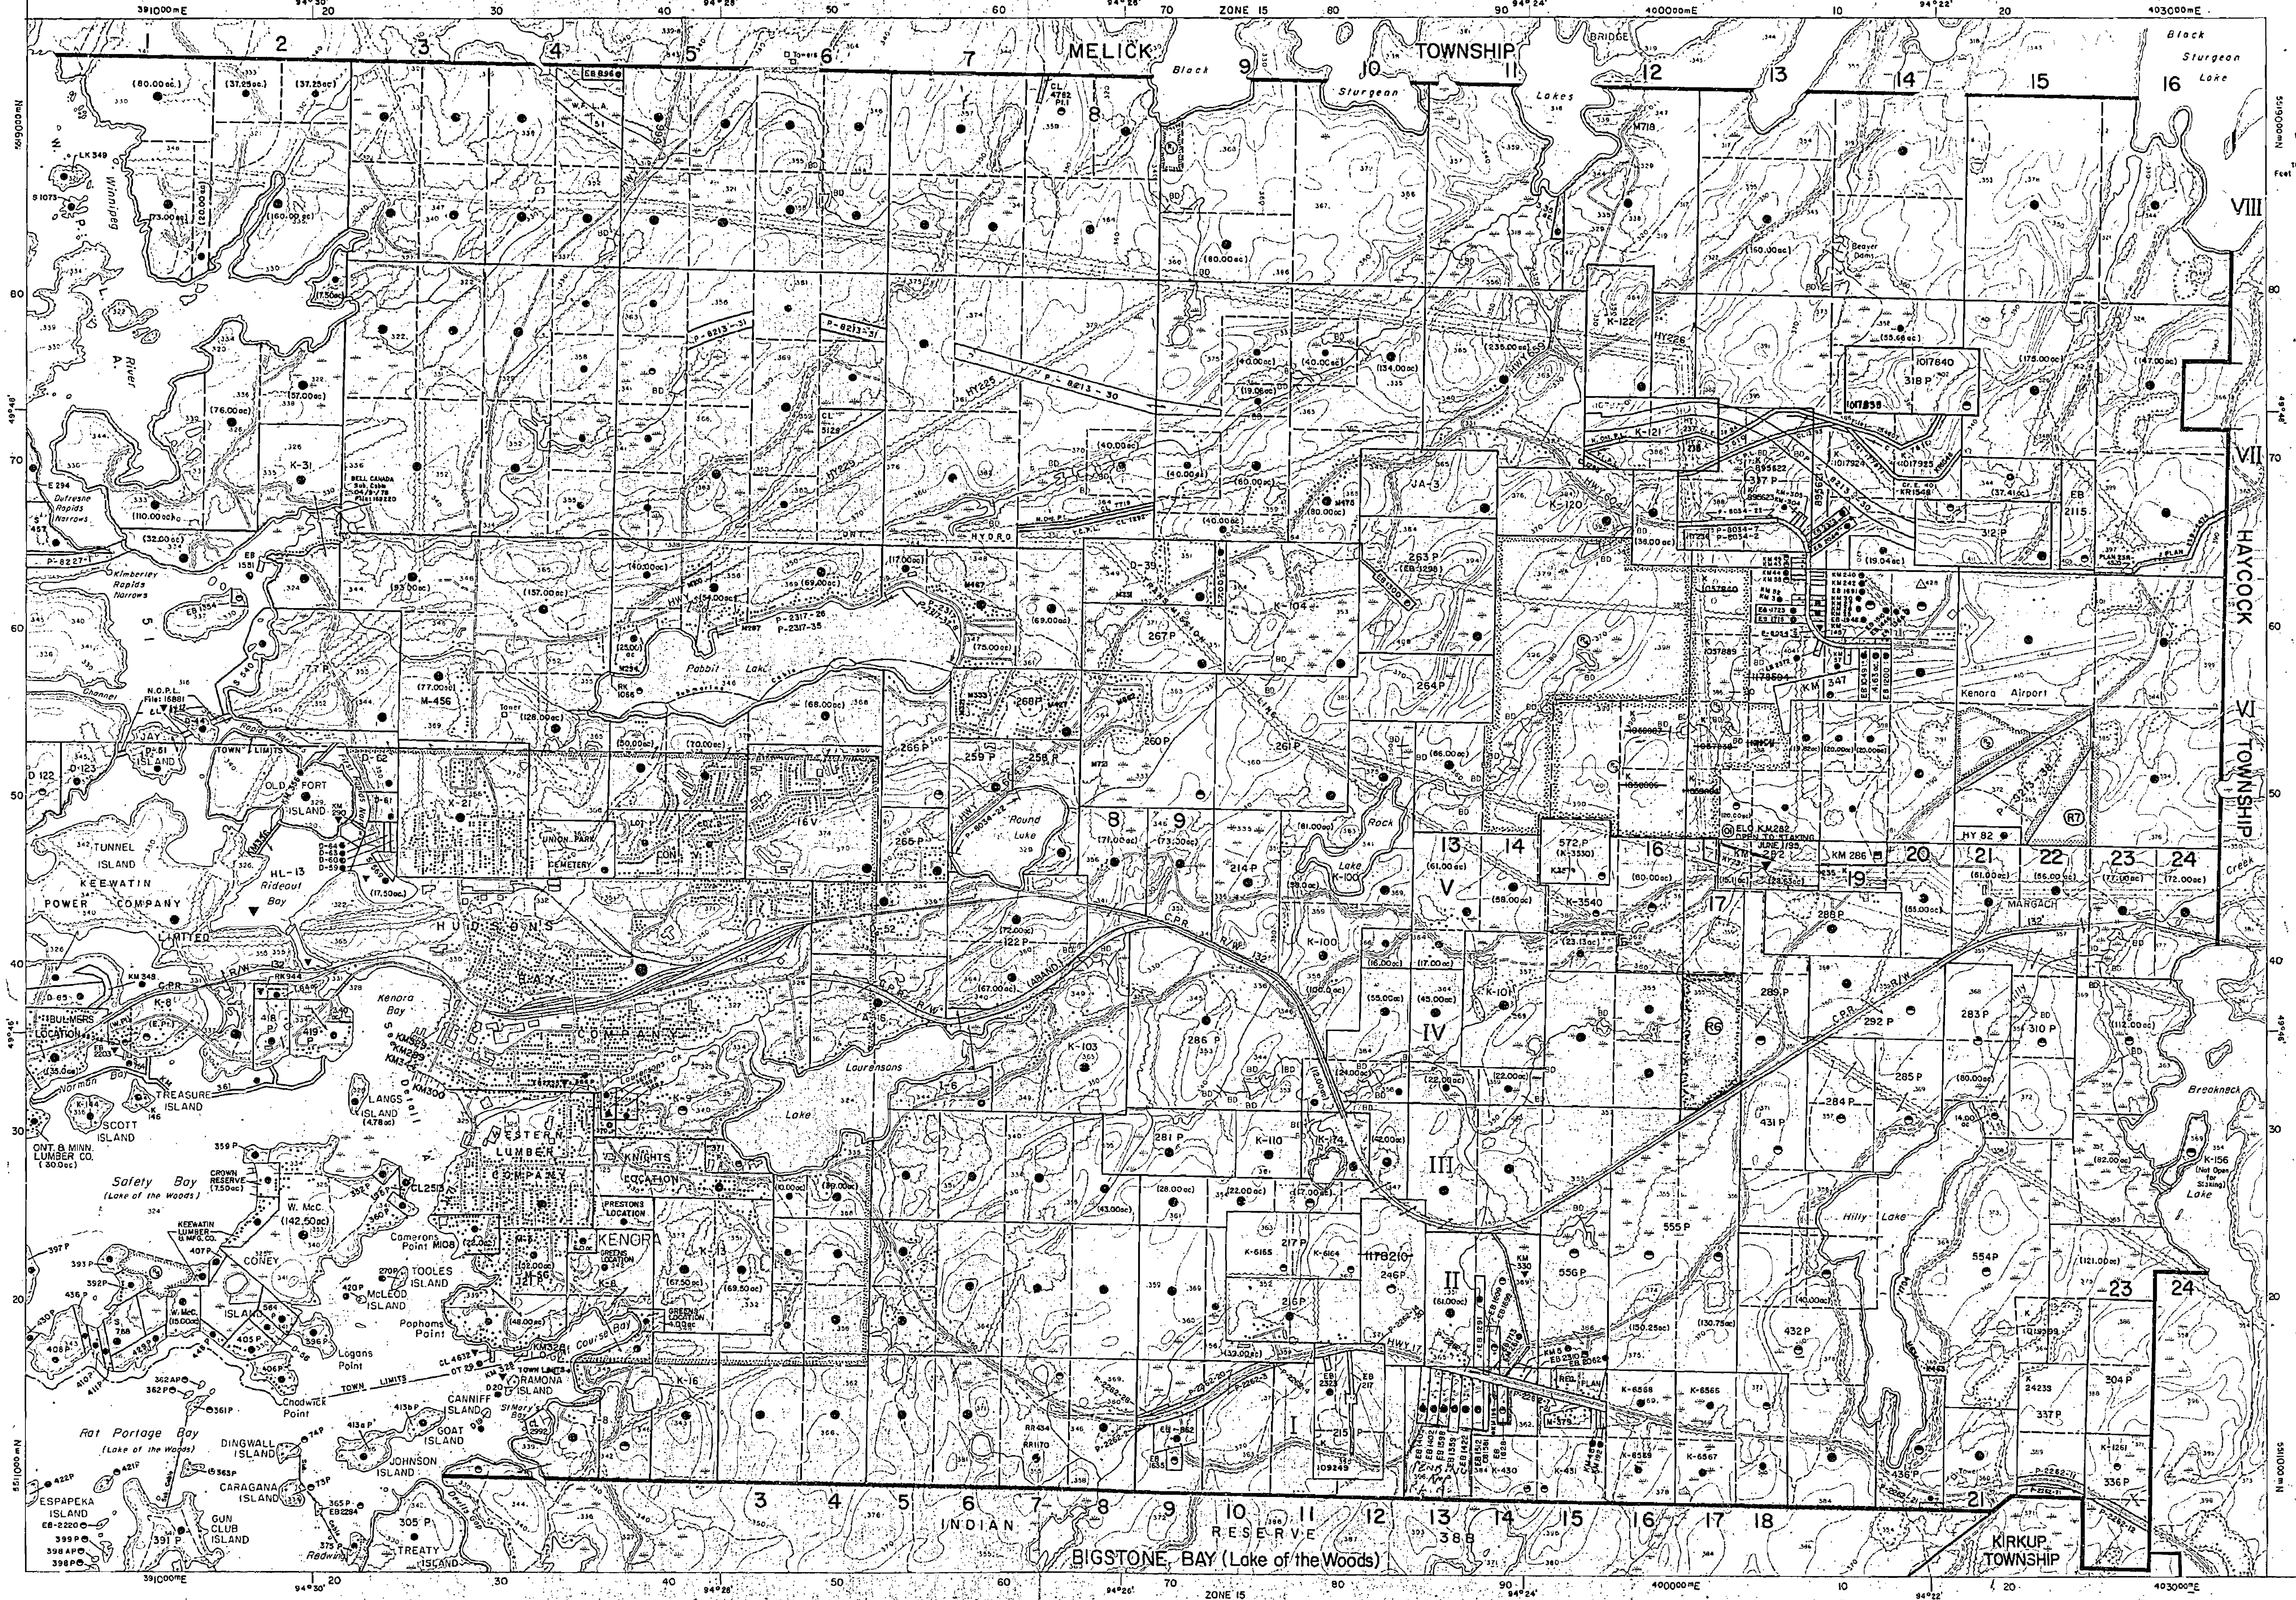

Scale 1:20 000

Metres 1000 0

Feet 1000 0 1000 2000 3000 4000 5000

Contour Interval 10 Metres

AREAS WITHDRAWN FROM DISPOSITIO

MRO - Mining Rights Only
SRO - Surface Rights Only
M + S - Mining and Surface Rights

Description	Order No.	Date	Disposition
(R1) MNR RESERVE			
(R2) SEC. 36/80	W.5/83	5/4/83	SRO
(R3) SEC. 36/80	W.36/88	30/5/88	SRO
(R4) SEC. 36/80	W.37/38	30/5/88	M+S.
(R5) MNR RESERVE			
(R6) MNR RESERVE	W.K-1/95 NWR	19/01/95	MBS

(R7) PENDING DISPOSITION UNDER PUBLIC LANDS ACT ROAD RIGHT-OF-WAY

DATE OF ISSUE

JUN 0 3 1998

PROVINCIAL RECORDING OFFICE - SUDBURY

FLOODING:

ONT. HYDRO FLOODING ON THE WINNIPEG RIVER AND ALCOCK LAKE TO CONTOUR ELEVATION 1045' G.S.C.
W.P.L.A. 51 FILE: 12999

NOTES

ISLANDS AND WATER LOTS, TO THE WEST OF JAFFRAY TWP., IN THE WINNIPEG RIVER AND LAKE OF THE WOODS ARE CLASSIFIED AS UNSURVEYED TERRITORY AND AS SUCH ARE NOT GEOGRAPHICALLY PART OF JAFFRAY TWP.

THE SOUTH, EAST AND WEST BOUNDARIES OF THE TOWNSHIP OF JAFFRAY, BEING PART OF THE CORPORATION OF THE TOWNSHIP OF JAFFRAY AND MELICK, REGULATED BY MUNICIPAL CORPORATIONS QUIETING ORDER DATED JAN. 6, 1956. P.F.C. 7296
(now the TOWN OF JAFFRAY and MELICK)

THE NORTH, EAST AND SOUTH BOUNDARIES OF THE TOWN OF KENORA, REGULATED BY MUNICIPAL CORPORATIONS QUIETING ORDER DATED JUNE 15, 1959. P.F.M. 6508

ISLANDS IN THE WINNIPEG RIVER AND LAKE OF THE WOODS ARE 'NOT OPEN FOR STAKING'

EFFECTIVE AS LINEN

Map base and land disposition drafting by Surveys and Mapping Branch, Ministry of Natural Resources.

The disposition of land, location of lot fabric and parcel boundaries on this index was compiled for administrative purposes only.

PLAN OF

JAFFRAY TWP. M-1992

KENORA MINING DIVISION.

DISTRICT OF KENORA.

Scale, 40 chains to an inch.

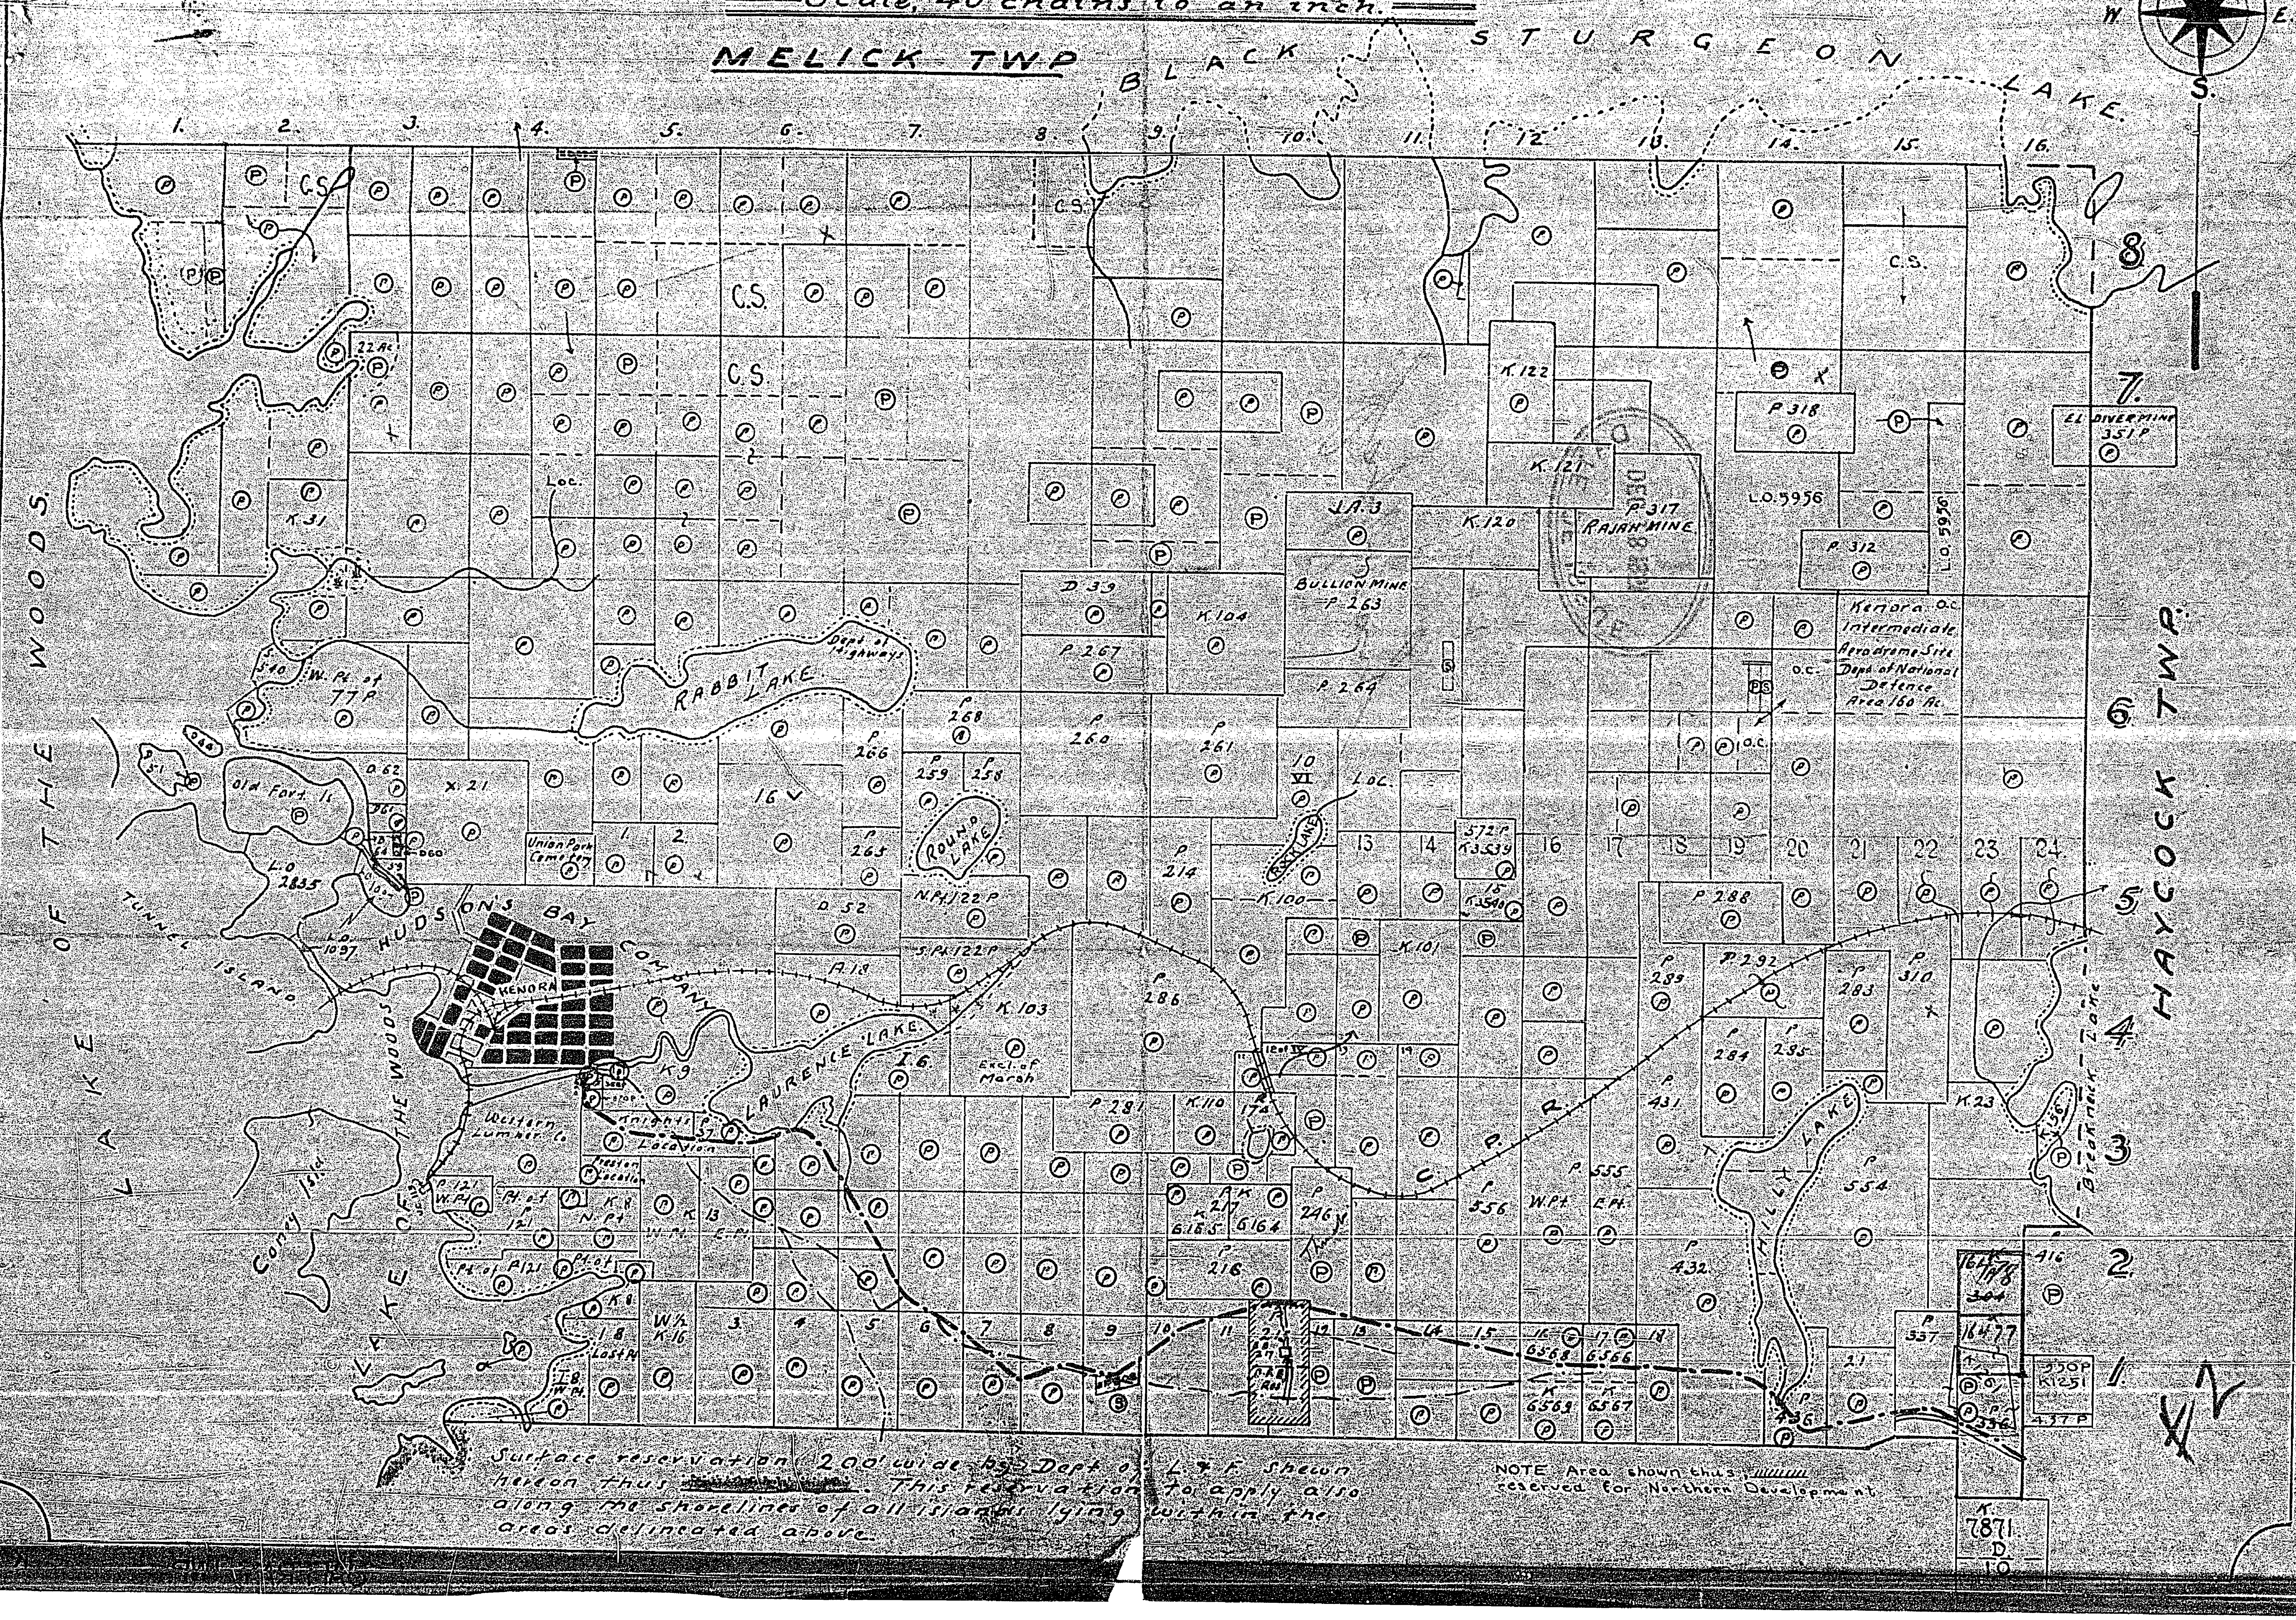

MELICK TWP
BLACK STURGEON LAKE
HAYCOCK TWP
LAKE OF THE WOODS
TUNNEL ISLAND
HUDSON'S BAY COMPANY
KENORA
RABBIT LAKE
Dept of Highways
ROUND LAKE
LAURENCE LAKE
HILLY LAKE
Breakneck Lake
C.P.R.
Old Fort Id.
Coney Isl.
Western Lumber Co.
Knight's Location
Union Park Cemetery
BULLION MINE P. 263
RAJAH MINE P. 317
EL DIVER MINE 351 P
Kenora O.C. Intermediate Aerodrome Site Dept. of National Defence Area 160 Ac.
L.O. 5956
L.O. 2835
L.O. 1097
C.S.
K.122
K.121
K.120
K 31
K 104
K 103
K.100
K 101
K 110
K 23
K 9
J.A. 3
D 39
D 52
P 318
P 312
P 267
P 264
P 260
P 261
P 268
P 266
P 259
P 258
P 265
P 214
P 286
P 288
P 289
P 292
P 310
P 283
P 284
P 285
P 281
P 216
P 431
P 432
P 555
P 556
P 554
P 337
N.Pt.122 P
S.Pt.122 P
W.Pt. of 77 P
K 6563
K 6567
6568
6566
6165
6164
K 7871 D 10
330 P K 1251
N
S
E
W
1.
2.
3.
4.
5.
6.
7.
8.

Surface reservation 200' wide by Dept of L. & F. shewn hereon thus ——. This reservation to apply also along the shorelines of all islands lying within the areas delineated above.

NOTE Area shown thus ////// reserved for Northern Development.

1992

1992

PLAN OF
JAFFRAY TWP.
KENORA MINING DIVISION.
DISTRICT OF KENORA.

Scale, 40 chains to an inch.

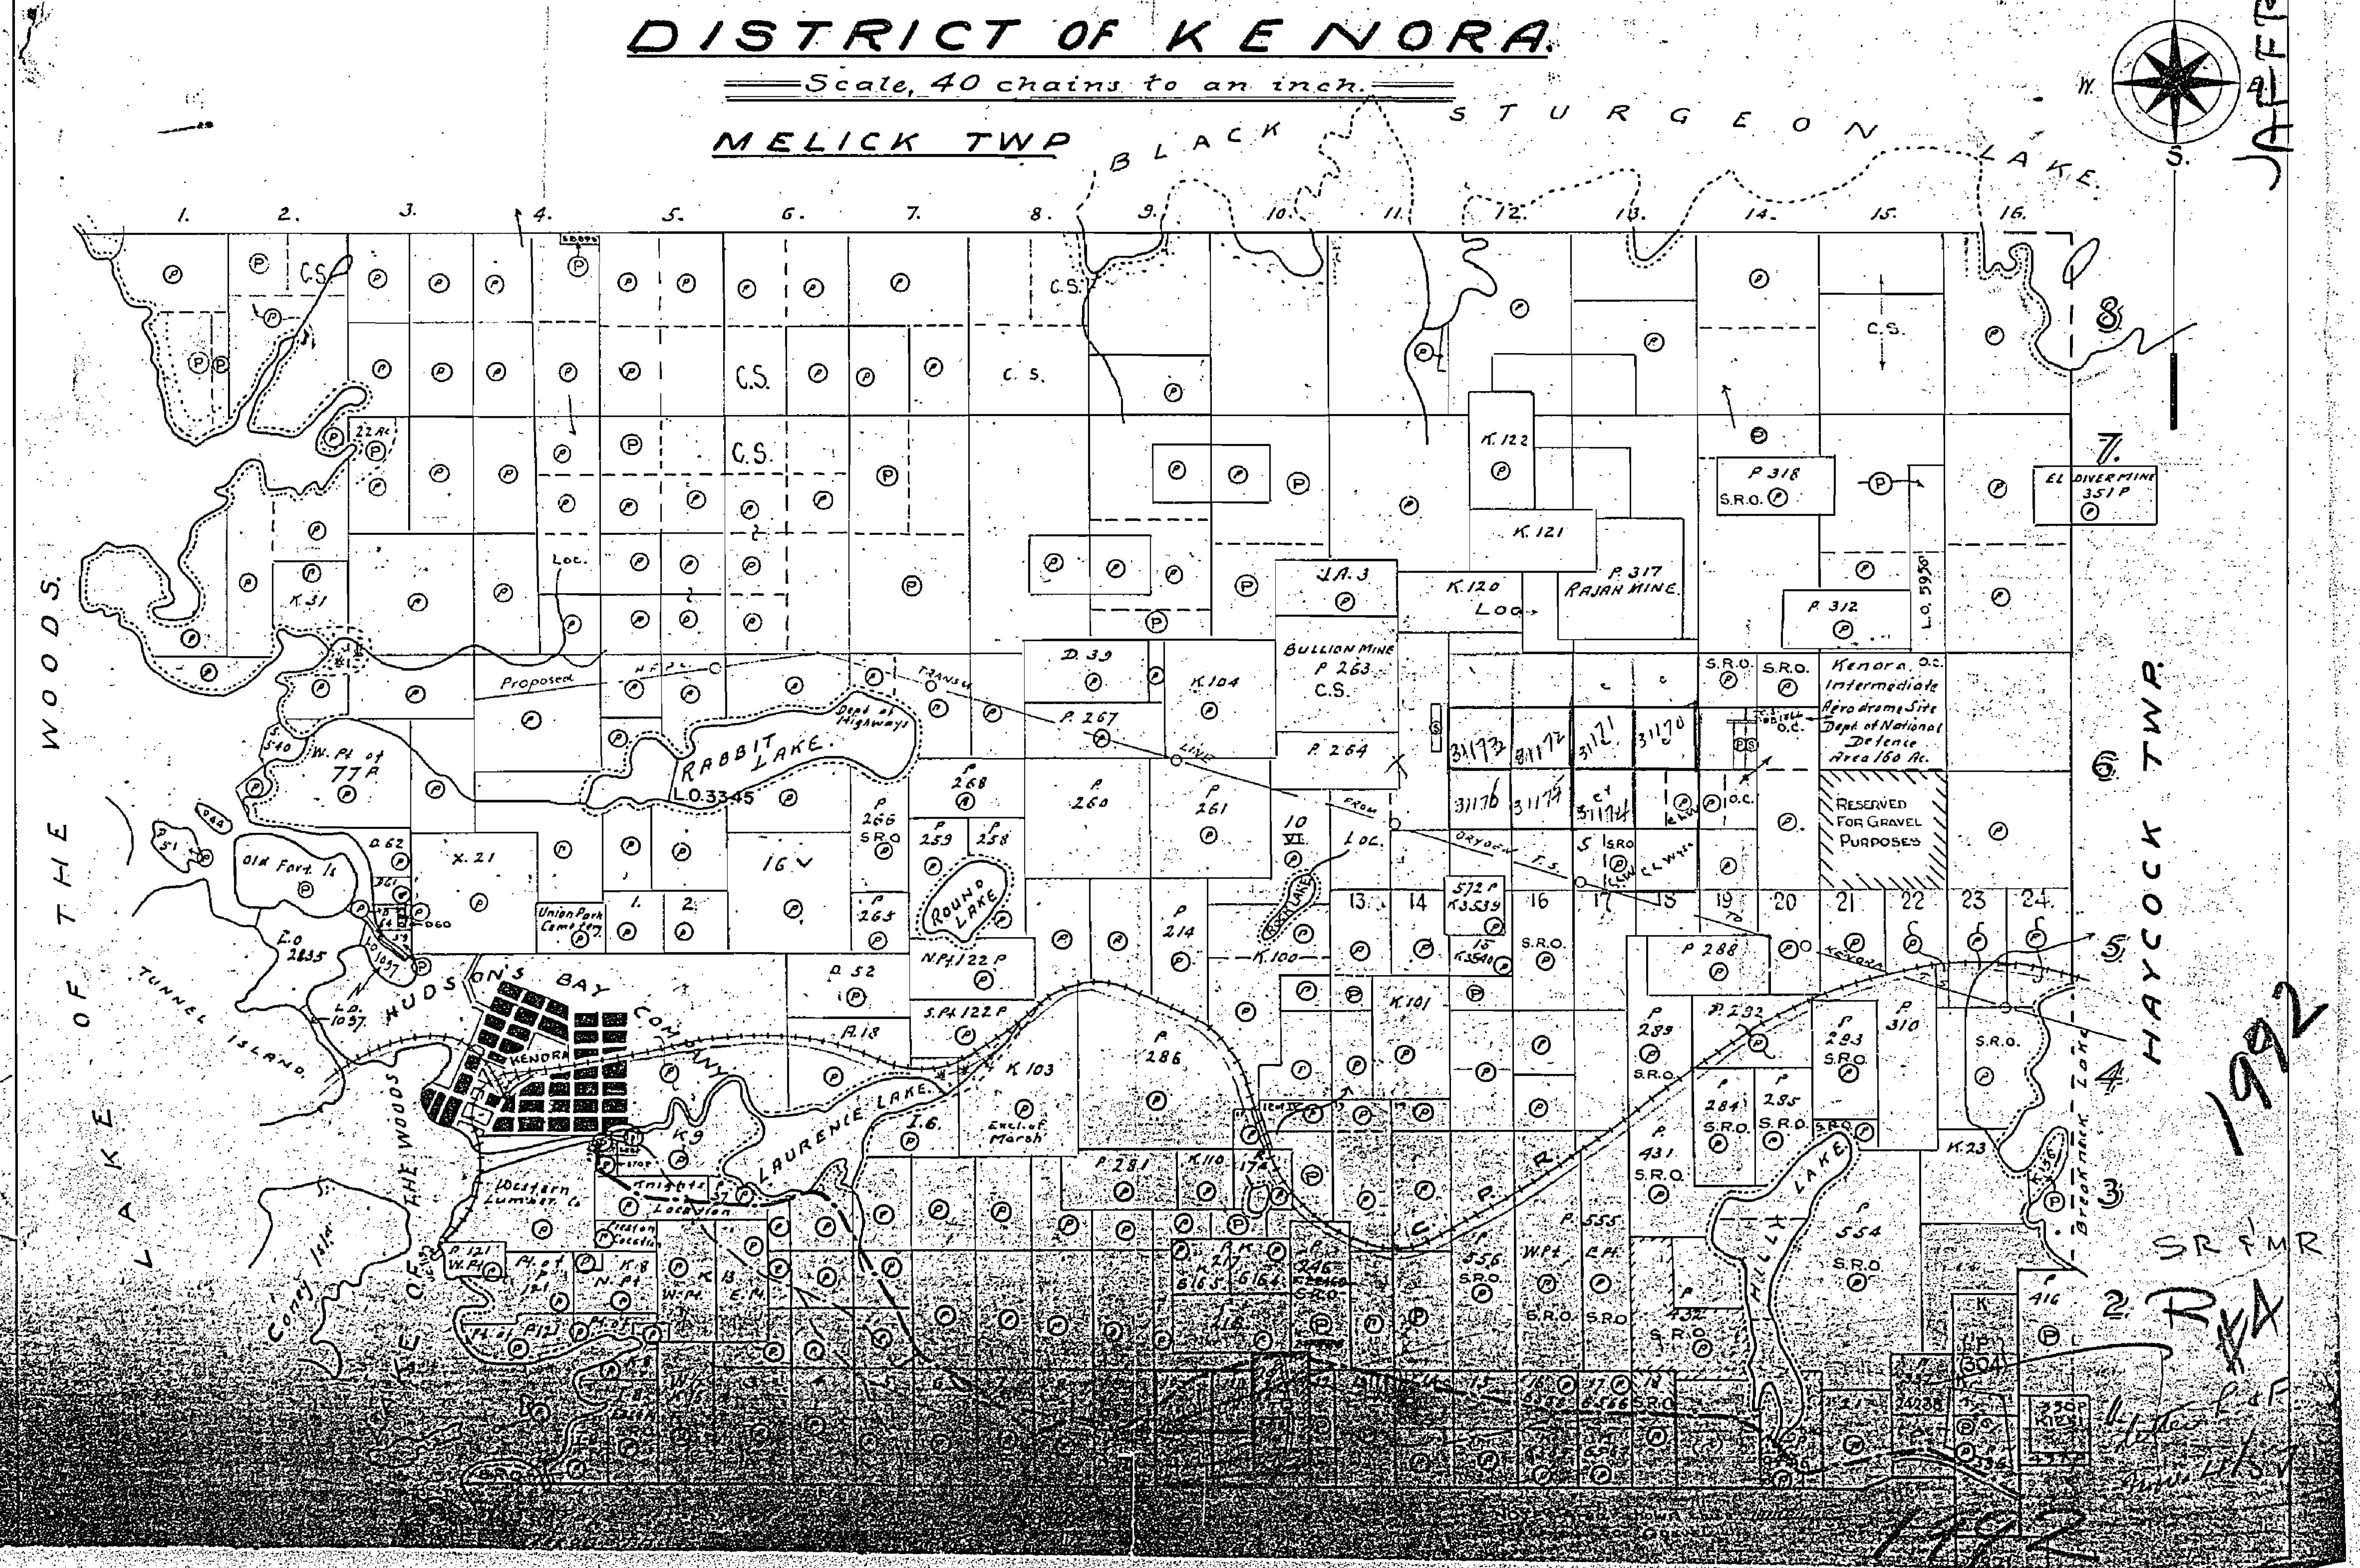

MELICK TWP
BLACK STURGEON LAKE
AST. NORTH
W.
S.
LAKE OF THE WOODS.
HAYCOCK TWP
TUNNEL ISLAND
HUDSON'S BAY COMPANY
KENORA
RABBIT LAKE
L.O. 3345
ROUND LAKE
LAURENCE LAKE
HILLY LAKE
Old Fort I.
W. Pt of 77 P
L.O. 2835
L.O. 1057
Coney Isl.
Western Lumber Co
Union Park Cemetery
Kenora Intermediate Aerodrome Site Dept of National Defence Area 160 Ac.
RESERVED FOR GRAVEL PURPOSES
BULLION MINE P 263 C.S.
P 317 RAJAH MINE
EL DIVER MINE 351 P
Proposed
Dept of Highways
C.P.R.
1. 2. 3. 4. 5. 6. 7. 8. 9. 10. 11. 12. 13. 14. 15. 16.
8 7 6 5 4 3 2
C.S.
S.R.O.
K.31
K.121
K.122
K.120
K.104
K.103
K.101
K.100
K.9
K.23
D.39
D.52
P.267
P.264
P 318
P 312
P 288
P 286
P 281
P 554
P 555
X.21
16

JAFFRAY 1992

1992

SR & MR

1992

1992

1992

PLAN OF
JAFFRAY TWP.

M-1992

KENORA MINING DIVISION.
DISTRICT OF KENORA.

Scale, 40 chains to an inch.

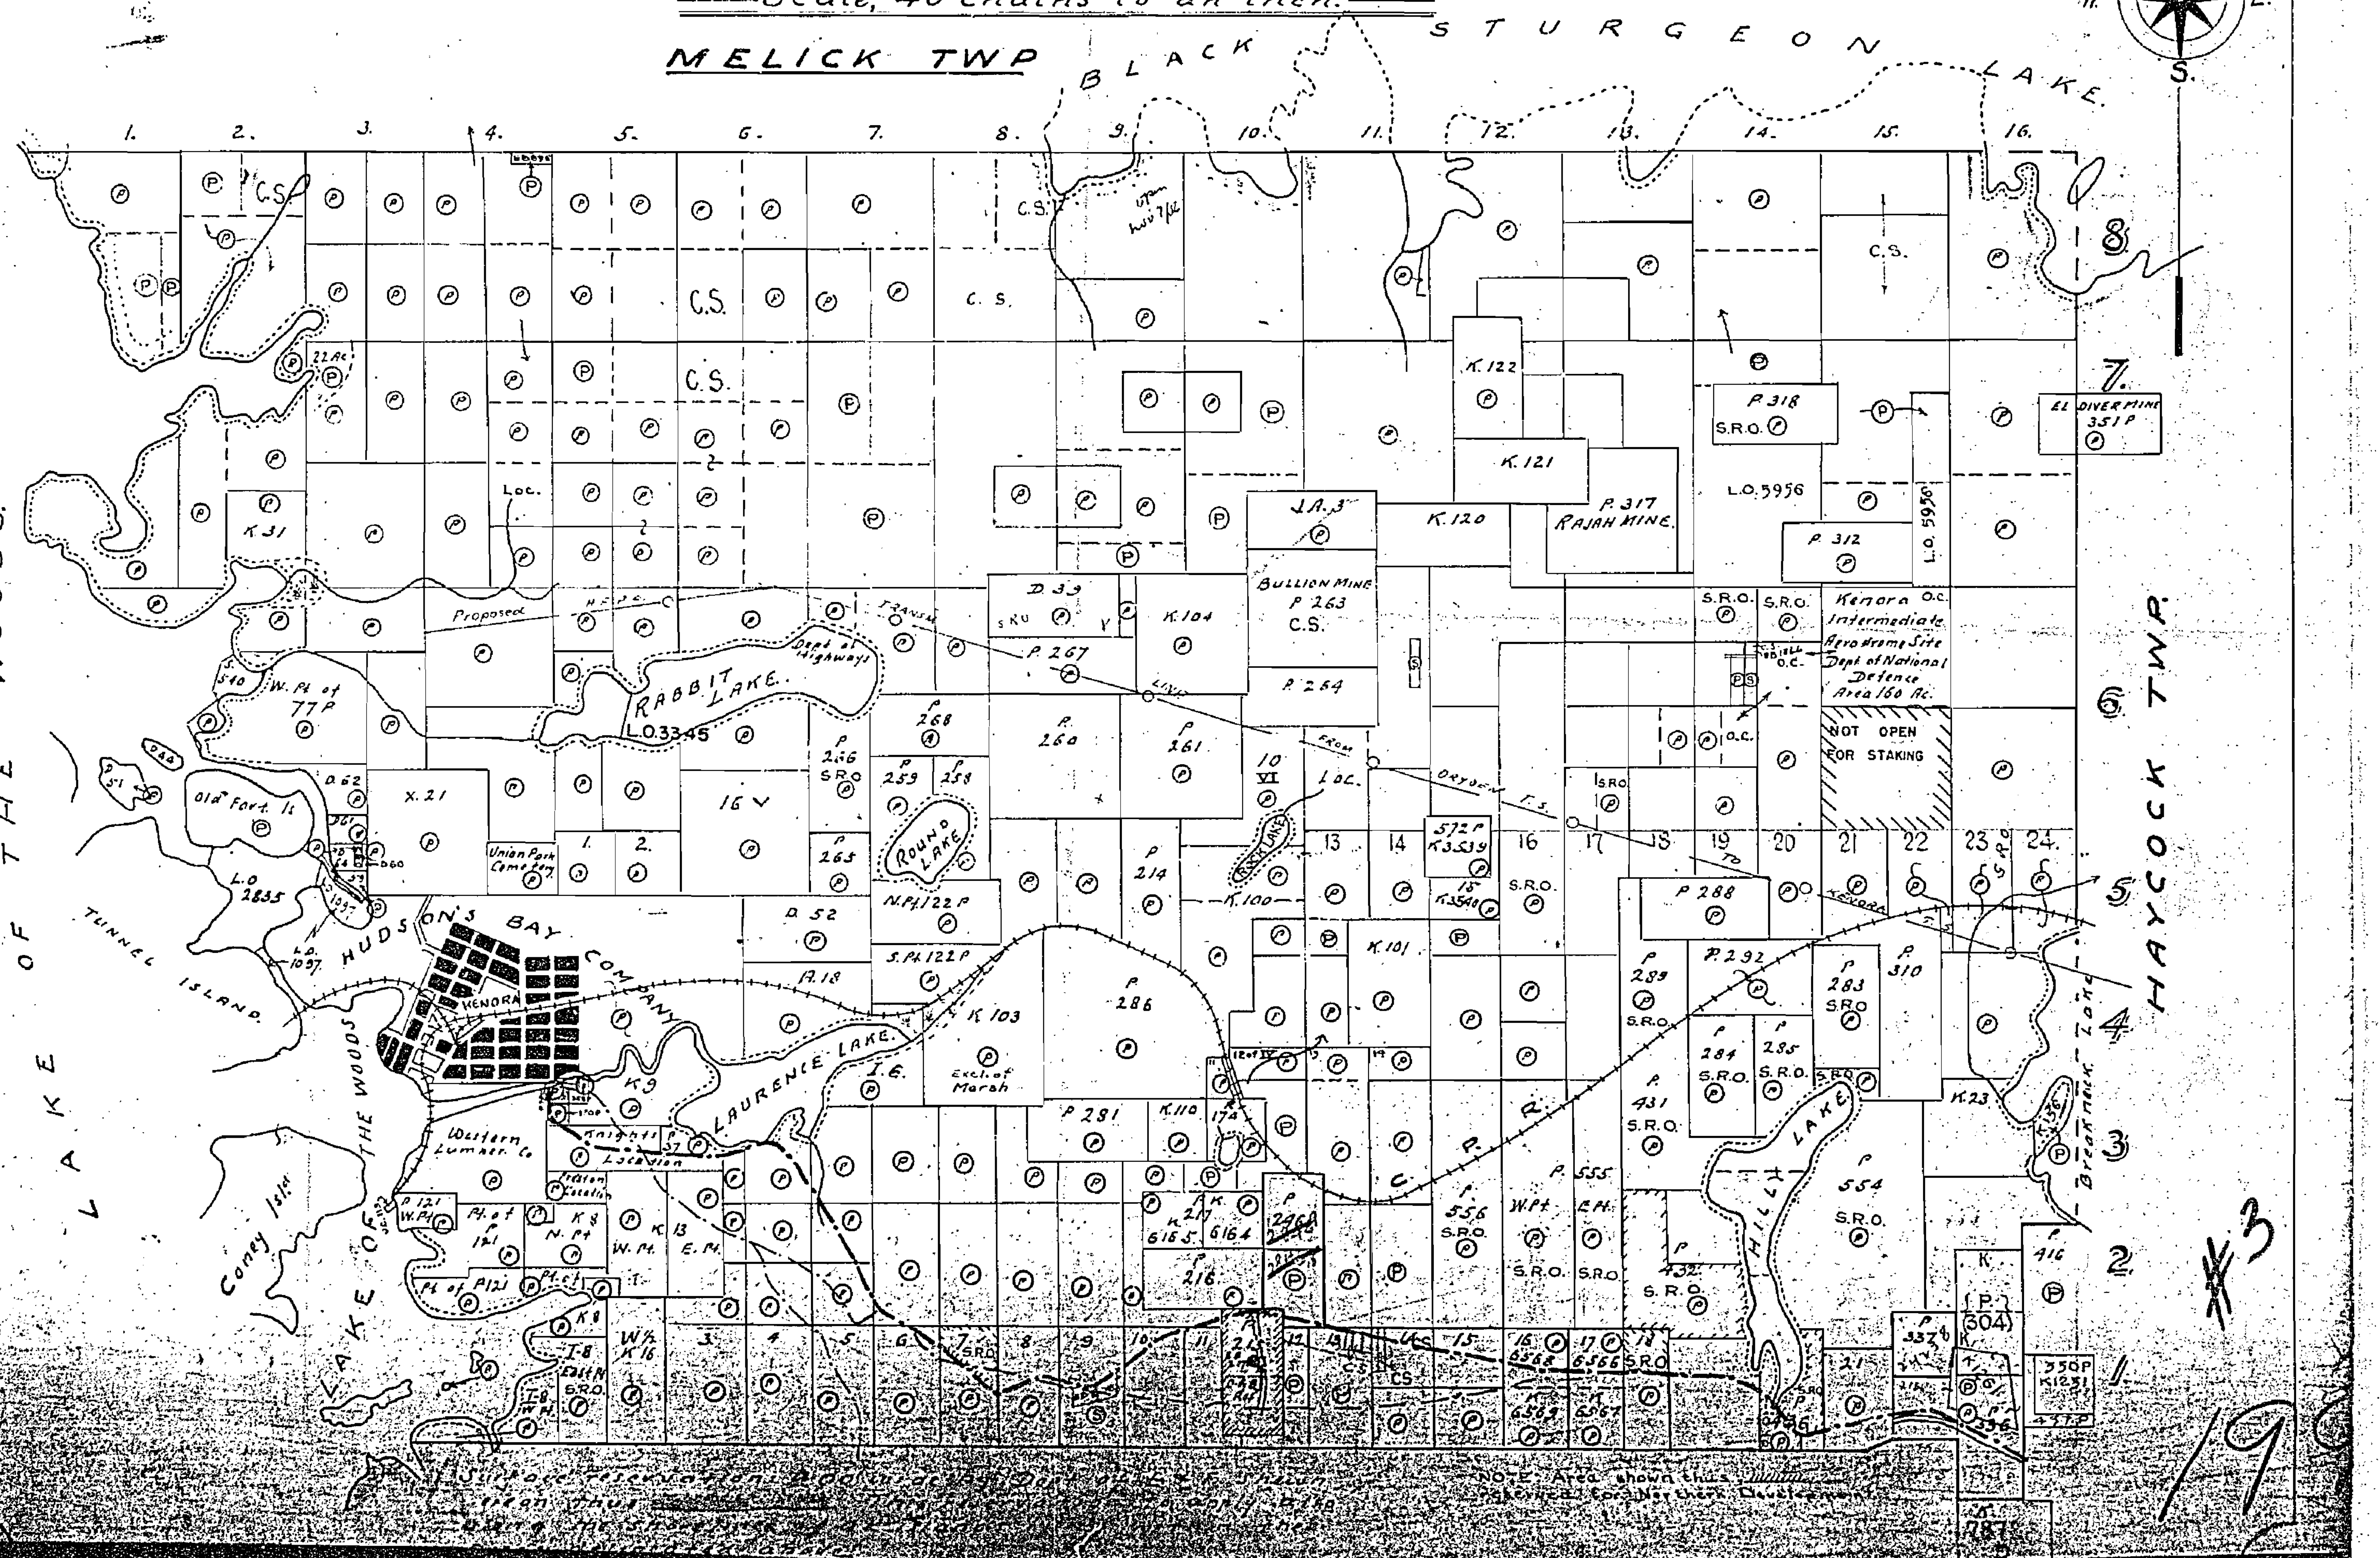

MELICK TWP
BLACK STURGEON LAKE
LAKE OF THE WOODS
HAYCOCK TWP.
TUNNEL ISLAND
HUDSON'S BAY COMPANY
KENORA
RABBIT LAKE
L.O. 3345
Dept. of Highways
ROUND LAKE
LAURENCE LAKE
HILLY LAKE
Breakneck Lake
Old Fort Is.
Coney Isl.
Western Lumber Co.
Knights Location
Union Park Cemetery
Proposed Highway
Trans. Line from Dryden F.S. to Kenora
C.P.R.
BULLION MINE P. 263 C.S.
P. 317 RAJAH MINE
EL DIVER MINE 351 P
Kenora O.C. Intermediate Aerodrome Site Dept. of National Defence Area 160 Ac.
NOT OPEN FOR STAKING
L.O. 5956
L.O. 2835
W. Pt. of 77 P
N. Pt. 122 P
S. Pt. 122 P
Excl. of Marsh
P. 318 S.R.O.
P. 288
P. 554 S.R.O.
K. 31
K. 120
K. 121
K. 122
K. 104
K. 103
K. 101
K. 100
K. 9
K. 23
X. 21
D. 39
P. 267
P. 264
P. 281
P. 286
P. 292
P. 310
P. 312
P. 52
P. 416
C.S.
1. 2. 3. 4. 5. 6. 7. 8. 9. 10. 11. 12. 13. 14. 15. 16.
1 2 3 4 5 6 7 8
W. N. E. S.
NOTE: Area shown thus reserved for Northern Development
Surface reservation

#3

19

PLAN OF

JAFFRAY TWP.

M-1992

KENORA MINING DIVISION.

DISTRICT OF KENORA.

Scale, 40 chains to an inch.

1992

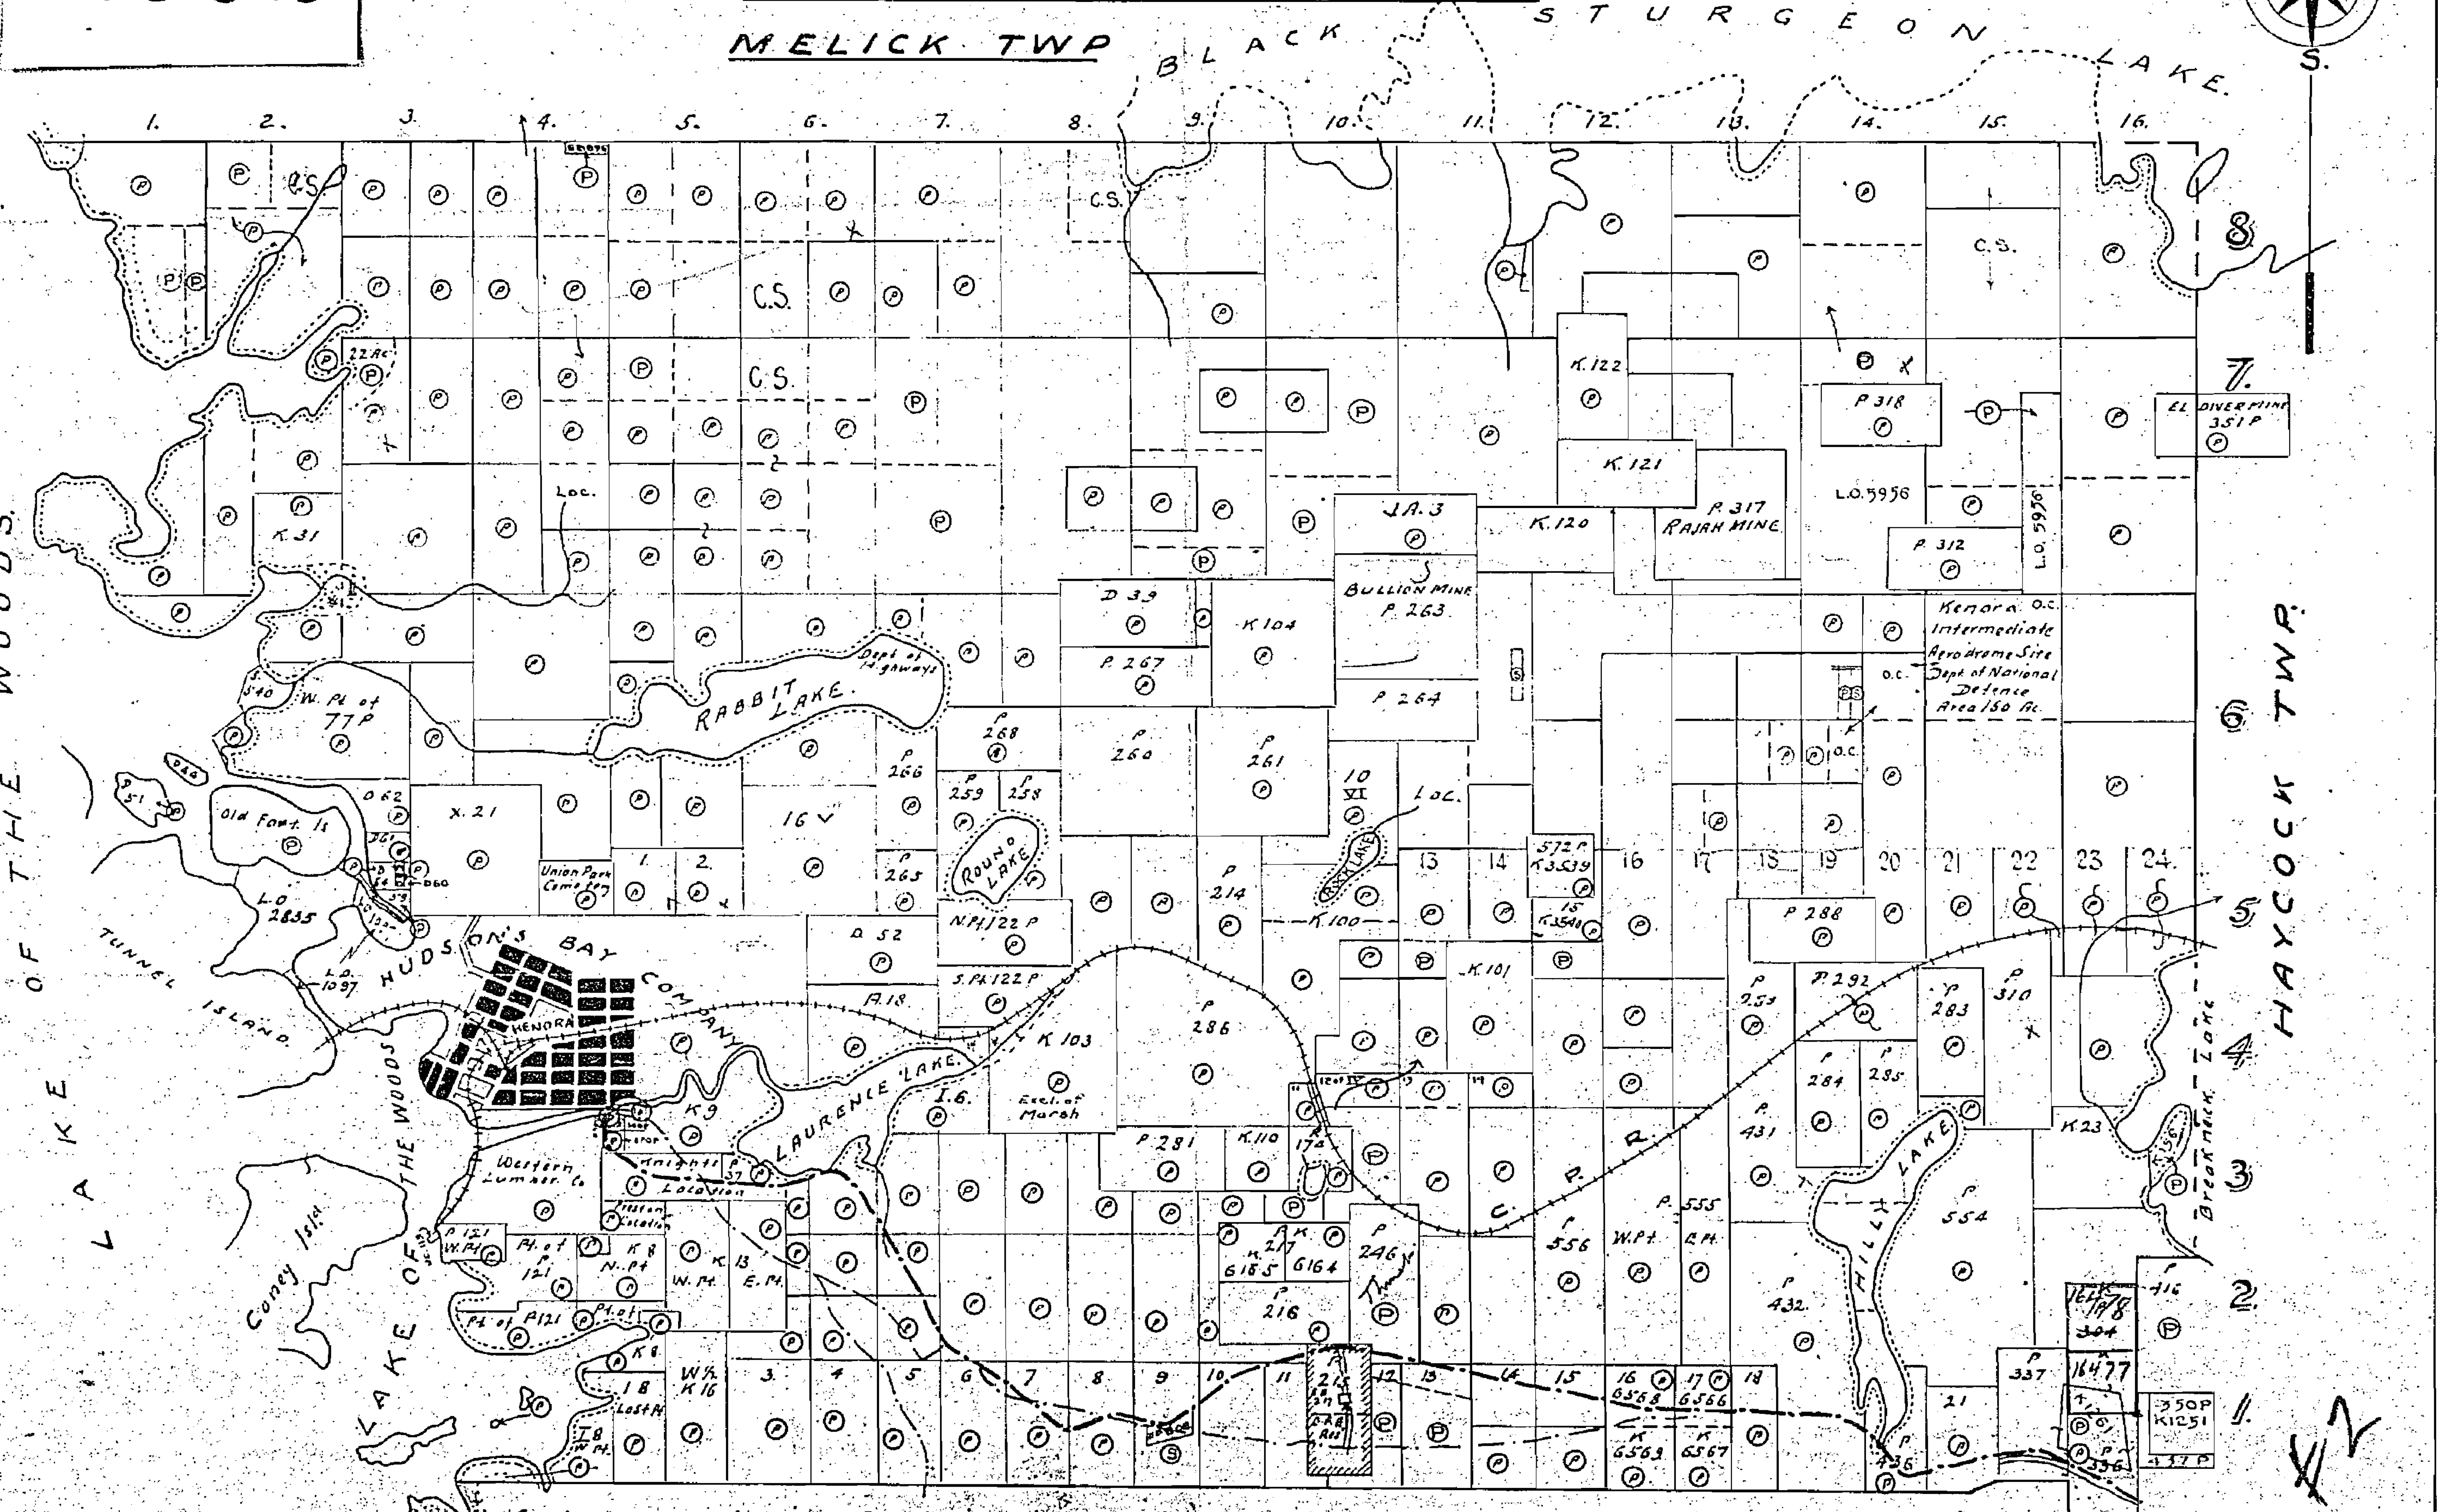

MELICK TWP
BLACK STURGEON LAKE
AST. NORTH
W.
E.
S.
LAKE OF THE WOODS
HAYCOCK TWP
TUNNEL ISLAND
HUDSON'S BAY COMPANY
KENORA
RABBIT LAKE
Dept of Highways
ROUND LAKE
LAURENCE LAKE
HILL LAKE
Bracknell Lake
Coney Isl'd
Old Fort Is
Western Lumber Co
Knights Location
Union Park Cemetery
C.P.R.
BULLION MINE P. 263
RAJAH MINE P. 317
EL DIVER MINE 351 P
Kenora O.C. Intermediate Aerodrome Site Dept of National Defence Area 150 Ac.
L.O. 5956
L.O. 2835
L.O. 1097
W. Pt. of 77 P
X. 21
K. 31
K. 122
K. 121
K. 120
K. 104
K. 103
K. 100
K. 101
K. 110
K9
K23
JA. 3
D 39
D 52
P. 267
P. 264
P. 260
P. 261
P. 268
P. 259
P. 258
P. 266
P. 265
N. Pt. 122 P
S. Pt. 122 P
P. 214
P. 286
P. 281
P. 246
P. 216
P. 288
P. 292
P. 283
P. 310
P. 284
P. 285
P. 253
P. 431
P. 432
P. 556
P. 555
P. 554
P. 416
P. 337
P. 318
P. 312
P 121
K 7871 D 10
16477
K1251
C.S.
Loc.
1 2 3 4 5 6 7 8 9 10 11 12 13 14 15 16
1 2 3 4 5 6 7 8

Surface reservations 200' wide by Dept of L. & F. shown hereon thus .... This reservation to apply also along the shorelines of all islands lying within the areas delineated above.

NOTE Area shown thus ////// reserved for Northern Development

1992

PLAN OF

JAFFRAY TWP.

M-1992

KENORA MINING DIVISION.

DISTRICT OF KENORA.

Scale, 40 chains to an inch.

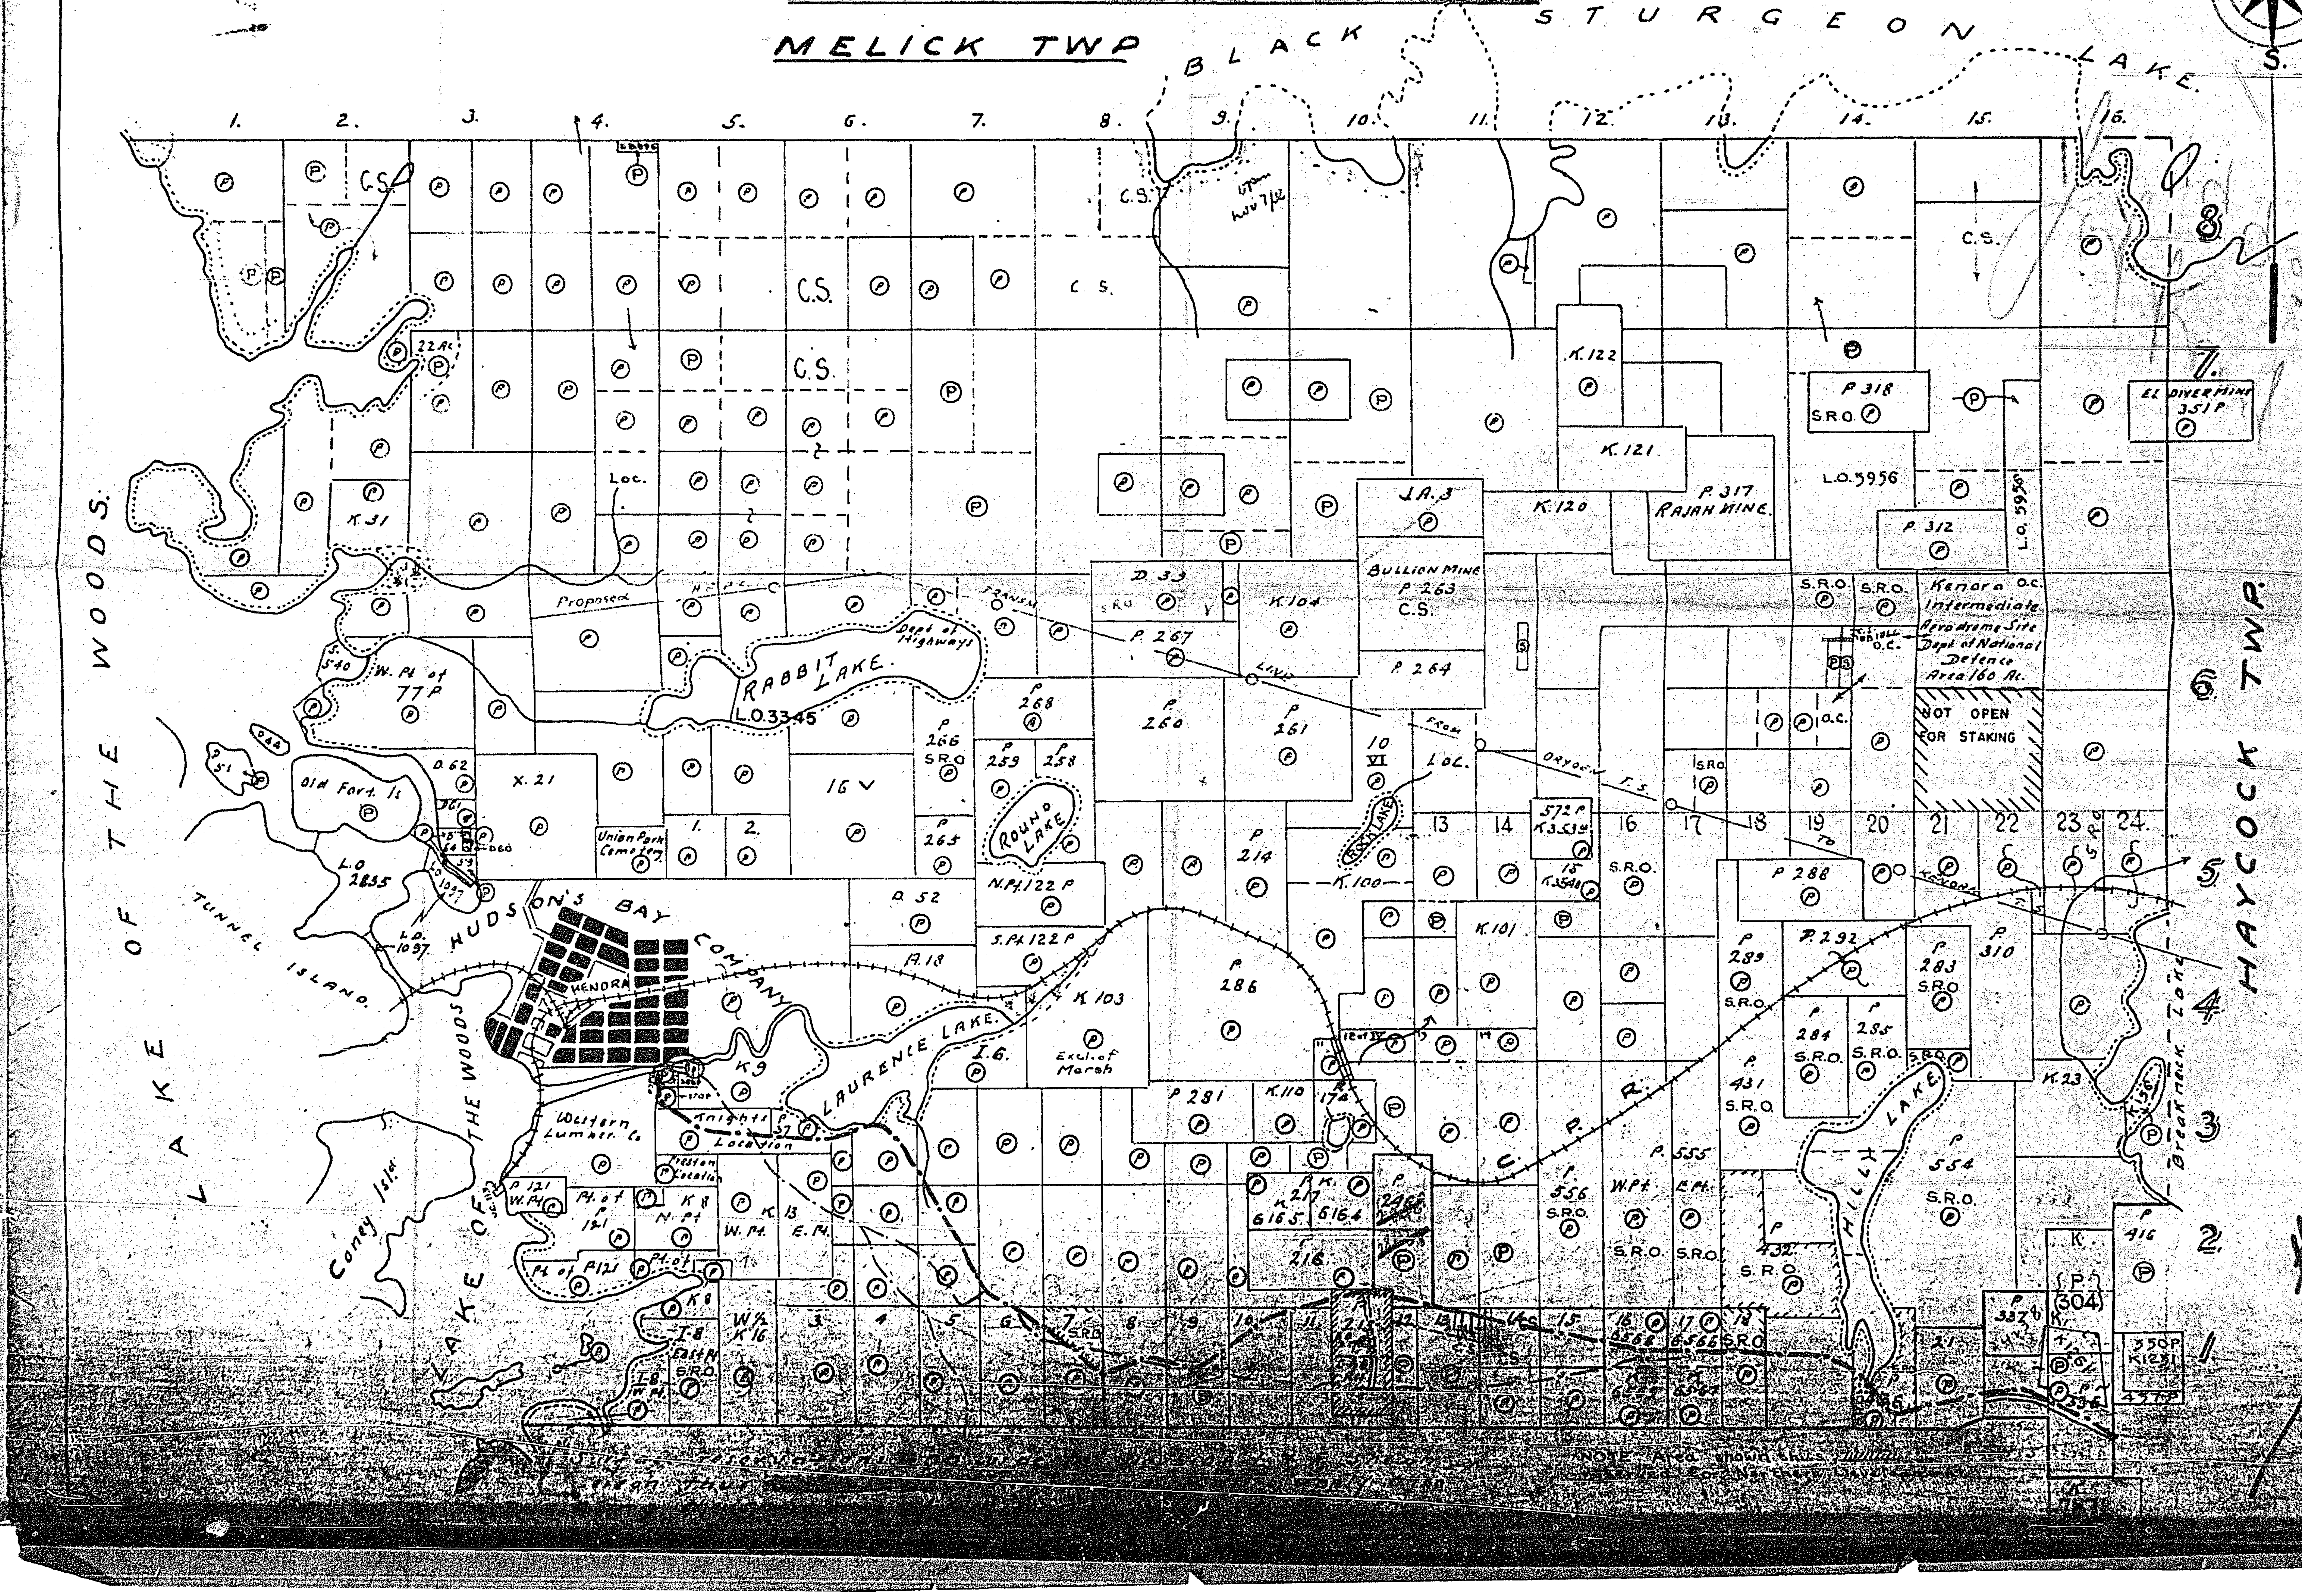

MELICK TWP
BLACK STURGEON LAKE
HAYCOCK TWP.
LAKE OF THE WOODS
N.
E.
S.
W.
Ast. North
RABBIT LAKE
L.O. 3345
ROUND LAKE
LAURENCE LAKE
HILLY LAKE
Old Fort Is.
TUNNEL ISLAND
Coney Isle
HUDSON'S BAY COMPANY
KENORA
Western Lumber Co.
C.P.R.
Proposed
Dept of Highways
BULLION MINE P. 263
RAJAH MINE P 317
EL DIVER MINE 351 P
Kenora O.C. Intermediate Aerodrome Site Dept of National Defence Area 160 Ac.
NOT OPEN FOR STAKING
Union Park Cemetery
Excl. of Marsh
Break neck Lake
FROM DRYDEN T.S. TO KENORA
C.S.
K.31
K.104
K.120
K.121
K.122
K.100
K.101
K.103
K.110
K.23
J.A.3
D.33
D.52
D.62
X.21
A.18
I.6
L.O. 5956
L.O. 2835
L.O. 1097
P. 312
P. 318
P. 267
P. 264
P. 260
P. 261
P. 286
P. 281
P. 288
P. 292
P. 289
P. 283
P. 284
P. 285
P. 310
P. 431
P. 554
P. 555
P. 556
P. 416
P. 304
W. Pt. of 77 P
N.Pt. 122 P
S.Pt. 122 P
1. 2. 3. 4. 5. 6. 7. 8. 9. 10. 11. 12. 13. 14. 15. 16.
1 2 3 4 5 6 7 8

#3

19

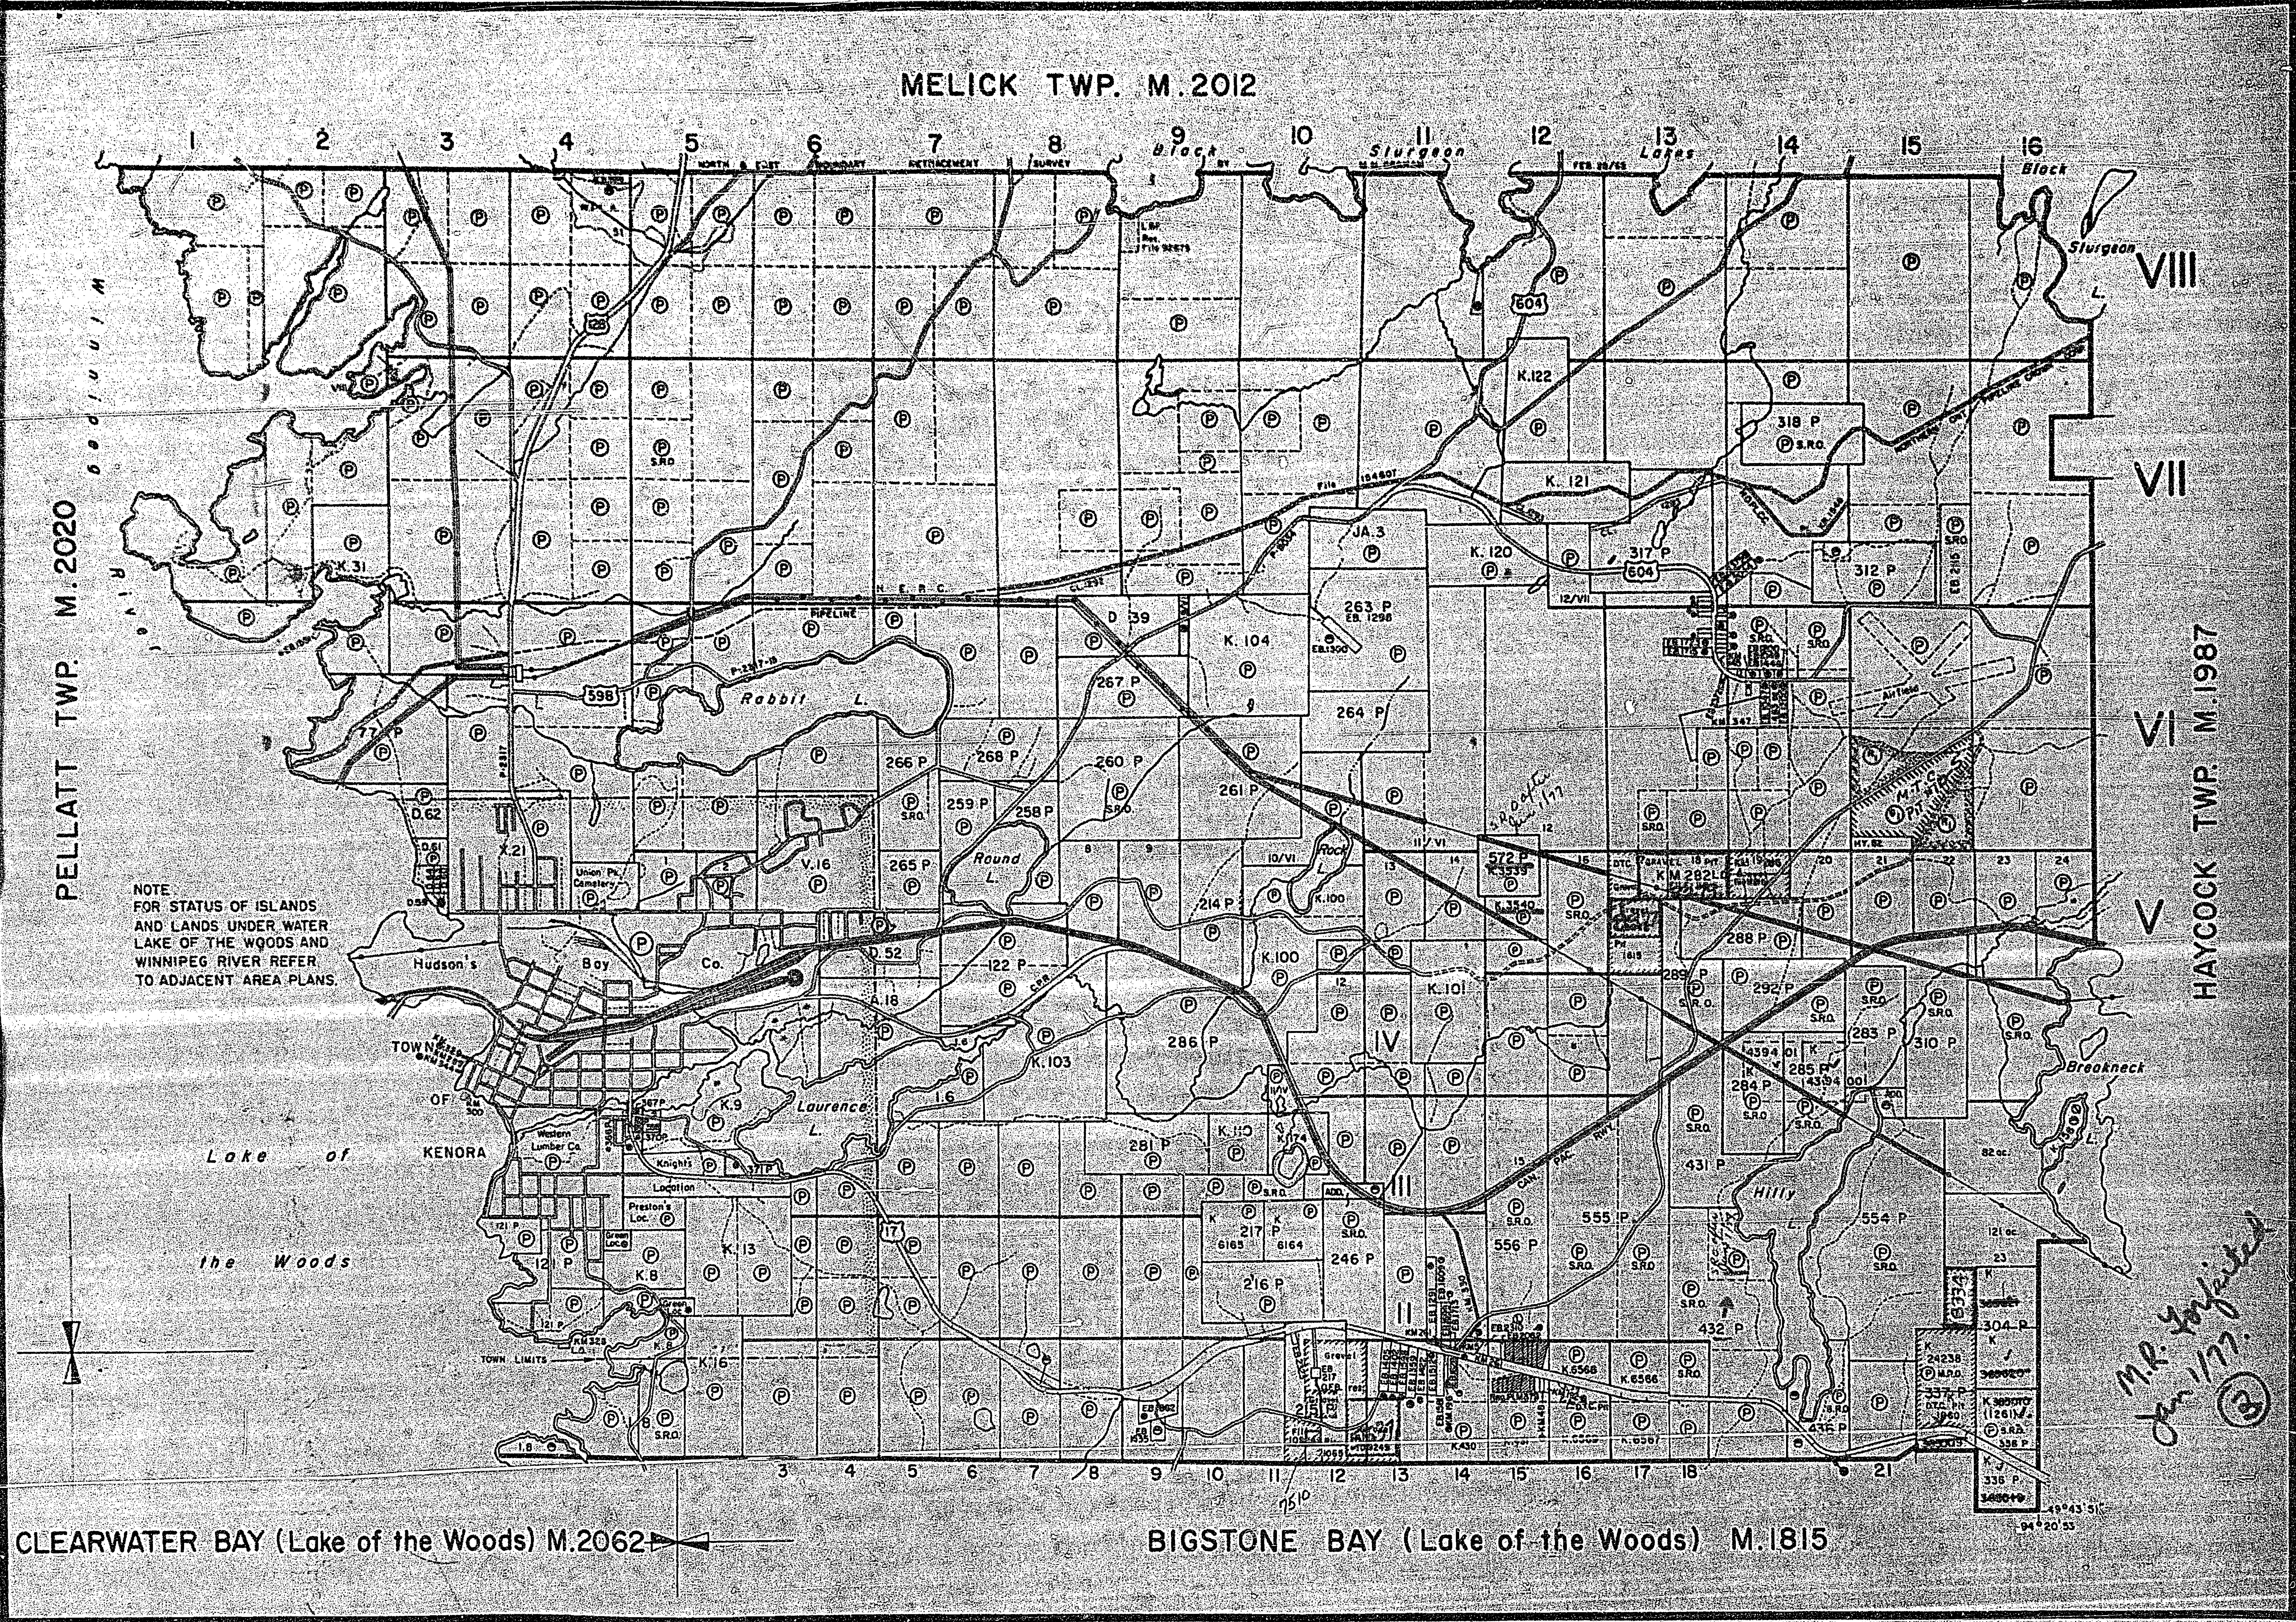
MELICK TWP. M.2012
PELLATT TWP. M.2020
HAYCOCK TWP. M.1987
CLEARWATER BAY (Lake of the Woods) M.2062
BIGSTONE BAY (Lake of the Woods) M.1815
Winnipeg River
Rabbit L.
Round L.
Rock L.
Laurence L.
Hilly L.
Breakneck L.
Sturgeon L.
Hudson's Bay Co.
TOWN OF KENORA
Lake of the Woods
Western Lumber Co.
Union Pt. Cemetery
Block Sturgeon Lakes
TOWN LIMITS
Air Field
NOTE. FOR STATUS OF ISLANDS AND LANDS UNDER WATER LAKE OF THE WOODS AND WINNIPEG RIVER REFER TO ADJACENT AREA PLANS.
VIII
VII
VI
V
IV
III
II
49°43'51"
94°20'53"
M.R. Forfeited Jan 1/77.
③

NOTES

400' surface rights reservation along the shores of all lakes and rivers.

Flooding rights reserved on Winnipeg River and Alcock Lake to contour elev. 1051.20' G.S.C. Jan. 23/40. File 4922 vol. 5

H.E.P.C. flooding rights on Winnipeg River and Alcock Lake to contour elev. 1045' G.S.C. W.P.L.A. 51 File 12999

Ⓡ S.R.O. RESERVED FOR REFORESTATION FILE: 97164.

Ⓡ SAND & GRAVEL RESERVE FILE: 97164

Mining Rights on K3540 ~~K3539~~ Thrown open for Staking on June 1/77

DATE OF ISSUE AUG 25 1976

KENORA MINING DIV. RECEIVED AUG 31 197 AM 7,8,9,10,11,12,1,2,3

LEGEND

PATENTED LAND	Ⓟ or ●†
PATENTED FOR SURFACE RIGHTS ONLY	◓†
LEASE	Ⓛ
LICENSE OF OCCUPATION	L.O.
CROWN LAND SALES	C.S.
LOCATED LAND	Loc.
CANCELLED	C.
NOT THROWN OPEN FOR STAKING	⊘
MINING RIGHTS ONLY	M.R.O.
SURFACE RIGHTS ONLY	S.R.O.
HIGHWAY & ROUTE NO.	17
ROADS	═
TRAILS	----
RAILWAYS	┼┼┼
POWER LINES	─•─
MARSH OR MUSKEG	
MINES	⚒

† used only with summer resort locations or when space is limited.

TOWNSHIP OF

JAFFRAY

DISTRICT OF
KENORA

KENORA
MINING DIVISION

#10

SCALE: 1 INCH = 40 CHAINS (1/2 MILE)

DR. D.T.
DATE JULY/71
PLAN NO. M.1992

ONTARIO
MINISTRY OF NATURAL RESOURCES
SURVEYS AND MAPPING BRANCH

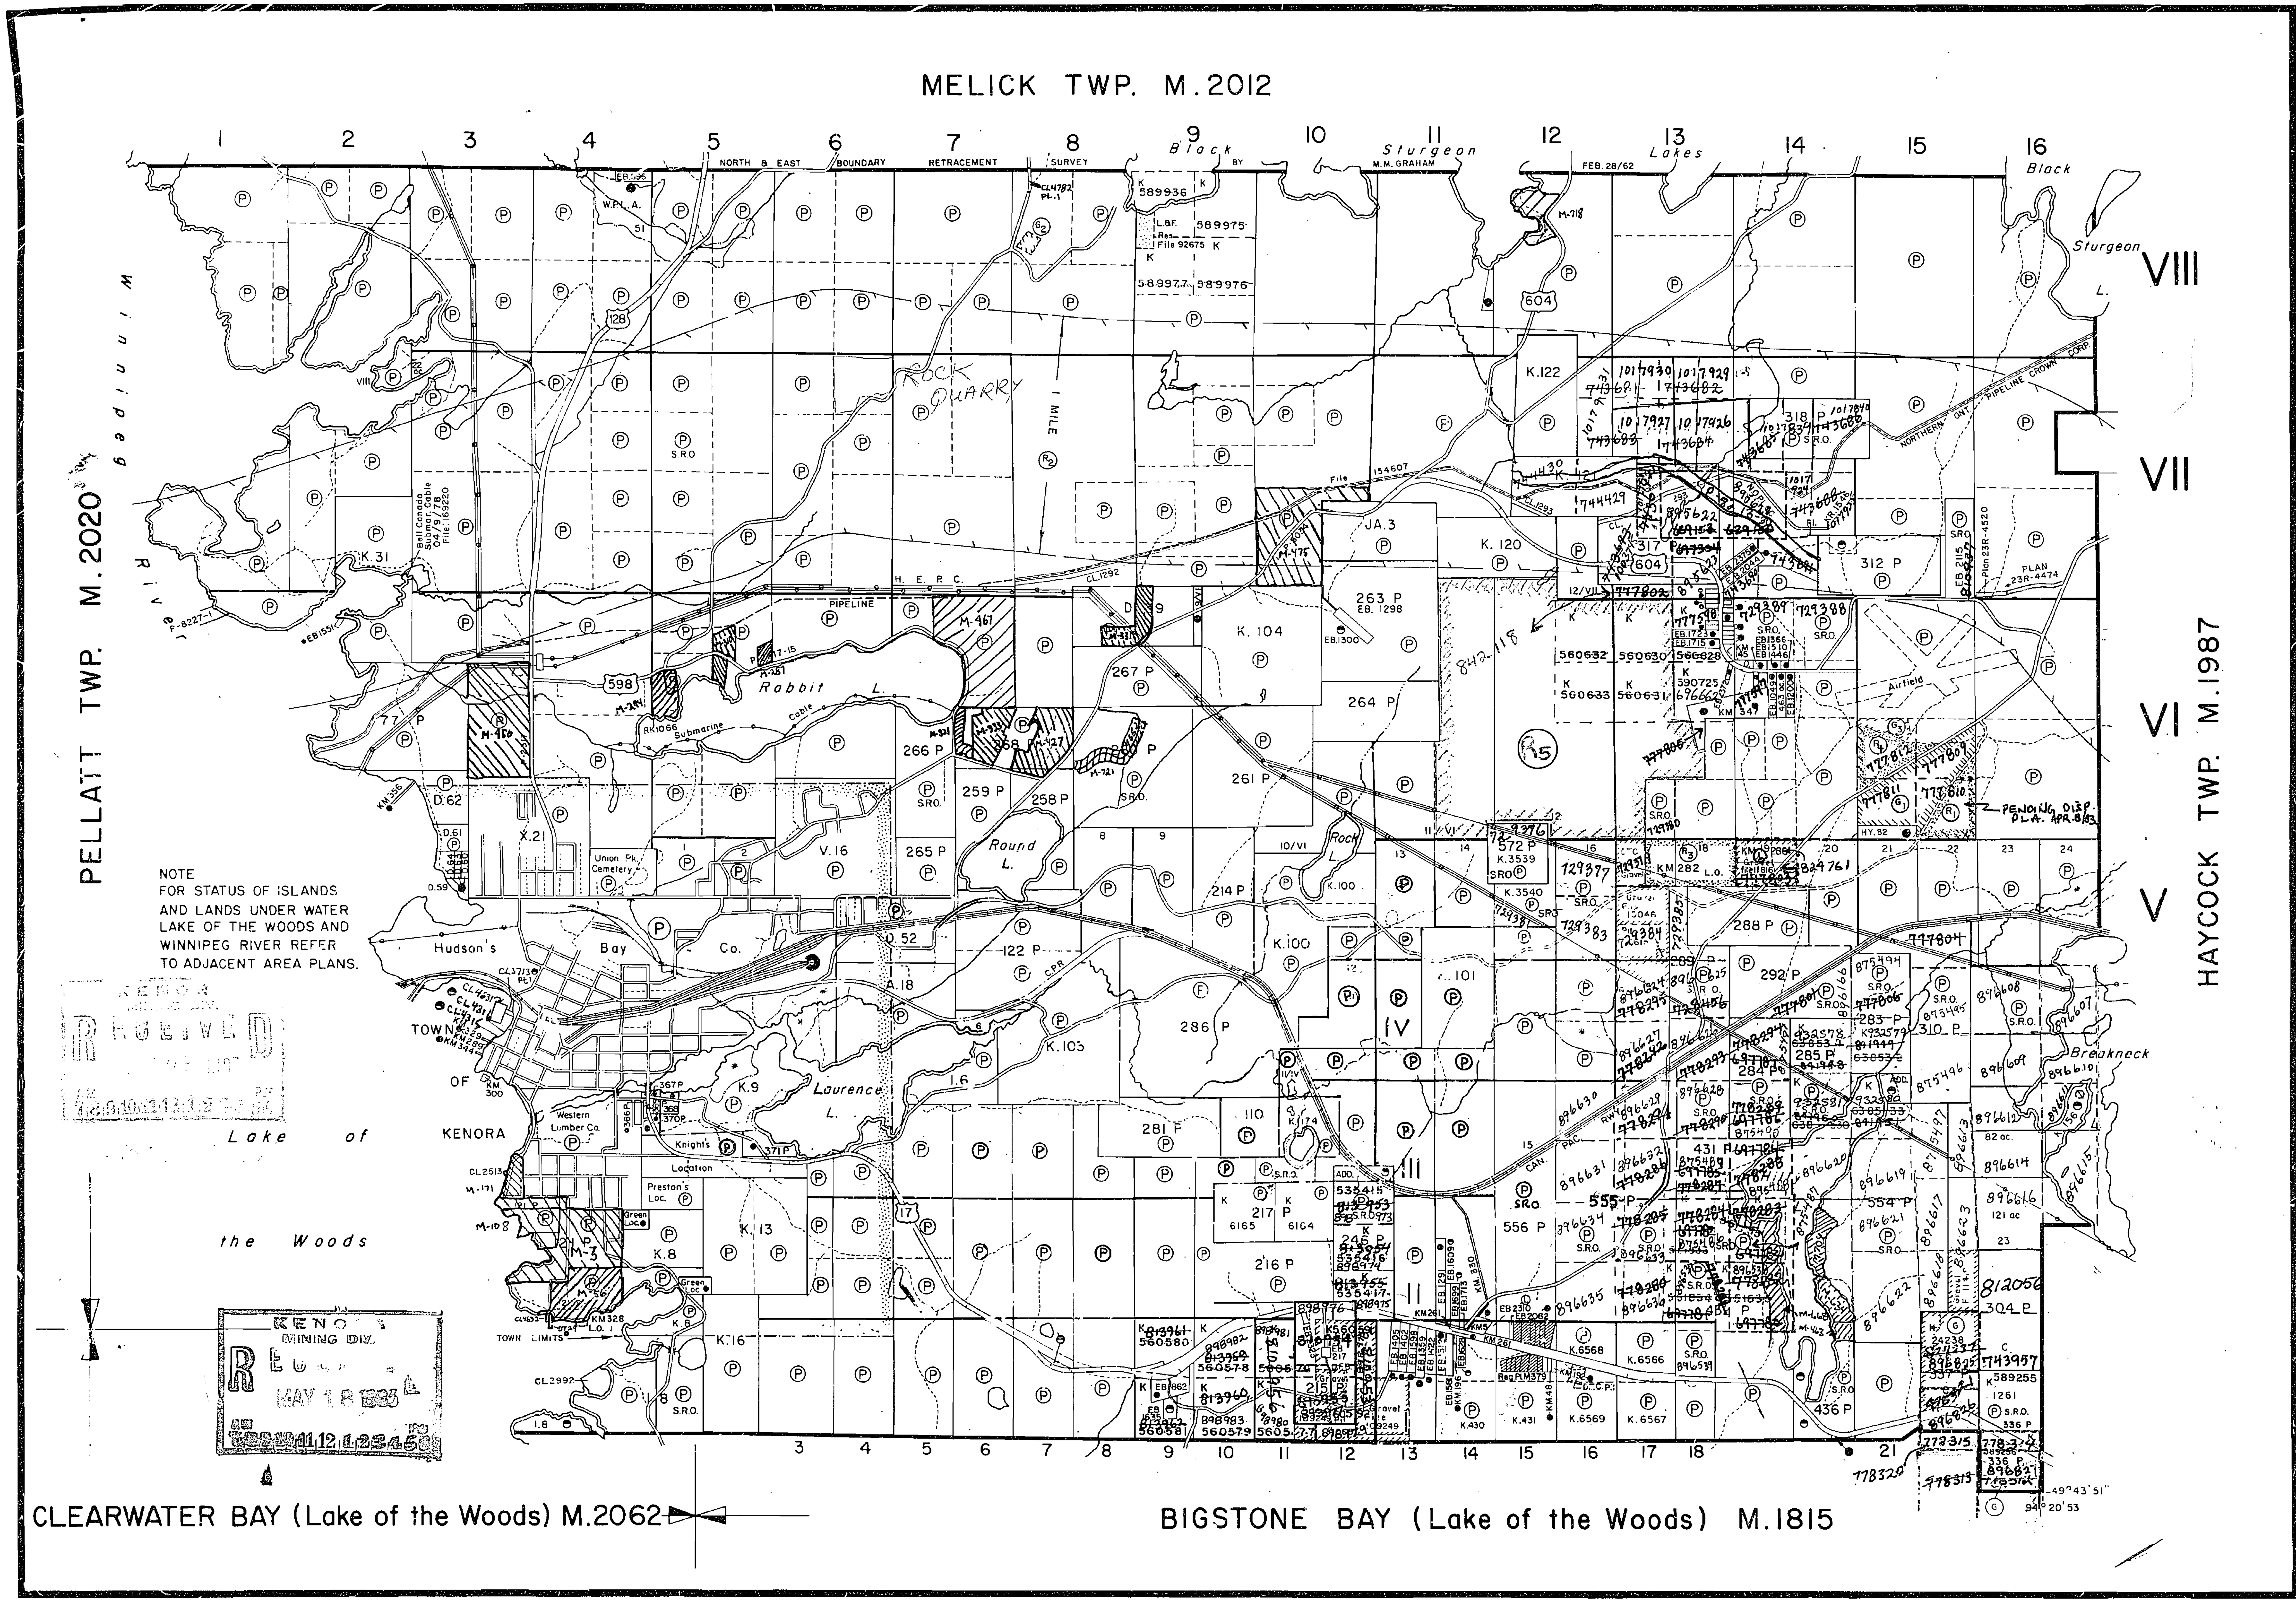
MELICK TWP. M.2012
PELLATT TWP. M.2020
HAYCOCK TWP. M.1987
CLEARWATER BAY (Lake of the Woods) M.2062
BIGSTONE BAY (Lake of the Woods) M.1815
Winnipeg River
Black Sturgeon Lakes
Rabbit L.
Round L.
Laurence L.
Rock L.
Lake of the Woods
Hudson's Bay Co.
TOWN OF KENORA
TOWN LIMITS
Airfield
ROCK QUARRY
H.E.P.C.
PIPELINE
Submarine Cable
NORTH & EAST BOUNDARY RETRACEMENT SURVEY BY M.M. GRAHAM FEB 28/62
Breakneck
VIII
VII
VI
V
IV
III
II
1 2 3 4 5 6 7 8 9 10 11 12 13 14 15 16
NOTE
FOR STATUS OF ISLANDS AND LANDS UNDER WATER LAKE OF THE WOODS AND WINNIPEG RIVER REFER TO ADJACENT AREA PLANS.
PENDING DISP. PLA. APR 8/83
KENORA MINING DIV. RECEIVED MAY 18 1983
49°43'51"
94°20'53"

NOTES

400' surface rights reservation along the shores of all lakes and rivers.

Flooding rights reserved on Winnipeg River and Alcock Lake to contour elev. 1051.20' G.S.C. Jan. 23/40. File 4922 vol.5

H.E.P.C. flooding rights on Winnipeg River and Alcock Lake to contour elev. 1045' G.S.C. W.P.L.A. 51 File 12999

SAND and GRAVEL

Ⓖ1 - M.T.C. Gravel Pit ID-5, File 97164 Ⓖ3 M.T.C. GRAVEL PIT ID-42

Ⓖ2 Gravel File 57027

Ⓖ QUARRY PERMIT

AREAS WITHDRAWN FROM STAKING

S.R. – SURFACE RIGHTS M.R. – MINING RIGHTS

	Section	Order No.	Date	Disposition	File
Ⓡ1	~~For Reforestation~~			~~S.R.~~	~~97164~~
Ⓡ2	43 (R.S.O. 1970)	W.22/78	11/5/78	S.R.	188521
Ⓡ3	43 (R.S.O. 1970)	W.1/81	22/1/81	S.R. & M.R.	11816
Ⓡ4		WNWRS/83	83/04/05	S.R	
Ⓡ5	W1/83 DEP.MIN		07/04/83	S&MR.	

LEGEND

PATENTED LAND	Ⓟ or ●†
PATENTED FOR SURFACE RIGHTS ONLY	◓†
LEASE	Ⓛ
LICENSE OF OCCUPATION	L.O.
CROWN LAND SALES	C.S.
LOCATED LAND	Loc.
CANCELLED	C
NOT THROWN OPEN FOR STAKING	Ȼ
MINING RIGHTS ONLY	M.R.O.
SURFACE RIGHTS ONLY	S.R.O.
HIGHWAY & ROUTE NO.	═(17)═
ROADS	═══
TRAILS	- - - - -
RAILWAYS	-+-+-+-
POWER LINES	—o—
MARSH OR MUSKEG	*
MINES	⚒

† used only with summer resort locations or when space is limited.

TOWNSHIP OF
JAFFRAY
DISTRICT OF
KENORA

KENORA
MINING DIVISION

SCALE : 1 INCH = 40 CHAINS (1/2 MILE)

DR. D.T.	PLAN NO. M.1992
DATE JULY/71	

ONTARIO
MINISTRY OF NATURAL RESOURCES
SURVEYS AND MAPPING BRANCH

NOTICE: THE SURFACE RIGHTS LYING WITHIN 40.25m OF THE CENTRE LINE OF THE TRANSCANADA PIPELINE RIGHT OF WAY ARE WITHDRAWN FROM STAKING OUT, PROSPECTING, SALE OR LEASE BY ORDER W.01.91 ONT. DATED SEPT.30, 1991. SECTION 112 OF THE NATIONAL ENERGY BOARD ACT APPLIES.

SYMBOLS

Boundary
- Township, Meridian, Baseline
- Road allowance; surveyed
  - shoreline
- Lot/Concession; surveyed
  - unsurveyed
- Parcel; surveyed
  - unsurveyed
- Right-of-way; road
  - railway
  - utility

- Reservation
- Cliff, Pit, Pile
- Contour
  - Interpolated
  - Approximate
  - Depression
- Control point (horizontal) △
- Flooded land
- Mine head frame
- Pipeline (above ground)

- Railway; single track
  - double track
  - abandoned
- Road; highway, county, township
  - access
  - trail, bush
- Shoreline (original)
- Transmission line
- Wooded area

DISPOSITION OF CROWN LANDS

Patent
- Surface & Mining Rights ●
- Surface Rights Only ◓
- Mining Rights Only ◒

Lease
- Surface & Mining Rights ▣
- Surface Rights Only ⬒
- Mining Rights Only ⬓

- Licence of Occupation ▼
- Order-in-Council OC
- Cancelled ⓧ
- Reservation Ⓡ
- Sand & Gravel Ⓖ

THE INFORMATION THAT APPEARS ON THIS MAP HAS BEEN COMPILED FROM VARIOUS SOURCES, AND ACCURACY IS NOT GUARANTEED. THOSE WISHING TO STAKE MINING CLAIMS SHOULD CONSULT WITH THE MINING RECORDER, MINISTRY OF NORTHERN DEVELOPMENT AND MINES, FOR ADDITIONAL INFORMATION ON THE STATUS OF THE LANDS SHOWN HEREON.

Ontario
Ministry of Natural Resources
Ministry of Northern Development and Mines

INDEX TO LAND DISPOSITION

PLAN G-1338

TOWNSHIP JAFFRAY

M.N.R. ADMINISTRATIVE DISTRICT
KENORA
MINING DIVISION
KENORA
LAND TITLES/REGISTRY DIVISION
KENORA

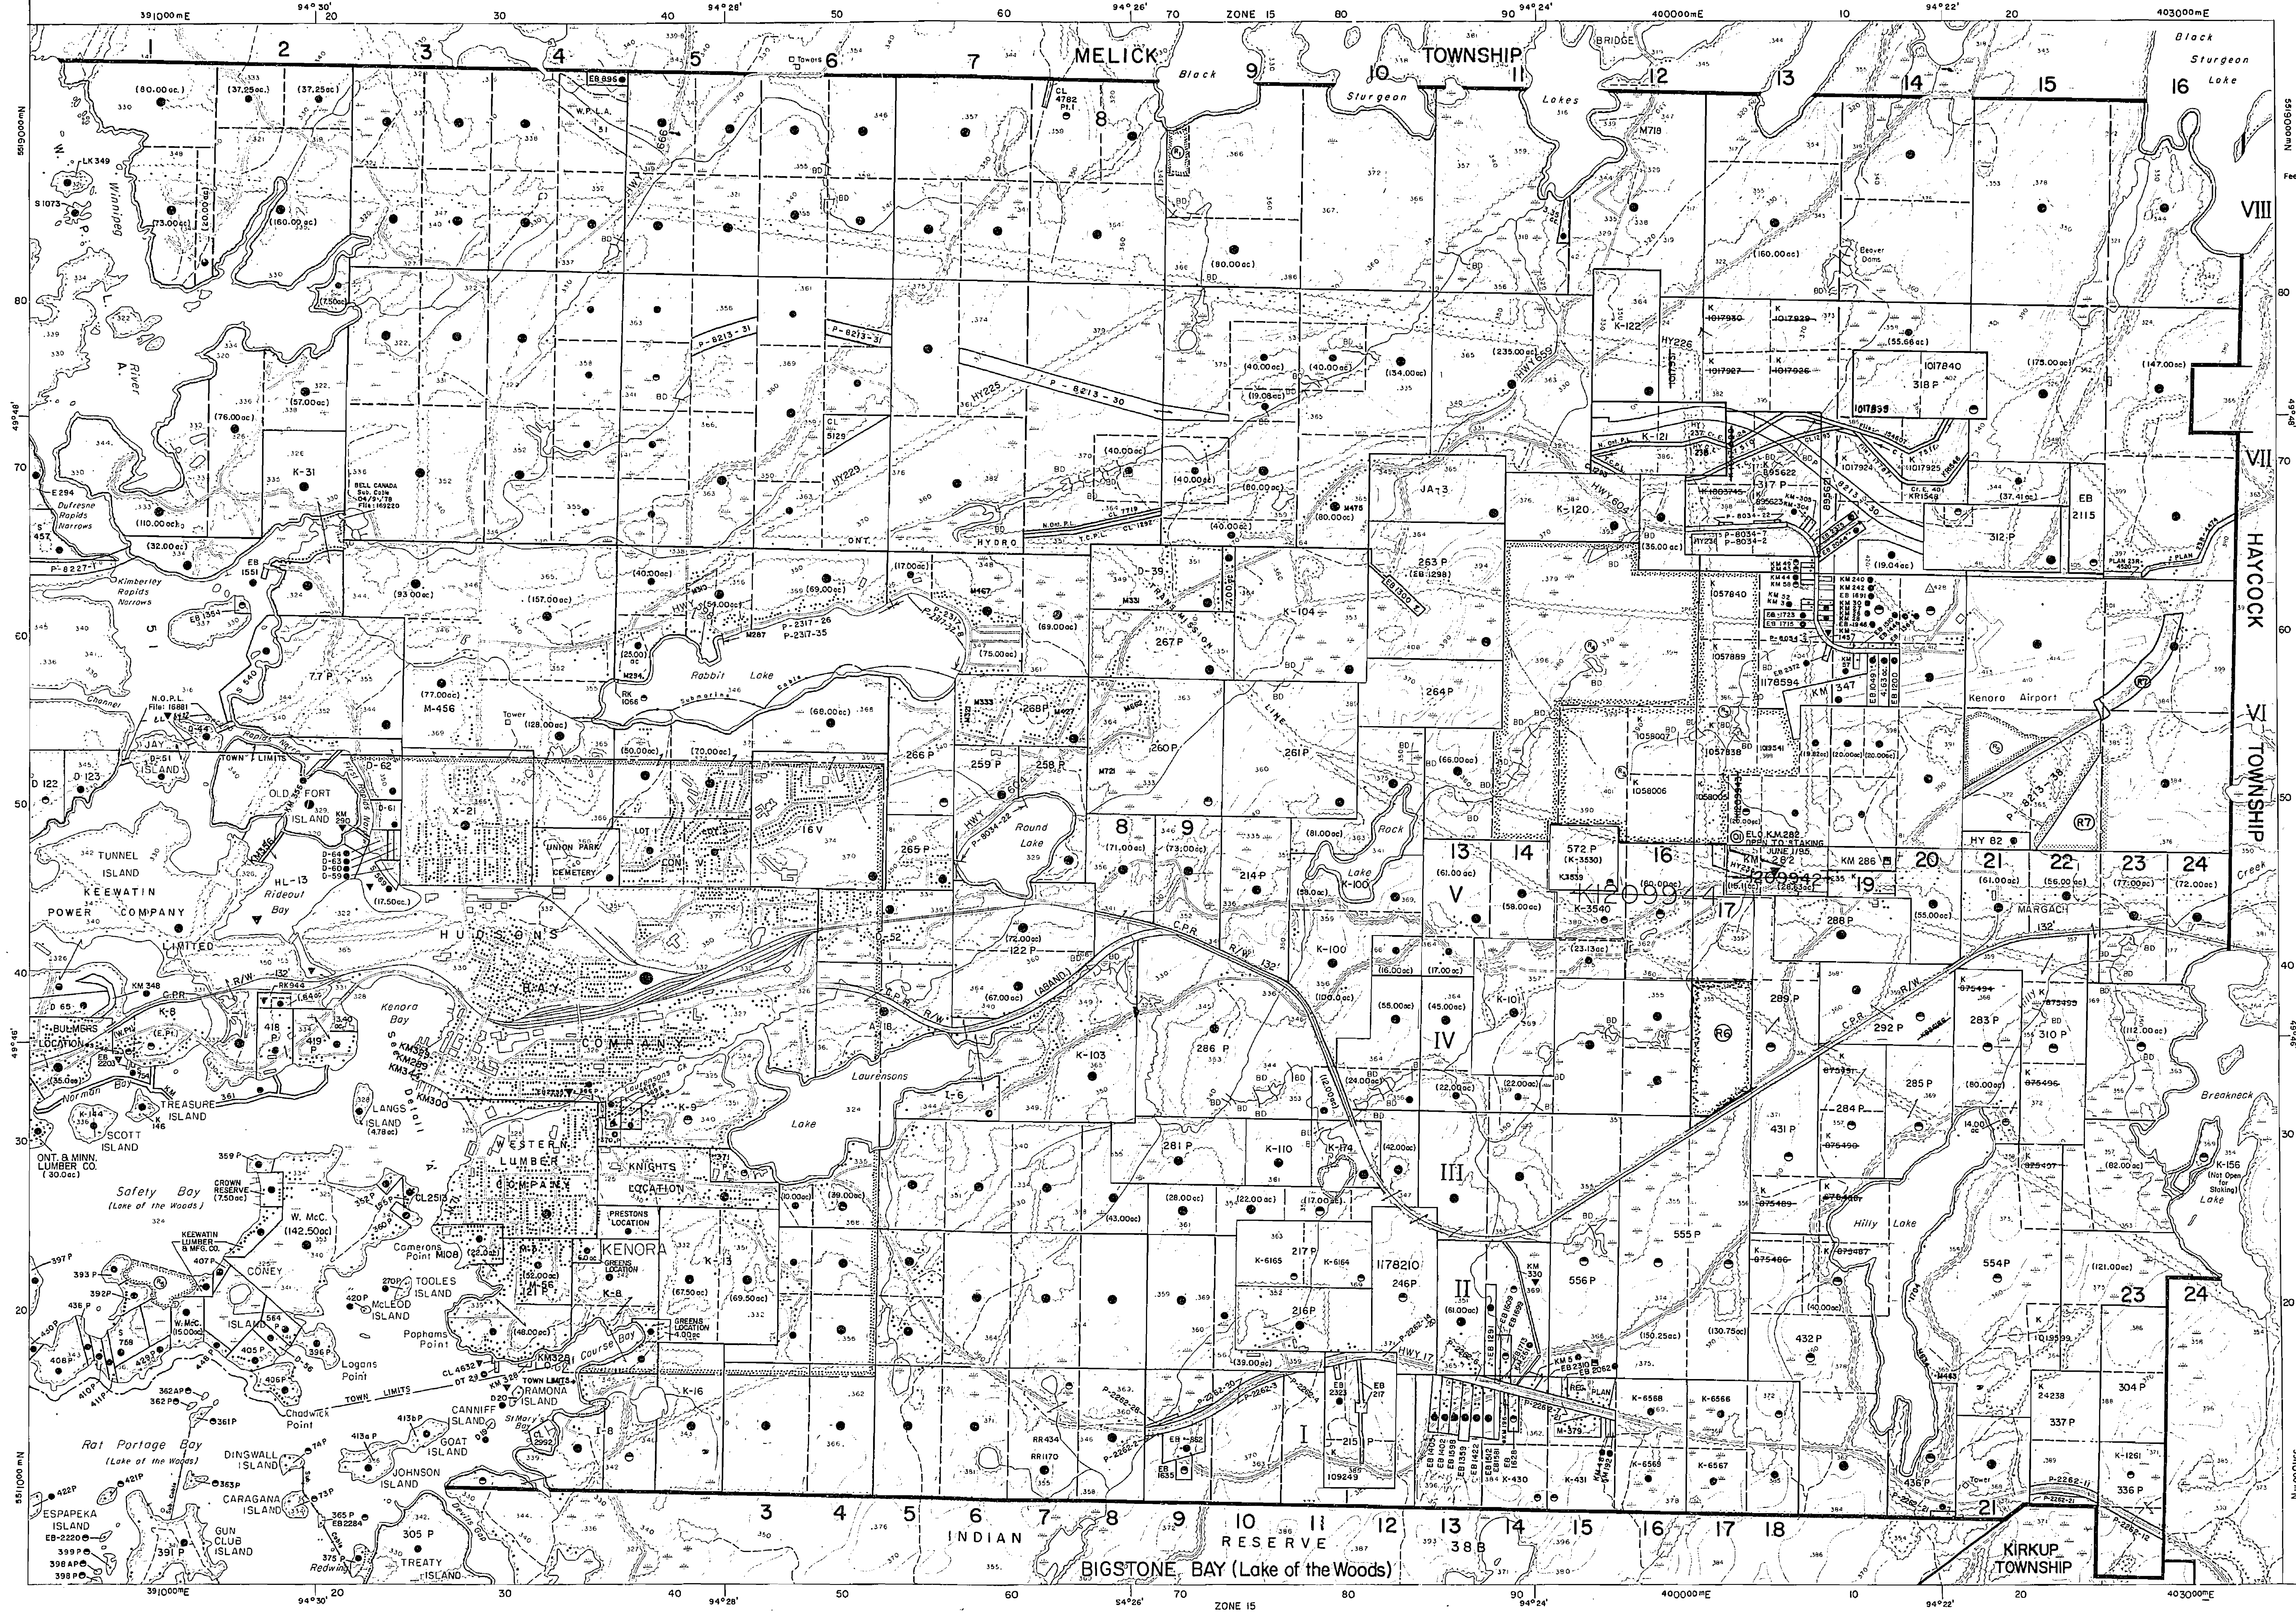
391000mE
94° 30'
94° 28'
94° 26'
ZONE 15
94° 24'
400000mE
94° 22'
403000mE
5519000mN
5511000mN
49° 48'
49° 46'
MELICK TOWNSHIP
Black Sturgeon Lake
HAYCOCK TOWNSHIP
KIRKUP TOWNSHIP
Winnipeg River
Rabbit Lake
Round Lake
Rock Lake
Laurensons Lake
Hilly Lake
Kenora Airport
KENORA
HUDSONS BAY COMPANY
WESTERN LUMBER COMPANY
KEEWATIN POWER COMPANY LIMITED
OLD FORT ISLAND
TUNNEL ISLAND
Rideout Bay
Kenora Bay
Safety Bay (Lake of the Woods)
Rat Portage Bay (Lake of the Woods)
COCONUT ISLAND
TREASURE ISLAND
SCOTT ISLAND
LANGS ISLAND
TOOLES ISLAND
McLEOD ISLAND
DINGWALL ISLAND
JOHNSON ISLAND
CARAGANA ISLAND
GUN CLUB ISLAND
ESPAPEKA ISLAND
TREATY ISLAND
GOAT ISLAND
CANNIFF ISLAND
RAMONA ISLAND
INDIAN RESERVE 38B
BIGSTONE BAY (Lake of the Woods)
Breakneck Lake
Margach
C.P.R.
HWY 17
Kimberley Rapids Narrows
Dufresne Rapids Narrows
Channel
TOWN LIMITS
I
II
III
IV
V
VI
VII
VIII

Scale 1:20 000

1000 Metres 0 1000 Metres

1000 Feet 0 1000 2000 3000 4000 5000 6000 Feet

Contour Interval 10 Metres

AREAS WITHDRAWN FROM DISPOSITION

MRO - Mining Rights Only
SRO - Surface Rights Only
M + S - Mining and Surface Rights

Description	Order No.	Date	Disposition	File
(R1) MNR RESERVE				92675
(R2) SEC. 36/80	W.5/83	5/4/83	SRO	97164
(R3) SEC. 36/80	W.36/88	30/5/88	SRO	188555 Vol.1
(R4) SEC. 36/80	W.37/88	30/5/88	M+S	188555 Vol.1
(P5) MNR RESERVE				77094 Vol.1
(R6) MNR RESERVE	W.K-1/95 NWR	19/01/95	M&S	195150

(R7) PENDING DISPOSITION UNDER PUBLIC LANDS ACT

DATE OF ISSUE

FEB 02 1998

PROVINCIAL RECORDING
OFFICE - SUDBURY

FLOODING:

ONT. HYDRO FLOODING ON THE WINNIPEG RIVER AND ALCOCK LAKE TO CONTOUR ELEVATION 1045' G.S.C.
W.P.L.A. 51 FILE: 12999

NOTES

ISLANDS AND WATER LOTS, TO THE WEST OF JAFFRAY TWP., IN THE WINNIPEG RIVER AND LAKE OF THE WOODS ARE CLASSIFIED AS UNSURVEYED TERRITORY AND AS SUCH ARE NOT GEOGRAPHICALLY PART OF JAFFRAY TWP.

THE SOUTH, EAST AND WEST BOUNDARIES OF THE TOWNSHIP OF JAFFRAY, BEING PART OF THE CORPORATION OF THE TOWNSHIP OF JAFFRAY AND MELICK, REGULATED BY MUNICIPAL CORPORATIONS QUIETING ORDER DATED JAN. 6, 1956. P.F.C. 7296
(now the TOWN OF JAFFRAY and MELICK)

THE NORTH, EAST AND SOUTH BOUNDARIES OF THE TOWN OF KENORA, REGULATED BY MUNICIPAL CORPORATIONS QUIETING ORDER DATED JUNE 15, 1959. P.F.M. 6508

ISLANDS IN THE WINNIPEG RIVER AND LAKE OF THE WOODS ARE 'NOT OPEN FOR STAKING'

←---- EFFECTIVE AS LINEN

Map base and land disposition drafting by Surveys and Mapping Branch, Ministry of Natural Resources.

The disposition of land, location of lot fabric and parcel boundaries on this index was compiled for administrative purposes only.

JAFFRAY.

Scale 40 Chains to an Inch

BLACK STURGEON LAKE
VIII
VII
VI
V
IV
III
II
1
2
3
4
5
6
7
8
9
10
11
12
13
14
15
16
K.31
K 182
K 121
K 120
P 312
P 317 RAJAH MINE
J.A.3
BULLION MINE P 263
D 39
P 267
K 104
P 264
Kenora Intermediate Aerodrome Site Dept. of National Defence Ar. 1160.05 Ac
9083
RABBIT LAKE
Dept of Highways
5540
West Part of 77.P
OLD FORT Is.
D.62
X 21
16.Y.
Union Park Cemetery
P 266
P 268
P 259
P 258
P 260
P 261
P 265
ROUND L.
N.pt. 122 P
S.pt. 122 P
D 52
A 18
K.100
K 101
K 103
P 214
P 286
K 5843
K 5842
572P
K 3540
9635
P 288
P 292
P 289
283
310
P 284
P 285
P 431
LO 2335
LO 1097
TUNNEL ISLAND
HUDSON'S BAY COMPANY
KENORA
LAURENCE LAKE
CANADIAN PACIFIC RAILWAY
I.6
K.9
P 37
P 281
K.110
K 174
WESTERN LUMBER Co
Knight Location
P 121
K.8.
K 13
I.8.
W 1/2 K.16
P 217
6165
6164
P 218
P 246
P 556
P 555
P 432
P 554
P 416
HILLY LAKE
BREAKNECK LAKE
LAKE OF THE WOODS
CONEY ISL.
P 215
9797
9718
9719
6568
6566
6569
6567
9597
LO
P 436
337
21

[illegible] withdrawn from staking Sec. 39 (d) No QP 7/18/55. RES. -A-

337P and part of 304P L & F Reservation removed.
See RES. J . 12/10/63

- - - - - - - - - - - - - - - - -

Gravel and staking reservation on Lots 9, 10, 11,
Con. 1 - Reservation continued until Jan. 1/63
See RES.J. 7/23/62 (121394)

OTE:

rea marked thus ▨,
ithdrawn from staking under
ection 39(d) of the Mg. Act.
lso gravel in the same area,
eserved from disposition.

PLAN OF
JAFFRAY TWP.
KENORA MINING DIVISION.
DISTRICT OF KENORA.

Scale, 40 chains to an inch.

RECEIVED
MAY 17 1962
KENORA MINING DIV.

May 27/63
Sept 10/63
June 23/64

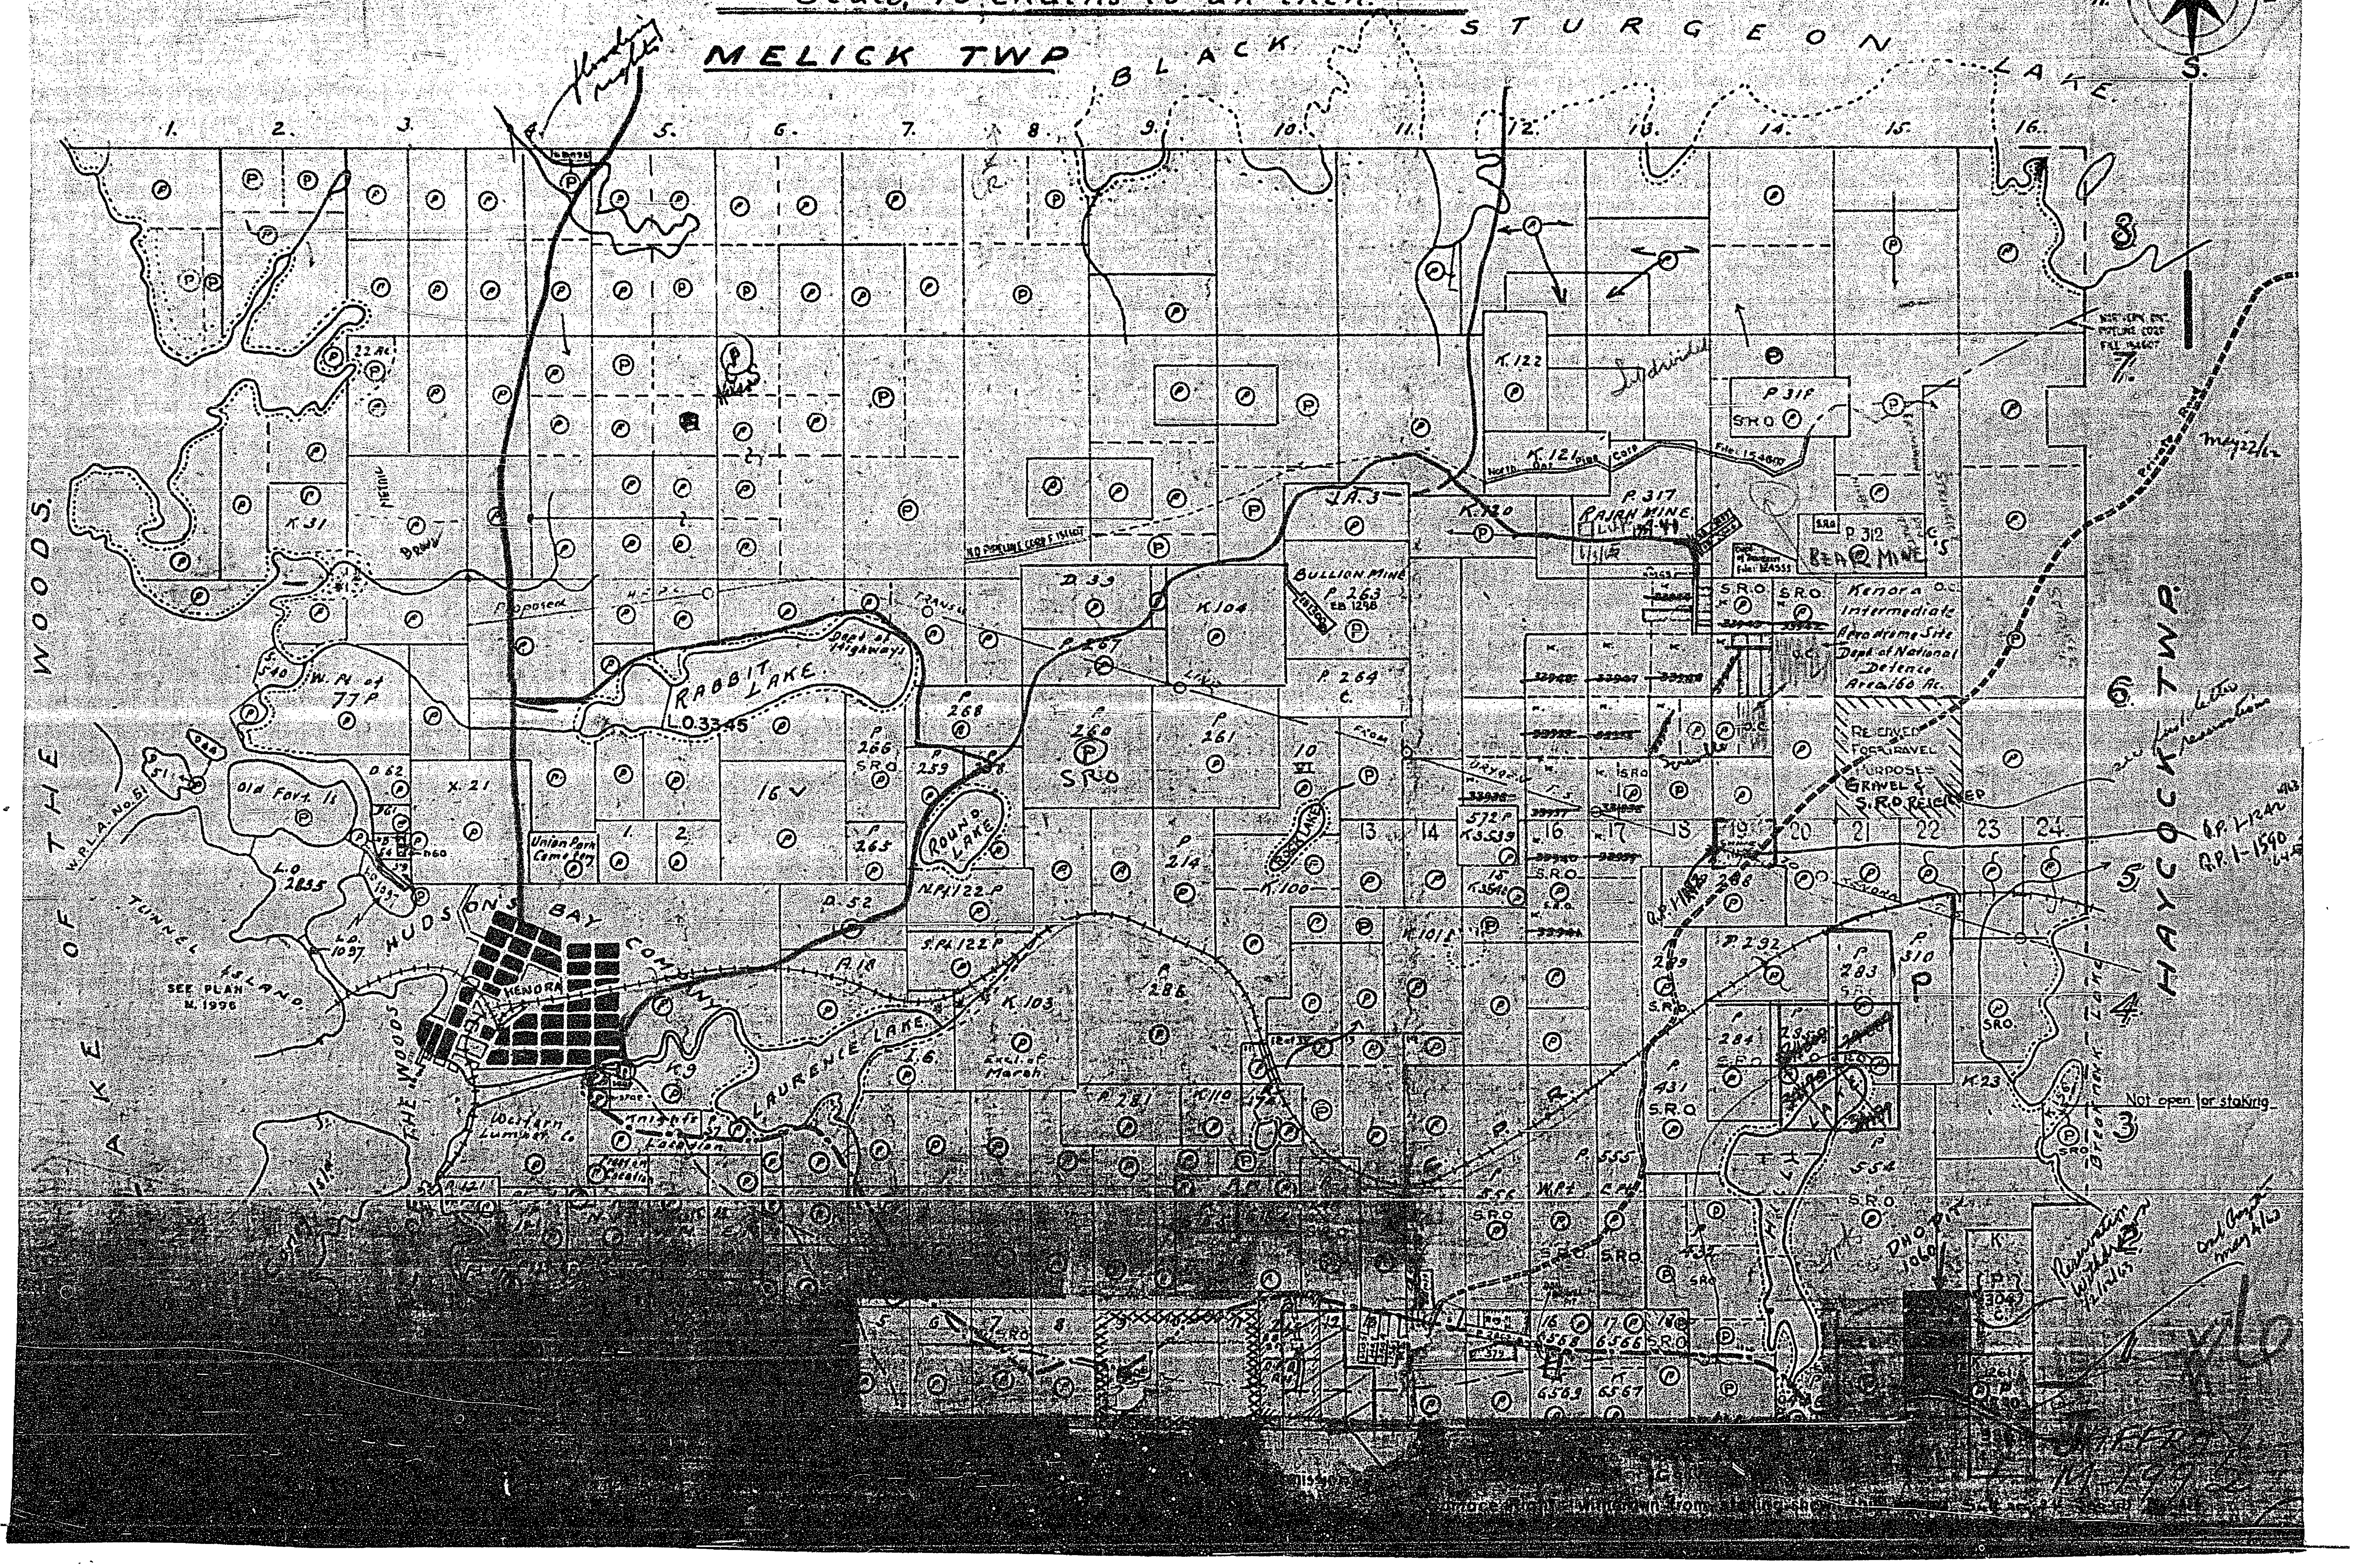

MELICK TWP
BLACK STURGEON LAKE
LAKE OF THE WOODS
HAYCOCK TWP.
AST. NORTH.
N
W.
E.
S.
1. 2. 3. 4. 5. 6. 7. 8. 9. 10. 11. 12. 13. 14. 15. 16.
8
7.
6
5
4
3
RABBIT LAKE
L.O. 3345
ROUND LAKE
LAURENCE LAKE
KENORA
HUDSONS BAY COMPANY
TUNNEL ISLAND
SEE PLAN M.1996
Old Fort. 11
Union Park Cemetery
BULLION MINE
P. 263
RAJAH MINE
BEAR MINE'S
P. 317
P. 312
P. 318
K. 122
K. 121
K. 120
K. 104
K. 103
K. 100
K. 31
K. 23
K. 9
D. 33
D. 52
D. 62
X. 21
P. 267
P. 264
P. 268
P. 266
P. 265
P. 260
P. 261
P. 259
P. 214
P. 286
P. 281
P. 292
P. 283
P. 284
P. 310
P. 431
P. 555
P. 554
S.R.O.
Kenora Intermediate Aerodrome Site Dept. of National Defence Area 186 Ac.
RESERVED FOR GRAVEL PURPOSES GRAVEL & S.R.O.
Dept. of Highways
Proposed
Private Road
Not open for staking
Q.P. 1-1590
Western Lumber Co.
Knights of Columbus
Keewatin
13 14 16 17 18 19 20 21 22 23 24
W. Pt. of 77 P.
N. Pt. 122 P.
S. Pt. 122 P.
DHO PIT 1060
Jaffray

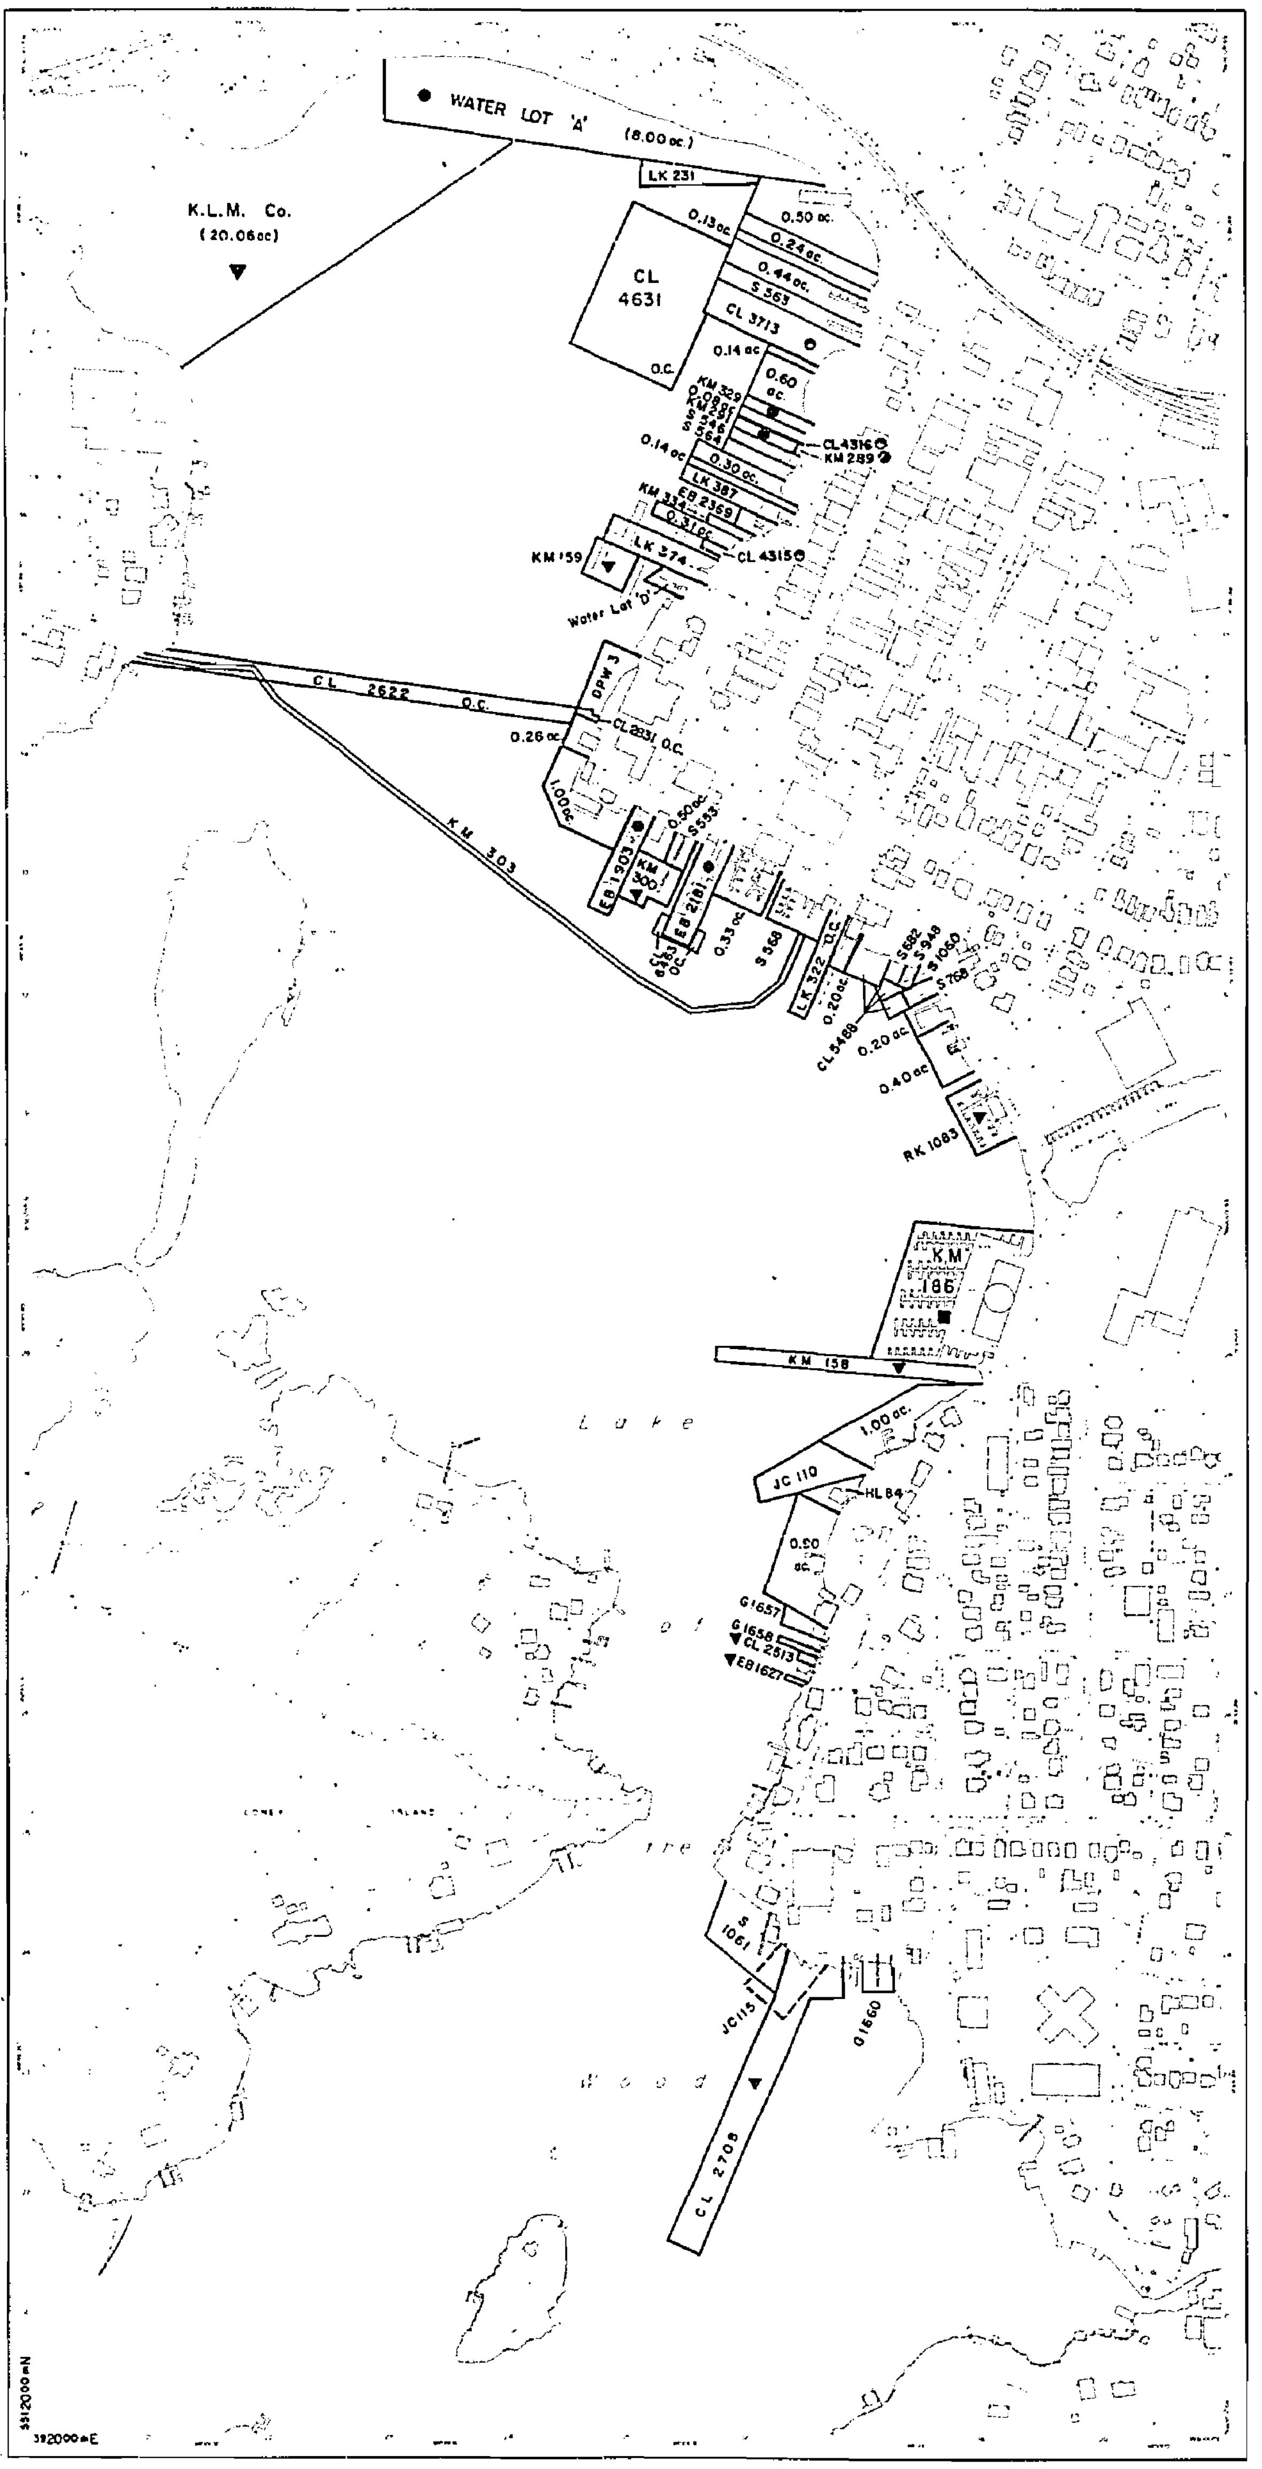
WATER LOT 'A' (8.00ac)
K.L.M. Co. (20.06ac)
CL 4631
CL 2622 O.C.
KM 303
Lake
of the Woods

DETAIL 'A'

"Water Lots Fronting The Townsite of Kenora"

(Scale 1 : 5000)

NOTICE: THE SURFACE RIGHTS LYING WITHIN 40.25m OF THE CENTRE LINE OF THE TRANSCANADA PIPELINE RIGHT OF WAY ARE WITHDRAWN FROM STAKING OUT, PROSPECTING, SALE OR LEASE BY ORDER W.OL91 ONT. DATED SEPT.30, 1991. SECTION 112 OF THE NATIONAL ENERGY BOARD ACT APPLIES.

SYMBOLS

Boundary
- Township, Meridian, Baseline
- Road allowance; surveyed
  - shoreline
- Lot/Concession; surveyed
  - unsurveyed
- Parcel; surveyed
  - unsurveyed
- Right-of-way; road
  - railway
  - utility

- Reservation
- Cliff, Pit, Pile
- Contour
  - Interpolated
  - Approximate
  - Depression
- Control point (horizontal) △
- Flooded land
- Mine head frame
- Pipeline (above ground)

- Railway; single track
  - double track
  - abandoned
- Road; highway, county, township
  - access
  - trail, bush
- Shoreline (original)
- Transmission line
- Wooded area

DISPOSITION OF CROWN LANDS

Patent
- Surface & Mining Rights ●
- Surface Rights Only ◓
- Mining Rights Only ◒

Lease
- Surface & Mining Rights ■
- Surface Rights Only ⬒
- Mining Rights Only ⬓

- Licence of Occupation ▼
- Order-in-Council OC
- Cancelled ⊗
- Reservation ⊙
- Sand & Gravel ⊙

THE INFORMATION THAT APPEARS ON THIS MAP HAS BEEN COMPILED FROM VARIOUS SOURCES, AND ACCURACY IS NOT GUARANTEED. THOSE WISHING TO STAKE MINING CLAIMS SHOULD CONSULT WITH THE MINING RECORDER, MINISTRY OF NORTHERN DEVELOPMENT AND MINES, FOR ADDITIONAL INFORMATION ON THE STATUS OF THE LANDS SHOWN HEREON.

Ontario
Ministry of Natural Resources
Ministry of Northern Development and Mines

INDEX TO LAND DISPOSITION

PLAN G-1338

TOWNSHIP **JAFFRAY**

M.N.R. ADMINISTRATIVE DISTRICT
KENORA
MINING DIVISION
KENORA
LAND TITLES/REGISTRY DIVISION
KENORA

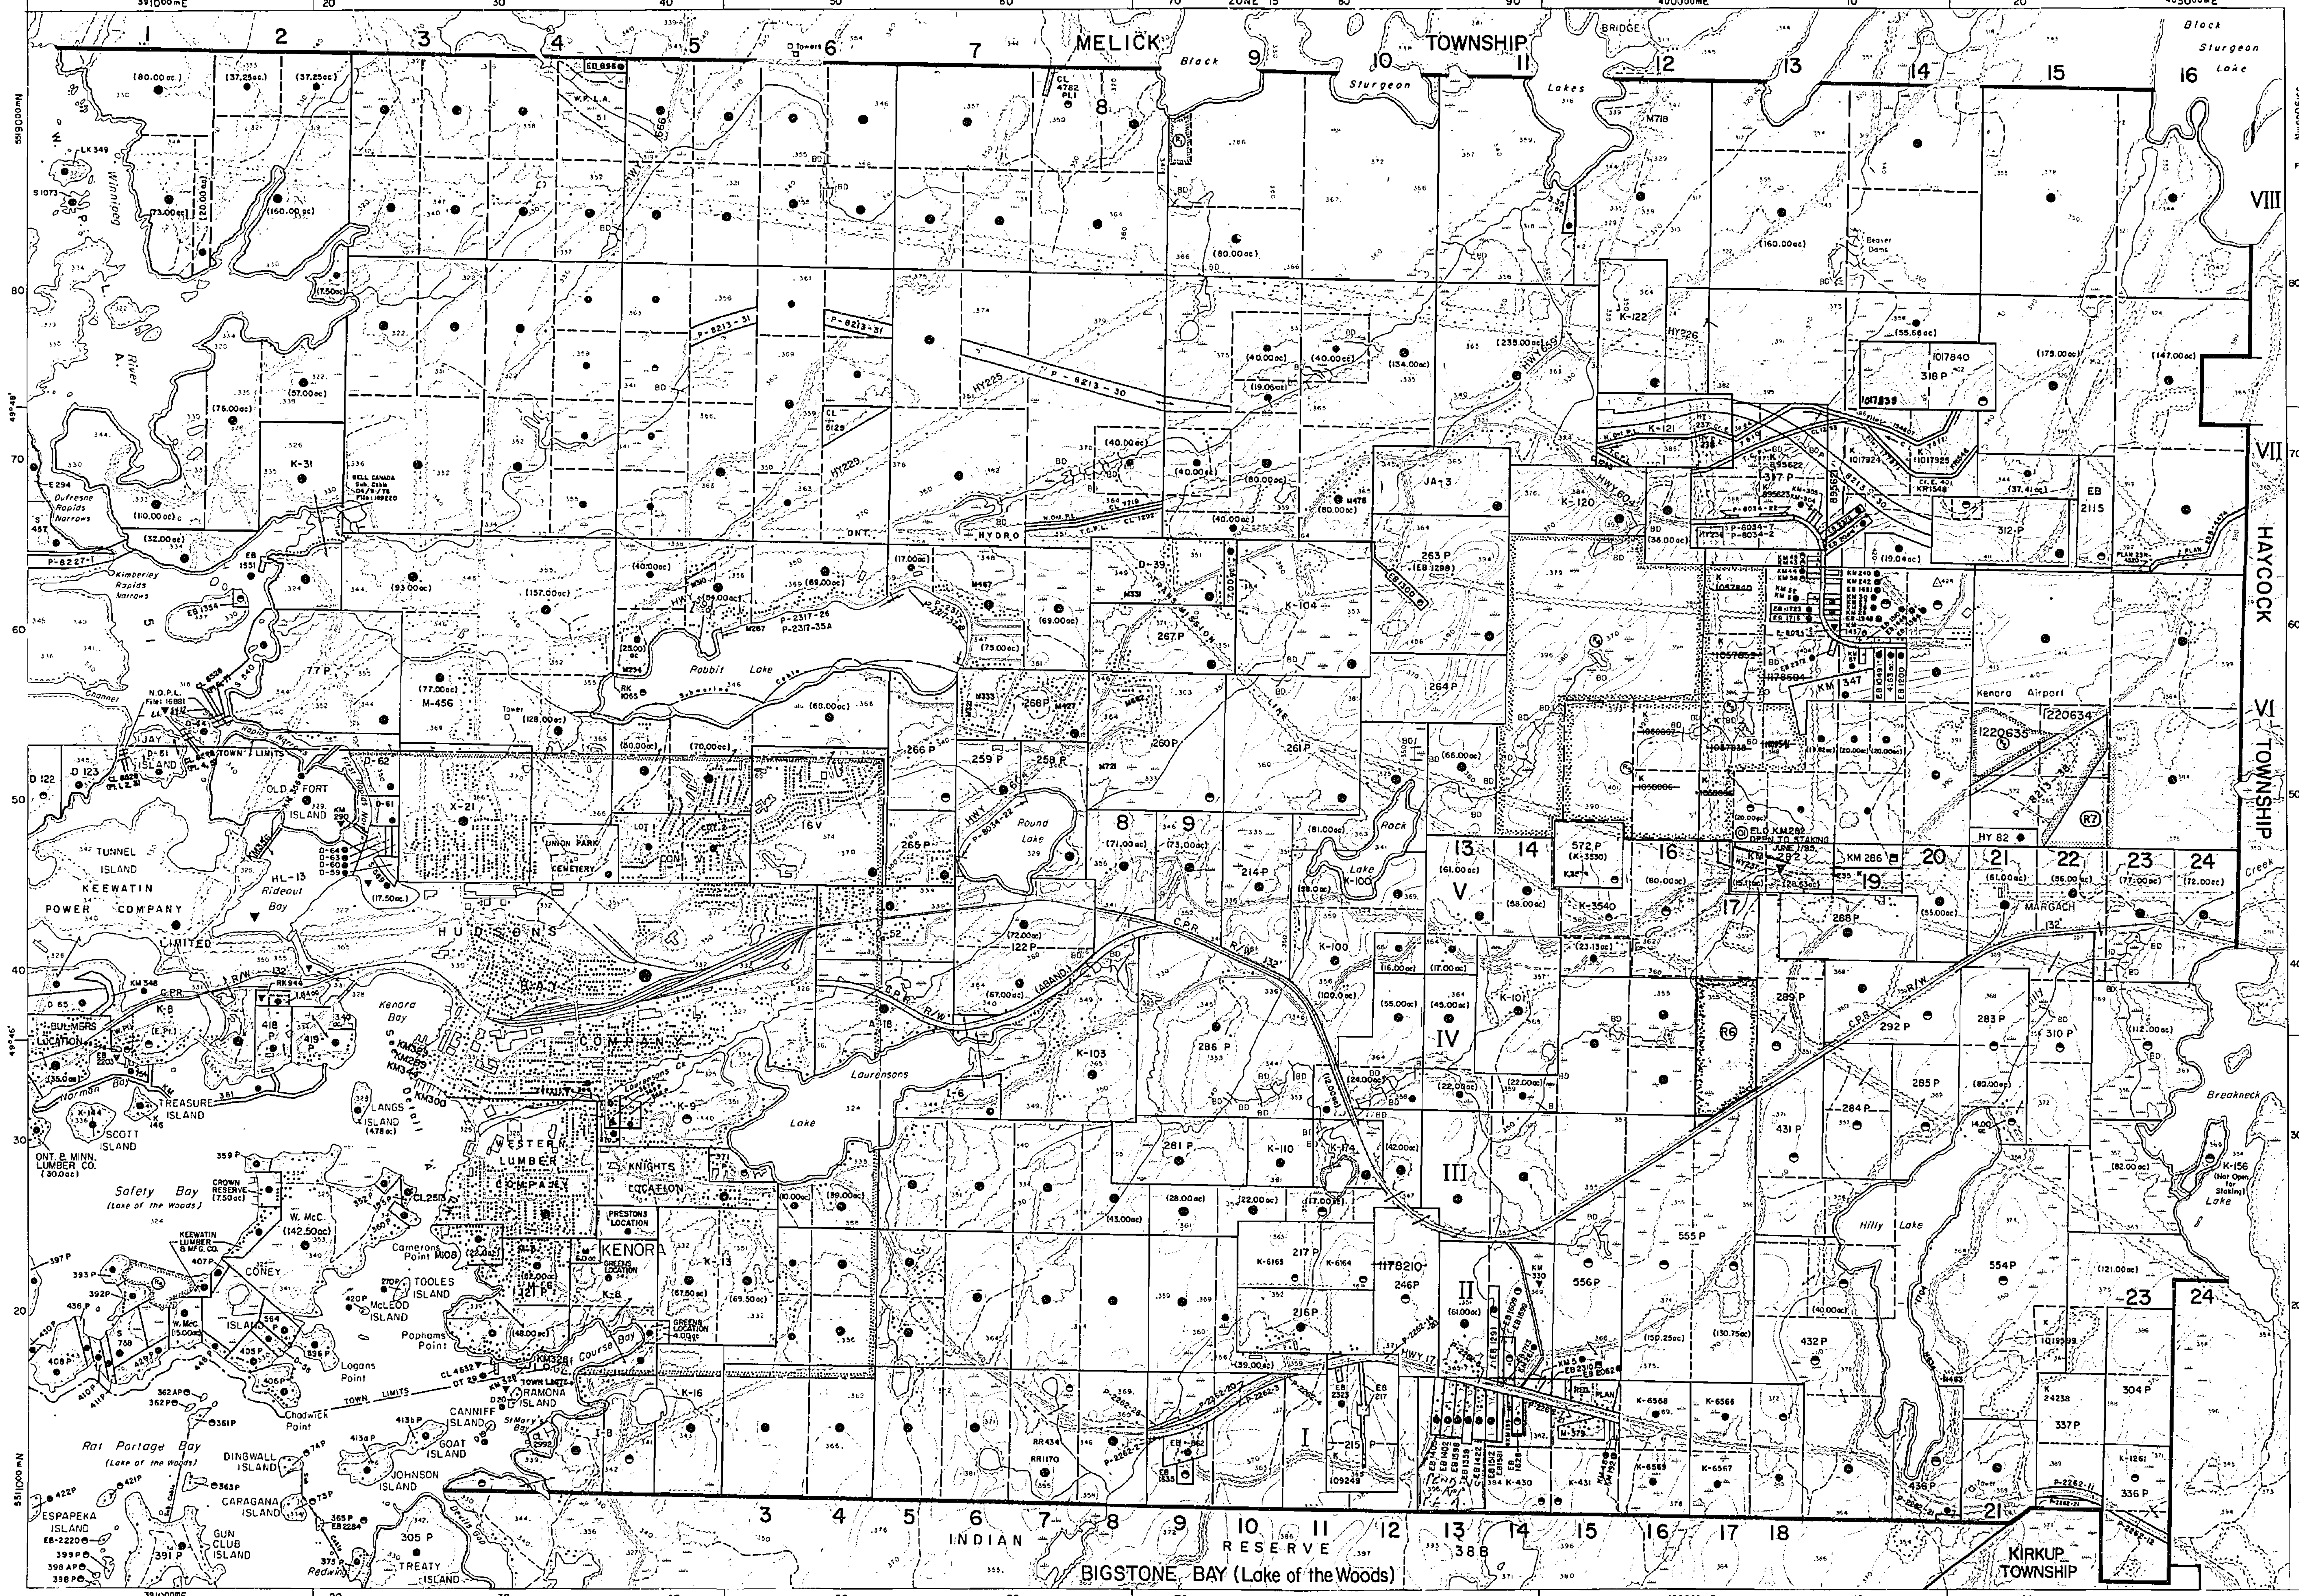
MELICK TOWNSHIP
HAYCOCK TOWNSHIP
KIRKUP TOWNSHIP
Black Sturgeon Lake
Rabbit Lake
Round Lake
Laurensons Lake
Hillys Lake
Kenora Airport
HUDSON'S BAY COMPANY
KEEWATIN POWER COMPANY LIMITED
WESTERN LUMBER COMPANY
KENORA
Safety Bay (Lake of the Woods)
Rat Portage Bay (Lake of the Woods)
INDIAN RESERVE
BIGSTONE BAY (Lake of the Woods)
TREASURE ISLAND
COURSE BAY
OLD FORT ISLAND
TUNNEL ISLAND
CPR
ZONE 15
391000mE
400000mE
403000mE
5519000mN
5510000mN
94°30'
94°28'
94°26'
94°24'
94°22'
49°48'
49°46'
I
II
III
IV
V
VI
VII
VIII

Scale 1:20 000

Contour Interval 10 Metres

AREAS WITHDRAWN FROM DISPOSITION

MRO - Mining Rights Only
SRO - Surface Rights Only
M + S - Mining and Surface Rights

Description	Order No.	Date	Disposition	File
(R1) MNR RESERVE				92675
(R2) SEC. 36/80	W.5/83	5/4/83	SRO	97164
(R3) SEC. 36/80	W.36/88	30/5/88	SRO	188555 Vol.1
(R4) SEC. 36/80	W.37/88	30/5/88	M+S	188555 Vol.1
(R5) MNR RESERVE				77094 Vol.1
(R6) MNR RESERVE	W-K-1/95 NWR	19/01/95	M&S	195150
(R7) PENDING DISPOSITION UNDER PUBLIC LANDS ACT ROAD RIGHT-OF-WAY		09/01/97		

FLOODING:

ONT. HYDRO FLOODING ON THE WINNIPEG RIVER AND ALCOCK LAKE TO CONTOUR ELEVATION 1048' G.S.C.
W.P.L.A. 51 FILE: 12999

NOTES

ISLANDS AND WATER LOTS, TO THE WEST OF JAFFRAY TWP., IN THE WINNIPEG RIVER AND LAKE OF THE WOODS ARE CLASSIFIED AS UNSURVEYED TERRITORY AND AS SUCH ARE NOT GEOGRAPHICALLY PART OF JAFFRAY TWP.

THE SOUTH, EAST AND WEST BOUNDARIES OF THE TOWNSHIP OF JAFFRAY, BEING PART OF THE CORPORATION OF THE TOWNSHIP OF JAFFRAY AND MELICK, REGULATED BY MUNICIPAL CORPORATIONS QUIETING ORDER DATED JAN. 6, 1956. P.F.C. 7296 (now the TOWN OF JAFFRAY and MELICK)

THE NORTH, EAST AND SOUTH BOUNDARIES OF THE TOWN OF KENORA, REGULATED BY MUNICIPAL CORPORATIONS QUIETING ORDER DATED JUNE 15, 1959. P.F.M. 6508

ISLANDS IN THE WINNIPEG RIVER AND LAKE OF THE WOODS ARE 'NOT OPEN FOR STAKING'

EFFECTIVE AS LINEN

Map base and land disposition drafting by Surveys and Mapping Branch, Ministry of Natural Resources.

The disposition of land, location of lot fabric and parcel boundaries on this index was compiled for administrative purposes only.

1992

PLAN OF
JAFFRAY TWP.
M-1992
KENORA MINING DIVISION.
DISTRICT OF KENORA.
Scale, 40 chains to an inch.

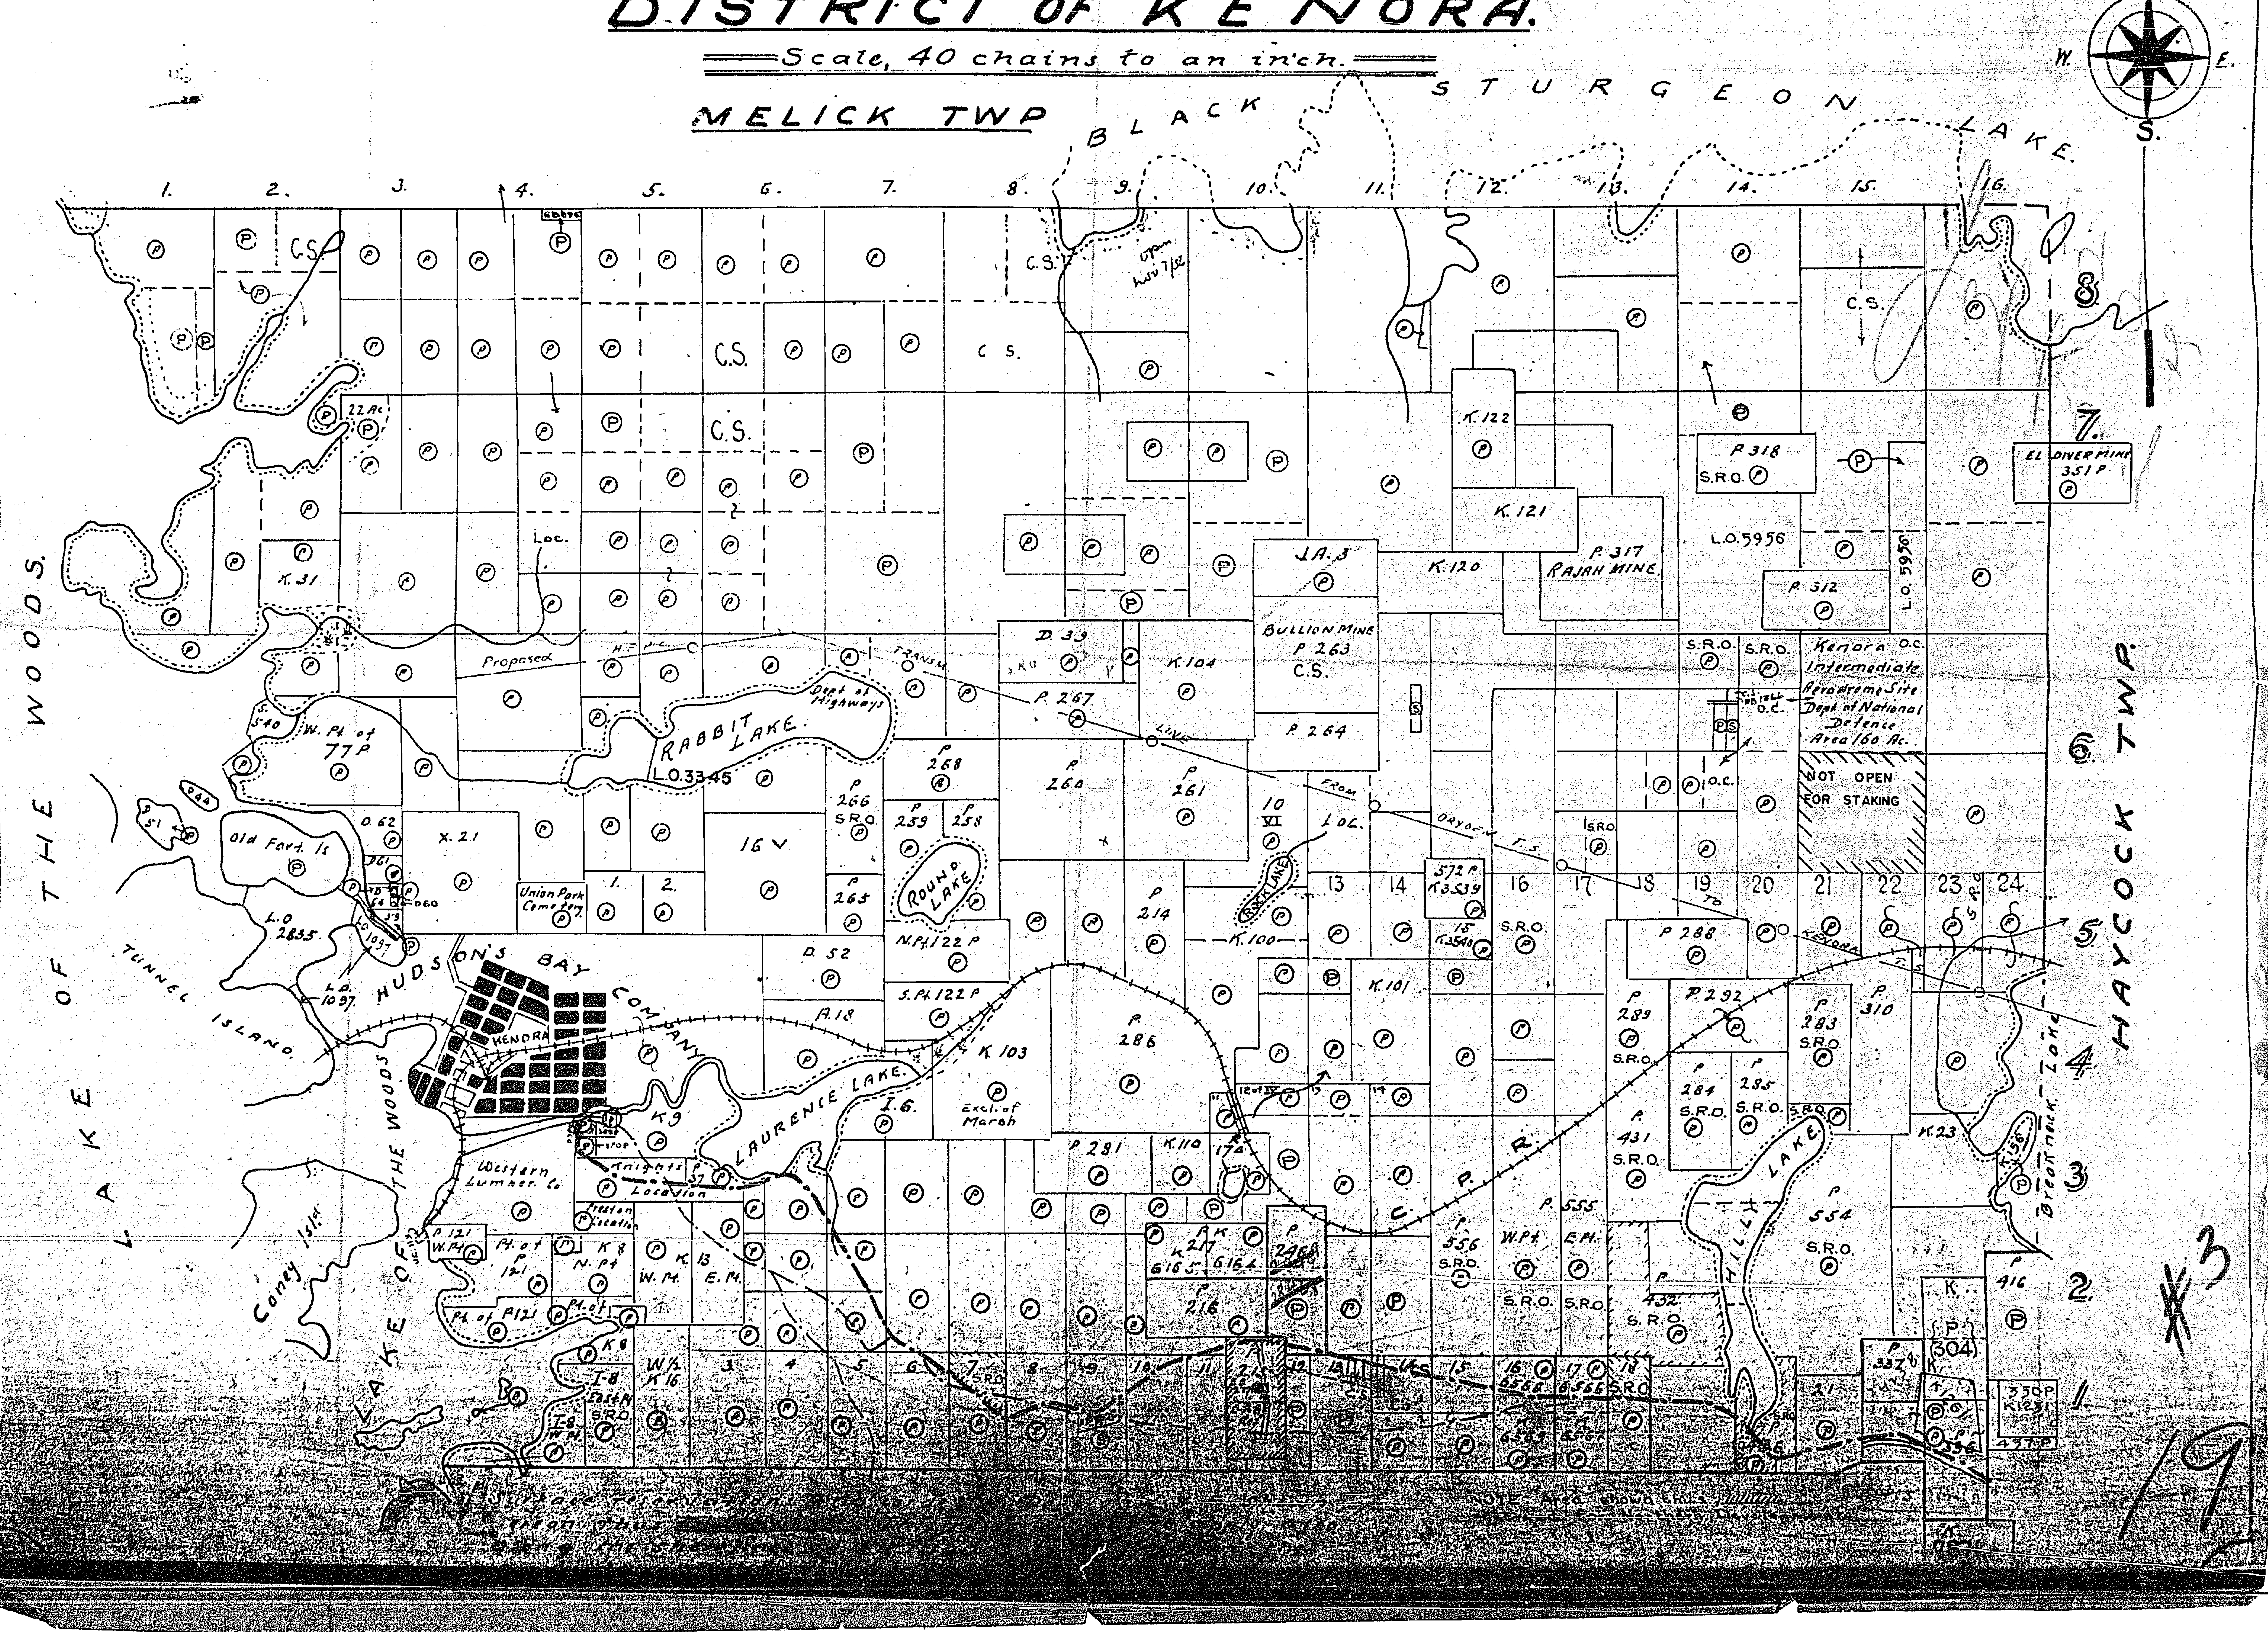

MELICK TWP
BLACK STURGEON LAKE
N
W
E
S
1. 2. 3. 4. 5. 6. 7. 8. 9. 10. 11. 12. 13. 14. 15. 16.
8
7.
6
5
4
3
2.
1.
C.S.
LAKE OF THE WOODS
HAYCOCK TWP.
K.31
K.122
K.121
K.120
P.318 S.R.O.
EL DIVER MINE 351 P
L.O.5956
P.317 RAJAH MINE
P.312
J.A.3
BULLION MINE P.263 C.S.
P.264
D.39
K.104
P.267
Kenora O.C. Intermediate Aerodrome Site Dept. of National Defence Area 160 Ac.
NOT OPEN FOR STAKING
Proposed H.E.P.C. TRANSM. LINE FROM DRYDEN T.S. TO KENORA T.S.
RABBIT LAKE
Dept. of Highways
L.O.3345
W. Pt. of 77P
Old Fort Is.
D.62
X.21
Loc.
Union Park Cemetery
16
P 266 S.R.O.
P 268
P 259
258
P 260
P 261
ROUND LAKE
N.Pt.122 P
S.Pt.122 P
P 265
P 214
K.100
572 P K.3539
D.52
A.18
L.O. 2835
L.O. 1097
TUNNEL ISLAND
HUDSON'S BAY COMPANY
KENORA
K9
LAURENCE LAKE
I.6.
K.103
Excl. of Marsh
P 286
P 281
K.110
K.101
P 288
P.292
P 289 S.R.O.
P 283 S.R.O.
P 310
P 284 S.R.O.
P 285 S.R.O.
P 431 S.R.O.
K.23
C.P.R.
HILL LAKE
P 554 S.R.O.
P.555
P 556 S.R.O.
W.Pt.
E.H.
432 S.R.O.
P 416
(304)
P 333
336
350P K.291
431P
K 217 6165
616.4
P 216
Western Lumber Co.
Knights Location
Preston Location
P.121 W.Pt.
Pt. of P.121
K.8
N.Pt.
K.13
W.Pt.
E.Pt.
I-8
W½ K.16
Coney Isl.
LAKE OF THE WOODS
Brodrick Lake
K.136
S.40
Open Nov 7/42
13 14 15 16 17 18 19 20 21 22 23 24

#3

19

1992

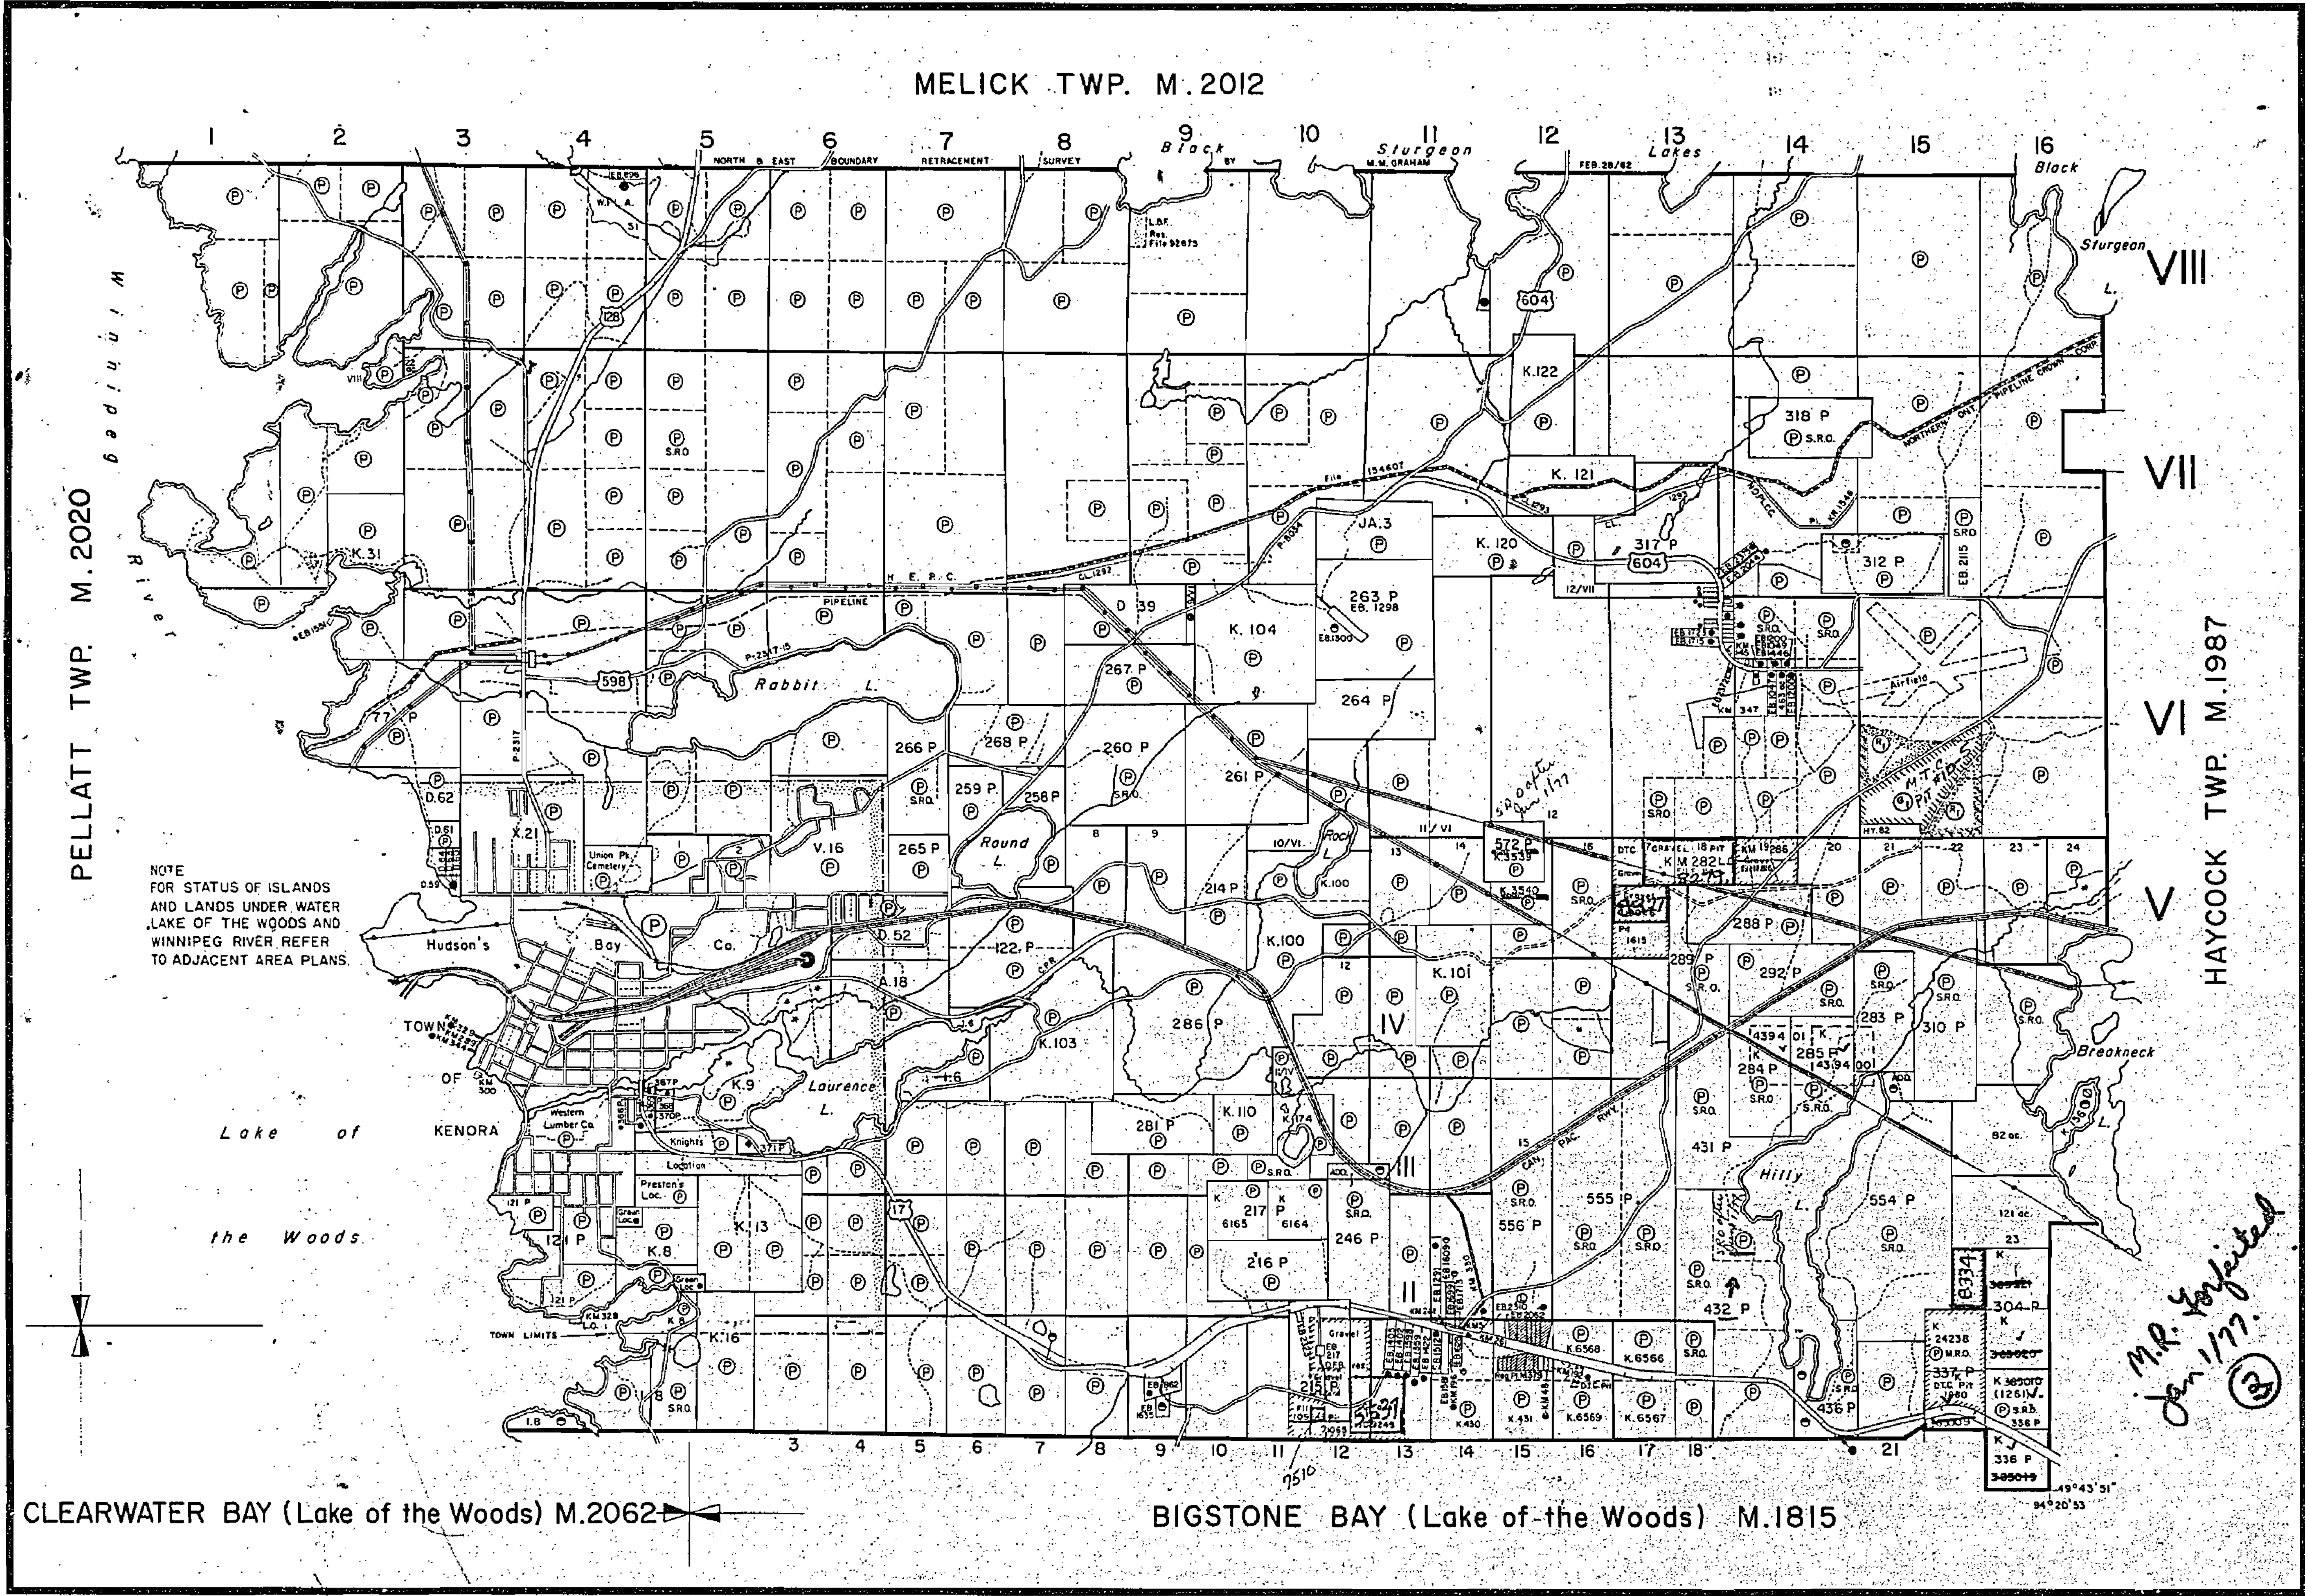
MELICK TWP. M.2012
PELLATT TWP. M.2020
HAYCOCK TWP. M.1987
CLEARWATER BAY (Lake of the Woods) M.2062
BIGSTONE BAY (Lake of the Woods) M.1815
Winnipeg River
Black Sturgeon Lakes
Sturgeon L.
Rabbit L.
Round L.
Laurence L.
Rock L.
Hilly L.
Breakneck
Hudson's Bay Co.
TOWN OF KENORA
Lake of the Woods
TOWN LIMITS
Airfield
VIII
VII
VI
V
IV
III
II
M.R. Forfeited Jan 1/77.
S.R.O. after Jan 1/77
7510

NOTE
FOR STATUS OF ISLANDS AND LANDS UNDER WATER LAKE OF THE WOODS AND WINNIPEG RIVER REFER TO ADJACENT AREA PLANS.

NOTES

400' surface rights reservation along the shores of all lakes and rivers.

Flooding rights reserved on Winnipeg River and Alcock Lake to contour elev. 1051.20' G.S.C.
Jan. 23/40. File 4922 vol. 5

H.E.P.C. flooding rights on Winnipeg River and Alcock Lake to contour elev. 1045' G.S.C.
W.P.L.A. 51 File 12999

(R1) S.R.O. RESERVED FOR REFORESTATION FILE: 97164.

(G1) SAND & GRAVEL RESERVE FILE: 97164

Mining Rights on K3540 & K3539 Thrown open for Staking on June 1/77

DATE OF ISSUE AUG 25 1976

KENORA MINING DIV. RECEIVED AUG 31 1976 AM 7 8 9 10 11 12 1 2 3 4 5 6 PM

LEGEND

PATENTED LAND	Ⓟ or ●†
PATENTED FOR SURFACE RIGHTS ONLY	◒†
LEASE	Ⓛ
LICENSE OF OCCUPATION	L.O.
CROWN LAND SALES	C.S.
LOCATED LAND	Loc.
CANCELLED	C.
NOT THROWN OPEN FOR STAKING	⊘
MINING RIGHTS ONLY	M.R.O.
SURFACE RIGHTS ONLY	S.R.O.
HIGHWAY & ROUTE NO.	═(17)═
ROADS	═══
TRAILS	- - - -
RAILWAYS	─┼─┼─
POWER LINES	─•─•─
MARSH OR MUSKEG	⬭
MINES	⚒

† used only with summer resort locations or when space is limited.

TOWNSHIP OF
JAFFRAY

DISTRICT OF
KENORA

KENORA
MINING DIVISION

#10

SCALE : 1 INCH = 40 CHAINS (1/2 MILE)

DR. D.T.
DATE JULY/71
PLAN NO. M.1992

ONTARIO
MINISTRY OF NATURAL RESOURCES
SURVEYS AND MAPPING BRANCH

1992

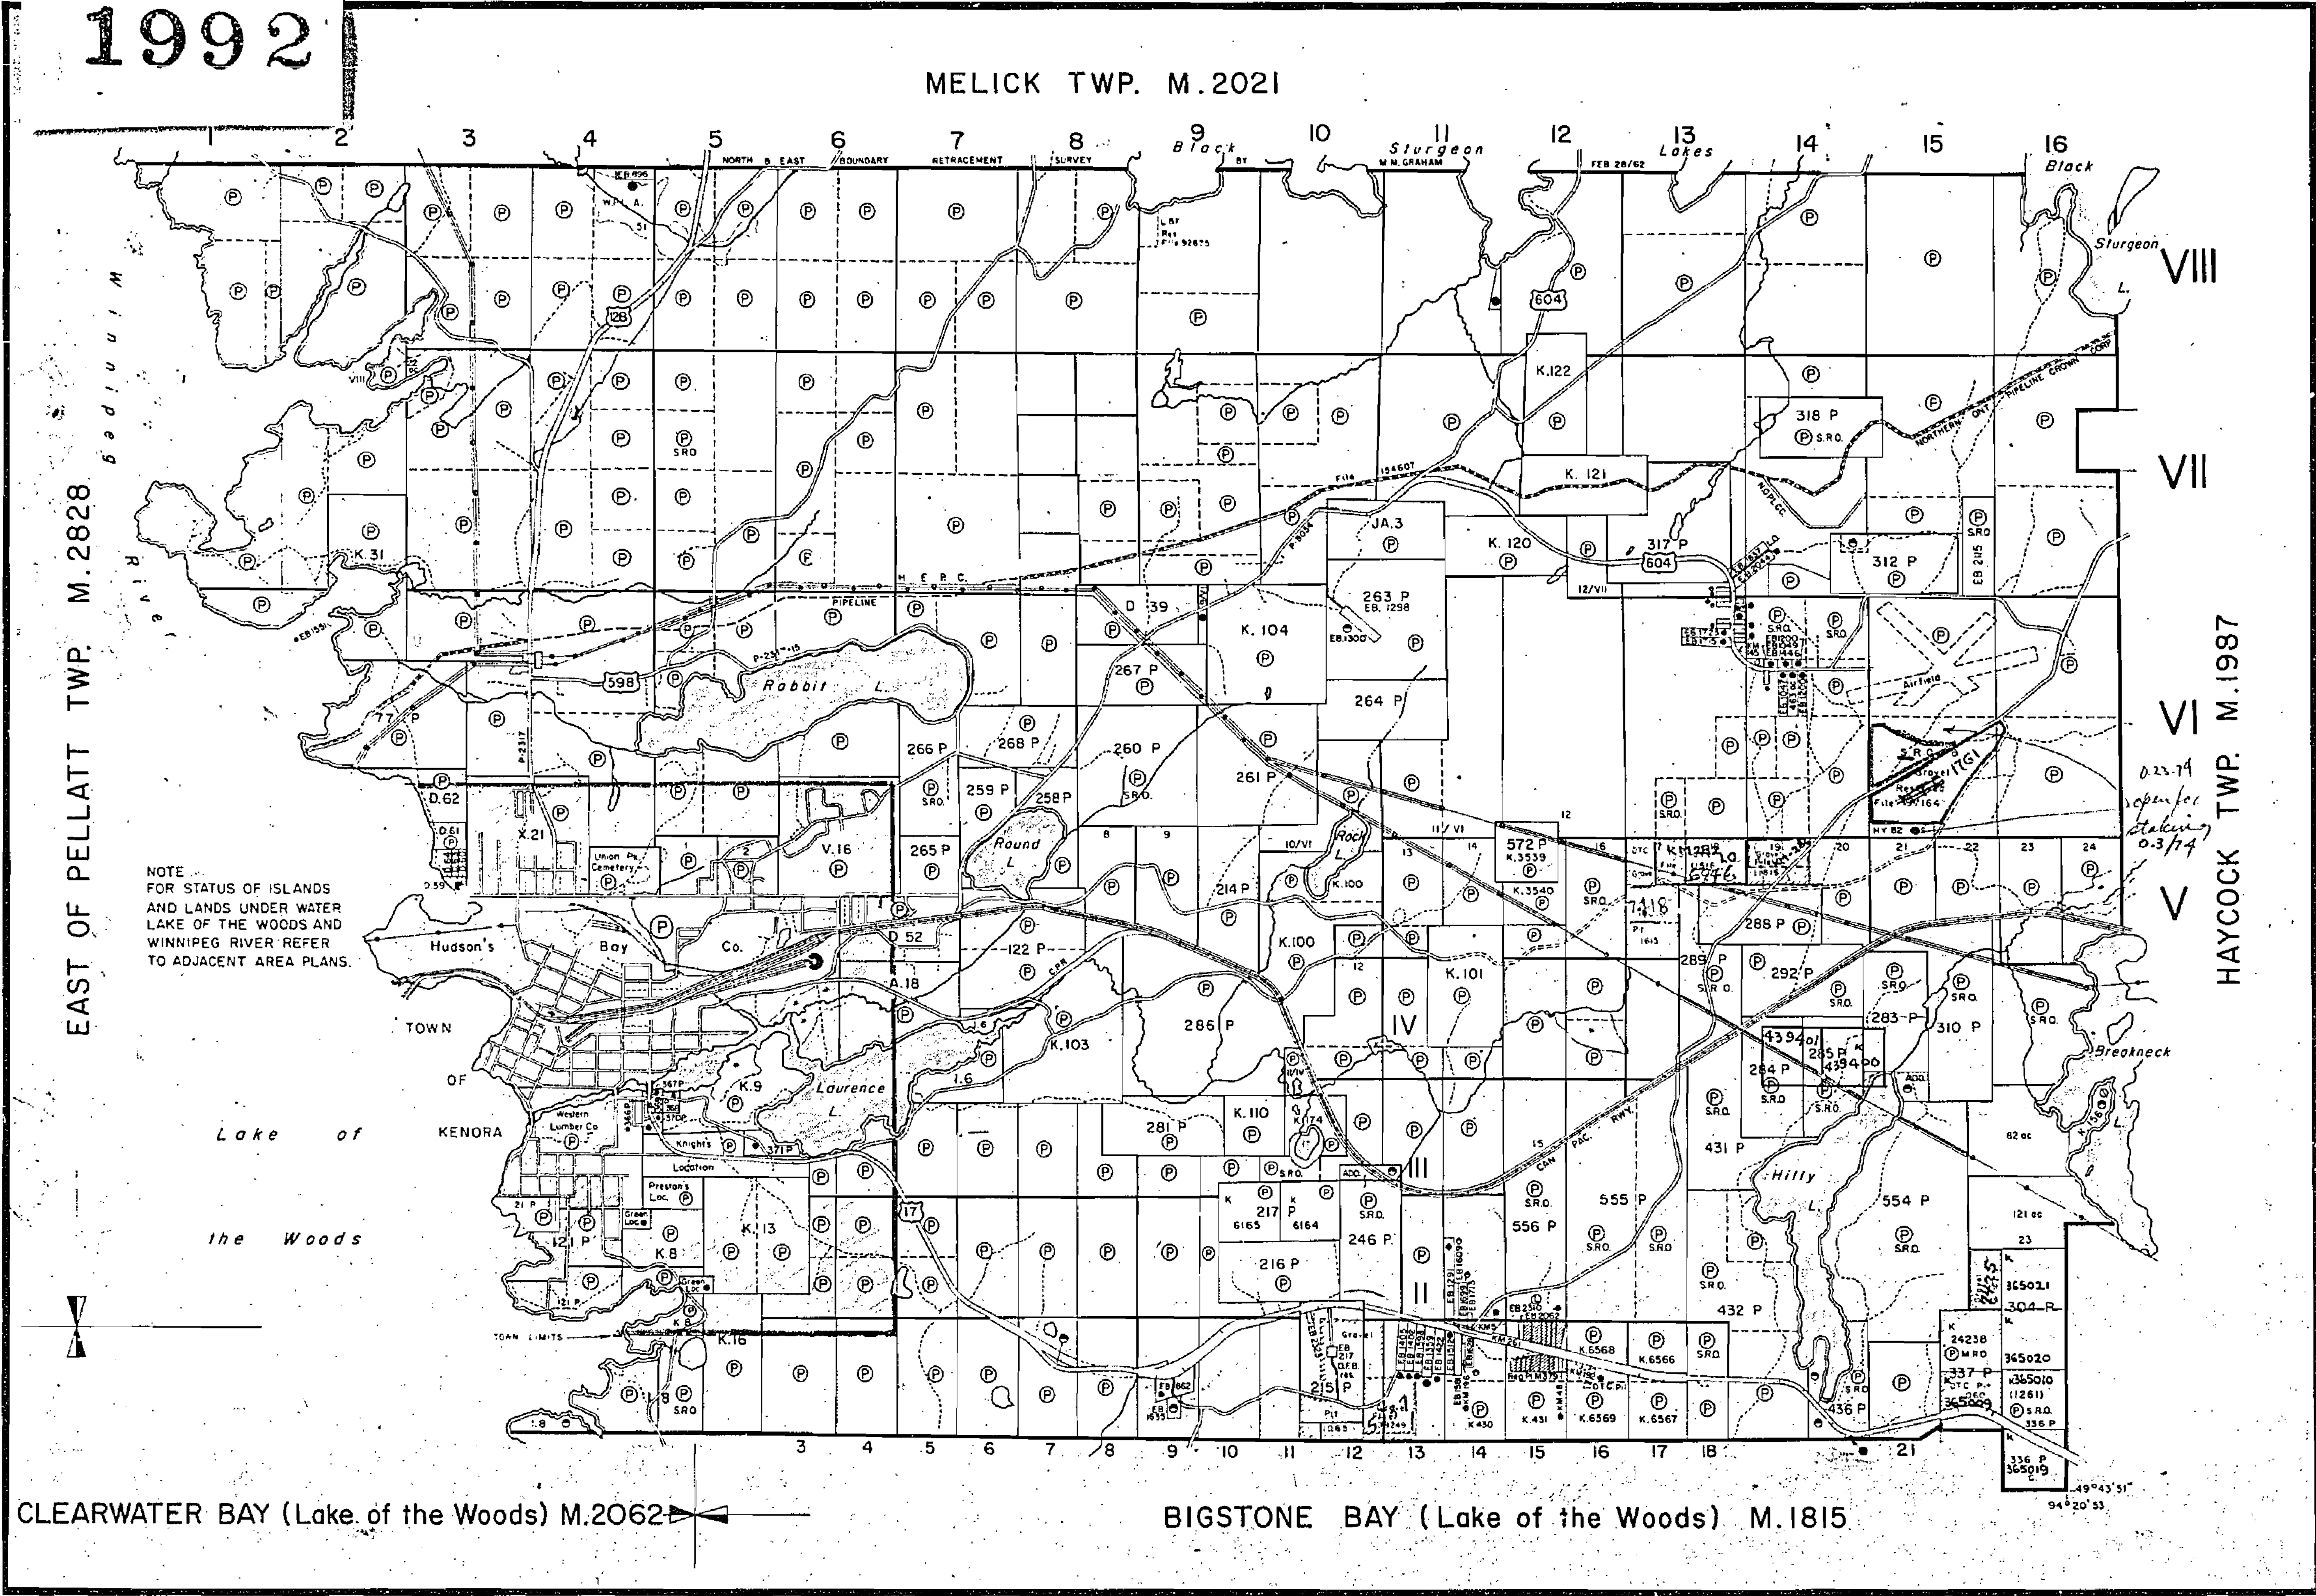
MELICK TWP. M.2021
EAST OF PELLATT TWP. M.2828
HAYCOCK TWP. M.1987
CLEARWATER BAY (Lake of the Woods) M.2062
BIGSTONE BAY (Lake of the Woods) M.1815
1
2
3
4
5
6
7
8
9
10
11
12
13
14
15
16
VIII
VII
VI
V
IV
III
II
NORTH & EAST BOUNDARY RETRACEMENT SURVEY
Black
Sturgeon
Lakes
Sturgeon L.
Winnipeg River
Rabbit L.
Round L.
Laurence L.
Rock L.
Hilly L.
Breakneck
Hudson's Bay Co.
TOWN OF KENORA
Lake of the Woods
Western Lumber Co
Union Pt. Cemetery
Knights Location
Preston's Loc.
TOWN LIMITS
Airfield
H.E.P.C.
PIPELINE
NORTHERN ONT. PIPELINE CROWN CORP.
CAN. PAC. RWY.
CPR
17
598
604
K.122
K.121
K.120
JA.3
K.104
K.31
K.100
K.101
K.103
K.110
K.9
K.13
K.8
K.16
D.39
D.62
D 52
X.21
V.16
A.18
L.6
263 P
264 P
267 P
266 P
268 P
260 P
261 P
259 P
258 P
265 P
122 P
286 P
281 P
217 P
216 P
246 P
215 P
572 P
286 P
289 P
292 P
283 P
285 P
284 P
310 P
318 P
317 P
312 P
431 P
432 P
555 P
556 P
554 P
436 P
337 P
336 P
121 P
S.R.O.
49°43'51"
94°20'53"
0.23.74
open for staking
0.3/74

NOTE
FOR STATUS OF ISLANDS
AND LANDS UNDER WATER
LAKE OF THE WOODS AND
WINNIPEG RIVER REFER
TO ADJACENT AREA PLANS.

NOTES

400' surface rights reservation along the shores of all lakes and rivers.

Flooding rights reserved on Winnipeg River and Alcock Lake to contour elev. 1051.20' GSC.
Jan. 23/40. File 4922 vol.5

H.E.P.C. flooding rights on Winnipeg River and Alcock Lake to contour elev. 1045' GSC.
W.P.L.A. 51 File 12999

KENORA MINING DIV.
RECEIVED
AUG 16 1971
AM PM
7 8 9 10 11 12 1 2 3 4 5 6

LEGEND

PATENTED LAND	Ⓟ or ●†
PATENTED FOR SURFACE RIGHTS ONLY	◓†
LEASE	Ⓛ
LICENSE OF OCCUPATION	L.O.
CROWN LAND SALES	C.S.
LOCATED LAND	Loc.
CANCELLED	C.
NOT THROWN OPEN FOR STAKING	⦸
MINING RIGHTS ONLY	M.R.O.
SURFACE RIGHTS ONLY	S.R.O.
HIGHWAY & ROUTE NO.	═(17)═
ROADS	═══
TRAILS	- - - - -
RAILWAYS	─┼─┼─┼─
POWER LINES	─●───●─
MARSH OR MUSKEG	⁂
MINES	⚒

† used only with summer resort locations or when space is limited.

TOWNSHIP OF

JAFFRAY

Feb 19/74

DISTRICT OF
KENORA

52 E16

KENORA
MINING DIVISION

#9

SCALE : 1 INCH = 40 CHAINS (1/2 MILE)

DR.	D.T.	PLAN NO. M.1992
DATE	JULY/71	

ONTARIO
DEPARTMENT OF MINES
AND NORTHERN AFFAIRS

JAFFRAY

1992

PLAN OF

JAFFRAY TWP.

#8 M-1992

KENORA MINING DIVISION.

DISTRICT OF KENORA.

Scale, 40 chains to an inch.

KENORA MINING DIV.
RECEIVED
JUN 3 1968

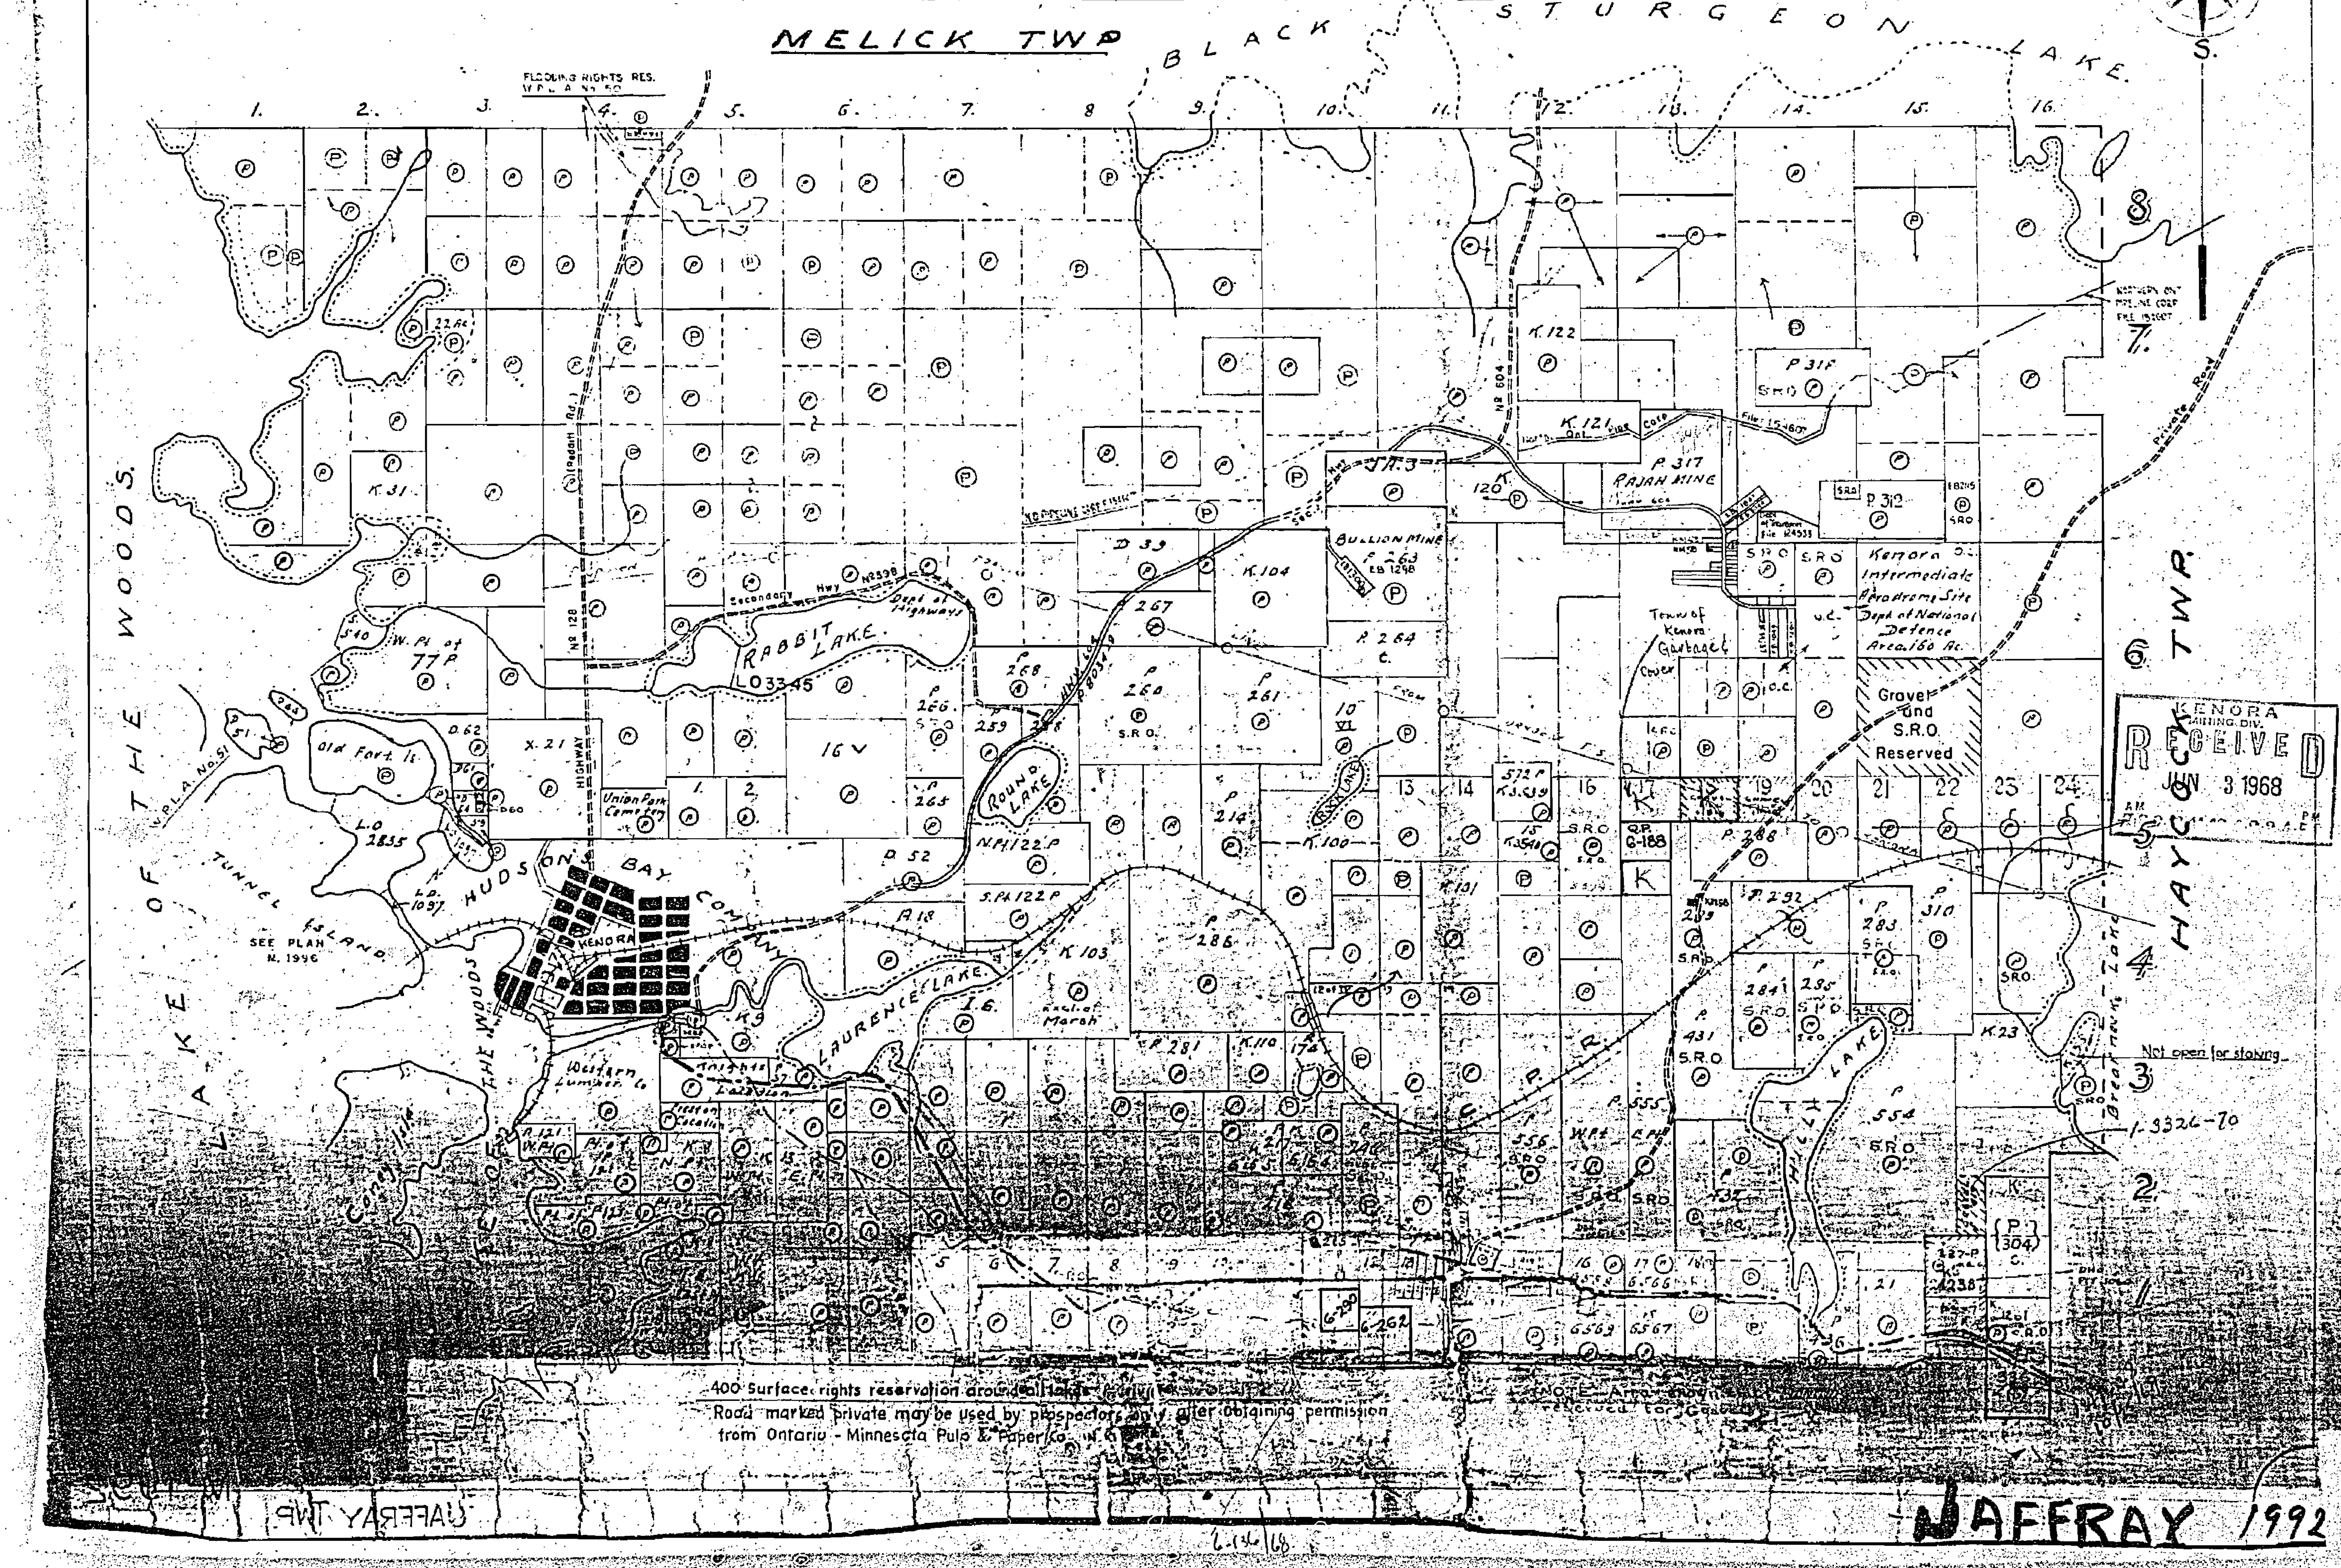

MELICK TWP
BLACK STURGEON LAKE
Ast. North.
W.
E.
S.
LAKE OF THE WOODS
HAYCOCK TWP
FLOODING RIGHTS RES.
RABBIT LAKE
ROUND LAKE
LAURENCE LAKE
Old Fort Is.
TUNNEL ISLAND
SEE PLAN M. 1996
HUDSON'S BAY COMPANY
KENORA
Union Park Cemetery
Western Lumber Co.
BULLION MINE
P. 263
P. 317 RAJAH MINE
Kenora Intermediate Aerodrome Site Dept. of National Defence Area 160 Ac.
Gravel and S.R.O. Reserved
Town of Kenora Garbage Dump
Secondary Hwy. No. 596
Northern Ont. Pipeline Corp.
Private Road
C.P.R.
Not open for staking
1-3326-70

400' Surface rights reservation around all lakes ...

Road marked private may be used by prospectors only after obtaining permission from Ontario - Minnesota Pulp & Paper Co.

NOTE - Area shown ... reserved for Gravel

6-136/68

JAFFRAY 1992

1992

S.½ Lot 15, Con. 6 Reforestation SRO withdrawn from staking Sec. 39 (d) No QP 7/18/55 RES. -A-

337P and part of 304P L & F Reservation removed.
See RES. J . 12/10/63

Gravel and staking reservation on Lots 9, 10, 11,
Con. 1 - Reservation continued until Jan. 1/63
See RES.J. 7/23/62 (121394)

OTE:

rea marked thus ▨,
ithdrawn from staking under
ection 39(d) of the Mg. Act.
lso gravel in the same area,
eserved from disposition.

PLAN OF
JAFFRAY TWP.
KENORA MINING DIVISION.
DISTRICT OF KENORA.

Scale, 40 chains to an inch.

RECEIVED
MAY 17 1962
KENORA MINING DIV.

May 27/63
Sept 10/63
June 23/64

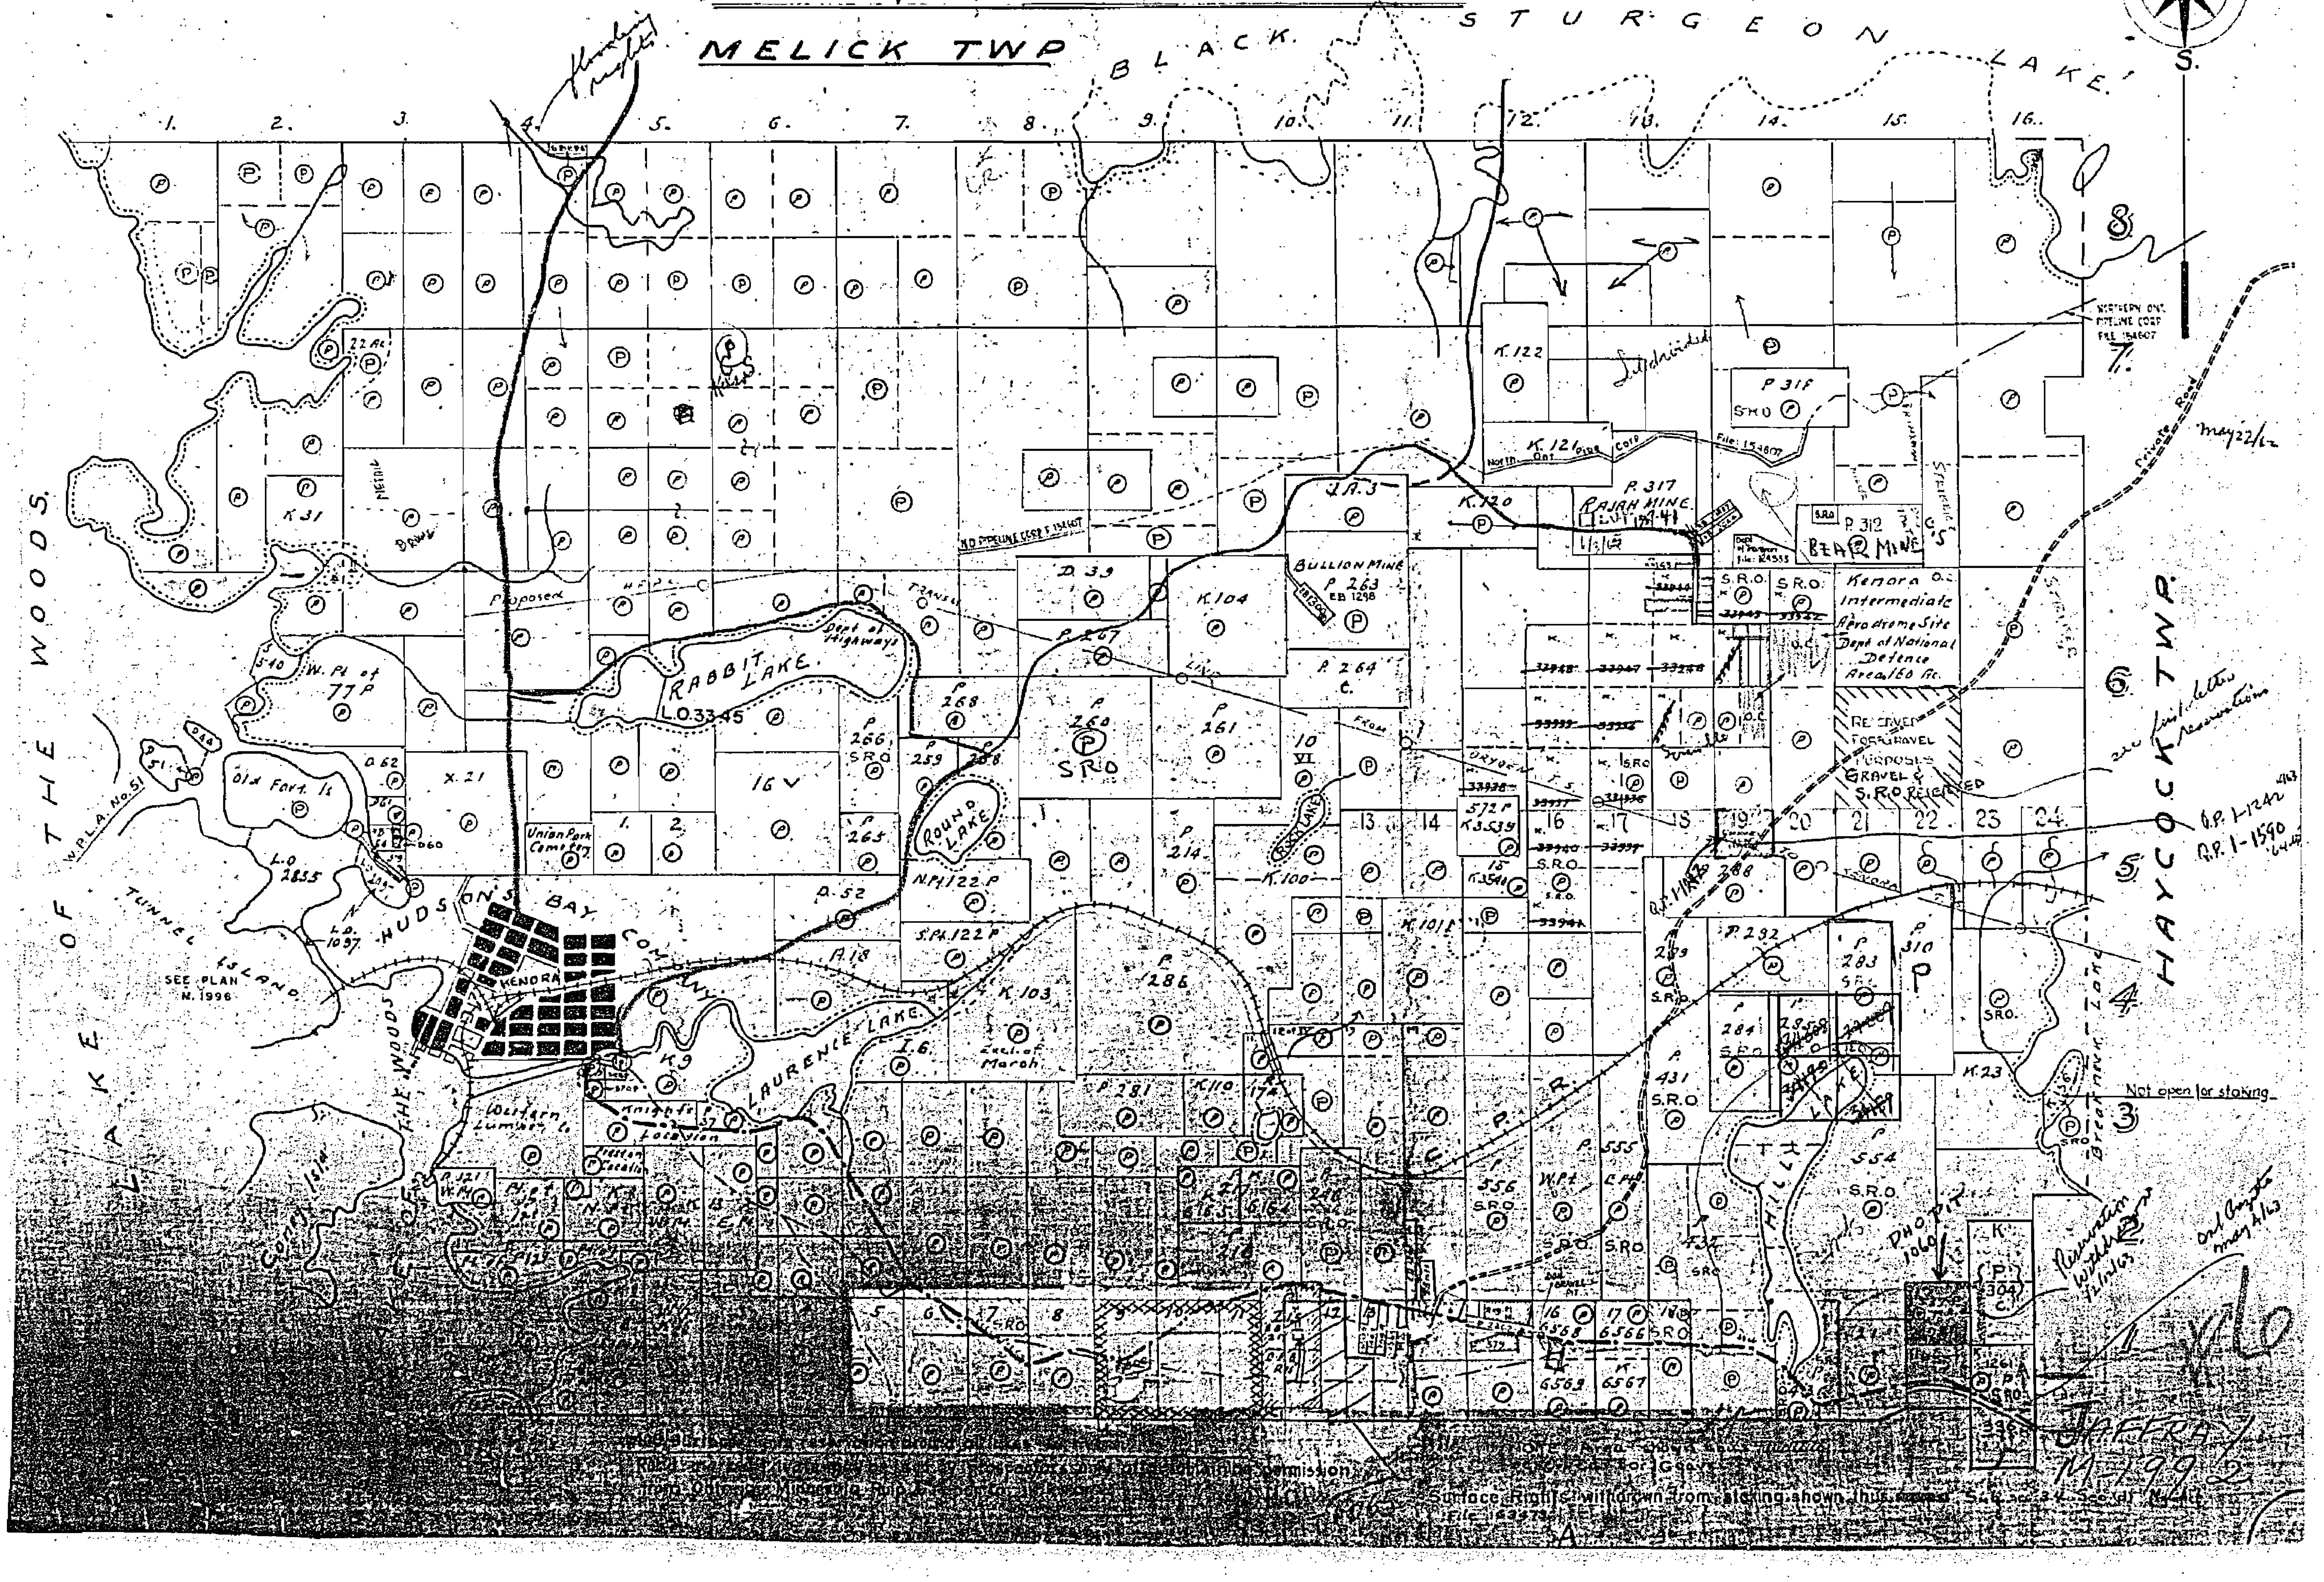
MELICK TWP
BLACK STURGEON LAKE
AST NORTH
W.
E.
S.
1. 2. 3. 4. 5. 6. 7. 8. 9. 10. 11. 12. 13. 14. 15. 16.
8
7.
6
5
4
3
HAYCOCK TWP.
LAKE OF THE WOODS
TUNNEL ISLAND
SEE PLAN M.1996
Old Fort Is
RABBIT LAKE
L.O.3345
ROUND LAKE
LAURENCE LAKE
HUDSON'S BAY COMPANY
KENORA
Western Lumber Co.
Union Park Cemetery
Dept of Highways
Proposed
BULLION MINE
P. 263
RAJAH MINE
P. 317
BEAR MINE
P. 312
Kenora Intermediate Aerodrome Site
Dept of National Defence
Area 160 Ac.
RESERVED FOR GRAVEL PURPOSES
GRAVEL & S.R.O. RELEASED
K.122
K.121
K.120
K.104
K.103
K.100
K.31
K.23
K.9
P. 318
P. 267
P. 264
P. 260
P. 261
P. 268
P. 266
P. 265
P. 214
P. 286
P. 281
P. 283
P. 284
P. 292
P. 310
P. 431
P. 554
P. 555
P. 556
D. 39
D. 52
J.A.3
S.R.O.
Not open for staking
Surface Rights withdrawn from staking shown thus
File 163473
Slashed
Private Road
may 22/62
see file letter re reservations
O.P. 1-1242
O.P. 1-1590
Reservation withdrawn 12/10/63
and Gravel
JAFFRAY M-1992

1992

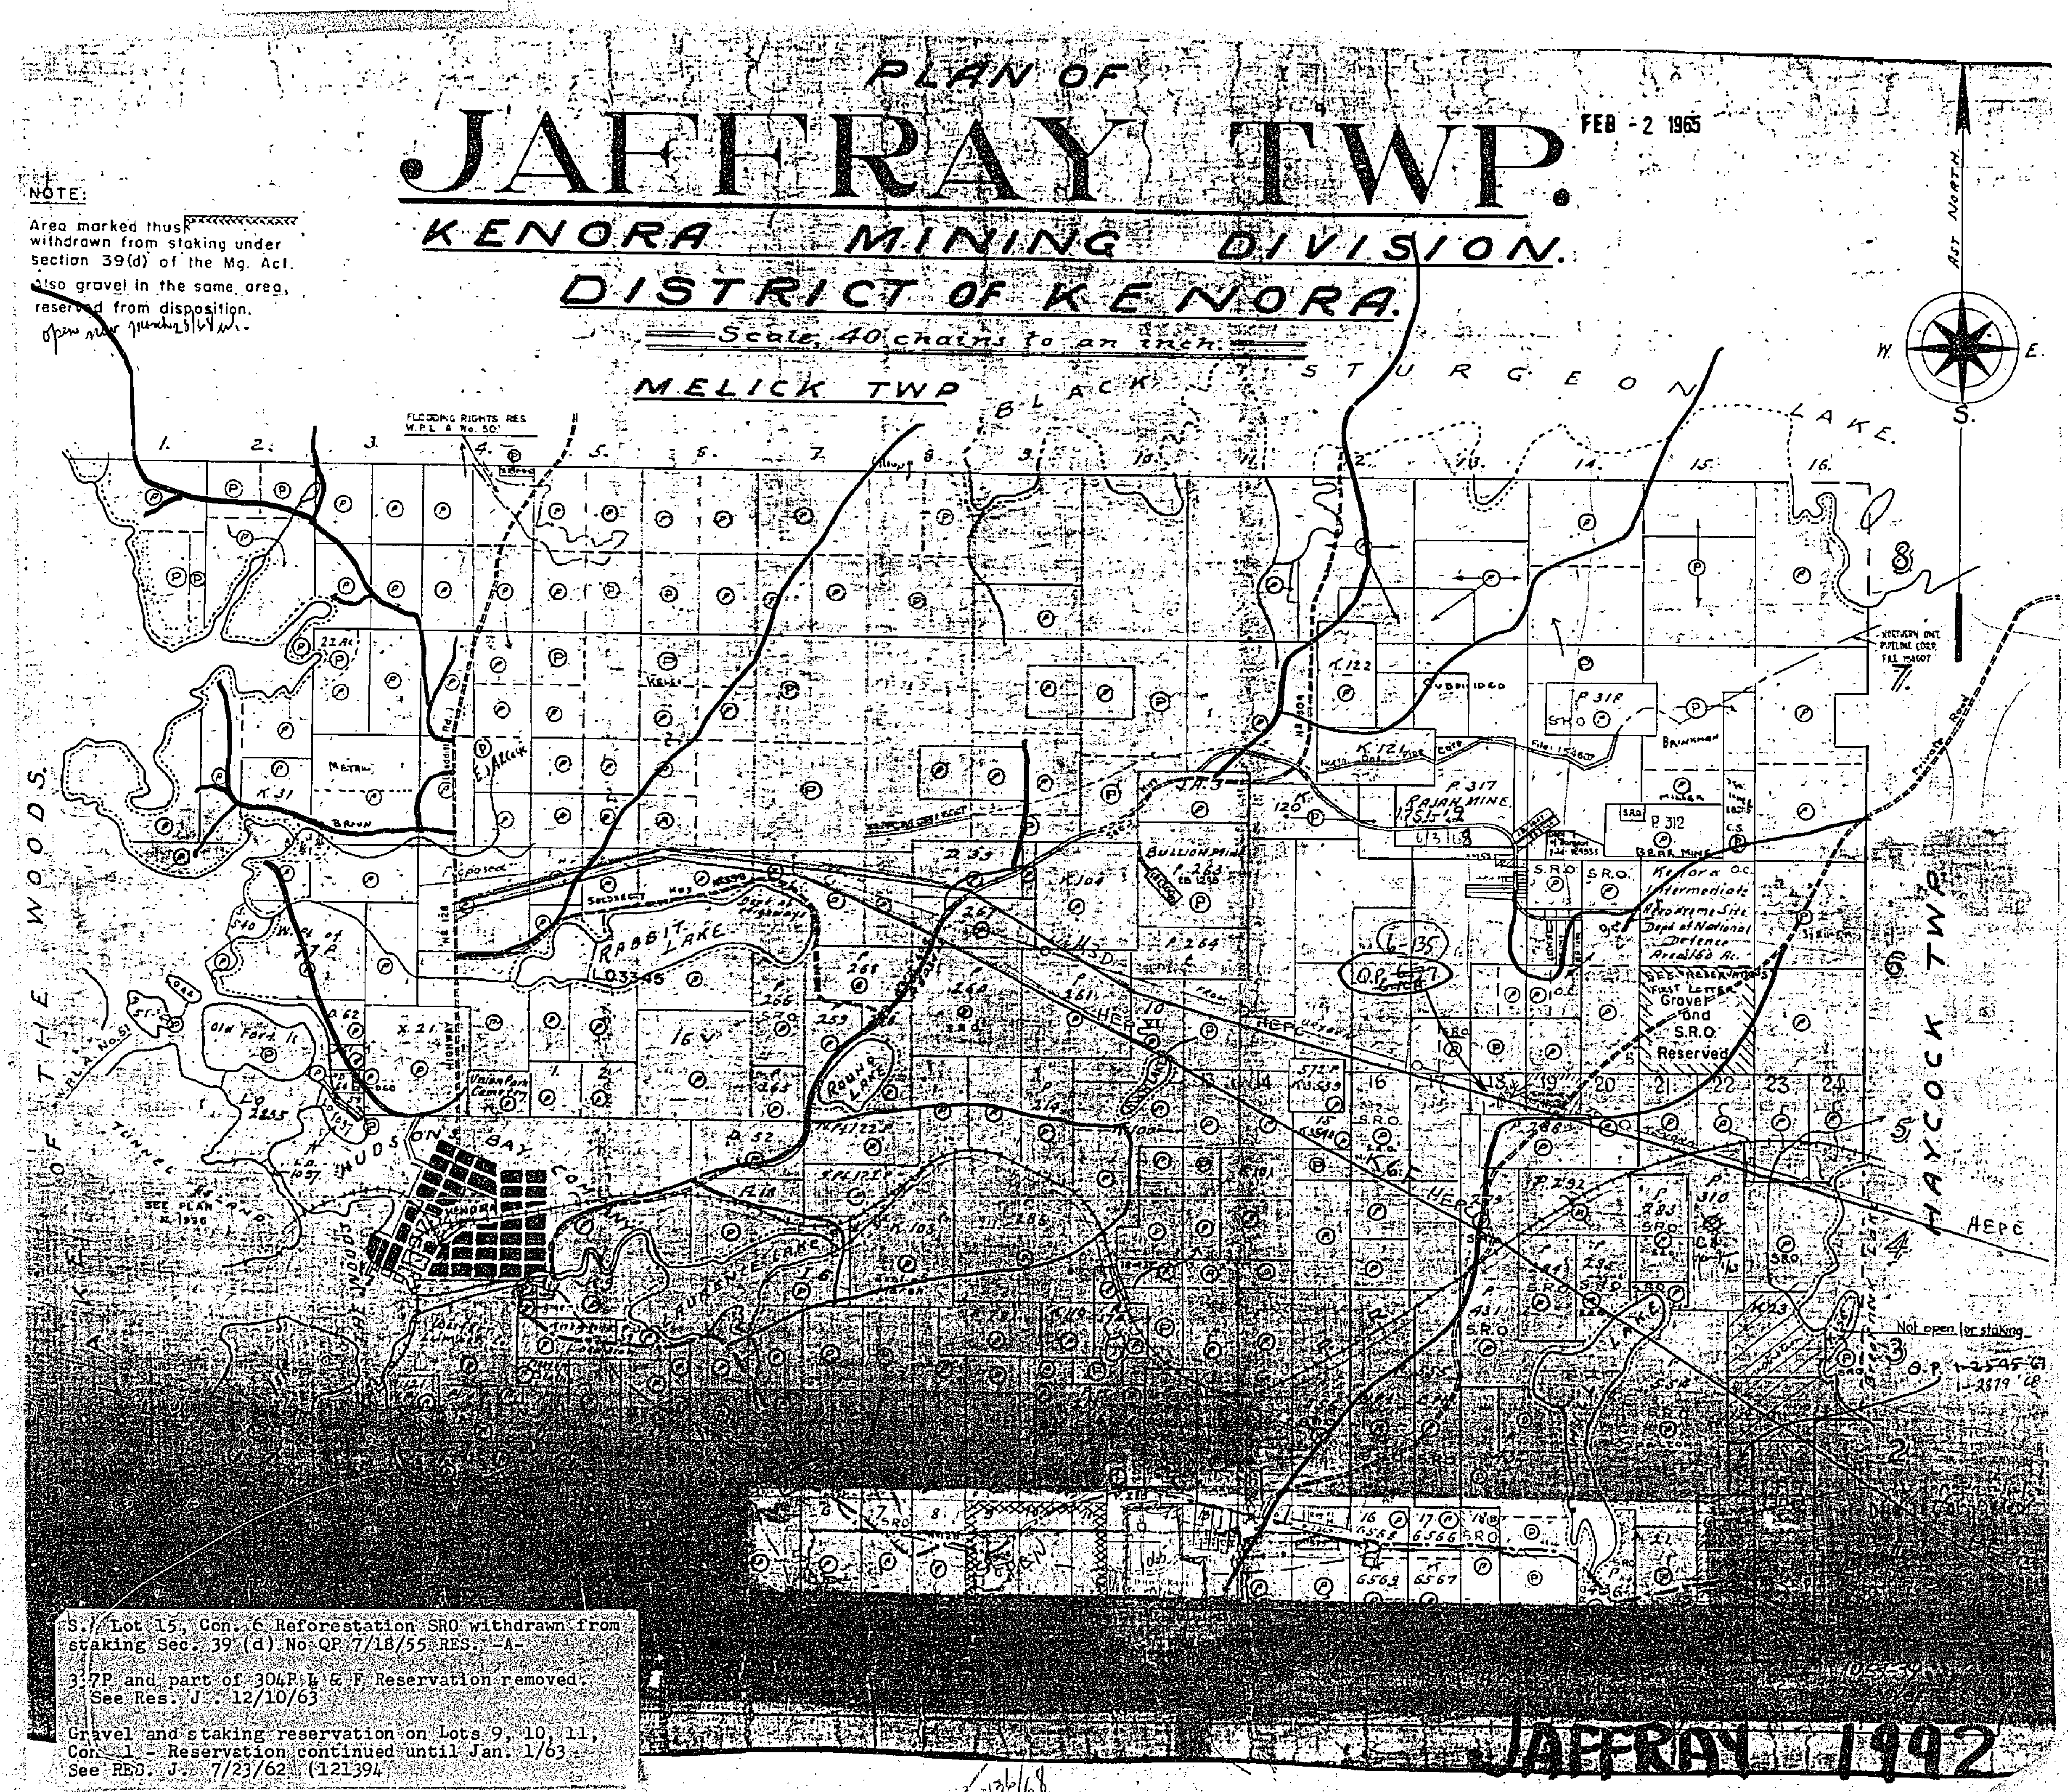

PLAN OF
JAFFRAY TWP.
KENORA MINING DIVISION.
DISTRICT OF KENORA.
Scale, 40 chains to an inch.

FEB - 2 1965

NOTE:
Area marked thus withdrawn from staking under section 39(d) of the Mg. Act.
Also gravel in the same area, reserved from disposition.
open now pending 3/4/69 ...

S.½ Lot 15, Con. 6 Reforestation SRO withdrawn from staking Sec. 39 (d) No QP 7/18/55 RES. -A-

3?7P and part of 304P L & F Reservation removed. See Res. J. 12/10/63

Gravel and staking reservation on Lots 9, 10, 11, Con. 1 - Reservation continued until Jan. 1/63 See RES. J. 7/23/62 (121394

JAFFRAY 1992

6-136/68

MELICK TWP
BLACK STURGEON LAKE
HAYCOCK TWP.
LAKE OF THE WOODS
FLOODING RIGHTS RES. W.P.L. & No. 50
Ast. NORTH
W.
E.
S.
RABBIT LAKE
ROUND LAKE
HUDSON BAY COMPANY
KENORA
RAJAH MINE
BULLION MINE
BEAR MINE
Kenora O.C. Intermediate Aerodrome Site Dept. of National Defence Area 160 Ac.
Gravel and S.R.O. Reserved
NORTHERN ONT. PIPELINE CORP. FILE 146607
Private Road
Not open for staking
O.P. 12545 '67
2879 '68
HEPC
S.R.O.
Tunnel
Union Park Cemetery
Old Fort Is.
1. 2. 3. 4. 5. 6. 7. 8. 9. 10. 11. 12. 13. 14. 15. 16.
8 7 6 5 4 3 2
K.31
K.21
K.121
K.122
P.317
P.318
P.312
P.263
P.264
L.135
O.P.

1992

PLAN OF
JAFFRAY TWP.
KENORA MINING DIVISION.
DISTRICT OF KENORA.
Scale, 40 chains to an inch.

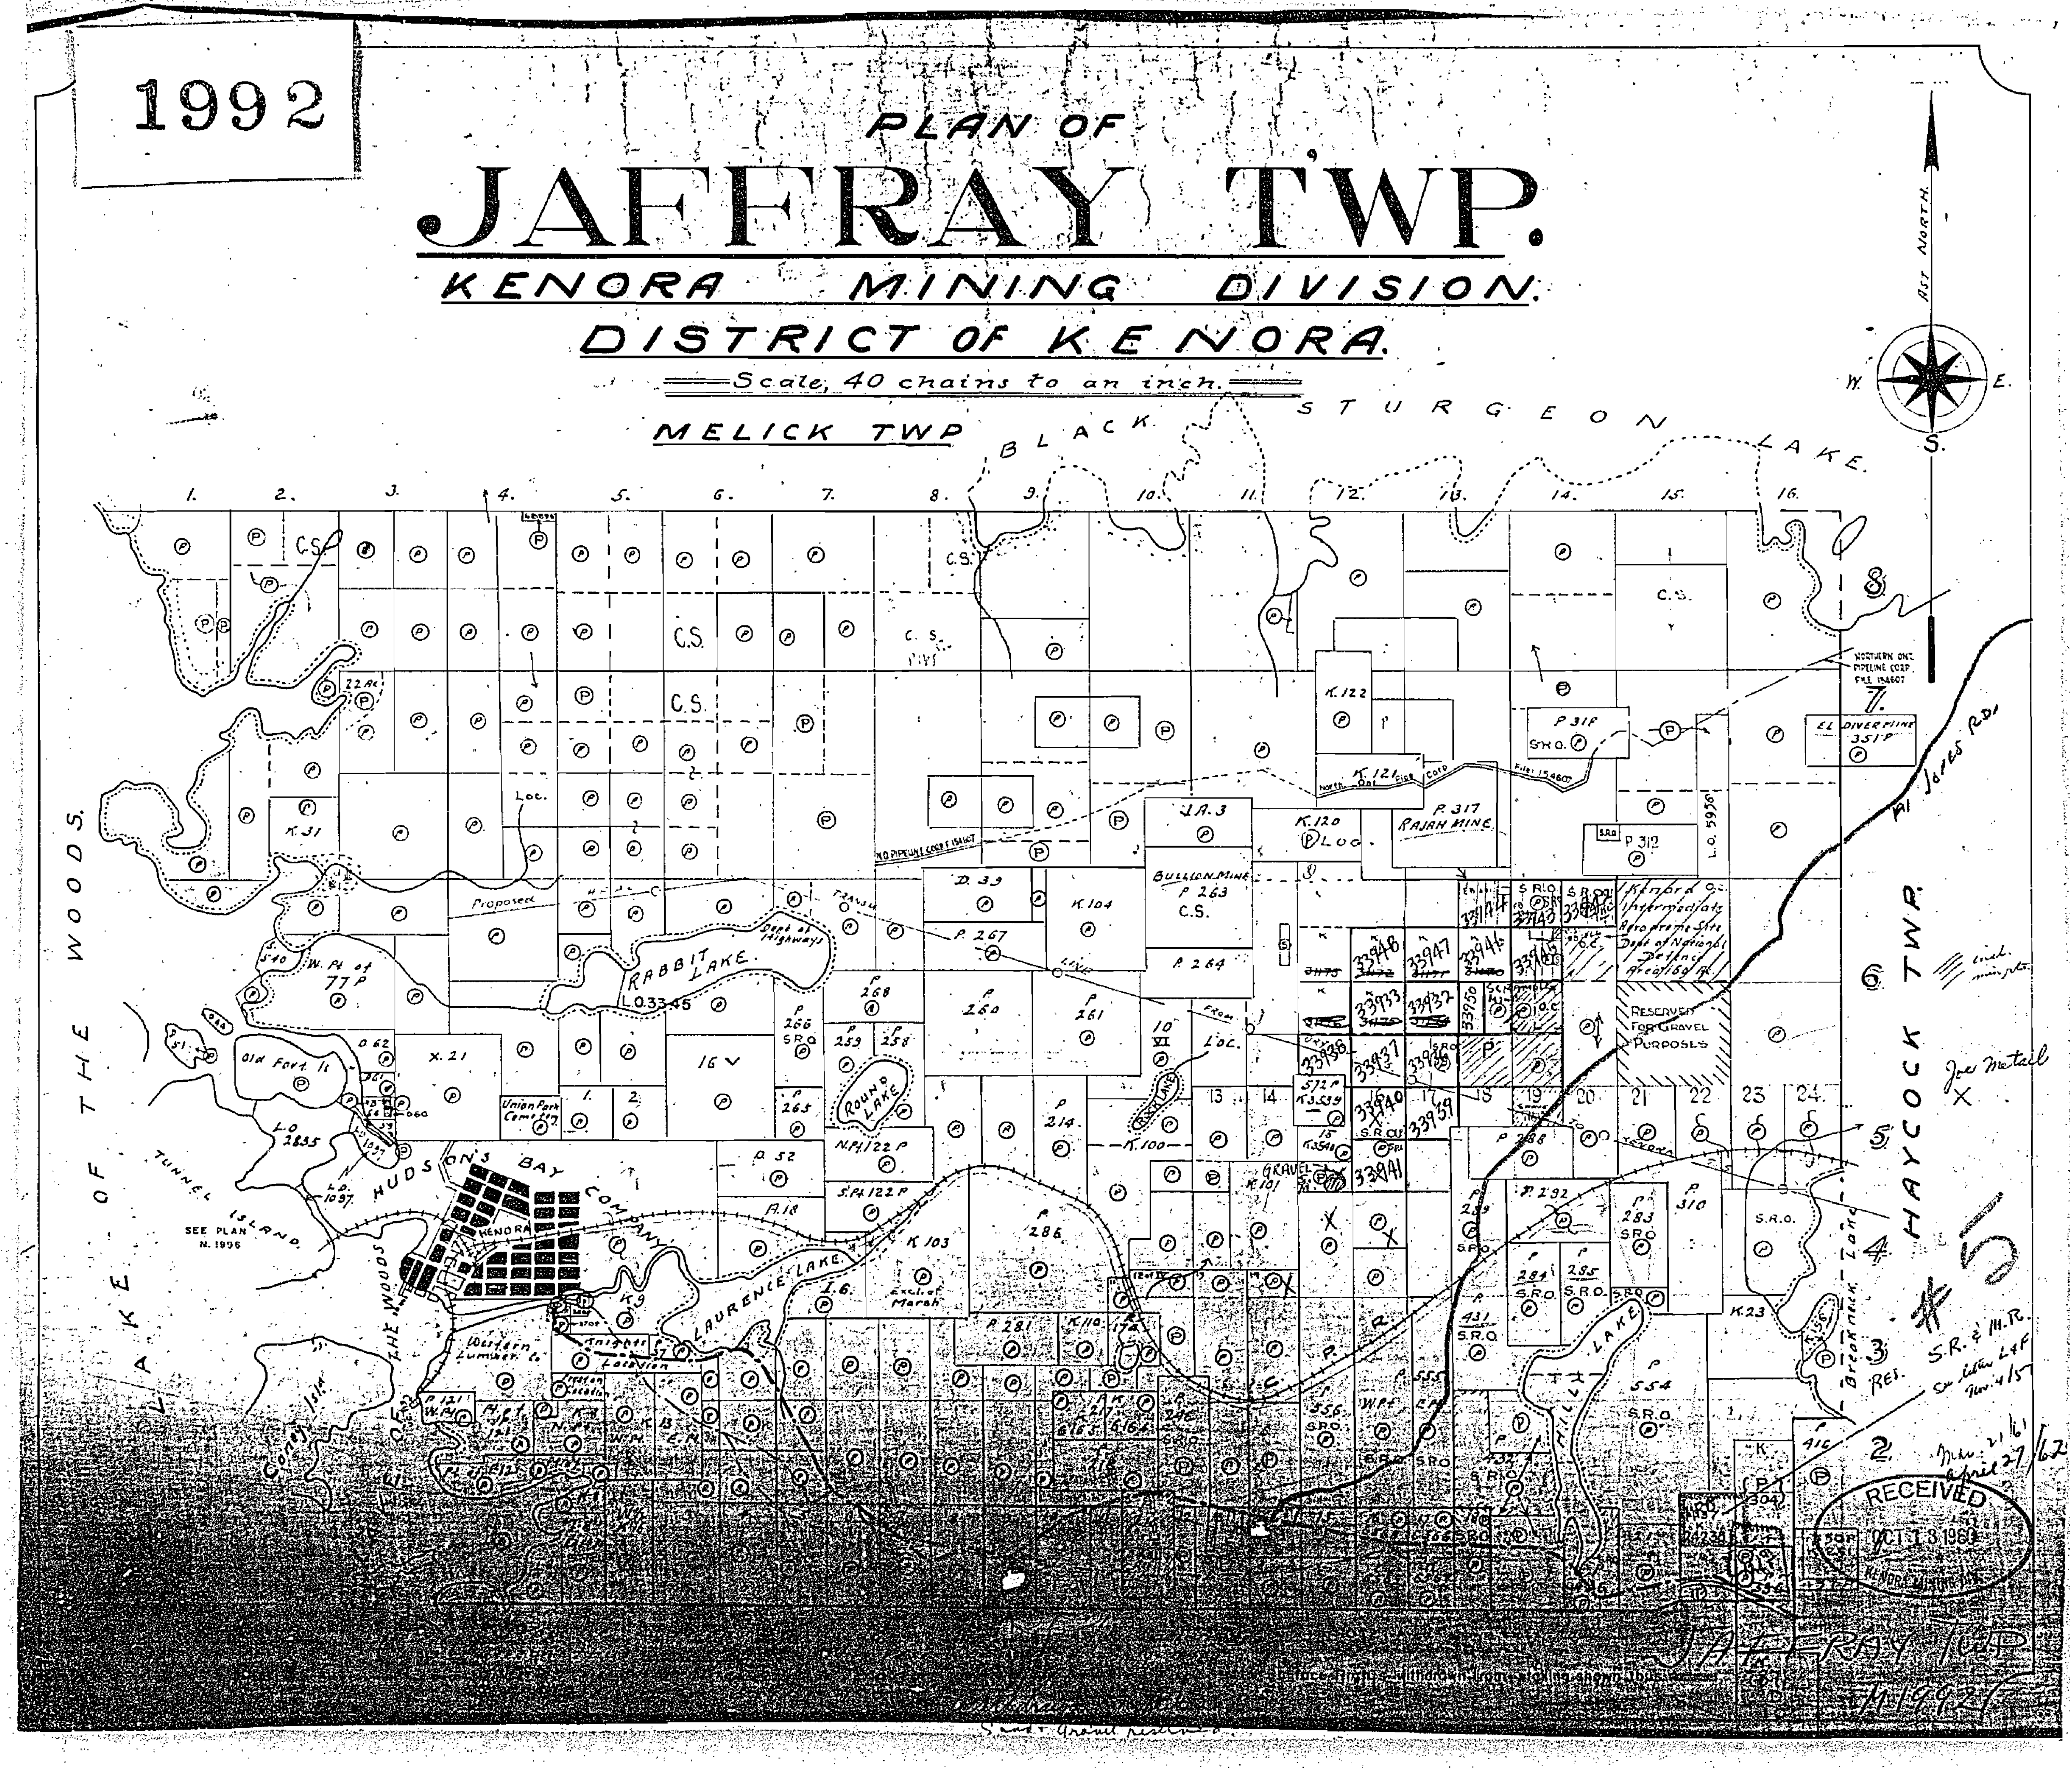

MELICK TWP
BLACK STURGEON LAKE
AST. NORTH
N.
W.
E.
S.
1. 2. 3. 4. 5. 6. 7. 8. 9. 10. 11. 12. 13. 14. 15. 16.
8
7
6
5
4
3
2
HAYCOCK TWP.
LAKE OF THE WOODS
C.S.
K.122
K.121
K.120
K.31
P 318
S.R.O.
P 317
RAJAH MINE
P 312
L.O. 5956
EL DIVER MINE 351 P
NORTHERN ONT. PIPELINE CORP. FILE 154607
N.O. PIPELINE CORP. F.154607
North Ont. Pipe Corp. File 154607
JA.3
BULLION MINE P 263 C.S.
D.39
K.104
P.267
P.264
P 260
P 261
268
266 S.R.O.
259
258
265
N.Pt.122 P
S.Pt.122 P
D.52
A.18
K.103
286
P.214
K.100
K.101
GRAVEL PIT
RABBIT LAKE
Dept of Highways
L.O.3345
ROUND LAKE
Proposed
W. Pt of 77 P
Old Fort Id
X.21
16
Union Park Cemetery
L.O. 2835
L.O. 1097
TUNNEL ISLAND
SEE PLAN N.1996
HUDSON'S BAY COMPANY
KENORA
LAURENCE LAKE
Western Lumber Co
Knight's Location
Coney Isld
OF THE WOODS
Kenora Intermediate Aerodrome Site Dept of National Defence Area 169 Ac.
RESERVED FOR GRAVEL PURPOSES
33946
33947
33948
33945
33944
33943
33933
33932
33938
33937
33940
33939
33941
P 288
P.292
283 S.R.O.
P 310
284 S.R.O.
285 S.R.O.
431 S.R.O.
554 S.R.O.
556 S.R.O.
P 281
K.110
K.23
P 416
C.P.R.
HILLY LAKE
Brokenhead Lake
Res.
S.R. & M.R.
See letter L&F Nov 4/57
Jones Rd.
Joe Metail
#5
Mar 21 '61
April 27 '62
RECEIVED OCT 13 1960
KENORA MINING DIV.
JAFFRAY TWP
M.1992
S. Sand & Gravel Restriction

[illegible] staking Sec. 39 (d) No QP 7/18/55 RES. -A-

337P and part of 304P L & F Reservation removed.
See RES. J . 12/10/63

Gravel and staking reservation on Lots 9, 10, 11,
Con. 1 - Reservation continued until Jan. 1/63
See RES.J. 7/23/62 (121394)

OTE:

rea marked thus ▨
ithdrawn from staking under
ection 39(d) of the Mg. Act.
lso gravel in the same area,
eserved from disposition.

RECEIVED
MAY 17 1962

May 27/63
Sept 10/63
June 23/64

PLAN OF

JAFFRAY TWP.

KENORA MINING DIVISION.

DISTRICT OF KENORA.

Scale, 40 chains to an inch.

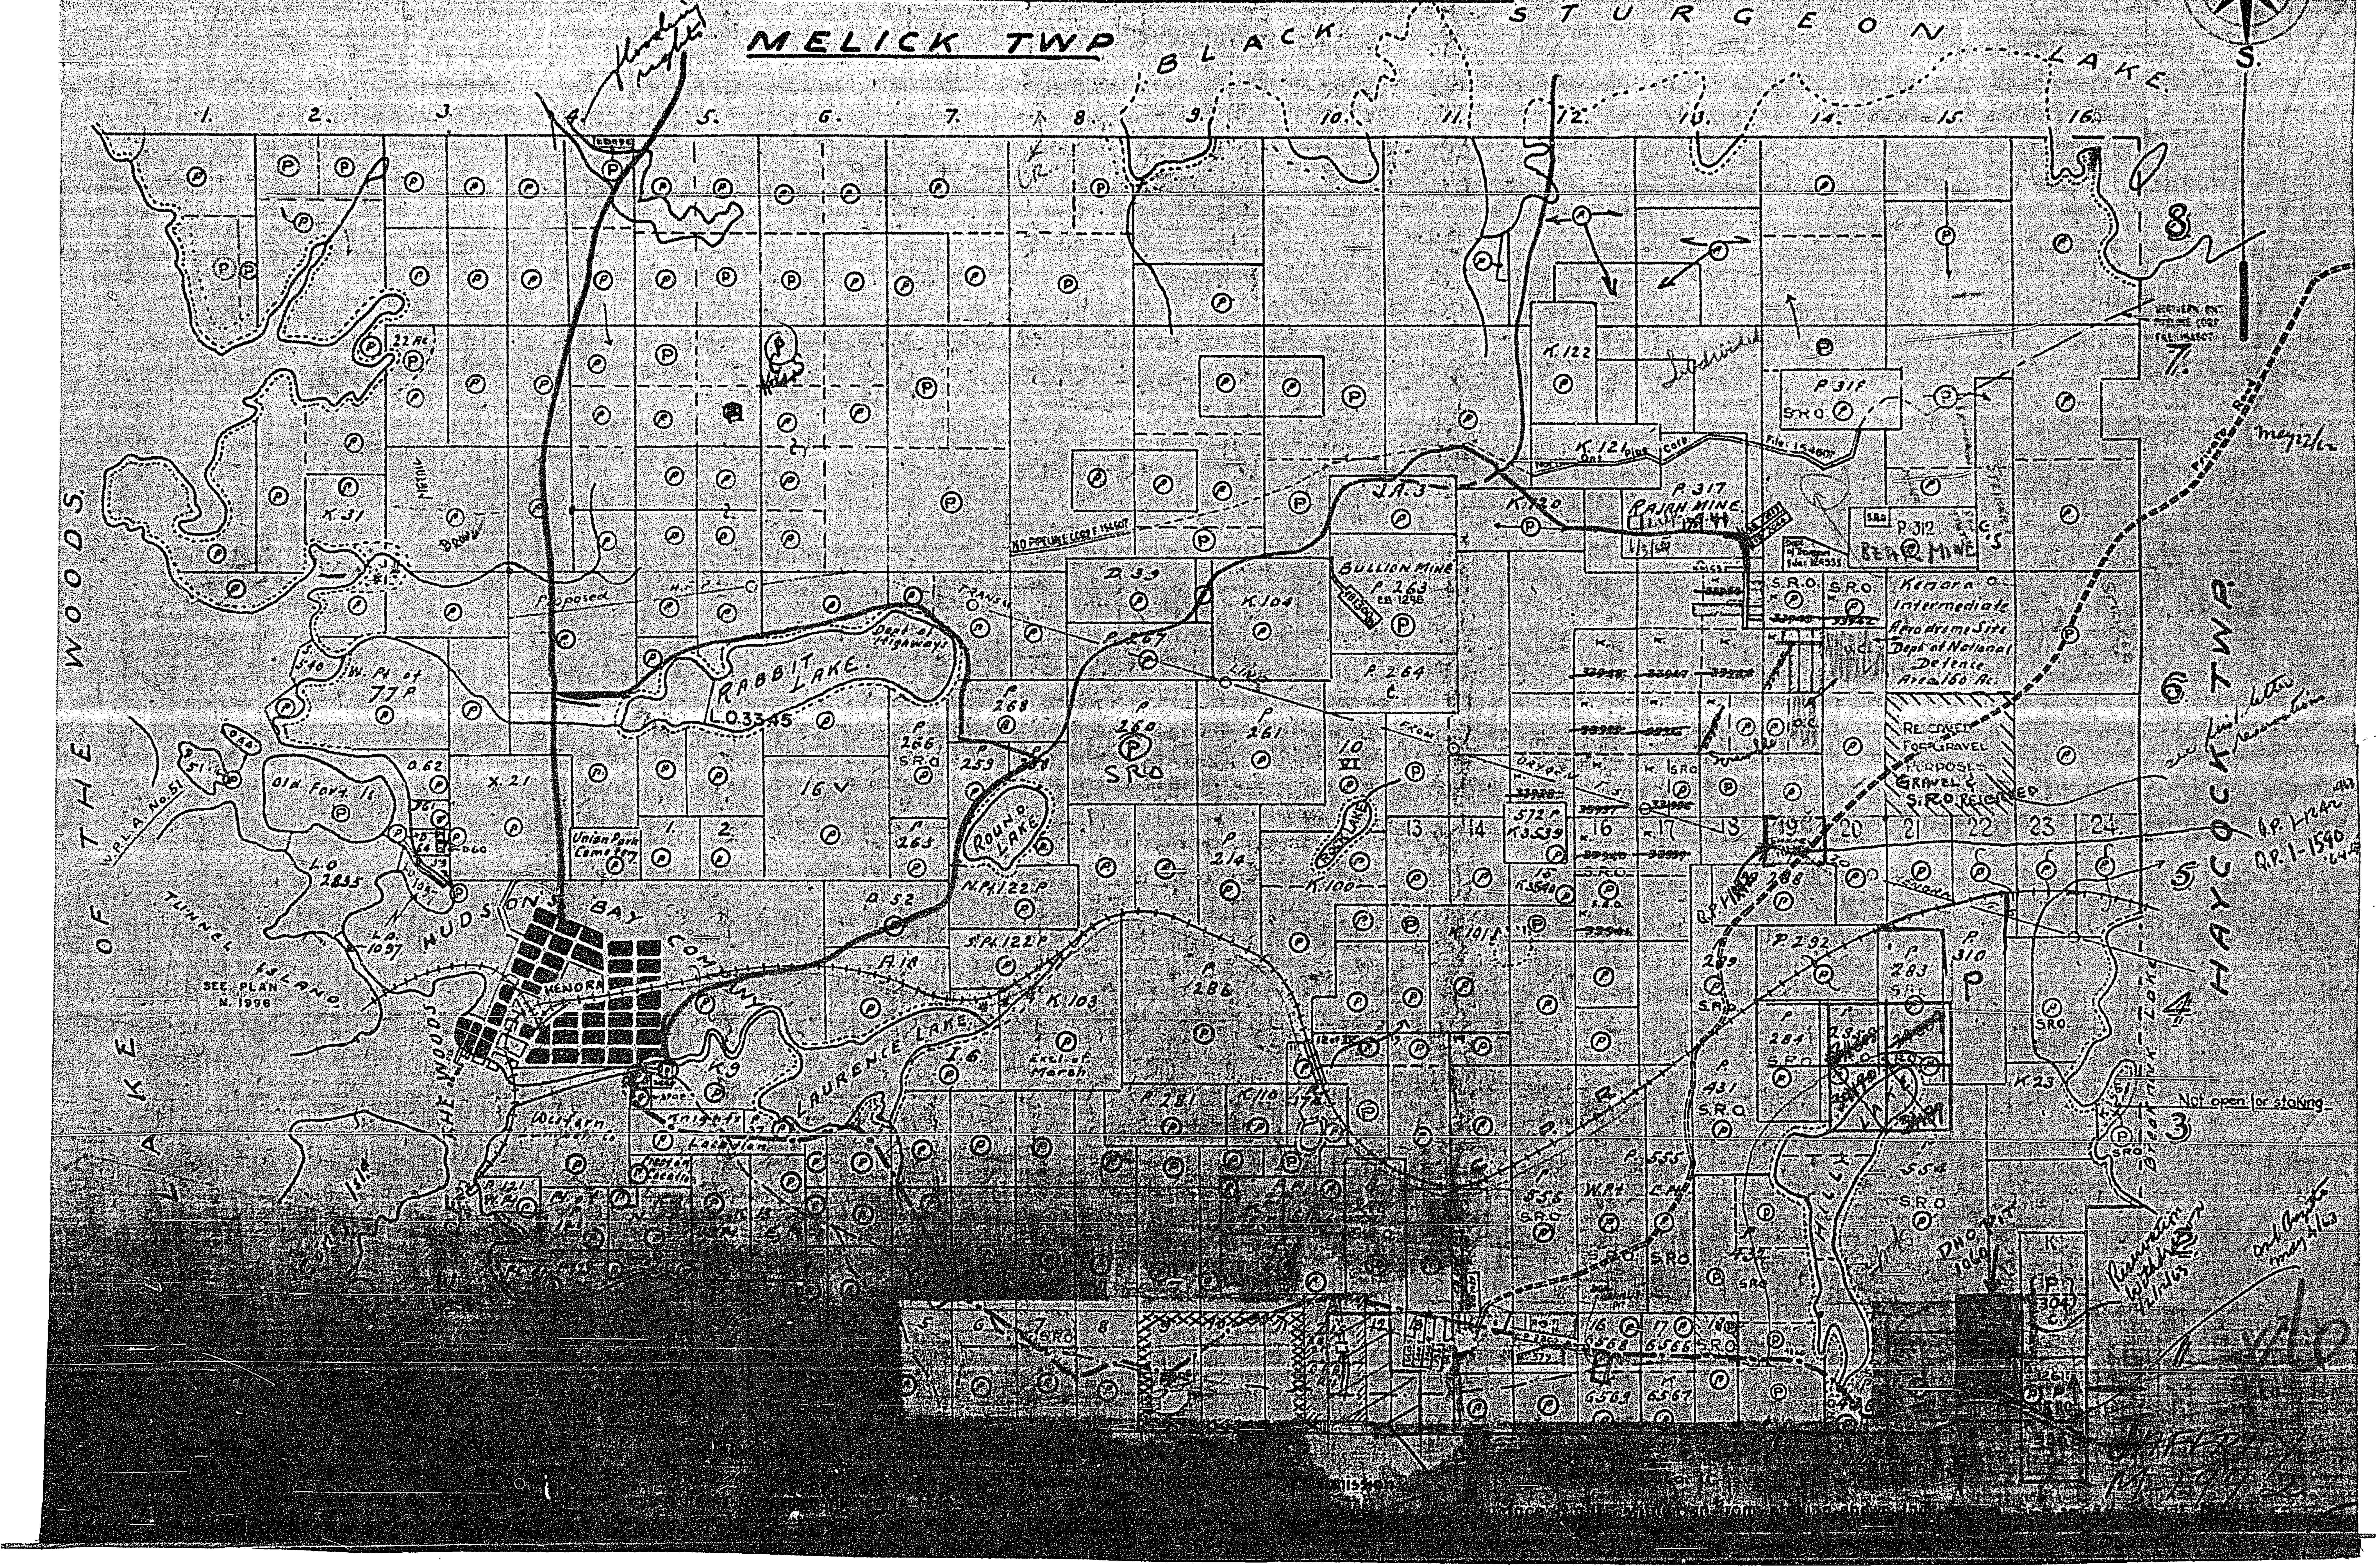

AST. NORTH
N.
W.
E.
S.
MELICK TWP
BLACK STURGEON LAKE
Hunting rights
1. 2. 3. 4. 5. 6. 7. 8. 9. 10. 11. 12. 13. 14. 15. 16.
8
7
6
5
4
3
P
K.122
K.121
K.120
K.31
P 31F
S.R.O.
P.317
RAIRH MINE
P.312
BEAR MINE
Subdivided
J.A.3
D.39
K.104
BULLION MINE
P.263
P.264
P.267
P.268
P.266
P.265
P.261
259
260
S.R.O.
Kenora Intermediate Aerodrome Site
Dept of National Defence
Area 150 Ac.
RESERVED FOR GRAVEL PURPOSES
GRAVEL & S.R.O. RELEASED
20 21 22 23 24
13 14 16 17 18 19
Proposed
Dept. of Highways
RABBIT LAKE
L.O. 33.45
W. Pt. of 77P
Old Fort Is.
K. 21
16 V
Union Park Cemetery
1. 2.
ROUND LAKE
P.214
K.100
K.101
D.52
N.Pt.122 P
S.Pt.122 P
A.18
K.103
P.286
P.292
P.283
P.310
P.284
P.289
P.431
P.555
P.554
K.23
K 9
I.6
Excl. of Marsh
LAURENCE LAKE
P.281
K.110
W.P.L.A. No.51
L.O. 2835
L.O. 1097
HUDSONS BAY COMPANY
KENORA
TUNNEL ISLAND
SEE PLAN M. 1998
LAKE OF THE WOODS
HAYCOCK TWP
Western
Lakeview
Not open for staking
Private Road
Q.P. 1-1590
Reservation withdrawn
DND Pit
Oct 1963
6568 6566 6563 6567
5 6 7 8 S.R.O.

PLAN OF

JAFFRAY TWP.

KENORA MINING DIVISION.

DISTRICT OF KENORA.

Scale, 40 chains to an inch.

8 # M-1992

KENORA MINING DIV.
RECEIVED
JUN 3 1968

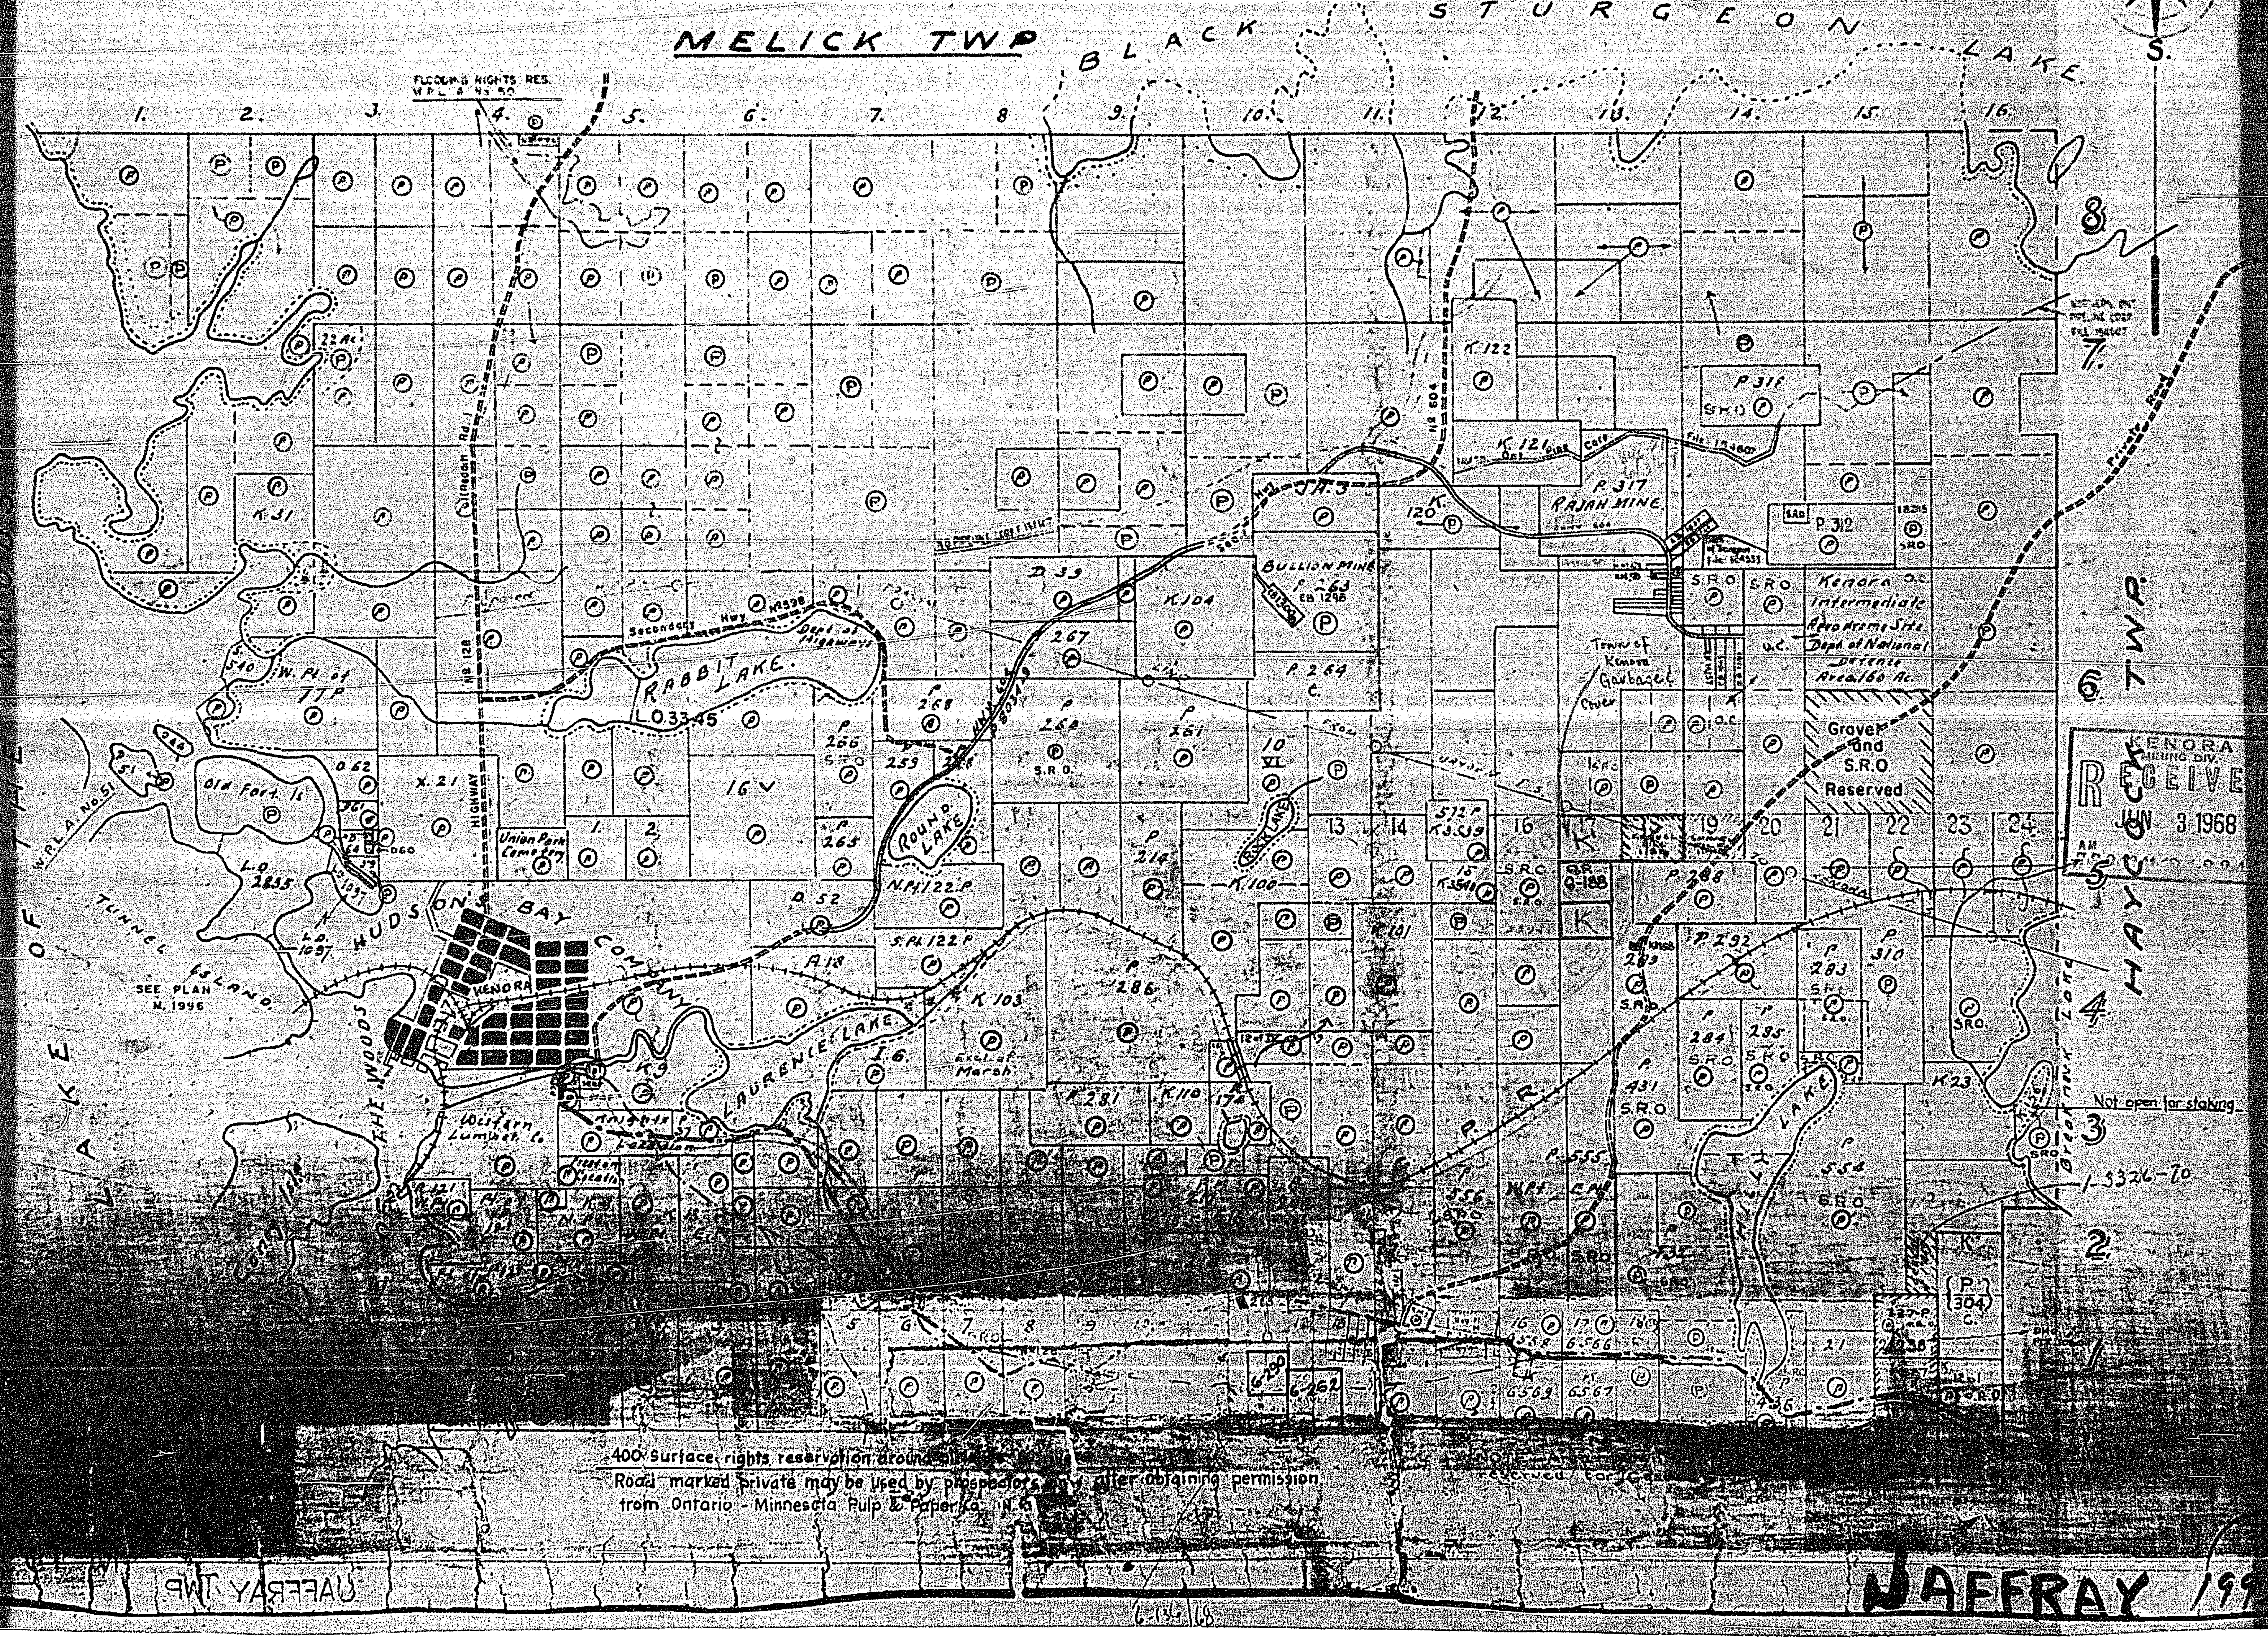

ALL NORTH
N
W
E
S
MELICK TWP
BLACK STURGEON LAKE
FLOODING RIGHTS RES.
LAKE OF THE WOODS
HAYCOCK TWP
RABBIT LAKE
L.O. 33.45
ROUND LAKE
LAURENCE LAKE
Secondary Hwy No 598
Dept of Highways
Old Fort Is.
TUNNEL ISLAND
SEE PLAN M.1996
HUDSONS BAY COMPANY
KENORA
W.P.L. No 51
THE WOODS
Western Lumber Co.
Union Park Cemetery
BULLION MINE
RAJAH MINE
Town of Kenora Garbage Cover
Kenora Intermediate Aero Drome Site Dept of National Defence Area 160 Ac.
Gravel and S.R.O. Reserved
Not open for staking
K.31
K.21
K.104
K.103
K.100
K.110
K.121
K.122
K.9
K.23
P.311
P.312
P.317
P.263
P.264
P.265
P.266
P.267
P.268
P.214
P.286
P.281
P.283
P.284
P.285
P.288
P.292
P.310
P.431
P.552
P.555
P.556
D.33
D.52
N.Pt.122 P.
S.Pt.122 P.
S.R.O.
1-3326-70
400' Surface rights reservation around all lakes
Road marked private may be used by prospectors only after obtaining permission from Ontario - Minnesota Pulp & Paper Co. Ltd.
JAFFRAY TWP
JAFFRAY 1992

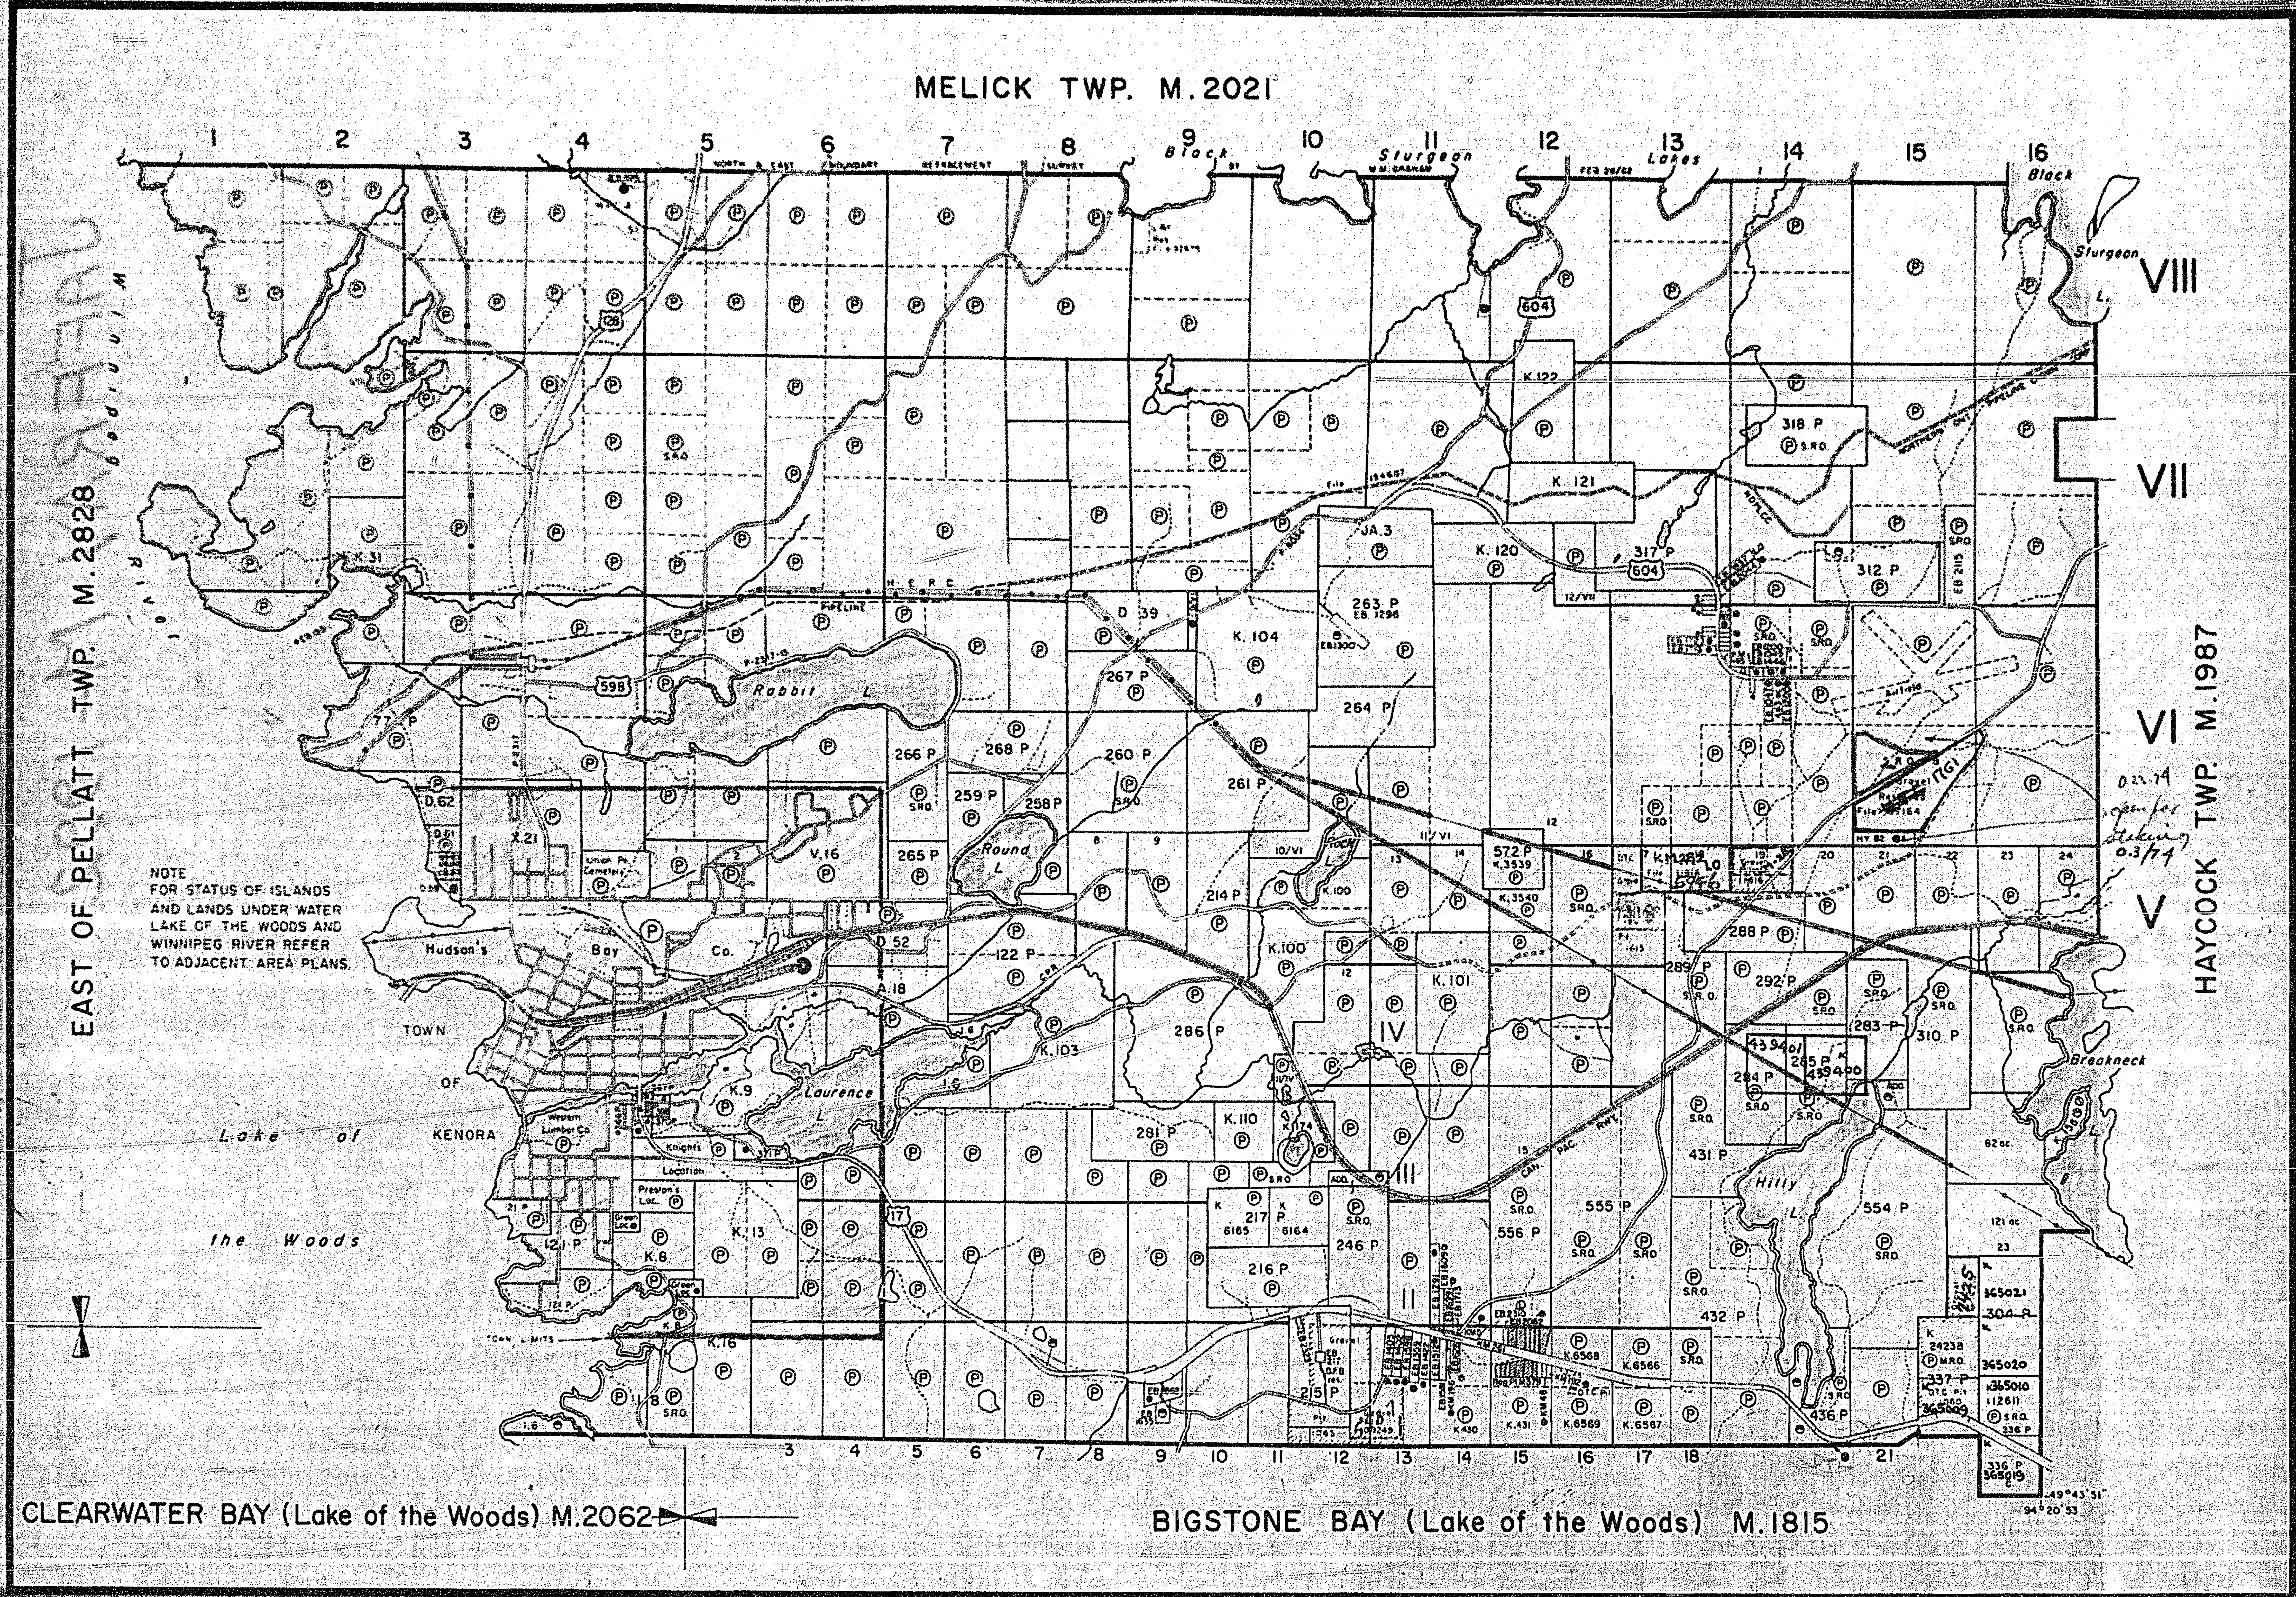
MELICK TWP. M.2021
EAST OF PELATT TWP. M.2828
HAYCOCK TWP. M.1987
CLEARWATER BAY (Lake of the Woods) M.2062
BIGSTONE BAY (Lake of the Woods) M.1815
Winnipeg River
Sturgeon Lakes
Block
Rabbit L.
Round L.
Laurence L.
Hilly L.
Breakneck
Hudson's Bay Co.
TOWN OF KENORA
Lake of the Woods
VIII
VII
VI
V
IV
III
II
598
604
17
H.E.P.C.
Pipeline
C.P.R.
49°43'51"
94°20'53"

NOTE
FOR STATUS OF ISLANDS AND LANDS UNDER WATER LAKE OF THE WOODS AND WINNIPEG RIVER REFER TO ADJACENT AREA PLANS.

NOTES

400' surface rights reservation along the shores of all lakes and rivers.

Flooding rights reserved on Winnipeg River and Alcock Lake to contour elev. 1051.20' GSC.
Jan. 23/40 File 4922 vol. 5

H.E.P.C. flooding rights on Winnipeg River and Alcock Lake to contour elev. 1045' GSC
W.P.L.A. 51 File 12999

KENORA
MINING DIV.
RECEIVED
AUG 16 1971
AM PM
7,8,9,10,11,12,1,2,3,4,5,6

LEGEND

PATENTED LAND	Ⓟ or ●†
PATENTED FOR SURFACE RIGHTS ONLY	◓†
LEASE	Ⓛ
LICENSE OF OCCUPATION	L.O.
CROWN LAND SALES	C.S.
LOCATED LAND	Loc.
CANCELLED	C
NOT THROWN OPEN FOR STAKING	⊘
MINING RIGHTS ONLY	M.R.O.
SURFACE RIGHTS ONLY	S.R.O.
HIGHWAY & ROUTE NO.	17
ROADS	═
TRAILS	---
RAILWAYS	┼┼┼
POWER LINES	•—•
MARSH OR MUSKEG	⬭
MINES	⚒

† used only with summer resort locations or when space is limited.

TOWNSHIP OF
JAFFRAY
Feb 19/74

DISTRICT OF
KENORA

52 E16

KENORA
MINING DIVISION

#9

SCALE: 1 INCH = 40 CHAINS (1/2 MILE)

DR. D.T.
DATE JULY/71
PLAN NO. M.1992

ONTARIO
DEPARTMENT OF MINES
AND NORTHERN AFFAIRS

JAFFRAY

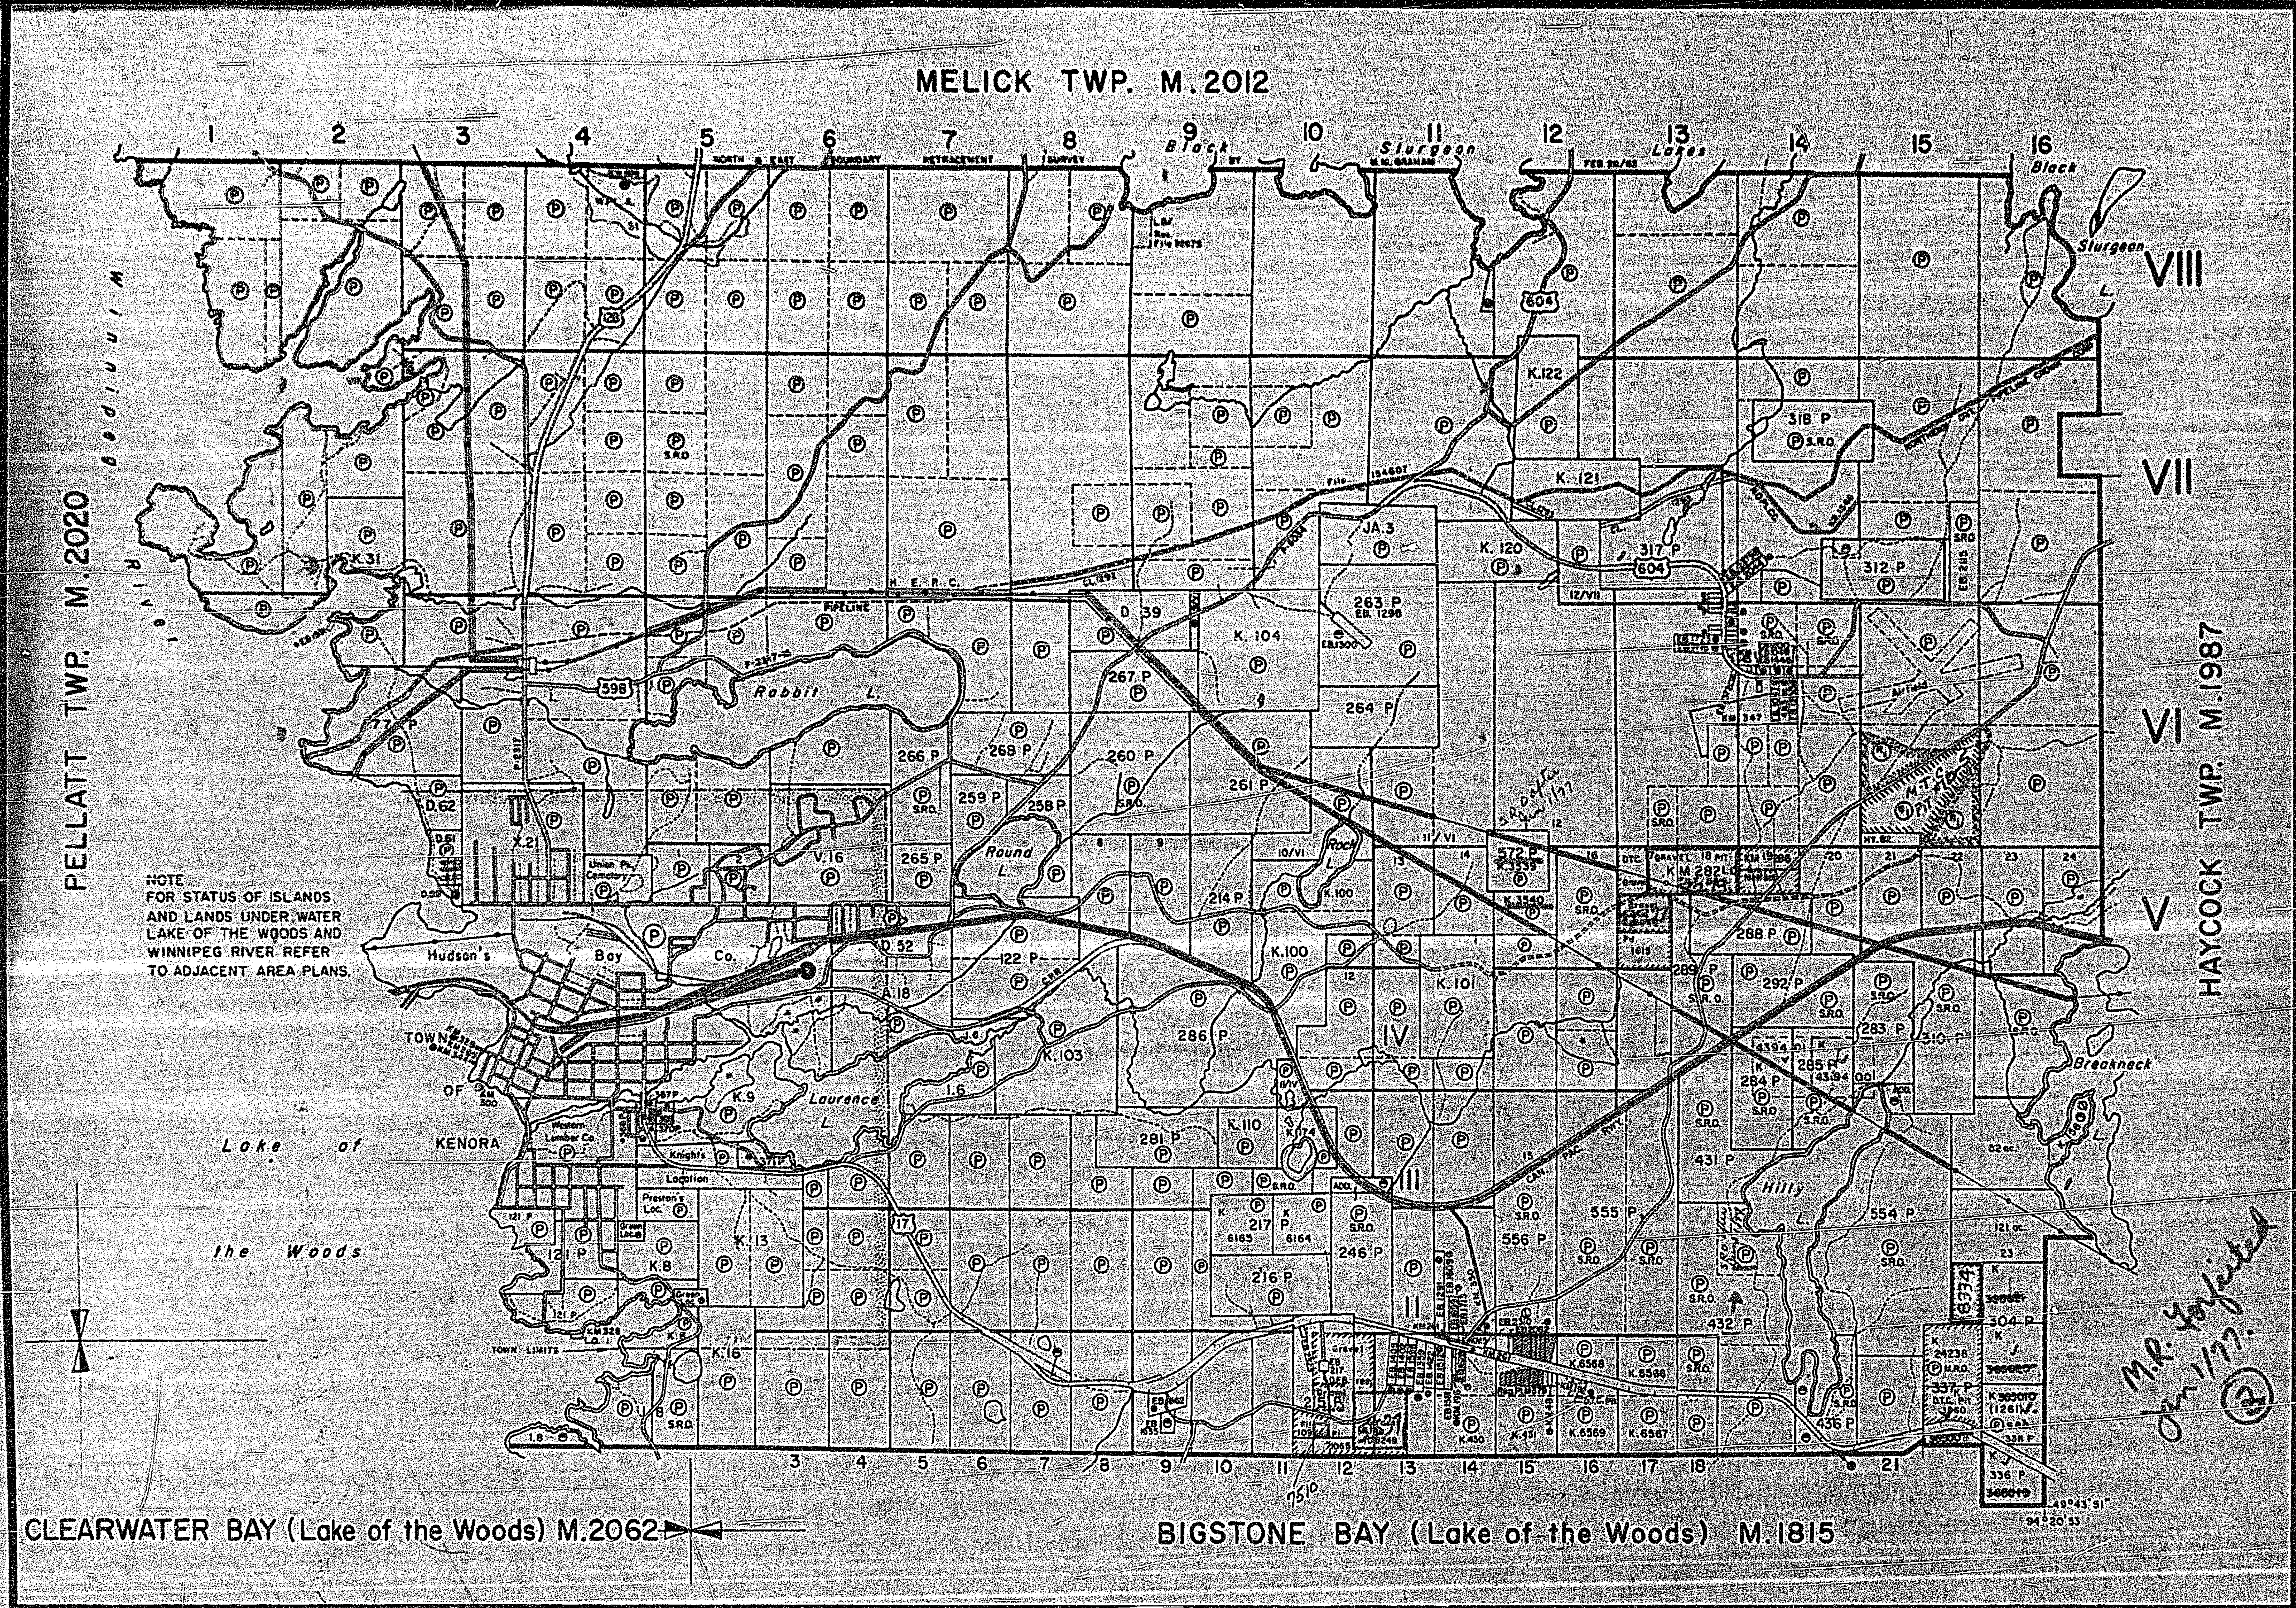
MELICK TWP. M.2012
NORTH & EAST BOUNDARY RETRACEMENT SURVEY BY W.N. GRAHAM FEB 26/63
Black Sturgeon Lakes
PELLATT TWP. M.2020
HAYCOCK TWP. M.1987
Winnipeg River
VIII
VII
VI
V
IV
III
II
Rabbit L.
Round L.
Rock L.
Laurence L.
Hilly L.
Breakneck L.
Hudson's Bay Co.
TOWN OF KENORA
Lake of the Woods
Knight's Location
Preston's Loc.
Union Pk. Cemetery
Airfield
H.E.P.C. PIPELINE
CAN. PAC. RY.
598
604
17
CLEARWATER BAY (Lake of the Woods) M.2062
BIGSTONE BAY (Lake of the Woods) M.1815
49°43'51"
94°20'53"

NOTE
FOR STATUS OF ISLANDS
AND LANDS UNDER WATER
LAKE OF THE WOODS AND
WINNIPEG RIVER REFER
TO ADJACENT AREA PLANS.

M.R. forfeited
Jan 1/77.
③

S.R.O. after Jan 1/77

NOTES

400' surface rights reservation along the shores of all lakes and rivers.

Flooding rights reserved on Winnipeg River and Alcock Lake to contour elev. 1051.20' G.S.C. Jan. 23/40. File 4922 vol. 5

H.E.P.C. flooding rights on Winnipeg River and Alcock Lake to contour elev. 1045' G.S.C. W.P.L.A. 51 File 12999

Ⓡ S.R.O. RESERVED FOR REFORESTATION FILE: 97164.

Ⓖ SAND & GRAVEL RESERVE FILE: 97164

Mining Rights on K3540 K3539
Thrown open
for staking
on June 1/77

DATE OF ISSUE
AUG 25 1976

KENORA
MINING DIV.
RECEIVED
AUG 31 197
AM
7,8,9,10,11,12,1,2,3

LEGEND

PATENTED LAND	Ⓟ or ●
PATENTED FOR SURFACE RIGHTS ONLY	⊖
LEASE	Ⓛ
LICENSE OF OCCUPATION	L.O.
CROWN LAND SALES	C.S.
LOCATED LAND	Loc.
CANCELLED	C
NOT THROWN OPEN FOR STAKING	⊘
MINING RIGHTS ONLY	M.R.O.
SURFACE RIGHTS ONLY	S.R.O.
HIGHWAY & ROUTE NO.	17
ROADS	═
TRAILS	----
RAILWAYS	┼┼┼
POWER LINES	—•—
MARSH OR MUSKEG	
MINES	⚒

† used only with summer resort locations or when space is limited

TOWNSHIP OF

JAFFRAY

DISTRICT OF
KENORA

KENORA
MINING DIVISION

#10

SCALE: 1 INCH = 40 CHAINS (1/2 MILE)

DR. D.T.	PLAN NO.	M.1992
DATE JULY/71		

ONTARIO
MINISTRY OF NATURAL RESOURCES
SURVEYS AND MAPPING BRANCH

1992

PLAN OF

JAFFRAY TWP.

M-1992

KENORA MINING DIVISION.

DISTRICT OF KENORA.

Scale, 40 chains to an inch.

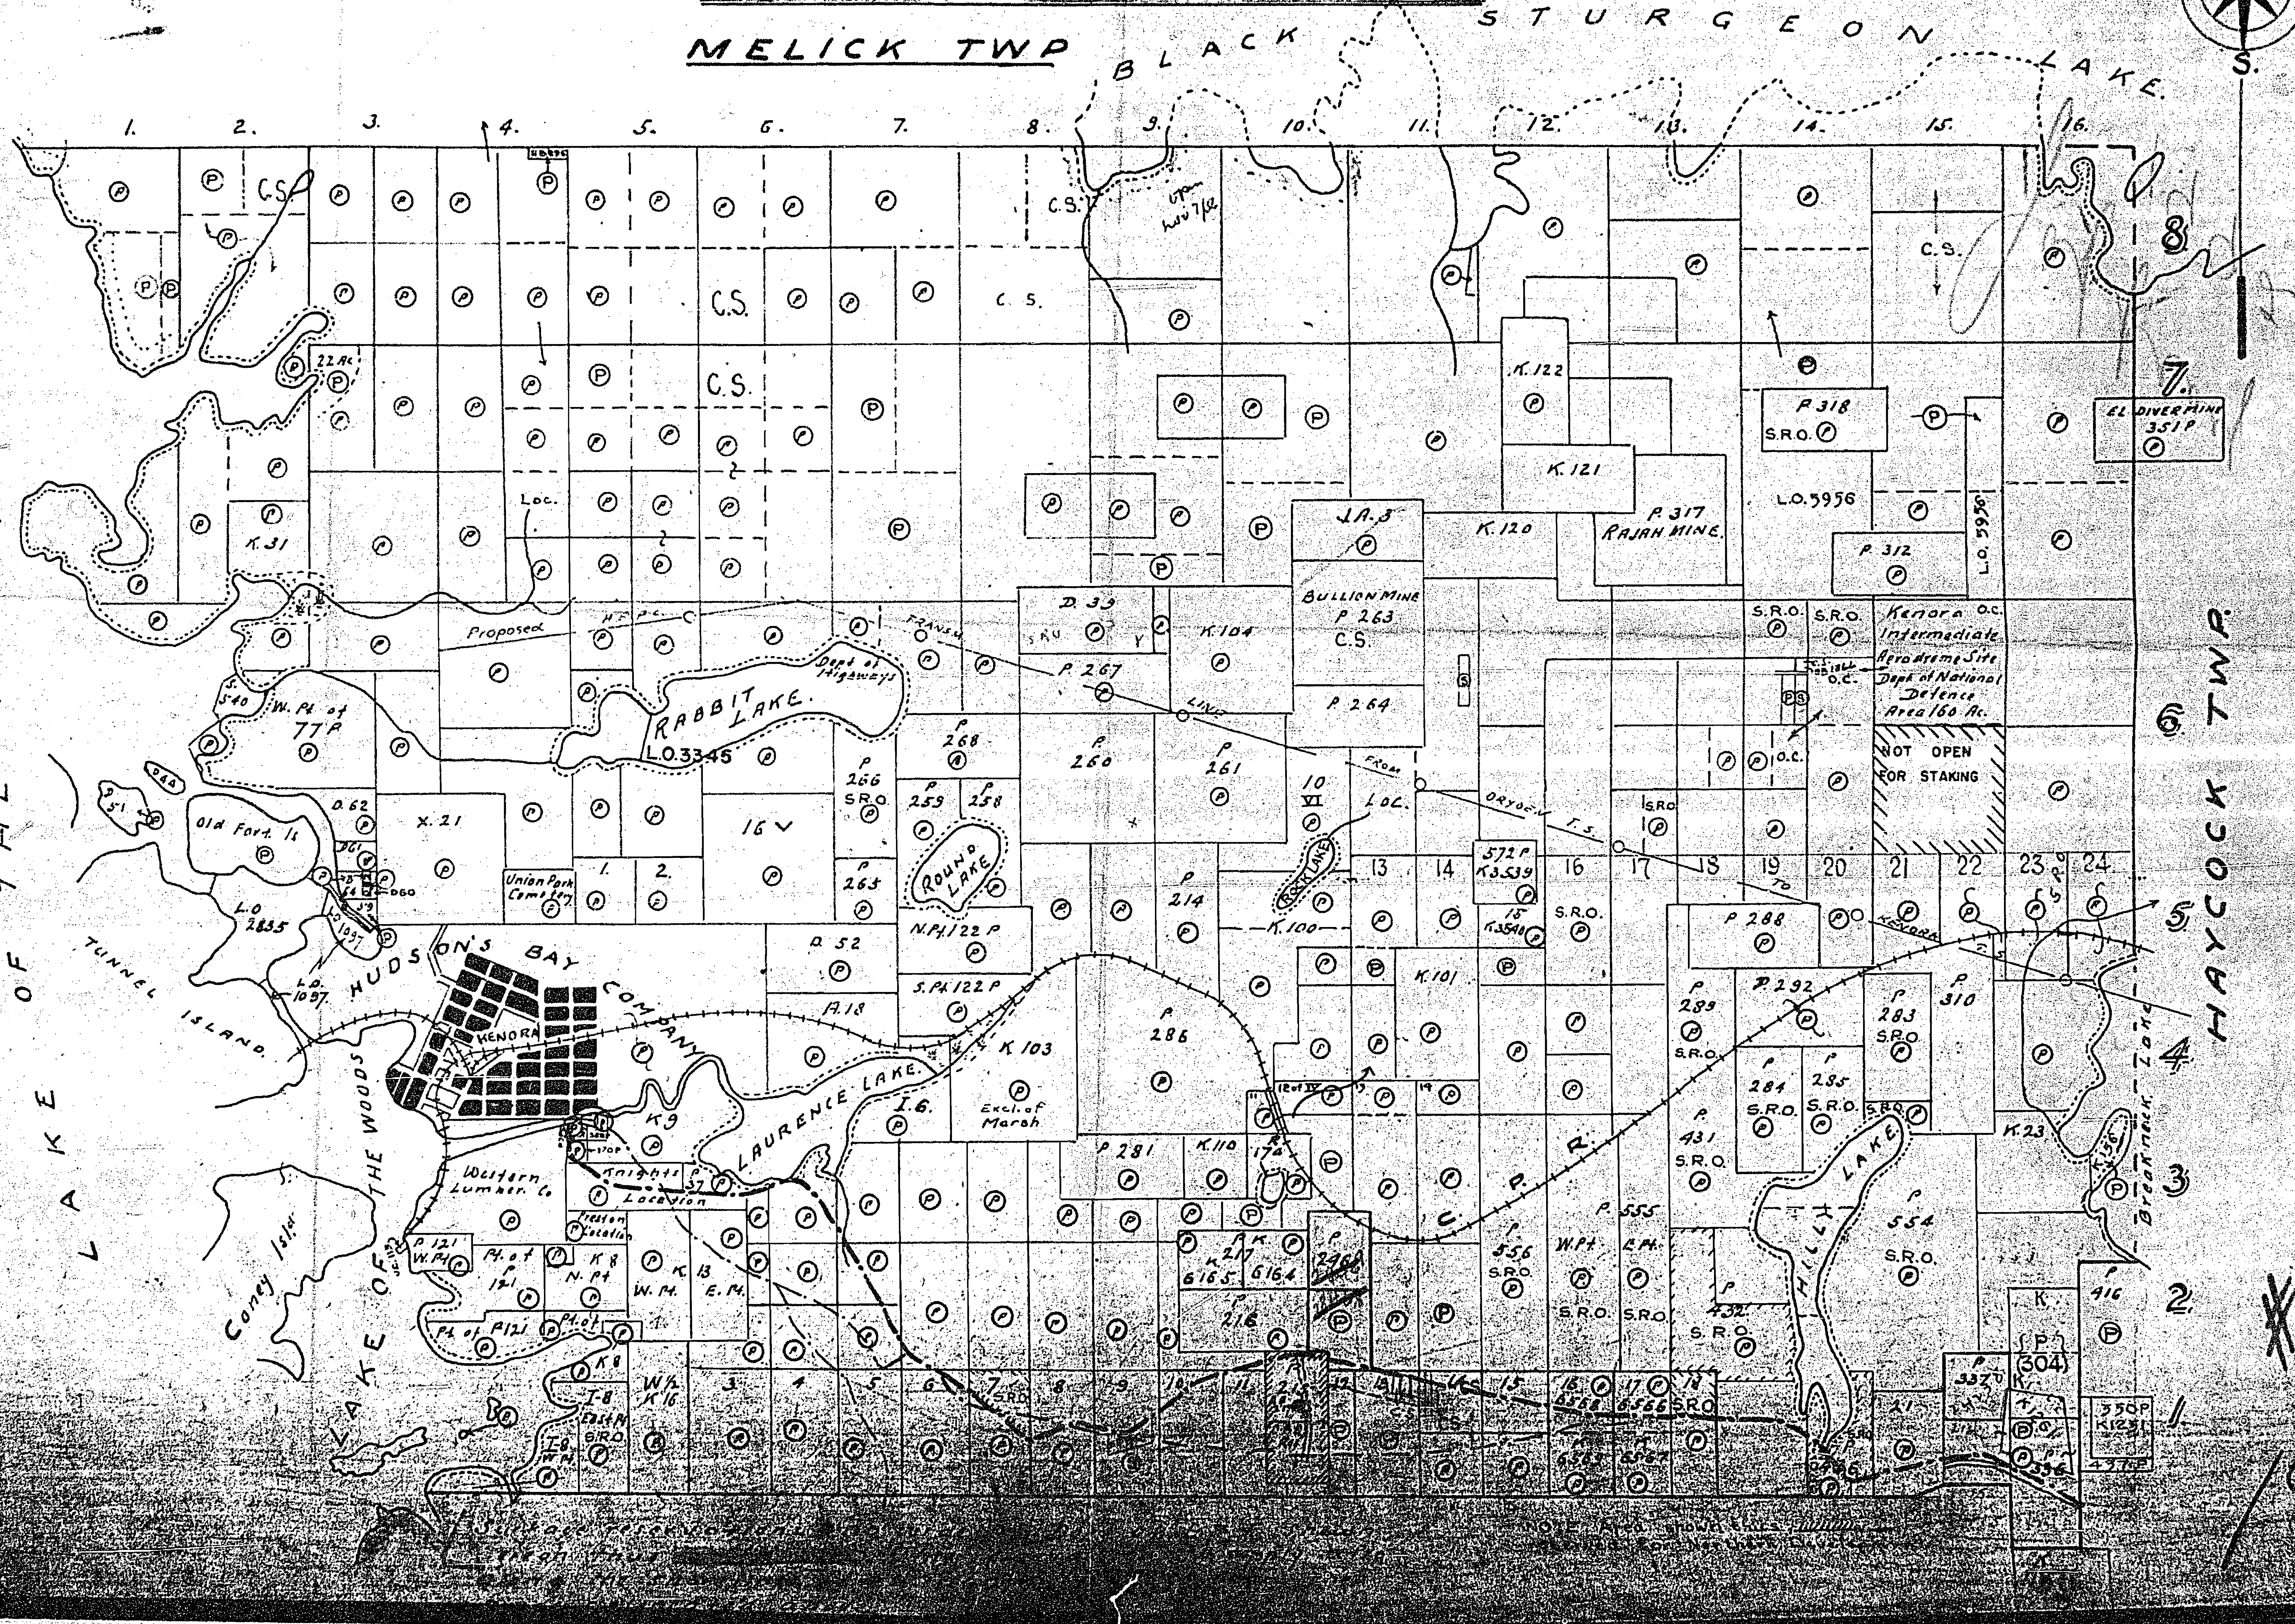

MELICK TWP
BLACK STURGEON LAKE
HAYCOCK TWP
LAKE OF THE WOODS
LAKE OF THE WOODS
TUNNEL ISLAND
HUDSON'S BAY COMPANY
KENORA
RABBIT LAKE
L.O. 3345
Dept of Highways
ROUND LAKE
LAURENCE LAKE
HILLY LAKE
Breakneck Lake
Old Fort. Is
Coney Isl.
Western Lumber Co
Knight's Location
Preston Location
Union Park Cemetery
Proposed
C.P.R.
BULLION MINE P 263
RAJAH MINE P 317
EL DIVER MINE 351 P
Kenora Intermediate Aerodrome Site Dept of National Defence Area 160 Ac.
NOT OPEN FOR STAKING
L.O. 5956
P 318 S.R.O.
P 312
K.122
K.121
K.120
K.104
K.103
K.101
K.100
K.110
K.31
K9
K8
X.21
P.267
P.264
P.260
P.261
P.268
P.259
P.258
P.266 S.R.O.
P.265
P.286
P.288
P.292
P.310
P.289 S.R.O.
P.283 S.R.O.
P.284 S.R.O.
P.285 S.R.O.
P.431 S.R.O.
P.432 S.R.O.
P.554 S.R.O.
P.555
P.556 S.R.O.
P.281
P.214
P.216
P.416
P.52
A.18
N.Pt.122 P
S.Pt.122 P
W.Pt. of 77 P
L.O. 2835
L.O. 1097
C.S.
N. W. S. E.
1. 2. 3. 4. 5. 6. 7. 8. 9. 10. 11. 12. 13. 14. 15. 16.
1 2 3 4 5 6 7 8

#3

1/9

1992

PLAN OF
JAFFRAY TWP.
KENORA MINING DIVISION.
DISTRICT OF KENORA.

Scale, 40 chains to an inch.

JAFFRAY 1992

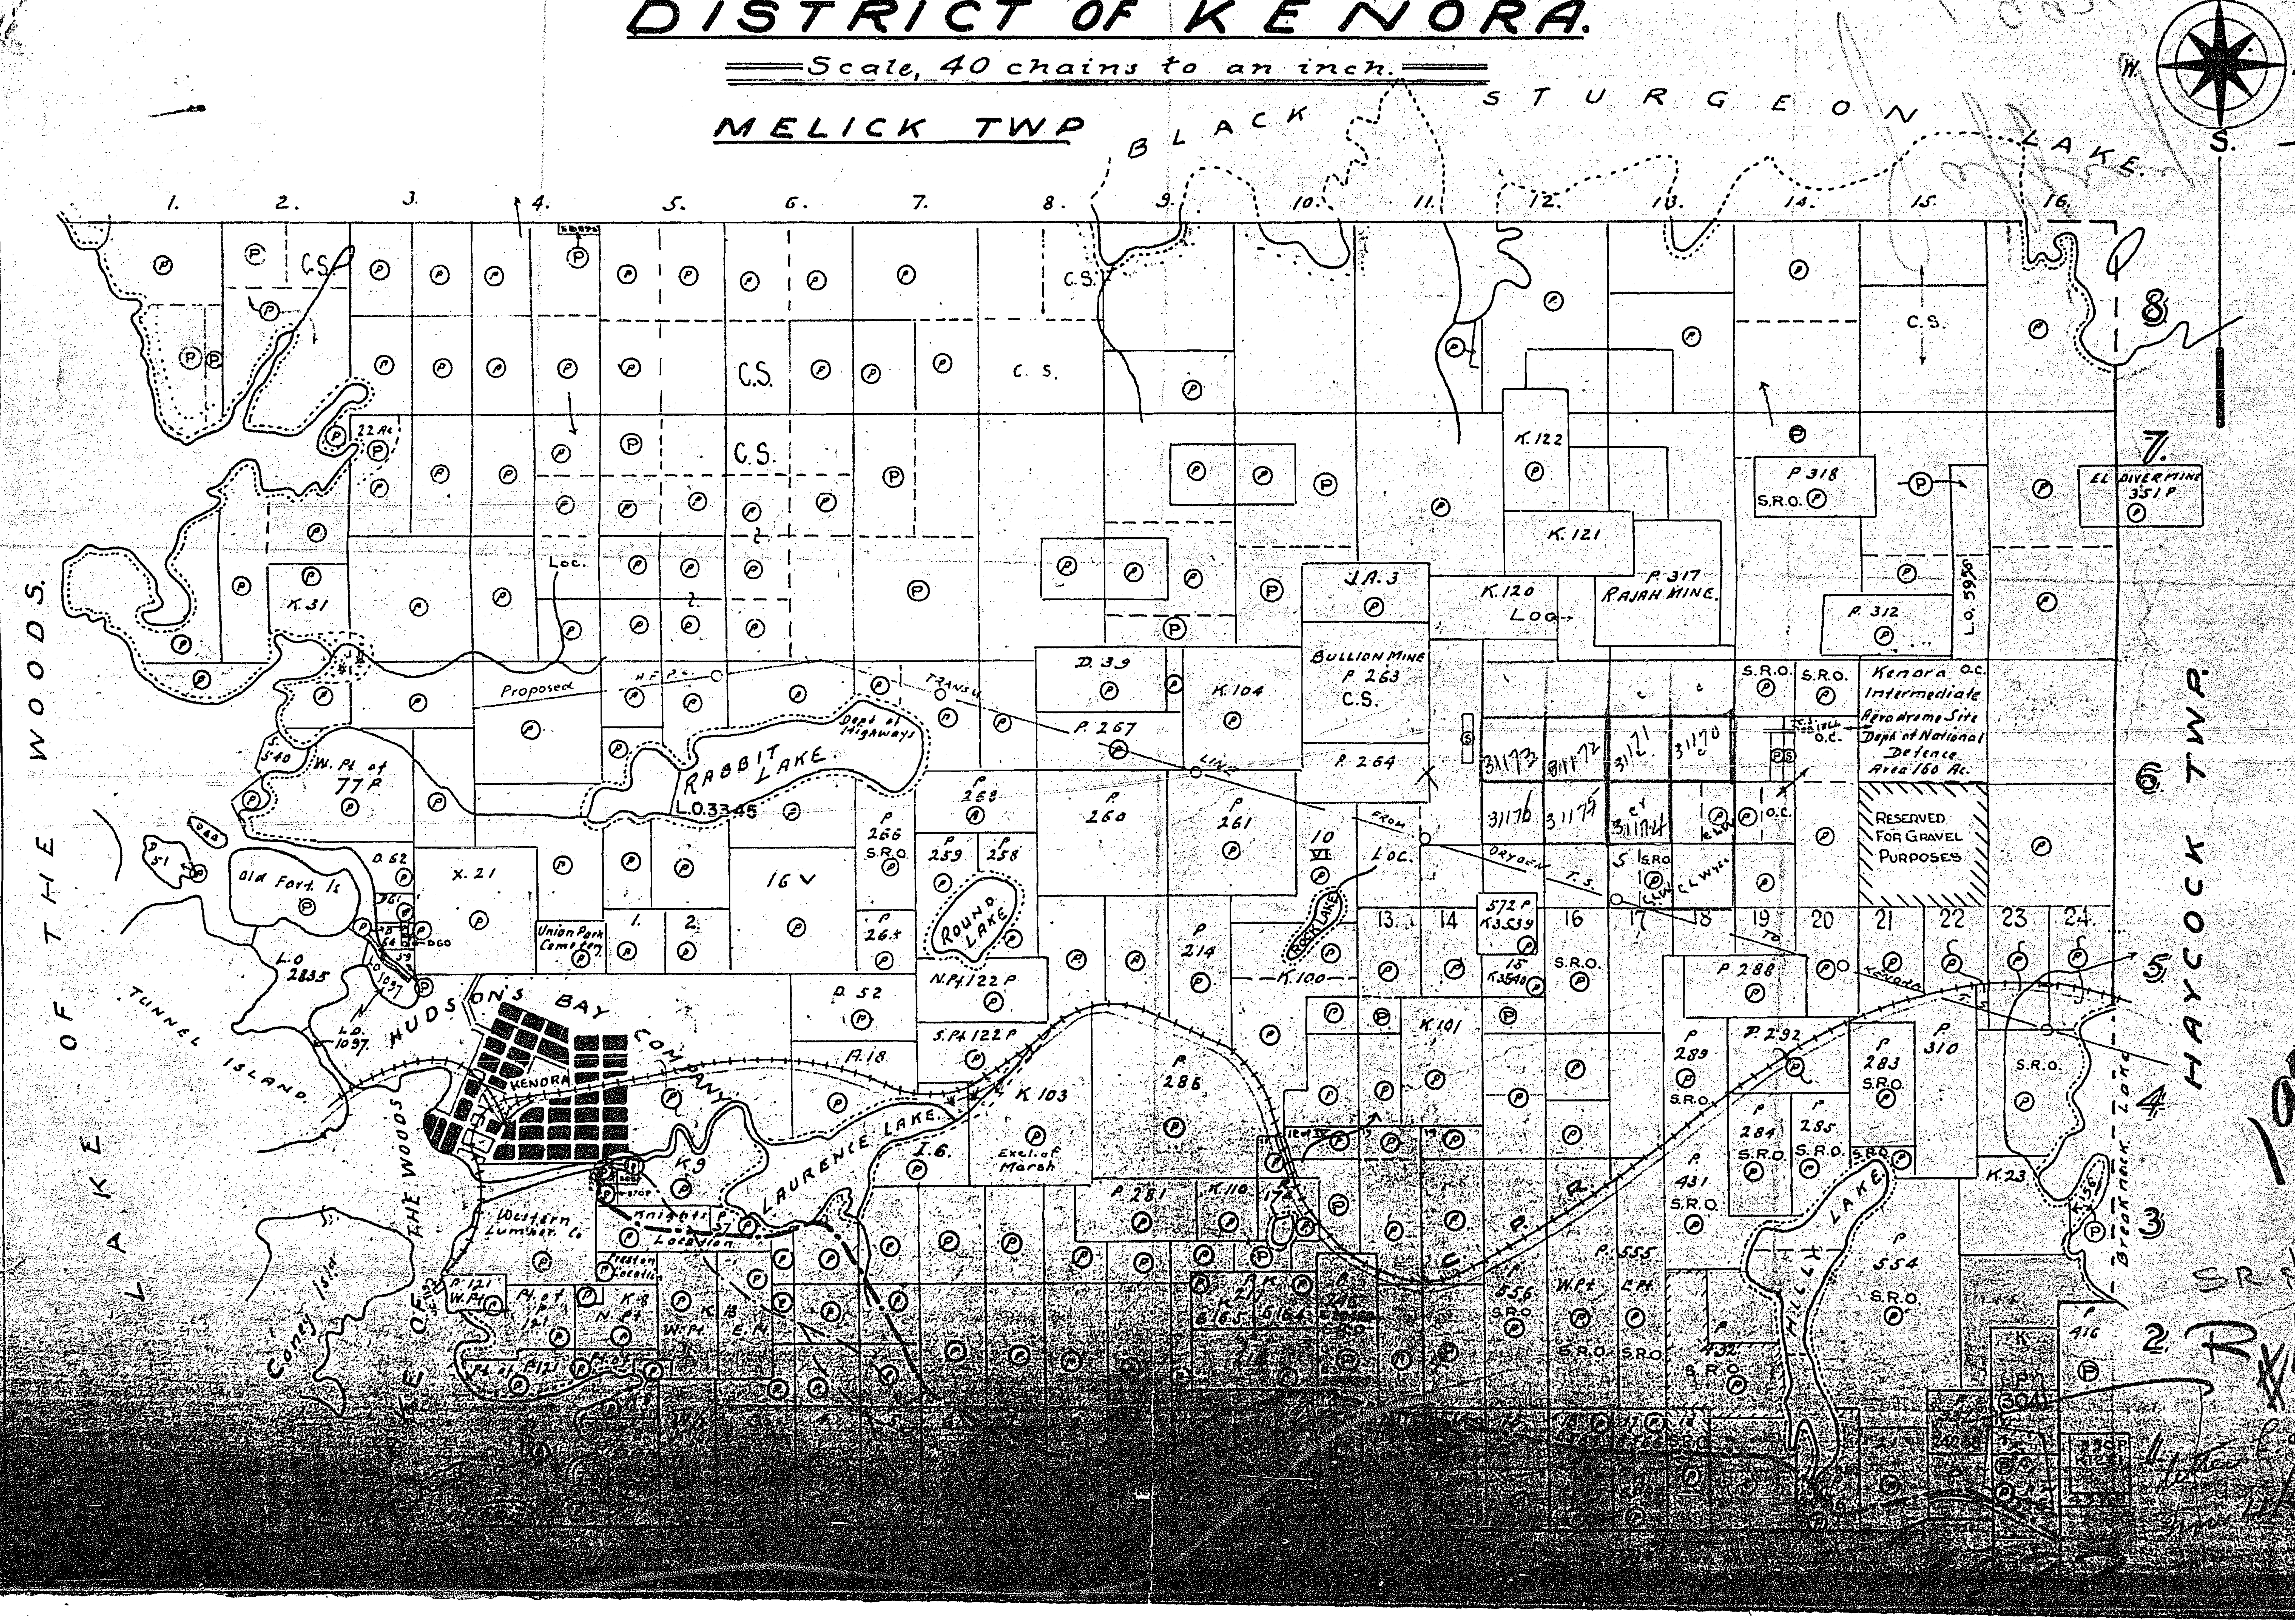

MELICK TWP
BLACK
STURGEON LAKE
AST. NORTH.
N
W
E
S
1.
2.
3.
4.
5.
6.
7.
8.
9.
10.
11.
12.
13.
14.
15.
16.
8
7.
6.
5
4
3
2
C.S.
K.31
22 Ac.
Loc.
K.122
K.121
K.120
Loc.
P. 317
RAJAH MINE.
P 318
S.R.O.
EL DIVER MINE
351 P
P. 312
L.O. 5956
J.A. 3
D. 39
K. 104
BULLION MINE
P. 263
C.S.
Kenora O.C.
Intermediate
Aerodrome Site
Dept. of National
Defence.
Area 160 Ac.
RESERVED
FOR GRAVEL
PURPOSES
Proposed
TRANS.
LINE
FROM
ORYOCH T.S.
TO KENORA
RABBIT LAKE
Dept. of Highways
L.O. 3345
W. Pt. of
77 P.
P. 267
P. 264
P. 260
P. 261
P 268
P 266
S.R.O.
P 259
P 258
31173
31172
31171
31170
31176
31175
31174
Old Ford. Is.
D. 62
X. 21
16 V
Union Park
Cemetery
P 26.5
ROUND LAKE
N. Pt. 122 P
S. Pt. 122 P
D. 52
A. 18.
L.O.
2835
L.O. 1057
TUNNEL ISLAND
HUDSON'S BAY COMPANY
KENORA
LAKE OF THE WOODS
LAURENCE LAKE
K 103
Excl. of Marsh
P. 286
P 214
K. 100
K. 101
10
VI
Loc.
13.
14.
15.
16
17
18
19
20
21
22
23
24.
572 P
K. 3539
K. 3540
S.R.O.
P. 288
P. 289
S.R.O.
P. 292
P. 283
S.R.O.
P. 310
P 284
S.R.O.
P 285
S.R.O.
P 431
S.R.O.
K. 9
Western Lumber Co.
Knights Location
Coney Island
K. 8
W. Pt.
P. 281
K. 110
P. 555
W. Pt.
E. Pt.
P 556
S.R.O.
S.R.O.
S.R.O.
P 554
S.R.O.
LILLY LAKE
K. 23
P 416
C. P. R.
HAYCOCK TWP.
Broken Zone
S.R. MR
R
#A
1992

JAFFRAY.

Scale 40 Chains to an Inch

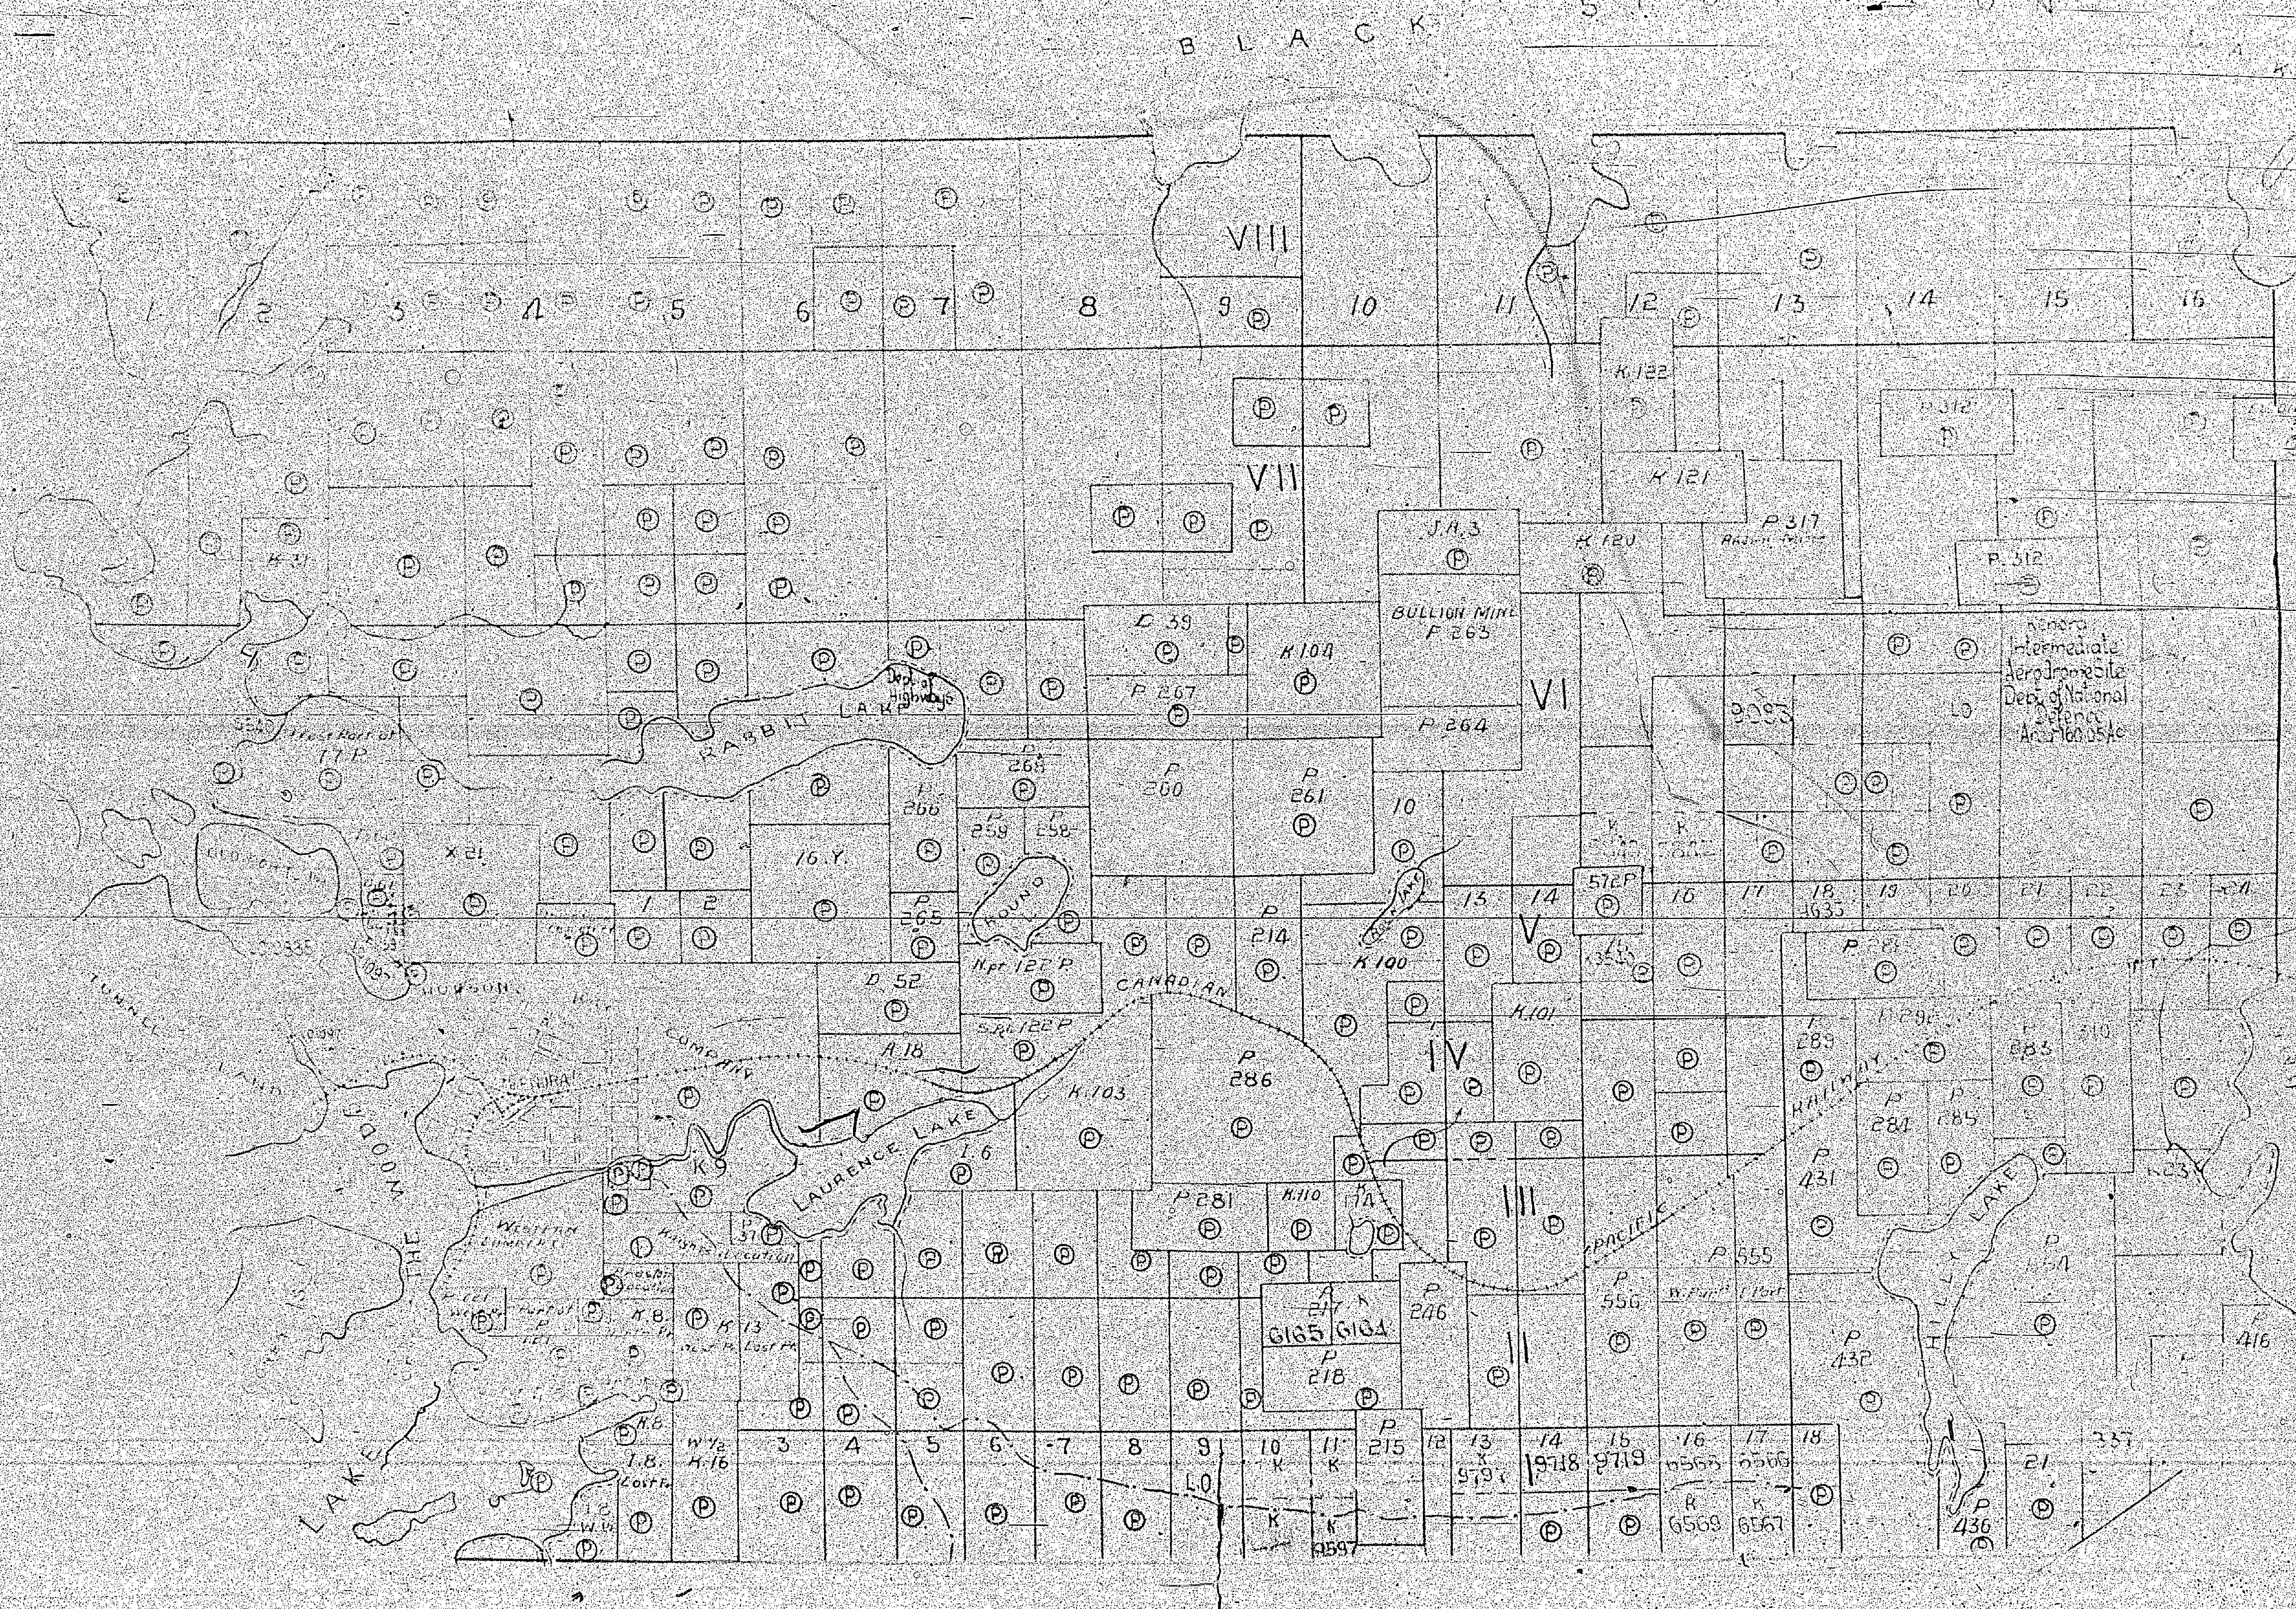
BLACK STURGEON LAKE
VIII
VII
VI
V
IV
III
II
1
2
3
4
5
6
7
8
9
10
11
12
13
14
15
16
K.122
K.121
K.120
P.312
P.317
P.312
J.A.3
BULLION MINE P.263
D.39
K.104
P.267
P.264
Dept. of Highways
RABBIT LAKE
Kenora Intermediate Aerodrome Site Dept. of National Defence
P 260
P 261
P 268
P 266
259
258
K 21
16.Y.
265
ROUND
1
2
D.52
A.18
K.103
P 286
P 214
K.100
K.101
P.281
K.110
K.9
LAURENCE LAKE
HUDSON'S BAY COMPANY
CANADIAN PACIFIC RAILWAY
TUNNEL ISLAND
LAKE OF THE WOODS
Western Lumber Co
K.8
K 13
P 246
6165
6164
P 218
P 556
P 555
P 431
P 432
P 284
P 285
HILLY LAKE
BREAKNECK
416
P 436
337
21
P 215
9718
9719
6565
6566
6569
6567
18
17
16
15
14
13
12
11
10
9
8
7
6
5
4
3
W½ K.16
9597
L.O.